Bid Set - ADDENDUM NO. 02

December 22, 2023

RE: City Hall Annex Building VRF HVAC Installation

310 1st Street

Kirkland, WA 98033 Project No. 52-23-CMO

FROM: Wood Harbinger, Inc.

929 108th Ave. NE, Suite 1000

Bellevue, WA 98004 (425) 628-6094

TO: Prospective Bidders

This Addendum forms a part of the Contract Documents and modifies the original Bidding Documents dated December 6, 2023, as noted below. Acknowledge receipt of this Addendum in the space provided on the Bid Form. Failure to do so may subject Bidder to disqualification.

This Addendum consists of 1 pages and the referenced attachments.

CHANGES TO INFORMATION FOR BIDDERS:

- 1. November 8, 2023 Bid Walk attendance roster
- 2. December 12, 2023 Bid Walk attendance roster

CHANGES TO SPECIFICATIONS:

1. No Changes.

CHANGES TO DRAWINGS:

1. Replace drawing E3.1, E3.2, E5.1 and E7.1 with attached revised drawings dated 12/20/2023.

THE FOLLOWING CLARIFICATIONS ARE ISSUED IN RESPONSE TO BIDDERS QUESTIONS AND ISSUES DISCUSSED AT PRE-BID - None

ATTACHMENTS:

Bid Walk attendance roster 11-08-23 Bid Walk attendance roster 12-12-23 Revised Drawing E3.1 Revised Drawing E3.2 Revised Drawing E5.2 Revised Drawing E7.1

END OF ADDENDUM



929 108th Ave NE, Suite 1000 Bellevue, WA 98004 425.628.6000 woodharbinger.com

City of Kirkland City Hall Annex Building VRF HVAC Installation WH #23018

11-\$08-2023

Meeting Attendance

| | | | Bid Walk 830 11/8 | | <i>(</i> |
|----------|------------------|----------------------------------|------------------------------|---------------|---------------|
| Initials | Attendee | Organization | Email | Office Phone | Cell |
| IM | Joe Moran | PSF Mech | mora wapsfuech | com | 266 331 665 |
| MM | Michael McCoy | JHI | seth@apexmenantal.org | ch. com | 206)786-440 |
| SGI | Samantha Granger | Apex Mechanical | seth@apexmenantal.org | 360-6 | 06-8735 |
| 58 | Segn Bollen | Wood Harbinger | sholker woodharking.com | | |
| MQ | MIKE LEKKAGE | u el | MLEH MERO WOOD HABING. | OF 615 6094 | |
| M. 5 | Michal Buch | MBE Electric | in bee lective @ hotmail.com | | |
| PN | Pave Nikolin | PAHSC | paulikelinagmail.com | 425 215 8384 | \rightarrow |
| EN | Elihn Nikolin | Product Air Heating & Cooling | Productairhand Cagmaile | 425-344-3738= | 7 |
| 74 | JOHN HUGHES | morgan | I thoughts GHUAR mongon. can | 2062239077 | |
| | | | | | , |
| | - | | | | |
| | | | | | |
| | | | | | |
| | | · | | | |
| | | | | | |



City of Kirkland City Hall Annex Building VRF HVAC Installation WH #23018 929 108th Ave NE, Suite 1000 Bellevue, WA 98004

425.628.6000


woodharbinger.com

Meeting Attendance

12/12/2023

Bid Walk

| Initials | Attendee | Organization | Email | Office Phone | Gell |
|----------|---------------|-----------------|---|---|--------------|
| YE | YURY PALATNIK | Apron TECH INC. | office/@apcon-TECH.60 | as 425-765-77 | 999 +1 |
| VB | KAL BRAN | K. A Com lenn | KA General but LLC | 20635327 | 7 <- |
| 1W | Trevor Wheted | Phase 3 Eleanz | Kagcco@gmail.com Trevorwephase3electri | | |
| KB | KOFI BOADY | BUADUS RRIDE | Trevor We phase 3 electri | con | 425-327-1992 |
| | | 4 | Office @ Barous . 40 m | 206-371-7234 | y |
| SB | San Bolley | Wood Harbinger | Shallen @ wood hashingo, co | 425-628-6051 | |
| ML | MIRE LEMMA | le 11 | Sholley a wood hashing on MIFHNERA WOOD HARRINGER | 15 628 6009 | |
| | | | WOOD HARBINGA | m | |
| | | | | | |
| | | | | | |
| | | | | 0 | |

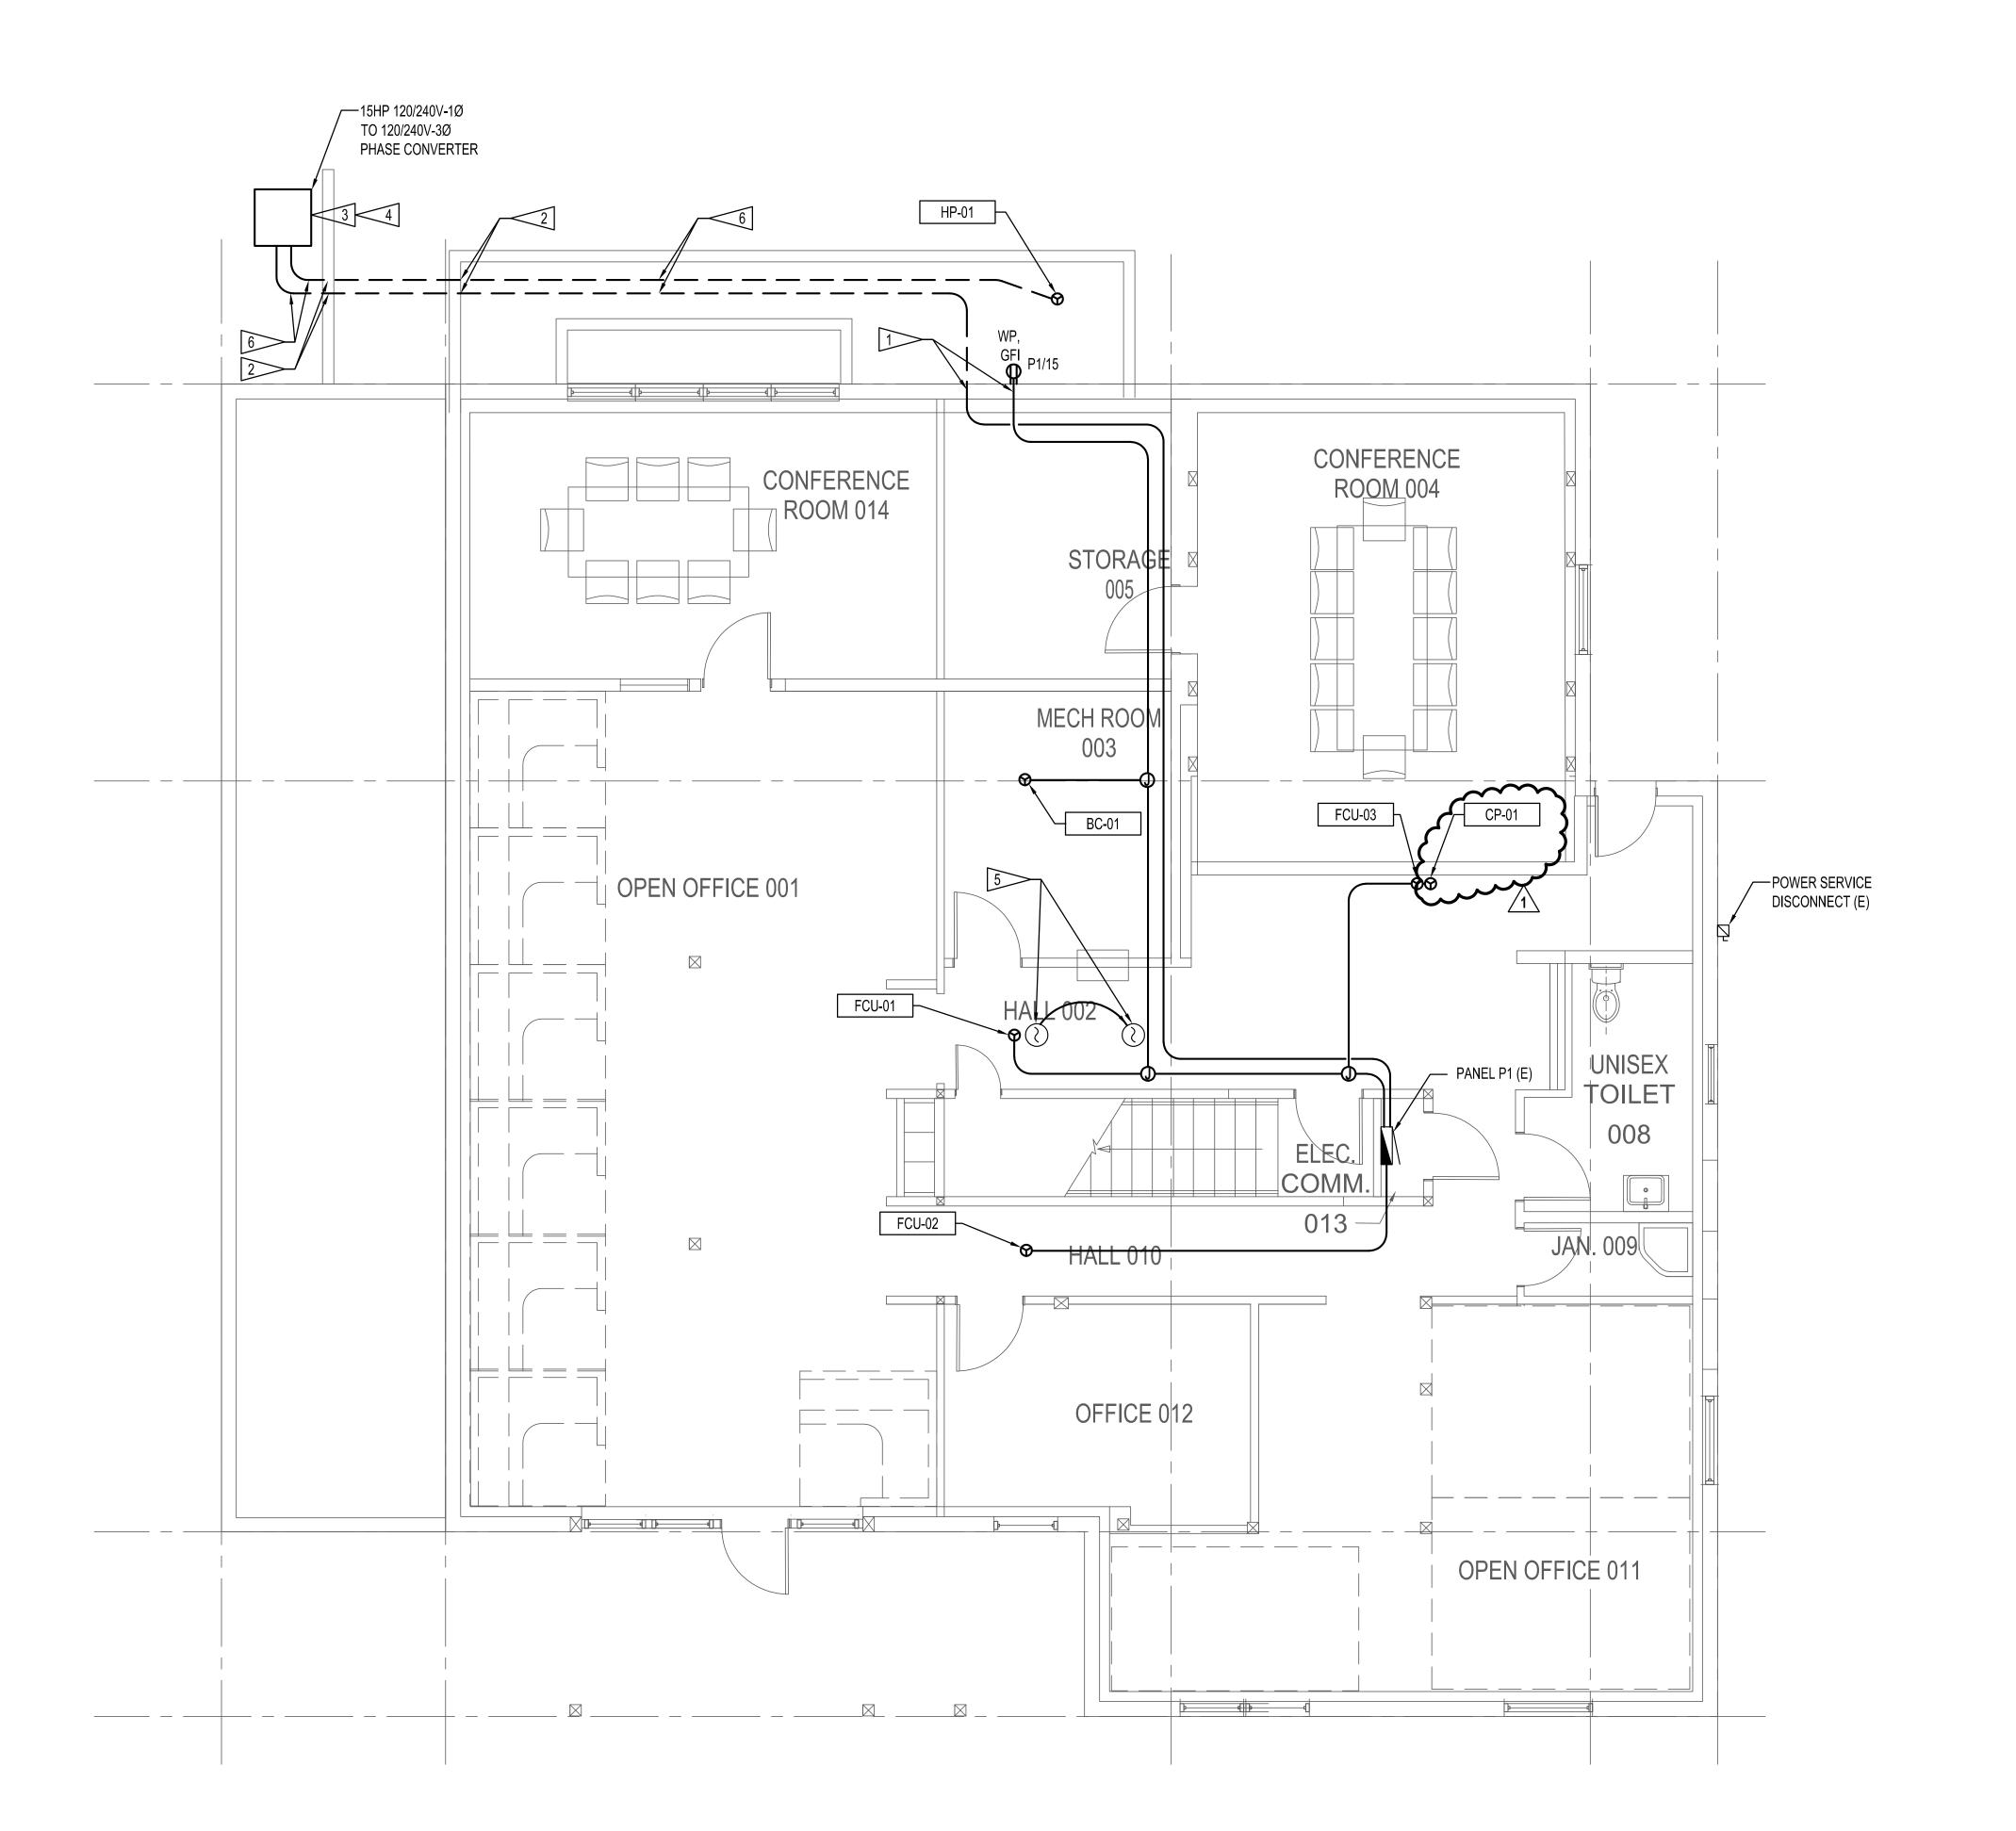

ELECTRICAL GROUND FLOOR PLAN SCALE: 1/4" = 1'-0"

GENERAL NOTES

1. CIRCUITS SHALL UTILIZE SURFACE METAL RACEWAY TO FAN COIL UNITS AND BRANCH CONTROLLERS. FIELD VERIFY LOCATION OF BEAMS. PROVIDE ALL REQUIRED FITTINGS TO ROUTE AROUND BEAMS.

HEAT PUMP SHALL UTILIZE EMT FIELD PAINTED TO MATCH WALLS/CEILINGS. CORE DRILL EXISTING EXTERIOR WALL. EXTERIOR CONDUIT SHALL BE PVC SCHEDULE 40.

SHEET NOTES

1 CORE DRILL EXISTING EXTERIOR WALL FOR CONDUIT PENETRATIONS. SEAL CONDUIT PENETRAION.

2 CORE DRILL UNDER EXISTING WALKWAY AND ROUTE CONDUITS UNDER WALKWAY.

3 PROVIDE 4" THICK CONCRETE HOUSE KEEPING PAD. PAD SHALL EXTEND 4" BEYOND EQUIPMENT FOOTPRINT. PROVIDE EXCAVATION SO PAD IS FLAT AND LEVEL.


4 PROVIDE UNISTRUT SUPPORT FOR DISCONNECT SWITCH.

5 RELOCATE EXISTING SMOKE DETECTOR TO ALLOW INSTALLATION OF MECHANICAL UNIT. CENTER DETECTOR BETWEEN LUMINAIRE AND SOFFIT. CUT AND PATCH/PAINT EXISTING CEILING. PROVIDE CONCEALED CONDUIT AND FIRE ALARM WIRING TO MATCH EXISTING. CONTRACTOR SHALL SUBMIT, PAY AND OBTAIN FIRE ALARM

6 CONDUIT SHALL BE MINIMUM OF 18" BELOW GRADE. PROVIDE REQUIRED TRENCHING AND BACKFILL.

REVISION 1 ADDENDUM 1 12/20/2023

| Wood | Harbinger

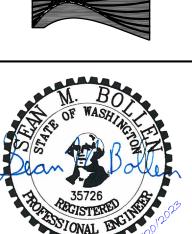


12/06/2023 AS-NOTED

> 23018 E3.1

SHEET - OF 5

BID DRAWING SET

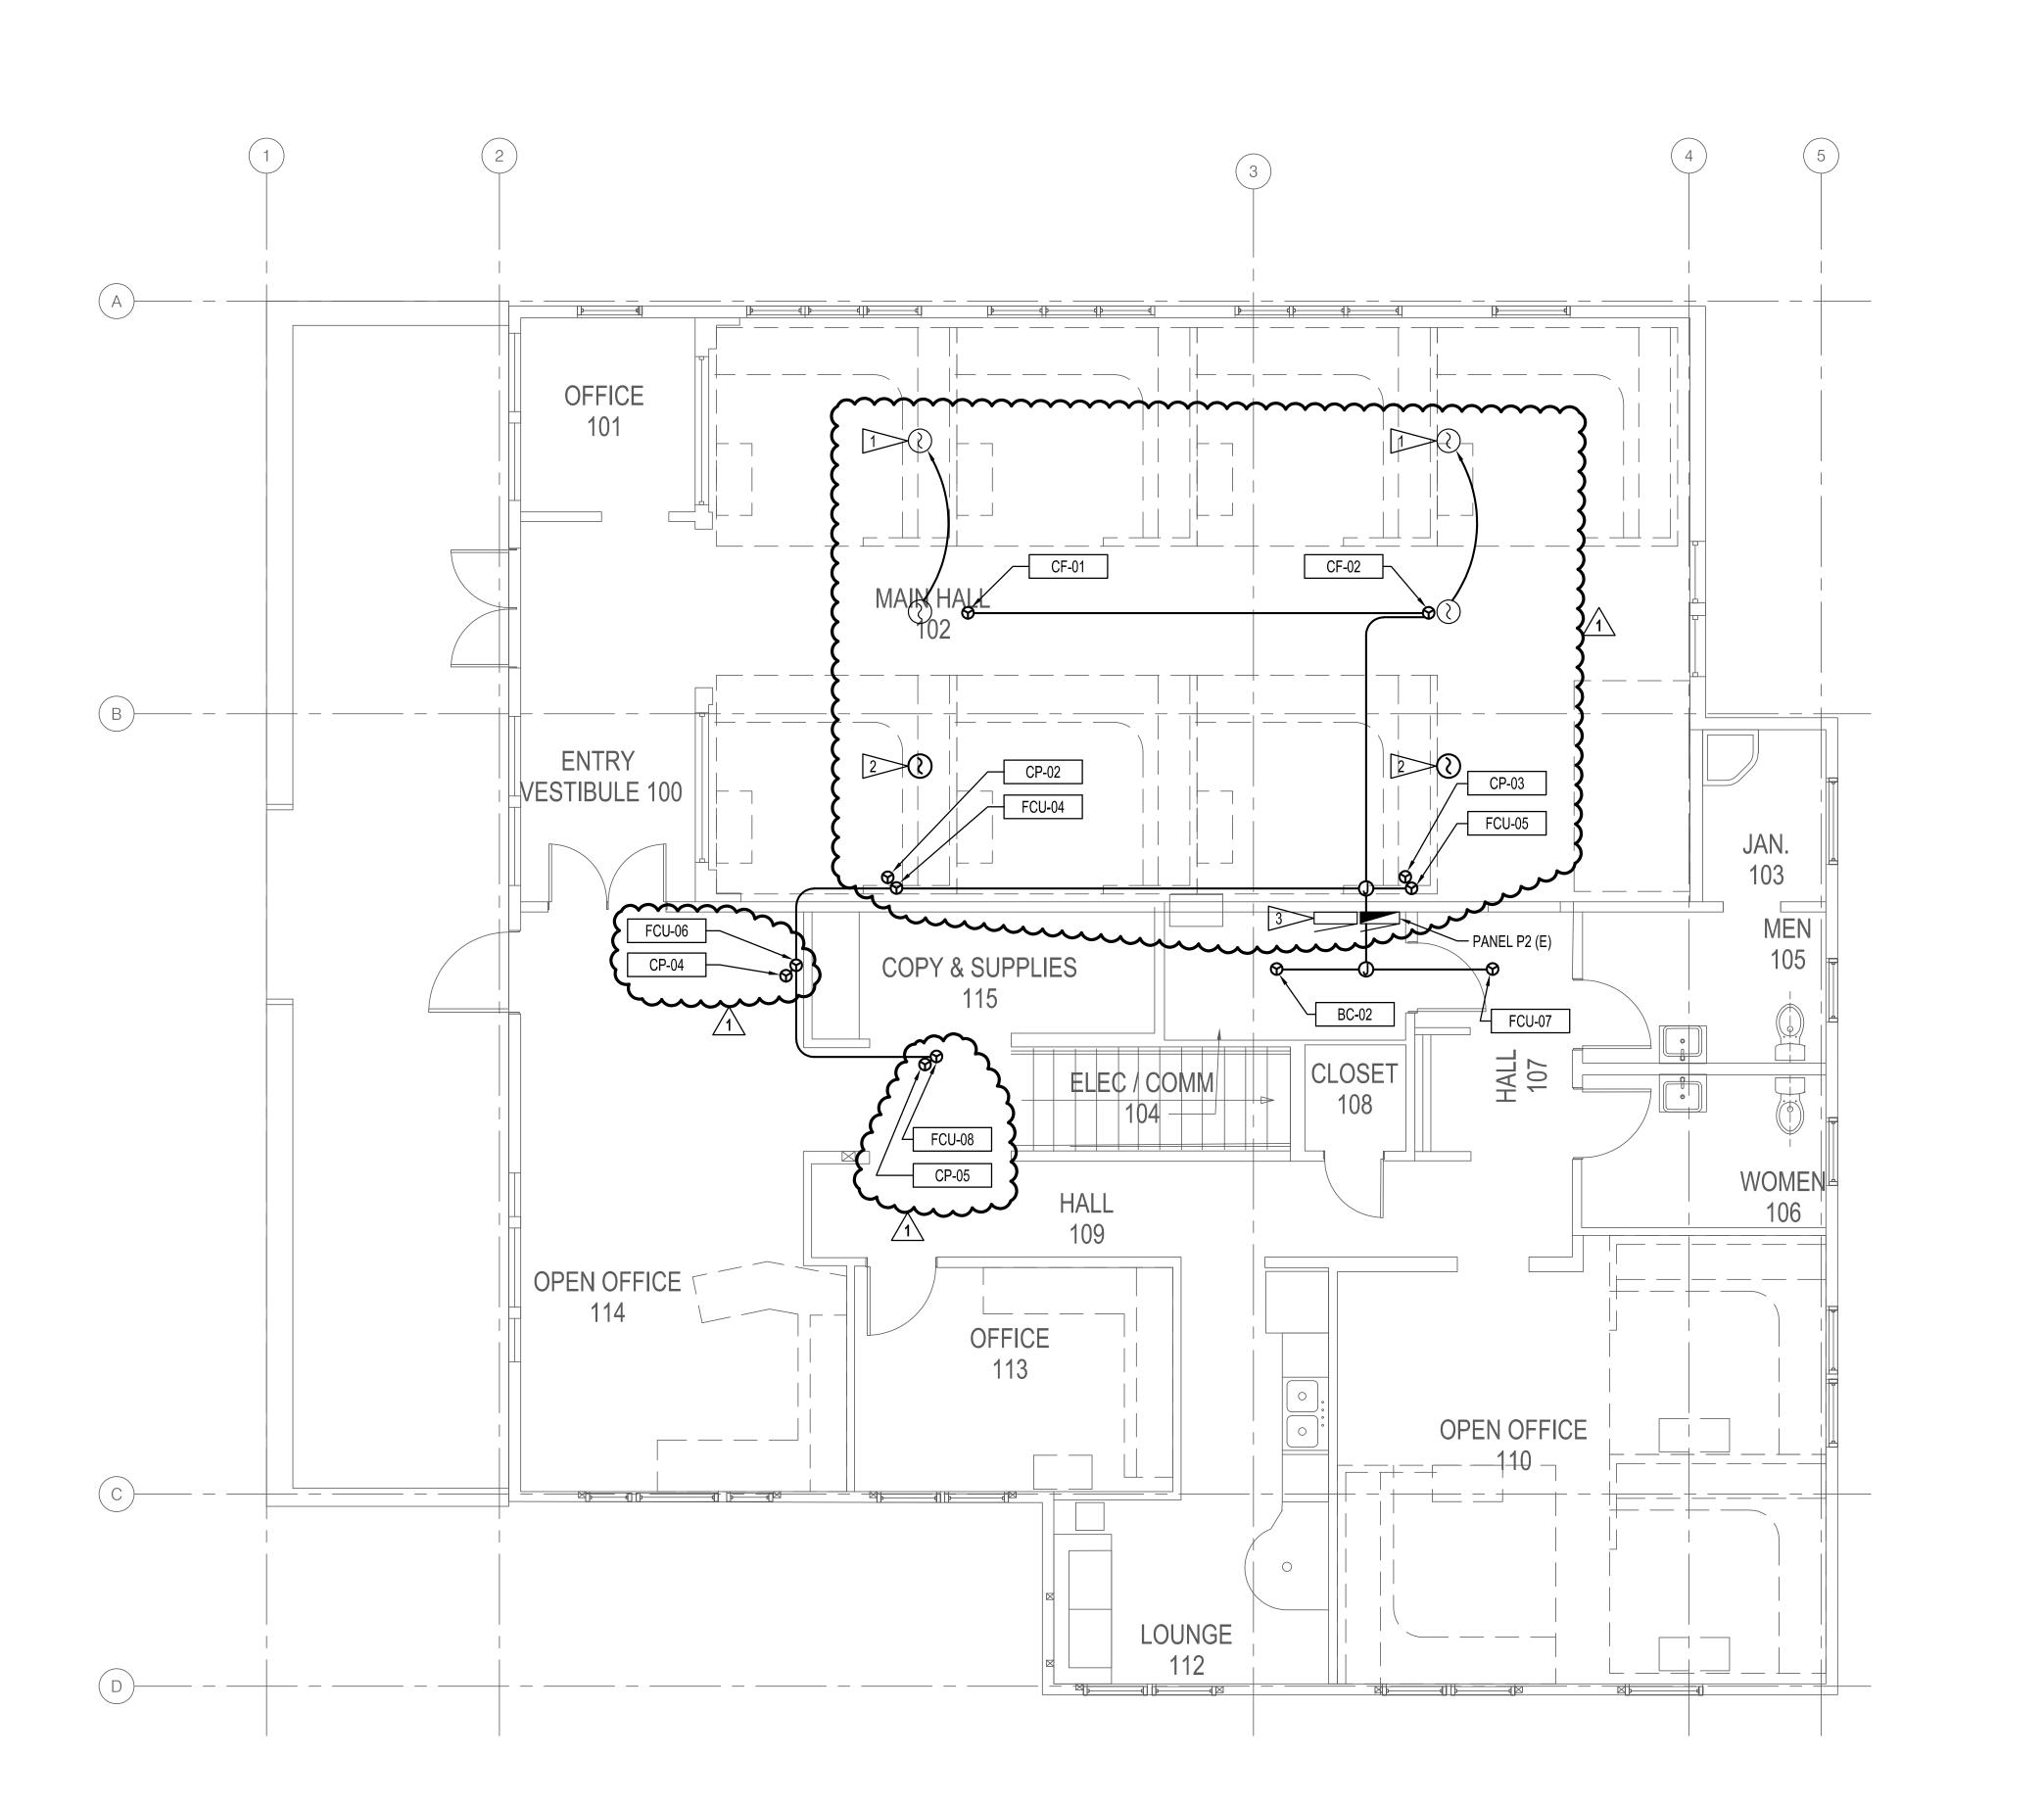

GENERAL NOTES 1. SURFACE MOUNTED CIRCUITS SHALL UTILIZE SURFACE METAL RACEWAY. FIELD VERIFY LOCATION OF BEAMS. PROVIDE ALL REQUIRED FITTINGS TO ROUTE AROUND BEAMS. EMT CONDUITS

CAN BE ROUTED IN ATTIC SPACE.

1 RELOCATE EXISTING SMOKE DETECTOR TO ALLOW INSTALLATION OF CEILING FAN. PROVIDE CONCEALED CONDUIT AND FIRE ALARM WIRING TO MATCH EXISTING IN ATTIC.


2 PROVIDE SMOKE DETECTOR. PROVIDE CONCEALED CONDUIT AND FIRE ALARM WIRING TO MATCH EXISTING IN ATTIC. SMOKE DETECTORS SHALL MATCH EXISTING SMOKE DETECTORS.

3 EXISTING FIRE-LITE MS-9050UD FIRE ALARM CONTROL PANEL. PROVIDE ALL REQUIRED MODIFICATIONS, MODULES, AND PROGRAMMING FOR ADDITIONAL SMOKE DETECTORS. cONTRACTOR SHALL SUBMIT, PAY AND OBTAIN FIRE ALARM PERMIT.

1 ADDENDUM 1 12/20/2023

REVISION

| Wood | Harbinger

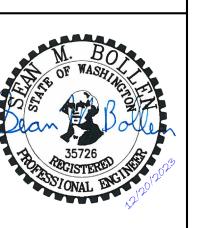

12/06/2023 AS-NOTED

> 23018 E3.2

SHEET - OF 5


BID DRAWING SET

ELECTRICAL FIRST FLOOR PLAN SCALE: 1/4" = 1'-0"

GENERAL NOTES

1. ALL ELECTRICAL ITEMS ON THIS SHEET ARE EXISTING AND SHOWN FOR REFERENCE ONLY.

1 ADDENDUM 1 12/20/2023

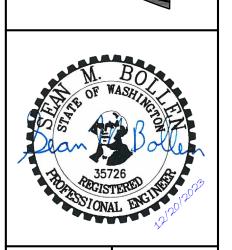

12/06/2023

23018 E5.1 SHEET - OF 5

1-1/2" - 3#2, #8 EGC / 1-1/2" - 2#2, #8 EGC 1-1/2" - 3#2, #8 EGC 15HP 1Ø - 3Ø PHASE 90AF/ 100A CONVERTER 1 - 1/2 - 3#1/0 & #6G—— PANEL P1 2 - 1/2 - 3#4/0 & #4G 15,610 SERVICE DISCONNECT 225A 120/240V 1PHASE, 3W GRADE GRADE **EQUPMENT XX** 2 - 1/2" - 3#4/0 EXISTING PSE SERVICE HANDHOLE 2 - 1/2" UNDERGROUND
POWER SERVICE RACEWAY

PANEL

| | PANEL NAME: P1 | EXIST) | | | | | | PANEL | SCHE | DULE | | | MFGR: EATON | |
|-------|---------------------|------------------|---------|----------|----------|-----------|-----------|-----------|------------|-------------|---------|---------|--|----|
| | LOCATION: 13 | , , | | | | 240/120 | VOLT | SECT | ΓΙΟN: | 1 | OF | 1 | CAT# PRL1A | |
| | FED FROM: UTIL | _ITY | | | 1 PHAS | E, 3 WIRE | SURF | ACE MOUNT | PNL | | | | | |
| | 22 kAIC SYM | | | 225 AMP | MAIN CB | 225 | AMP E | BUS | | | CU BUS | ; | 100% NEUTRAL | |
| CKT. | | | | | | СВ | | | Р | | CE | 3 | | Ck |
| NO. | | CIRCUIT | DESCRIF | PTION | | AMPS | POL | kVA | Н | kVA | AMPS | POL | CIRCUIT DESCRIPTION | No |
| 1 | LTG: RM 01, 03, 08, | 09, 11, 12 | | | | 20/ | 1 | 0.60 | а | 0.10 | 20. | / 1 | EF-01, EF-02, EF-03, EF-04, EF-05, EF-06 | 2 |
| 3 | LTG: RM 02, 04, 06, | 07, 010, 012, 0 |)14 | | | 20/ | 1 | 0.70 | b | 0.10 | 20. | / 1 | BOILER B-1 | 4 |
| 5 | LTG: EXIT SIGNS | | | | | 20/ | 1 | 0.10 | а | 0.00 | 20. | / 1 | DOMESTIC HOT WATER PUMP | 6 |
| 7 | REC: RM 004 - PRO | JECTOR | | | | 20/ | 1 | 0.20 | b | 0.10 | 20. | / 1 | FIRE DAMPERS | 8 |
| 9 | REC: RM 014 - PRO | JECTOR | | | | 20/ | 1 | 0.20 | а | 0.20 | 20 | / 1 | REC: RM 001 - COPIER | 10 |
| 11 | FCU-1 THRU FCU-3 | , BC - 01 | | | (NOTE 1) | 20/ | 2 | 0.30 | b | 0.80 | 20 | / 1 | REC: RM 004, 014 - COMPUTER | 12 |
| 13 | - | | | | | - | | 0.30 | а | 1.00 | 20 | / 1 | REC: RM 011 - COMPUTER | 14 |
| 15 | REC - EXTERIOR | | | | (NOTE 2) | 20/ | 1 | 0.18 | b | 0.80 | 20 | / 1 | REC: RM 001, 011, 012 - COMPUTER | 16 |
| 17 | SPARE | | | | , | 20/ | 2 | 0.00 | а | 1.00 | 20. | / 1 | REC: RM 001 - COMPUTER | 18 |
| 12 | SPARE | ~~~ | ~~ | ~~~ | ~~~ | ~~ | ~~ | ~~~ | b | 0.72 | 20 | / 1 | REC: RM 011, 012 | 20 |
| 21 | CP-01 | | | | (NOTE 2) | 20/ | 1 | 0.10 | Q a | 0.90 | 20 | / 1 | REC: RM 001, 010, 012 | 22 |
| 23 | SPARE | ~~ | | | | | | |) b | 0.90 | 20 | / 1 | REC: RM 002, 003, 005 | 24 |
| 25 | SPARE | | | | | 20/ | 1 | 0.00 | а | 0.90 | 20. | / 1 | REC: RM 06, 07, 08, 09, 013 | 26 |
| 27 | SPARE | | | | | 20/ | 1 | 0.00 | b | 0.90 | 20. | / 1 | REC: RM 004 | 28 |
| 29 | SPARE | | | | | 20/ | 1 | 0.00 | а | 0.90 | 20 | / 1 | REC: RM 005, 014 | 30 |
| 31 | SPARE | | | | | 20/ | 1 | 0.00 | b | 0.90 | 20 | / 1 | REC: RM 001, 014 | 32 |
| 33 | SPARE | | | | | 20/ | 1 | 0.00 | а | 0.90 | 20 | / 1 | REC: RM 001 | 34 |
| 35 | SPARE | | | | | 20/ | 1 | 0.00 | b | 0.04 | 20 | / 1 | BOILER CONTROL PANEL AND PUMPS | 36 |
| 37 | SPARE | | | | | 20/ | 1 | 0.00 | а | 0.00 | 20 | / 1 | SPARE | 38 |
| 39 | HP-01 | | | | (NOTE 1) | 90/ | 2 | 5.40 | b | 0.00 | 20 | / 1 | SPARE | 40 |
| 41 | - | | | | | - | | 5.40 | а | 0.00 | 20. | / 1 | SPARE | 42 |
| LOAE | SUM | CONN LO | DAD | FACTOR | CALC LOA | D | | | NOTE | :S | | | | , |
| LIGH | TING | | kVA | 125% | | _ kVA | | | 1. | REMOVE EXI | STING S | PARE (| CIRCUIT BREAKERS AND PROVIDE NEW | |
| RECE | EPTACLES | 20.16 | kVA | 50%>10kV | A 15.08 | kVA | | | | CIRCUIT BRE | AKER | | | |
| ALL N | MOTORS | 0.00 | kVA | 100% | 0.00 | kVA | | | 2. | NEW LOAD C | N EXIST | ING CIF | RCUIT BREAKER. | |
| LRGS | ST MOTOR | 0.67 | kVA | 125% | 0.83 | kVA | | | | | | | | |
| KITCI | HEN | 0.00 | kVA | 100% | 0.00 | kVA | | | | | | | | |
| MISC | ELLANEOUS | 31.84 | kVA | 100% | 31.84 | kVA | | | | | | | | |
| NON- | COINCIDENT | 0.00 | kVA | 0% | 0.00 | kVA | | | | | | | | |
| | TOTAL | 57.63 | kVA | | 53.95 | kVA | • | | | | | | | |
| l | | 240.1 | AMPS | | 22/18 | Amps | | | | | | | | |


| | PANEL NAME: P2 (E) | (IST) | | | | PANEL | . SCHE | EDULE | | MFGR: EATON | |
|------------|------------------------|------------------|-----------|----------|---------------|--------------|------------|-------------|--------------|----------------------------------|-----|
| | LOCATION: 13 | , | | | 240/120 VOL | T SEC1 | ION: | 1 | OF 1 | CAT# PRL1A | |
| | FED FROM: UTILIT | Υ | | 1 PHAS | E, 3 WIRE SUR | FACE MOUNT | PNL | | | | |
| | 22 kAIC SYM | | 225 AMP | MAIN CB | 225 AMP | BUS | | | CU BUS | 100% NEUTRAL | |
| CK | Γ, | | | | СВ | | Р | | СВ | | Ckt |
| NO |), | CIRCUIT DES | CRIPTION | | AMPS POL | kVA | Н | kVA | AMPS PO | CIRCUIT DESCRIPTION | No. |
| 1 | LTG: BUILDING EXTER | RIOR | | | 20/ 1 | 0.40 | a | 0.00 | 20/ 1 | EF-07 - EF-13 | 2 |
| 3 | LTG: SITE EXTERIOR | | | | 20/ 1 | 0.40 | b | 0.50 | 20/ 1 | REC: RM KITCHNEN - INSTANT HOT | 4 |
| 5 | LTG: RM 102, 103, 104 | , 105, 106 | | | 20/ 1 | 0.40 | а | 1.17 | 20/ 1 | REC: RM KITCHEN - DISPOSER | 6 |
| 7 | LTG: RM 101, 102, 115 | | | | 20/ 1 | 0.30 | b | 0.70 | 20/ 1 | REC: RM KITCHEN - REFRIGERATOR | 8 |
| 9 | LTG: EXIT SIGNS | | | | 20/ 1 | 0.10 | а | 0.18 | 20/ 1 | REC: RM KITCHEN - GFI | 10 |
| 11 | LTG: 107 - 113 | | | | 20/ 1 | 0.00 | b | 0.18 | 20/ 1 | REC: RM KITCHEN - GFI | 12 |
| 13 | REC: RM 104 - FACP | | | | 20/ 1 | 0.30 | а | 0.40 | 20/ 1 | REC: RM 104 - DATA / COMM. | 14 |
| 15 | REC: RM 001, 101 | | | | 20/ 1 | 0.36 | b | 0.40 | 20/ 1 | REC: RM 104 - DATA / COMM. | 16 |
| 17 | REC: RM ATTIC - A/C | | | | 20/ 1 | 0.00 | а | 0.20 | 20/ 1 | REC: RM 104 - SECURITY PANEL | 18 |
| 19 | - | | | | 20/ 1 | 0.00 | b | 0.20 | 20/ 1 | REC: RM 115 - COPIER | 20 |
| 21 | REC: RM ATTIC - L++ | | | | 20/ 1 | 0.18 | а | 0.80 | 20/ 1 | REC: RM 110, 113 - COMPUTER | 22 |
| 23 | FCU-04 THRU FCU-08, | BC-02 | | (NOTE 1) | 20/ 2 | 0.35 | b | 0.80 | 20/ 1 | REC: RM 102, 113, 114 - COMPUTER | 24 |
| 25 | - | | | | - | 0.35 | а | 1.00 | 20/ 1 | REC: RM 102 - COMPUTER | 26 |
| 27 | CF-01, CF-02 | | | (NOTE 1) | 15/ 2 | 0.10 | b | 0.80 | 20/ 1 | REC: RM 102 - COMPUTER | 28 |
| ~20 | ~~~~ | ~~~ | ~~~ | ~~~ | ~~~ | ~~8 ₽ | а | 0.90 | 20/ 1 | REC: RM 103, 104, 105, 106, 107 | 30 |
| 31 | CP-02, CP-03, CP-04, C | CP-05 | | (NOTE 2) | 20/ 1 | 0.40 | { b | 0.90 | 20/ 1 | REC: RM 110, 112 | 32 |
| 133 | SPARE | | | | | | Ja | 1.08 | 20/ 1 | REC: RM 019, 112, 113 | 34 |
| 35 | SPARE | | | | 20/ 1 | 0.00 | b | 0.90 | 20/ 1 | REC: RM 102, 114 | 36 |
| 37 | SPARE | | | | 20/ 1 | 0.00 | а | 0.36 | 20/ 1 | REC: RM 115 | 38 |
| 39 | SPARE | | | | 20/ 1 | 0.00 | b | 0.90 | 20/ 1 | REC: RM 102 | 40 |
| 41 | SPARE | | | | 20/ 1 | 0.00 | a | 0.72 | 20/ 1 | REC: RM 102 | 42 |
| LOA | AD SUM | CONN LOAD | FACTOR | CALC LOA | ,D | | NOTE | ES | | | |
| LIG | HTING | 1.78 kVA | 125% | 2.23 | kVA | | 1. | REMOVE EXI | STING SPARE | CIRCUIT BREAKERS AND PROVIDE NEW | |
| REC | CEPTACLES | 6.48 kVA | 50%>10kVA | 6.48 | kVA | | ~ | CIRCUIT BRE | AKER | ~~~ \1\ | |
| ALL | . MOTORS | 0.00 kVA | 100% | 0.00 | kVA | (| 2. | NEW LOAD C | N EXISTING C | IRCUIT BREAKER. | |
| LRO | SST MOTOR | 0.00 kVA | 125% | 0.00 | kVA | | _ | ~~~ | ••• | | |
| KIT | CHEN | 0.00 kVA | 100% | 0.00 | kVA | | | | | | |
| MIS | CELLANEOUS | 7.90 kVA | 100% | 7.90 | kVA | | | | | | |
| NOI | N-COINCIDENT | 0.00 kVA | 0% | 0.00 | kVA | | | | | | |
| | TOTAL | 16.16 kVA | <u> </u> | 16.61 | kVA | | | | | | |
| | | 67.3 AMP | PS | 69.2 | Amps | | | | | | |

| | | | | | MOTOR A | AND EQUIPMENT WIRING SCHE | DULE | | | | |
|--|--|----------|-------------------|----------|-------------|--|------------|------|---------|--------|---|
| | | | | | | | DISCONNECT | | STARTER | | |
| PLAN | DESCRIPTION | KW/HP | VOLTS | PH | PANEL | WIRE & | SIZE | FUSE | NEMA | COMB'N | REMARKS |
| MARK | | | | | ~~~~ | CONDUIT | AMPS | AMPS | ~SIZE~ | YES NO | ······································ |
| CP-01 | CONDENSATE PUMP | 0.1 KVA | 120 | 1 | P2 | 2#12, 1#12 EGC | 20 | | | | RACEWAY SHALL BE WHITE SURFACE METAL RACEWAY |
| CP-02 | CONDENSATE PUMP | 0.1 KVA | 120 | 1 | P2 | 2#12, 1#12 EGC | 20 | | | | RACEWAY SHALL BE WHITE SURFACE METAL RACEWAY |
| CP-03 | CONDENSATE PUMP | 0.1 KVA | 120 | 1 | P2 | 2#12, 1#12 EGC | 20 | | | | RACEWAY SHALL BE WHITE SURFACE METAL RACEWAY |
| CP-04 | CONDENSATE PUMP | 0.1 KVA | 120 | 1 | P2 | 2#12, 1#12 EGC | 20 | | | | RACEWAY SHALL BE WHITE SURFACE METAL RACEWAY |
| CP-05 | CONDENSATE PUMP | 0.1 KVA | 120 | 1 | P2 | 2#12, 1#12 EGC | 20 | | | | RACEWAY SHALL BE WHITE SURFACE METAL RACEWAY |
| WEENSTAND OF THE SECOND OF THE | CENTING LANGE TO THE CASE OF T | <u> </u> | ~249 ~ | ~ | MP2M | ~~~~~~~~~~~~~~~~~~~~~~~~~~~~~~~~~~~~~~ | ····· | ~~~ | ~~~ | | RACEUMAY SHALL BE WHITE OURFACE METAL RACEWAY |
| CF-02 | CEILING FAN | 0.1 KVA | 240 | 1 | P2 | 2#12, 1#12 EGC | | | | | RACEWAY SHALL BE WHITE SURFACE METAL RACEWAY |
| FCU-01 | AIR CONDITIONING UNIT | 0.2 KVA | 240 | 1 | P1 | 2#12, 1#12 EGC | 30 | 15 | | | RACEWAY SHALL BE WHITE SURFACE METAL RACEWAY |
| FCU-02 | AIR CONDITIONING UNIT | 0.2 KVA | 240 | 1 | P1 | 2#12, 1#12 EGC | 30 | 15 | | | RACEWAY SHALL BE WHITE SURFACE METAL RACEWAY |
| FCU-03 | AIR CONDITIONING UNIT | 0.1 KVA | 240 | 1 | P1 | 2#12, 1#12 EGC | 30 | 15 | | | RACEWAY SHALL BE WHITE SURFACE METAL RACEWAY |
| FCU-04 | AIR CONDITIONING UNIT | 0.1 KVA | 240 | 1 | P2 | 2#12, 1#12 EGC | 30 | 15 | | | RACEWAY SHALL BE WHITE SURFACE METAL RACEWAY |
| FCU-05 | AIR CONDITIONING UNIT | 0.1 KVA | 240 | 1 | P2 | 2#12, 1#12 EGC | 30 | 15 | | | RACEWAY SHALL BE WHITE SURFACE METAL RACEWAY |
| FCU-06 | AIR CONDITIONING UNIT | 0.1 KVA | 240 | 1 | P2 | 2#12, 1#12 EGC | 30 | 15 | | | RACEWAY SHALL BE WHITE SURFACE METAL RACEWAY |
| FCU-07 | AIR CONDITIONING UNIT | 0.2 KVA | 240 | 1 | P2 | 2#12, 1#12 EGC | 30 | 15 | | | RACEWAY SHALL BE WHITE SURFACE METAL RACEWAY |
| FCU-08 | AIR CONDITIONING UNIT | 0.1 KVA | 240 | 1 | P2 | 2#12, 1#12 EGC | 30 | 15 | | | RACEWAY SHALL BE WHITE SURFACE METAL RACEWAY |
| BC-01 | BRANCH CIRCUIT CONTROLLER | 0.1 KVA | 240 | 1 | P1 | 2#12, 1#12 EGC | 30 | 15 | | | RACEWAY SHALL BE WHITE SURFACE METAL RACEWAY |
| BC-02 | BRANCH CIRCUIT CONTROLLER | 0.1 KVA | 240 | 1 | P2 | 2#12, 1#12 EGC | 30 | 15 | | | RACEWAY SHALL BE WHITE SURFACE METAL RACEWAY |
| HP-01 | AIR COOLED CONDENSING UNITS | 10.8 KVA | 208 | 3 | P1 | | 100 | 35 | | | NEMA 3R FUSED DISCONNECT SWITCH. SEE SHEET E5.1 |
| | | | | | | | | | | | |

ADDENDUM 1 12/20/2023

929 108th Ave NE
Suite 1000
Bellevue WA 98004
425.628.6000
woodharbinger.com

Jabupan Mender Harbinger

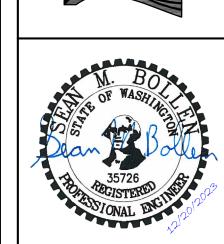

John Follows 35726 DOUGHT TOWN TOWN TOWN TOWN TOWN TOWN TOWN THE THE PARTY OF THE P

CITY HALL ANNEX BUILDING VRF HVAC INSTALLATION
CITY OF KIRKLAND
310 First Street, Kirkland, WA 98033
ELECTRICAL
SCHEDULES

HEET TITLE

DATE 12/06/2023

SCALE NONE
ENGR SMB

DRWN CL
CHKD _
APPR

JOB 23018

E7.1SHEET - OF 5