APPENDIX A

INTERSECTION SUMMARY, PROJECT PLANS

City of Kirkland

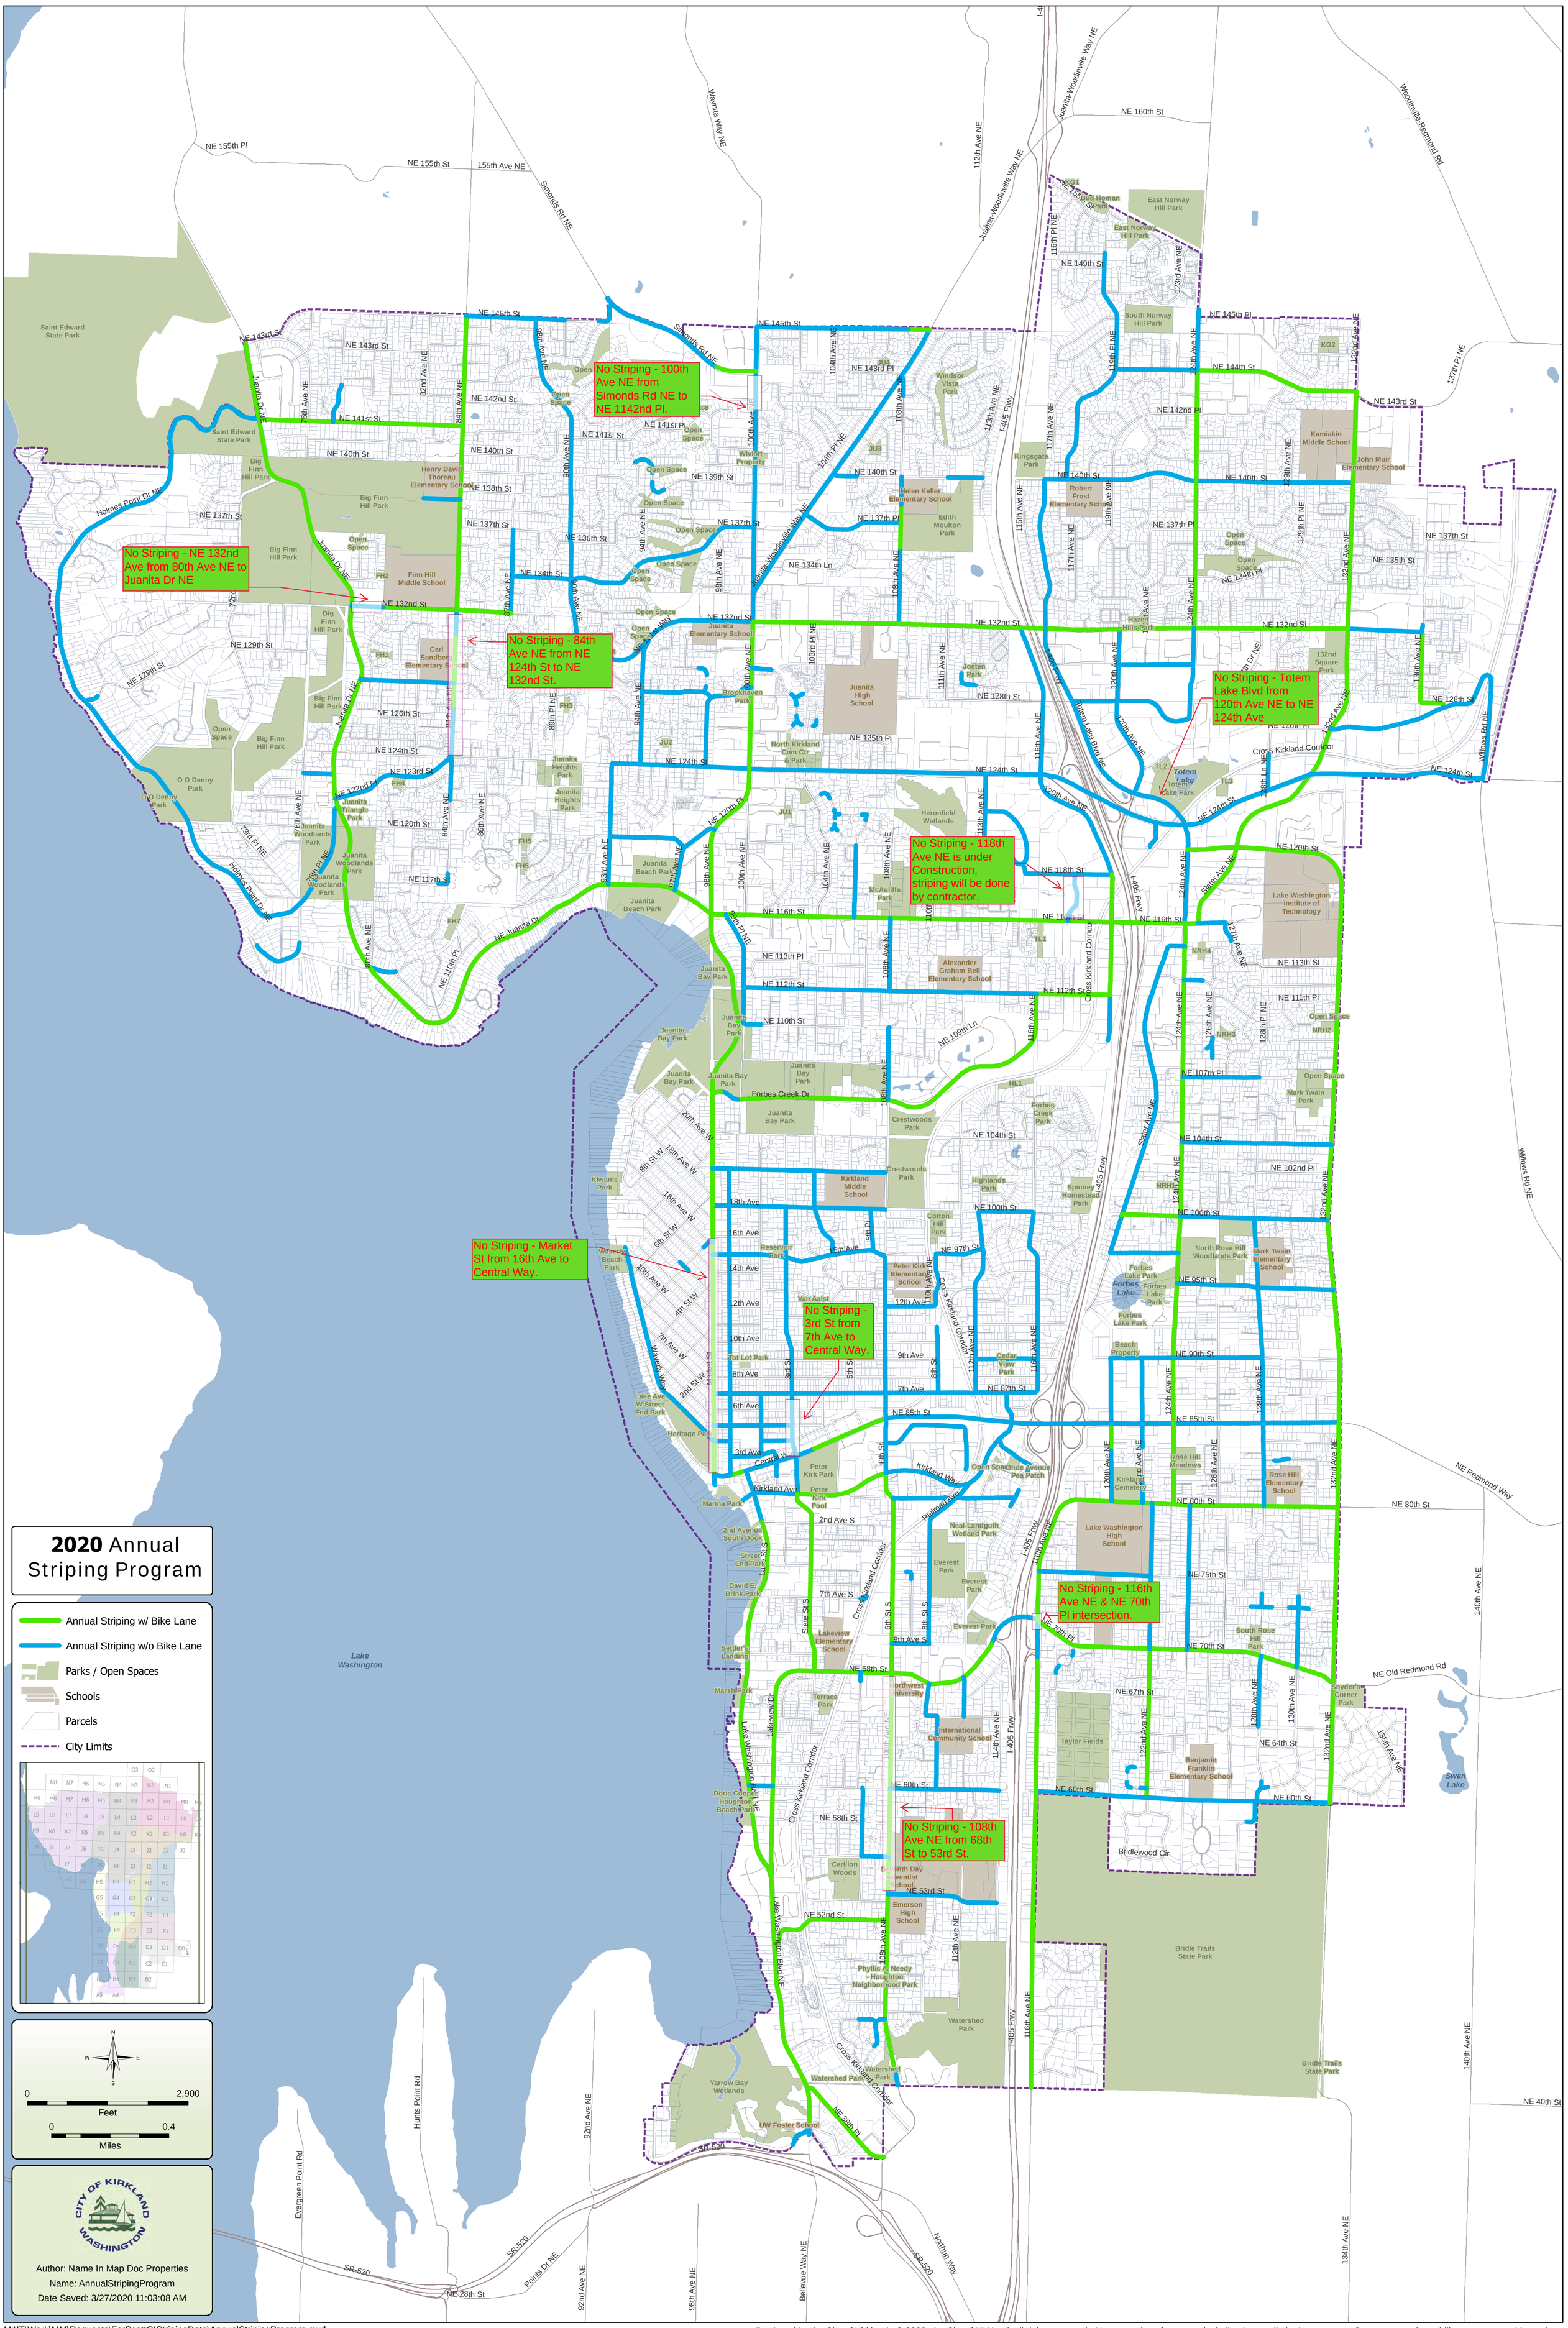

M:\IT\Work\MM\Requests\ForScottG\StripingData\AnnualStripingProgram.mxd

Produced by the City of Kirkland. © 2020, the City of Kirkland, all rights reserved. No warranties of any sort, including but not limited to accuracy, fitness or merchantability, accompany this product.

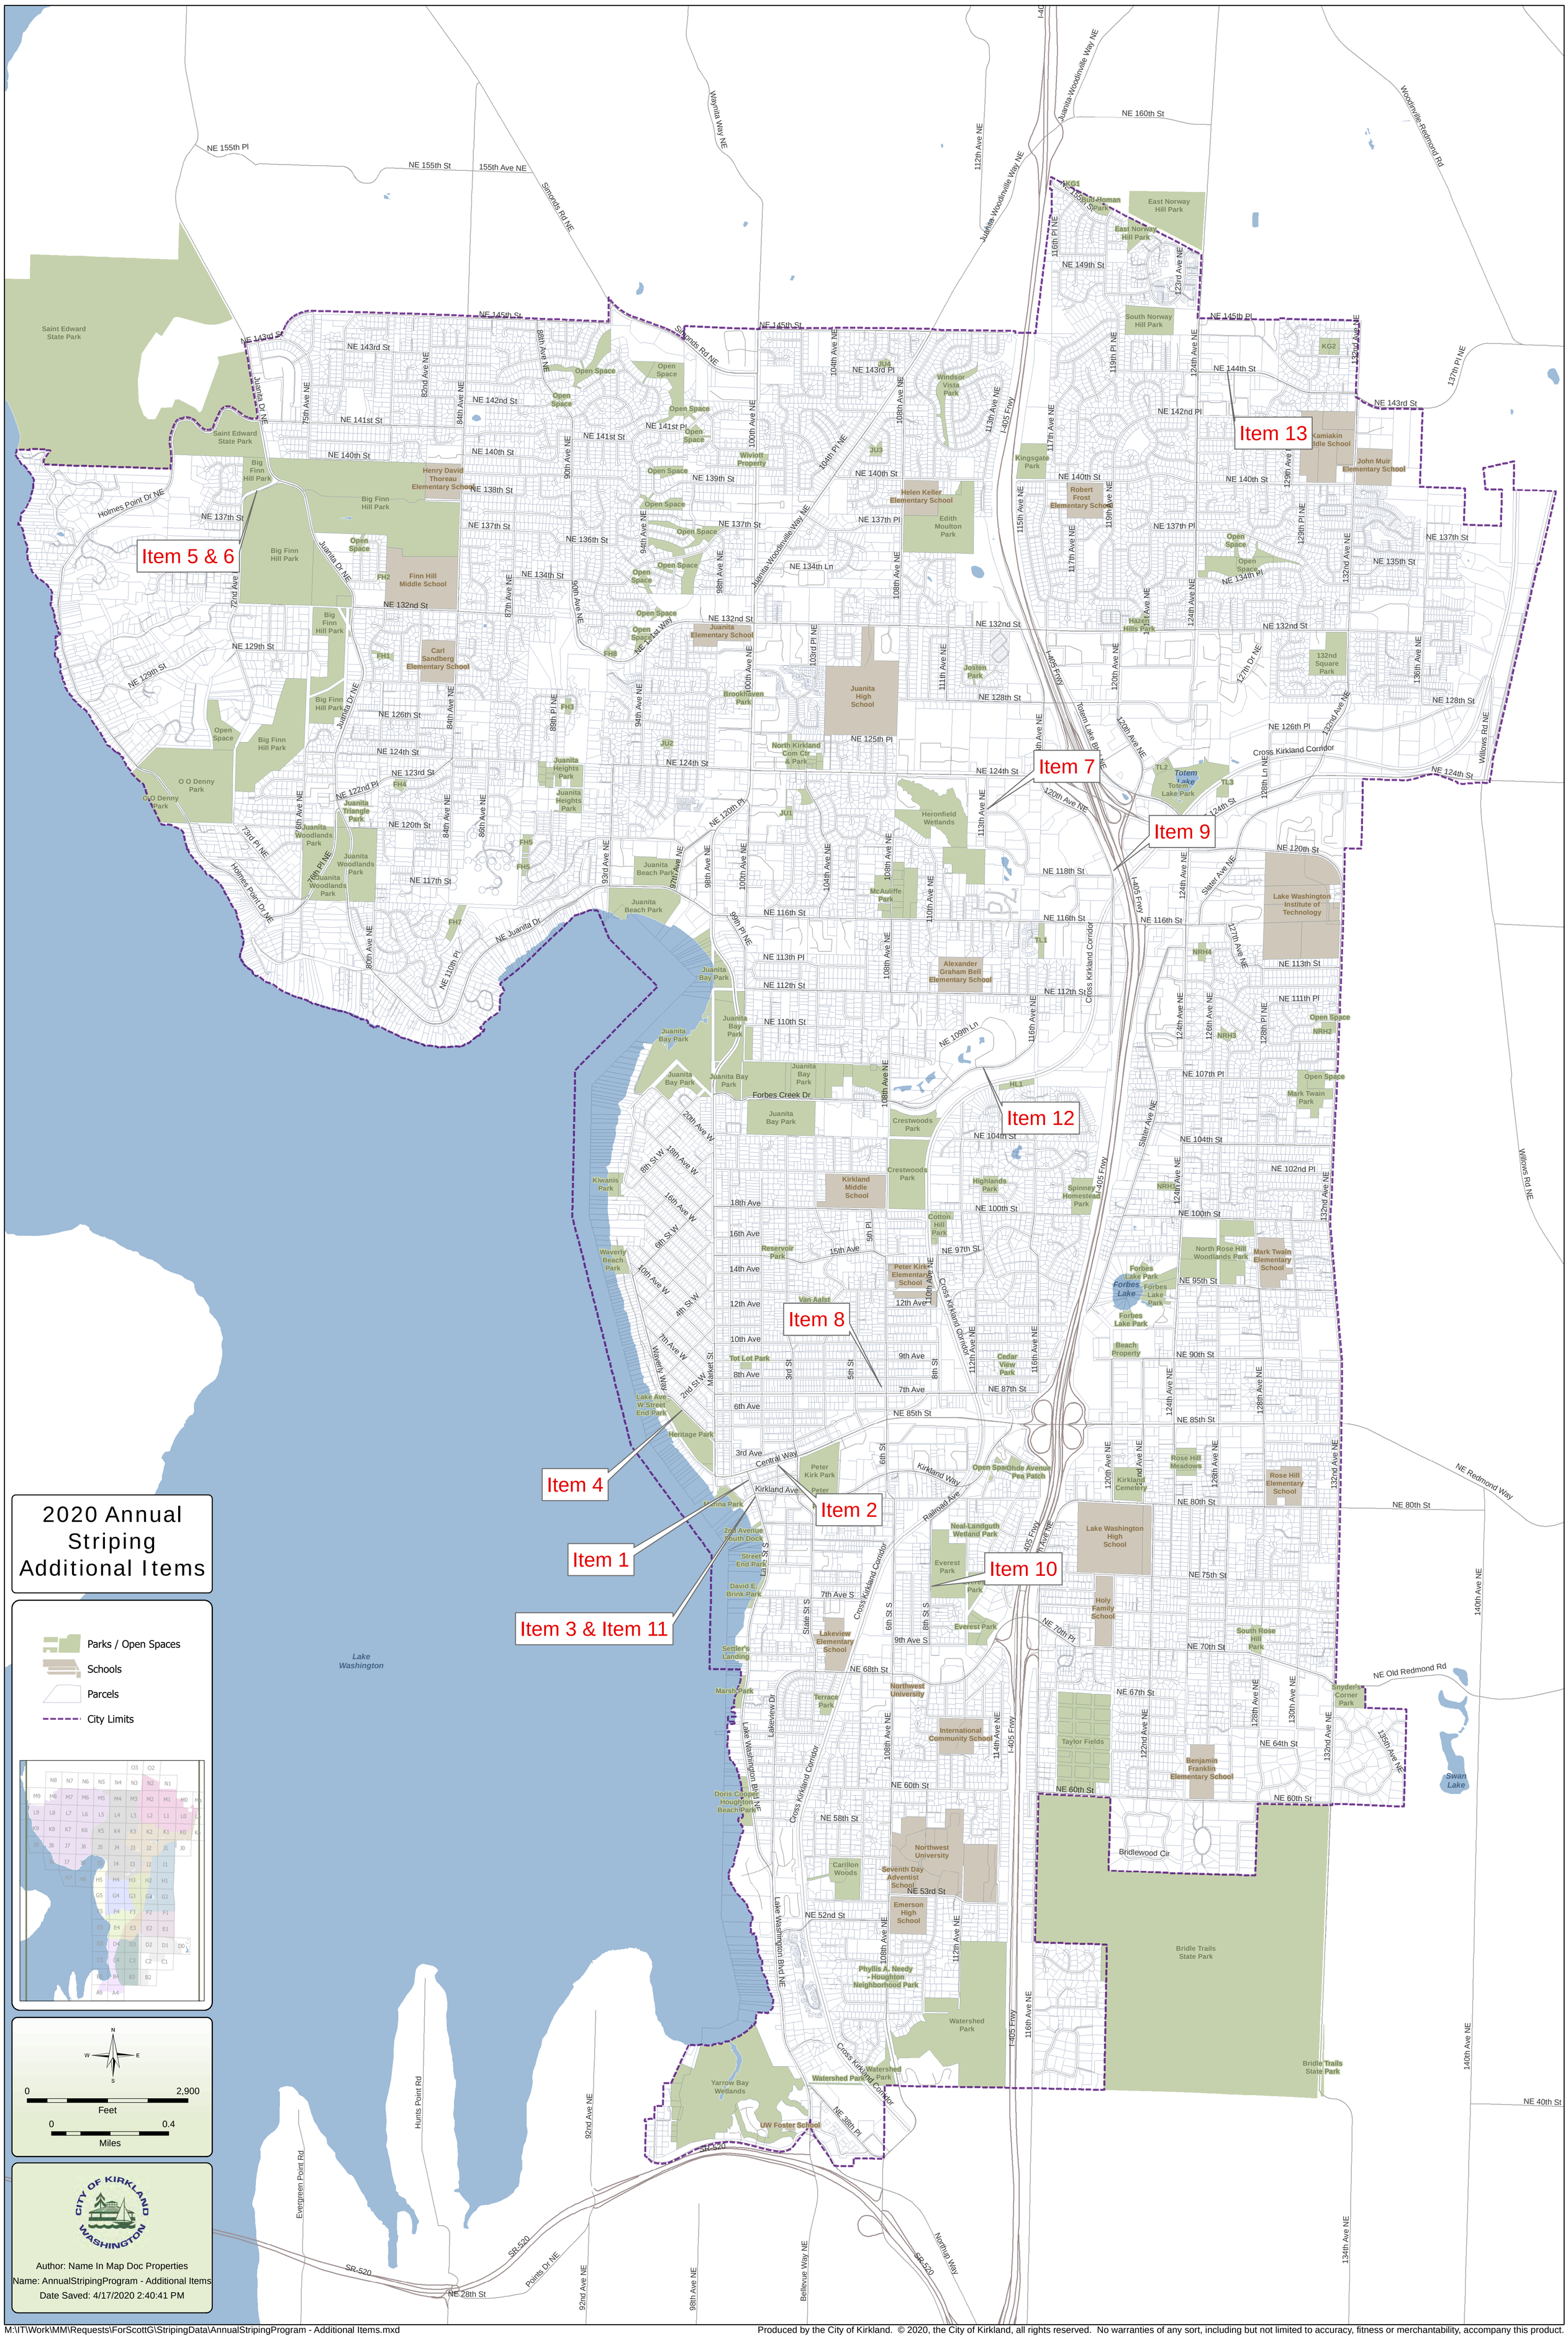

M:\IT\Work\MM\Requests\ForScottG\StripingData\AnnualStripingProgram - Additional Items.mxd

Produced by the City of Kirkland. © 2020, the City of Kirkland, all rights reserved. No warranties of any sort, including but not limited to accuracy, fitness or merchantability, accompany this product.

APPENDIX B

SCHEDULE B – PLAN SHEETS

NORTH ROSE HILL INTERSECTION PLANS

CITY OF KIRKLAND
DEPARTMENT OF PUBLIC WORKS
123 FIFTH AVENUE KIRKLAND, WA 98033
(425) 587-3800 www.kirklandwa.gov

S GONSAR	1/2019	DESIGNED BY: DATE
J.JENNINGS	1/2019	DRAWN BY: DATE
		CHECKED BY: DATE

2020 PAVEMENT MARKING PROGRAM

STREET:

CROSS STREET:

SEGMENT:

SCALE: N.T.S.

FILENAME: 9-0

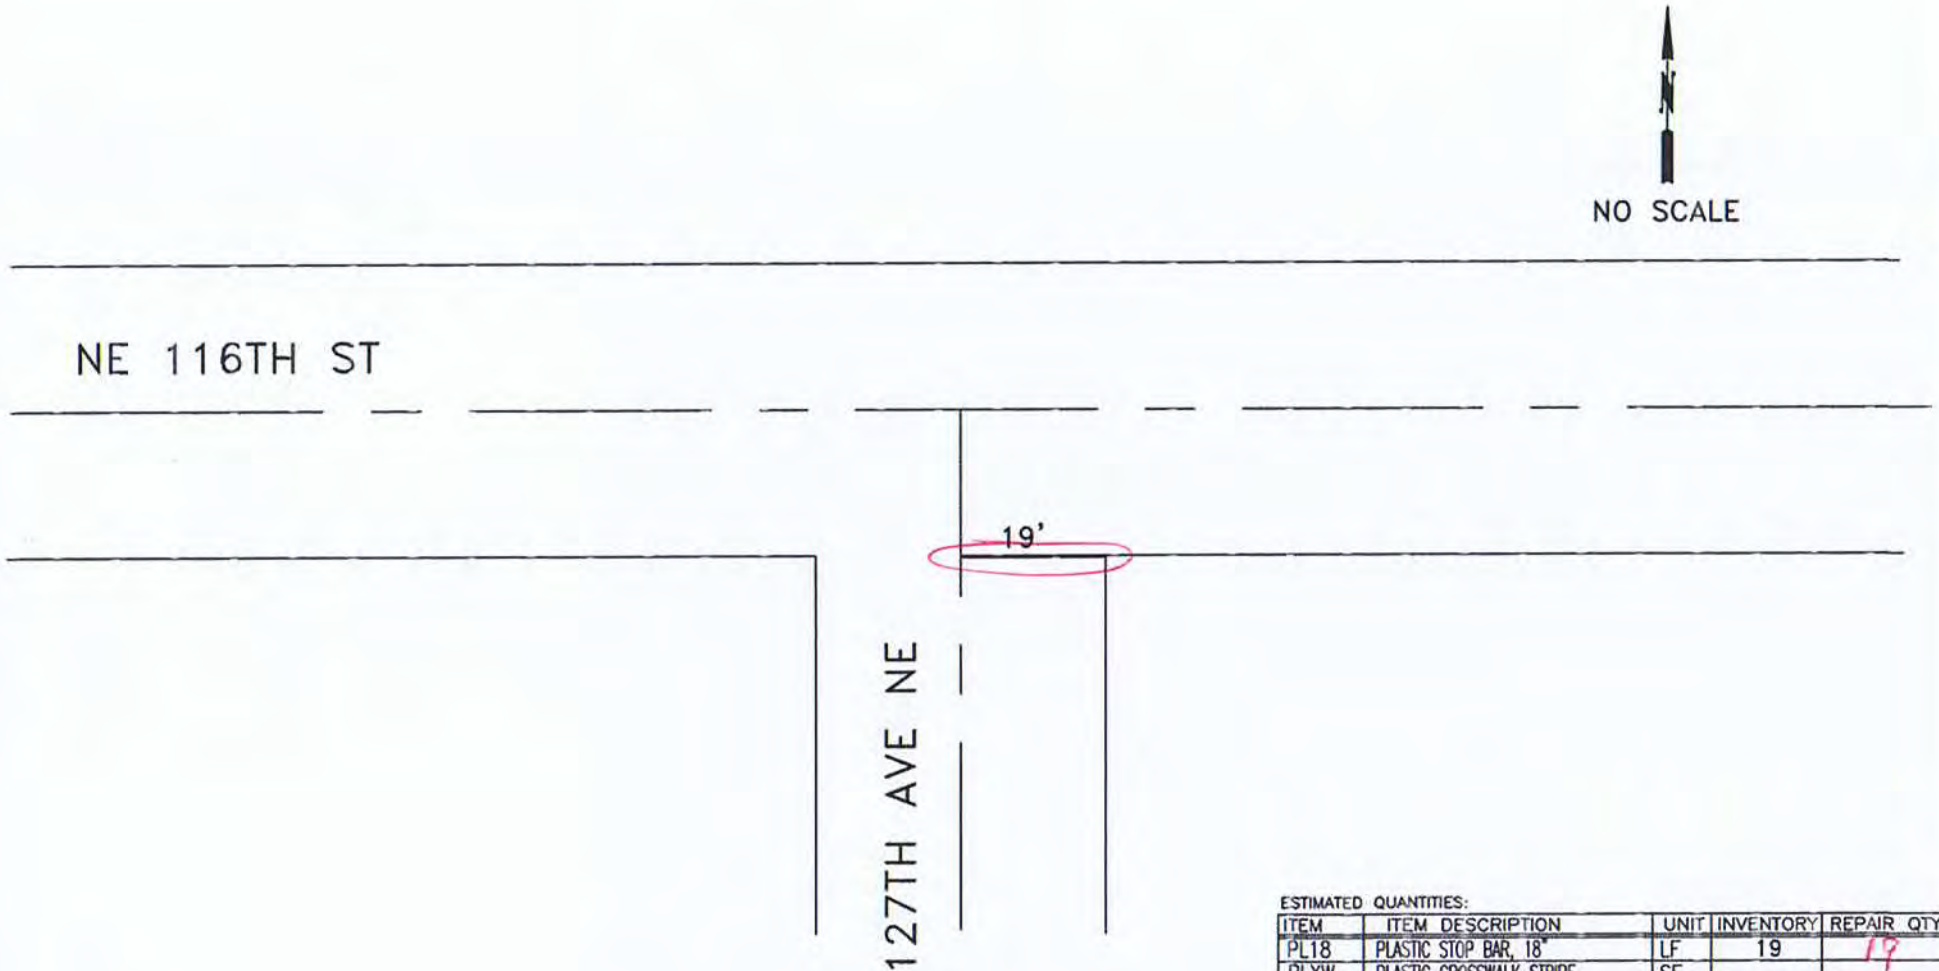

ESTIMATED QUANTITIES:

ITEM	ITEM DESCRIPTION	UNIT	INVENTORY	REPAIR QTY
PL18	PLASTIC STOP BAR, 18"	LF	19	19
PLXW	PLASTIC CROSSWALK STRIPE	SF		
PLARW	PLASTIC TRAFFIC ARROW	EA		
PLLTR	PLASTIC TRAFFIC LETTER, 8 FT HIGH	EA		
PLRR	PLASTIC RAILROAD SYMBOL	EA		
RPLSYM	REMOVE PL. ARROW, LETTER, SYMBOL	EA		
RRPM	REMOVE RPM	EA		
RPLXW	REMOVE PLASTIC STRIPE	SF		

CITY OF KIRKLAND
DEPARTMENT OF PUBLIC WORKS
123 FIFTH AVENUE KIRKLAND, WA 98033
(425) 587-3800 www.kirklandwa.gov

D.GRILLEY 1/2000
DESIGNED BY: DATE

J.JENNINGS 1/2000
DRAWN BY: DATE

CHECKED BY: DATE

2022 PAVEMENT MARKING PROGRAM

STREET: NE 116TH ST

CROSS STREET: 127TH AVE NE

SEGMENT:

SCALE: N.T.S.

FILENAME: Page 9-1

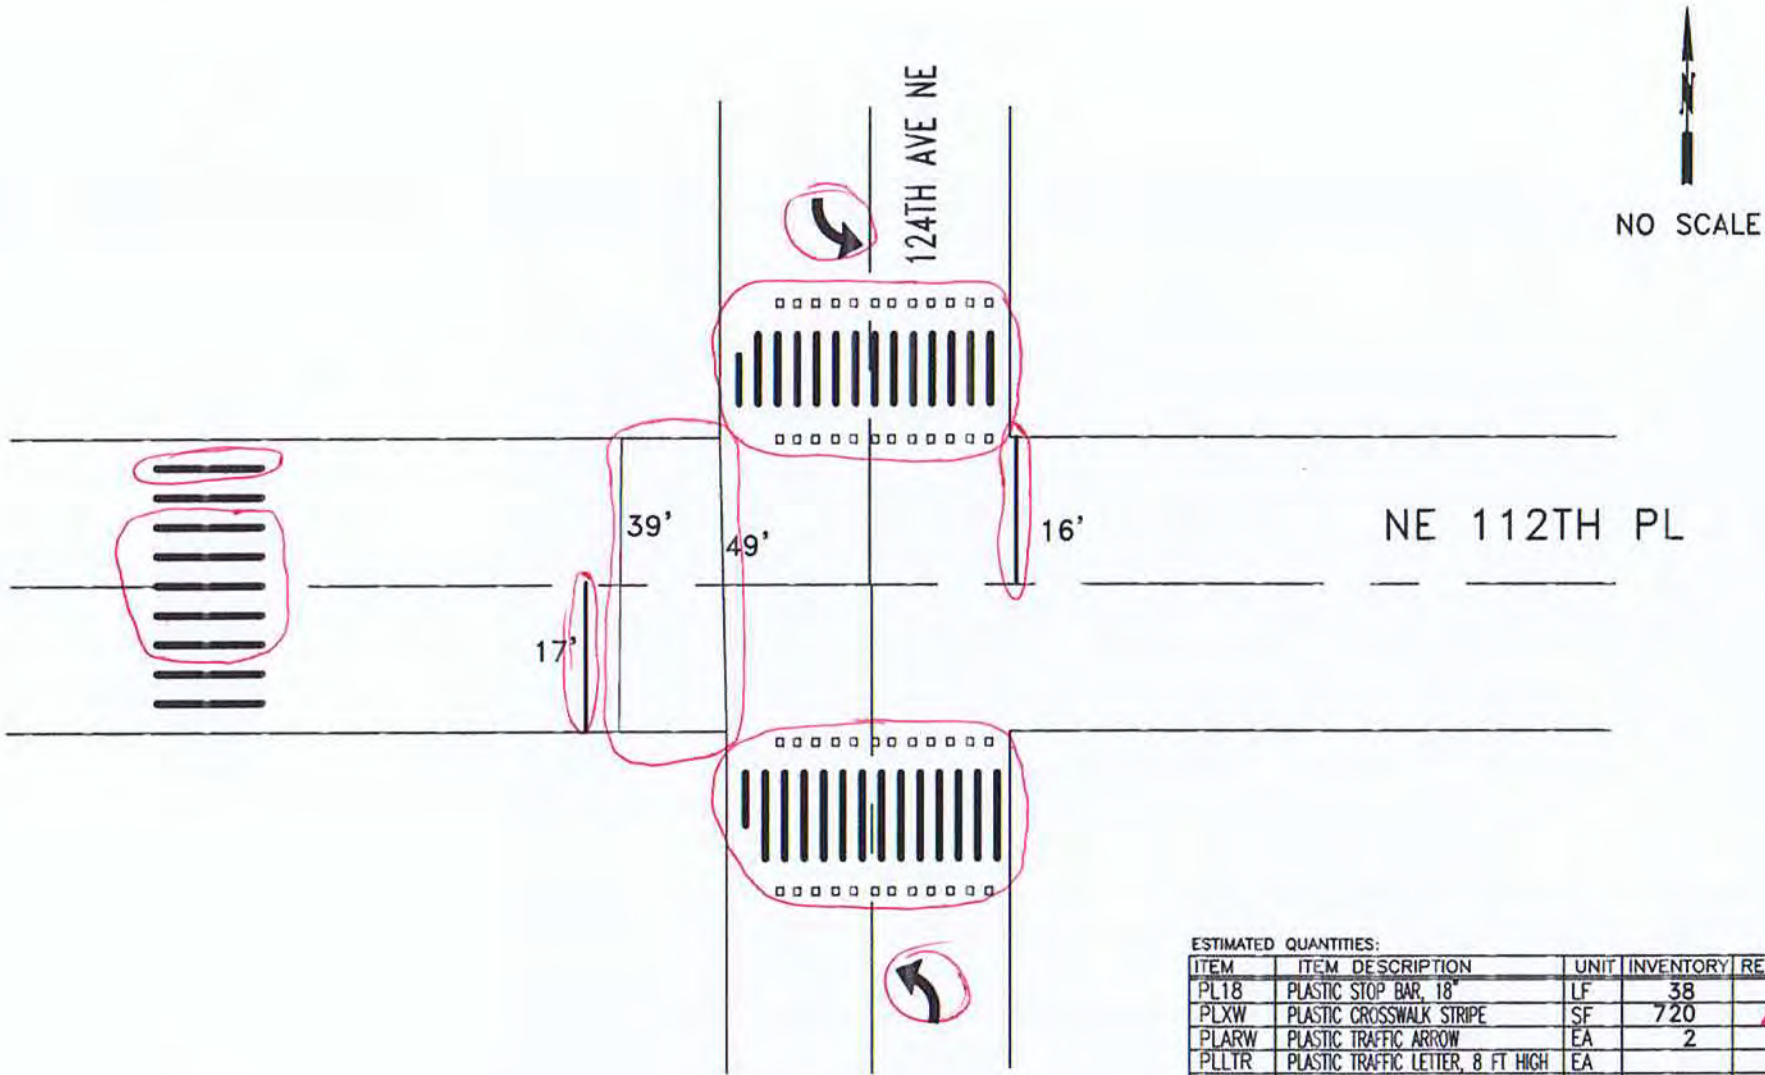

ESTIMATED QUANTITIES:

ITEM	ITEM DESCRIPTION	UNIT	INVENTORY	REPAIR QTY
PL18	PLASTIC STOP BAR, 18"	LF	38	33
PLXW	PLASTIC CROSSWALK STRIPE	SF	720	665
PLARW	PLASTIC TRAFFIC ARROW	EA	2	
PLLTR	PLASTIC TRAFFIC LETTER, 8 FT HIGH	EA		
PLRR	PLASTIC RAILROAD SYMBOL	EA		
RPLSYM	REMOVE PL. ARROW, LETTER, SYMBOL	EA		
RRPM	REMOVE RPM	EA		12
RPLXW	REMOVE PLASTIC STRIPE	SF		320
	RAISED PAVEMENT MARKER TYPE 2	EA	48	48

CITY OF KIRKLAND
DEPARTMENT OF PUBLIC WORKS
123 FIFTH AVENUE KIRKLAND, WA 98033
(425) 587-3800 www.kirklandwa.gov

G. HORTILLLOSA 2/2010
DESIGNED BY: DATE

J.JENNINGS 2/2010
DRAWN BY: DATE

CHECKED BY: DATE


STREET: NE 112TH PL

CROSS STREET: 124TH AVE NE

SEGMENT:

SCALE: N.T.S.

FILENAME: Page 9-2

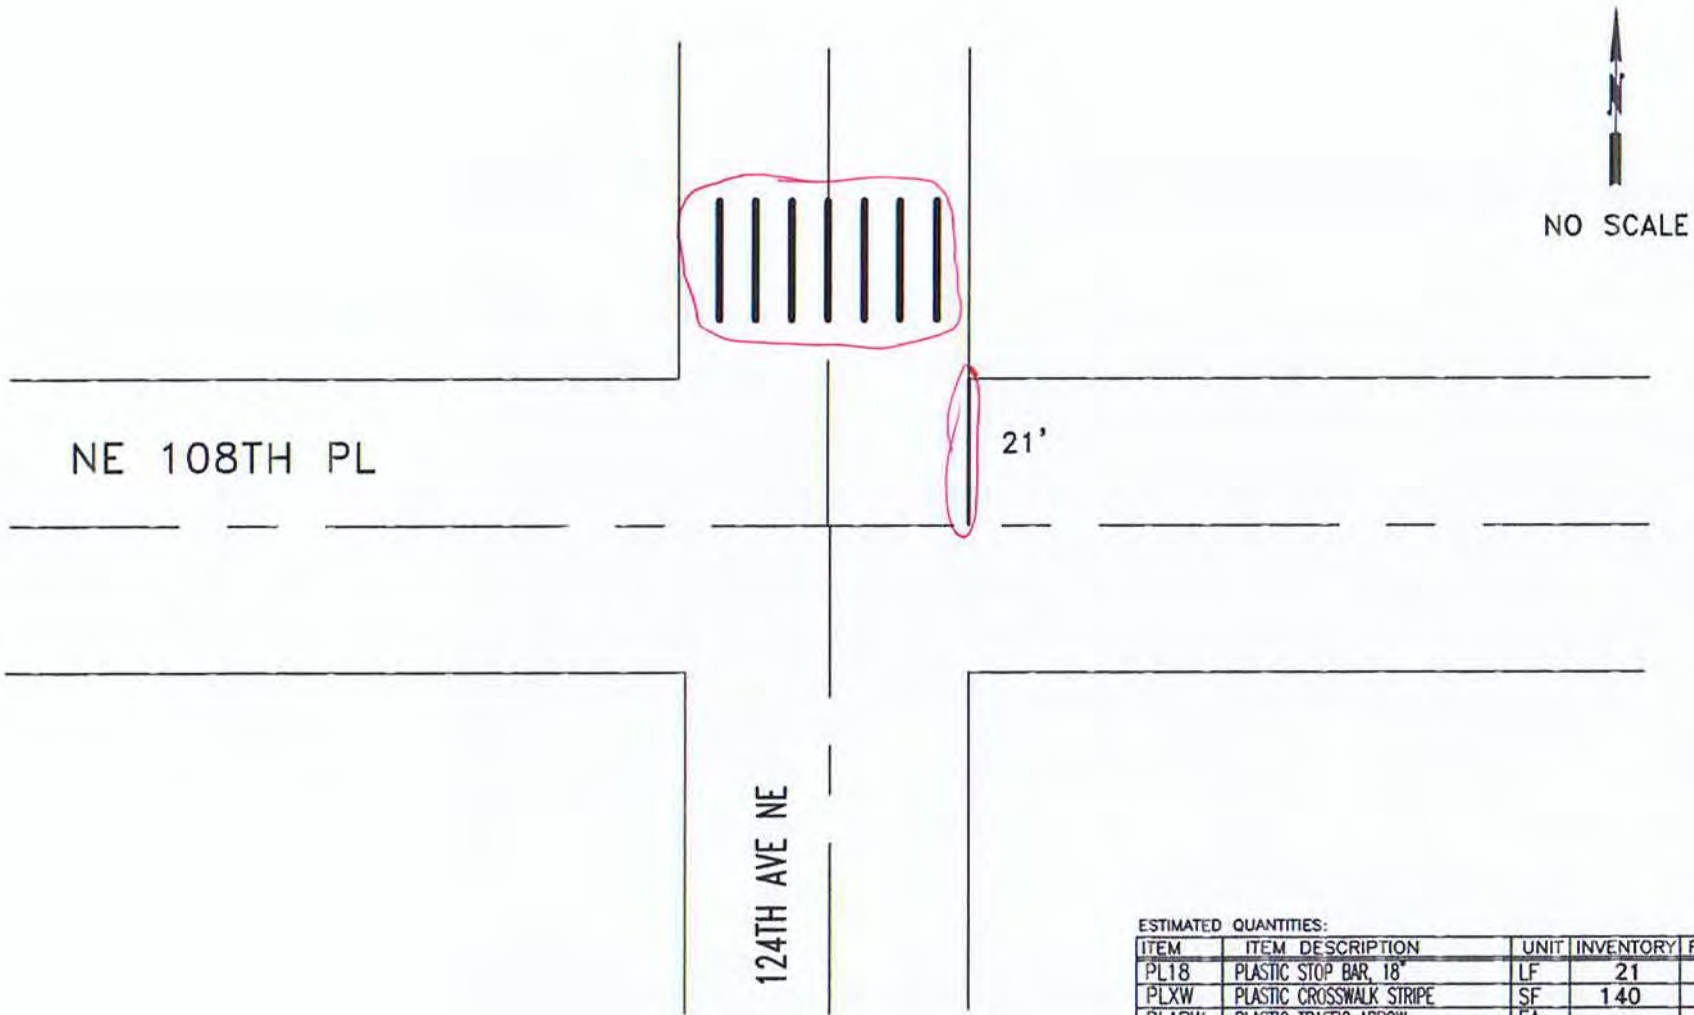

ESTIMATED QUANTITIES:

ITEM	ITEM DESCRIPTION	UNIT	INVENTORY	REPAIR QTY
PL18	PLASTIC STOP BAR, 18"	LF	21	21
PLXW	PLASTIC CROSSWALK STRIPE	SF	140	140
PLARW	PLASTIC TRAFFIC ARROW	EA		
PLLTR	PLASTIC TRAFFIC LETTER, 8 FT HIGH	EA		
PLRR	PLASTIC RAILROAD SYMBOL	EA		
RPLSYM	REMOVE PL. ARROW, LETTER, SYMBOL	EA		
RRPM	REMOVE RPM	EA		
RPLXW	REMOVE PLASTIC STRIPE	SF		70

CITY OF KIRKLAND
DEPARTMENT OF PUBLIC WORKS
123 FIFTH AVENUE KIRKLAND, WA 98033
(425) 587-3800 www.kirklandwa.gov

D.GRILLEY 1/2000
DESIGNED BY: DATE

J.JENNINGS 1/2000
DRAWN BY: DATE

CHECKED BY: DATE

2020 PAVEMENT MARKING PROGRAM

STREET: 124TH AVE NE

CROSS STREET: NE 108TH PL

SEGMENT:

SCALE: N.T.S.

FILENAME: Page 9-3

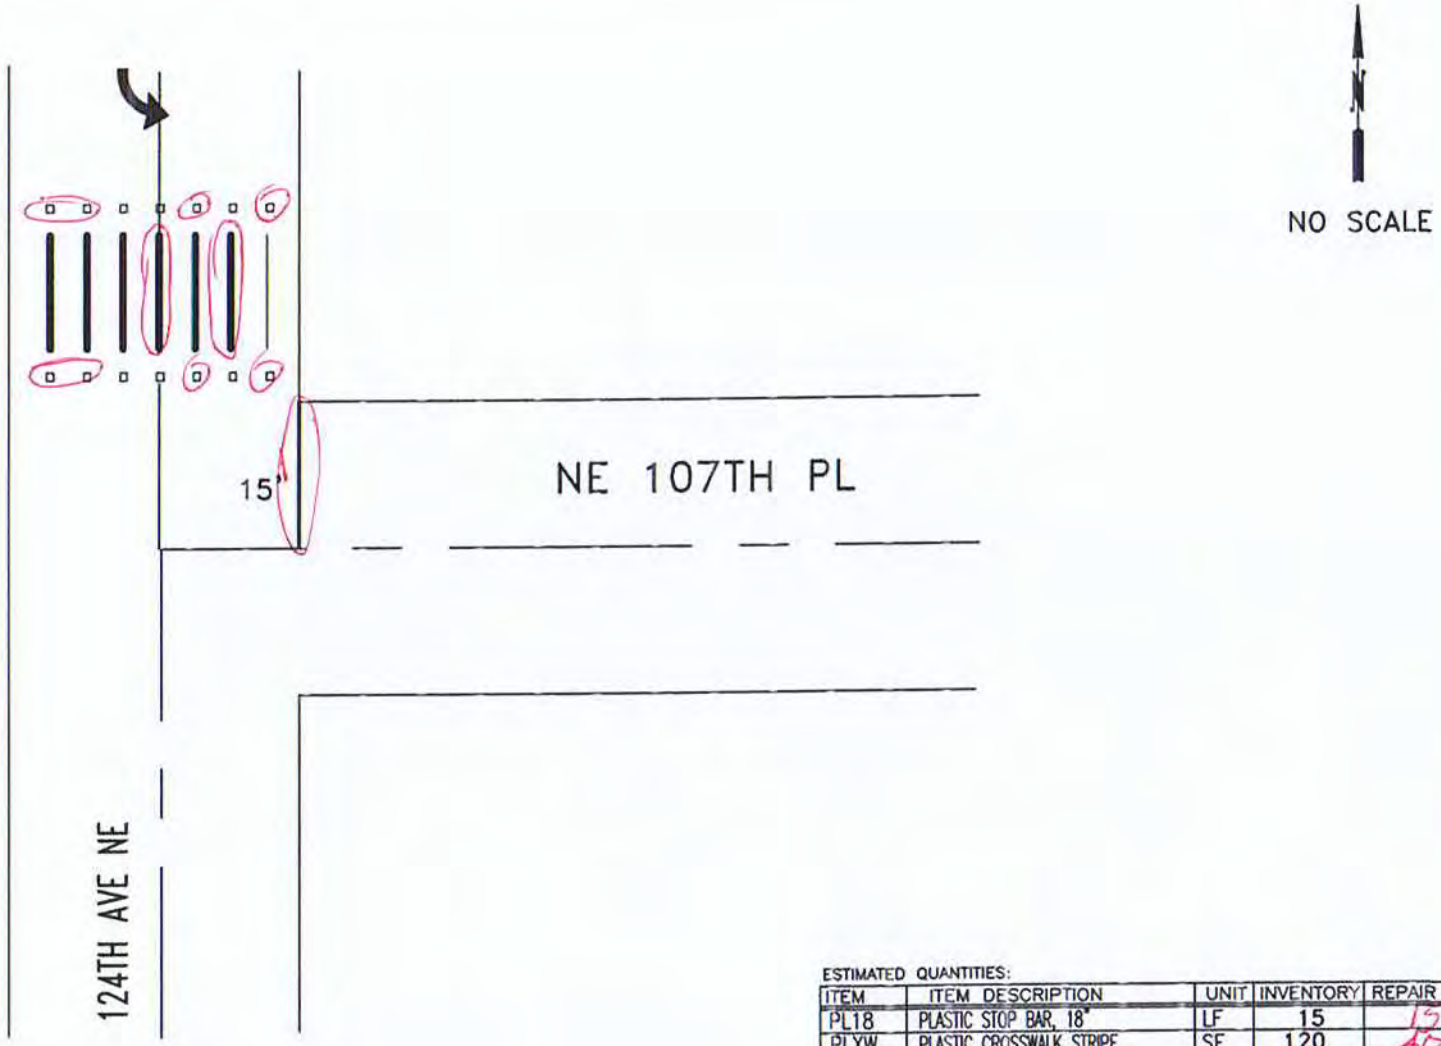

ESTIMATED QUANTITIES:

ITEM	ITEM DESCRIPTION	UNIT	INVENTORY	REPAIR QTY
PL18	PLASTIC STOP BAR, 18"	LF	15	13
PLXW	PLASTIC CROSSWALK STRIPE	SF	120	48
PLARW	PLASTIC TRAFFIC ARROW	EA	1	
PLLTR	PLASTIC TRAFFIC LETTER, 8 FT HIGH	EA		
PLRR	PLASTIC RAILROAD SYMBOL	EA		
RPLSYM	REMOVE PL. ARROW, LETTER, SYMBOL	EA		
RRPM	REMOVE RPM	EA		
RPLXW	REMOVE PLASTIC STRIPE	SF		78
	RAISED PAVEMENT MARKER TYPE 2	EA	14	8

CITY OF KIRKLAND
DEPARTMENT OF PUBLIC WORKS
123 FIFTH AVENUE KIRKLAND, WA 98033
(425) 587-3800 www.kirklandwa.gov

G. HORTILLOSA 10/2006
DESIGNED BY: DATE

J.JENNINGS 10/2006
DRAWN BY: DATE

CHECKED BY: DATE

2020 PAVEMENT MARKING PROGRAM

STREET: 124TH AVE NE

CROSS STREET: NE 107TH PL

SEGMENT:

SCALE: N.T.S.

FILENAME: Page 9-4

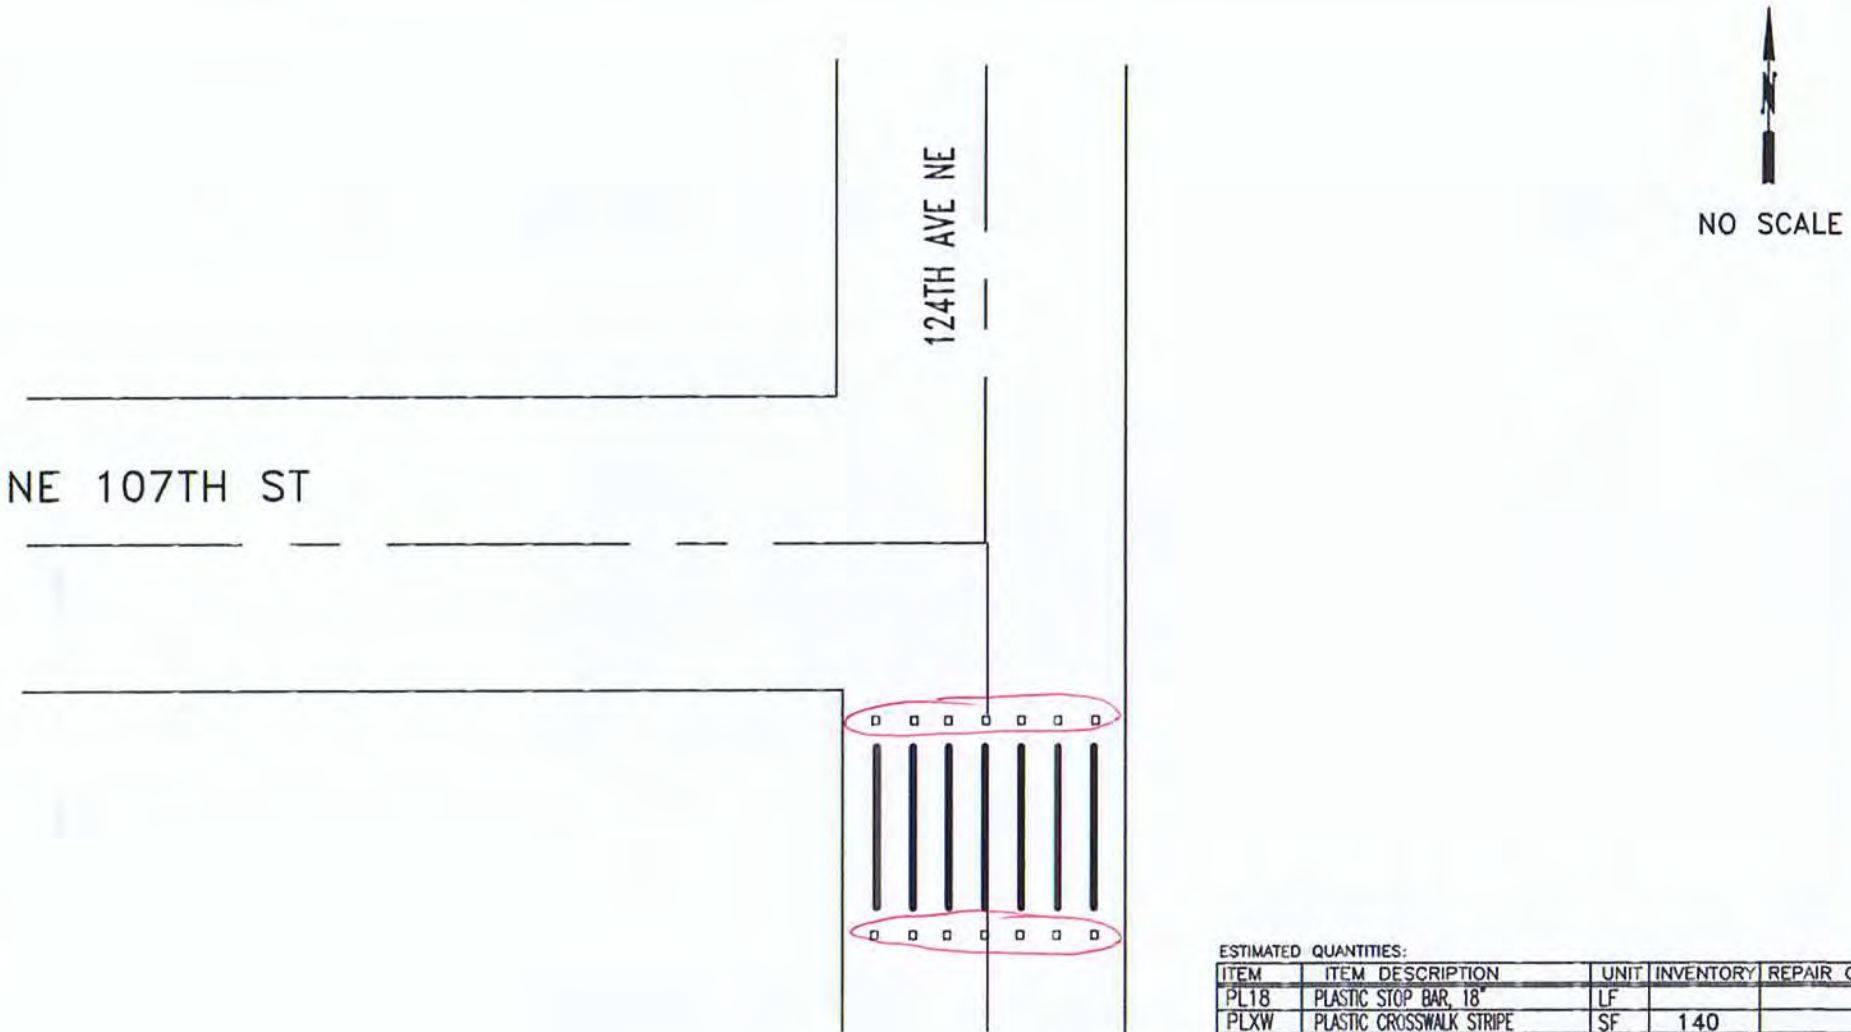

ESTIMATED QUANTITIES:

ITEM	ITEM DESCRIPTION	UNIT	INVENTORY	REPAIR QTY
PL18	PLASTIC STOP BAR, 18"	LF		
PLXW	PLASTIC CROSSWALK STRIPE	SF	140	
PLARW	PLASTIC TRAFFIC ARROW	EA		
PLLTR	PLASTIC TRAFFIC LETTER, 8 FT HIGH	EA		
PLRR	PLASTIC RAILROAD SYMBOL	EA		
RPLSYM	REMOVE PL. ARROW, LETTER, SYMBOL	EA		
RRPM	REMOVE RPM	EA		7
RPLXW	REMOVE PLASTIC STRIPE	SF		
	RAISED PAVEMENT MARKER TYPE 2	EA	14	14

CITY OF KIRKLAND
DEPARTMENT OF PUBLIC WORKS
123 FIFTH AVENUE KIRKLAND, WA 98033
(425) 587-3800 www.kirklandwa.gov

G. HORTILLOSA 3/2009
DESIGNED BY: DATE

J.JENNINGS 3/2009
DRAWN BY: DATE

CHECKED BY: DATE


STREET: 124TH AVE NE

CROSS STREET: NE 107TH ST

SEGMENT:

SCALE: N.T.S.

FILENAME: Page 9-5

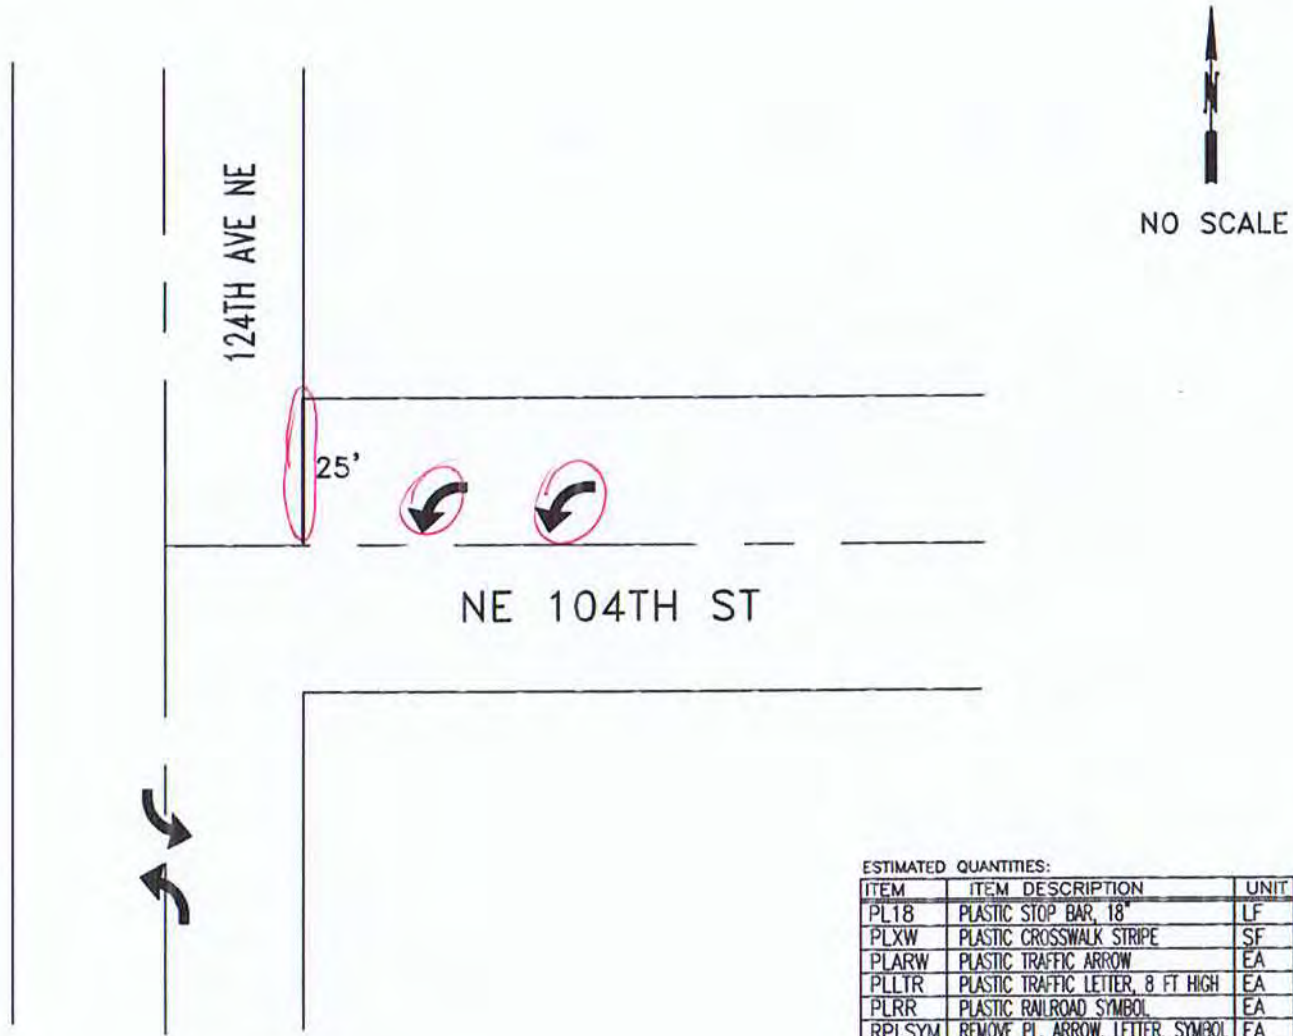

ESTIMATED QUANTITIES:

ITEM	ITEM DESCRIPTION	UNIT	INVENTORY	REPAIR QTY
PL18	PLASTIC STOP BAR, 18"	LF	25	25
PLXW	PLASTIC CROSSWALK STRIPE	SF		
PLARW	PLASTIC TRAFFIC ARROW	EA	2	2
PLLTR	PLASTIC TRAFFIC LETTER, 8 FT HIGH	EA		
PLRR	PLASTIC RAILROAD SYMBOL	EA		
RPLSYM	REMOVE PL. ARROW, LETTER, SYMBOL	EA		2
RRPM	REMOVE RPM	EA		
RPLXW	REMOVE PLASTIC STRIPE	SF		33

CITY OF KIRKLAND
DEPARTMENT OF PUBLIC WORKS
123 FIFTH AVENUE KIRKLAND, WA 98033
(425) 587-3800 www.kirklandwa.gov

D.GRILLEY 1/2000
DESIGNED BY: DATE

J.JENNINGS 10/2009
DRAWN BY: DATE

CHECKED BY: DATE

2020 PAVEMENT MARKING PROGRAM

STREET: 124TH AVE NE


SEGMENT:

SCALE: N.T.S.

FILENAME: Page 9-6

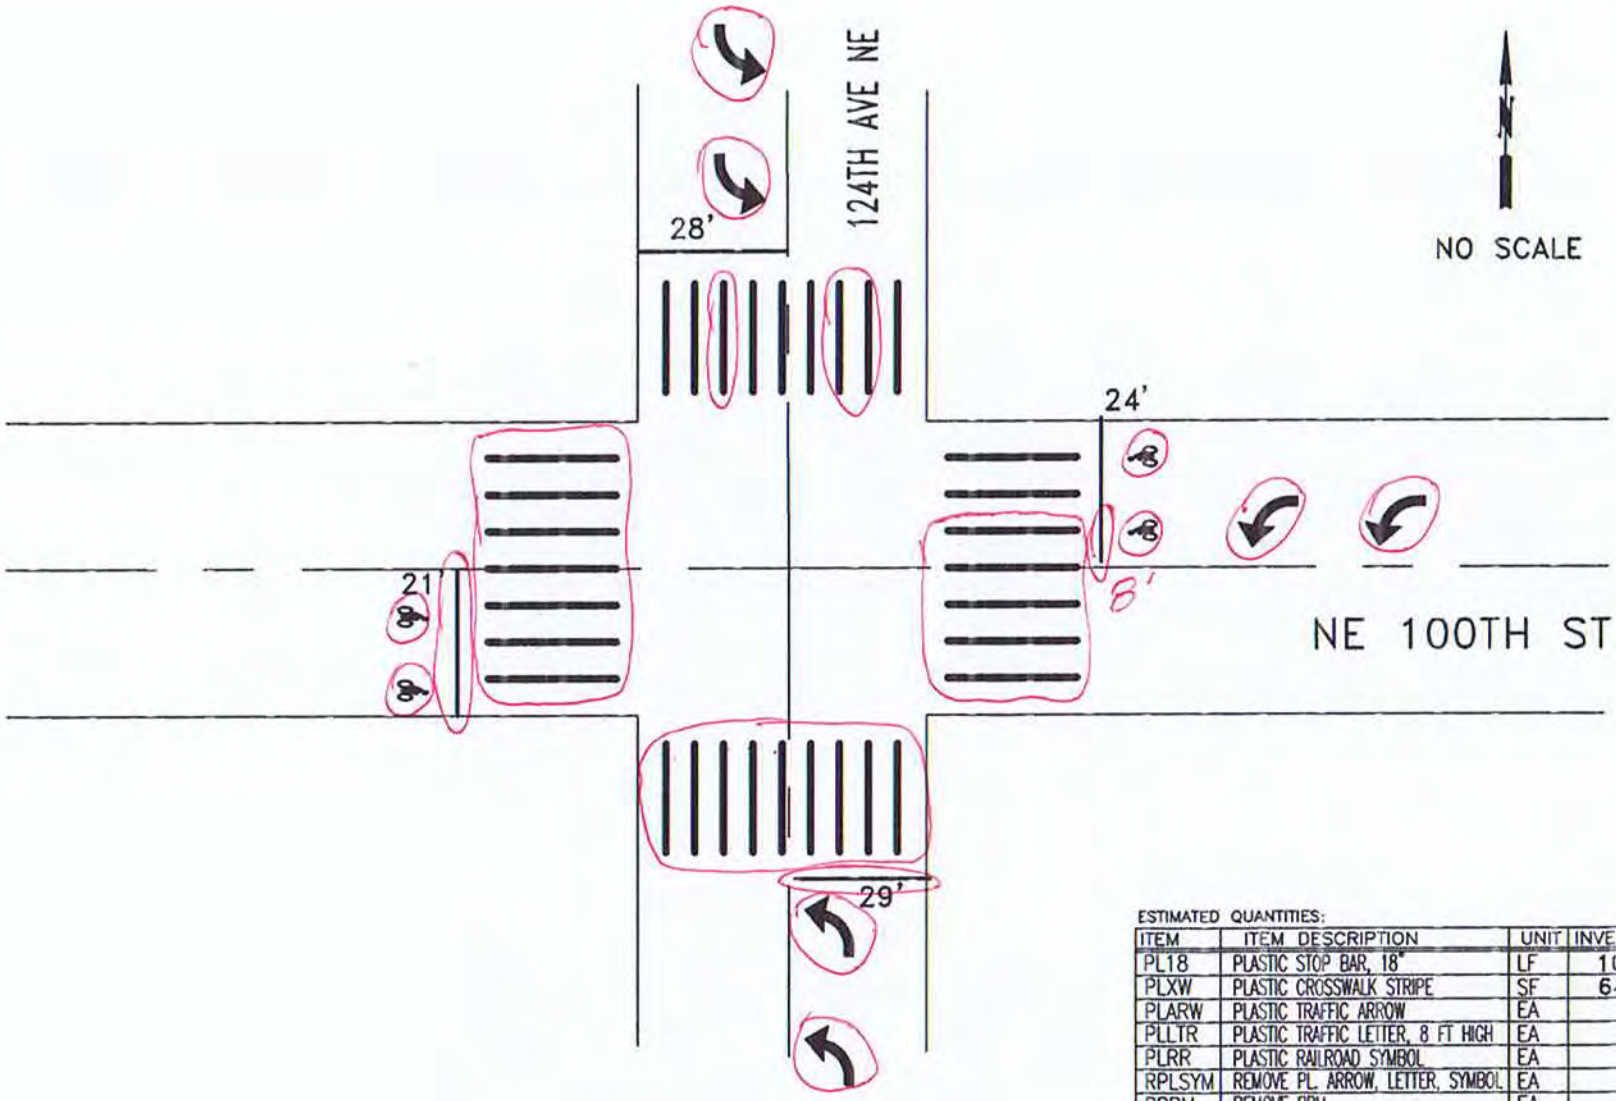

ESTIMATED QUANTITIES:

ITEM	ITEM DESCRIPTION	UNIT	INVENTORY	REPAIR QTY
PL18	PLASTIC STOP BAR, 18"	LF	102	39
PLXW	PLASTIC CROSSWALK STRIPE	SF	640	480
PLARW	PLASTIC TRAFFIC ARROW	EA	6	6
PLLTR	PLASTIC TRAFFIC LETTER, 8 FT HIGH	EA		
PLRR	PLASTIC RAILROAD SYMBOL	EA		
RPLSYM	REMOVE PL. ARROW, LETTER, SYMBOL	EA		1
RRPM	REMOVE RPM	EA		
RPLXW	REMOVE PLASTIC STRIPE	SF		150
	PLASTIC BIKE DETECTION SYMBOL	EA	4	4

CITY OF KIRKLAND
DEPARTMENT OF PUBLIC WORKS
123 FIFTH AVENUE KIRKLAND, WA 98033
(425) 587-3800 www.kirklandwa.gov

G. HORTILLOSA 2/2011
DESIGNED BY: DATE

J.JENNINGS 2/2011
DRAWN BY: DATE

CHECKED BY: DATE

2022 PAVEMENT MARKING PROGRAM

STREET: 124TH AVE NE

CROSS STREET: NE 100TH ST

SEGMENT:

SCALE: N.T.S.

FILENAME: Page 9-7

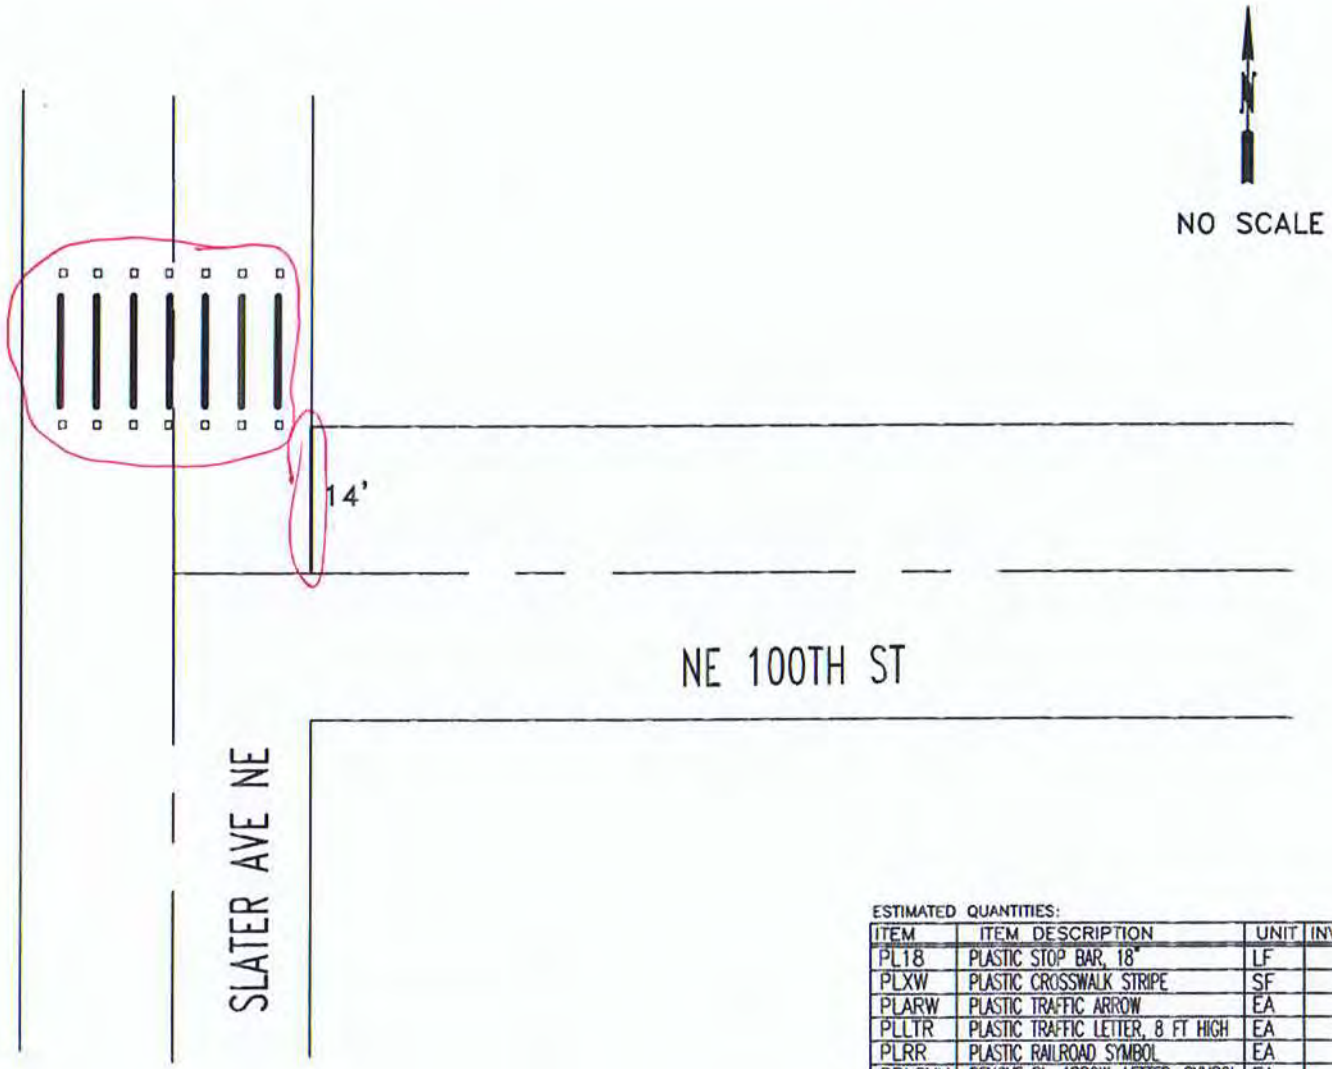

ESTIMATED QUANTITIES:

ITEM	ITEM DESCRIPTION	UNIT	INVENTORY	REPAIR QTY
PL18	PLASTIC STOP BAR, 18"	LF	14	14
PLXW	PLASTIC CROSSWALK STRIPE	SF	140	140
PLARW	PLASTIC TRAFFIC ARROW	EA		
PLLTR	PLASTIC TRAFFIC LETTER, 8 FT HIGH	EA	5	
PLRR	PLASTIC RAILROAD SYMBOL	EA		
RPLSYM	REMOVE PL. ARROW, LETTER, SYMBOL	EA		
RRPM	REMOVE RPM	EA		
RPLXW	REMOVE PLASTIC STRIPE	SF		6
	RAISED PAVEMENT MARKER TYPE 2	EA	14	14

CITY OF KIRKLAND
DEPARTMENT OF PUBLIC WORKS
123 FIFTH AVENUE KIRKLAND, WA 98033
(425) 587-3800 www.kirklandwa.gov

G. HORTILLOSA 4/2007
DESIGNED BY: DATE

J.JENNINGS 4/2007
DRAWN BY: DATE

CHECKED BY: DATE

2020 PAVEMENT MARKING PROGRAM

STREET: NE 100TH ST

CROSS STREET: SLATER AVE NE

SEGMENT:

SCALE: N.T.S.

FILENAME: Page 9-8

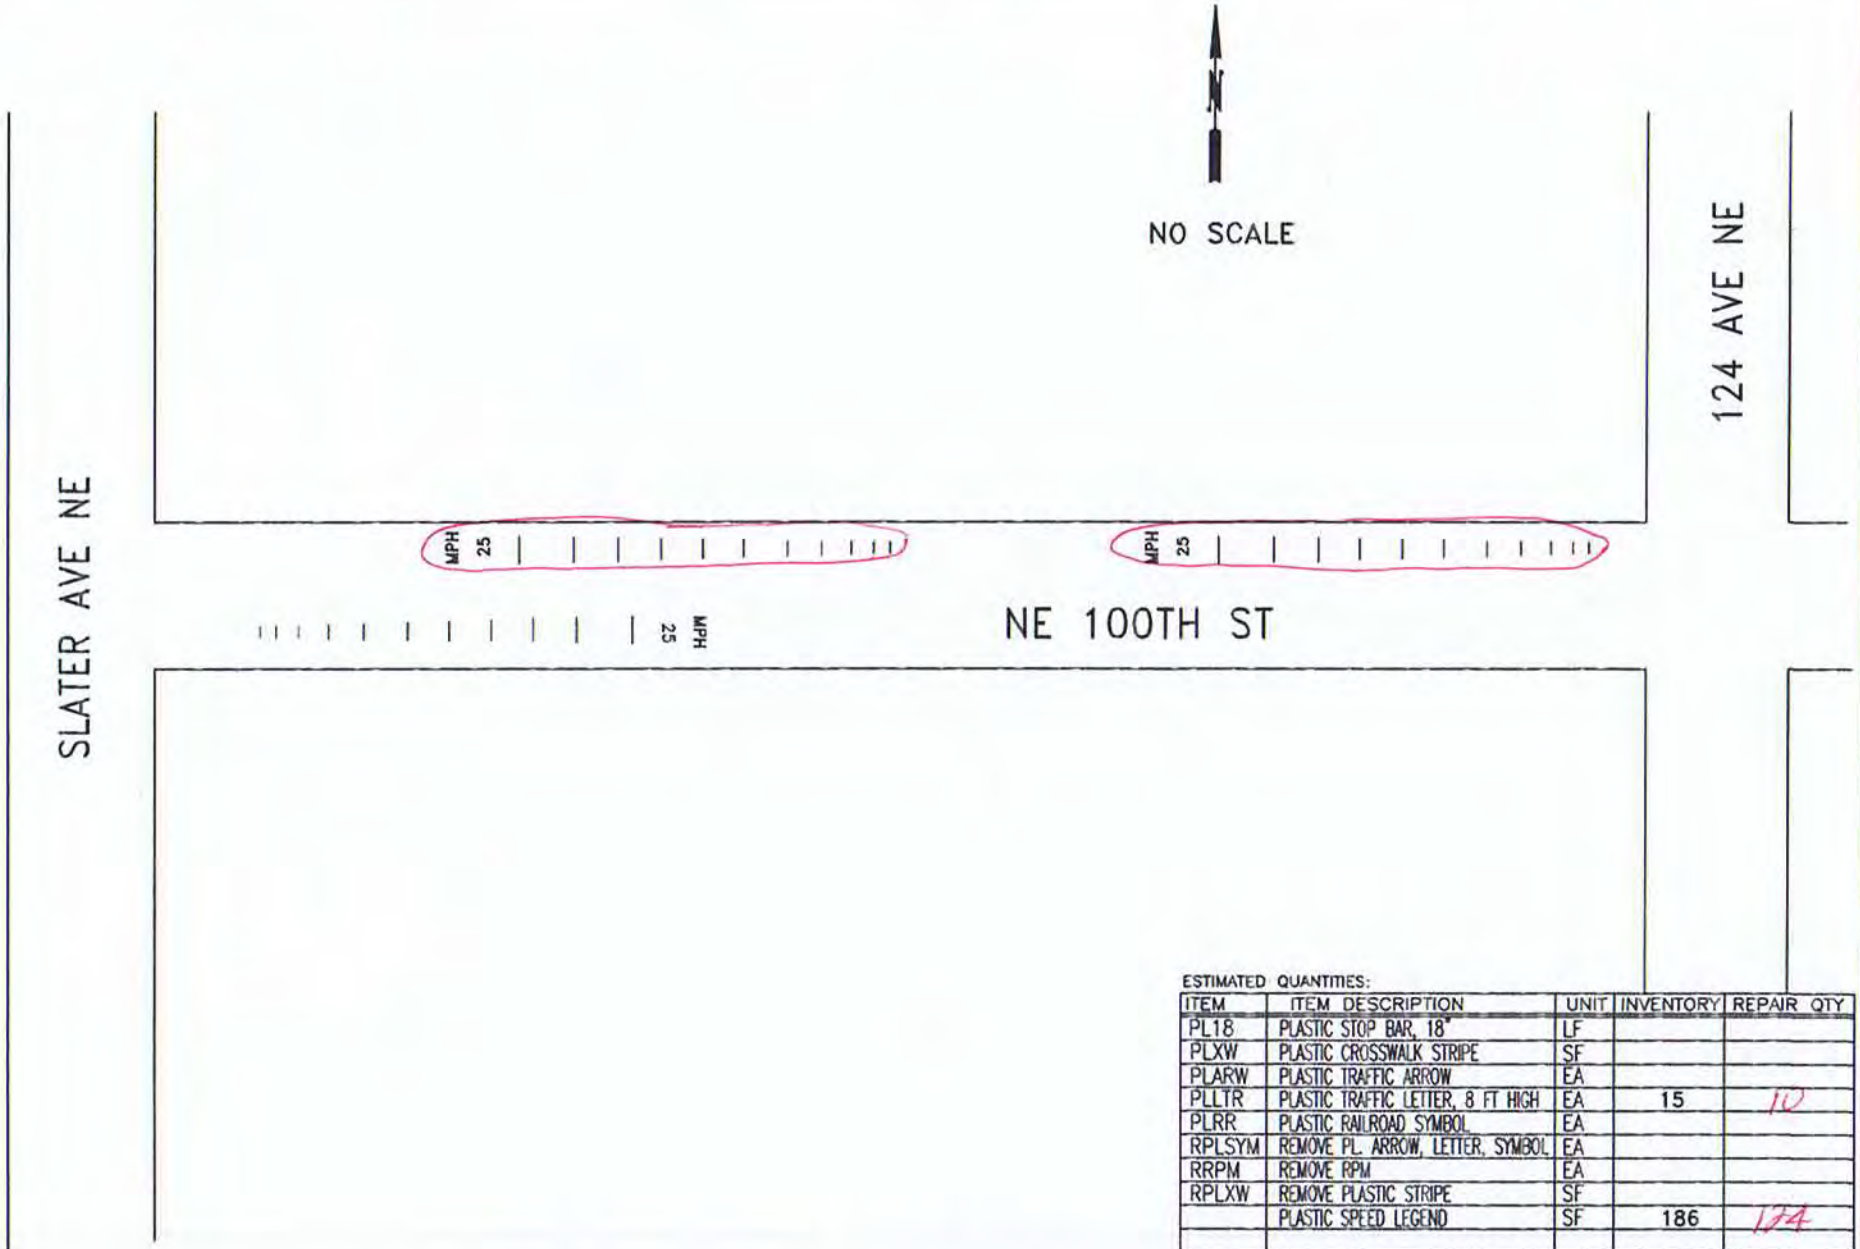

ESTIMATED QUANTITIES:

ITEM	ITEM DESCRIPTION	UNIT	INVENTORY	REPAIR QTY
PL18	PLASTIC STOP BAR, 18"	LF		
PLXW	PLASTIC CROSSWALK STRIPE	SF		
PLARW	PLASTIC TRAFFIC ARROW	EA		
PLLTR	PLASTIC TRAFFIC LETTER, 8 FT HIGH	EA	15	10
PLRR	PLASTIC RAILROAD SYMBOL	EA		
RPLSYM	REMOVE PL. ARROW, LETTER, SYMBOL	EA		
RRPM	REMOVE RPM	EA		
RPLXW	REMOVE PLASTIC STRIPE	SF		
	PLASTIC SPEED LEGEND	SF	186	124

CITY OF KIRKLAND WASHINGTON

CITY OF KIRKLAND
DEPARTMENT OF PUBLIC WORKS
123 FIFTH AVENUE KIRKLAND, WA 98033
(425) 587-3800 www.kirklandwa.gov

G. HORTILLOSA 4/2007
DESIGNED BY: DATE

J.JENNINGS 4/2007
DRAWN BY: DATE

CHECKED BY: DATE

2020 PAVEMENT MARKING PROGRAM

STREET: NE 100 ST

CROSS STREET: SLATER AVE TO 124 AVE NE

SEGMENT:

SCALE: N.T.S.

FILENAME: PAGE 9-9

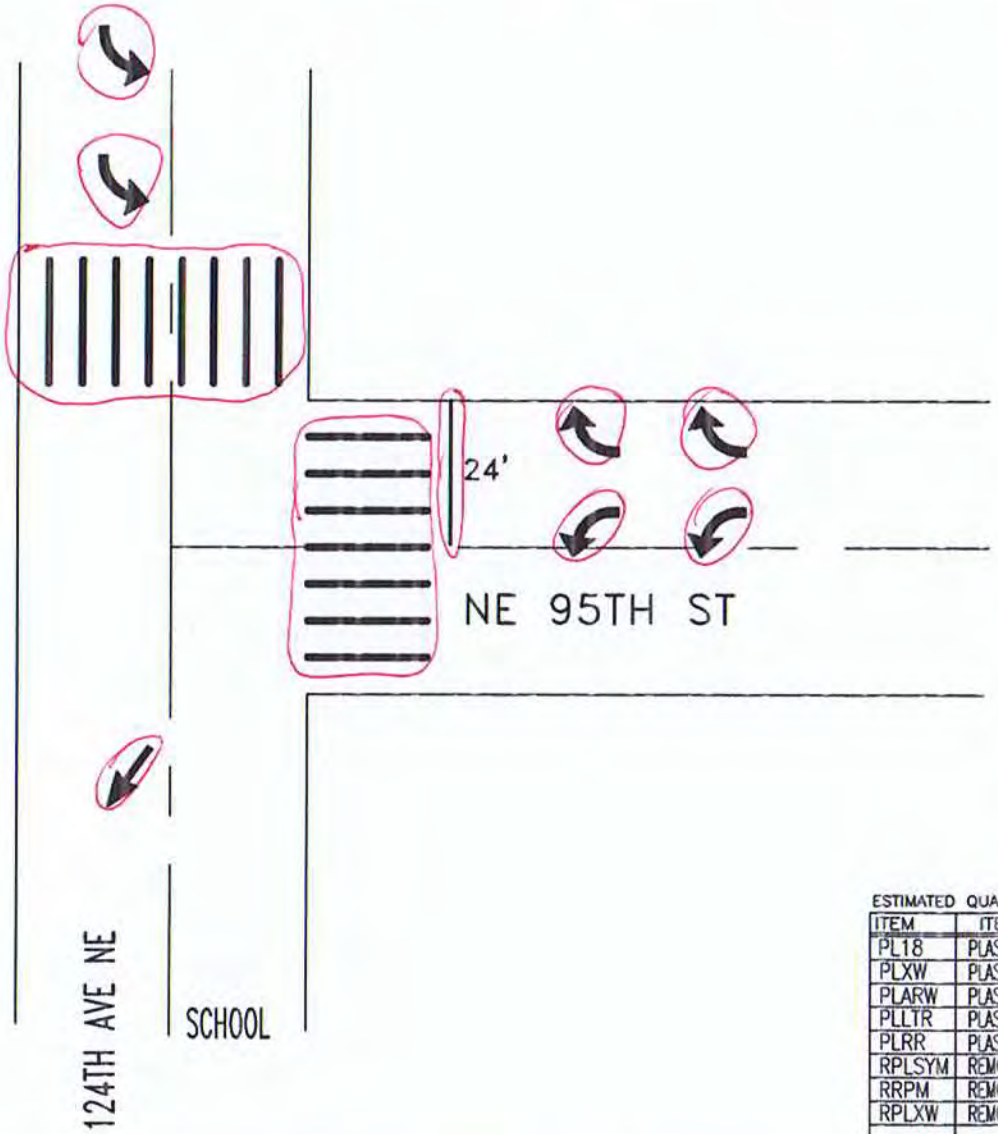

NO SCALE

ESTIMATED QUANTITIES:

ITEM	ITEM DESCRIPTION	UNIT	INVENTORY	REPAIR QTY
PL18	PLASTIC STOP BAR, 18"	LF	24	24
PLXW	PLASTIC CROSSWALK STRIPE	SF	300	300
PLARW	PLASTIC TRAFFIC ARROW	EA	7	7
PLLTR	PLASTIC TRAFFIC LETTER, 8 FT HIGH	EA		
PLRR	PLASTIC RAILROAD SYMBOL	EA		
RPLSYM	REMOVE PL. ARROW, LETTER, SYMBOL	EA		2
RRPM	REMOVE RPM	EA		
RPLXW	REMOVE PLASTIC STRIPE	SF		120

CITY OF KIRKLAND
DEPARTMENT OF PUBLIC WORKS
123 FIFTH AVENUE KIRKLAND, WA 98033
(425) 587-3800 www.kirklandwa.gov

D.GRILLEY 1/2000
DESIGNED BY: DATE

J.JENNINGS 10/2009
DRAWN BY: DATE

CHECKED BY: DATE

2020 PAVEMENT MARKING PROGRAM

STREET: 124TH AVE NE

CROSS STREET: NE 95TH ST

SEGMENT:

SCALE: N.T.S.

FILENAME: Page 9-10

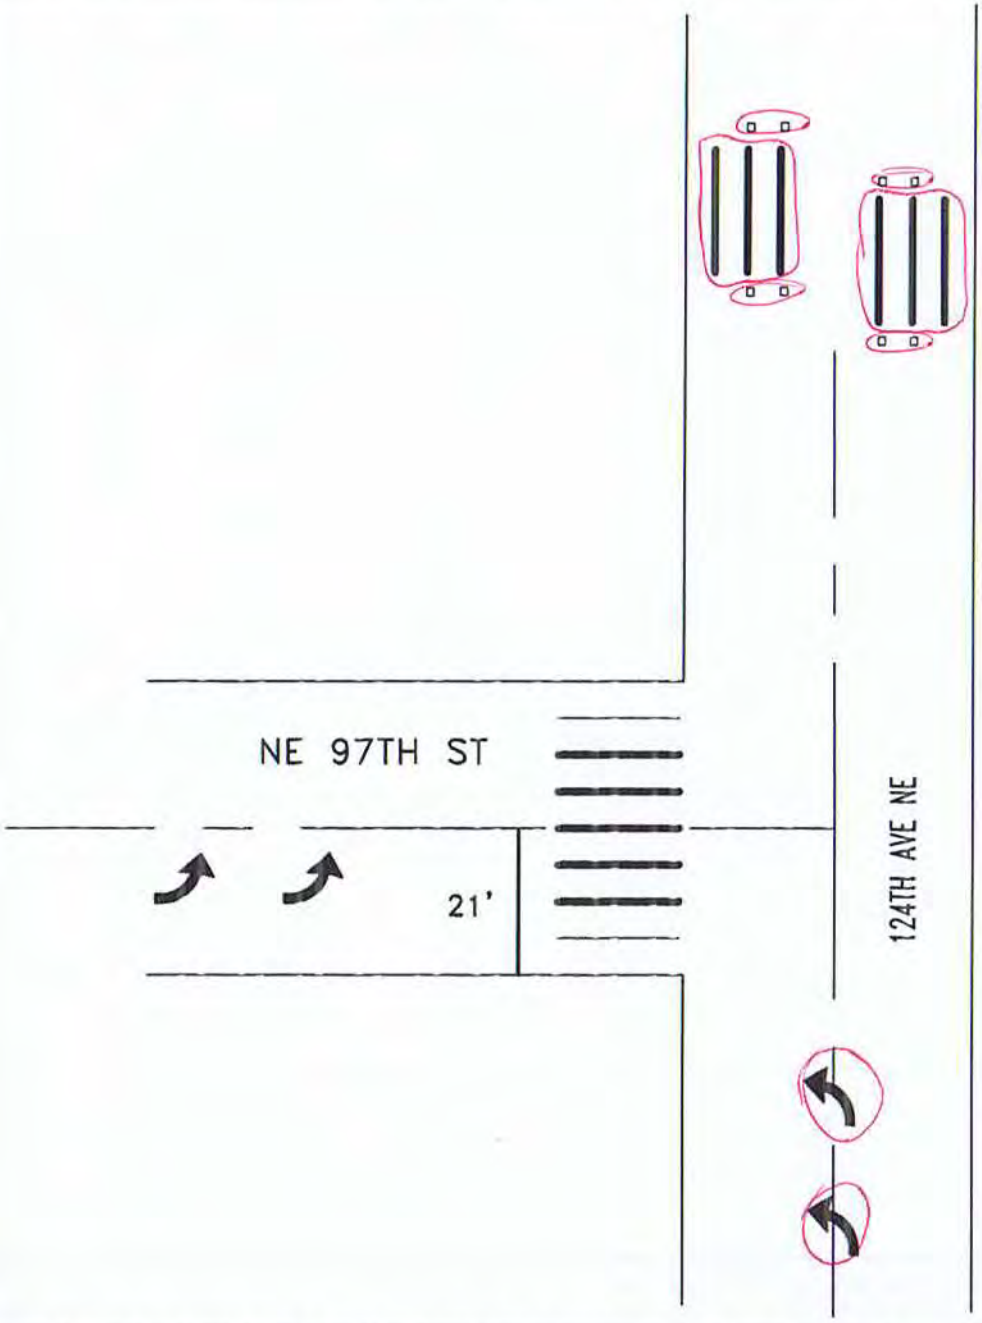

NO SCALE

ESTIMATED QUANTITIES:

ITEM	ITEM DESCRIPTION	UNIT	INVENTORY	REPAIR QTY
PL18	PLASTIC STOP BAR, 18"	LF	21	
PLXW	PLASTIC CROSSWALK STRIPE	SF	240	120
PLARW	PLASTIC TRAFFIC ARROW	EA	4	2
PLLTR	PLASTIC TRAFFIC LETTER, 8 FT HIGH	EA		
PLRR	PLASTIC RAILROAD SYMBOL	EA		
RPLSYM	REMOVE PL. ARROW, LETTER, SYMBOL	EA		
RRPM	REMOVE RPM	EA		4
RPLXW	REMOVE PLASTIC STRIPE	SF		
	RPM TYPE 2	EA	8	8

CITY OF KIRKLAND
DEPARTMENT OF PUBLIC WORKS
123 FIFTH AVENUE KIRKLAND, WA 98033
(425) 587-3800 www.kirklandwa.gov

F. LEE 3/2015
DESIGNED BY: DATE

J.JENNINGS 3/2015
DRAWN BY: DATE

CHECKED BY: DATE

2022 PAVEMENT MARKING PROGRAM

STREET: 124TH AVE NE

CROSS STREET: NE 97TH ST

SEGMENT:

SCALE: N.T.S.

FILENAME: Page 9-11

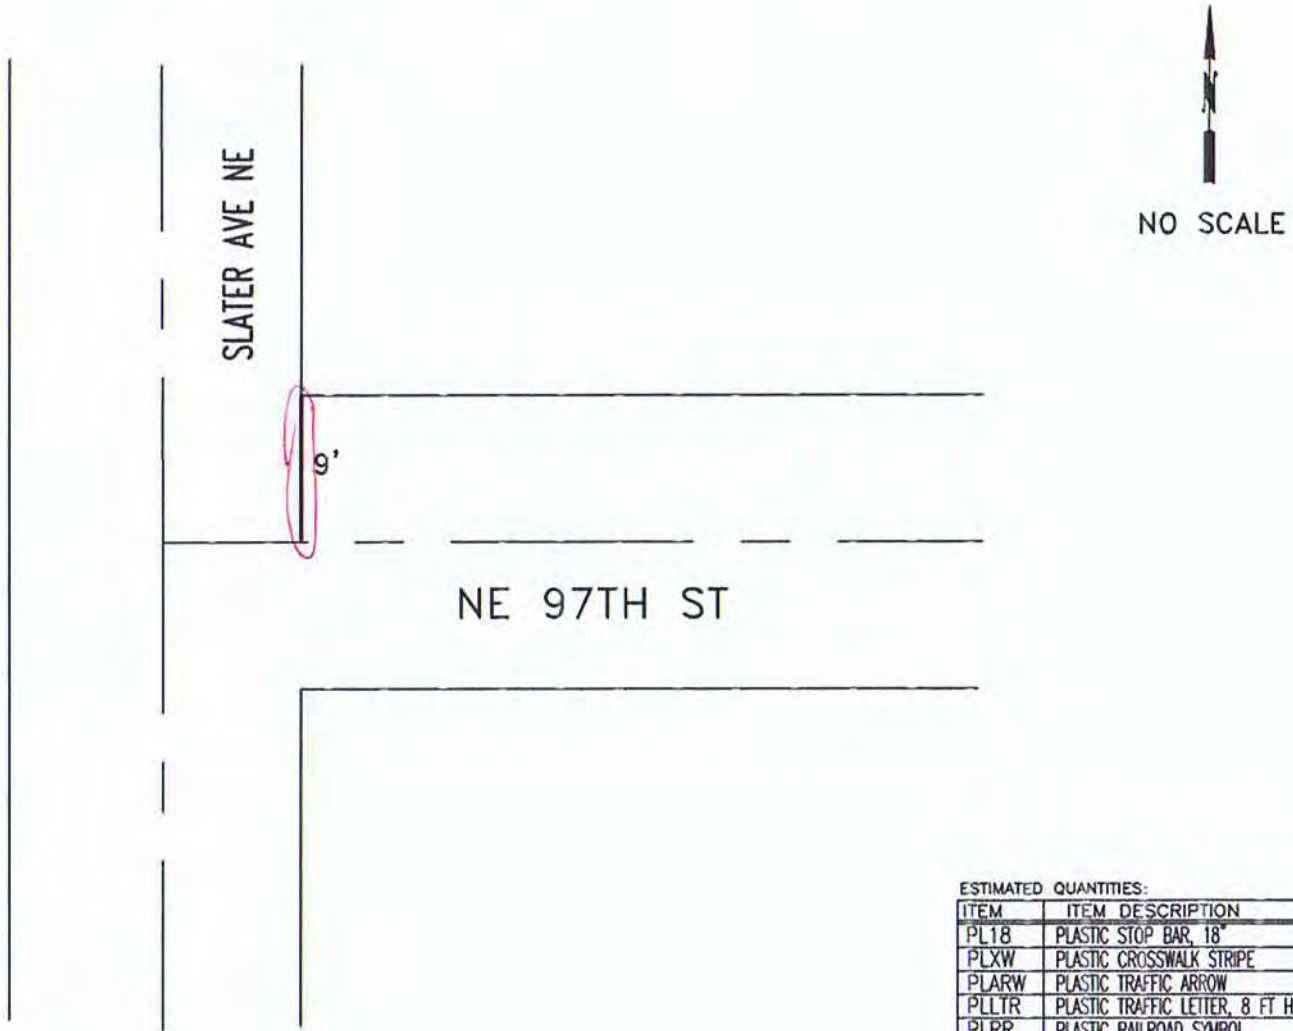

ESTIMATED QUANTITIES:

ITEM	ITEM DESCRIPTION	UNIT	INVENTORY	REPAIR QTY
PL18	PLASTIC STOP BAR, 18"	LF	9	9
PLXW	PLASTIC CROSSWALK STRIPE	SF		
PLARW	PLASTIC TRAFFIC ARROW	EA		
PLLTR	PLASTIC TRAFFIC LETTER, 8 FT HIGH	EA		
PLRR	PLASTIC RAILROAD SYMBOL	EA		
RPLSYM	REMOVE PL. ARROW, LETTER, SYMBOL	EA		
RRPM	REMOVE RPM	EA		
RPLXW	REMOVE PLASTIC STRIPE	SF		

CITY OF KIRKLAND
DEPARTMENT OF PUBLIC WORKS
123 FIFTH AVENUE KIRKLAND, WA 98033
(425) 587-3800 www.kirklandwa.gov

D.GRILLEY 1/2000
DESIGNED BY: DATE

J.JENNINGS 1/2000
DRAWN BY: DATE

CHECKED BY: DATE

2020 PAVEMENT MARKING PROGRAM

STREET: NE 97TH ST

CROSS STREET: SLATER AVE NE

SEGMENT:

SCALE: N.T.S.

FILENAME: Page 9-12

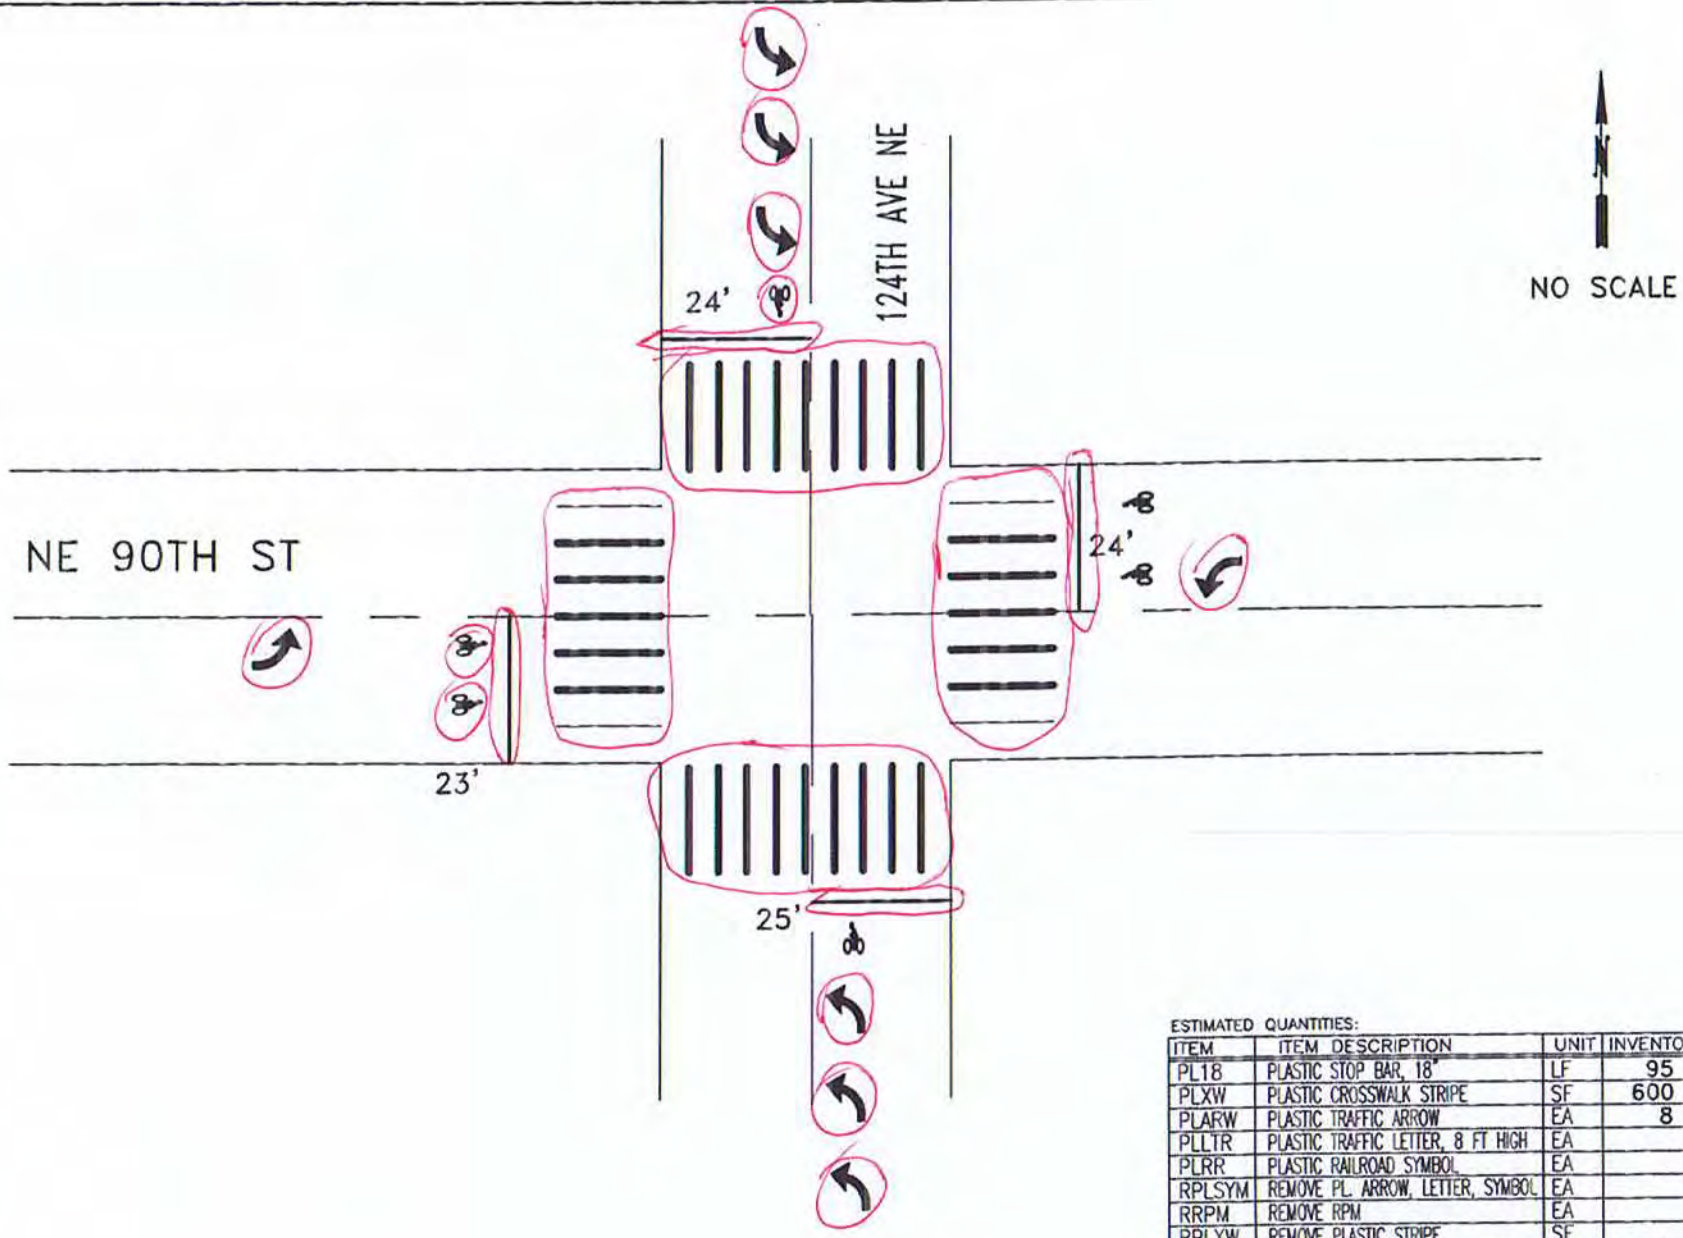

ESTIMATED QUANTITIES:

ITEM	ITEM DESCRIPTION	UNIT	INVENTORY	REPAIR QTY
PL18	PLASTIC STOP BAR, 18"	LF	95	90
PLXW	PLASTIC CROSSWALK STRIPE	SF	600	600
PLARW	PLASTIC TRAFFIC ARROW	EA	8	8
PLLTR	PLASTIC TRAFFIC LETTER, 8 FT HIGH	EA		
PLRR	PLASTIC RAILROAD SYMBOL	EA		
RPLSYM	REMOVE PL. ARROW, LETTER, SYMBOL	EA		4
RRPM	REMOVE RPM	EA		
RPLXW	REMOVE PLASTIC STRIPE	SF		350
	PLASTIC BIKE DETECTION SYMBOL	EA	6	3

CITY OF KIRKLAND
DEPARTMENT OF PUBLIC WORKS
123 FIFTH AVENUE KIRKLAND, WA 98033
(425) 587-3800 www.kirklandwa.gov

G. HORTILLOSA 3/2010
DESIGNED BY: DATE

J.JENNINGS 3/2010
DRAWN BY: DATE

CHECKED BY: DATE

2020 PAVEMENT MARKING PROGRAM

STREET: 124TH AVE NE

CROSS STREET: NE 90TH ST

SEGMENT:

SCALE: N.T.S.

FILENAME: Page 9-13

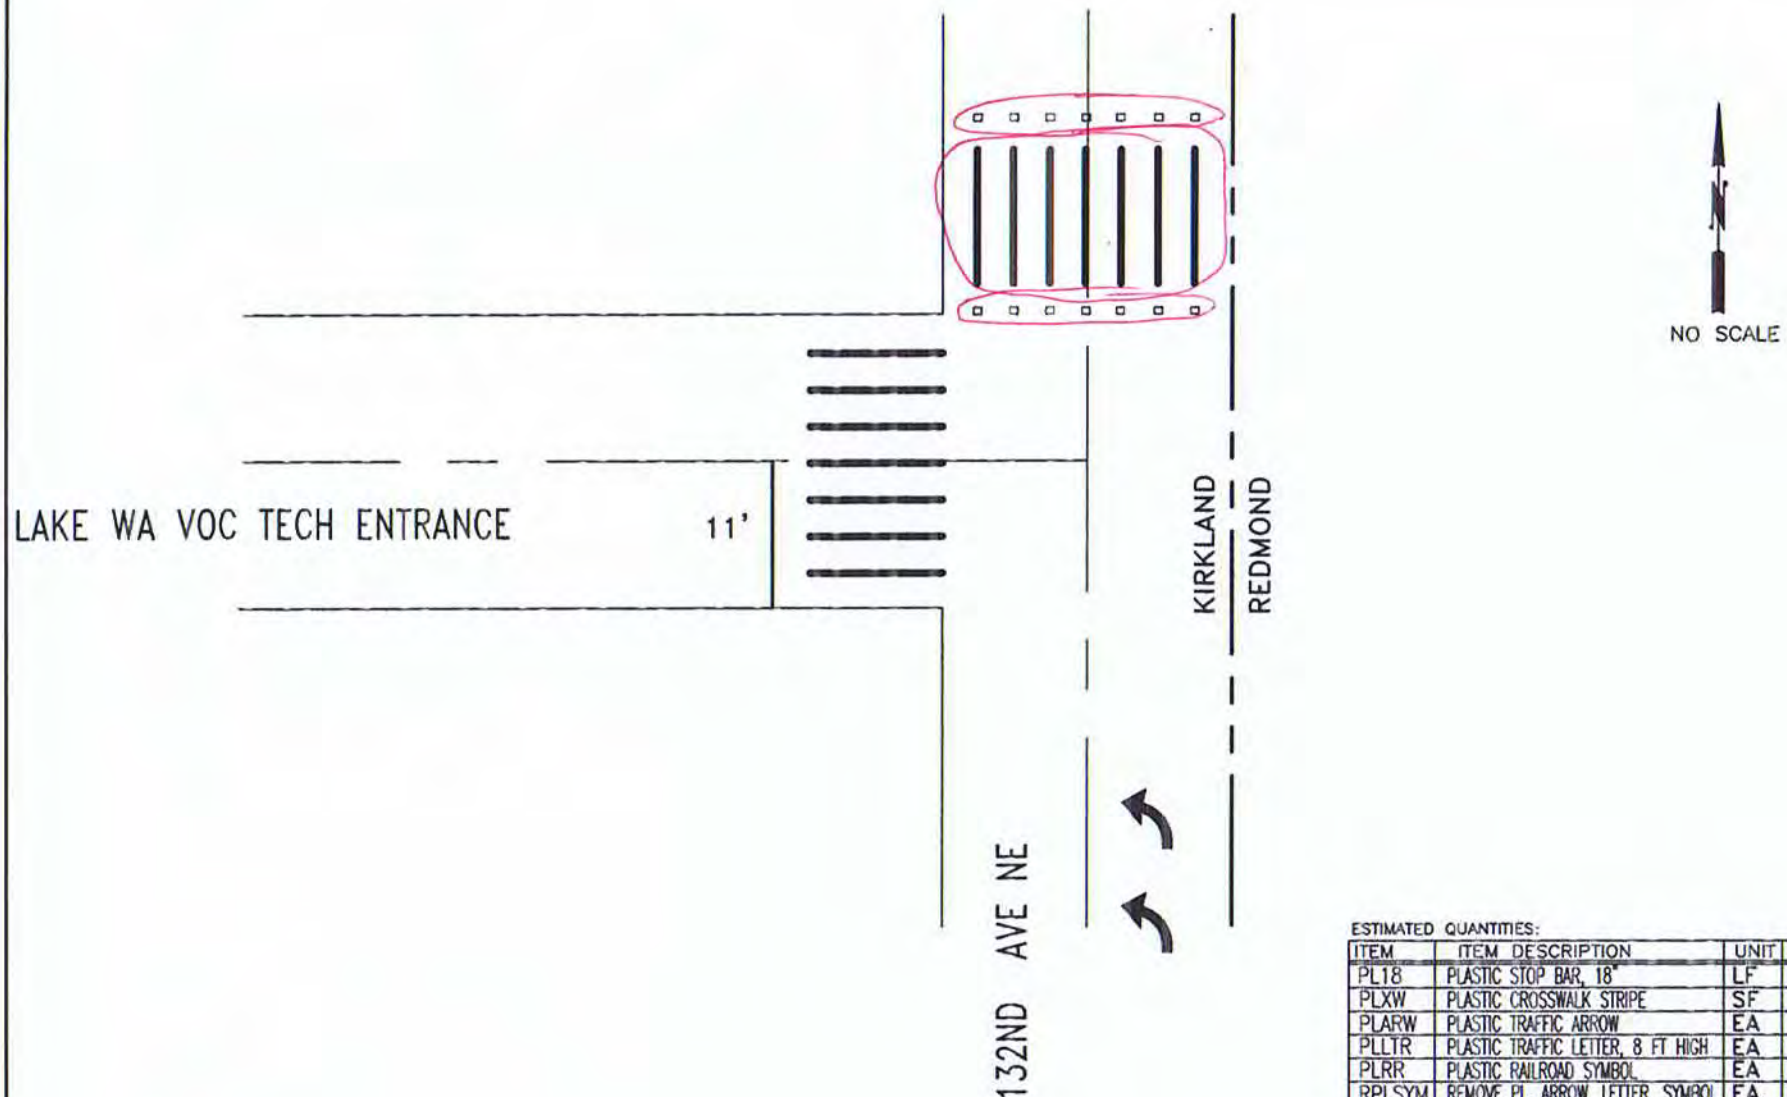

ESTIMATED QUANTITIES:

ITEM	ITEM DESCRIPTION	UNIT	INVENTORY	REPAIR QTY
PL18	PLASTIC STOP BAR, 18"	LF	11	
PLXW	PLASTIC CROSSWALK STRIPE	SF	280	140
PLARW	PLASTIC TRAFFIC ARROW	EA	2	
PLLTR	PLASTIC TRAFFIC LETTER, 8 FT HIGH	EA		
PLRR	PLASTIC RAILROAD SYMBOL	EA		
RPLSYM	REMOVE PL. ARROW, LETTER, SYMBOL	EA		
RRPM	REMOVE RPM	EA		5
RPLXW	REMOVE PLASTIC STRIPE	SF		140
RPM11	TYPE 2W RPM	EA	14	14

CITY OF KIRKLAND
DEPARTMENT OF PUBLIC WORKS
123 FIFTH AVENUE KIRKLAND, WA 98033
(425) 587-3800 www.kirklandwa.gov

R. STEITZER 8/2005
DESIGNED BY: DATE

J.JENNINGS 8/2005
DRAWN BY: DATE

CHECKED BY: DATE

2022 PAVEMENT MARKING PROGRAM

STREET: 132ND AVE NE

CROSS STREET: LK WA VOC TECH ENTRANCE

SEGMENT:

SCALE: N.T.S.

FILENAME: PAGE 9-14

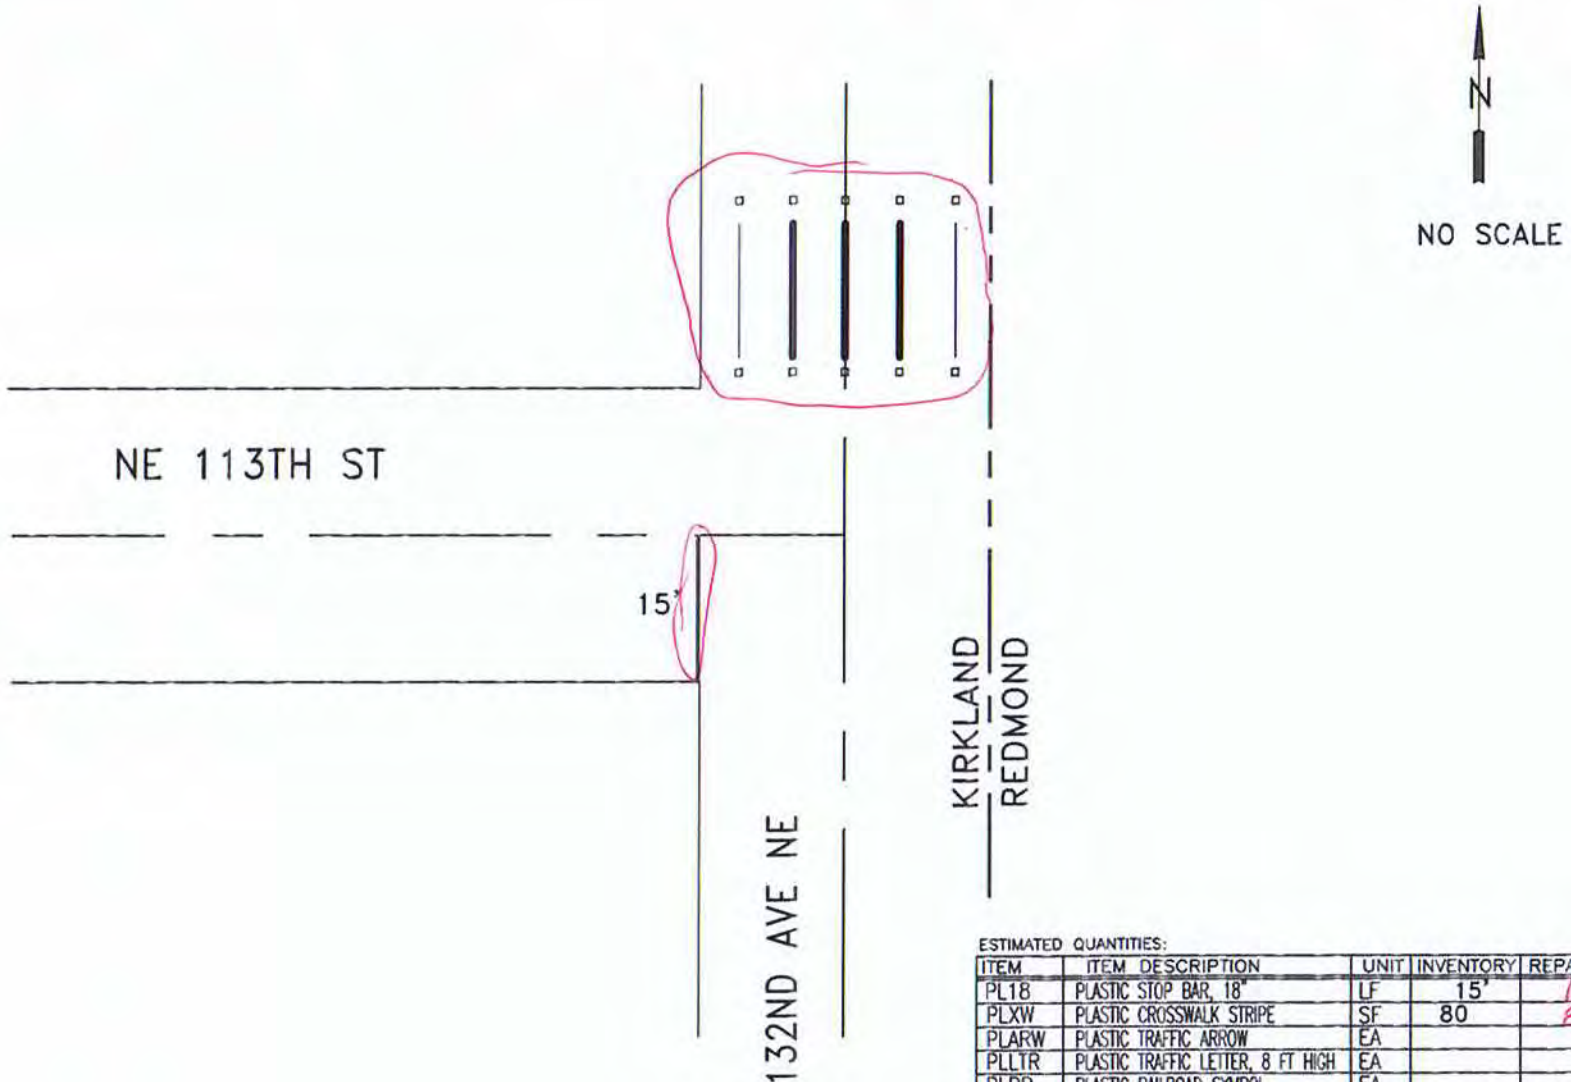

ESTIMATED QUANTITIES:

ITEM	ITEM DESCRIPTION	UNIT	INVENTORY	REPAIR QTY
PL18	PLASTIC STOP BAR, 18"	LF	15'	15
PLXW	PLASTIC CROSSWALK STRIPE	SF	80	80
PLARW	PLASTIC TRAFFIC ARROW	EA		
PLLTR	PLASTIC TRAFFIC LETTER, 8 FT HIGH	EA		
PLRR	PLASTIC RAILROAD SYMBOL	EA		
RPLSYM	REMOVE PL. ARROW, LETTER, SYMBOL	EA		
RRPM	REMOVE RPM	EA		3
RPLXW	REMOVE PLASTIC STRIPE	SF		60
RPM11	TYPE 2W RPM	EA	10	10

CITY OF KIRKLAND
DEPARTMENT OF PUBLIC WORKS
123 FIFTH AVENUE KIRKLAND, WA 98033
(425) 587-3800 www.kirklandwa.gov

D.GRILLEY 1/2000
DESIGNED BY: DATE

J.JENNINGS 1/2000
DRAWN BY: DATE

CHECKED BY: DATE

2022 PAVEMENT MARKING PROGRAM

STREET: 132ND AVE NE

CROSS STREET: NE 113TH ST

SEGMENT:

SCALE: N.T.S.

FILENAME: Page 9-15

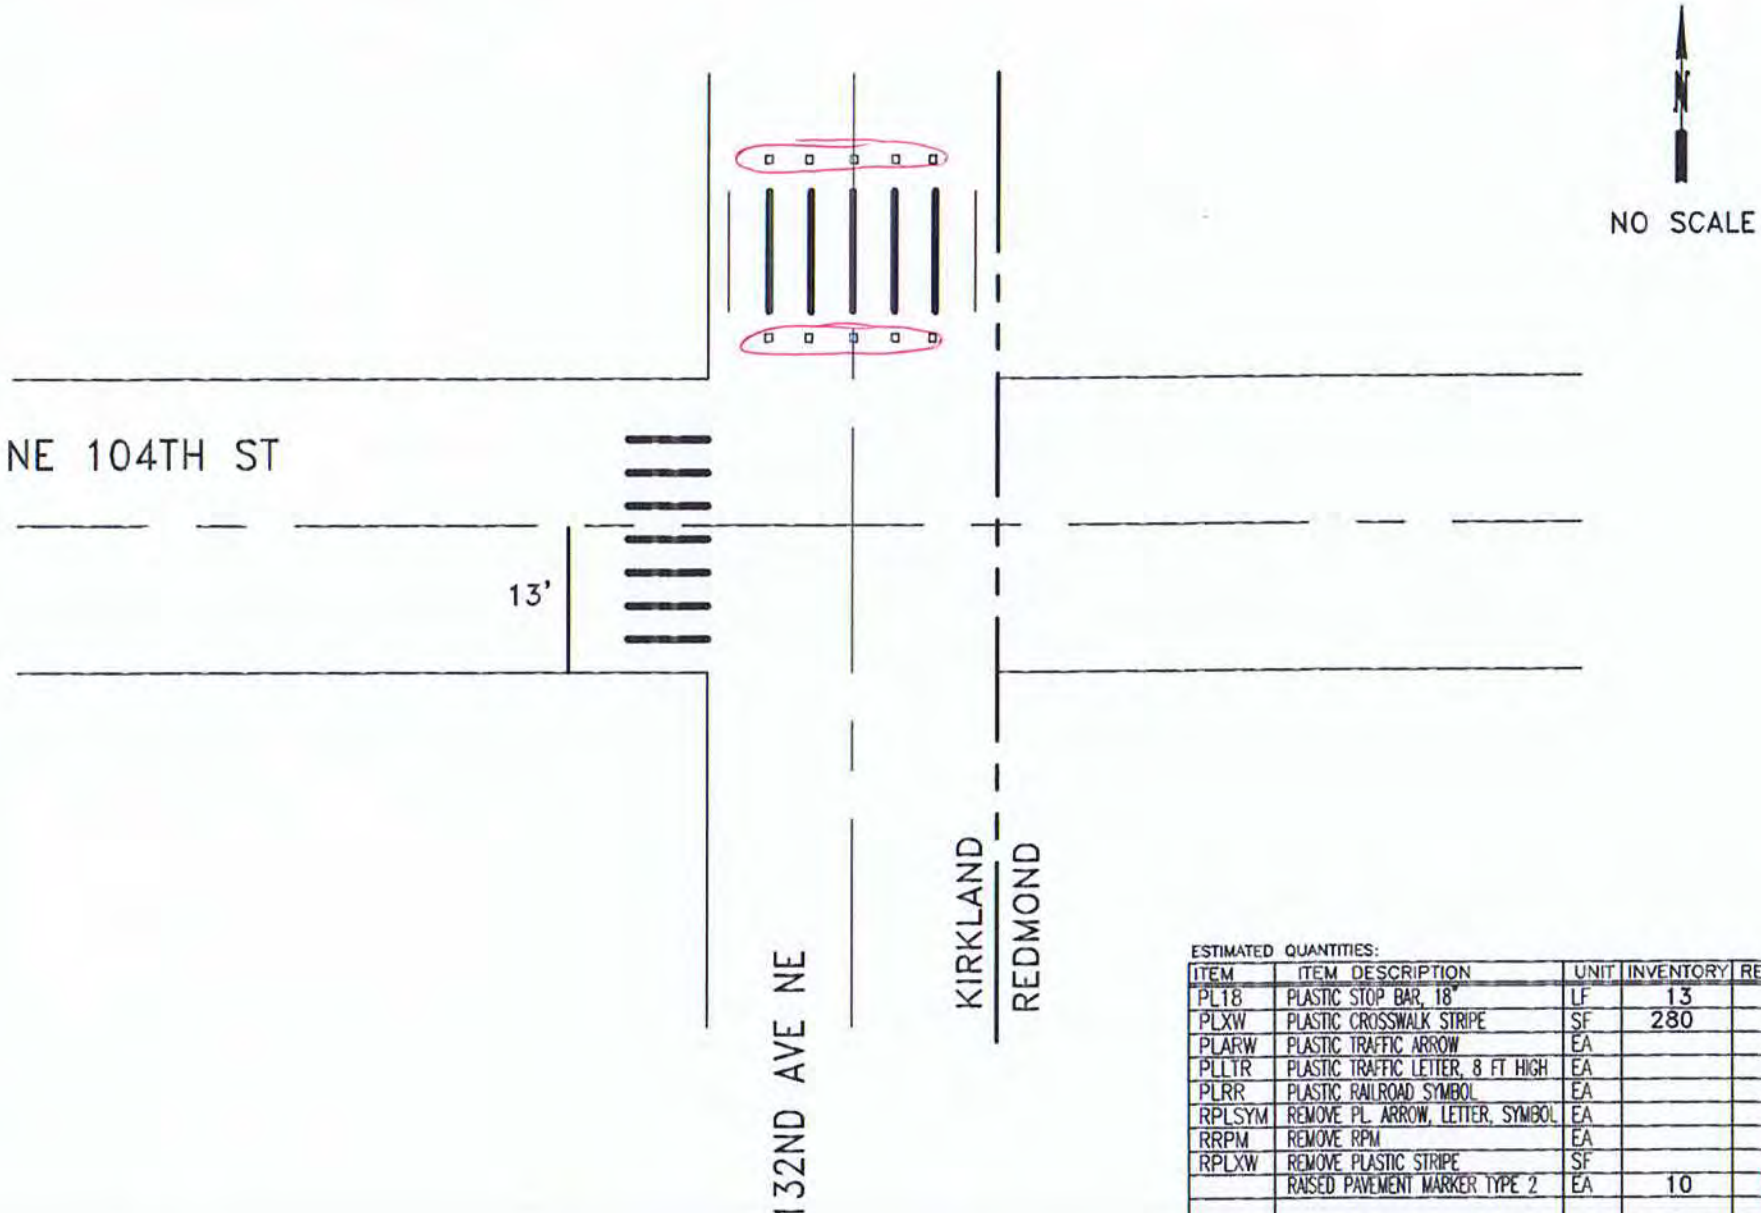

ESTIMATED QUANTITIES:

ITEM	ITEM DESCRIPTION	UNIT	INVENTORY	REPAIR QTY
PL18	PLASTIC STOP BAR, 18"	LF	13	
PLXW	PLASTIC CROSSWALK STRIPE	SF	280	
PLARW	PLASTIC TRAFFIC ARROW	EA		
PLLTR	PLASTIC TRAFFIC LETTER, 8 FT HIGH	EA		
PLRR	PLASTIC RAILROAD SYMBOL	EA		
RPLSYM	REMOVE PL. ARROW, LETTER, SYMBOL	EA		
RRPM	REMOVE RPM	EA		5
RPLXW	REMOVE PLASTIC STRIPE	SF		
	RAISED PAVEMENT MARKER TYPE 2	EA	10	10

CITY OF KIRKLAND
DEPARTMENT OF PUBLIC WORKS
123 FIFTH AVENUE KIRKLAND, WA 98033
(425) 587-3800 www.kirklandwa.gov

G. HORTILLOSA 2/2011
DESIGNED BY: DATE

J.JENNINGS 2/2011
DRAWN BY: DATE

CHECKED BY: DATE

2020 PAVEMENT MARKING PROGRAM

STREET: 132ND AVE NE

CROSS STREET: NE 104TH ST

SEGMENT:

SCALE: N.T.S.

FILENAME:

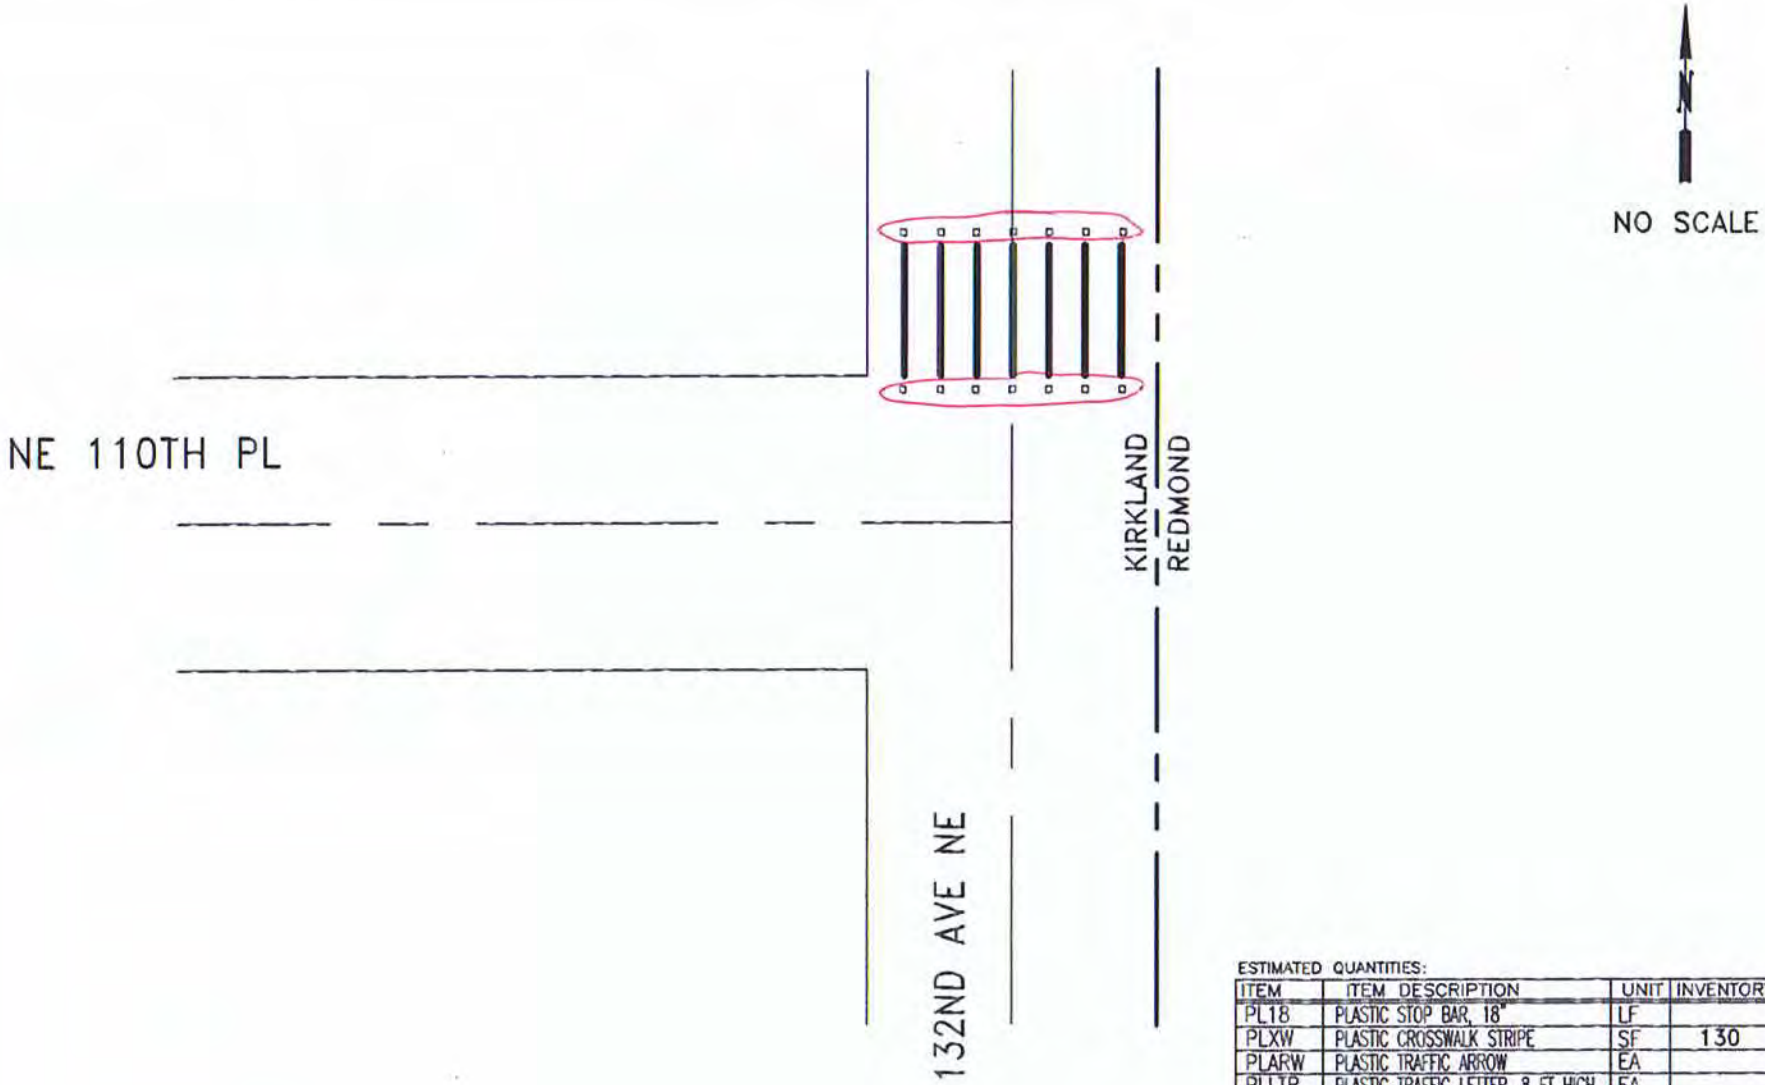

ESTIMATED QUANTITIES:

ITEM	ITEM DESCRIPTION	UNIT	INVENTORY	REPAIR QTY
PL18	PLASTIC STOP BAR, 18"	LF		
PLXW	PLASTIC CROSSWALK STRIPE	SF	130	
PLARW	PLASTIC TRAFFIC ARROW	EA		
PLLTR	PLASTIC TRAFFIC LETTER, 8 FT HIGH	EA		
PLRR	PLASTIC RAILROAD SYMBOL	EA		
RPLSYM	REMOVE PL. ARROW, LETTER, SYMBOL	EA		
RRPM	REMOVE RPM	EA		12
RPLXW	REMOVE PLASTIC STRIPE	SF		
RPM11	TYPE 2W RPM	EA	14	14

CITY OF KIRKLAND
DEPARTMENT OF PUBLIC WORKS
123 FIFTH AVENUE KIRKLAND, WA 98033
(425) 587-3800 www.kirklandwa.gov

S. GONSAR 1/2020
DESIGNED BY: DATE

J.JENNINGS 1/2020
DRAWN BY: DATE

CHECKED BY: DATE

2022 PAVEMENT MARKING PROGRAM

STREET: 132ND AVE NE

CROSS STREET: NE 110TH PL

SEGMENT:

SCALE: N.T.S.

FILENAME:

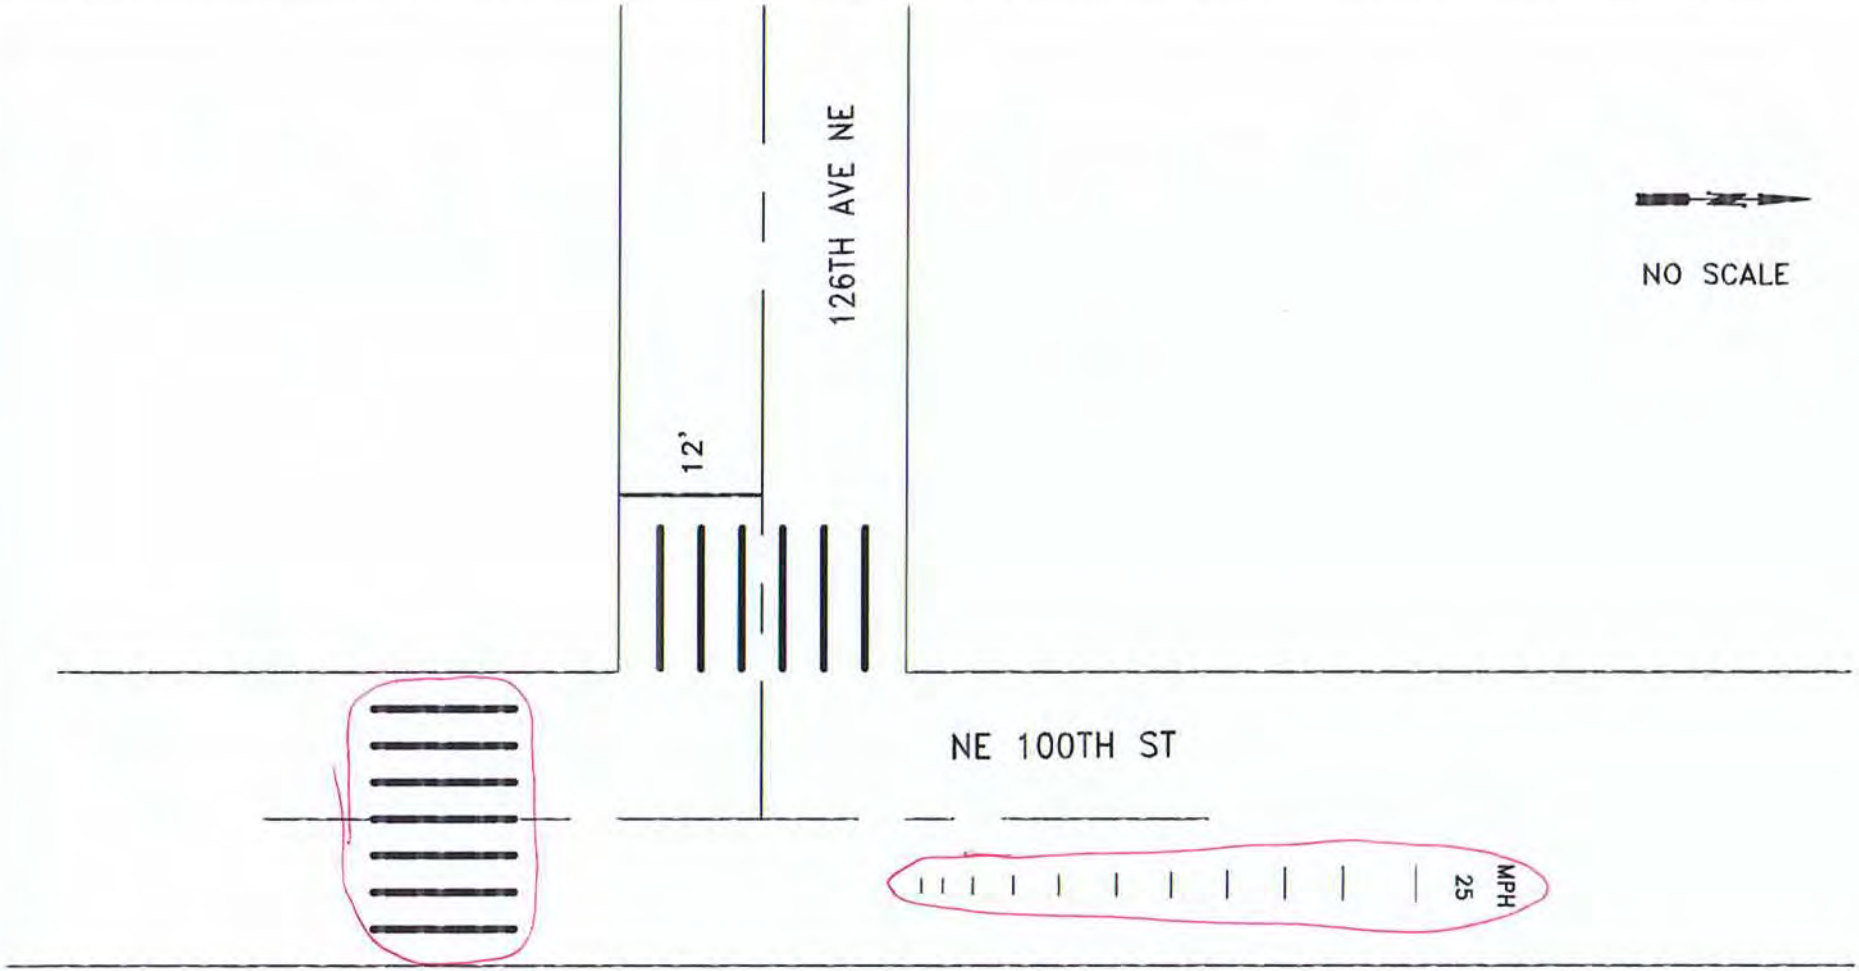

ESTIMATED QUANTITIES:

ITEM	ITEM DESCRIPTION	UNIT	INVENTORY	REPAIR QTY
PL18	PLASTIC STOP BAR, 18"	LF	12	
PLXW	PLASTIC CROSSWALK STRIPE	SF	260	140
PLARW	PLASTIC TRAFFIC ARROW	EA		
PLLTR	PLASTIC TRAFFIC LETTER, 8 FT HIGH	EA	5	5
PLRR	PLASTIC RAILROAD SYMBOL	EA		
RPLSYM	REMOVE PL. ARROW, LETTER, SYMBOL	EA		
RRPM	REMOVE RPM	EA		
RPLXW	REMOVE PLASTIC STRIPE	SF		
PLLGD	PLASTIC SPEED LEGEND BARS	SF	62	62

CITY OF KIRKLAND
DEPARTMENT OF PUBLIC WORKS
123 FIFTH AVENUE KIRKLAND, WA 98033
(425) 587-3800 www.kirklandwa.gov

G. HORTILLOSA 11/2008
DESIGNED BY: DATE

J.JENNINGS 11/2008
DRAWN BY: DATE

CHECKED BY: DATE

2020 PAVEMENT MARKING PROGRAM

STREET: 126TH AVE NE

CROSS STREET: NE 100TH ST

SEGMENT:

SCALE: N.T.S.

FILENAME: Page 9-20

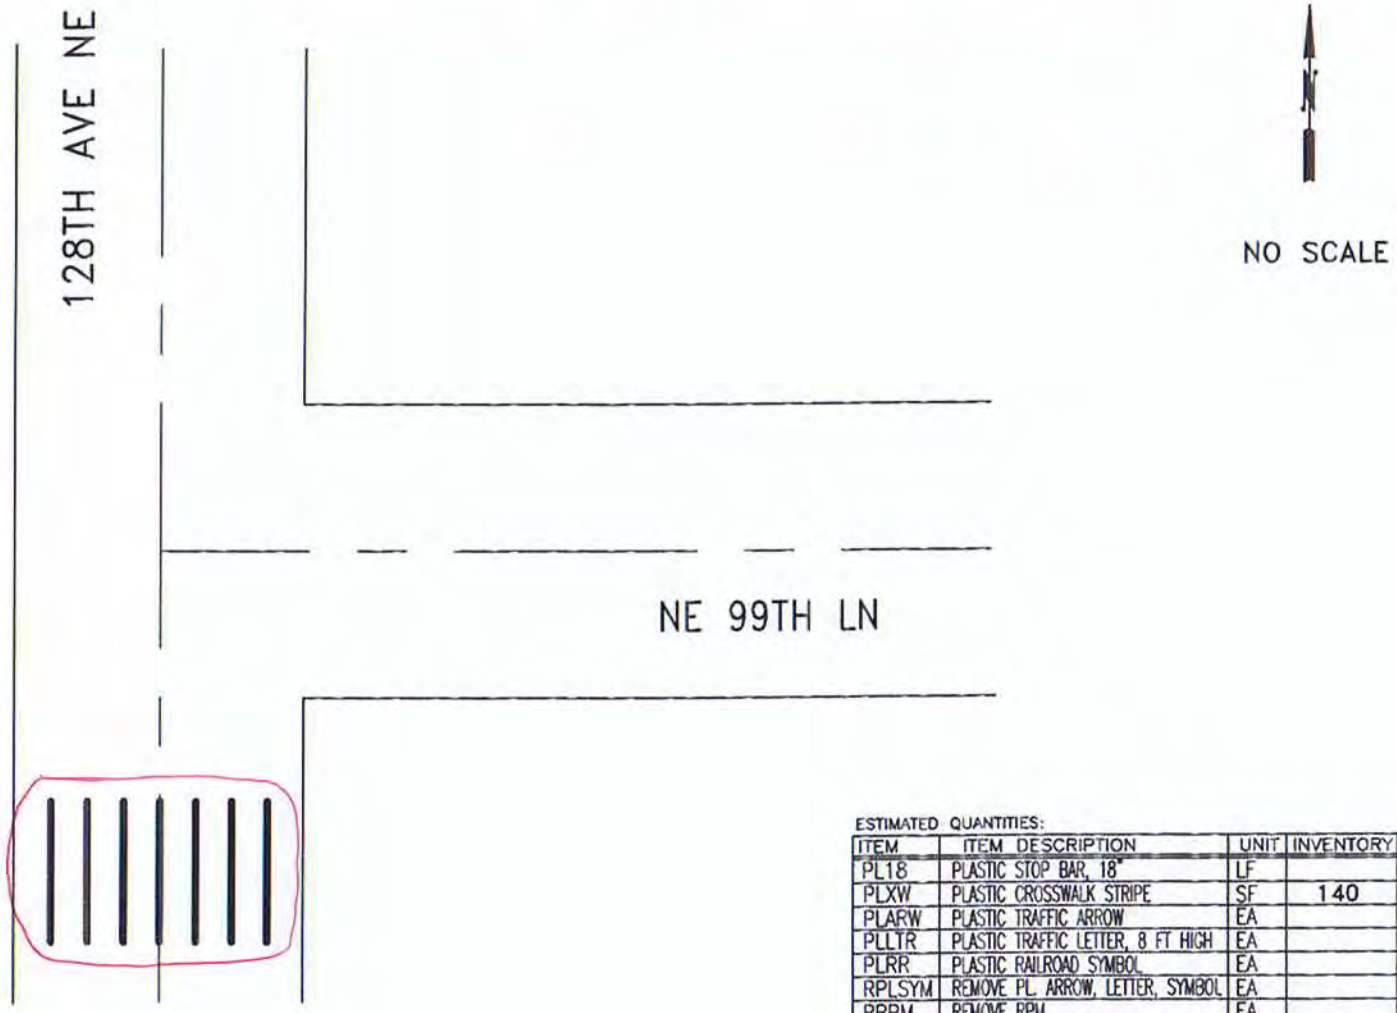

ESTIMATED QUANTITIES:

ITEM	ITEM DESCRIPTION	UNIT	INVENTORY	REPAIR QTY
PL18	PLASTIC STOP BAR, 18"	LF		
PLXW	PLASTIC CROSSWALK STRIPE	SF	140	140
PLARW	PLASTIC TRAFFIC ARROW	EA		
PLLTR	PLASTIC TRAFFIC LETTER, 8 FT HIGH	EA		
PLRR	PLASTIC RAILROAD SYMBOL	EA		
RPLSYM	REMOVE PL. ARROW, LETTER, SYMBOL	EA		
RRPM	REMOVE RPM	EA		
RPLXW	REMOVE PLASTIC STRIPE	SF		140

CITY OF KIRKLAND
DEPARTMENT OF PUBLIC WORKS
123 FIFTH AVENUE KIRKLAND, WA 98033
(425) 587-3800 www.kirklandwa.gov

D.GRILLEY 1/2000
DESIGNED BY: DATE

J.JENNINGS 1/2000
DRAWN BY: DATE

CHECKED BY: DATE

2020 PAVEMENT MARKING PROGRAM

STREET: 128TH AVE NE

CROSS STREET: NE 99TH LN

SEGMENT:

SCALE: N.T.S.

FILENAME:

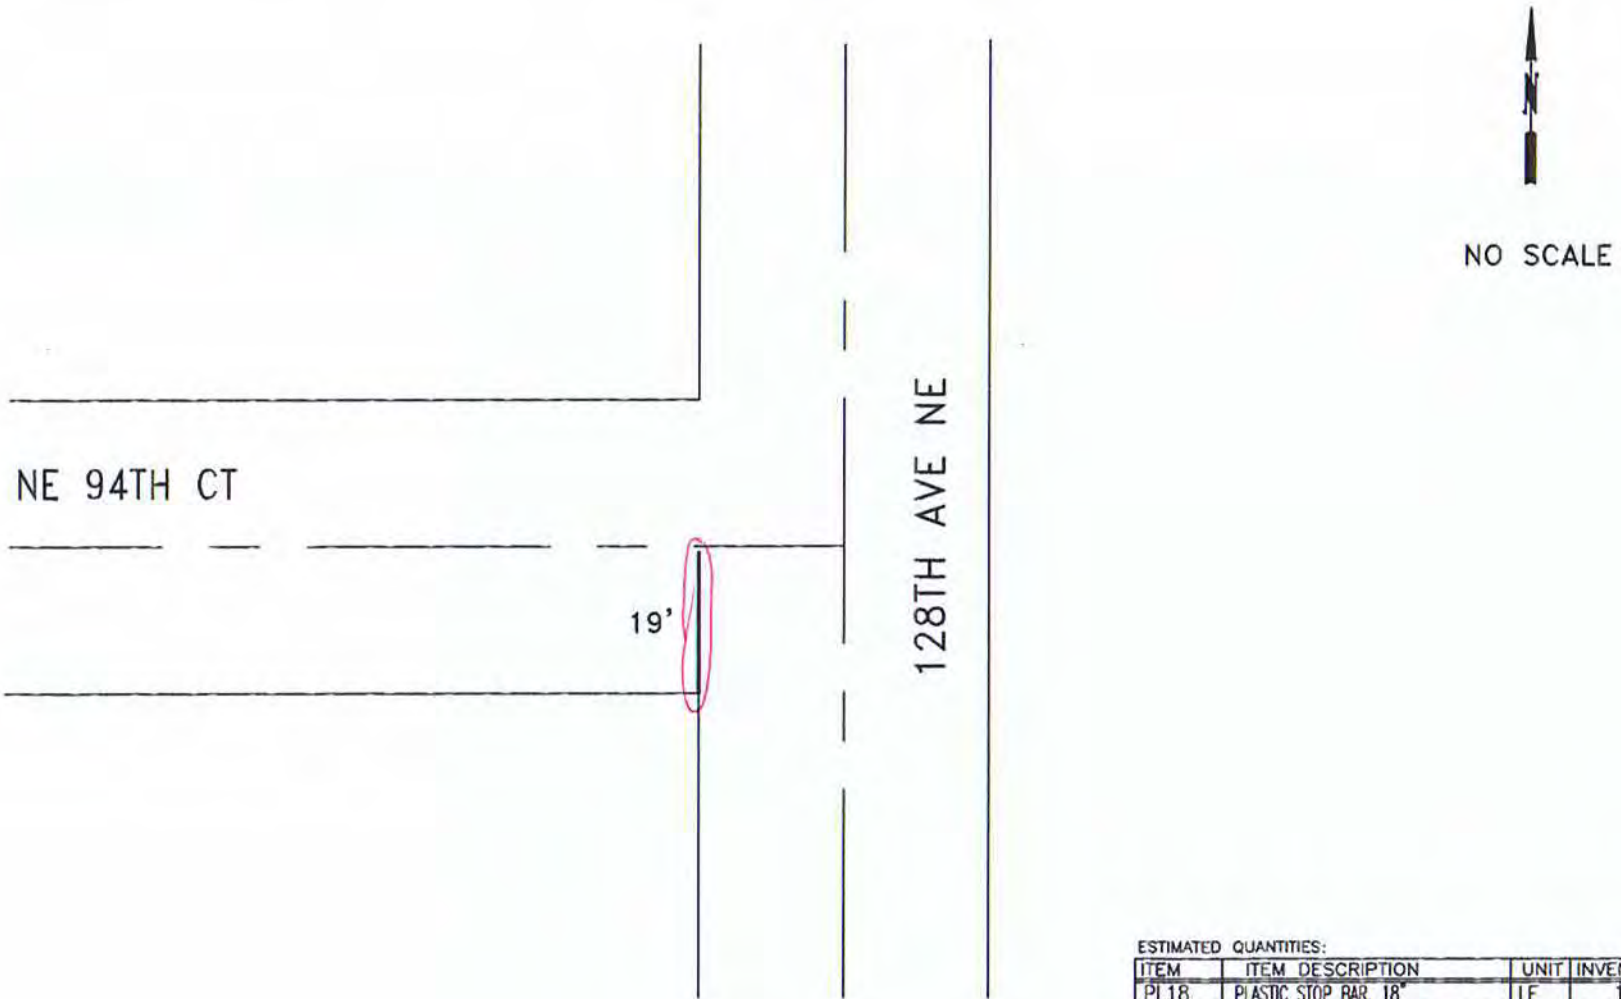

ESTIMATED QUANTITIES:

ITEM	ITEM DESCRIPTION	UNIT	INVENTORY	REPAIR QTY
PL18	PLASTIC STOP BAR, 18"	LF	19	19
PLXW	PLASTIC CROSSWALK STRIPE	SF		
PLARW	PLASTIC TRAFFIC ARROW	EA		
PLLTR	PLASTIC TRAFFIC LETTER, 8 FT HIGH	EA		
PLRR	PLASTIC RAILROAD SYMBOL	EA		
RPLSYM	REMOVE PL. ARROW, LETTER, SYMBOL	EA		
RRPM	REMOVE RPM	EA		
RPLXW	REMOVE PLASTIC STRIPE	SF		30

CITY OF KIRKLAND
DEPARTMENT OF PUBLIC WORKS
123 FIFTH AVENUE KIRKLAND, WA 98033
(425) 587-3800 www.kirklandwa.gov

D.GRILLEY 1/2000
DESIGNED BY: DATE

J.JENNINGS 1/2000
DRAWN BY: DATE

CHECKED BY: DATE

2020 PAVEMENT MARKING PROGRAM

STREET: 128TH AVE NE

CROSS STREET: NE 94TH CT

SEGMENT:

SCALE: N.T.S.

FILENAME:

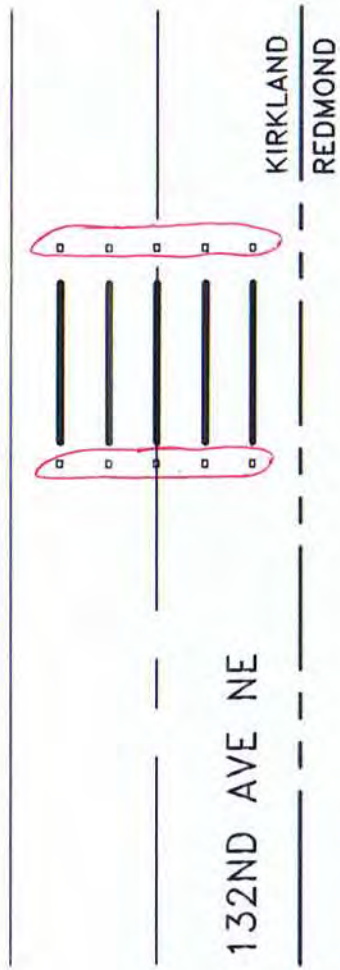

NO SCALE

ESTIMATED QUANTITIES:

ITEM	ITEM DESCRIPTION	UNIT	INVENTORY	REPAIR QTY
PL18	PLASTIC STOP BAR, 18"	LF		
PLXW	PLASTIC CROSSWALK STRIPE	SF	100	
PLARW	PLASTIC TRAFFIC ARROW	EA		
PLLTR	PLASTIC TRAFFIC LETTER, 8 FT HIGH	EA		
PLRR	PLASTIC RAILROAD SYMBOL	EA		
RPLSYM	REMOVE PL. ARROW, LETTER, SYMBOL	EA		
RRPM	REMOVE RPM	EA		3
RPLXW	REMOVE PLASTIC STRIPE	SF		
RPM11	TYPE 2W RPM	EA	10	10

CITY OF KIRKLAND
DEPARTMENT OF PUBLIC WORKS
123 FIFTH AVENUE KIRKLAND, WA 98033
(425) 587-3800 www.kirklandwa.gov

D.GRILLEY 1/2000
DESIGNED BY: DATE

J.JENNINGS 1/2000
DRAWN BY: DATE

CHECKED BY: DATE

2000 PAVEMENT MARKING PROGRAM

STREET: 132ND AVE NE

CROSS STREET: NE 106TH BLOCK

SEGMENT:

SCALE: N.T.S.

FILENAME: Page 9-24

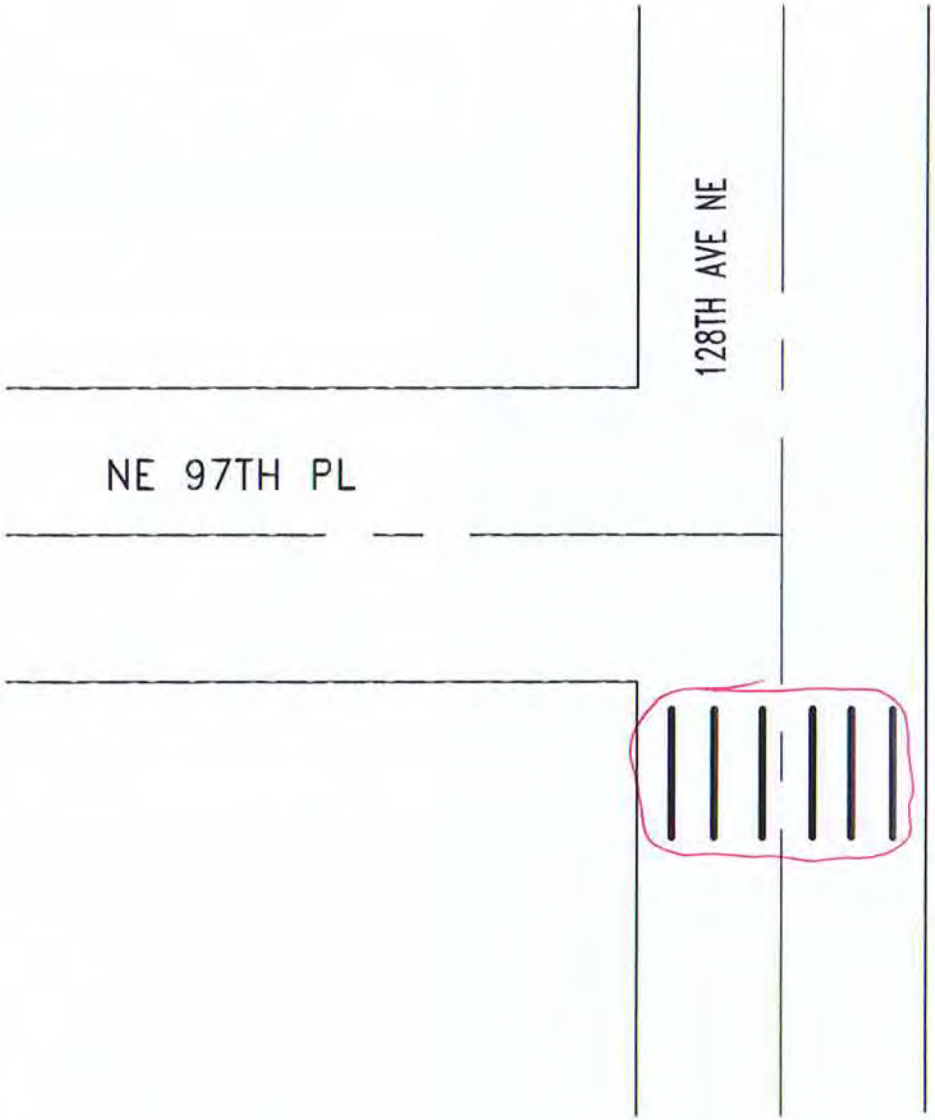

NO SCALE

MARK TWAIN ELEMENTARY

ESTIMATED QUANTITIES:

ITEM	ITEM DESCRIPTION	UNIT	INVENTORY	REPAIR QTY
PL18	PLASTIC STOP BAR, 18"	LF		
PLXW	PLASTIC CROSSWALK STRIPE	SF	120	120
PLARW	PLASTIC TRAFFIC ARROW	EA		
PLLTR	PLASTIC TRAFFIC LETTER, 8 FT HIGH	EA		
PLRR	PLASTIC RAILROAD SYMBOL	EA		
RPLSYM	REMOVE PL. ARROW, LETTER, SYMBOL	EA		
RRPM	REMOVE RPM	EA		
RPLXW	REMOVE PLASTIC STRIPE	SF		

CITY OF KIRKLAND
DEPARTMENT OF PUBLIC WORKS
123 FIFTH AVENUE KIRKLAND, WA 98033

D.GRILLEY 1/2000
DESIGNED BY: DATE

J.JENNINGS 1/2000
DRAWN BY: DATE

CHECKED BY: DATE

2020 PAVEMENT MARKING PROGRAM

STREET: 128TH AVE NE

CROSS STREET: NE 97TH PL

SEGMENT:

SCALE: N.T.S.

FILENAME: Page 9-27

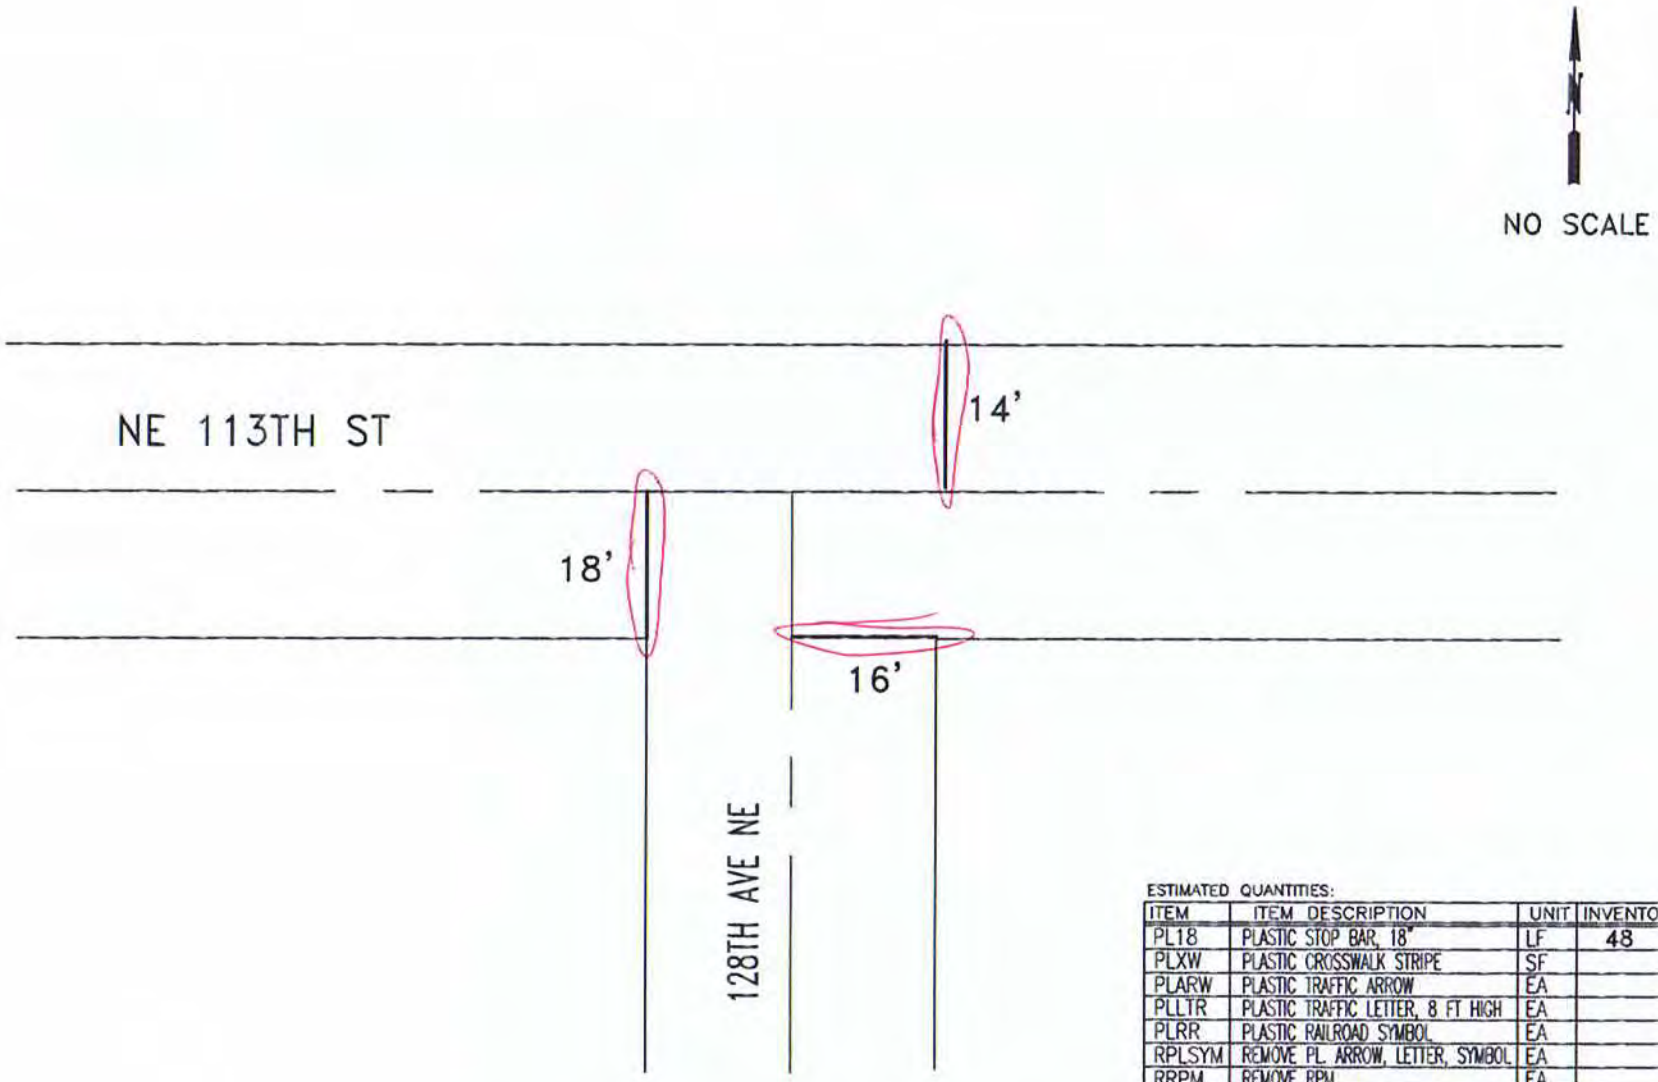

ESTIMATED QUANTITIES:

ITEM	ITEM DESCRIPTION	UNIT	INVENTORY	REPAIR QTY
PL18	PLASTIC STOP BAR, 18"	LF	48	AB
PLXW	PLASTIC CROSSWALK STRIPE	SF		
PLARW	PLASTIC TRAFFIC ARROW	EA		
PLLTR	PLASTIC TRAFFIC LETTER, 8 FT HIGH	EA		
PLRR	PLASTIC RAILROAD SYMBOL	EA		
RPLSYM	REMOVE PL. ARROW, LETTER, SYMBOL	EA		
RRPM	REMOVE RPM	EA		
RPLXW	REMOVE PLASTIC STRIPE	SF		

CITY OF KIRKLAND
DEPARTMENT OF PUBLIC WORKS
123 FIFTH AVENUE KIRKLAND, WA 98033
(425) 587-3800 www.kirklandwa.gov

R STEITZER 10/2003
DESIGNED BY: DATE

J.JENNINGS 10/2003
DRAWN BY: DATE

CHECKED BY: DATE

2022 PAVEMENT MARKING PROGRAM

STREET: 128TH AVE NE

CROSS STREET: NE 113TH ST

SEGMENT:

SCALE: N.T.S.

FILENAME:

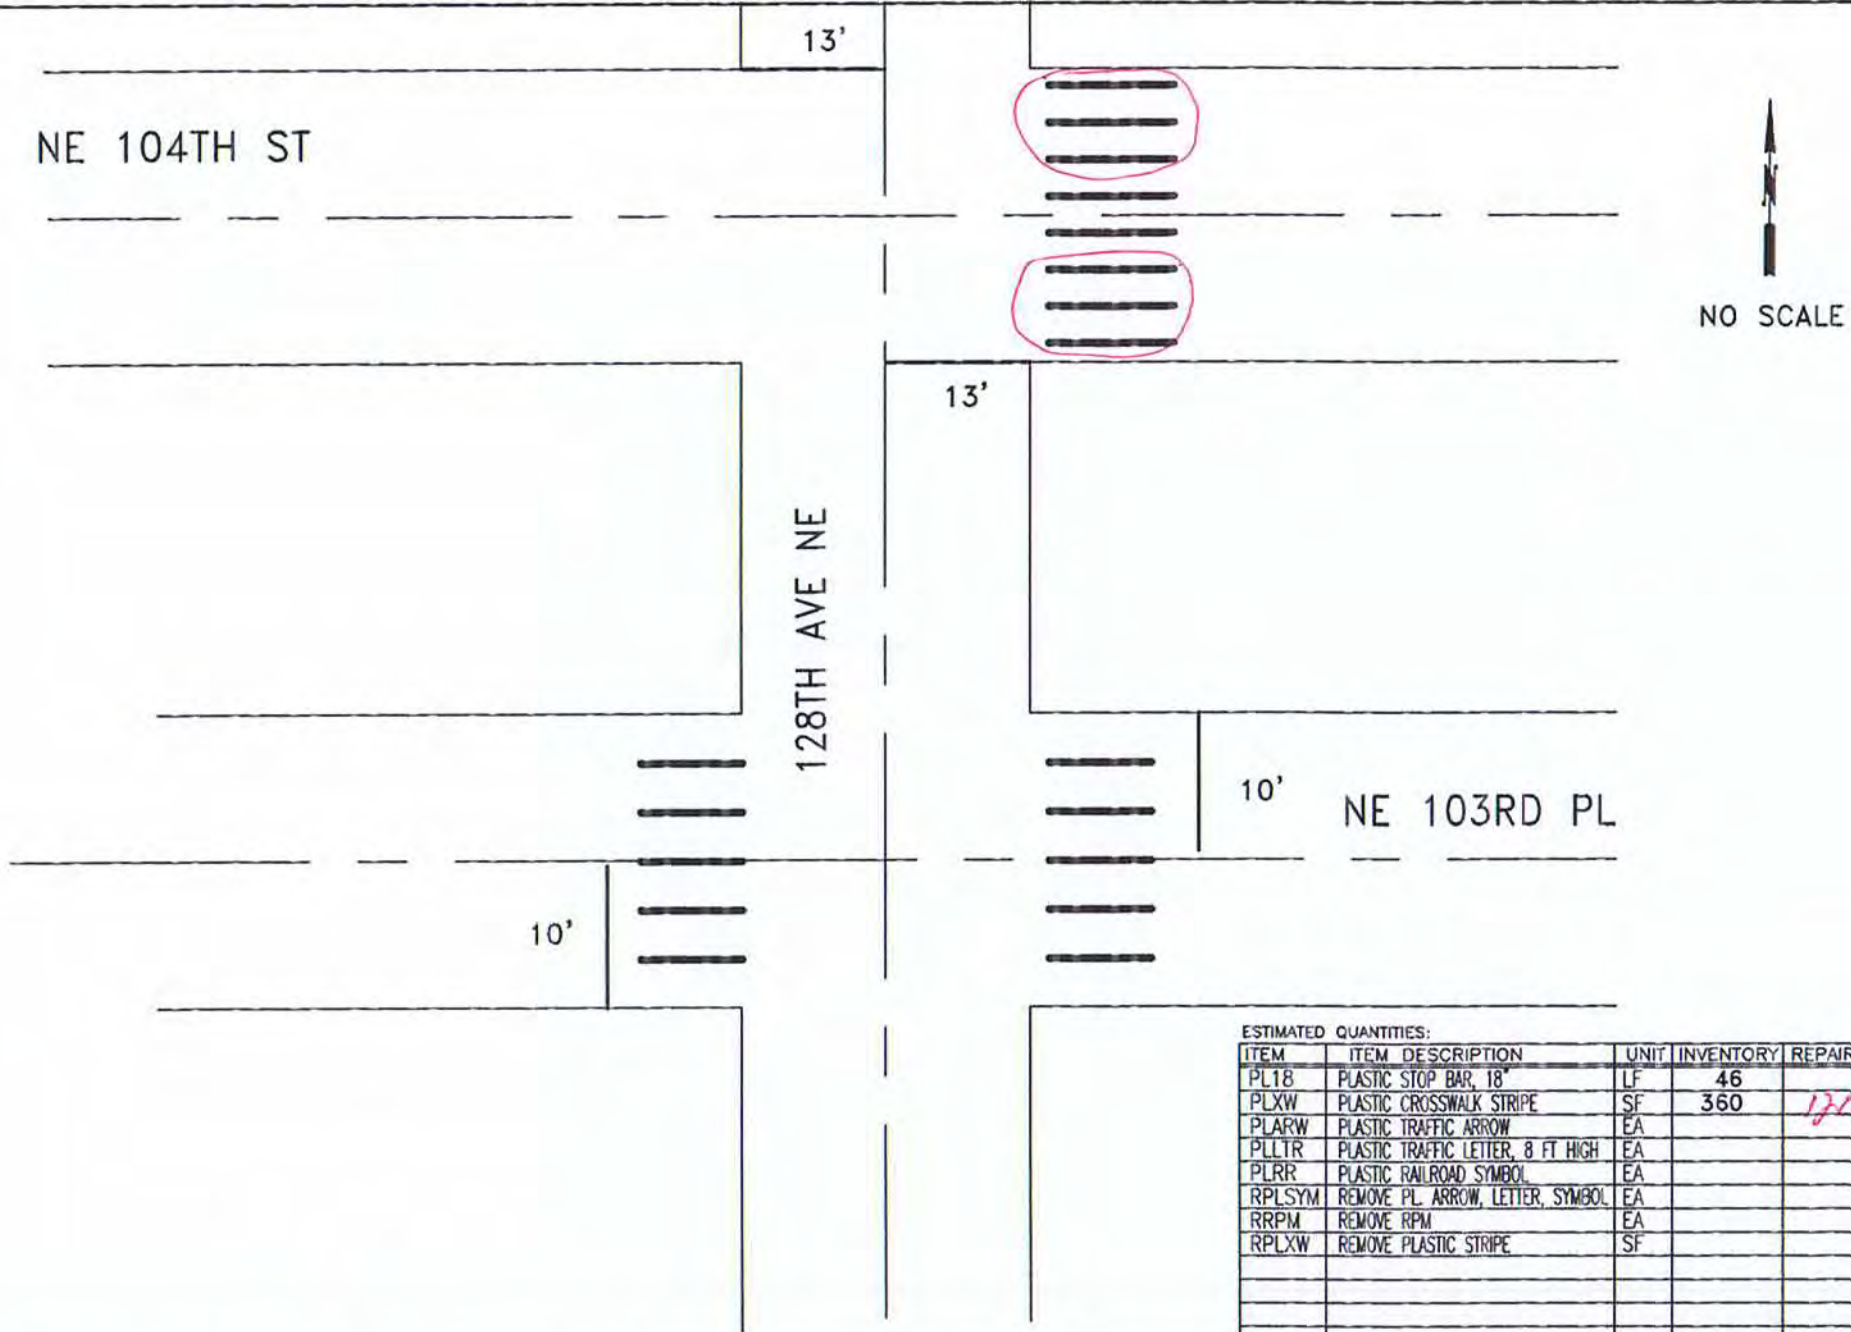

ESTIMATED QUANTITIES:

ITEM	ITEM DESCRIPTION	UNIT	INVENTORY	REPAIR QTY
PL18	PLASTIC STOP BAR, 18"	LF	46	
PLXW	PLASTIC CROSSWALK STRIPE	SF	360	120
PLARW	PLASTIC TRAFFIC ARROW	EA		
PLLTR	PLASTIC TRAFFIC LETTER, 8 FT HIGH	EA		
PLRR	PLASTIC RAILROAD SYMBOL	EA		
RPLSYM	REMOVE PL. ARROW, LETTER, SYMBOL	EA		
RRPM	REMOVE RPM	EA		
RPLXW	REMOVE PLASTIC STRIPE	SF		

CITY OF KIRKLAND
DEPARTMENT OF PUBLIC WORKS
123 FIFTH AVENUE KIRKLAND, WA 98033
(425) 587-3800 www.kirklandwa.gov

R STEITZER 4/2004
DESIGNED BY: DATE

J.JENNINGS 4/2004
DRAWN BY: DATE

CHECKED BY: DATE

2020 PAVEMENT MARKING PROGRAM

STREET: NE 104TH ST

CROSS STREET: 128TH AVE NE

SEGMENT:

SCALE: N.T.S.

FILENAME: Page 9-29

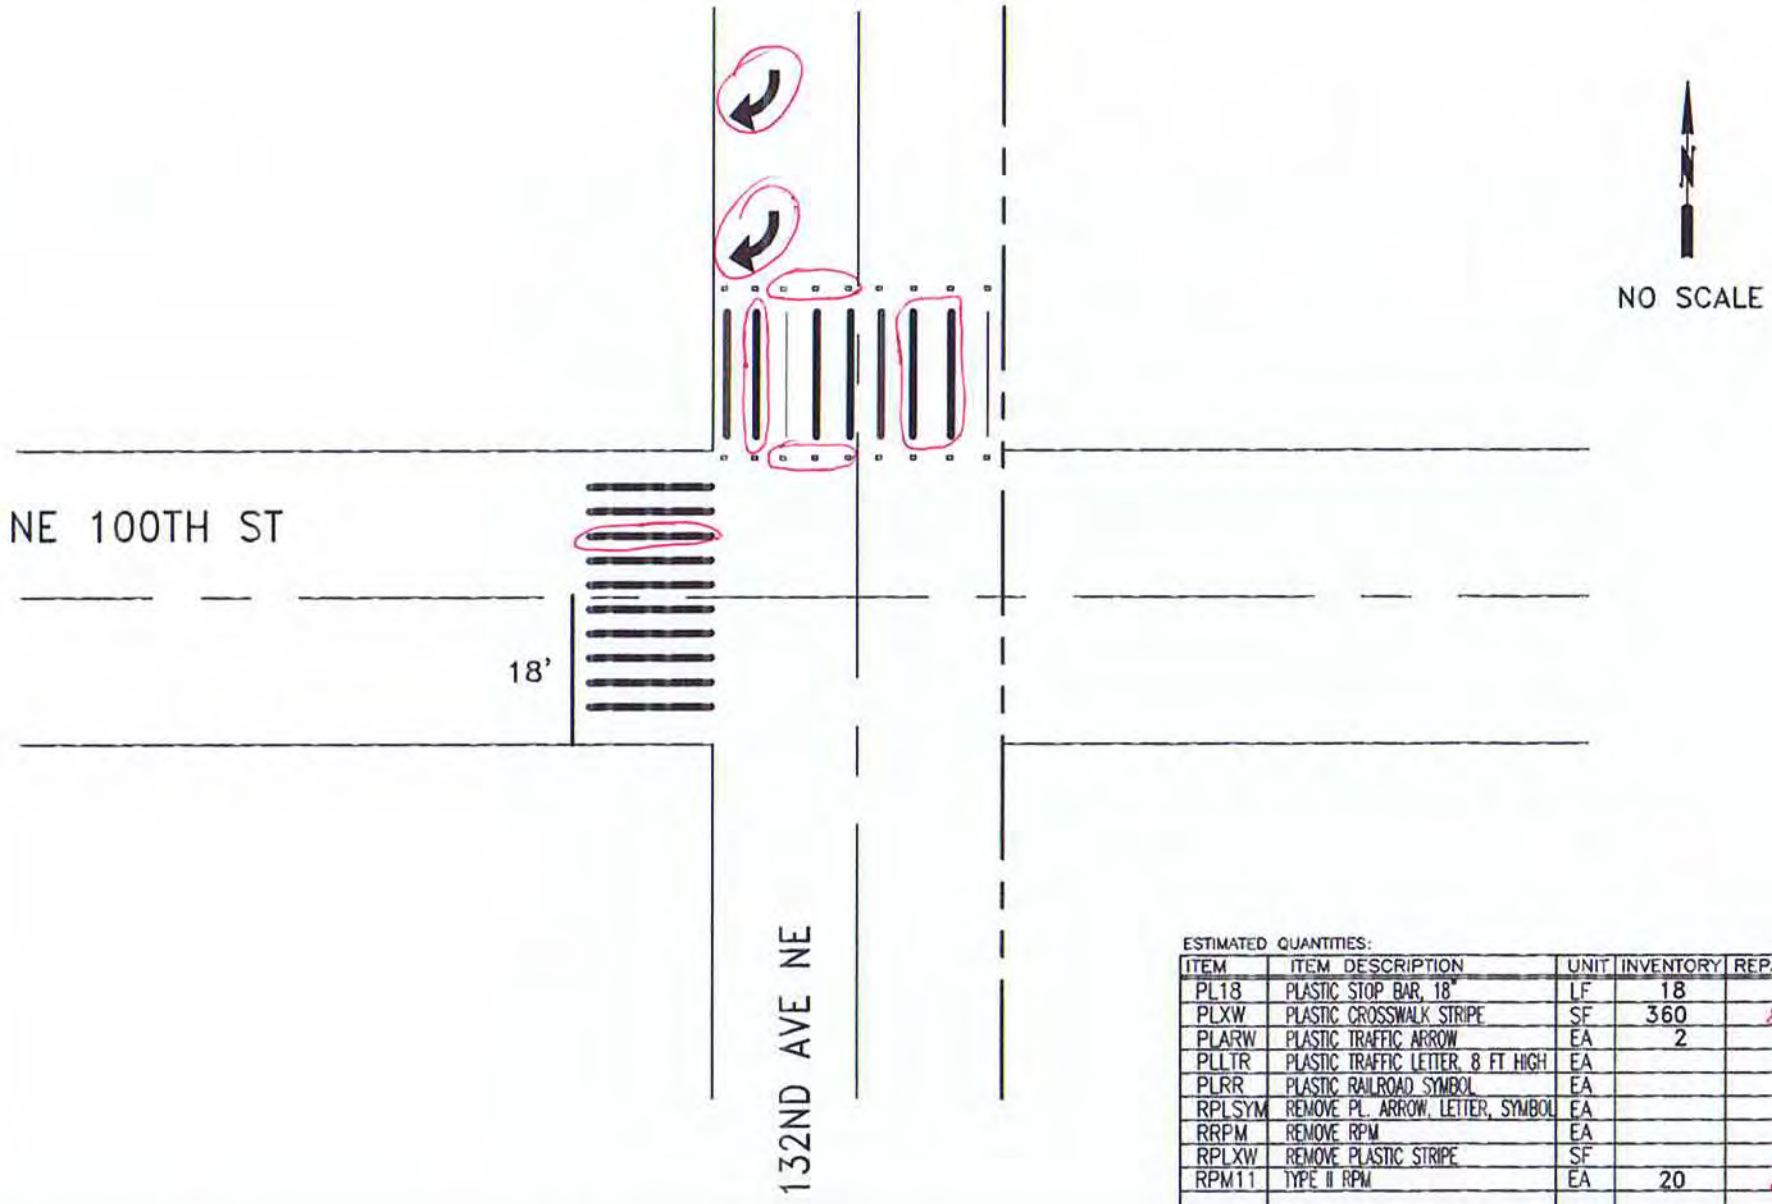

ESTIMATED QUANTITIES:

ITEM	ITEM DESCRIPTION	UNIT	INVENTORY	REPAIR QTY
PL18	PLASTIC STOP BAR, 18"	LF	18	
PLXW	PLASTIC CROSSWALK STRIPE	SF	360	20
PLARW	PLASTIC TRAFFIC ARROW	EA	2	2
PLLTR	PLASTIC TRAFFIC LETTER, 8 FT HIGH	EA		
PLRR	PLASTIC RAILROAD SYMBOL	EA		
RPLSYM	REMOVE PL. ARROW, LETTER, SYMBOL	EA		
RRPM	REMOVE RPM	EA		2
RPLXW	REMOVE PLASTIC STRIPE	SF		
RPM11	TYPE II RPM	EA	20	6

CITY OF KIRKLAND
DEPARTMENT OF PUBLIC WORKS
123 FIFTH AVENUE KIRKLAND, WA 98033
(425) 587-3800 www.kirklandwa.gov

D.GRILLEY 1/2000
DESIGNED BY: DATE

J.JENNINGS 1/2000
DRAWN BY: DATE

CHECKED BY: DATE

2020 PAVEMENT MARKING PROGRAM

STREET: NE 100TH ST

CROSS STREET: 132ND AVE NE

SEGMENT:

SCALE: N.T.S.

FILENAME:

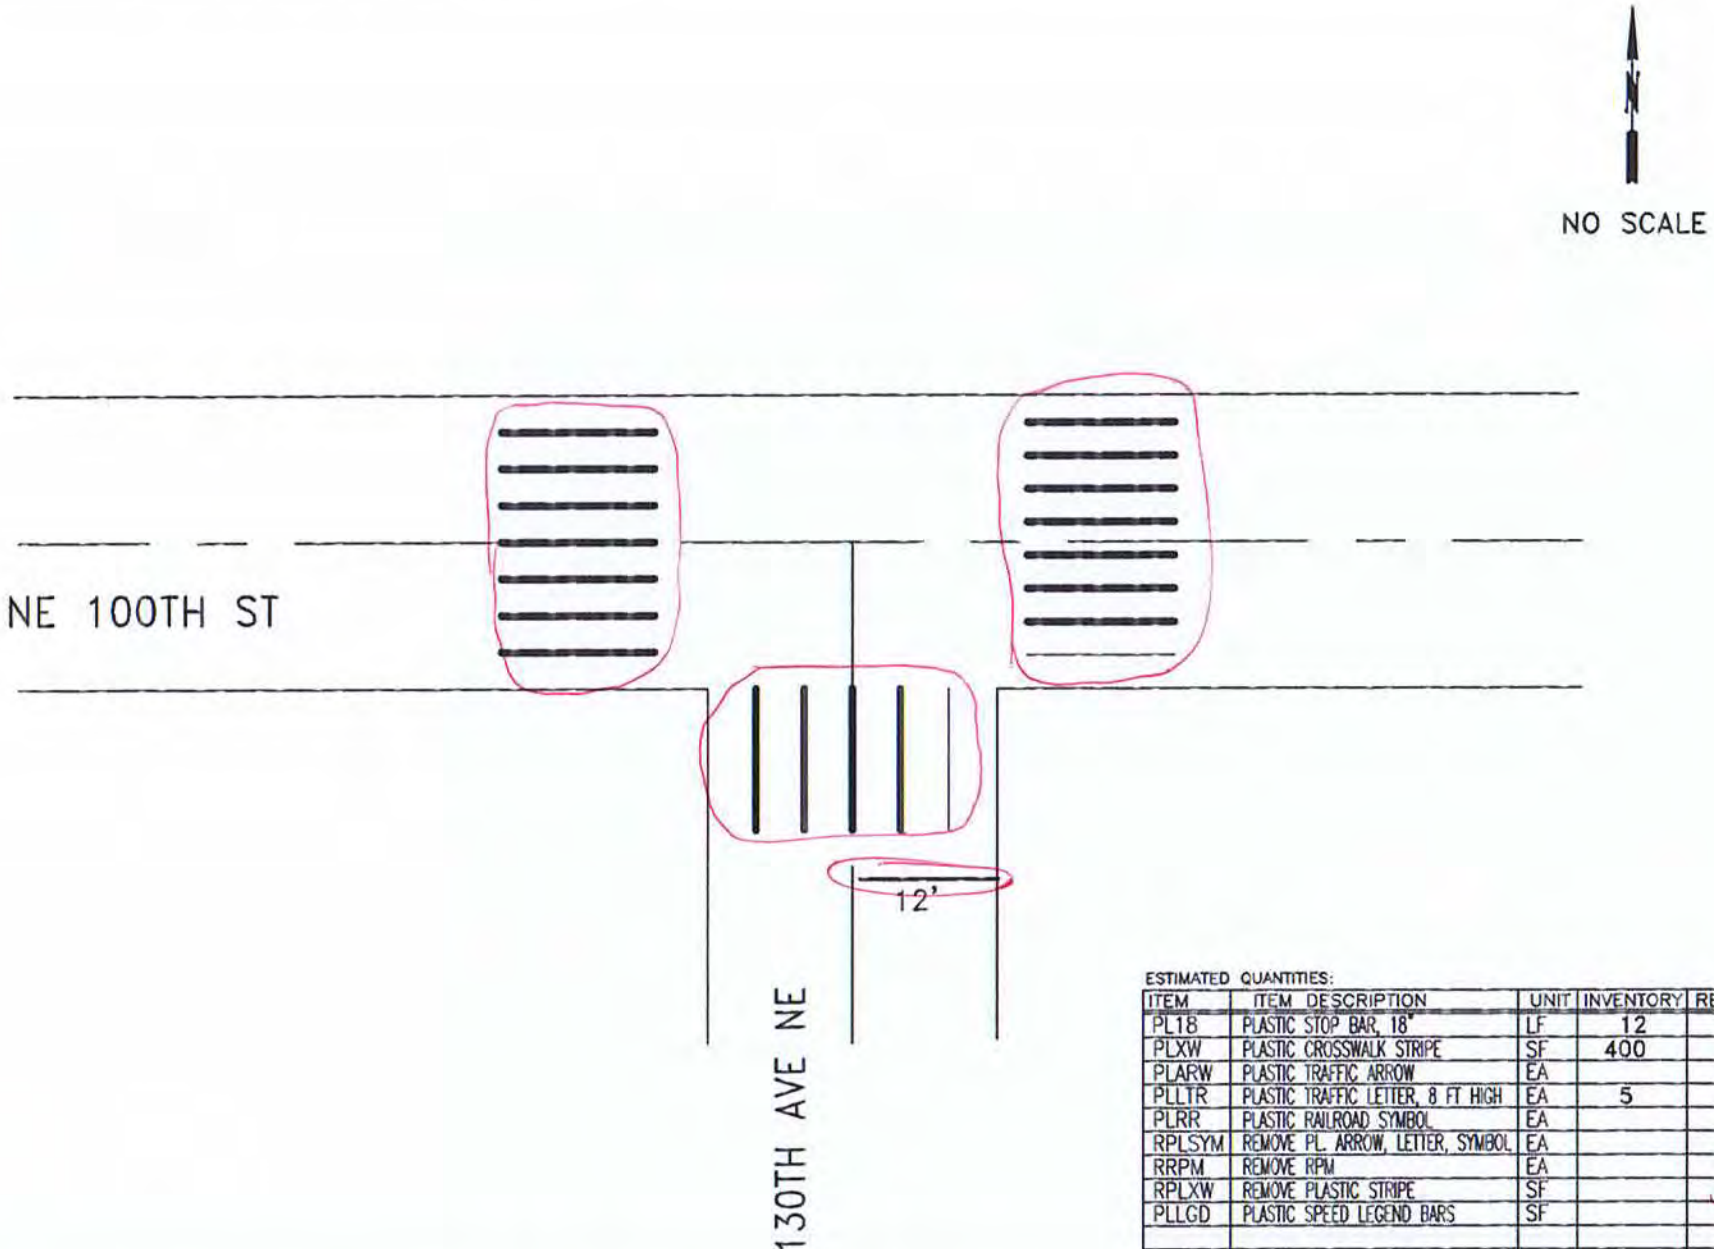

ESTIMATED QUANTITIES:

ITEM	ITEM DESCRIPTION	UNIT	INVENTORY	REPAIR QTY
PL18	PLASTIC STOP BAR, 18"	LF	12	12
PLXW	PLASTIC CROSSWALK STRIPE	SF	400	ADD
PLARW	PLASTIC TRAFFIC ARROW	EA		
PLLTR	PLASTIC TRAFFIC LETTER, 8 FT HIGH	EA	5	
PLRR	PLASTIC RAILROAD SYMBOL	EA		
RPLSYM	REMOVE PL. ARROW, LETTER, SYMBOL	EA		
RRPM	REMOVE RPM	EA		
RPLXW	REMOVE PLASTIC STRIPE	SF		340
PLLGD	PLASTIC SPEED LEGEND BARS	SF		

CITY OF KIRKLAND
DEPARTMENT OF PUBLIC WORKS
123 FIFTH AVENUE KIRKLAND, WA 98033
(425) 587-3800 www.kirklandwa.gov

G. HORTILLOSA 4/2008
DESIGNED BY: DATE

J.JENNINGS 4/2008
DRAWN BY: DATE

CHECKED BY: DATE

2020 PAVEMENT MARKING PROGRAM

STREET: NE 100TH ST

CROSS STREET: 130TH AVE NE

SEGMENT:

SCALE: N.T.S.

FILENAME: Page 9-32

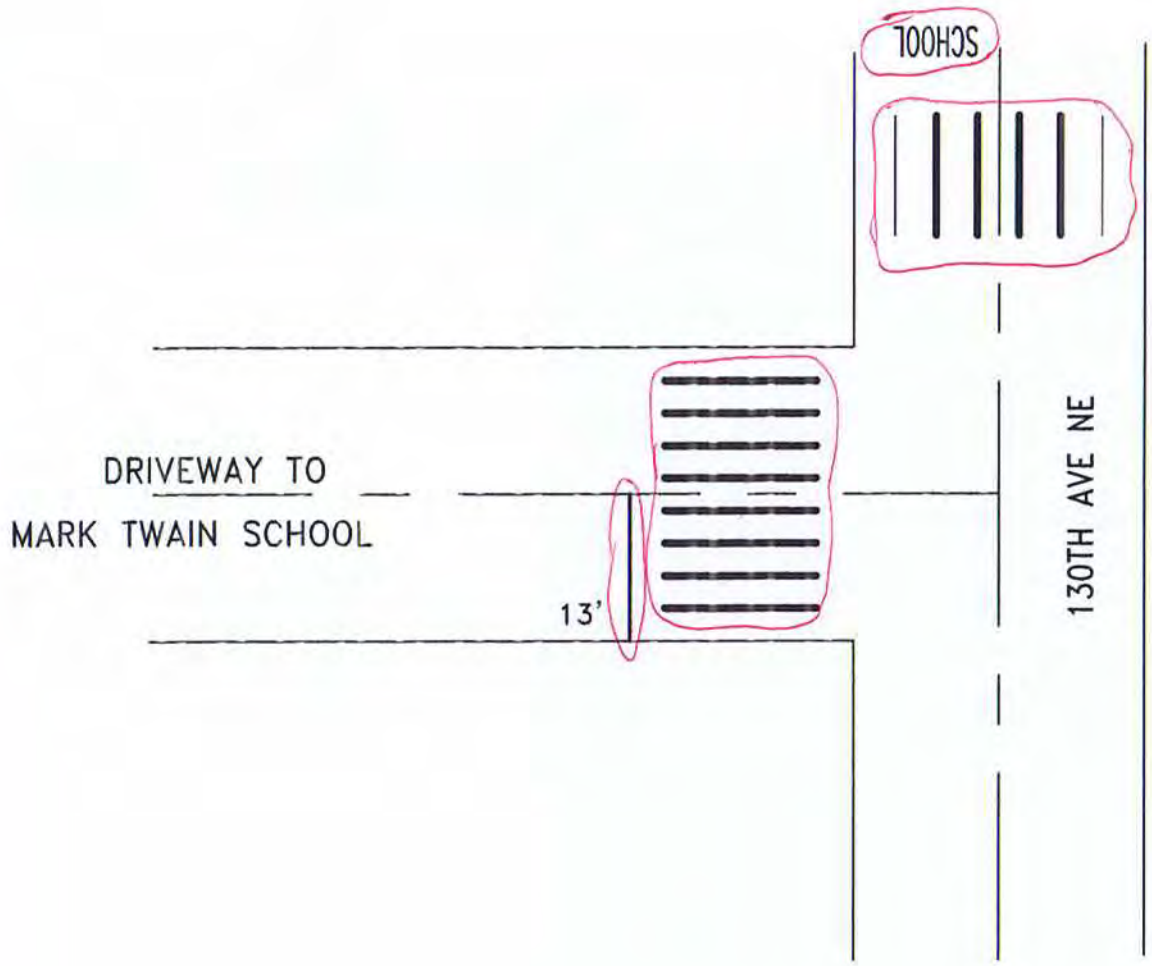

NO SCALE

ESTIMATED QUANTITIES:

ITEM	ITEM DESCRIPTION	UNIT	INVENTORY	REPAIR QTY
PL18	PLASTIC STOP BAR, 18"	LF	12	12
PLXW	PLASTIC CROSSWALK STRIPE	SF	260	260
PLARW	PLASTIC TRAFFIC ARROW	EA		
PLLTR	PLASTIC TRAFFIC LETTER, 8 FT HIGH	EA	6	6
PLRR	PLASTIC RAILROAD SYMBOL	EA		
RPLSYM	REMOVE PL. ARROW, LETTER, SYMBOL	EA		
RRPM	REMOVE RPM	EA		
RPLXW	REMOVE PLASTIC STRIPE	SF		200

CITY OF KIRKLAND
DEPARTMENT OF PUBLIC WORKS
123 FIFTH AVENUE KIRKLAND, WA 98033
(425) 587-3800 www.kirklandwa.gov

G. HORTILLOSA 3/2006
DESIGNED BY: DATE

J.JENNINGS 3/2006
DRAWN BY: DATE

CHECKED BY: DATE

20__ PAVEMENT MARKING PROGRAM

STREET: 130TH AVE NE

CROSS STREET: MARK TWAIN SCHOOL ENTRANCE

SEGMENT:

SCALE: N.T.S.

FILENAME: Page 9-33

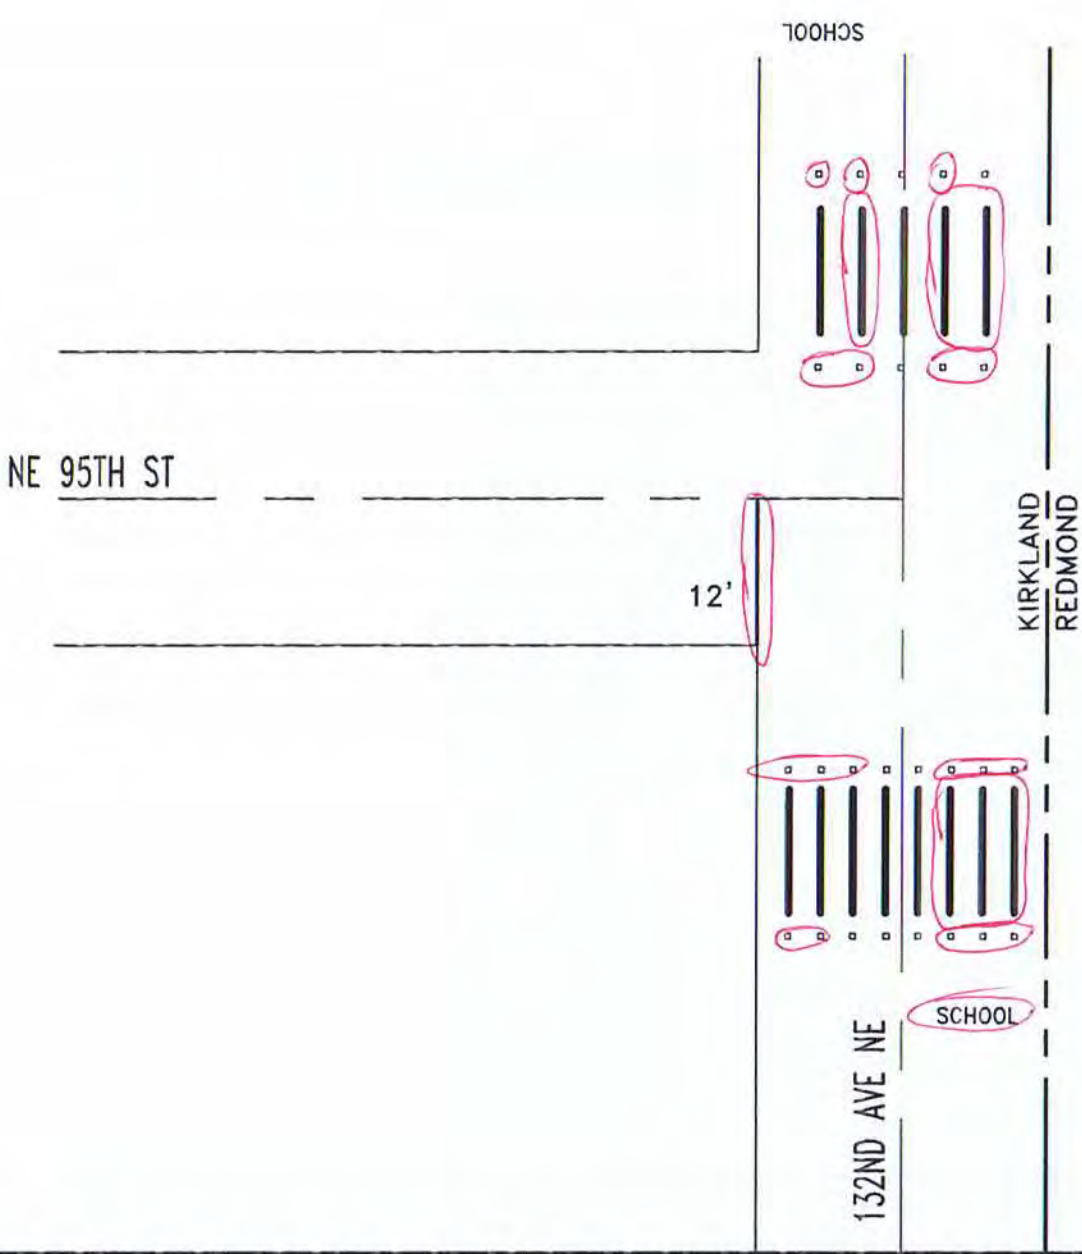

NO SCALE

ESTIMATED QUANTITIES:

ITEM	ITEM DESCRIPTION	UNIT	INVENTORY	REPAIR QTY
PL18	PLASTIC STOP BAR, 18"	LF	12	15
PLXW	PLASTIC CROSSWALK STRIPE	SF	260	170
PLARW	PLASTIC TRAFFIC ARROW	EA		
PLLTR	PLASTIC TRAFFIC LETTER, 8 FT HIGH	EA	12	6
PLRR	PLASTIC RAILROAD SYMBOL	EA		
RPLSYM	REMOVE PL. ARROW, LETTER, SYMBOL	EA		2
RRPM	REMOVE RPM	EA		4
RPLXW	REMOVE PLASTIC STRIPE	SF		
RPM11	TYPE 2W RPM	EA	28	18

CITY OF KIRKLAND
DEPARTMENT OF PUBLIC WORKS
123 FIFTH AVENUE KIRKLAND, WA 98033
(425) 587-3800 www.kirklandwa.gov

G. HORTILLOSA 10/2012
DESIGNED BY: DATE

J.JENNINGS 10/2012
DRAWN BY: DATE

CHECKED BY: DATE

2022 PAVEMENT MARKING PROGRAM

STREET: 132ND AVE NE

CROSS STREET: NE 95TH ST

SEGMENT:

SCALE: N.T.S.

FILENAME: Page 9-34

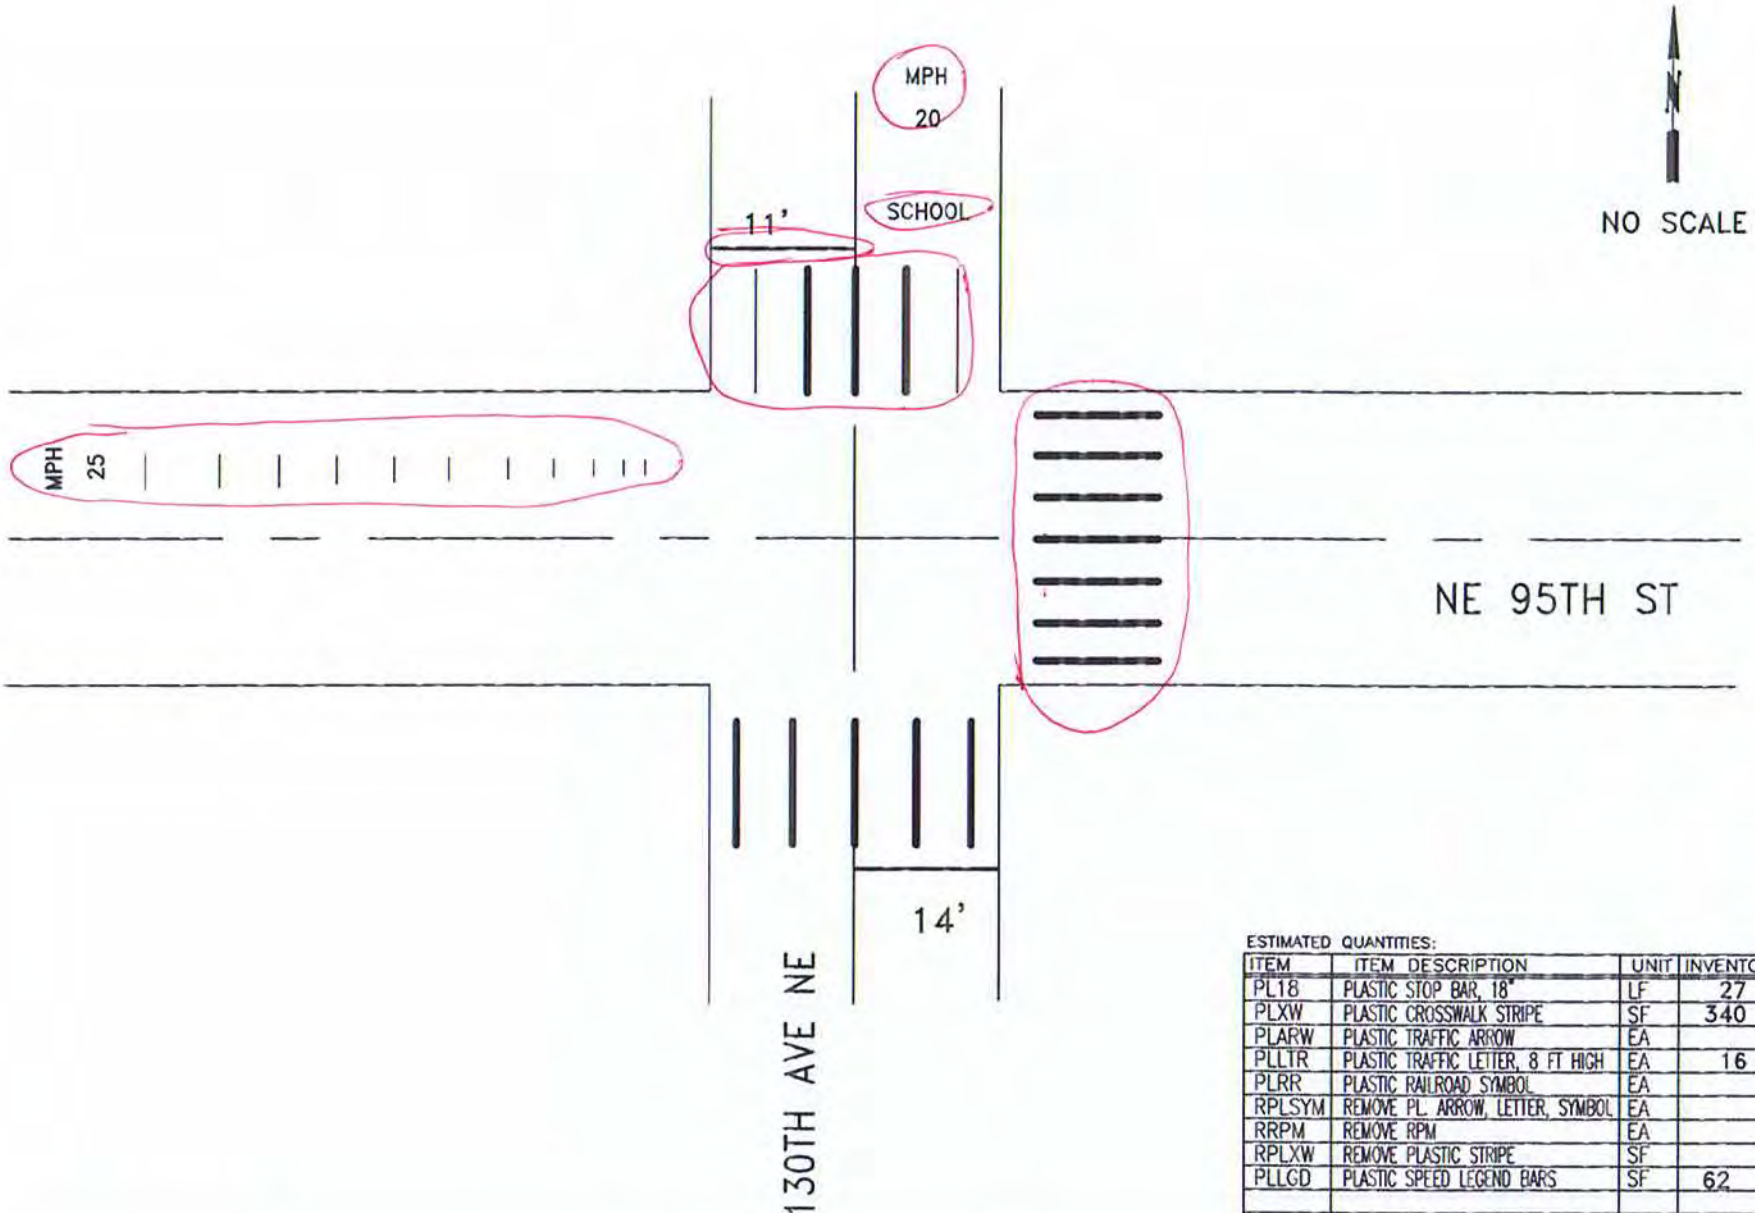

ESTIMATED QUANTITIES:

ITEM	ITEM DESCRIPTION	UNIT	INVENTORY	REPAIR QTY
PL18	PLASTIC STOP BAR, 18"	LF	27	11
PLXW	PLASTIC CROSSWALK STRIPE	SF	340	330
PLARW	PLASTIC TRAFFIC ARROW	EA		
PLLTR	PLASTIC TRAFFIC LETTER, 8 FT HIGH	EA	16	16
PLRR	PLASTIC RAILROAD SYMBOL	EA		
RPLSYM	REMOVE PL. ARROW, LETTER, SYMBOL	EA		6
RRPM	REMOVE RPM	EA		
RPLXW	REMOVE PLASTIC STRIPE	SF		80
PLLGD	PLASTIC SPEED LEGEND BARS	SF	62	62

CITY OF KIRKLAND
DEPARTMENT OF PUBLIC WORKS
123 FIFTH AVENUE KIRKLAND, WA 98033
(425) 587-3800 www.kirklandwa.gov

G. HORTILLOSA 2/2011
DESIGNED BY: DATE

J.JENNINGS 2/2011
DRAWN BY: DATE

CHECKED BY: DATE

2022 PAVEMENT MARKING PROJECT

STREET: NE 95TH ST

CROSS STREET: 130TH AVE NE

SEGMENT:

SCALE: N.T.S.

FILENAME: Page 9-35

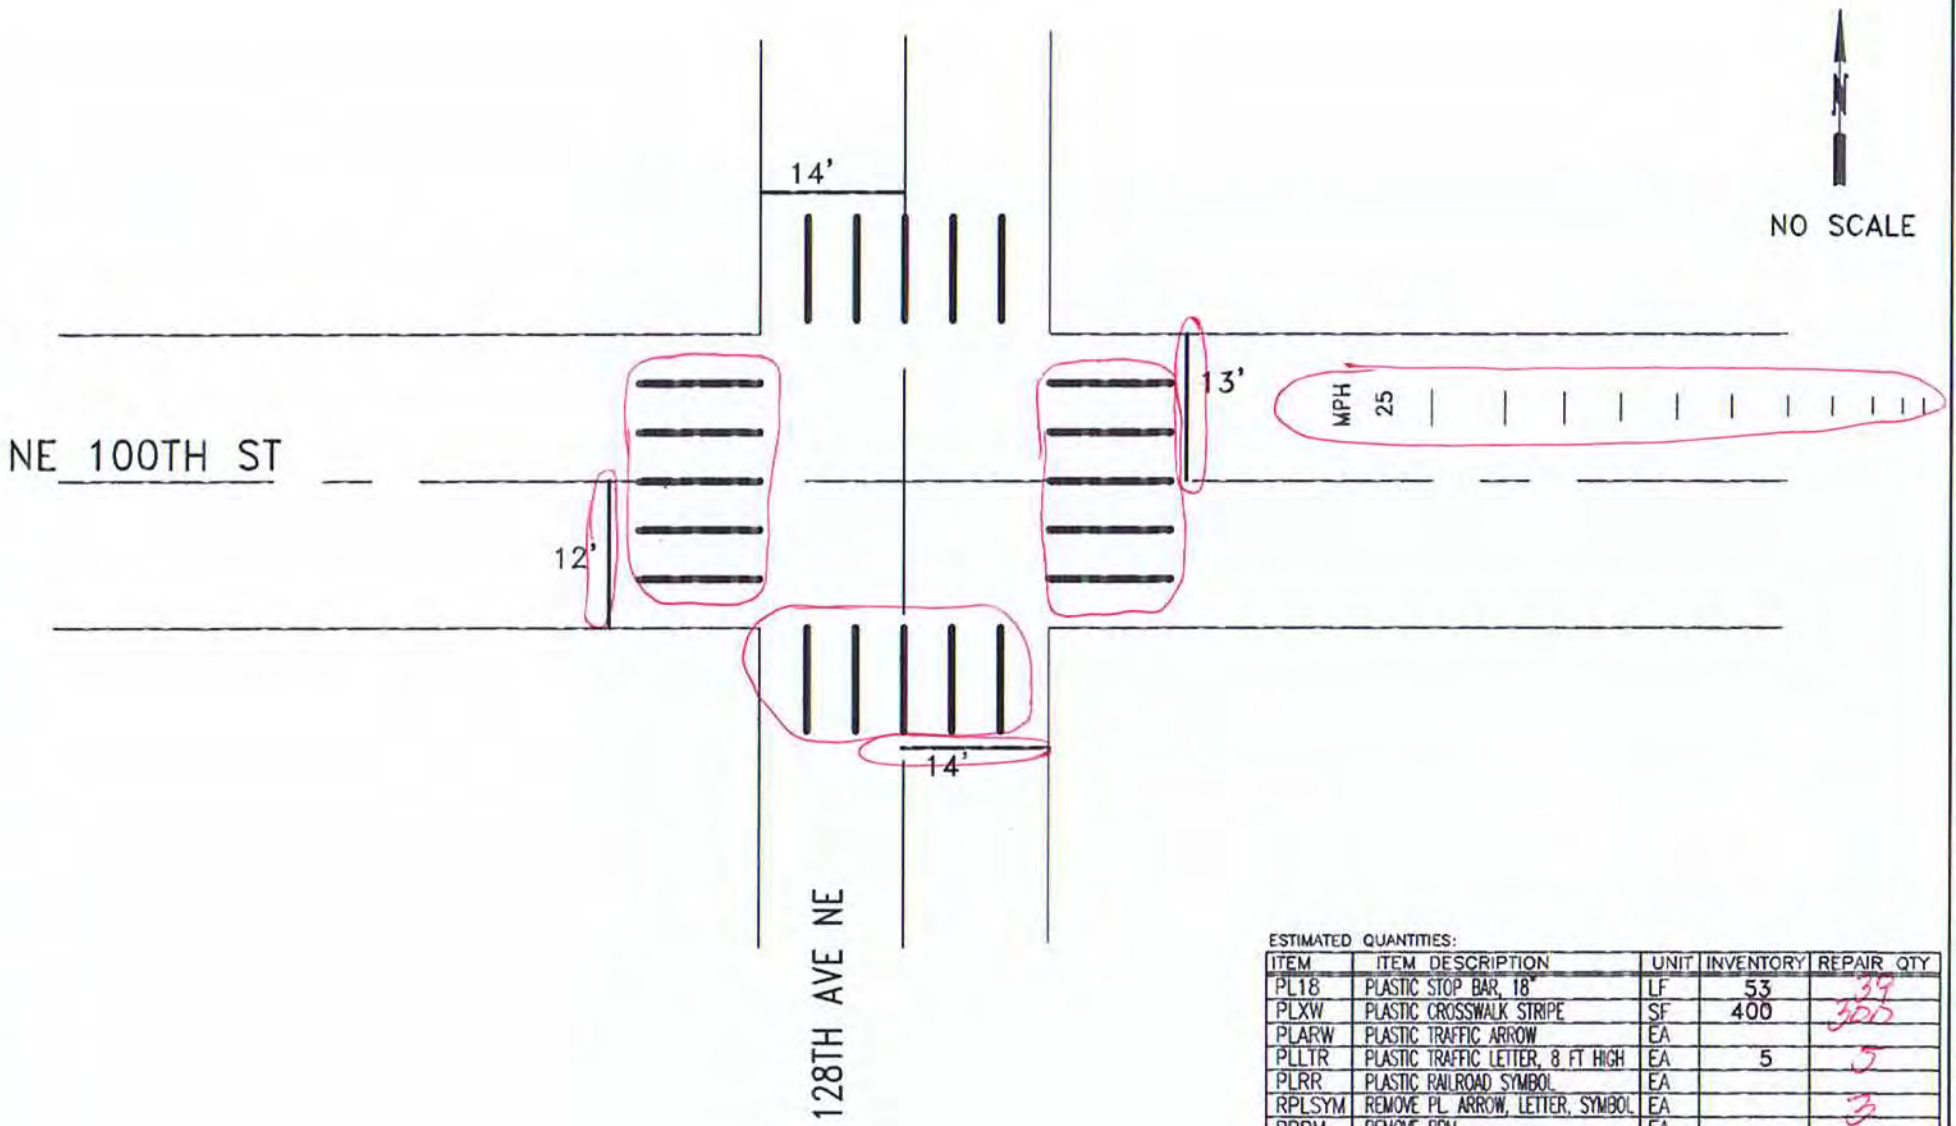

ESTIMATED QUANTITIES:

ITEM	ITEM DESCRIPTION	UNIT	INVENTORY	REPAIR QTY
PL18	PLASTIC STOP BAR, 18"	LF	53	39
PLXW	PLASTIC CROSSWALK STRIPE	SF	400	300
PLARW	PLASTIC TRAFFIC ARROW	EA		
PLLTR	PLASTIC TRAFFIC LETTER, 8 FT HIGH	EA	5	5
PLRR	PLASTIC RAILROAD SYMBOL	EA		
RPLSYM	REMOVE PL. ARROW, LETTER, SYMBOL	EA		3
RRPM	REMOVE RPM	EA		
RPLXW	REMOVE PLASTIC STRIPE	SF		360
PLLGD	PLASTIC SPEED LEGEND BARS	SF	64	62

CITY OF KIRKLAND
DEPARTMENT OF PUBLIC WORKS
123 FIFTH AVENUE KIRKLAND, WA 98033
(425) 587-3800 www.kirklandwa.gov

G. HORTILLOSA 10/2006
DESIGNED BY: DATE

J.JENNINGS 10/2006
DRAWN BY: DATE

CHECKED BY: DATE

2020 PAVEMENT MARKING PROGRAM

STREET: NE 100TH ST

CROSS STREET: 128TH AVE NE

SEGMENT:

SCALE: N.T.S.

FILENAME: Page 9-36

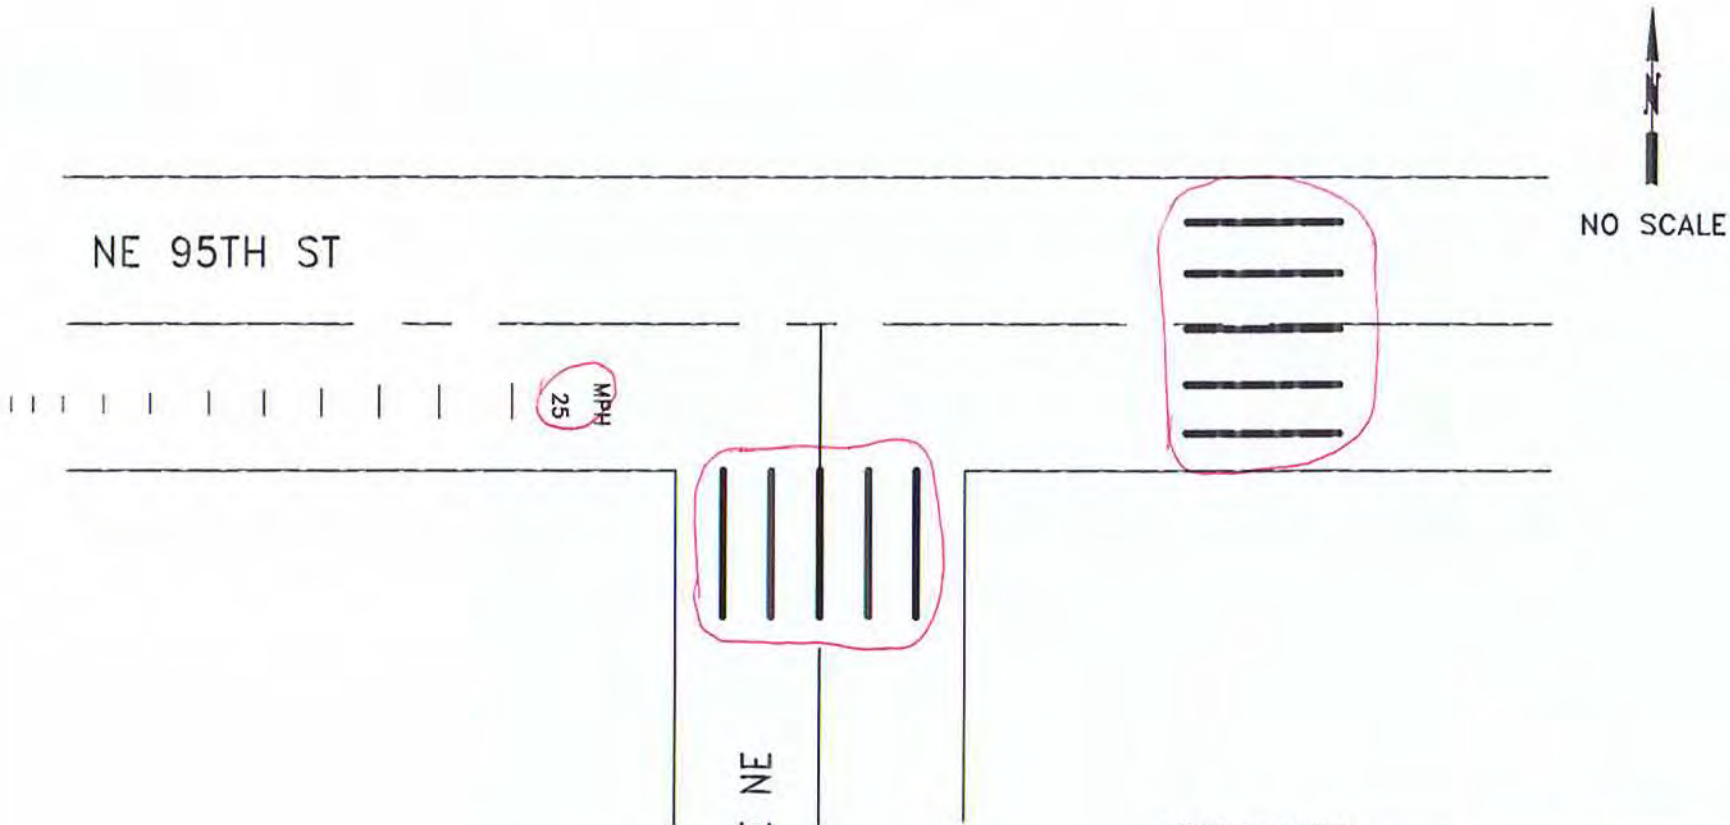

ESTIMATED QUANTITIES:

ITEM	ITEM DESCRIPTION	UNIT	INVENTORY	REPAIR QTY
PL18	PLASTIC STOP BAR, 18"	LF		
PLXW	PLASTIC CROSSWALK STRIPE	SF	200	200
PLARW	PLASTIC TRAFFIC ARROW	EA		
PLLTR	PLASTIC TRAFFIC LETTER, 8 FT HIGH	EA	5	5
PLRR	PLASTIC RAILROAD SYMBOL	EA		
RPLSYM	REMOVE PL. ARROW, LETTER, SYMBOL	EA		
RRPM	REMOVE RPM	EA		
RPLXW	REMOVE PLASTIC STRIPE	SF		200
PLLGD	PLASTIC SPEED LEGEND BARS	SF	64	

CITY OF KIRKLAND
DEPARTMENT OF PUBLIC WORKS
123 FIFTH AVENUE KIRKLAND, WA 98033
(425) 587-3800 www.kirklandwa.gov

G. HORTILLOSA 2/2011
DESIGNED BY: DATE

J.JENNINGS 2/2011
DRAWN BY: DATE

CHECKED BY: DATE

2020 PAVEMENT MARKING PROGRAM

STREET: NE 95TH ST

CROSS STREET: 126TH AVE NE

SEGMENT:

SCALE: N.T.S.

FILENAME:

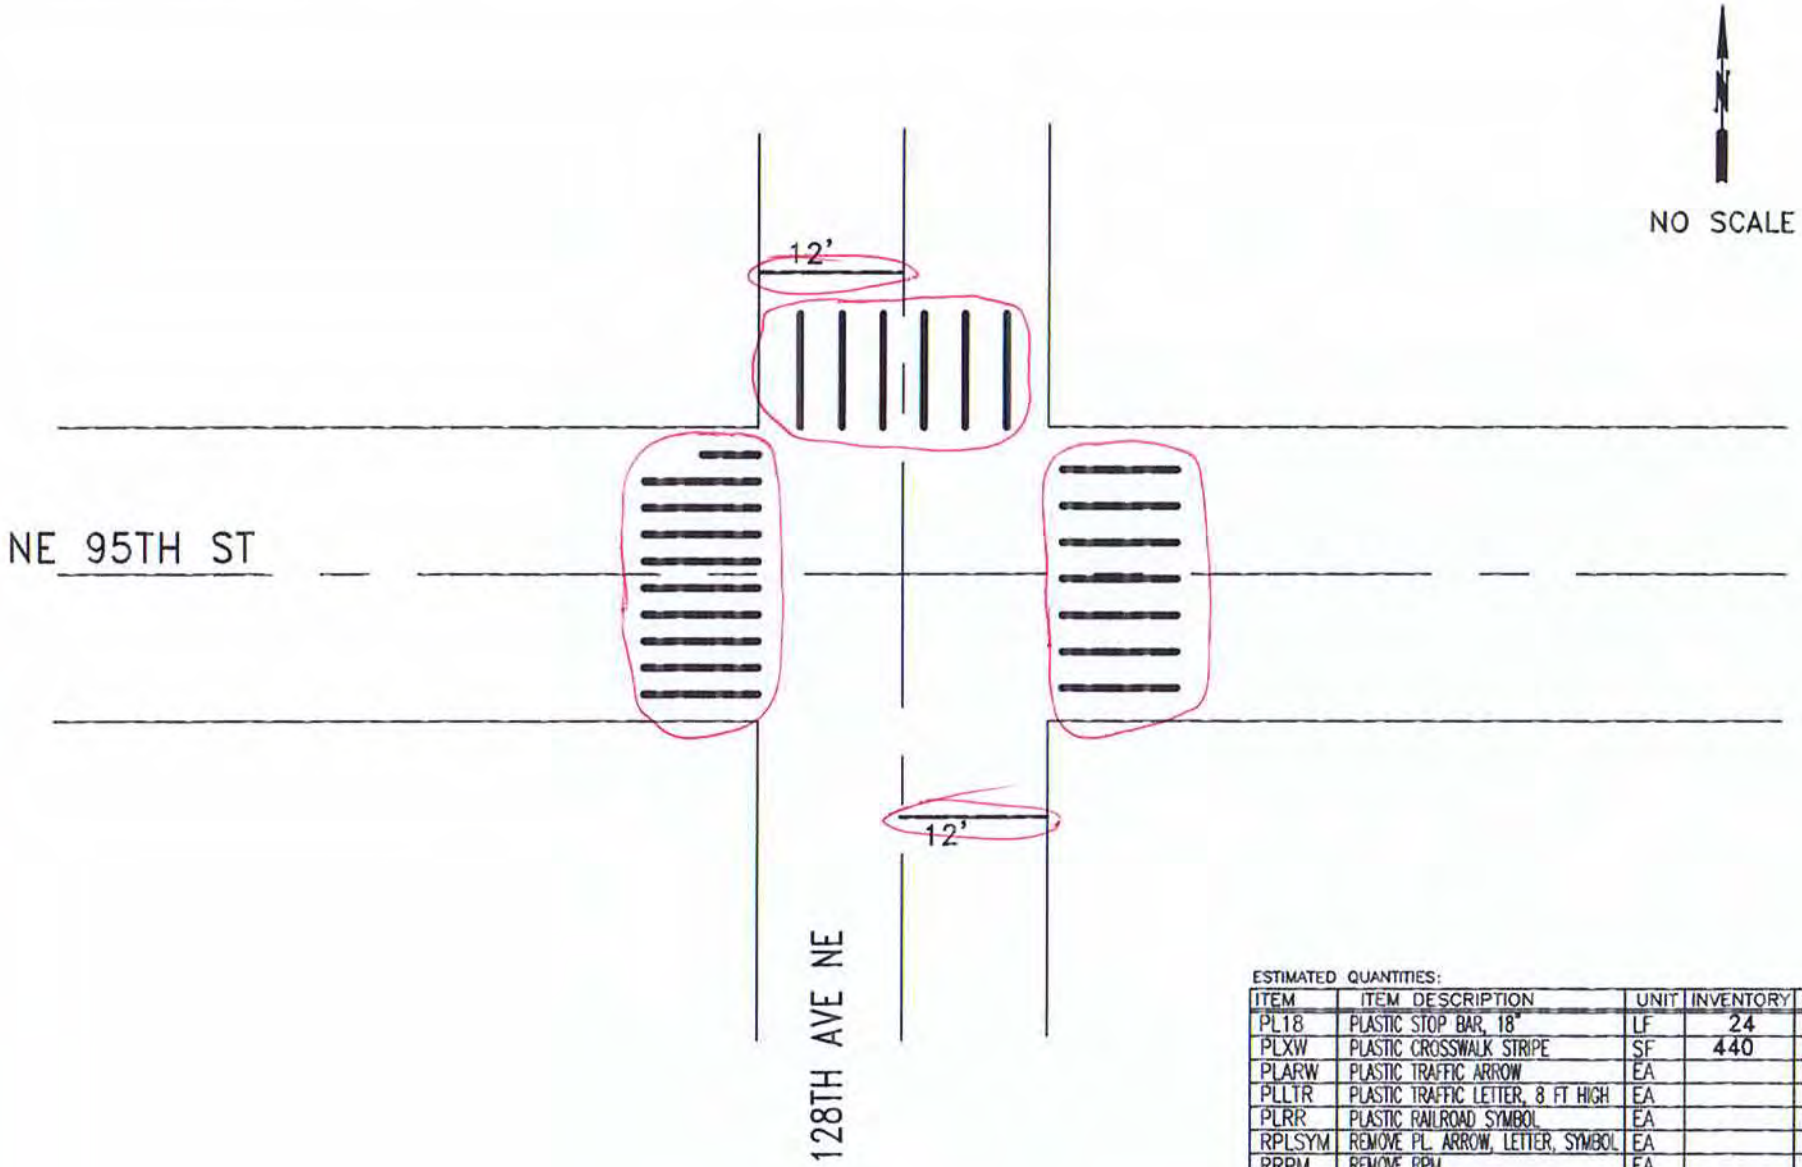

ESTIMATED QUANTITIES:

ITEM	ITEM DESCRIPTION	UNIT	INVENTORY	REPAIR QTY
PL18	PLASTIC STOP BAR, 18"	LF	24	24
PLXW	PLASTIC CROSSWALK STRIPE	SF	440	440
PLARW	PLASTIC TRAFFIC ARROW	EA		
PLLTR	PLASTIC TRAFFIC LETTER, 8 FT HIGH	EA		
PLRR	PLASTIC RAILROAD SYMBOL	EA		
RPLSYM	REMOVE PL. ARROW, LETTER, SYMBOL	EA		
RRPM	REMOVE RPM	EA		
RPLXW	REMOVE PLASTIC STRIPE	SF		180

CITY OF KIRKLAND
DEPARTMENT OF PUBLIC WORKS
123 FIFTH AVENUE KIRKLAND, WA 98033
(425) 587-3800 www.kirklandwa.gov

D.GRILLEY 1/2000
DESIGNED BY: DATE

J.JENNINGS 10/2009
DRAWN BY: DATE

CHECKED BY: DATE

2022 PAVEMENT MARKING PROGRAM

STREET: NE 95TH ST

CROSS STREET: 128TH AVE NE

SEGMENT:

SCALE: N.T.S.

FILENAME: Page 9-38

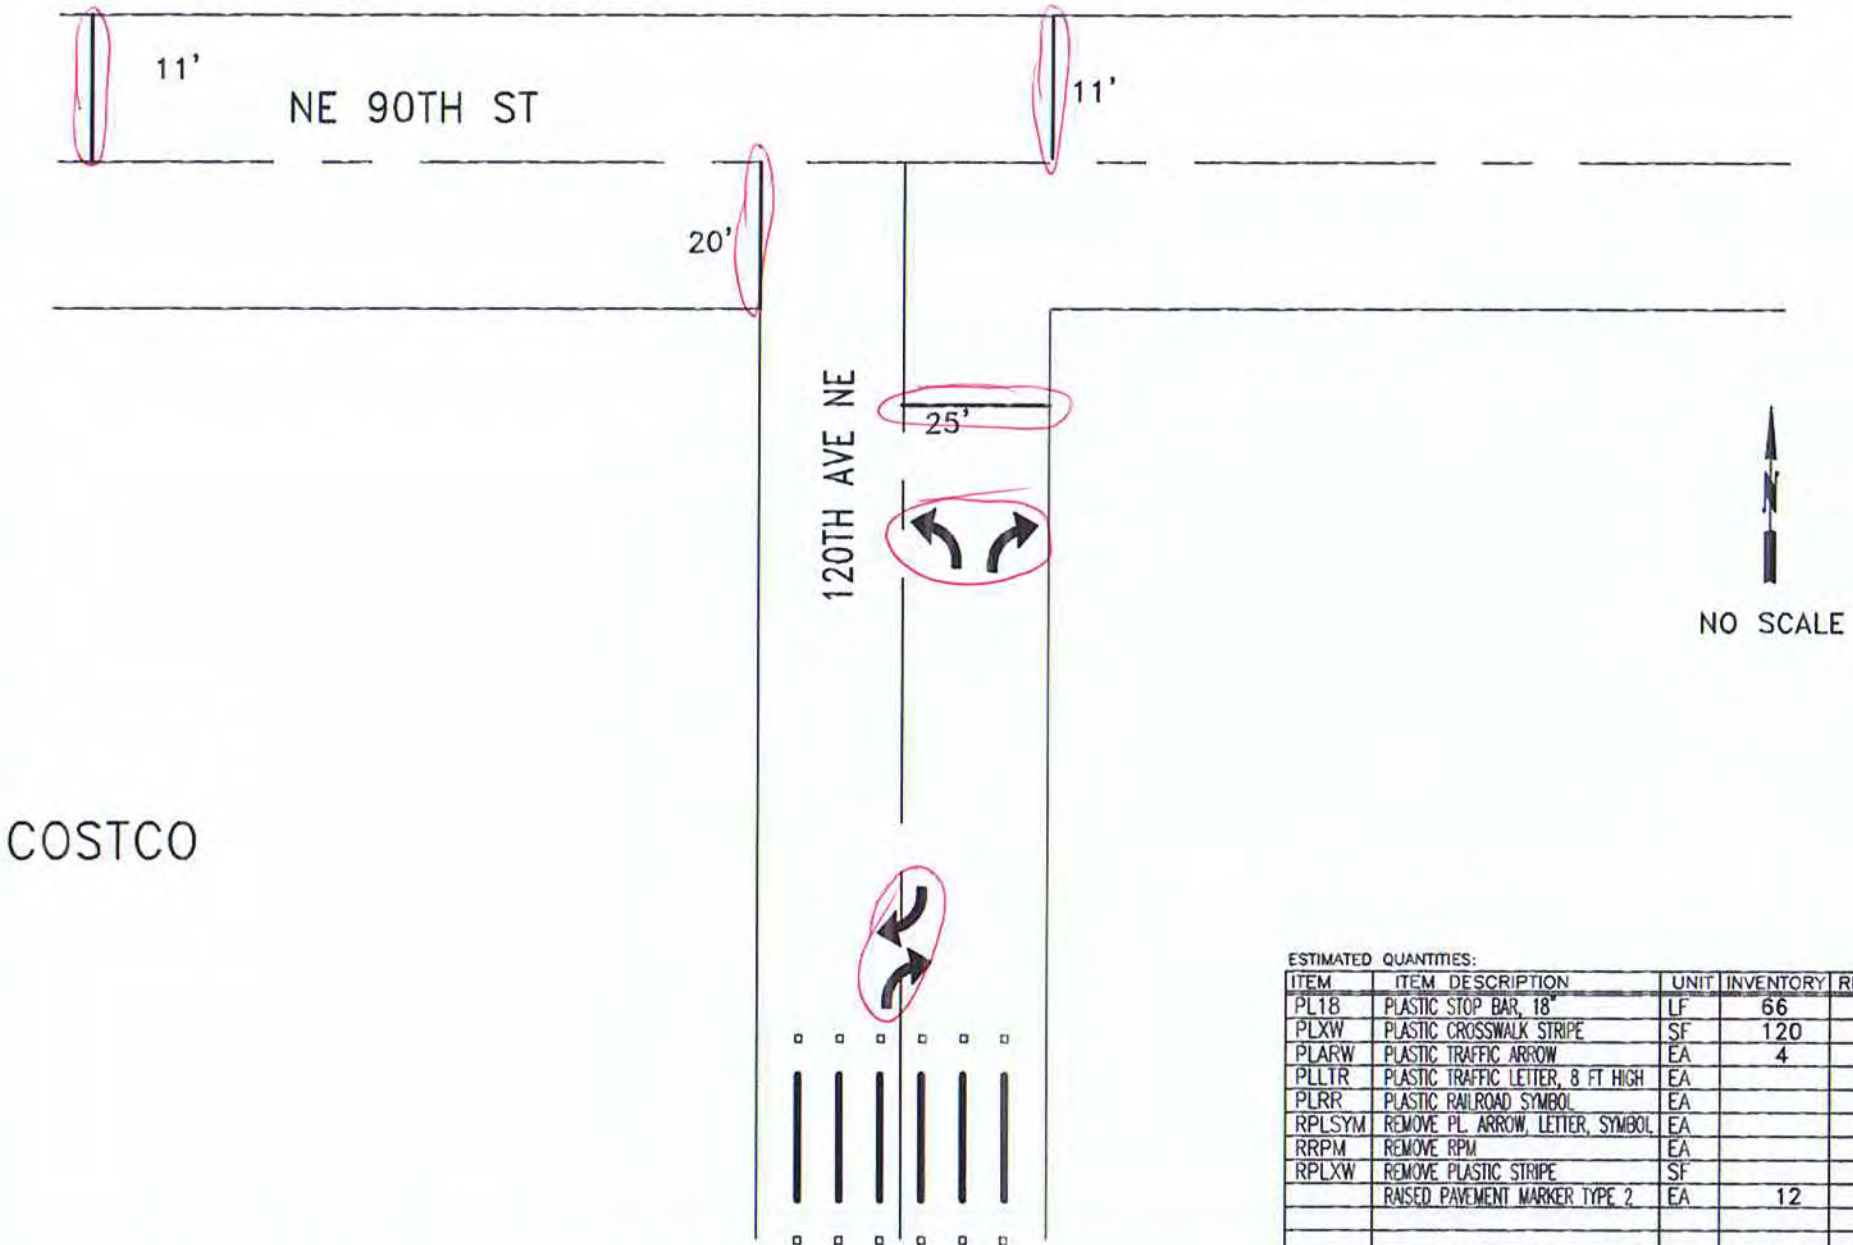

ESTIMATED QUANTITIES:

ITEM	ITEM DESCRIPTION	UNIT	INVENTORY	REPAIR QTY
PL18	PLASTIC STOP BAR, 18"	LF	66	67
PLXW	PLASTIC CROSSWALK STRIPE	SF	120	
PLARW	PLASTIC TRAFFIC ARROW	EA	4	4
PLLTR	PLASTIC TRAFFIC LETTER, 8 FT HIGH	EA		
PLRR	PLASTIC RAILROAD SYMBOL	EA		
RPLSYM	REMOVE PL. ARROW, LETTER, SYMBOL	EA		3
RRPM	REMOVE RPM	EA		
RPLXW	REMOVE PLASTIC STRIPE	SF		
	RAISED PAVEMENT MARKER TYPE 2	EA	12	

CITY OF KIRKLAND
DEPARTMENT OF PUBLIC WORKS
123 FIFTH AVENUE KIRKLAND, WA 98033
(425) 587-3800 www.kirklandwa.gov

G. HORTILLOSA 4/2008
DESIGNED BY: DATE

J.JENNINGS 10/2009
DRAWN BY: DATE

CHECKED BY: DATE

2020 PAVEMENT MARKING PROGRAM

STREET: NE 90TH ST

CROSS STREET: 120TH AVE NE

SEGMENT:

SCALE: N.T.S.

FILENAME: Page 9-39

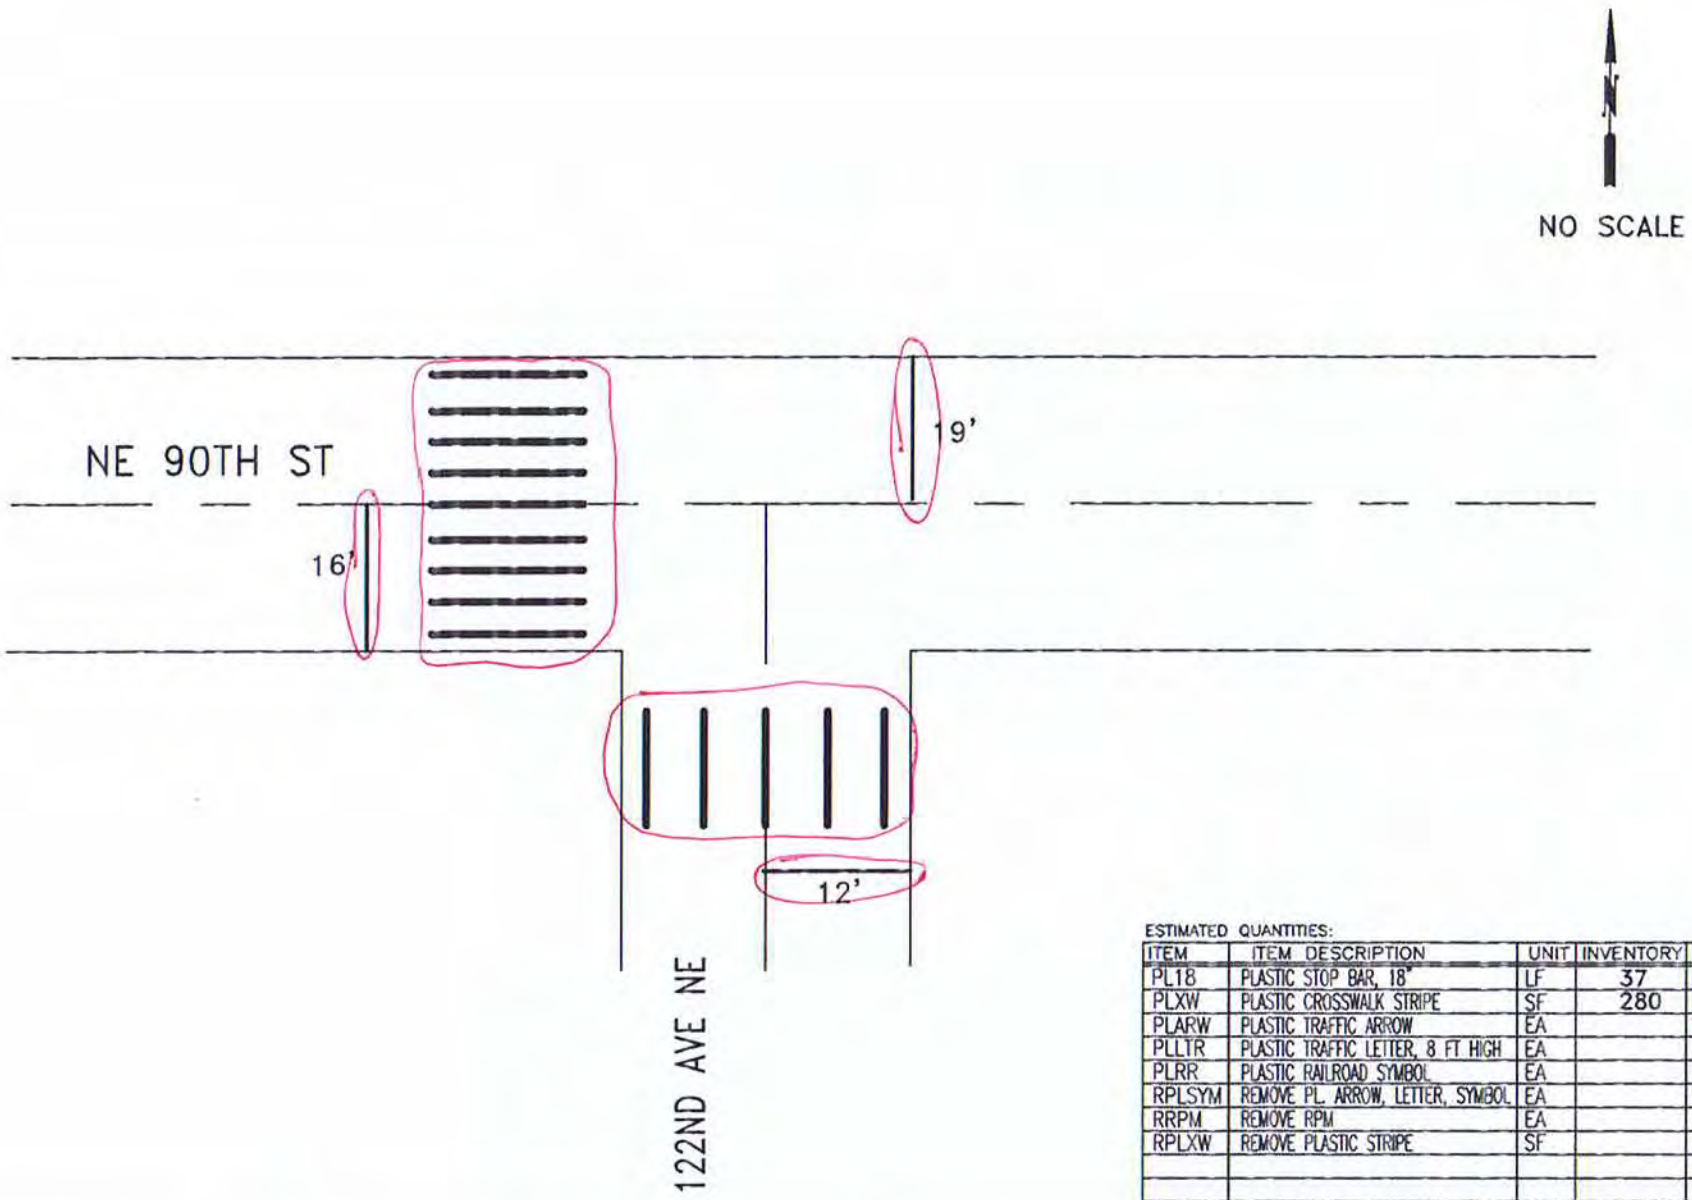

ESTIMATED QUANTITIES:

ITEM	ITEM DESCRIPTION	UNIT	INVENTORY	REPAIR QTY
PL18	PLASTIC STOP BAR, 18"	LF	37	47
PLXW	PLASTIC CROSSWALK STRIPE	SF	280	280
PLARW	PLASTIC TRAFFIC ARROW	EA		
PLLTR	PLASTIC TRAFFIC LETTER, 8 FT HIGH	EA		
PLRR	PLASTIC RAILROAD SYMBOL	EA		
RPLSYM	REMOVE PL. ARROW, LETTER, SYMBOL	EA		
RRPM	REMOVE RPM	EA		
RPLXW	REMOVE PLASTIC STRIPE	SF		60

CITY OF KIRKLAND
DEPARTMENT OF PUBLIC WORKS
123 FIFTH AVENUE KIRKLAND, WA 98033
(425) 587-3800 www.kirklandwa.gov

G. HORTILLOSA 2/2011
DESIGNED BY: DATE

J.JENNINGS 2/2011
DRAWN BY: DATE

CHECKED BY: DATE

20~~20~~ PAVEMENT MARKING PROGRAM

STREET: NE 90TH ST

CROSS STREET: 122ND AVE NE

SEGMENT:

SCALE: N.T.S.

FILENAME:

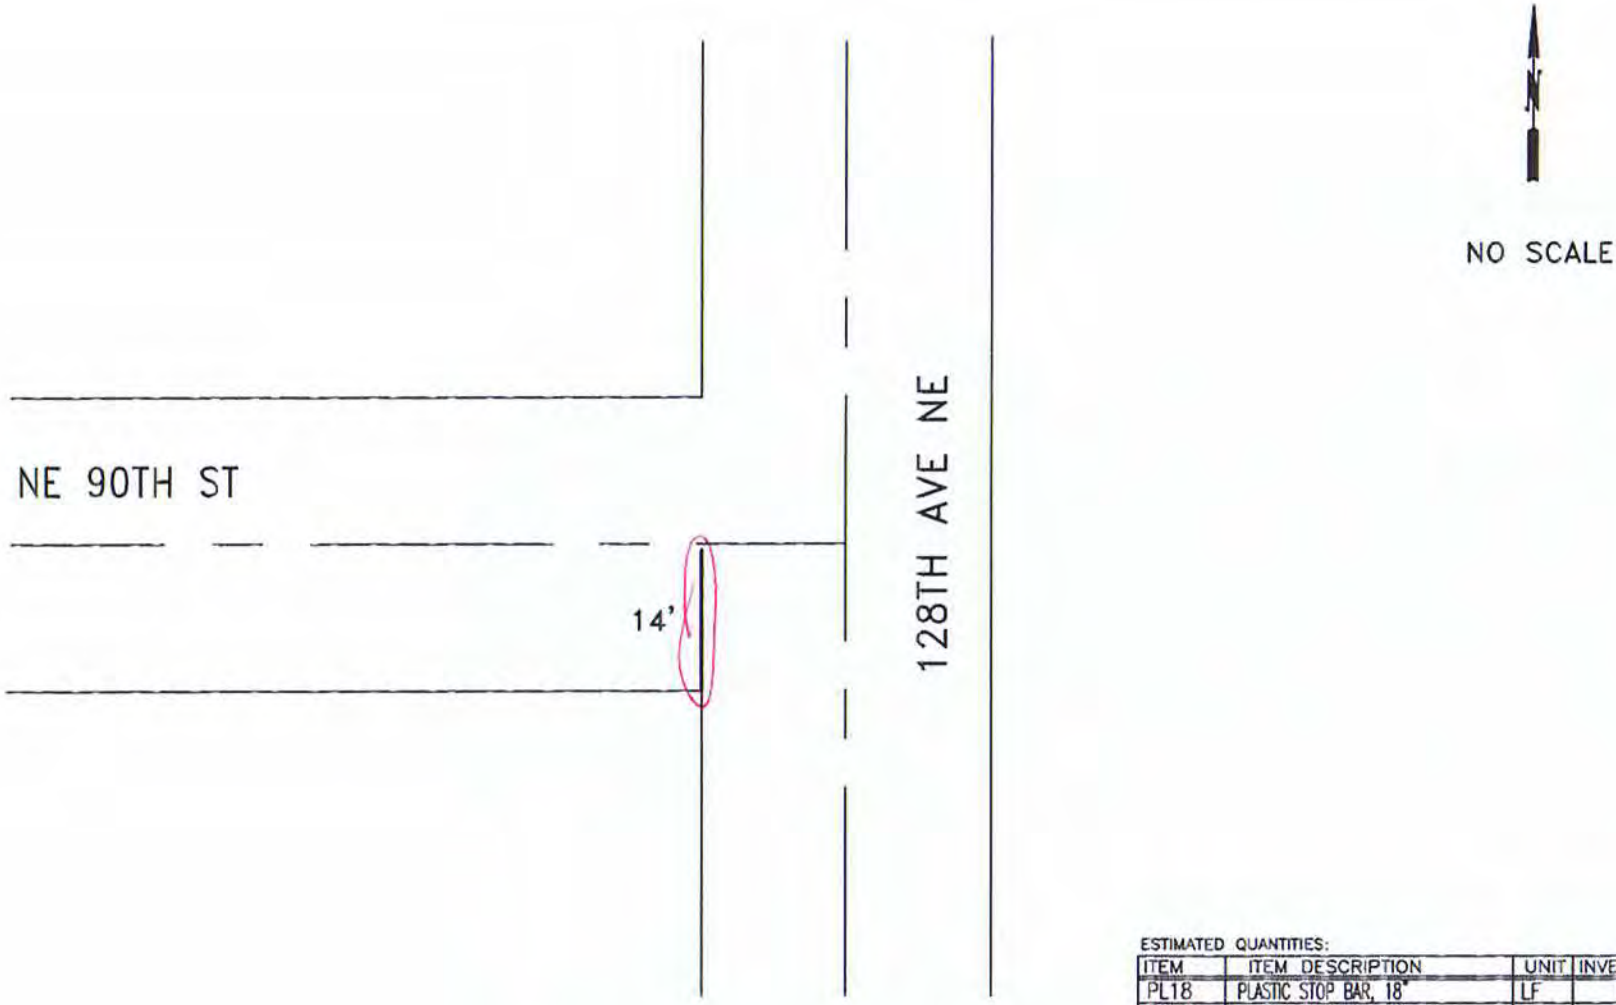

ESTIMATED QUANTITIES:

ITEM	ITEM DESCRIPTION	UNIT	INVENTORY	REPAIR QTY
PL18	PLASTIC STOP BAR, 18"	LF	14	14
PLXW	PLASTIC CROSSWALK STRIPE	SF		
PLARW	PLASTIC TRAFFIC ARROW	EA		
PLLTR	PLASTIC TRAFFIC LETTER, 8 FT HIGH	EA		
PLRR	PLASTIC RAILROAD SYMBOL	EA		
RPLSYM	REMOVE PL. ARROW, LETTER, SYMBOL	EA		
RRPM	REMOVE RPM	EA		
RPLXW	REMOVE PLASTIC STRIPE	SF		

CITY OF KIRKLAND
DEPARTMENT OF PUBLIC WORKS
123 FIFTH AVENUE KIRKLAND, WA 98033
(425) 587-3800 www.kirklandwa.gov

D.GRILLEY 1/2000
DESIGNED BY: DATE

J.JENNINGS 1/2000
DRAWN BY: DATE

CHECKED BY: DATE

2022 PAVEMENT MARKING PROGRAM

STREET: 128TH AVE NE

CROSS STREET: NE 90TH ST

SEGMENT:

SCALE: N.T.S.

FILENAME: Page 9-41

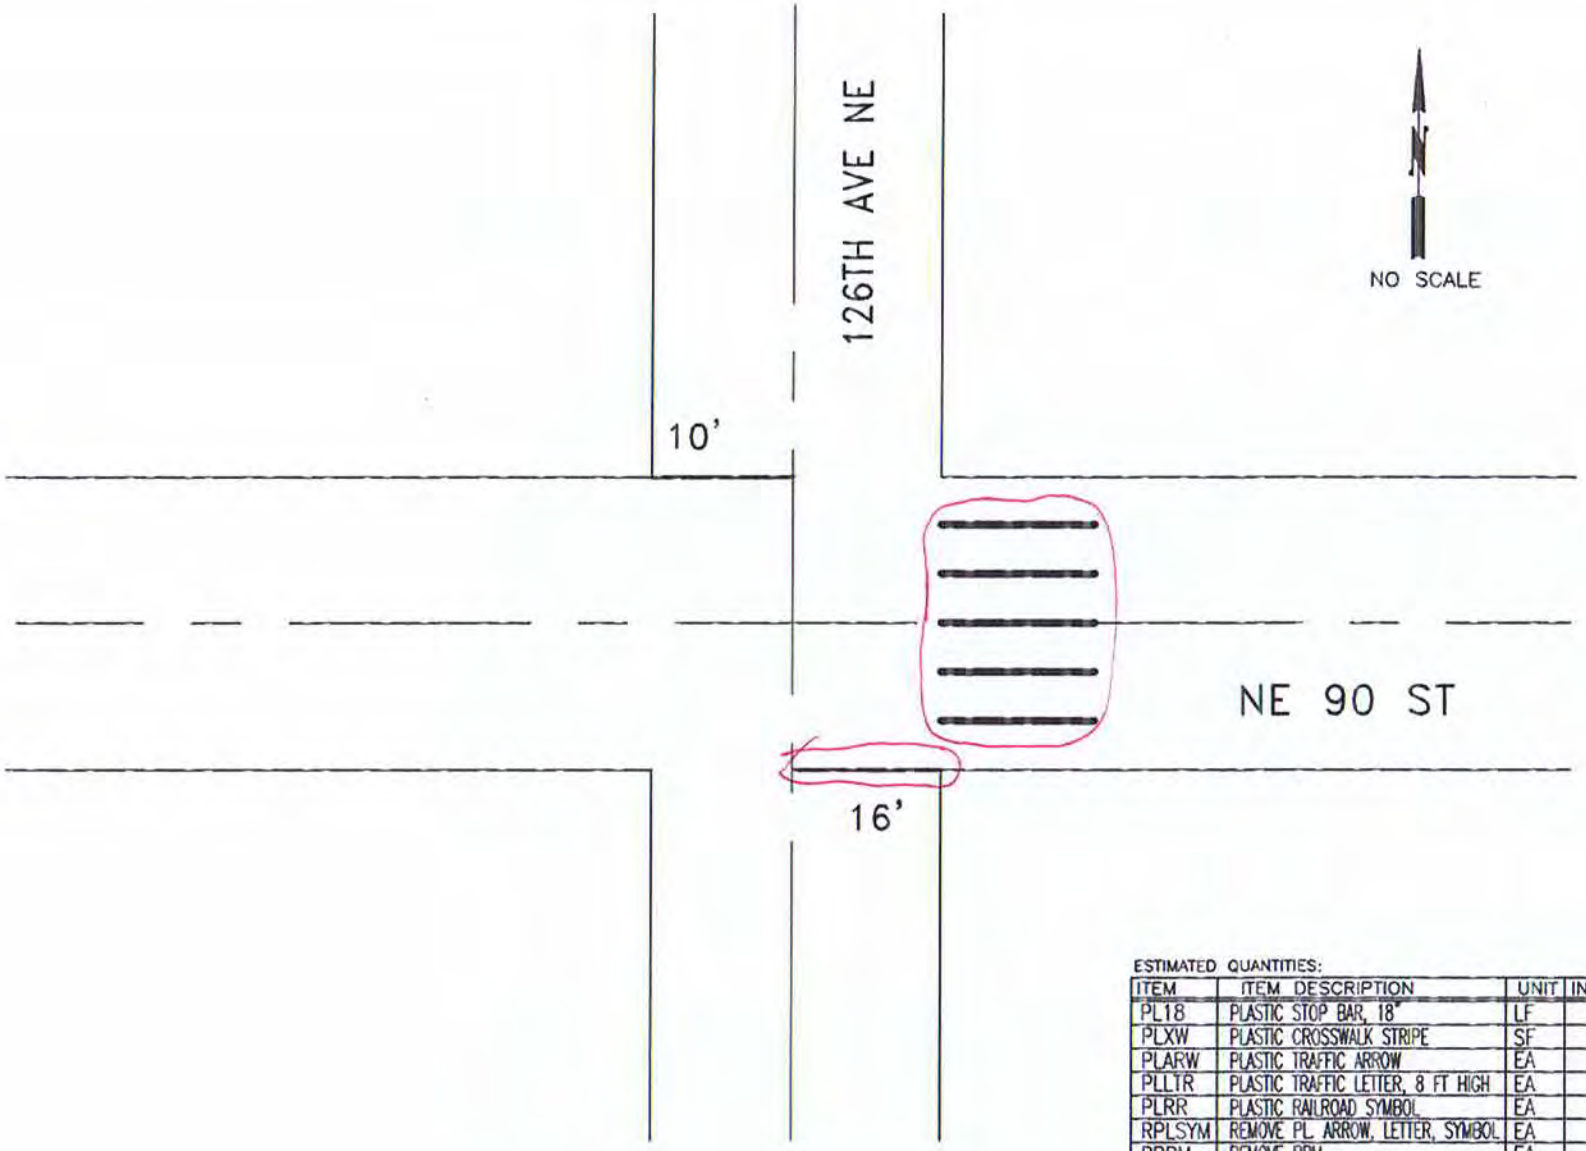

ESTIMATED QUANTITIES:

ITEM	ITEM DESCRIPTION	UNIT	INVENTORY	REPAIR QTY
PL18	PLASTIC STOP BAR, 18"	LF	26	16
PLXW	PLASTIC CROSSWALK STRIPE	SF	100	102
PLARW	PLASTIC TRAFFIC ARROW	EA		
PLLTR	PLASTIC TRAFFIC LETTER, 8 FT HIGH	EA		
PLRR	PLASTIC RAILROAD SYMBOL	EA		
RPLSYM	REMOVE PL. ARROW, LETTER, SYMBOL	EA		
RRPM	REMOVE RPM	EA		
RPLXW	REMOVE PLASTIC STRIPE	SF		

CITY OF KIRKLAND
DEPARTMENT OF PUBLIC WORKS
123 FIFTH AVENUE KIRKLAND, WA 98033
(425) 587-3800 www.kirklandwa.gov

G. HORTILLOSA 11/2008
DESIGNED BY: DATE

J.JENNINGS 10/2009
DRAWN BY: DATE

CHECKED BY: DATE

2022 PAVEMENT MARKING PROGRAM

STREET: NE 90TH ST

CROSS STREET: 126TH AVE NE

SEGMENT:

SCALE: N.T.S.

FILENAME: PAGE 9-42

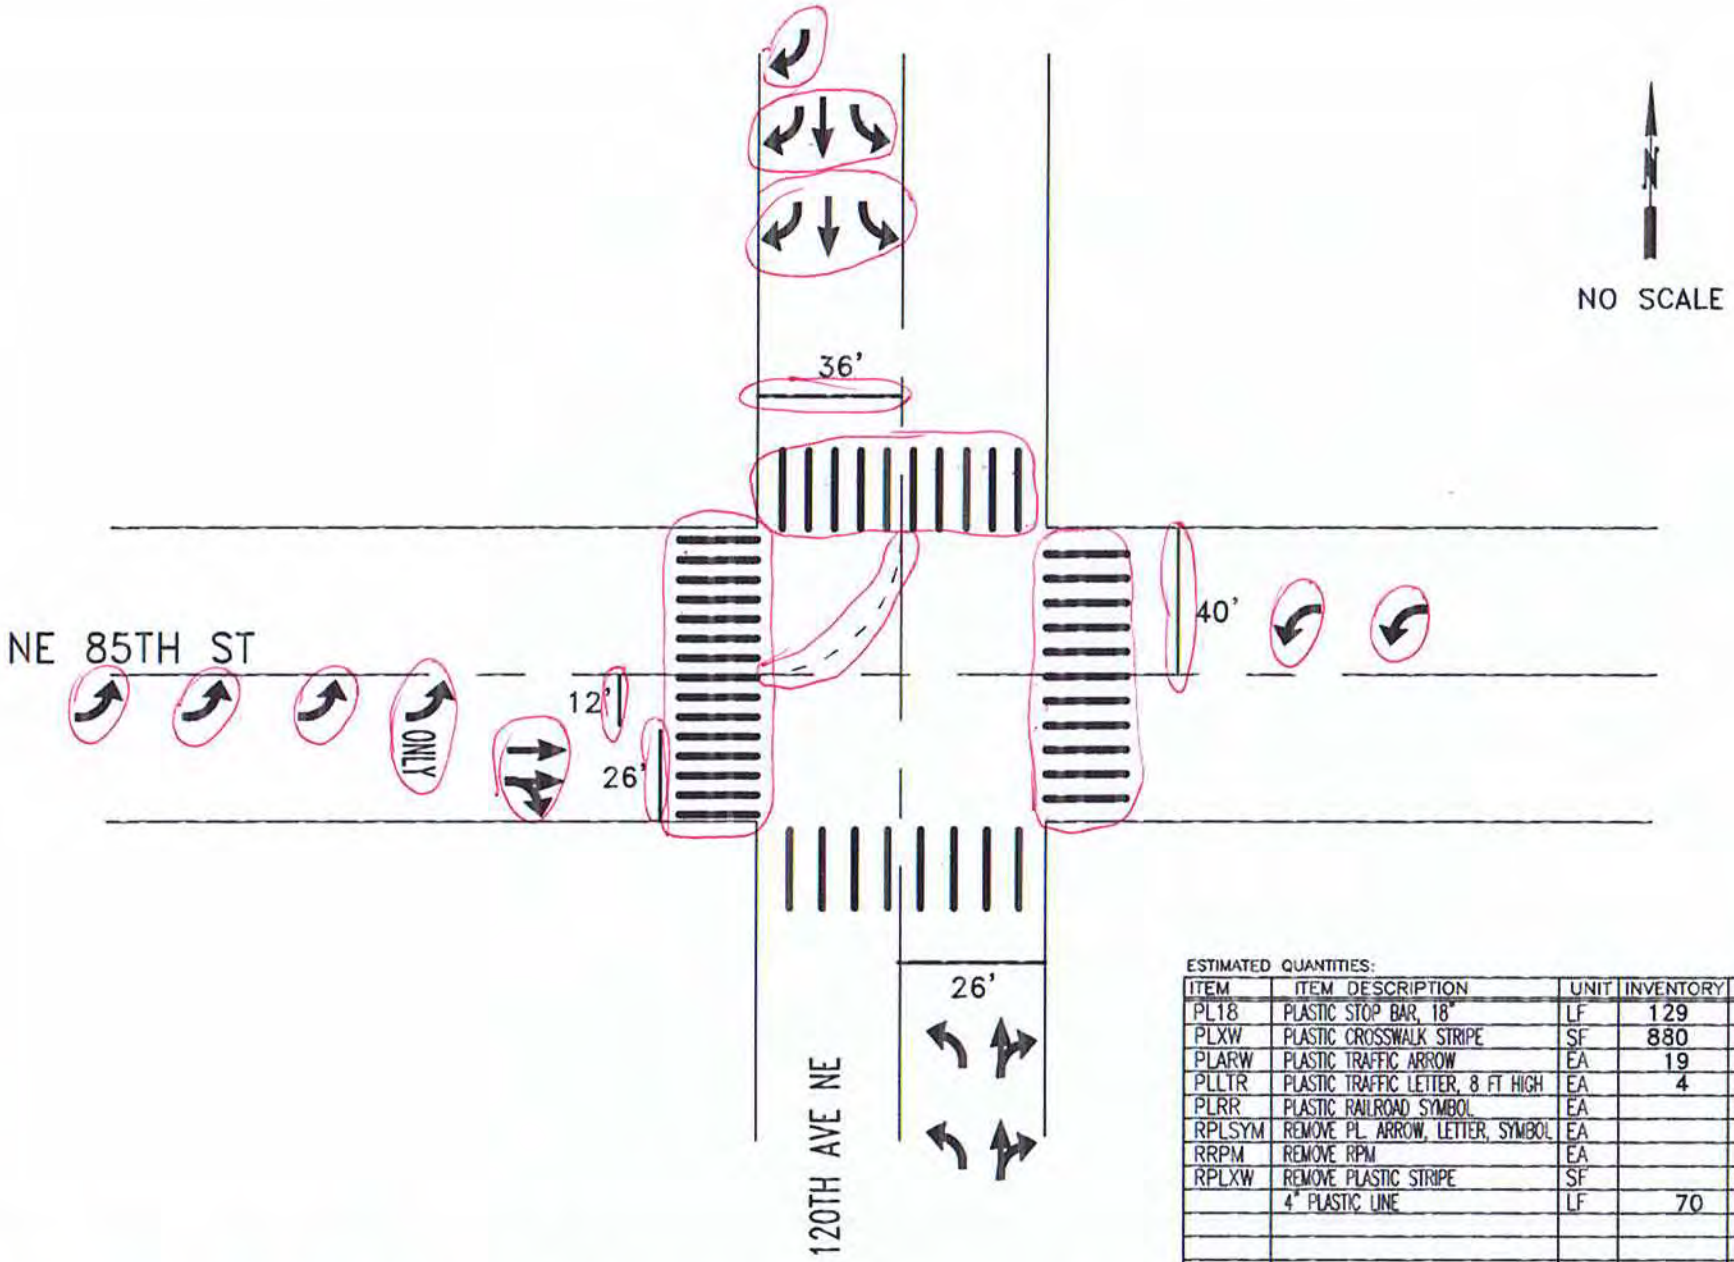

ESTIMATED QUANTITIES:

ITEM	ITEM DESCRIPTION	UNIT	INVENTORY	REPAIR QTY
PL18	PLASTIC STOP BAR, 18"	LF	129	118
PLXW	PLASTIC CROSSWALK STRIPE	SF	880	770
PLARW	PLASTIC TRAFFIC ARROW	EA	19	5
PLLTR	PLASTIC TRAFFIC LETTER, 8 FT HIGH	EA	4	4
PLRR	PLASTIC RAILROAD SYMBOL	EA		
RPLSYM	REMOVE PL. ARROW, LETTER, SYMBOL	EA		
RRPM	REMOVE RPM	EA		
RPLXW	REMOVE PLASTIC STRIPE	SF		350
	4" PLASTIC LINE	LF	70	70

CITY OF KIRKLAND
DEPARTMENT OF PUBLIC WORKS
123 FIFTH AVENUE KIRKLAND, WA 98033
(425) 587-3800 www.kirklandwa.gov

G. HORTILLOSA 3/2009
DESIGNED BY: DATE

J.JENNINGS 3/2009
DRAWN BY: DATE

CHECKED BY: DATE

2020 PAVEMENT MARKING PROGRAM

STREET: NE 85TH ST

CROSS STREET: 120TH AVE NE

SEGMENT:

SCALE: N.T.S.

FILENAME: Page 9-43

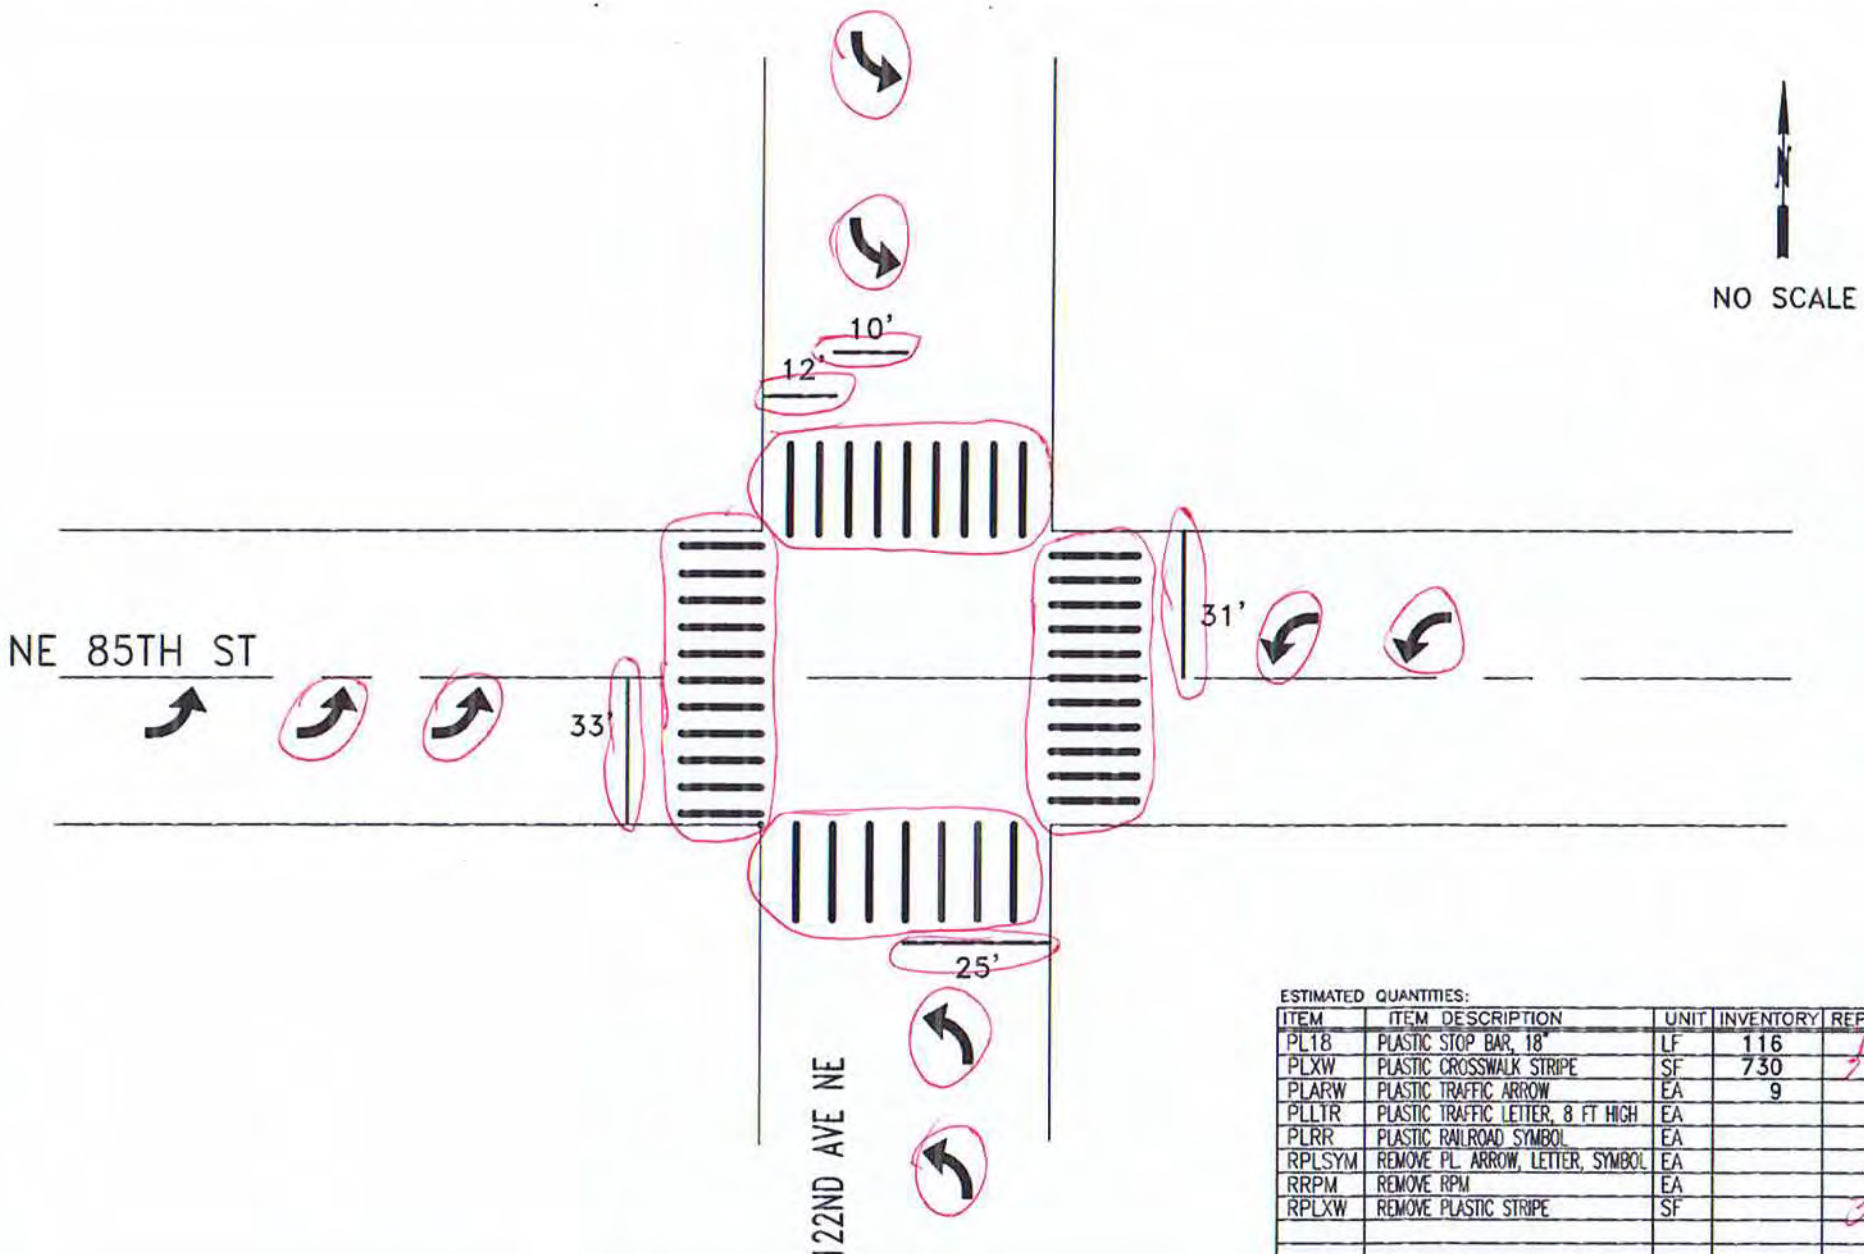

ESTIMATED QUANTITIES:

ITEM	ITEM DESCRIPTION	UNIT	INVENTORY	REPAIR QTY
PL18	PLASTIC STOP BAR, 18"	LF	116	116
PLXW	PLASTIC CROSSWALK STRIPE	SF	730	730
PLARW	PLASTIC TRAFFIC ARROW	EA	9	8
PLLTR	PLASTIC TRAFFIC LETTER, 8 FT HIGH	EA		
PLRR	PLASTIC RAILROAD SYMBOL	EA		
RPLSYM	REMOVE PL. ARROW, LETTER, SYMBOL	EA		6
RRPM	REMOVE RPM	EA		
RPLXW	REMOVE PLASTIC STRIPE	SF		300

CITY OF KIRKLAND
DEPARTMENT OF PUBLIC WORKS
123 FIFTH AVENUE KIRKLAND, WA 98033
(425) 587-3800 www.kirklandwa.gov

R. STEITZER 8/2005
DESIGNED BY: DATE

J.JENNINGS 8/2005
DRAWN BY: DATE

CHECKED BY: DATE

2020 PAVEMENT MARKING PROGRAM

STREET: NE 85TH ST

CROSS STREET: 122ND AVE NE

SEGMENT:

SCALE: N.T.S.

FILENAME:

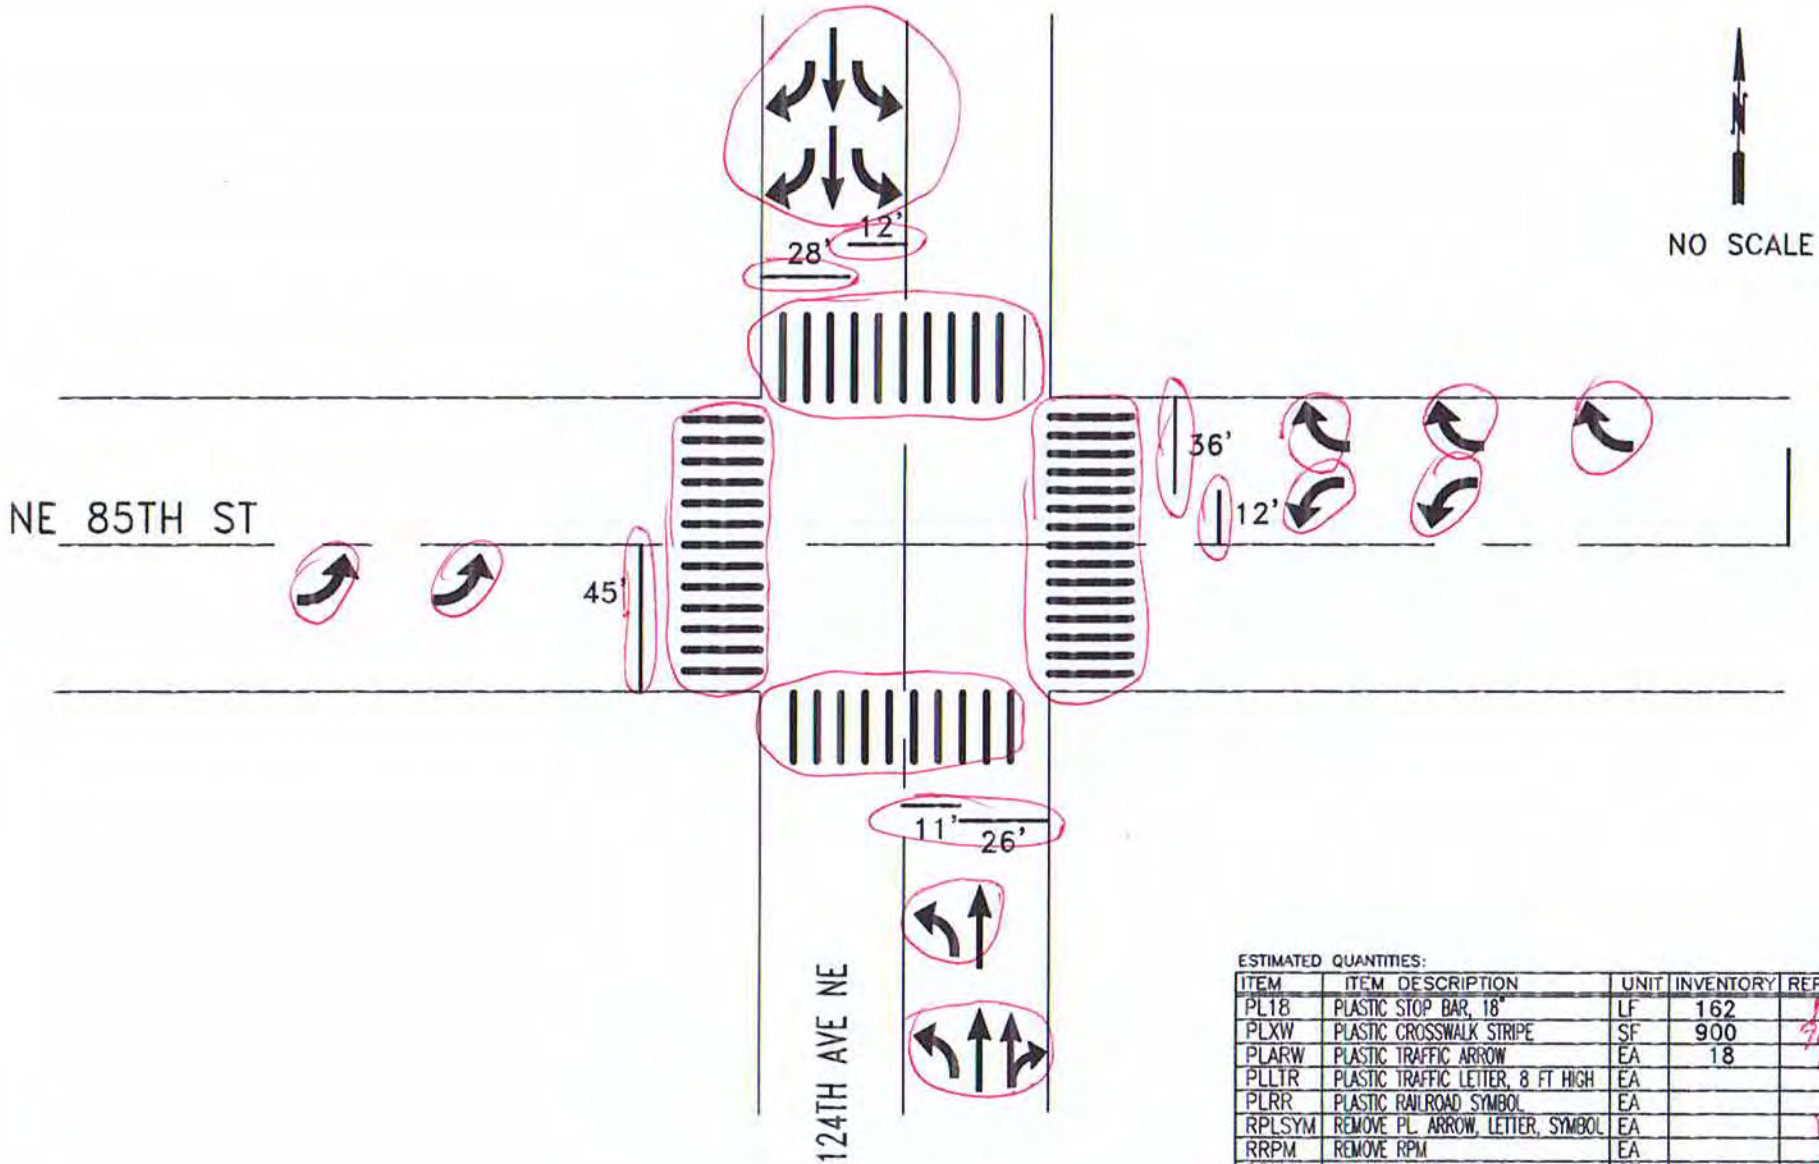

ESTIMATED QUANTITIES:

ITEM	ITEM DESCRIPTION	UNIT	INVENTORY	REPAIR QTY
PL18	PLASTIC STOP BAR, 18"	LF	162	162
PLXW	PLASTIC CROSSWALK STRIPE	SF	900	900
PLARW	PLASTIC TRAFFIC ARROW	EA	18	18
PLLTR	PLASTIC TRAFFIC LETTER, 8 FT HIGH	EA		
PLRR	PLASTIC RAILROAD SYMBOL	EA		
RPLSYM	REMOVE PL. ARROW, LETTER, SYMBOL	EA		12
RRPM	REMOVE RPM	EA		
RPLXW	REMOVE PLASTIC STRIPE	SF		400

CITY OF KIRKLAND
DEPARTMENT OF PUBLIC WORKS
123 FIFTH AVENUE KIRKLAND, WA 98033
(425) 587-3800 www.kirklandwa.gov

D.GRILLEY 1/2000
DESIGNED BY: DATE

J.JENNINGS 4/2004
DRAWN BY: DATE

CHECKED BY: DATE

2022 PAVEMENT MARKING PROGRAM

STREET: NE 85TH ST

CROSS STREET: 124TH AVE NE

SEGMENT:

SCALE: N.T.S.

FILENAME: Page 9-45

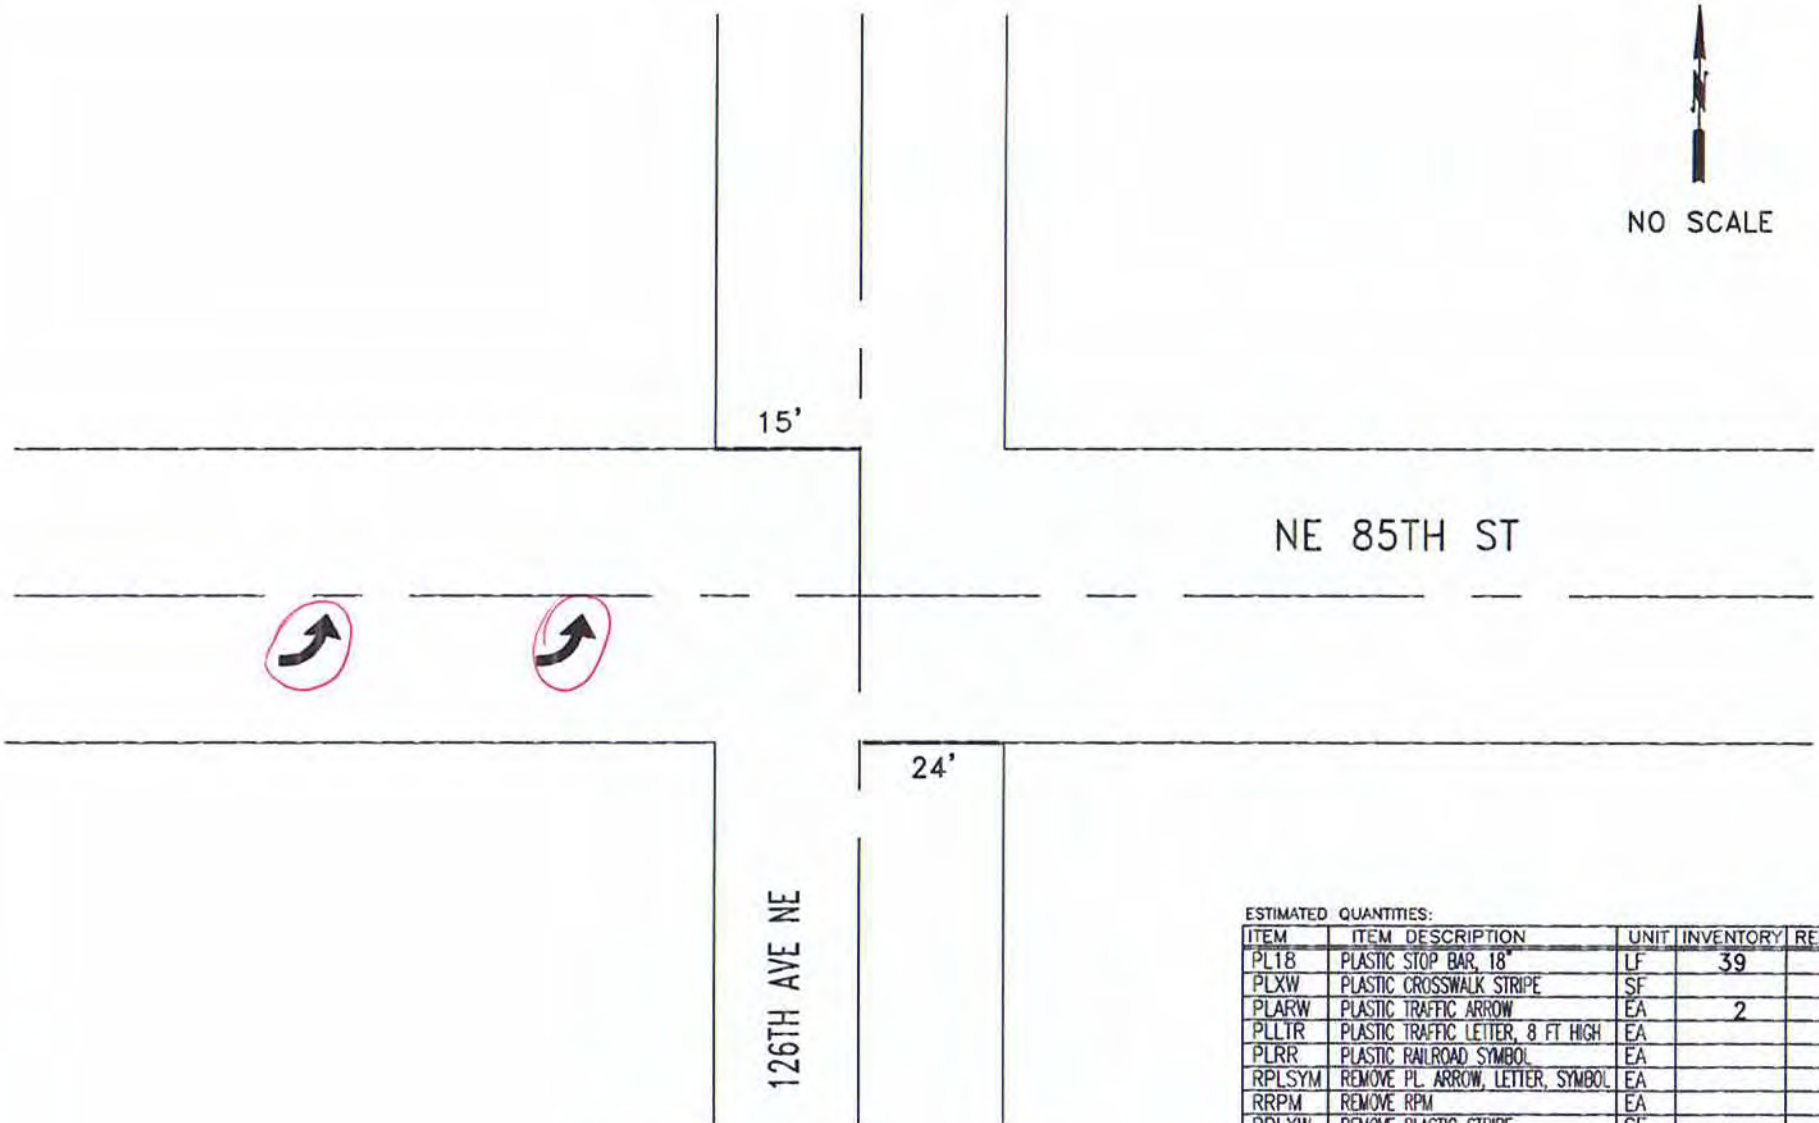

ESTIMATED QUANTITIES:

ITEM	ITEM DESCRIPTION	UNIT	INVENTORY	REPAIR QTY
PL18	PLASTIC STOP BAR, 18"	LF	39	
PLXW	PLASTIC CROSSWALK STRIPE	SF		
PLARW	PLASTIC TRAFFIC ARROW	EA	2	2
PLLTR	PLASTIC TRAFFIC LETTER, 8 FT HIGH	EA		
PLRR	PLASTIC RAILROAD SYMBOL	EA		
RPLSYM	REMOVE PL. ARROW, LETTER, SYMBOL	EA		
RRPM	REMOVE RPM	EA		
RPLXW	REMOVE PLASTIC STRIPE	SF		

CITY OF KIRKLAND
DEPARTMENT OF PUBLIC WORKS
123 FIFTH AVENUE KIRKLAND, WA 98033
(425) 587-3800 www.kirklandwa.gov

D.GRILLEY 1/2000
DESIGNED BY: DATE

J.JENNINGS 10/2009
DRAWN BY: DATE

CHECKED BY: DATE

2022 PAVEMENT MARKING PROGRAM

STREET: NE 85TH STREET

CROSS STREET: 126TH AVENUE NE

SEGMENT:

SCALE: N.T.S.

FILENAME:

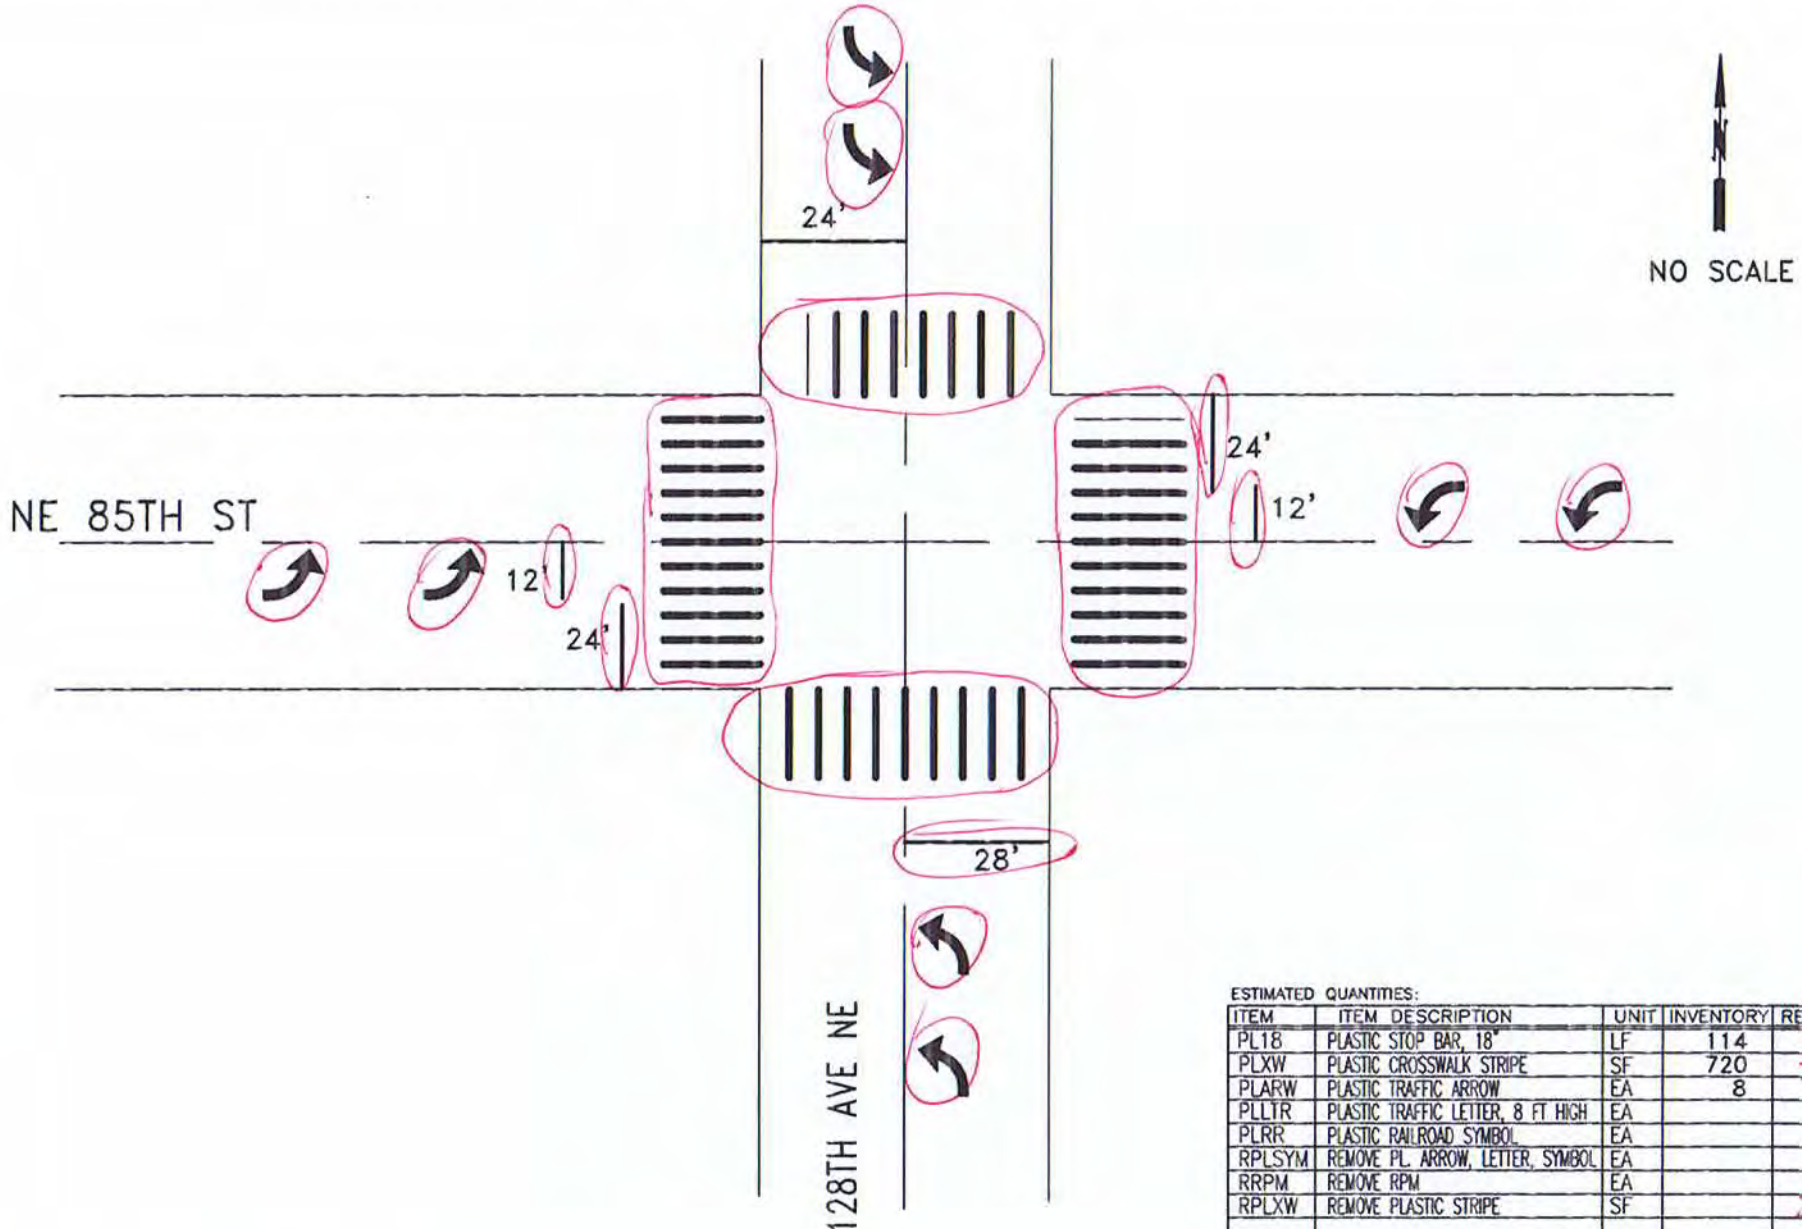

ESTIMATED QUANTITIES:

ITEM	ITEM DESCRIPTION	UNIT	INVENTORY	REPAIR QTY
PL18	PLASTIC STOP BAR, 18"	LF	114	114
PLXW	PLASTIC CROSSWALK STRIPE	SF	720	720
PLARW	PLASTIC TRAFFIC ARROW	EA	8	8
PLLTR	PLASTIC TRAFFIC LETTER, 8 FT HIGH	EA		
PLRR	PLASTIC RAILROAD SYMBOL	EA		
RPLSYM	REMOVE PL. ARROW, LETTER, SYMBOL	EA		4
RRPM	REMOVE RPM	EA		
RPLXW	REMOVE PLASTIC STRIPE	SF		360

CITY OF KIRKLAND
DEPARTMENT OF PUBLIC WORKS
123 FIFTH AVENUE KIRKLAND, WA 98033
(425) 587-3800 www.kirklandwa.gov

G. HORTILLOSA 3/2006
DESIGNED BY: DATE

J.JENNINGS 10/2009
DRAWN BY: DATE

CHECKED BY: DATE

2020 PAVEMENT MARKING PROGRAM

STREET: NE 85TH ST

CROSS STREET: 128TH AVE NE

SEGMENT:

SCALE: N.T.S.

FILENAME: Page 9-47

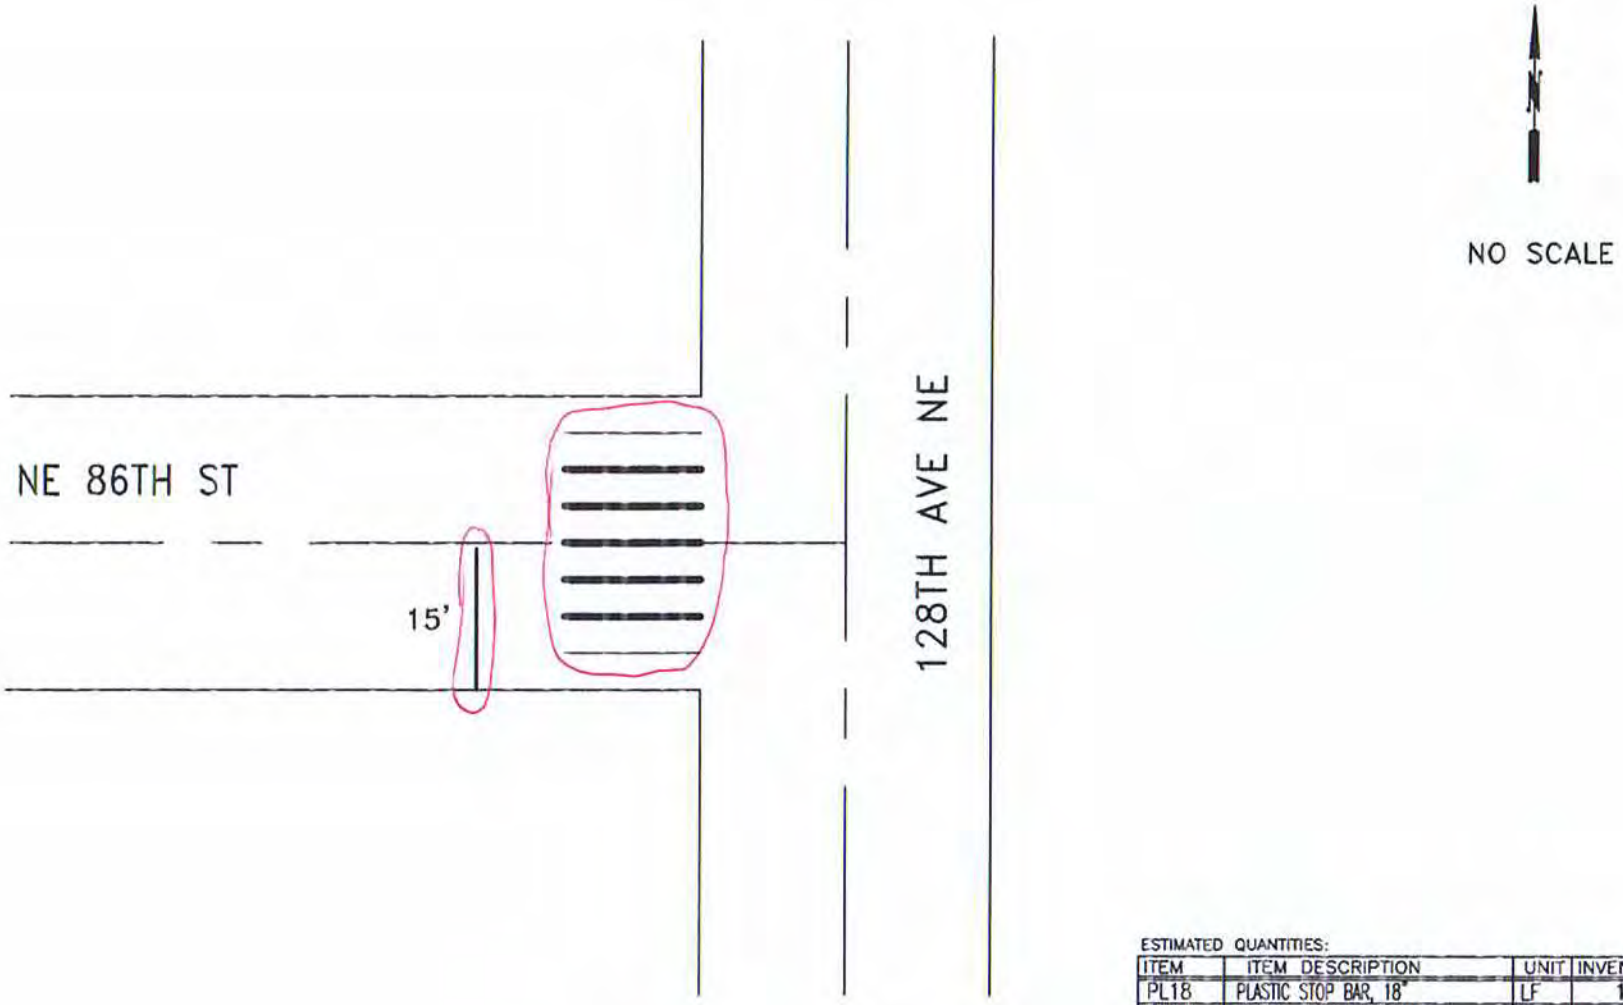

ESTIMATED QUANTITIES:

ITEM	ITEM DESCRIPTION	UNIT	INVENTORY	REPAIR QTY
PL18	PLASTIC STOP BAR, 18"	LF	15	15
PLXW	PLASTIC CROSSWALK STRIPE	SF	120	120
PLARW	PLASTIC TRAFFIC ARROW	EA		
PLLTR	PLASTIC TRAFFIC LETTER, 8 FT HIGH	EA		
PLRR	PLASTIC RAILROAD SYMBOL	EA		
RPLSYM	REMOVE PL. ARROW, LETTER, SYMBOL	EA		
RRPM	REMOVE RPM	EA		
RPLXW	REMOVE PLASTIC STRIPE	SF		130

CITY OF KIRKLAND
DEPARTMENT OF PUBLIC WORKS
123 FIFTH AVENUE KIRKLAND, WA 98033
(425) 587-3800 www.kirklandwa.gov

D.GRILLEY 1/2000
DESIGNED BY: DATE

J.JENNINGS 1/2000
DRAWN BY: DATE

CHECKED BY: DATE

2020 PAVEMENT MARKING PROGRAM

STREET: 128TH AVE NE

CROSS STREET: NE 86TH ST

SEGMENT:

SCALE: N.T.S.

FILENAME: Page 9-48

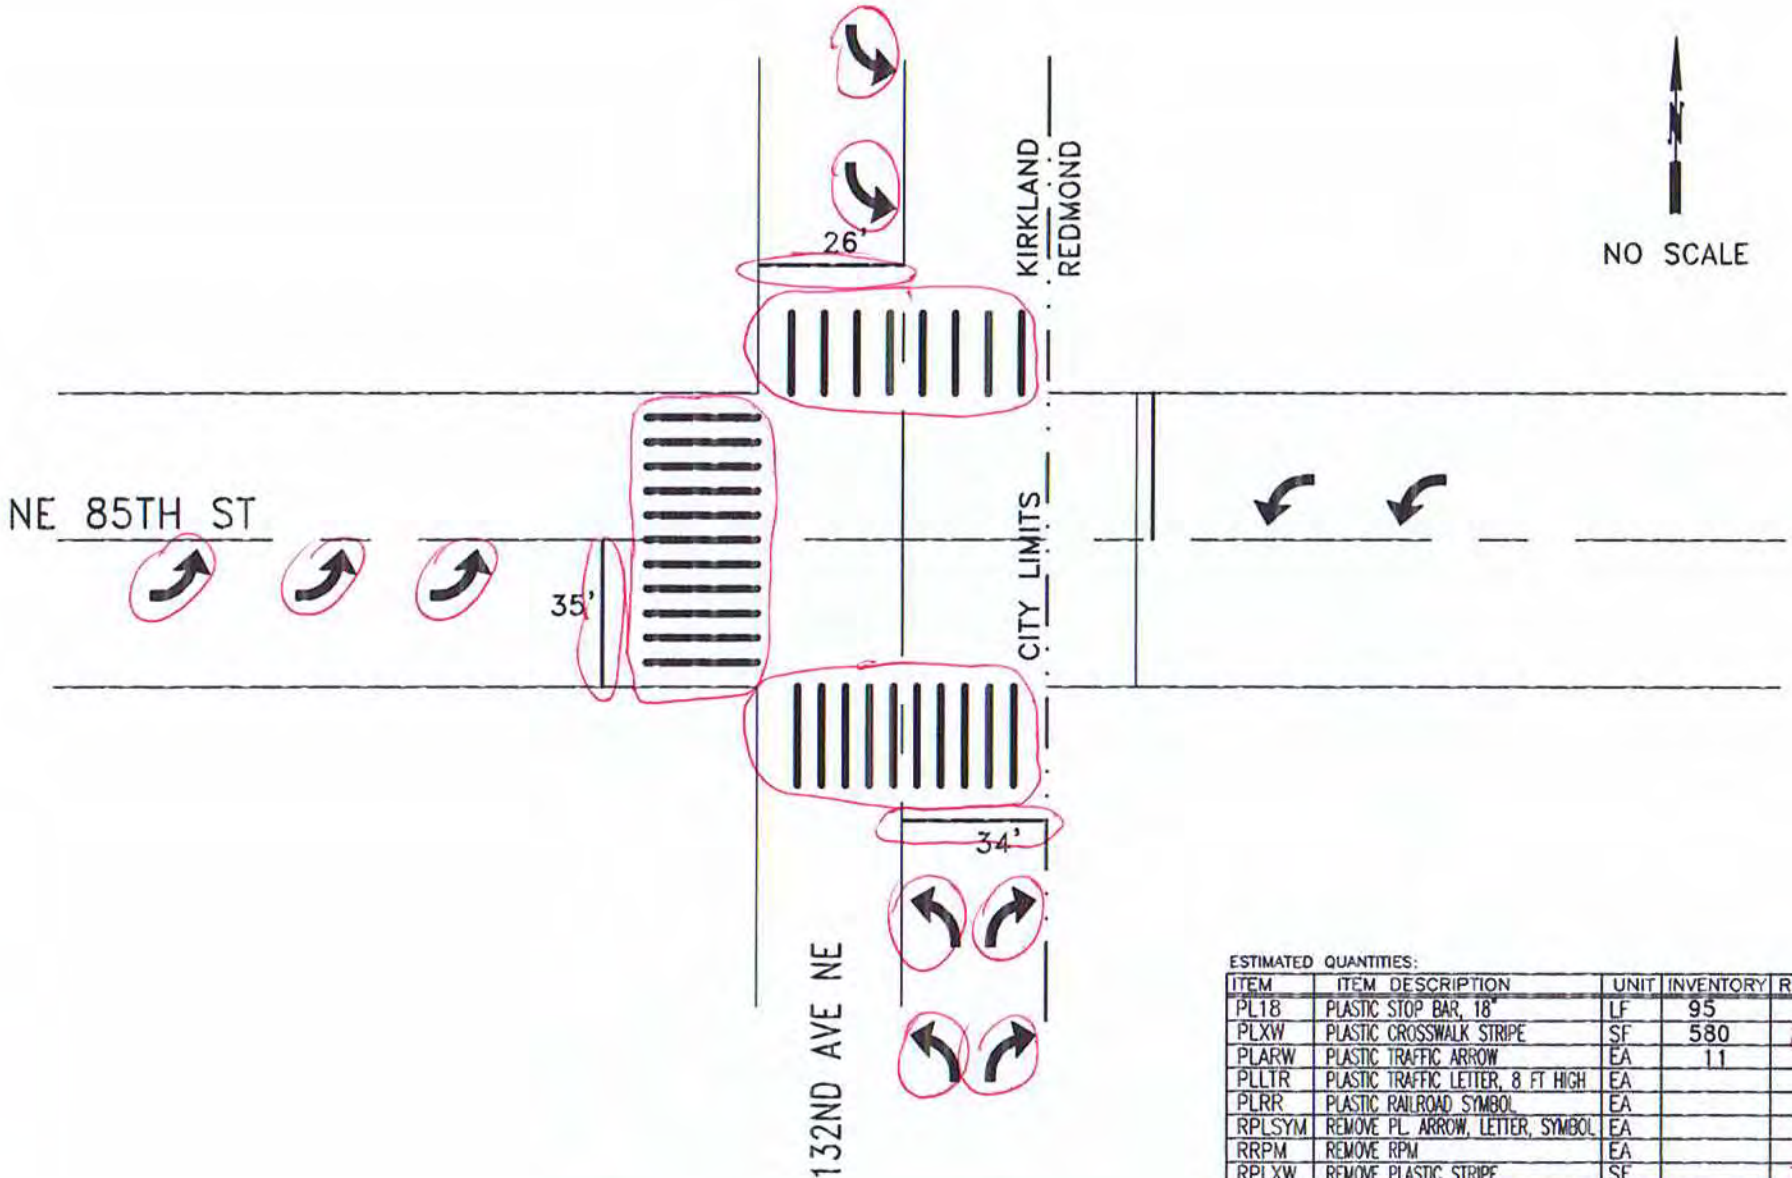

ESTIMATED QUANTITIES:

ITEM	ITEM DESCRIPTION	UNIT	INVENTORY	REPAIR QTY
PL18	PLASTIC STOP BAR, 18"	LF	95	95
PLXW	PLASTIC CROSSWALK STRIPE	SF	580	580
PLARW	PLASTIC TRAFFIC ARROW	EA	11	9
PLLTR	PLASTIC TRAFFIC LETTER, 8 FT HIGH	EA		
PLRR	PLASTIC RAILROAD SYMBOL	EA		
RPLSYM	REMOVE PL. ARROW, LETTER, SYMBOL	EA		6
RRPM	REMOVE RPM	EA		
RPLXW	REMOVE PLASTIC STRIPE	SF		350

CITY OF KIRKLAND
DEPARTMENT OF PUBLIC WORKS
123 FIFTH AVENUE KIRKLAND, WA 98033
(425) 587-3800 www.kirklandwa.gov

R. STEITZER 8/2005
DESIGNED BY: DATE

J.JENNINGS 10/2009
DRAWN BY: DATE

CHECKED BY: DATE

20__ PAVEMENT MARKING PROGRAM

STREET: NE 85TH ST

CROSS STREET: 132ND AVE NE

SEGMENT:

SCALE: N.T.S.

FILENAME: Page 9-49

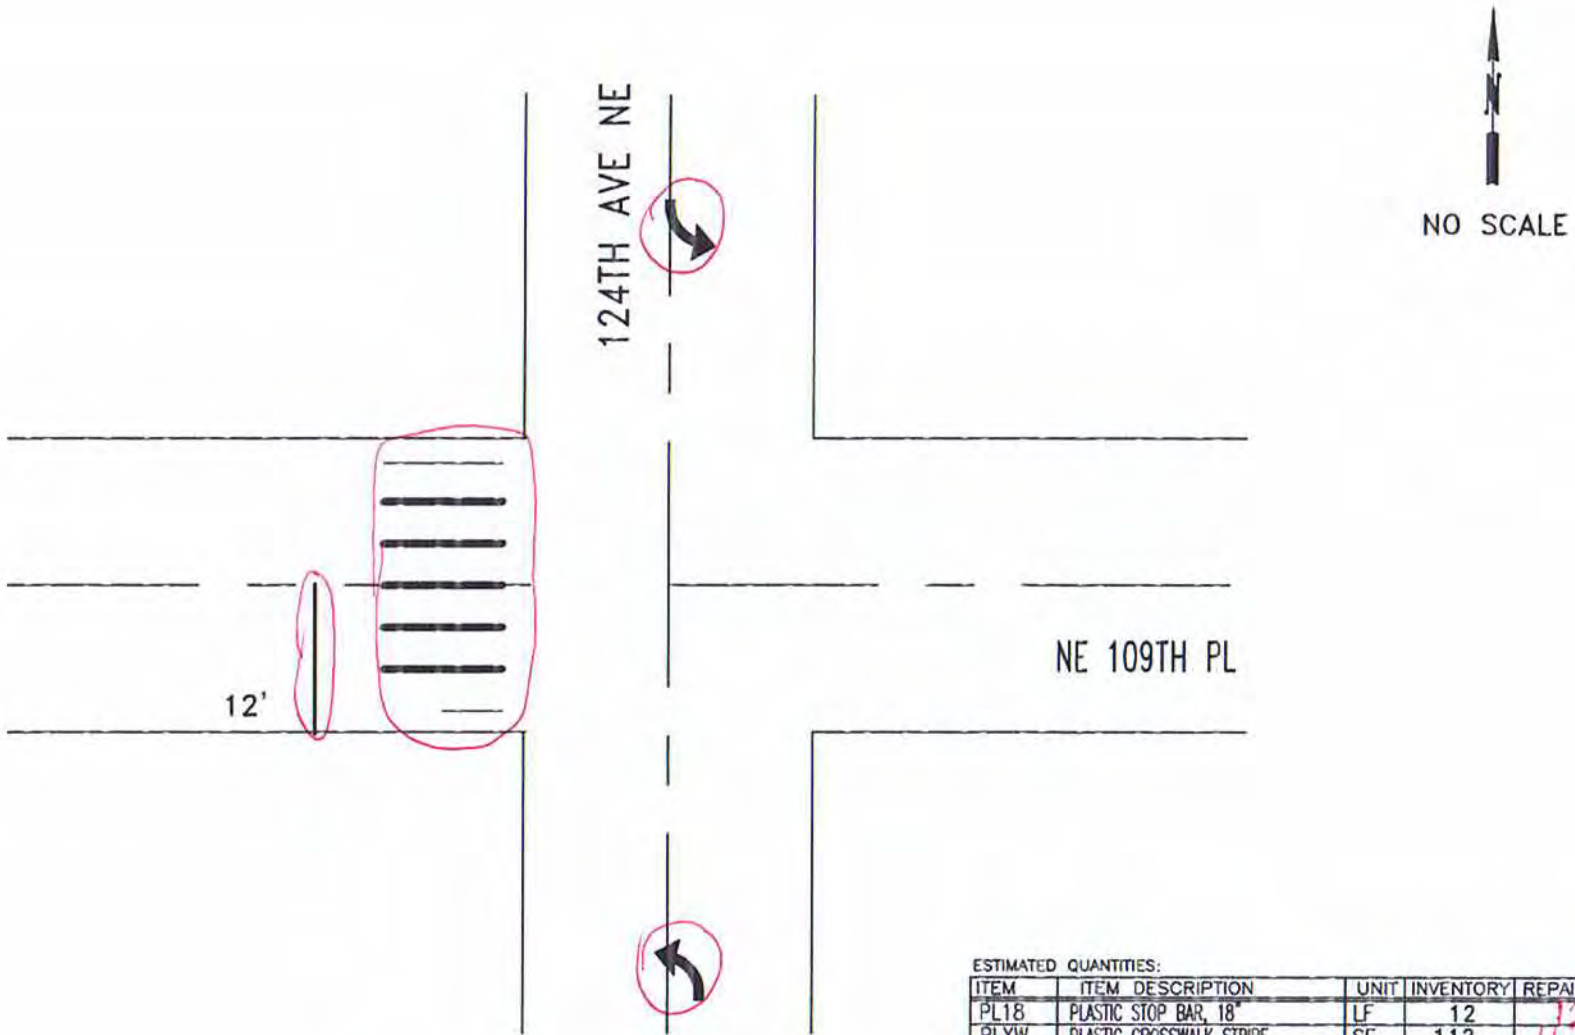

ESTIMATED QUANTITIES:

ITEM	ITEM DESCRIPTION	UNIT	INVENTORY	REPAIR QTY
PL18	PLASTIC STOP BAR, 18"	LF	12	12
PLXW	PLASTIC CROSSWALK STRIPE	SF	112	112
PLARW	PLASTIC TRAFFIC ARROW	EA	2	2
PLLTR	PLASTIC TRAFFIC LETTER, 8 FT HIGH	EA		
PLRR	PLASTIC RAILROAD SYMBOL	EA		
RPLSYM	REMOVE PL. ARROW, LETTER, SYMBOL	EA		
RRPM	REMOVE RPM	EA		
RPLXW	REMOVE PLASTIC STRIPE	SF		170

CITY OF KIRKLAND
DEPARTMENT OF PUBLIC WORKS
123 FIFTH AVENUE KIRKLAND, WA 98033
(425) 587-3800 www.kirklandwa.gov

F. LEE 4/2015
DESIGNED BY: DATE

J.JENNINGS 4/2015
DRAWN BY: DATE

CHECKED BY: DATE

2020 PAVEMENT MARKING PROGRAM

STREET: 124TH AVE NE

CROSS STREET: NE 109TH PL

SEGMENT:

SCALE: N.T.S.

FILENAME:

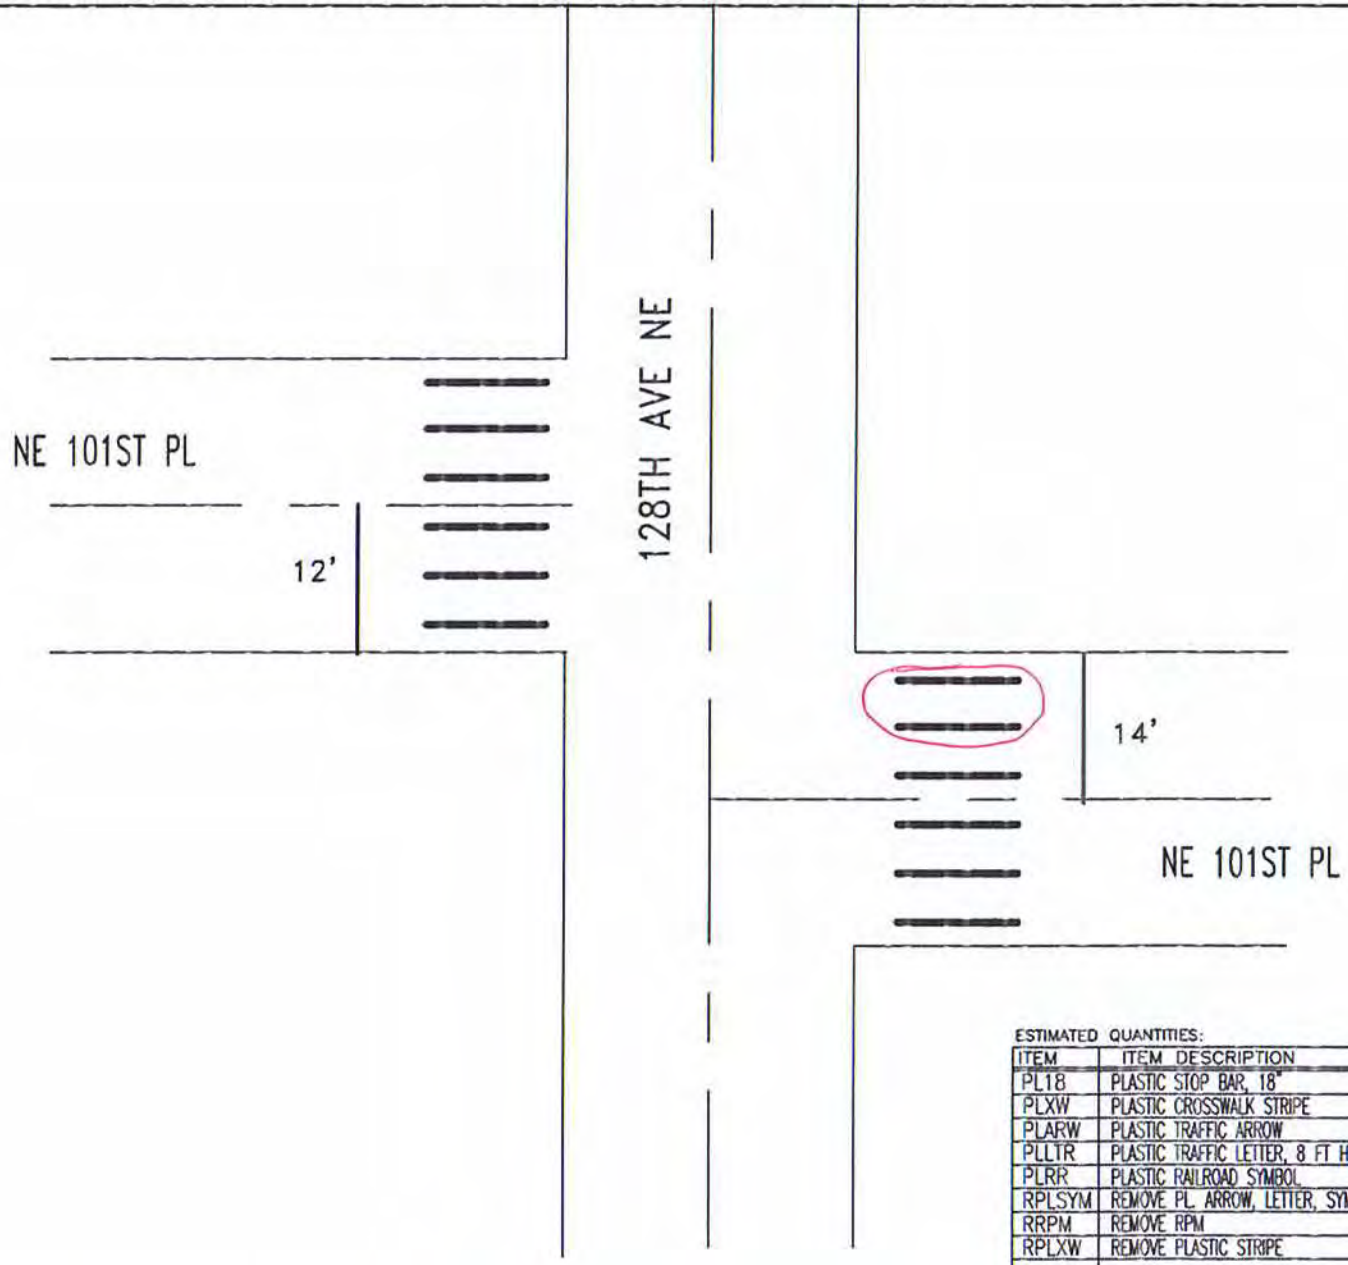

ESTIMATED QUANTITIES:

ITEM	ITEM DESCRIPTION	UNIT	INVENTORY	REPAIR QTY
PL18	PLASTIC STOP BAR, 18"	LF	26	
PLXW	PLASTIC CROSSWALK STRIPE	SF	240	40
PLARW	PLASTIC TRAFFIC ARROW	EA		
PLLTR	PLASTIC TRAFFIC LETTER, 8 FT HIGH	EA		
PLRR	PLASTIC RAILROAD SYMBOL	EA		
RPLSYM	REMOVE PL. ARROW, LETTER, SYMBOL	EA		
RRPM	REMOVE RPM	EA		
RPLXW	REMOVE PLASTIC STRIPE	SF		40

CITY OF KIRKLAND
DEPARTMENT OF PUBLIC WORKS
123 FIFTH AVENUE KIRKLAND, WA 98033
(425) 587-3800 www.kirklandwa.gov

L KAWAOKA 3/2016
DESIGNED BY: DATE

J.JENNINGS 3/2016
DRAWN BY: DATE

CHECKED BY: DATE

2020 PAVEMENT MARKING PROGRAM

STREET: 128TH AVE NE

CROSS STREET: NE 101ST PL

SEGMENT:

SCALE: N.T.S.

FILENAME: Page 9-51

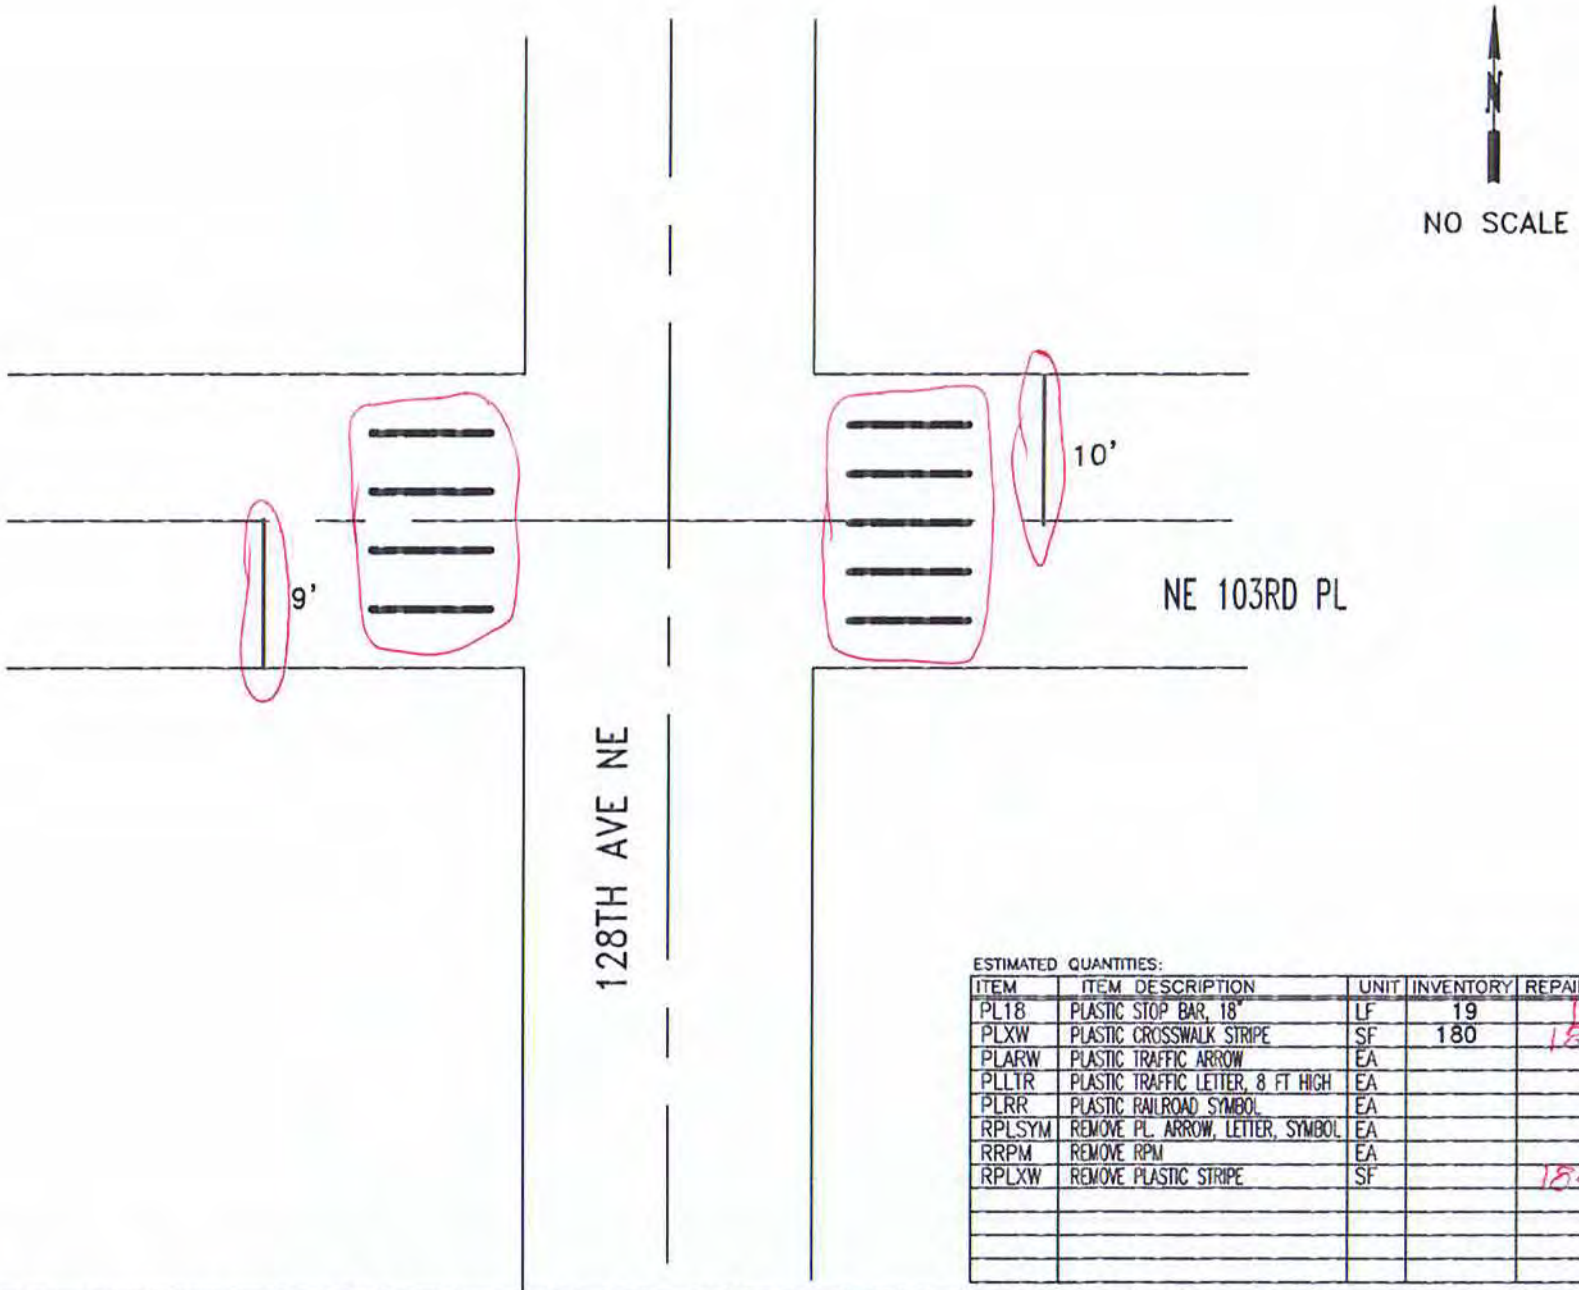

ESTIMATED QUANTITIES:

ITEM	ITEM DESCRIPTION	UNIT	INVENTORY	REPAIR QTY
PL18	PLASTIC STOP BAR, 18"	LF	19	19
PLXW	PLASTIC CROSSWALK STRIPE	SF	180	180
PLARW	PLASTIC TRAFFIC ARROW	EA		
PLLTR	PLASTIC TRAFFIC LETTER, 8 FT HIGH	EA		
PLRR	PLASTIC RAILROAD SYMBOL	EA		
RPLSYM	REMOVE PL. ARROW, LETTER, SYMBOL	EA		
RRPM	REMOVE RPM	EA		
RPLXW	REMOVE PLASTIC STRIPE	SF		180

CITY OF KIRKLAND
DEPARTMENT OF PUBLIC WORKS
123 FIFTH AVENUE KIRKLAND, WA 98033
(425) 587-3800 www.kirklandwa.gov

L. KAWAOKA 3/2016
DESIGNED BY: DATE

J.JENNINGS 3/2016
DRAWN BY: DATE

CHECKED BY: DATE

2022 PAVEMENT MARKING PROGRAM

STREET: 128TH AVE NE

CROSS STREET: NE 103RD PL

SEGMENT:

SCALE: N.T.S.

FILENAME: Page 9-53

SOUTH ROSE HILL INTERSECTION PLANS

CITY OF KIRKLAND
DEPARTMENT OF PUBLIC WORKS
123 FIFTH AVENUE KIRKLAND, WA 98033
(425) 587-3800 www.kirklandwa.gov

S GONSAR	1/2019	DESIGNED BY: DATE
J.JENNINGS	1/2019	DRAWN BY: DATE
		CHECKED BY: DATE

2020 PAVEMENT MARKING PROGRAM

STREET:

CROSS STREET:

SEGMENT:

SCALE: N.T.S.

FILENAME: 12-0

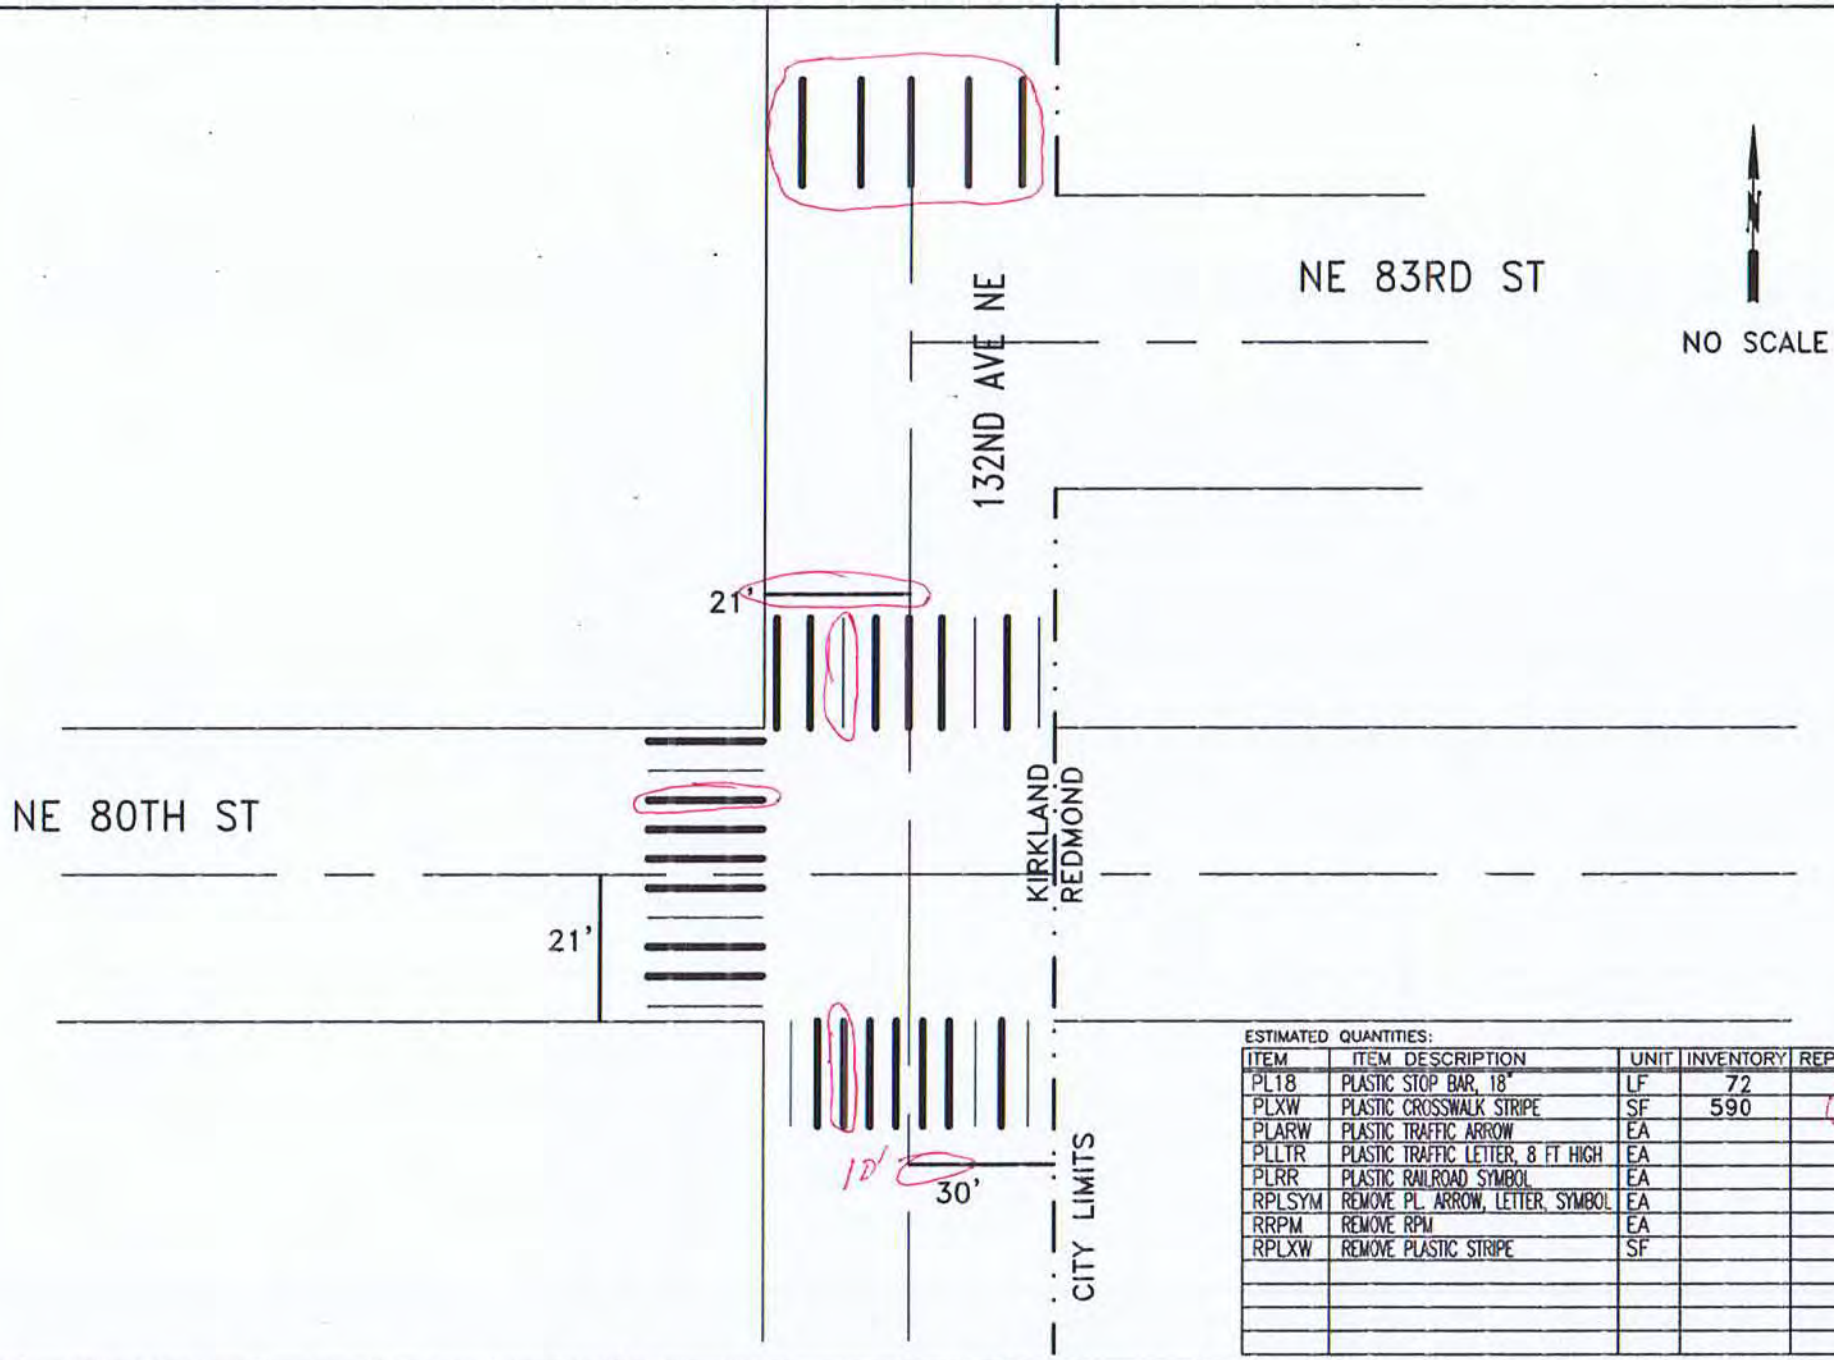

ESTIMATED QUANTITIES:

ITEM	ITEM DESCRIPTION	UNIT	INVENTORY	REPAIR QTY
PL18	PLASTIC STOP BAR, 18"	LF	72	10
PLXW	PLASTIC CROSSWALK STRIPE	SF	590	150
PLARW	PLASTIC TRAFFIC ARROW	EA		
PLLTR	PLASTIC TRAFFIC LETTER, 8 FT HIGH	EA		
PLRR	PLASTIC RAILROAD SYMBOL	EA		
RPLSYM	REMOVE PL. ARROW, LETTER, SYMBOL	EA		
RRPM	REMOVE RPM	EA		
RPLXW	REMOVE PLASTIC STRIPE	SF		

CITY OF KIRKLAND
DEPARTMENT OF PUBLIC WORKS
123 FIFTH AVENUE KIRKLAND, WA 98033
(425) 587-3800 www.kirklandwa.gov

S GONSAR 2/2018
DESIGNED BY: DATE

J.JENNINGS 2/2018
DRAWN BY: DATE

CHECKED BY: DATE

2022 PAVEMENT MARKING PROGRAM

STREET: NE 80TH ST

CROSS STREET: 132ND AVE NE

SEGMENT:

SCALE: N.T.S.

FILENAME: Page 12-1

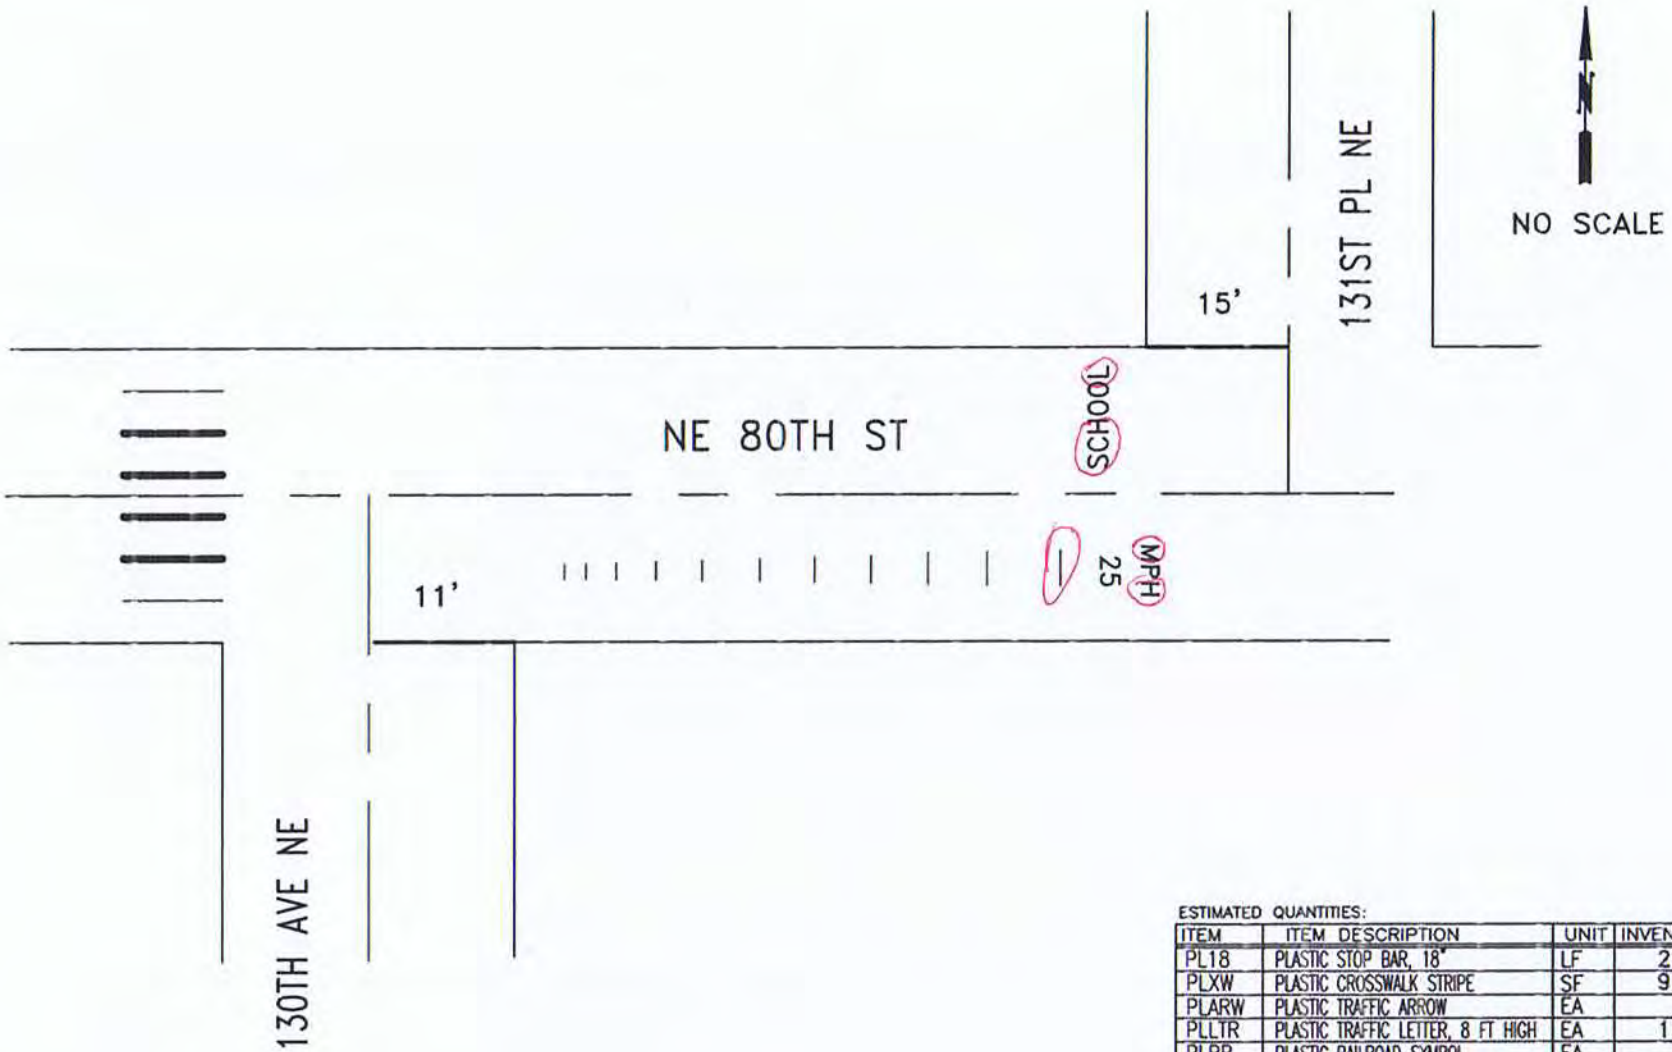

ESTIMATED QUANTITIES:

ITEM	ITEM DESCRIPTION	UNIT	INVENTORY	REPAIR QTY
PL18	PLASTIC STOP BAR, 18"	LF	26	
PLXW	PLASTIC CROSSWALK STRIPE	SF	90	
PLARW	PLASTIC TRAFFIC ARROW	EA		
PLLTR	PLASTIC TRAFFIC LETTER, 8 FT HIGH	EA	11	5
PLRR	PLASTIC RAILROAD SYMBOL	EA		
RPLSYM	REMOVE PL. ARROW, LETTER, SYMBOL	EA		
RRPM	REMOVE RPM	EA		
RPLXW	REMOVE PLASTIC STRIPE	SF		
PLLGD	PLASTIC SPEED LEGEND BARS	SF	62	17

CITY OF KIRKLAND
DEPARTMENT OF PUBLIC WORKS
123 FIFTH AVENUE KIRKLAND, WA 98033
(425) 587-3800 www.kirklandwa.gov

S. GONSAR 1/2020
DESIGNED BY: DATE

J.JENNINGS 1/2020
DRAWN BY: DATE

CHECKED BY: DATE

2022 PAVEMENT MARKING PROGRAM

STREET: NE 80TH ST

CROSS STREET: 130TH AVE NE. & 131ST PL NE

SEGMENT:

SCALE: N.T.S.

FILENAME: Page 12-2

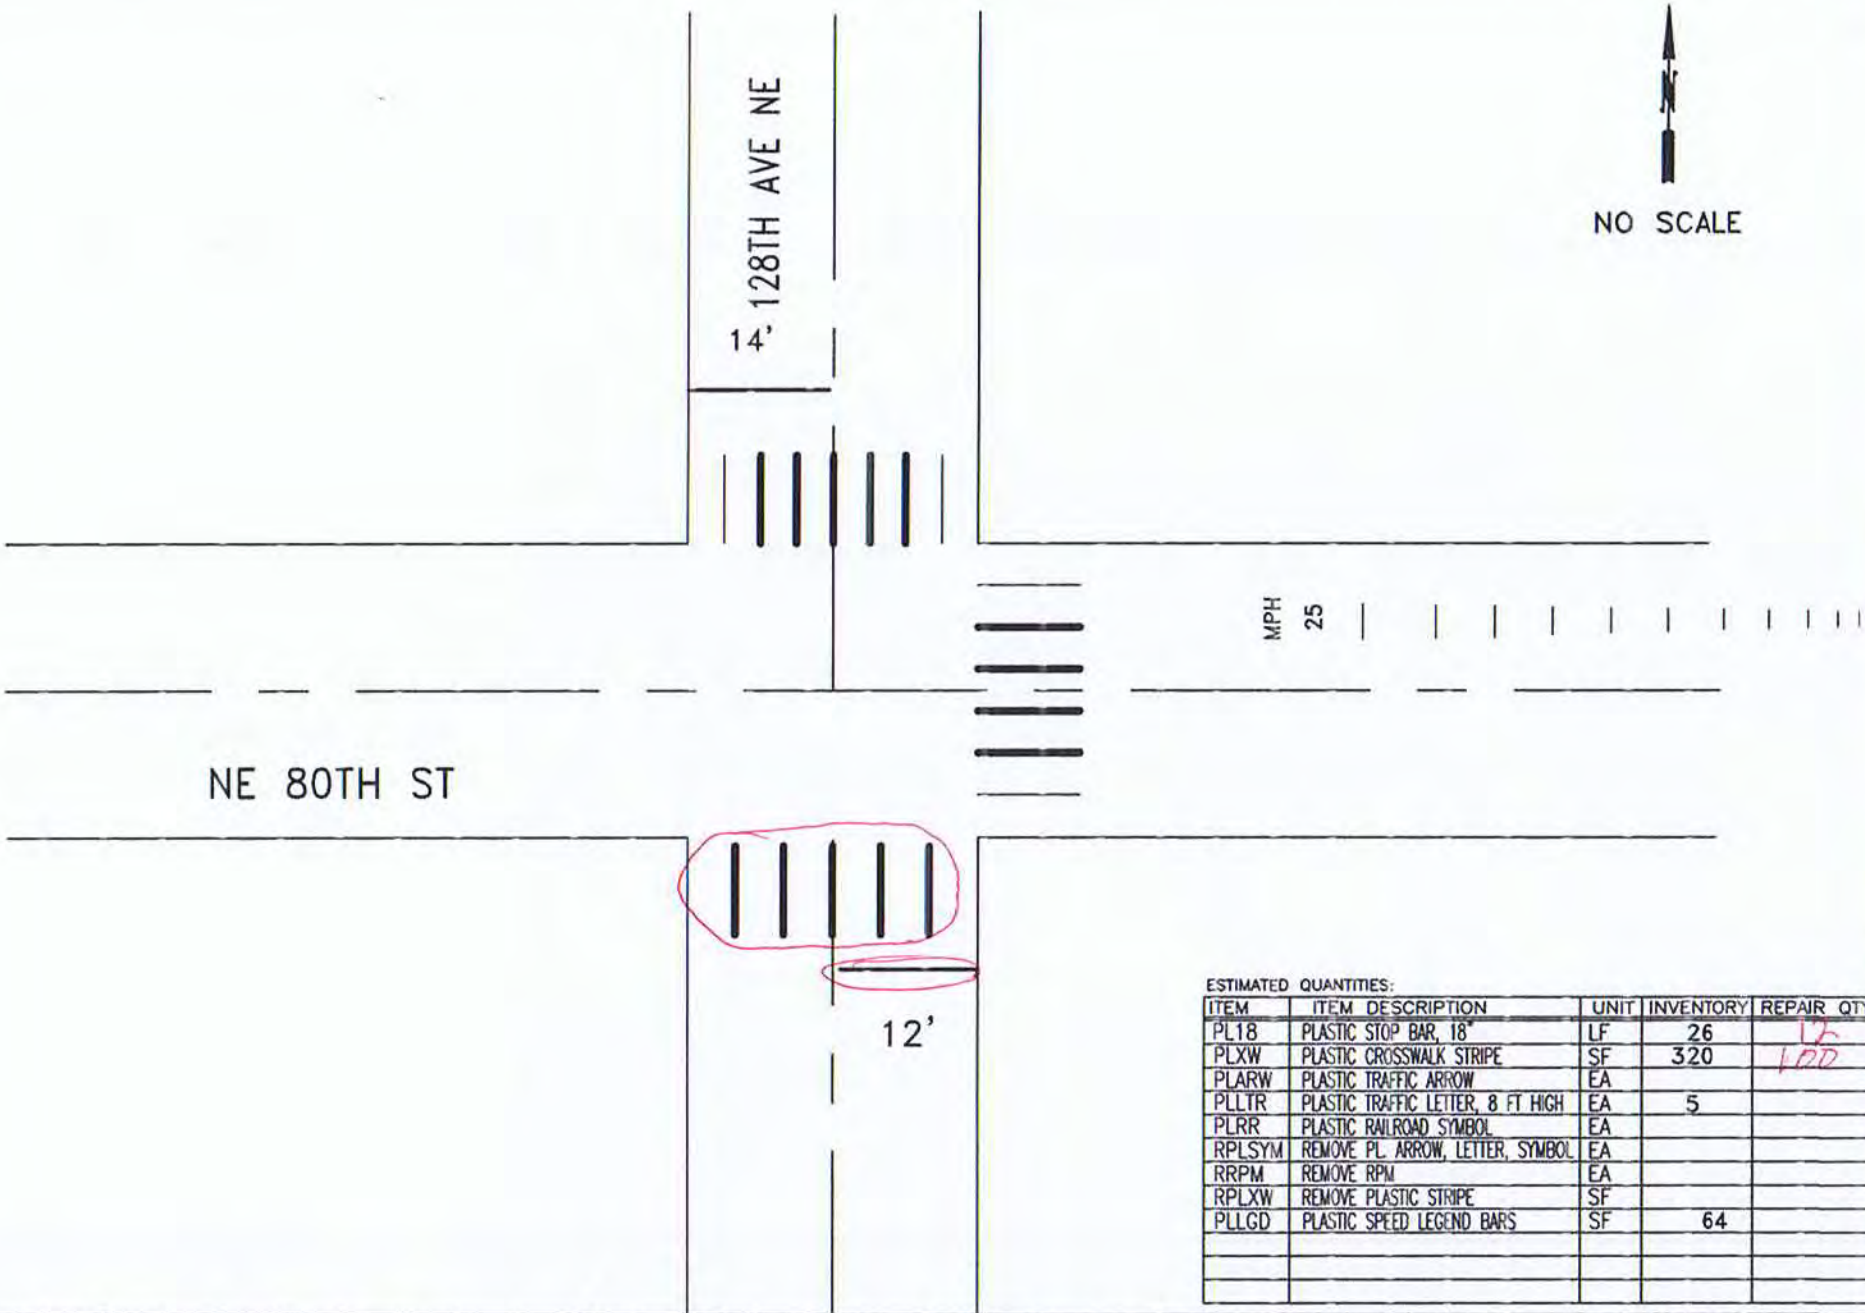

ESTIMATED QUANTITIES:

ITEM	ITEM DESCRIPTION	UNIT	INVENTORY	REPAIR QTY
PL18	PLASTIC STOP BAR, 18"	LF	26	12
PLXW	PLASTIC CROSSWALK STRIPE	SF	320	100
PLARW	PLASTIC TRAFFIC ARROW	EA		
PLLTR	PLASTIC TRAFFIC LETTER, 8 FT HIGH	EA	5	
PLRR	PLASTIC RAILROAD SYMBOL	EA		
RPLSYM	REMOVE PL. ARROW, LETTER, SYMBOL	EA		
RRPM	REMOVE RPM	EA		
RPLXW	REMOVE PLASTIC STRIPE	SF		
PLLGD	PLASTIC SPEED LEGEND BARS	SF	64	

CITY OF KIRKLAND WASHINGTON

CITY OF KIRKLAND
DEPARTMENT OF PUBLIC WORKS
123 FIFTH AVENUE KIRKLAND, WA 98033
(425) 587-3800 www.kirklandwa.gov

S.GONSAR 2/2018
DESIGNED BY: DATE

J.JENNINGS 2/2018
DRAWN BY: DATE

CHECKED BY: DATE

2022 PAVEMENT MARKING PROGRAM

STREET: NE 80TH ST

CROSS STREET: 128TH AVE NE

SEGMENT:

SCALE: N.T.S.

FILENAME: Page 12-3

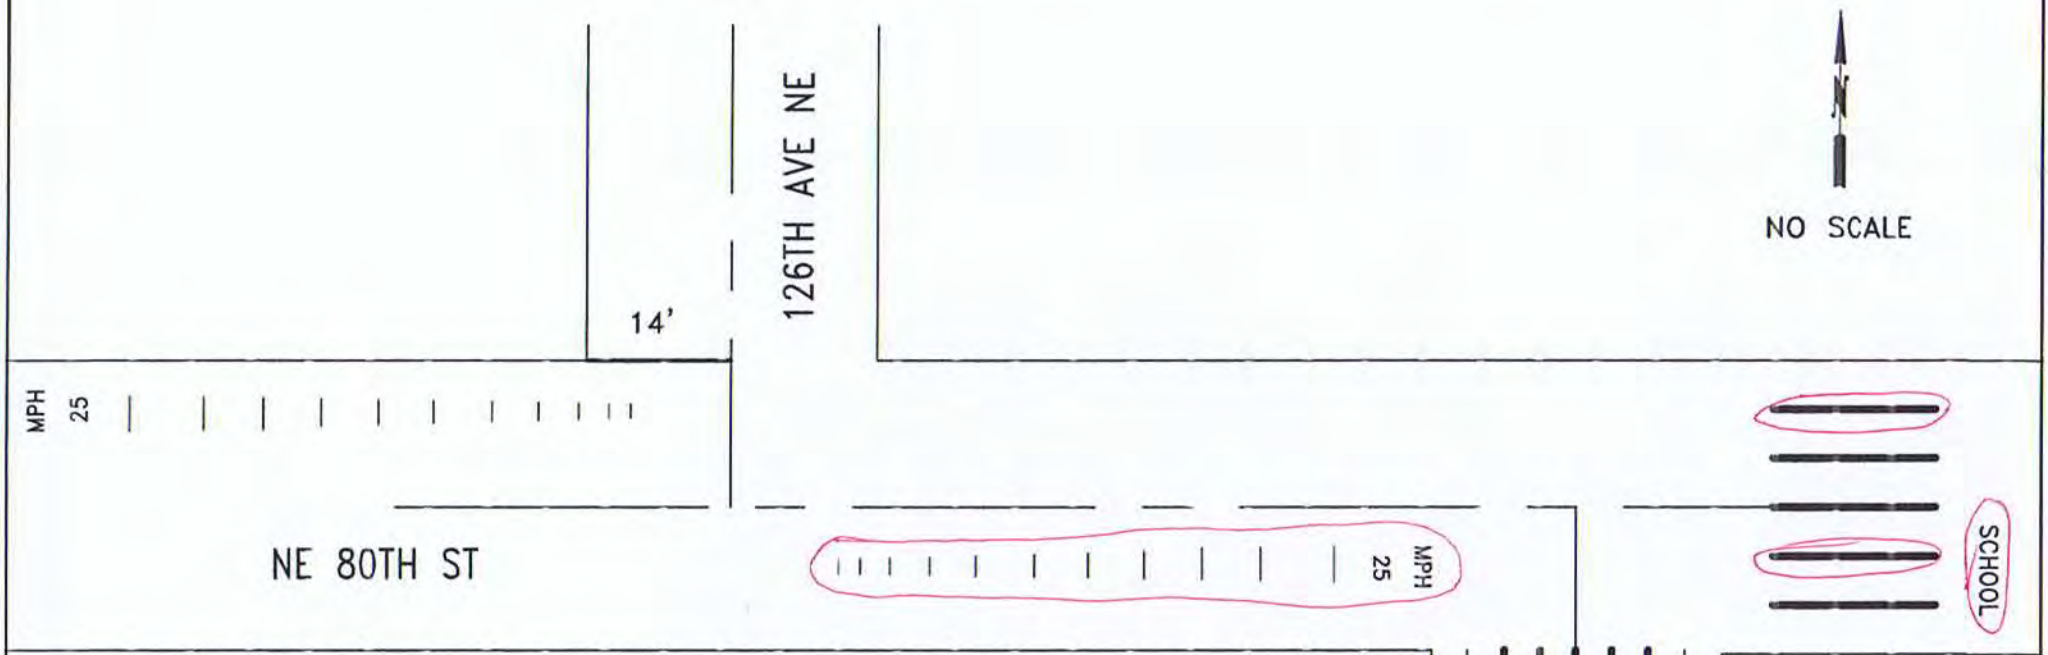

ESTIMATED QUANTITIES:

ITEM	ITEM DESCRIPTION	UNIT	INVENTORY	REPAIR QTY
PL18	PLASTIC STOP BAR, 18"	LF	27	
PLXW	PLASTIC CROSSWALK STRIPE	SF	220	40
PLARW	PLASTIC TRAFFIC ARROW	EA		
PLLTR	PLASTIC TRAFFIC LETTER, 8 FT HIGH	EA	16	11
PLRR	PLASTIC RAILROAD SYMBOL	EA		
RPLSYM	REMOVE PL. ARROW, LETTER, SYMBOL	EA		6
RRPM	REMOVE RPM	EA		
RPLXW	REMOVE PLASTIC STRIPE	SF		
PLLGD	PLASTIC SPEED LEGEND BARS	SF	124	62

CITY OF KIRKLAND
DEPARTMENT OF PUBLIC WORKS
123 FIFTH AVENUE KIRKLAND, WA 98033
(425) 587-3800 www.kirklandwa.gov

D.GRILLEY 1/2000
DESIGNED BY: DATE

J.JENNINGS 1/2000
DRAWN BY: DATE

CHECKED BY: DATE

2020 PAVEMENT MARKING PROGRAM

STREET: NE 80TH ST

CROSS STREET: 126TH AVE NE

SEGMENT:

SCALE: N.T.S.

FILENAME:

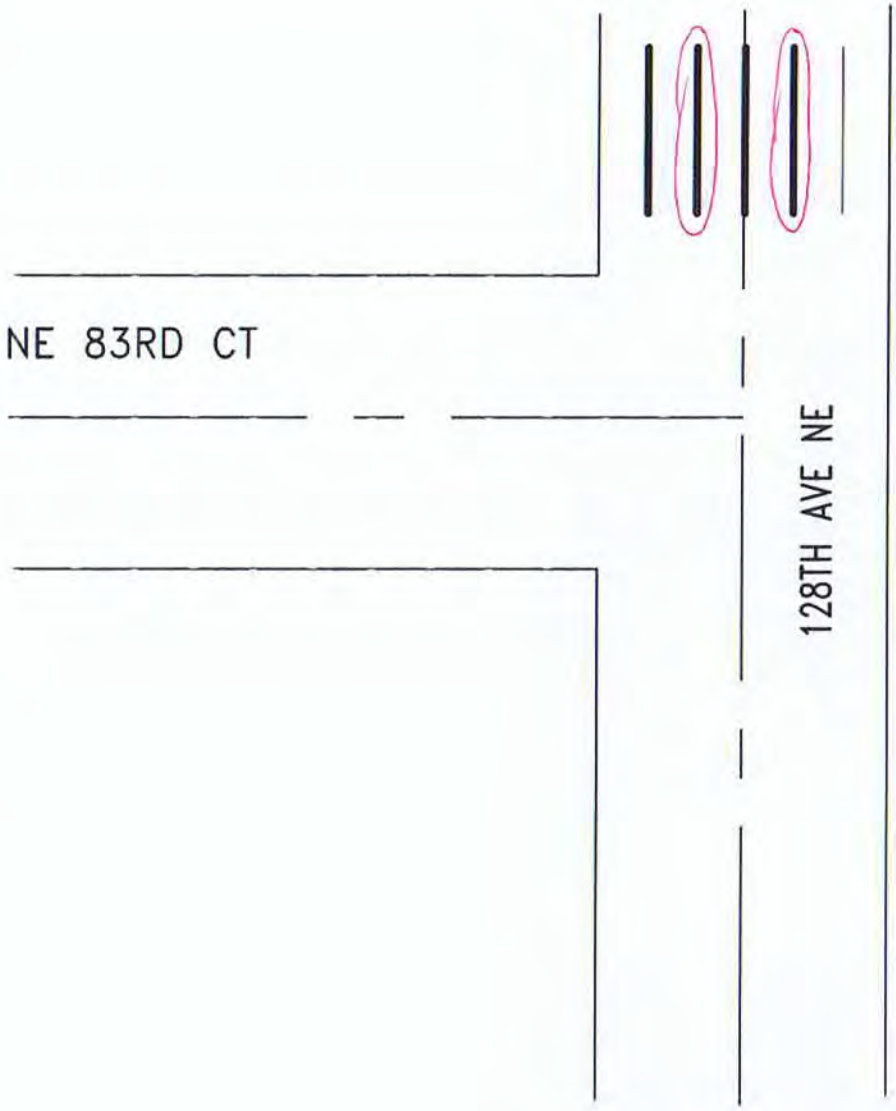

NO SCALE

ROSE HILL
ELEMENTARY SCHOOL

ESTIMATED QUANTITIES:

ITEM	ITEM DESCRIPTION	UNIT	INVENTORY	REPAIR QTY
PL18	PLASTIC STOP BAR, 18"	LF		
PLXW	PLASTIC CROSSWALK STRIPE	SF	90	10
PLARW	PLASTIC TRAFFIC ARROW	EA		
PLLTR	PLASTIC TRAFFIC LETTER, 8 FT HIGH	EA		
PLRR	PLASTIC RAILROAD SYMBOL	EA		
RPLSYM	REMOVE PL. ARROW, LETTER, SYMBOL	EA		
RRPM	REMOVE RPM	EA		
RPLXW	REMOVE PLASTIC STRIPE	SF		

CITY OF KIRKLAND
DEPARTMENT OF PUBLIC WORKS
123 FIFTH AVENUE KIRKLAND, WA 98033
(425) 587-3800 www.kirklandwa.gov

D.GRILLEY 1/2000
DESIGNED BY: DATE

J.JENNINGS 1/2000
DRAWN BY: DATE

CHECKED BY: DATE

2020 PAVEMENT MARKING PROGRAM

STREET: 128TH AVE NE

CROSS STREET: NE 83RD CT

SEGMENT:

SCALE: N.T.S.

FILENAME:

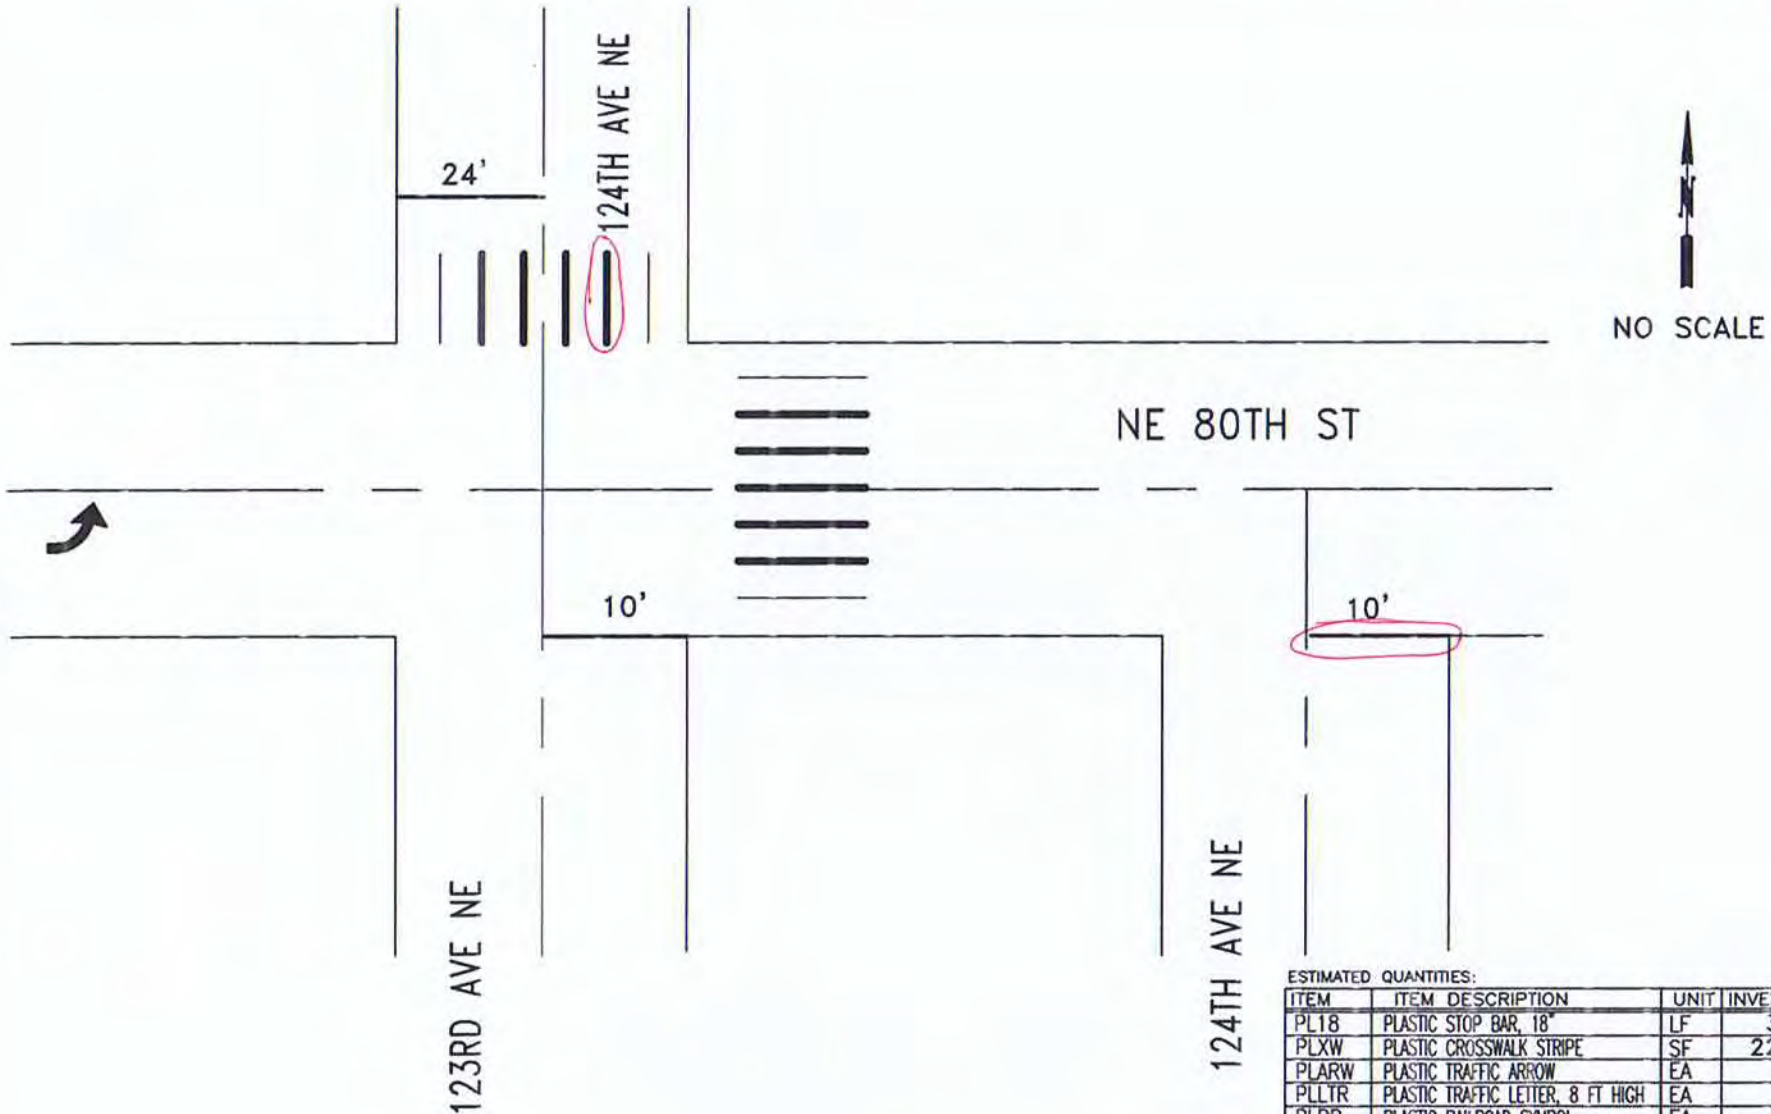

ESTIMATED QUANTITIES:

ITEM	ITEM DESCRIPTION	UNIT	INVENTORY	REPAIR QTY
PL18	PLASTIC STOP BAR, 18"	LF	36	10
PLXW	PLASTIC CROSSWALK STRIPE	SF	220	20
PLARW	PLASTIC TRAFFIC ARROW	EA	1	
PLLTR	PLASTIC TRAFFIC LETTER, 8 FT HIGH	EA		
PLRR	PLASTIC RAILROAD SYMBOL	EA		
RPLSYM	REMOVE PL. ARROW, LETTER, SYMBOL	EA		
RRPM	REMOVE RPM	EA		
RPLXW	REMOVE PLASTIC STRIPE	SF		

CITY OF KIRKLAND
DEPARTMENT OF PUBLIC WORKS
123 FIFTH AVENUE KIRKLAND, WA 98033
(425) 587-3800 www.kirklandwa.gov

G. HORTILLOSA 2/2011
DESIGNED BY: DATE

J.JENNINGS 2/2011
DRAWN BY: DATE

CHECKED BY: DATE

2022 PAVEMENT MARKING PROGRAM

STREET: NE 80TH ST

CROSS STREET: 124TH AVE NE

SEGMENT:

SCALE: N.T.S.

FILENAME: Page 12-6

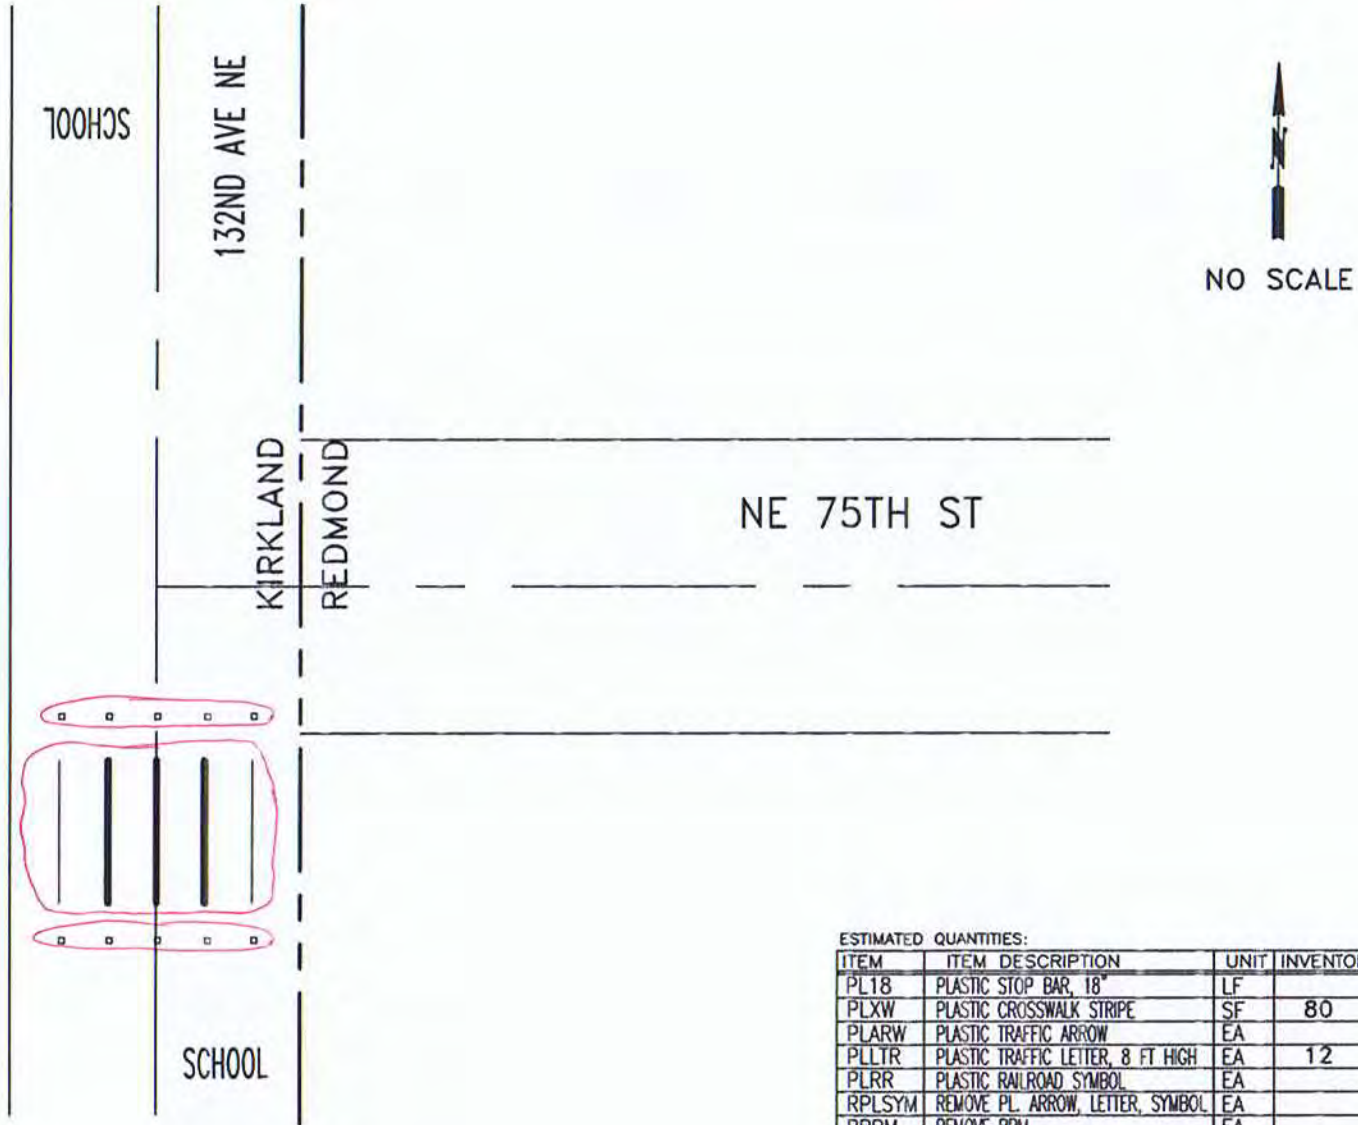

ESTIMATED QUANTITIES:

ITEM	ITEM DESCRIPTION	UNIT	INVENTORY	REPAIR QTY
PL18	PLASTIC STOP BAR, 18"	LF		
PLXW	PLASTIC CROSSWALK STRIPE	SF	80	80
PLARW	PLASTIC TRAFFIC ARROW	EA		
PLLTR	PLASTIC TRAFFIC LETTER, 8 FT HIGH	EA	12	
PLRR	PLASTIC RAILROAD SYMBOL	EA		
RPLSYM	REMOVE PL. ARROW, LETTER, SYMBOL	EA		
RRPM	REMOVE RPM	EA		
RPLXW	REMOVE PLASTIC STRIPE	SF		
RPM11	TYPE 2W RPM	EA	10	10

CITY OF KIRKLAND
DEPARTMENT OF PUBLIC WORKS
123 FIFTH AVENUE KIRKLAND, WA 98033
(425) 587-3800 www.kirklandwa.gov

G. HORTILLOSA 10/2012
DESIGNED BY: DATE

J.JENNINGS 10/2012
DRAWN BY: DATE

CHECKED BY: DATE

2022 PAVEMENT MARKING PROGRAM

STREET: NE 75TH ST

CROSS STREET: 132ND AVE NE

SEGMENT:

SCALE: N.T.S.

FILENAME: Page 12-9

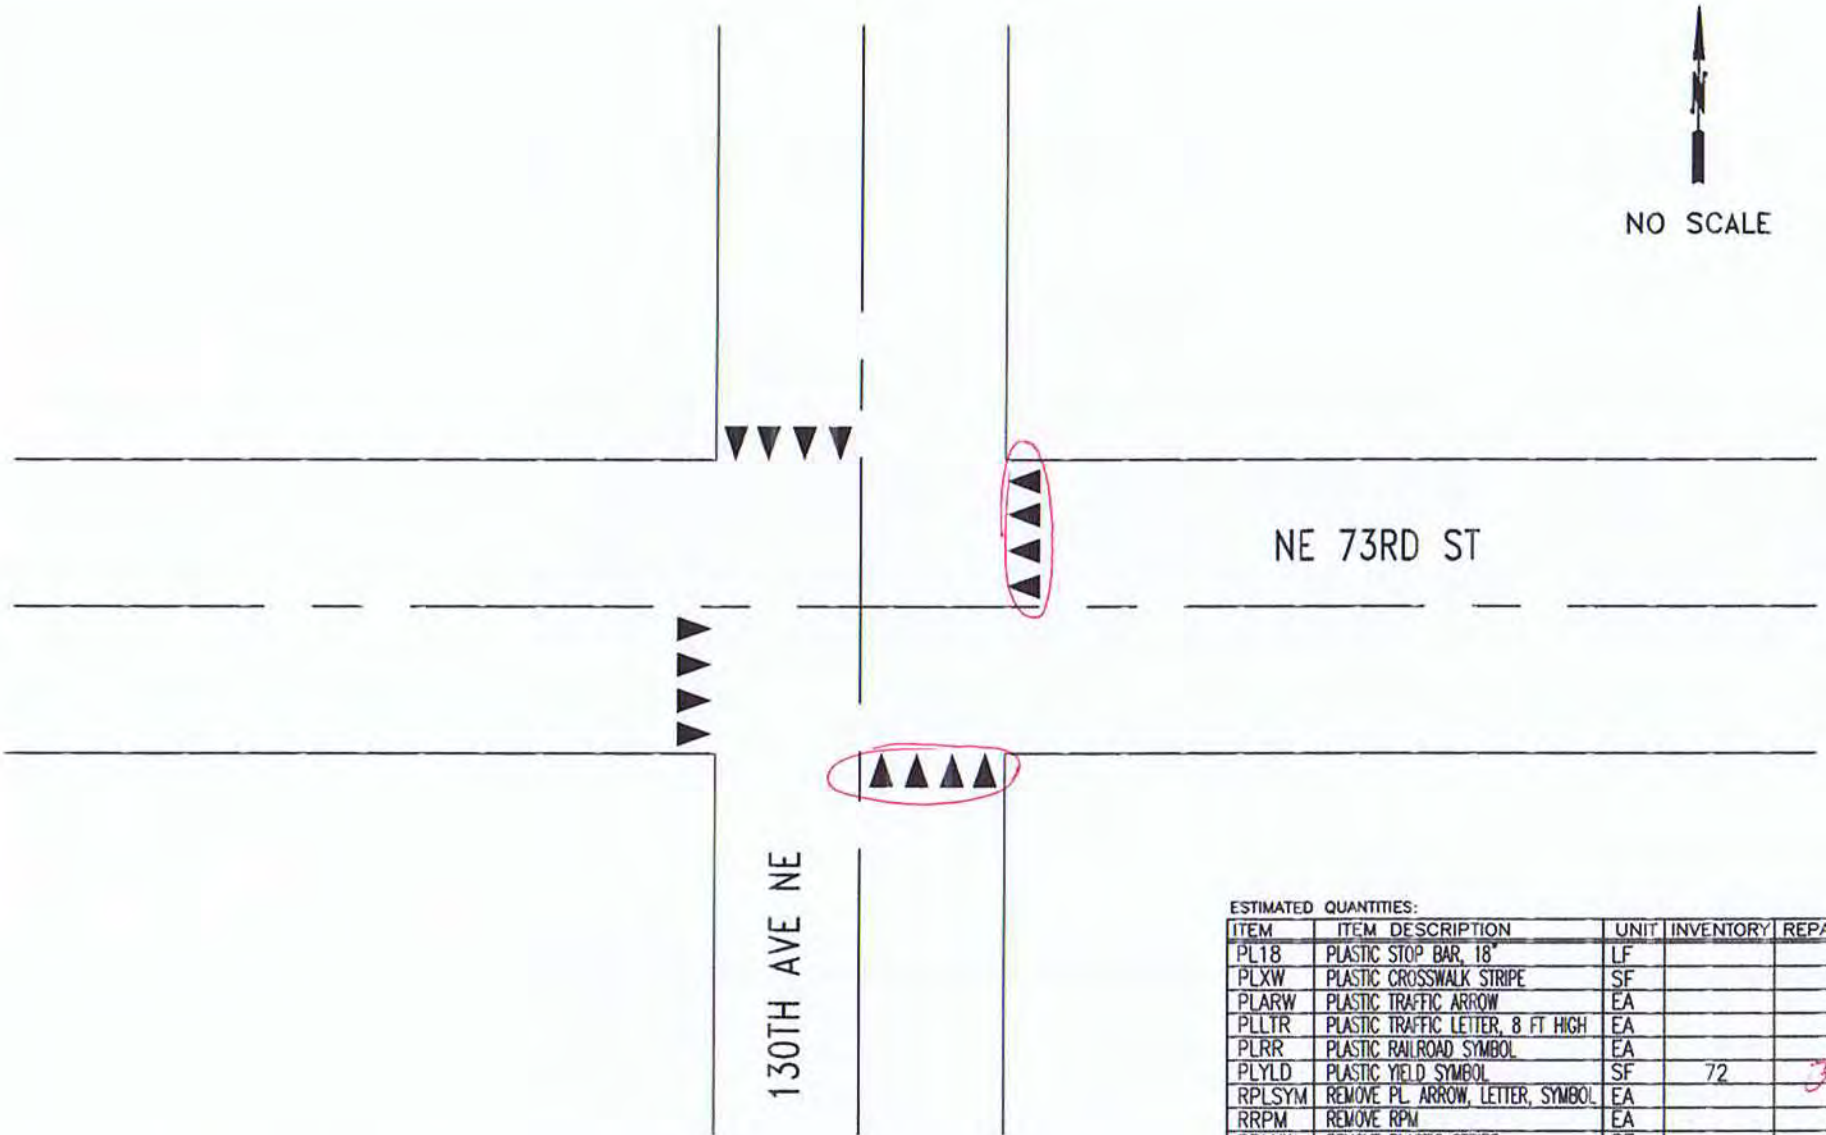

ESTIMATED QUANTITIES:

ITEM	ITEM DESCRIPTION	UNIT	INVENTORY	REPAIR QTY
PL18	PLASTIC STOP BAR, 18"	LF		
PLXW	PLASTIC CROSSWALK STRIPE	SF		
PLARW	PLASTIC TRAFFIC ARROW	EA		
PLLTR	PLASTIC TRAFFIC LETTER, 8 FT HIGH	EA		
PLRR	PLASTIC RAILROAD SYMBOL	EA		
PLYLD	PLASTIC YIELD SYMBOL	SF	72	36
RPLSYM	REMOVE PL. ARROW, LETTER, SYMBOL	EA		
RRPM	REMOVE RPM	EA		
RPLXW	REMOVE PLASTIC STRIPE	SF		

CITY OF KIRKLAND
DEPARTMENT OF PUBLIC WORKS
123 FIFTH AVENUE KIRKLAND, WA 98033
(425) 587-3800 www.kirklandwa.gov

D.GRILLEY 1/2000
DESIGNED BY: DATE

J.JENNINGS 1/2000
DRAWN BY: DATE

CHECKED BY: DATE

2022 PAVEMENT MARKING PROGRAM

STREET: NE 73RD ST

CROSS STREET: 130TH AVE NE

SEGMENT:

SCALE: N.T.S.

FILENAME: Page 12-10

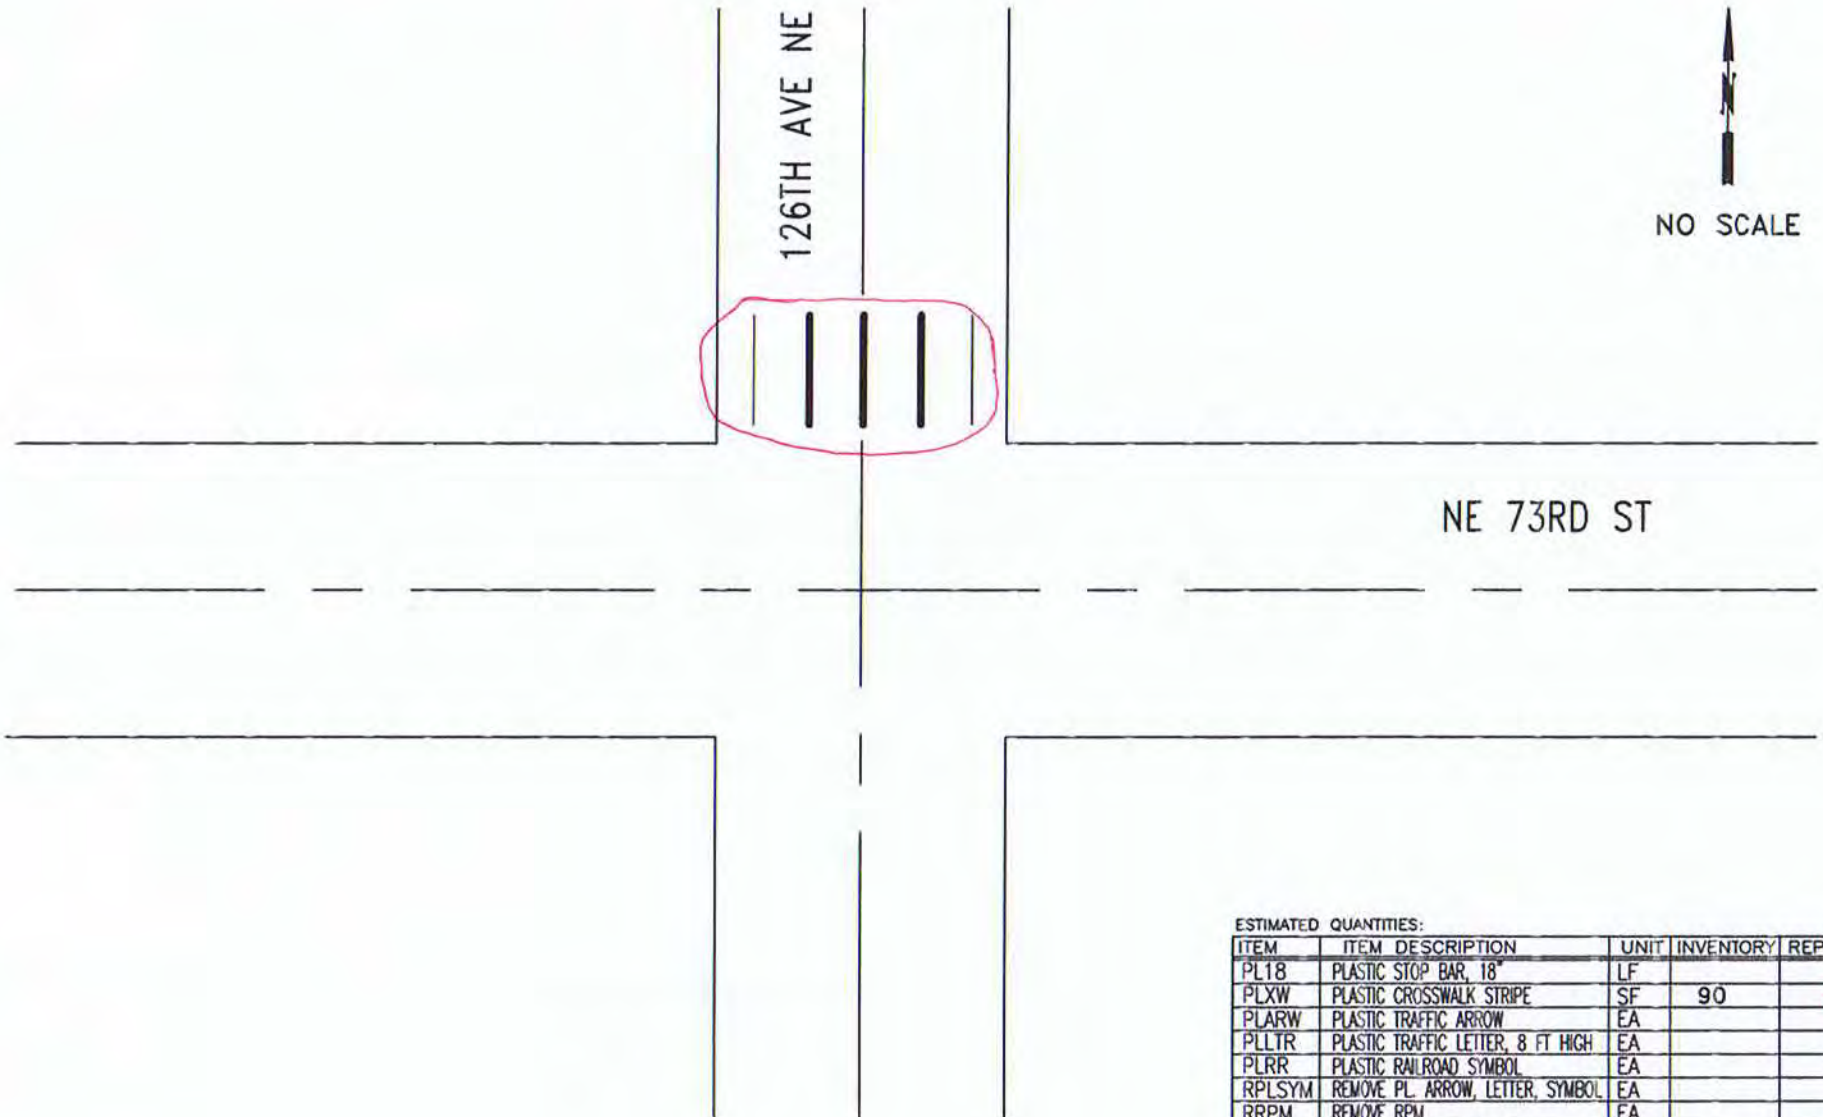

ESTIMATED QUANTITIES:

ITEM	ITEM DESCRIPTION	UNIT	INVENTORY	REPAIR QTY
PL18	PLASTIC STOP BAR, 18"	LF		
PLXW	PLASTIC CROSSWALK STRIPE	SF	90	80
PLARW	PLASTIC TRAFFIC ARROW	EA		
PLLTR	PLASTIC TRAFFIC LETTER, 8 FT HIGH	EA		
PLRR	PLASTIC RAILROAD SYMBOL	EA		
RPLSYM	REMOVE PL. ARROW, LETTER, SYMBOL	EA		
RRPM	REMOVE RPM	EA		
RPLXW	REMOVE PLASTIC STRIPE	SF		80

CITY OF KIRKLAND
DEPARTMENT OF PUBLIC WORKS
123 FIFTH AVENUE KIRKLAND, WA 98033
(425) 587-3800 www.kirklandwa.gov

G. HORTILLOSA 10/2011
DESIGNED BY: DATE

J.JENNINGS 10/2011
DRAWN BY: DATE

CHECKED BY: DATE

2022 PAVEMENT MARKING PROGRAM

STREET: NE 73RD ST

CROSS STREET: 126TH AVE NE

SEGMENT:

SCALE: N.T.S.

FILENAME: Page 12-12

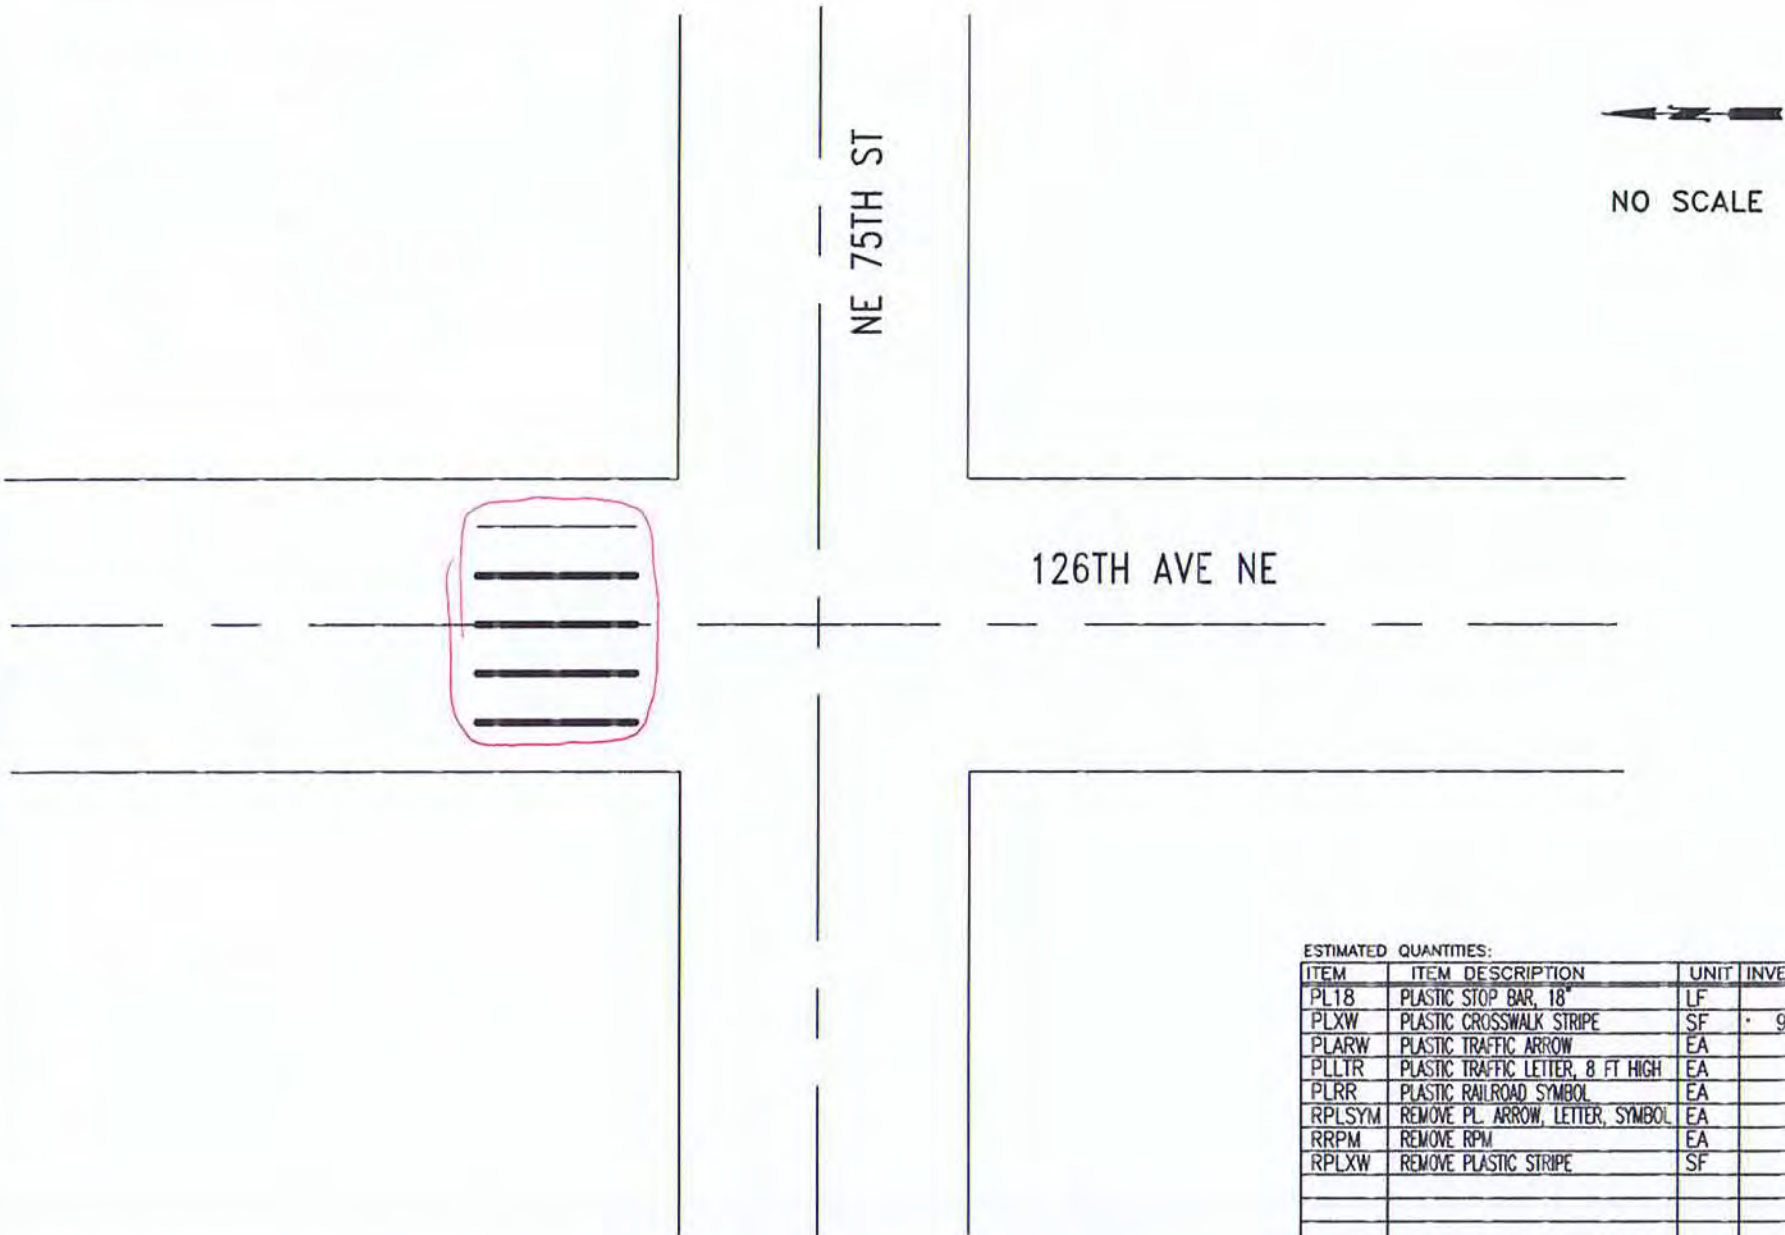

ESTIMATED QUANTITIES:

ITEM	ITEM DESCRIPTION	UNIT	INVENTORY	REPAIR QTY
PL18	PLASTIC STOP BAR, 18"	LF		
PLXW	PLASTIC CROSSWALK STRIPE	SF	90	90
PLARW	PLASTIC TRAFFIC ARROW	EA		
PLLTR	PLASTIC TRAFFIC LETTER, 8 FT HIGH	EA		
PLRR	PLASTIC RAILROAD SYMBOL	EA		
RPLSYM	REMOVE PL. ARROW, LETTER, SYMBOL	EA		
RRPM	REMOVE RPM	EA		
RPLXW	REMOVE PLASTIC STRIPE	SF		60

CITY OF KIRKLAND
DEPARTMENT OF PUBLIC WORKS
123 FIFTH AVENUE KIRKLAND, WA 98033
(425) 587-3800 www.kirklandwa.gov

G. HORTILLOSA 5/2006
DESIGNED BY: DATE

J.JENNINGS 5/2006
DRAWN BY: DATE

CHECKED BY: DATE

2022 PAVEMENT MARKING PROGRAM

STREET: 126TH AVE NE

CROSS STREET: NE 75TH ST

SEGMENT:

SCALE: N.T.S.

FILENAME: PAGE 12-13

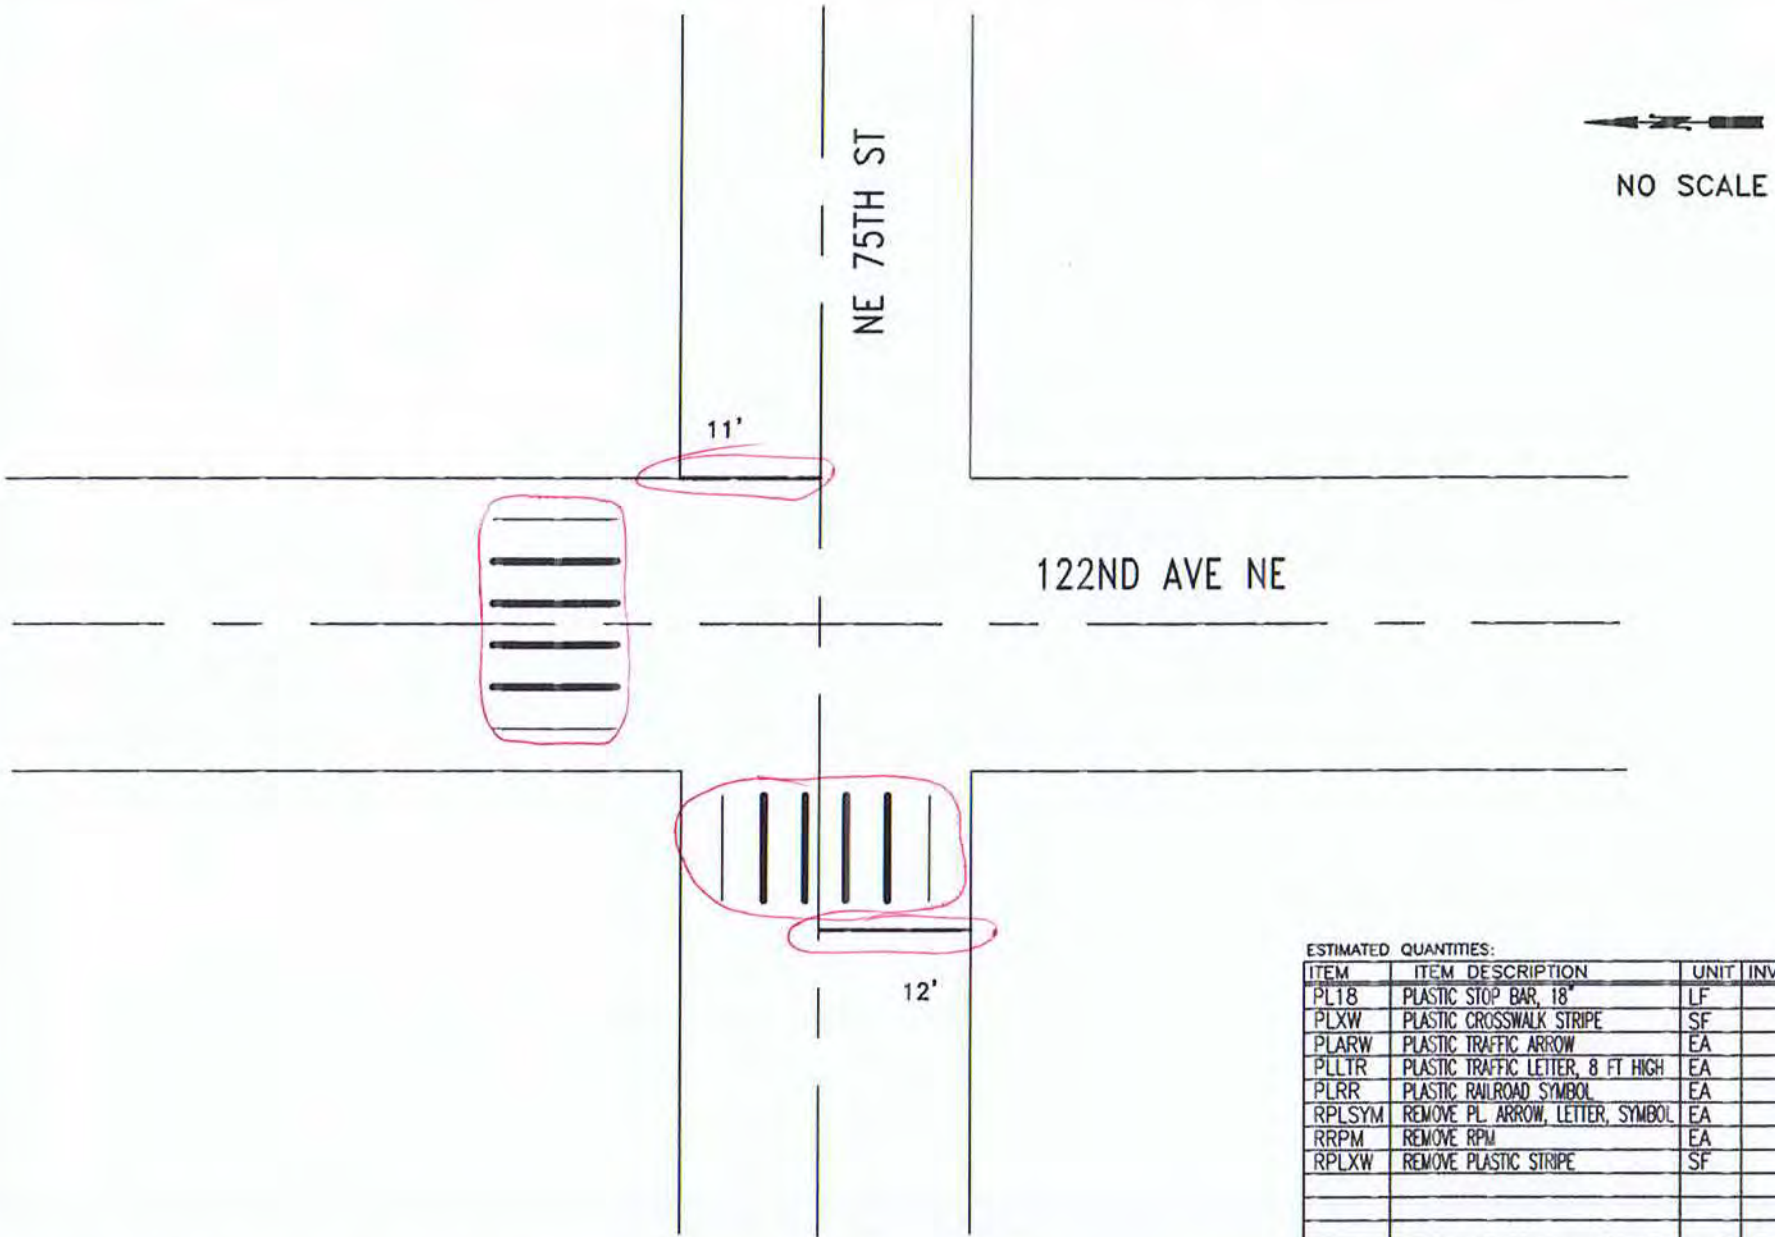

ESTIMATED QUANTITIES:

ITEM	ITEM DESCRIPTION	UNIT	INVENTORY	REPAIR QTY
PL18	PLASTIC STOP BAR, 18"	LF	26	35
PLXW	PLASTIC CROSSWALK STRIPE	SF	200	200
PLARW	PLASTIC TRAFFIC ARROW	EA		
PLLTR	PLASTIC TRAFFIC LETTER, 8 FT HIGH	EA		
PLRR	PLASTIC RAILROAD SYMBOL	EA		
RPLSYM	REMOVE PL. ARROW, LETTER, SYMBOL	EA		
RRPM	REMOVE RPM	EA		
RPLXW	REMOVE PLASTIC STRIPE	SF		80

CITY OF KIRKLAND
DEPARTMENT OF PUBLIC WORKS
123 FIFTH AVENUE KIRKLAND, WA 98033
(425) 587-3800 www.kirklandwa.gov

G. HORTILLOSA 5/2006
DESIGNED BY: DATE

J.JENNINGS 5/2006
DRAWN BY: DATE

CHECKED BY: DATE

2022 PAVEMENT MARKING PROGRAM

STREET: 122ND AVE NE

CROSS STREET: NE 75TH ST

SEGMENT:

SCALE: N.T.S.

FILENAME: PAGE 12-14

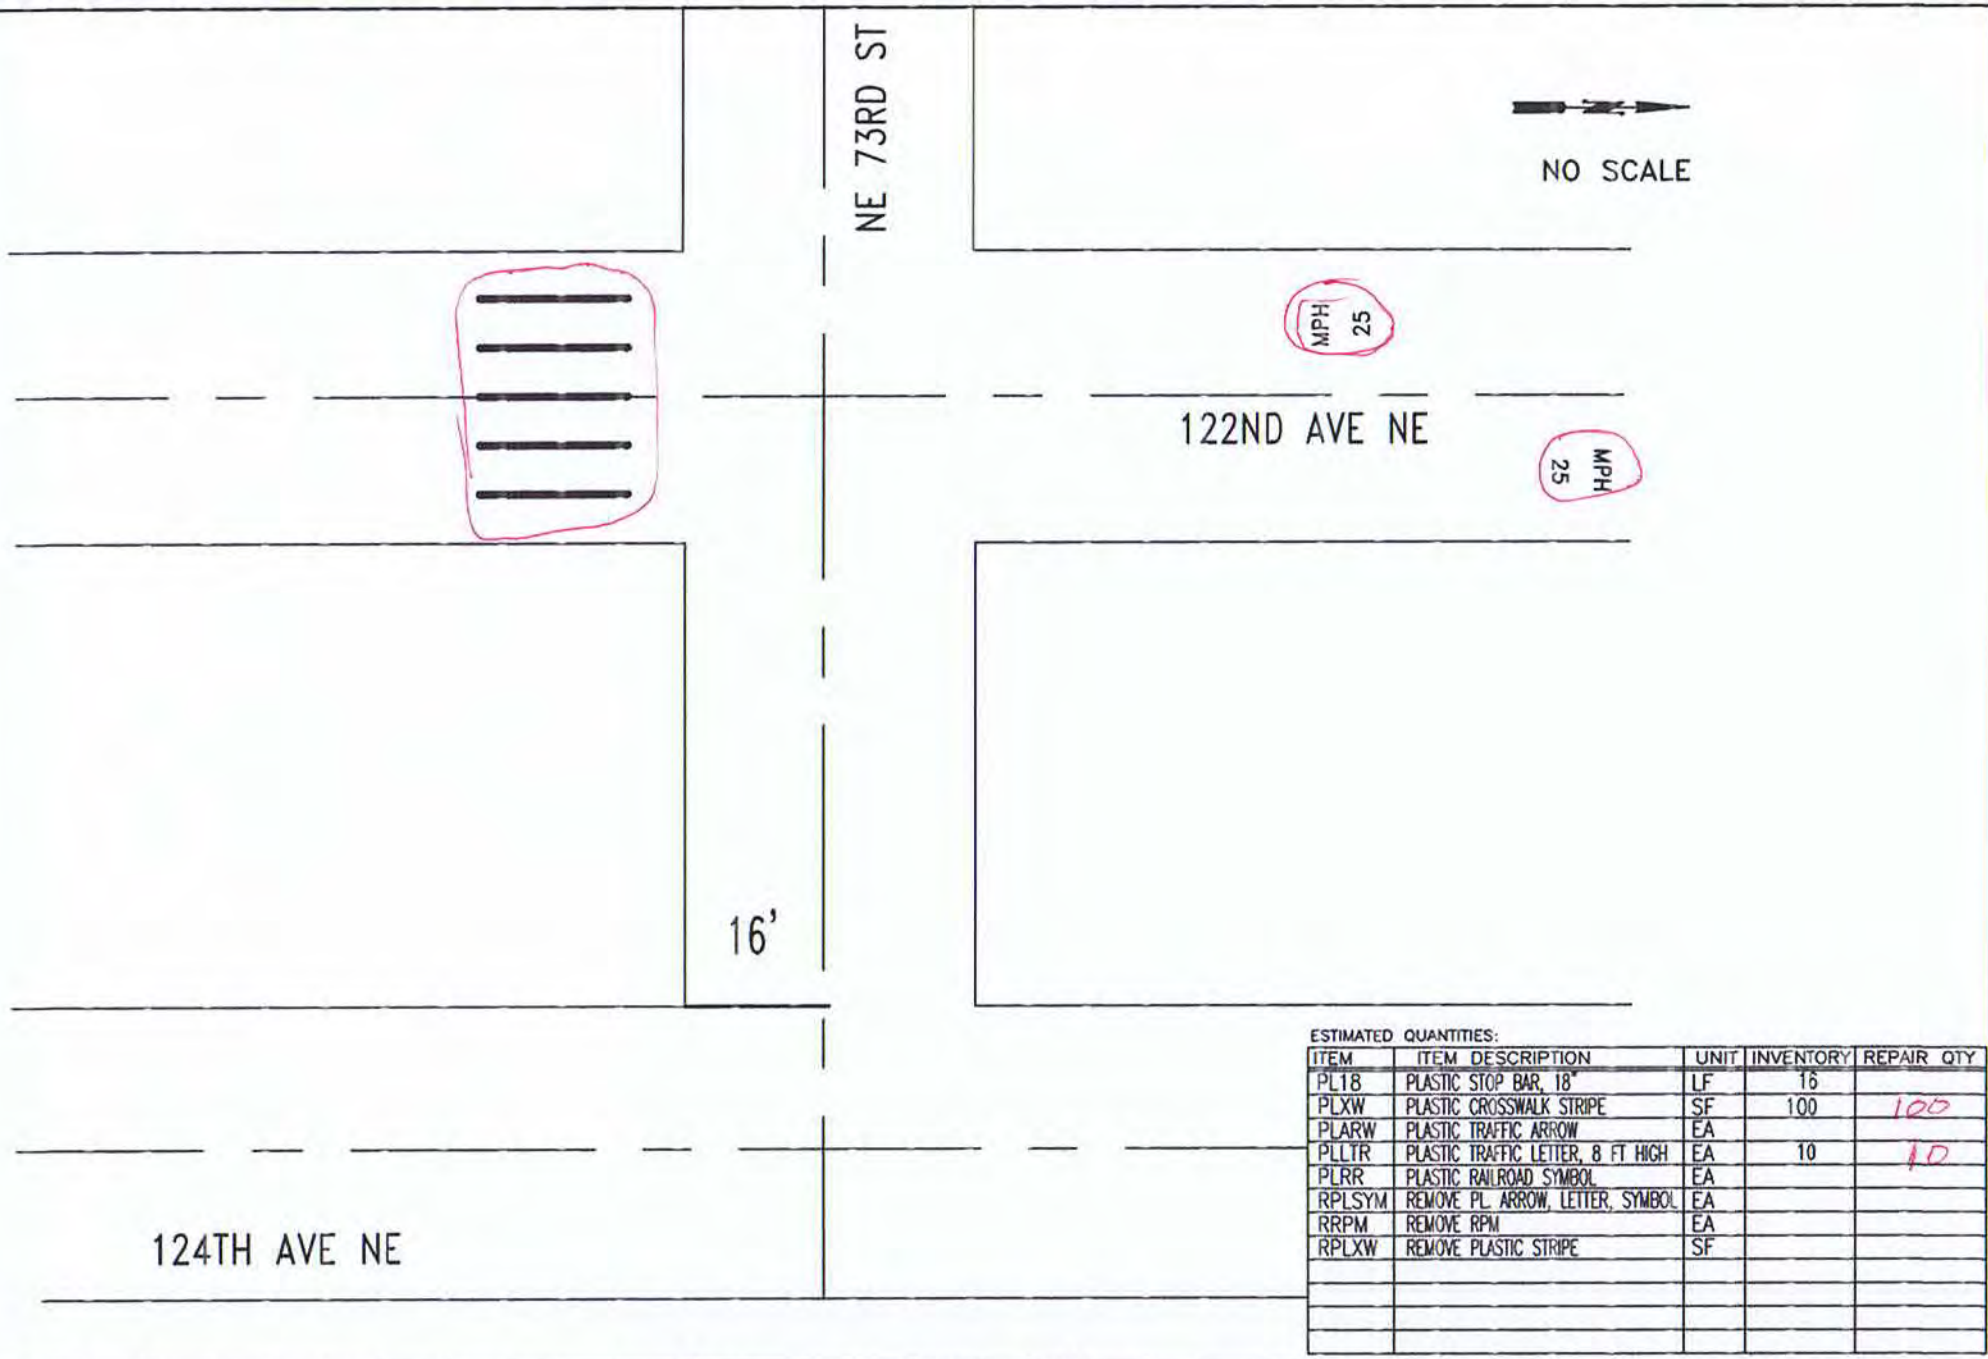

ESTIMATED QUANTITIES:

ITEM	ITEM DESCRIPTION	UNIT	INVENTORY	REPAIR QTY
PL18	PLASTIC STOP BAR, 18"	LF	16	
PLXW	PLASTIC CROSSWALK STRIPE	SF	100	100
PLARW	PLASTIC TRAFFIC ARROW	EA		
PLLTR	PLASTIC TRAFFIC LETTER, 8 FT HIGH	EA	10	10
PLRR	PLASTIC RAILROAD SYMBOL	EA		
RPLSYM	REMOVE PL. ARROW, LETTER, SYMBOL	EA		
RRPM	REMOVE RPM	EA		
RPLXW	REMOVE PLASTIC STRIPE	SF		

CITY OF KIRKLAND
DEPARTMENT OF PUBLIC WORKS
123 FIFTH AVENUE KIRKLAND, WA 98033
(425) 587-3800 www.kirklandwa.gov

S. GONSAR 2/2018
DESIGNED BY: DATE

J.JENNINGS 2/2018
DRAWN BY: DATE

CHECKED BY: DATE

2022 PAVEMENT MARKING PROGRAM

STREET: 122ND AVE NE

CROSS STREET: NE 73RD ST

SEGMENT:

SCALE: N.T.S.

FILENAME: PAGE 12-15

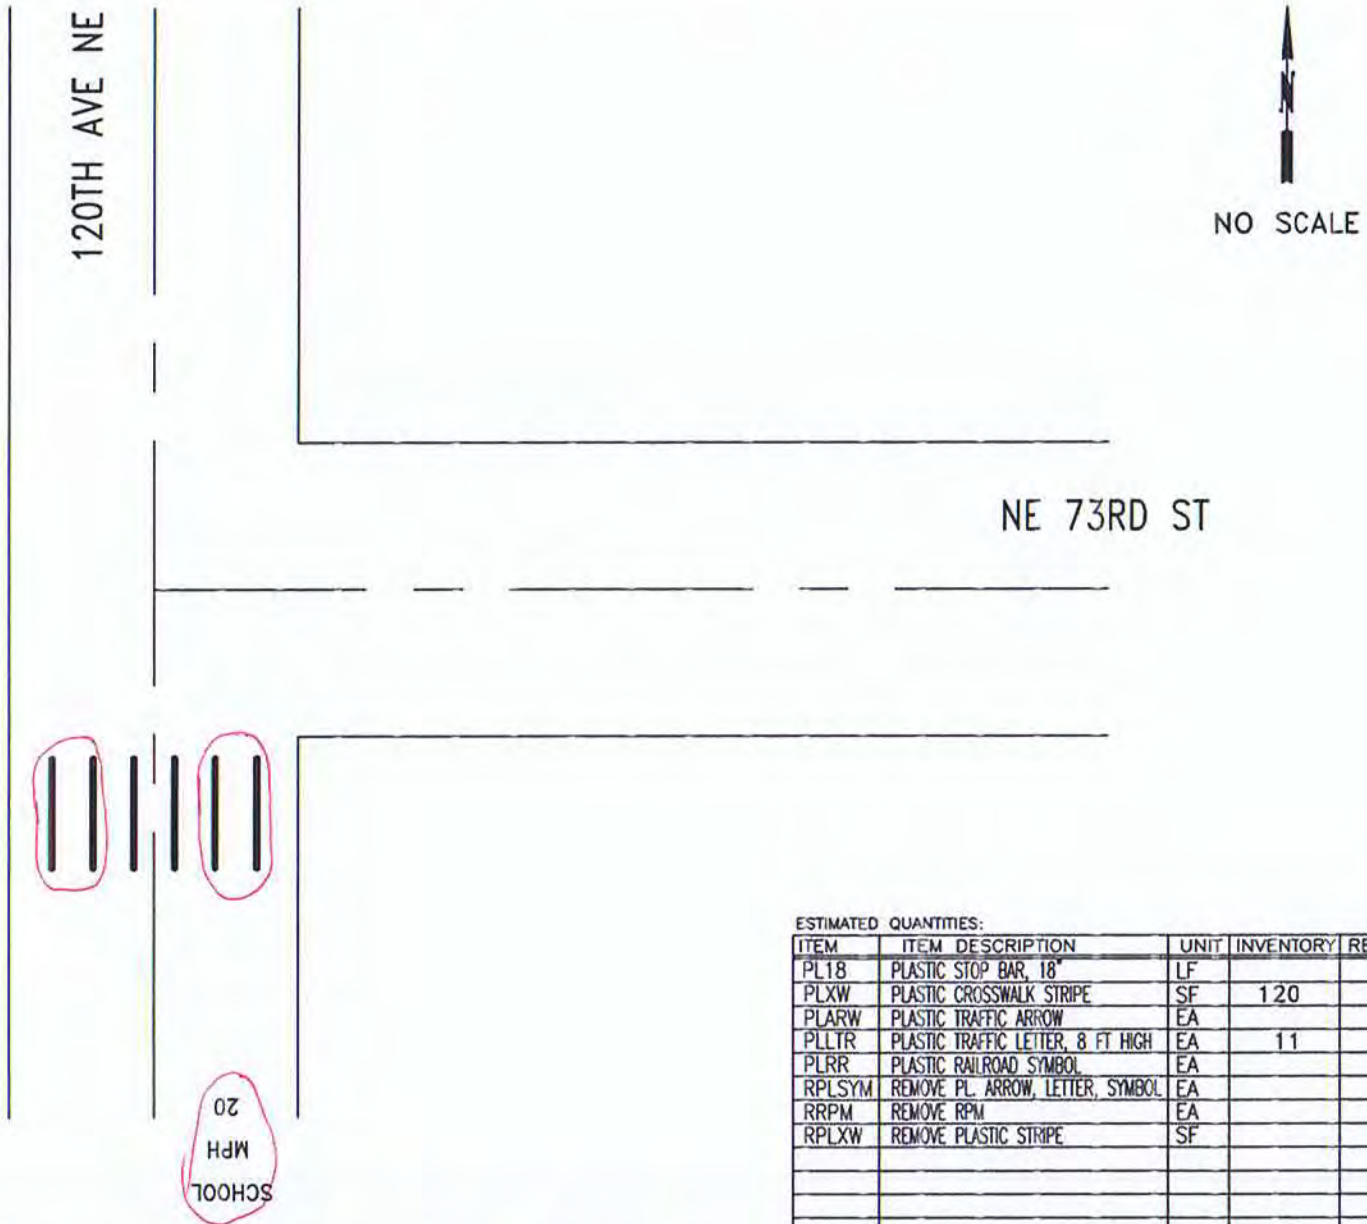

ESTIMATED QUANTITIES:

ITEM	ITEM DESCRIPTION	UNIT	INVENTORY	REPAIR QTY
PL18	PLASTIC STOP BAR, 18"	LF		
PLXW	PLASTIC CROSSWALK STRIPE	SF	120	80
PLARW	PLASTIC TRAFFIC ARROW	EA		
PLLTR	PLASTIC TRAFFIC LETTER, 8 FT HIGH	EA	11	11
PLRR	PLASTIC RAILROAD SYMBOL	EA		
RPLSYM	REMOVE PL. ARROW, LETTER, SYMBOL	EA		11
RRPM	REMOVE RPM	EA		
RPLXW	REMOVE PLASTIC STRIPE	SF		80

CITY OF KIRKLAND
DEPARTMENT OF PUBLIC WORKS
123 FIFTH AVENUE KIRKLAND, WA 98033
(425) 587-3800 www.kirklandwa.gov

G. HORTILLOSA 2/2011
DESIGNED BY: DATE

J.JENNINGS 2/2011
DRAWN BY: DATE

CHECKED BY: DATE

2020 PAVEMENT MARKING PROGRAM

STREET: NE 73RD ST

CROSS STREET: 120TH AVE NE

SEGMENT:

SCALE: N.T.S.

FILENAME: Page 12-16

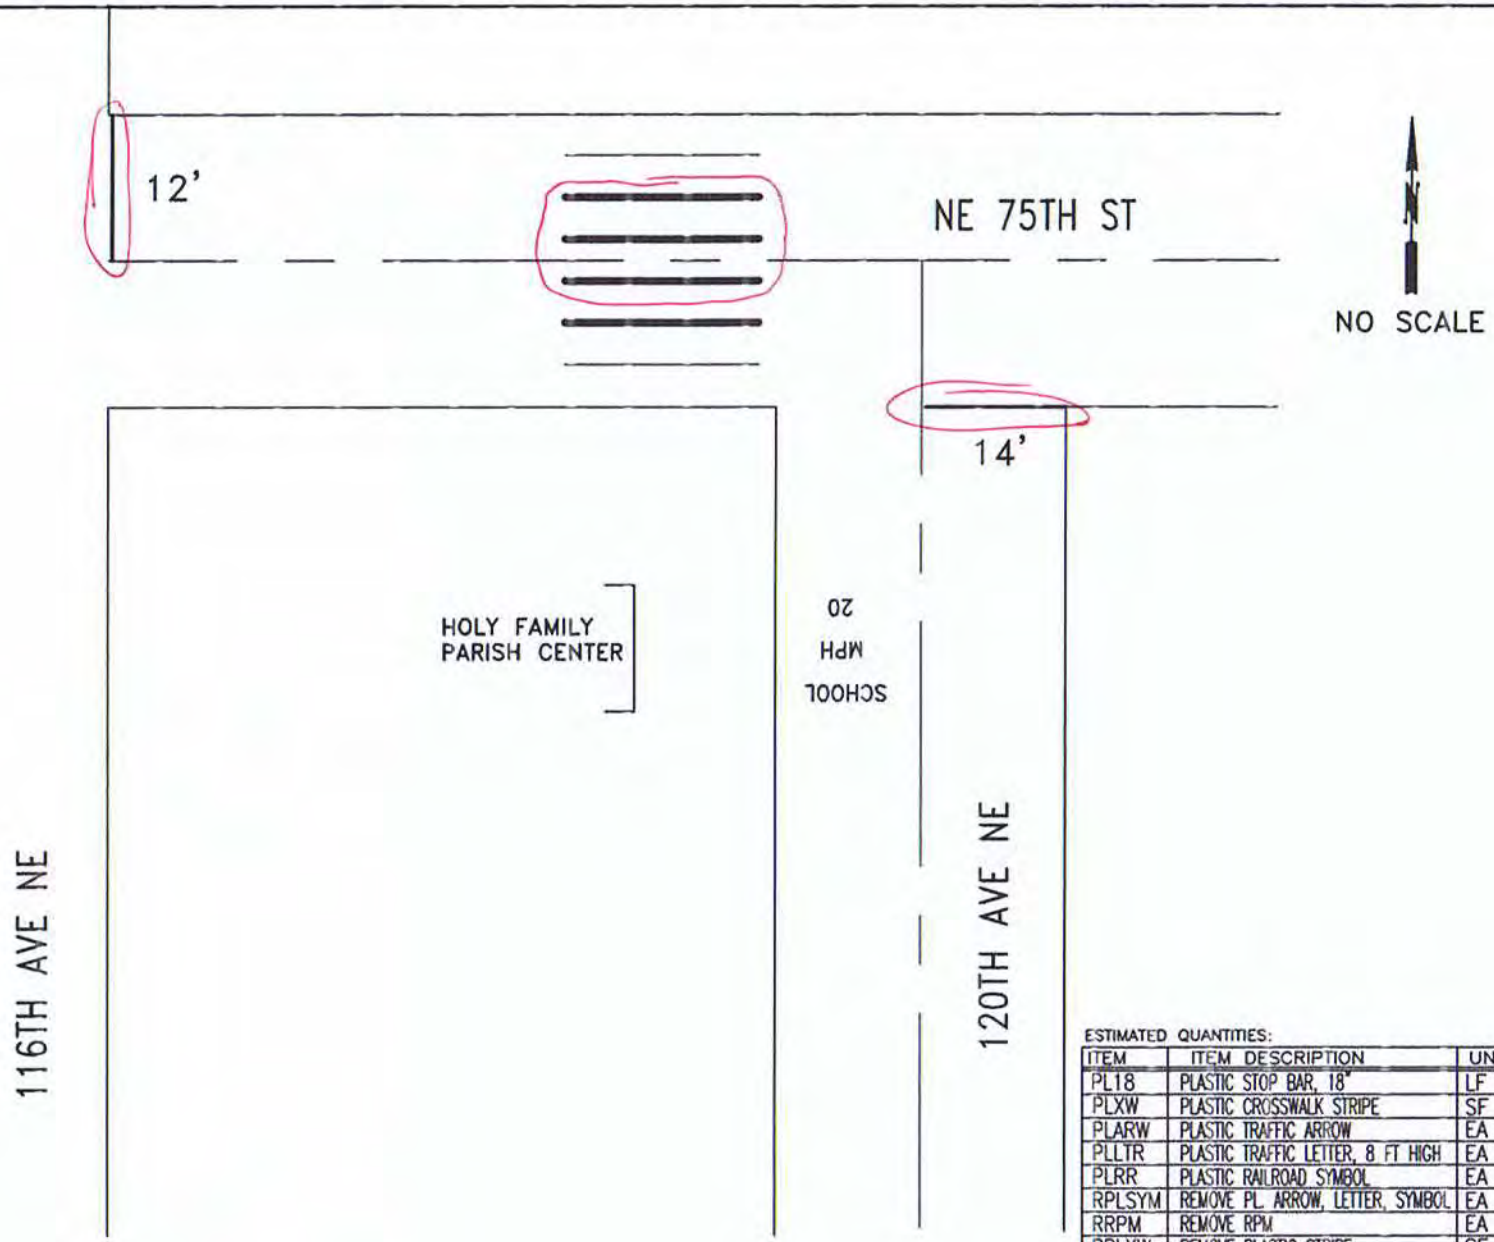

ESTIMATED QUANTITIES:

ITEM	ITEM DESCRIPTION	UNIT	INVENTORY	REPAIR QTY
PL18	PLASTIC STOP BAR, 18"	LF	26	25
PLXW	PLASTIC CROSSWALK STRIPE	SF	100	60
PLARW	PLASTIC TRAFFIC ARROW	EA		
PLLTR	PLASTIC TRAFFIC LETTER, 8 FT HIGH	EA	11	
PLRR	PLASTIC RAILROAD SYMBOL	EA		
RPLSYM	REMOVE PL. ARROW, LETTER, SYMBOL	EA		
RRPM	REMOVE RPM	EA		
RPLXW	REMOVE PLASTIC STRIPE	SF		

CITY OF KIRKLAND
DEPARTMENT OF PUBLIC WORKS
123 FIFTH AVENUE KIRKLAND, WA 98033
(425) 587-3800 www.kirklandwa.gov

G. HORTILLOSA 2/2011
DESIGNED BY: DATE

J.JENNINGS 2/2011
DRAWN BY: DATE

CHECKED BY: DATE

2020 PAVEMENT MARKING PROGRAM

STREET: NE 75TH ST

CROSS STREET: 120TH AVE NE

SEGMENT:

SCALE: N.T.S.

FILENAME: Page 12-17

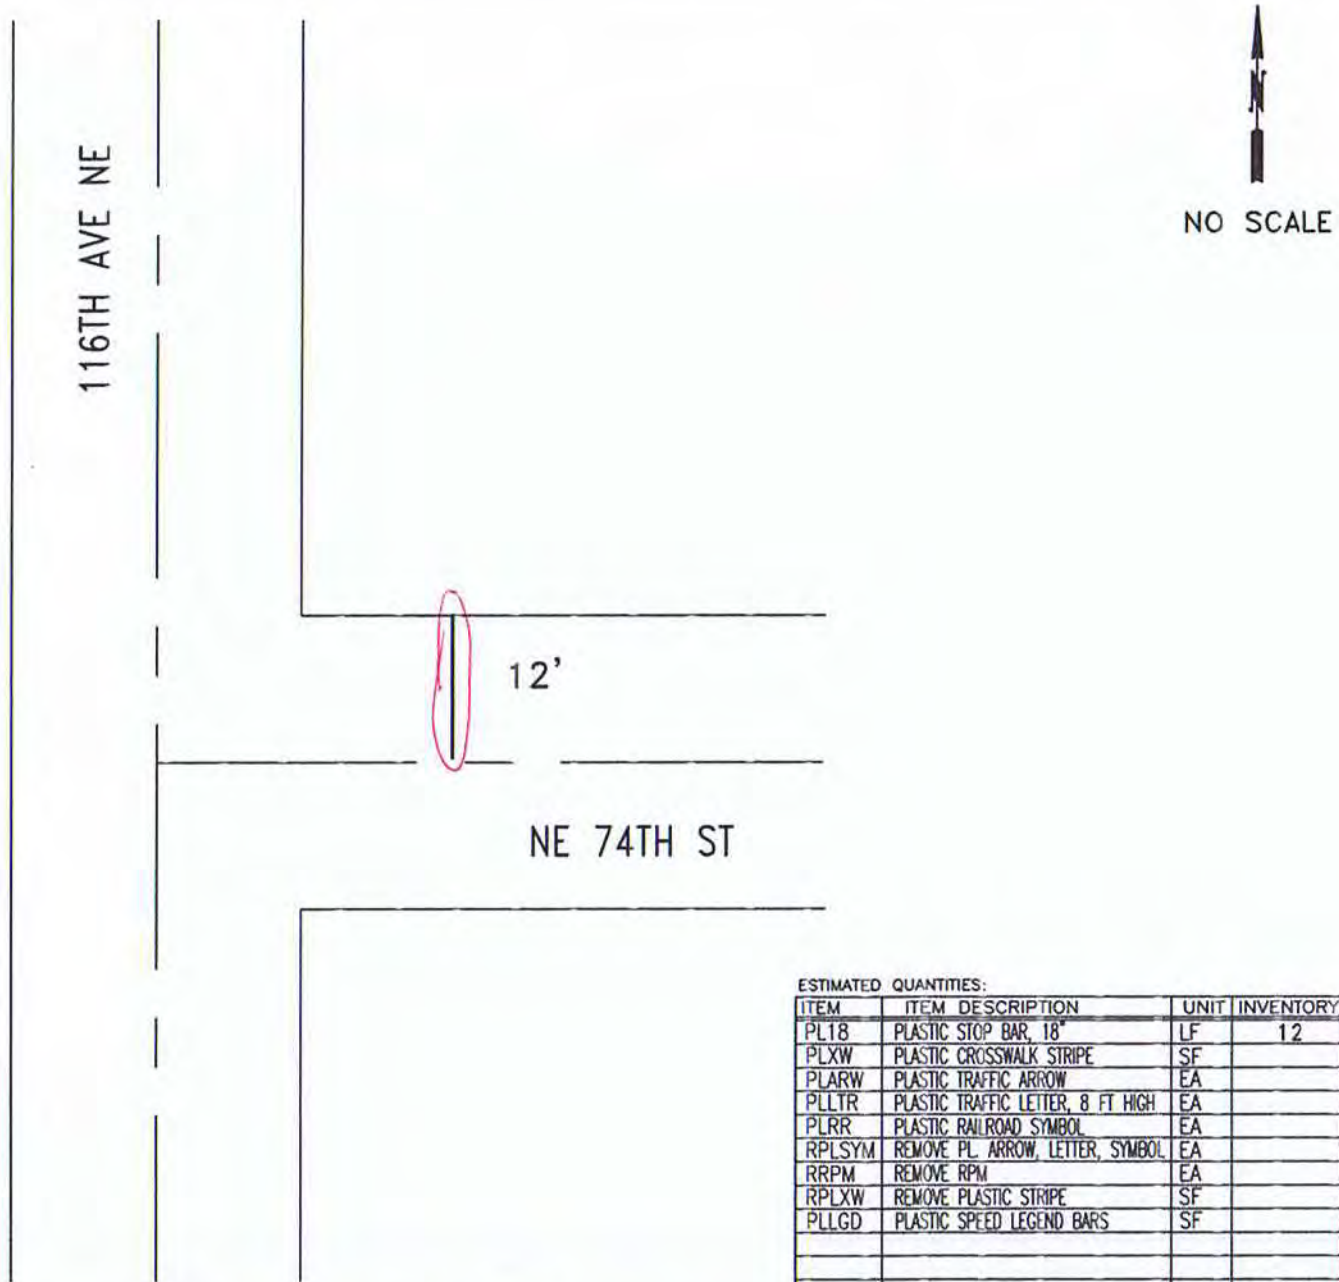

ESTIMATED QUANTITIES:

ITEM	ITEM DESCRIPTION	UNIT	INVENTORY	REPAIR QTY
PL18	PLASTIC STOP BAR, 18"	LF	12	12
PLXW	PLASTIC CROSSWALK STRIPE	SF		
PLARW	PLASTIC TRAFFIC ARROW	EA		
PLLTR	PLASTIC TRAFFIC LETTER, 8 FT HIGH	EA		
PLRR	PLASTIC RAILROAD SYMBOL	EA		
RPLSYM	REMOVE PL. ARROW, LETTER, SYMBOL	EA		
RRPM	REMOVE RPM	EA		
RPLXW	REMOVE PLASTIC STRIPE	SF		
PLLGD	PLASTIC SPEED LEGEND BARS	SF		

CITY OF KIRKLAND
DEPARTMENT OF PUBLIC WORKS
123 FIFTH AVENUE KIRKLAND, WA 98033
(425) 587-3800 www.kirklandwa.gov

G. HORTILLOSA 4/2009
DESIGNED BY: DATE

J.JENNINGS 4/2009
DRAWN BY: DATE

CHECKED BY: DATE

2022 PAVEMENT MARKING PROGRAM

STREET: 116TH AVE NE

CROSS STREET: NE 73RD ST

SEGMENT:

SCALE: N.T.S.

FILENAME:

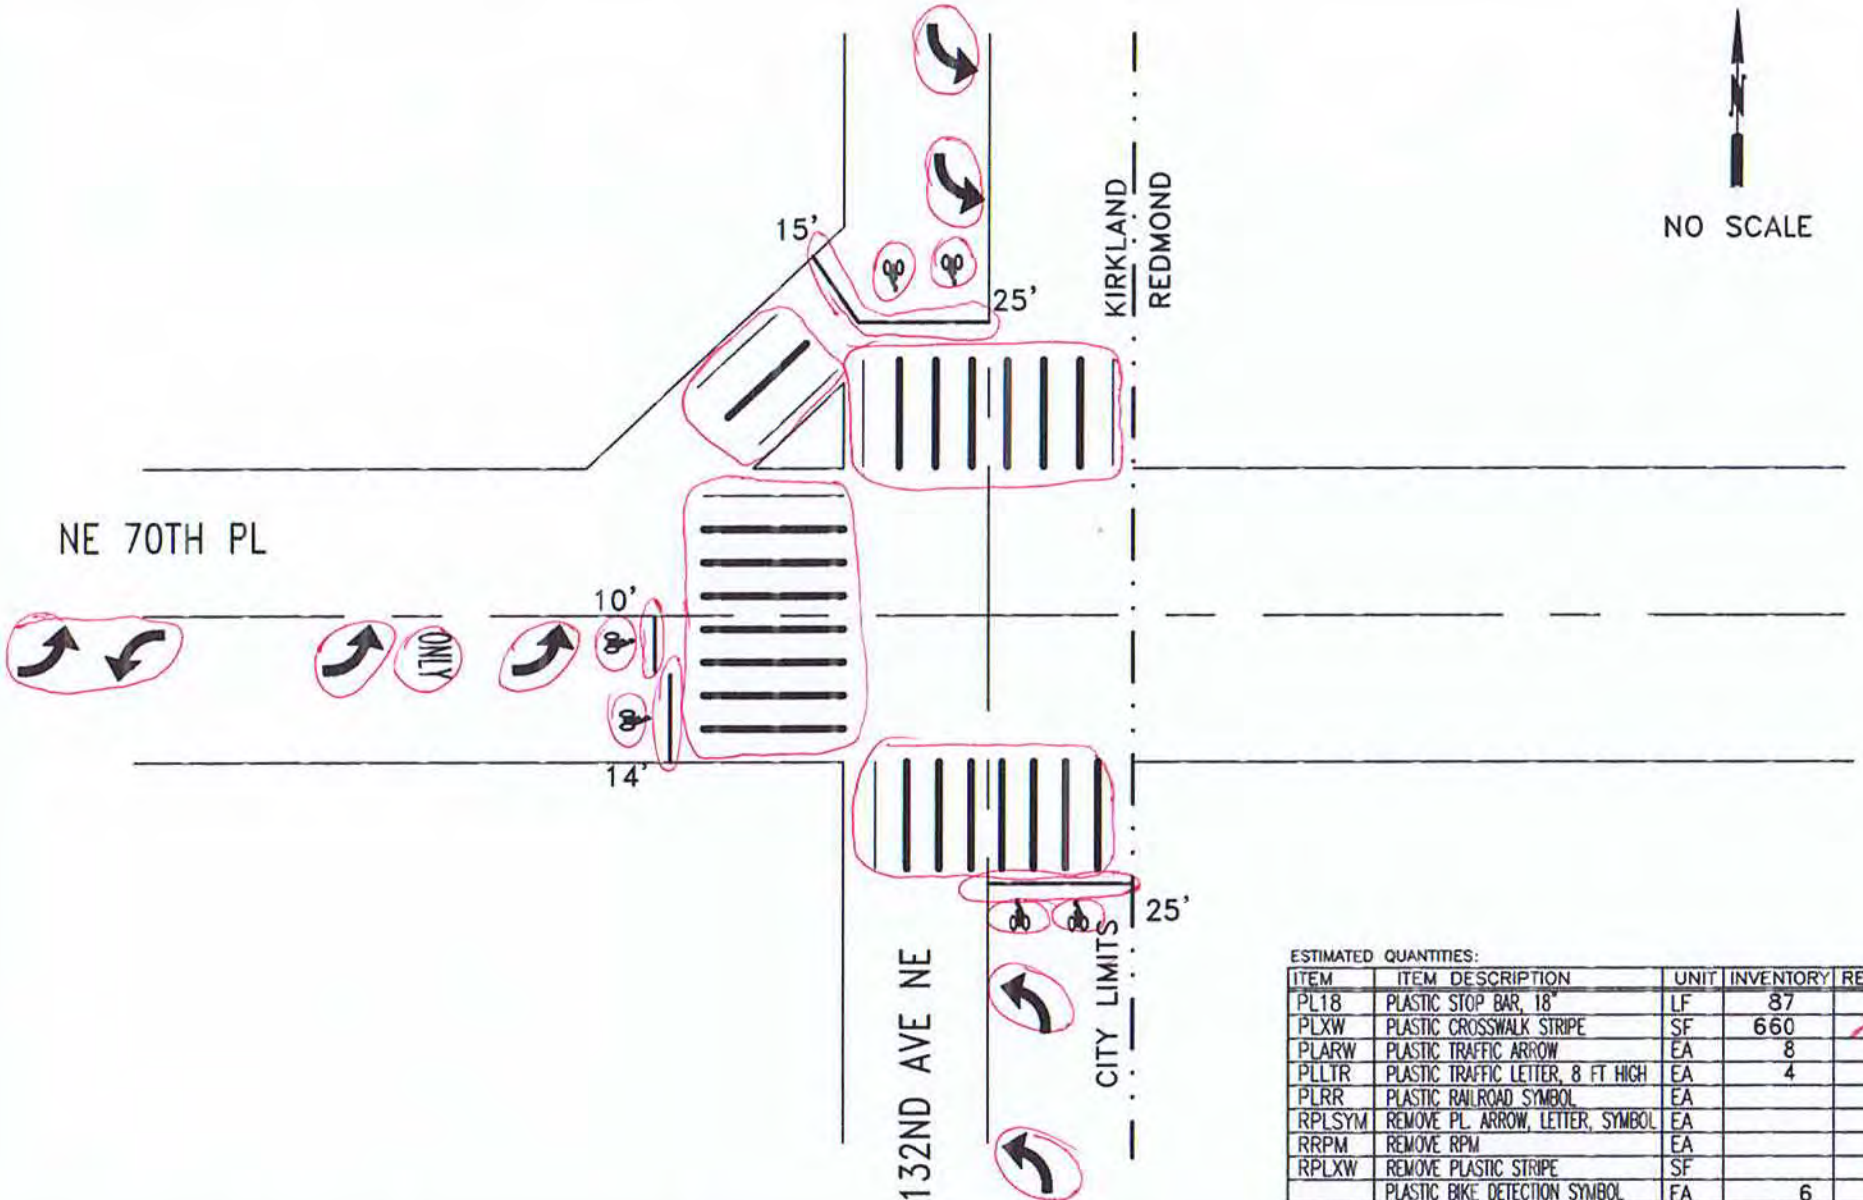

ESTIMATED QUANTITIES:

ITEM	ITEM DESCRIPTION	UNIT	INVENTORY	REPAIR QTY
PL18	PLASTIC STOP BAR, 18"	LF	87	87
PLXW	PLASTIC CROSSWALK STRIPE	SF	660	660
PLARW	PLASTIC TRAFFIC ARROW	EA	8	8
PLLTR	PLASTIC TRAFFIC LETTER, 8 FT HIGH	EA	4	1
PLRR	PLASTIC RAILROAD SYMBOL	EA		
RPLSYM	REMOVE PL. ARROW, LETTER, SYMBOL	EA		4
RRPM	REMOVE RPM	EA		
RPLXW	REMOVE PLASTIC STRIPE	SF		50
	PLASTIC BIKE DETECTION SYMBOL	EA	6	6

CITY OF KIRKLAND
DEPARTMENT OF PUBLIC WORKS
123 FIFTH AVENUE KIRKLAND, WA 98033
(425) 587-3800 www.kirklandwa.gov

G. HORTILLOSA 2/2011
DESIGNED BY: DATE

J.JENNINGS 2/2011
DRAWN BY: DATE

CHECKED BY: DATE

2022 PAVEMENT MARKING PROGRAM

STREET: NE 70TH PL

CROSS STREET: 132ND AVE NE

SEGMENT:

SCALE: N.T.S.

FILENAME:

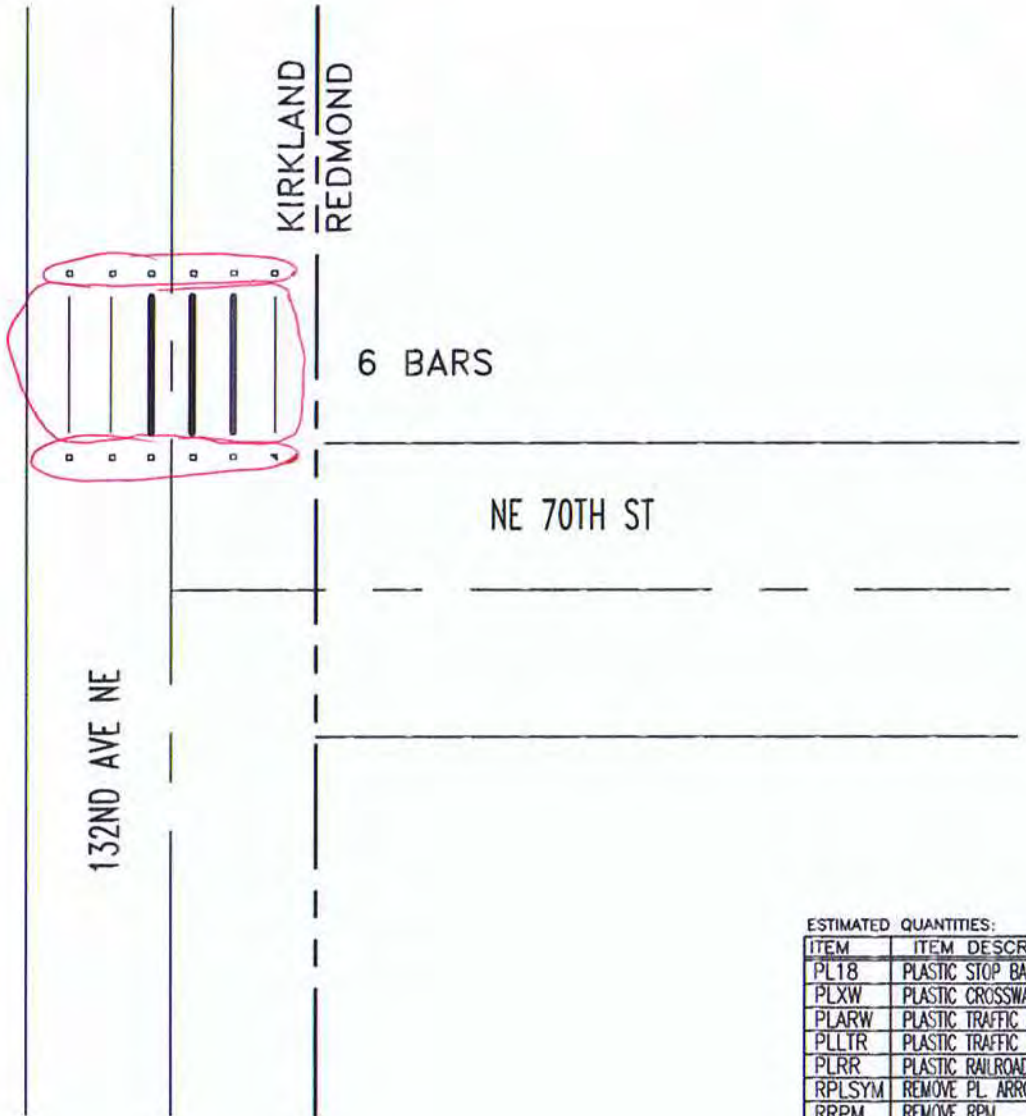

ESTIMATED QUANTITIES:

ITEM	ITEM DESCRIPTION	UNIT	INVENTORY	REPAIR QTY
PL18	PLASTIC STOP BAR, 18"	LF		
PLXW	PLASTIC CROSSWALK STRIPE	SF	100	100
PLARW	PLASTIC TRAFFIC ARROW	EA		
PLLTR	PLASTIC TRAFFIC LETTER, 8 FT HIGH	EA		
PLRR	PLASTIC RAILROAD SYMBOL	EA		
RPLSYM	REMOVE PL. ARROW, LETTER, SYMBOL	EA		
RRPM	REMOVE RPM	EA		12
RPLXW	REMOVE PLASTIC STRIPE	SF		100
RPM11	TYPE II RPM	EA	12	12

CITY OF KIRKLAND
DEPARTMENT OF PUBLIC WORKS
123 FIFTH AVENUE KIRKLAND, WA 98033
(425) 587-3800 www.kirklandwa.gov

G. HORTILLOSA 2/2011
DESIGNED BY: DATE

J.JENNINGS 2/2011
DRAWN BY: DATE

CHECKED BY: DATE

2022 PAVEMENT MARKING PROGRAM

STREET: NE 70TH ST

CROSS STREET: 132ND AVE NE

SEGMENT:

SCALE: N.T.S.

FILENAME: Page 12-20

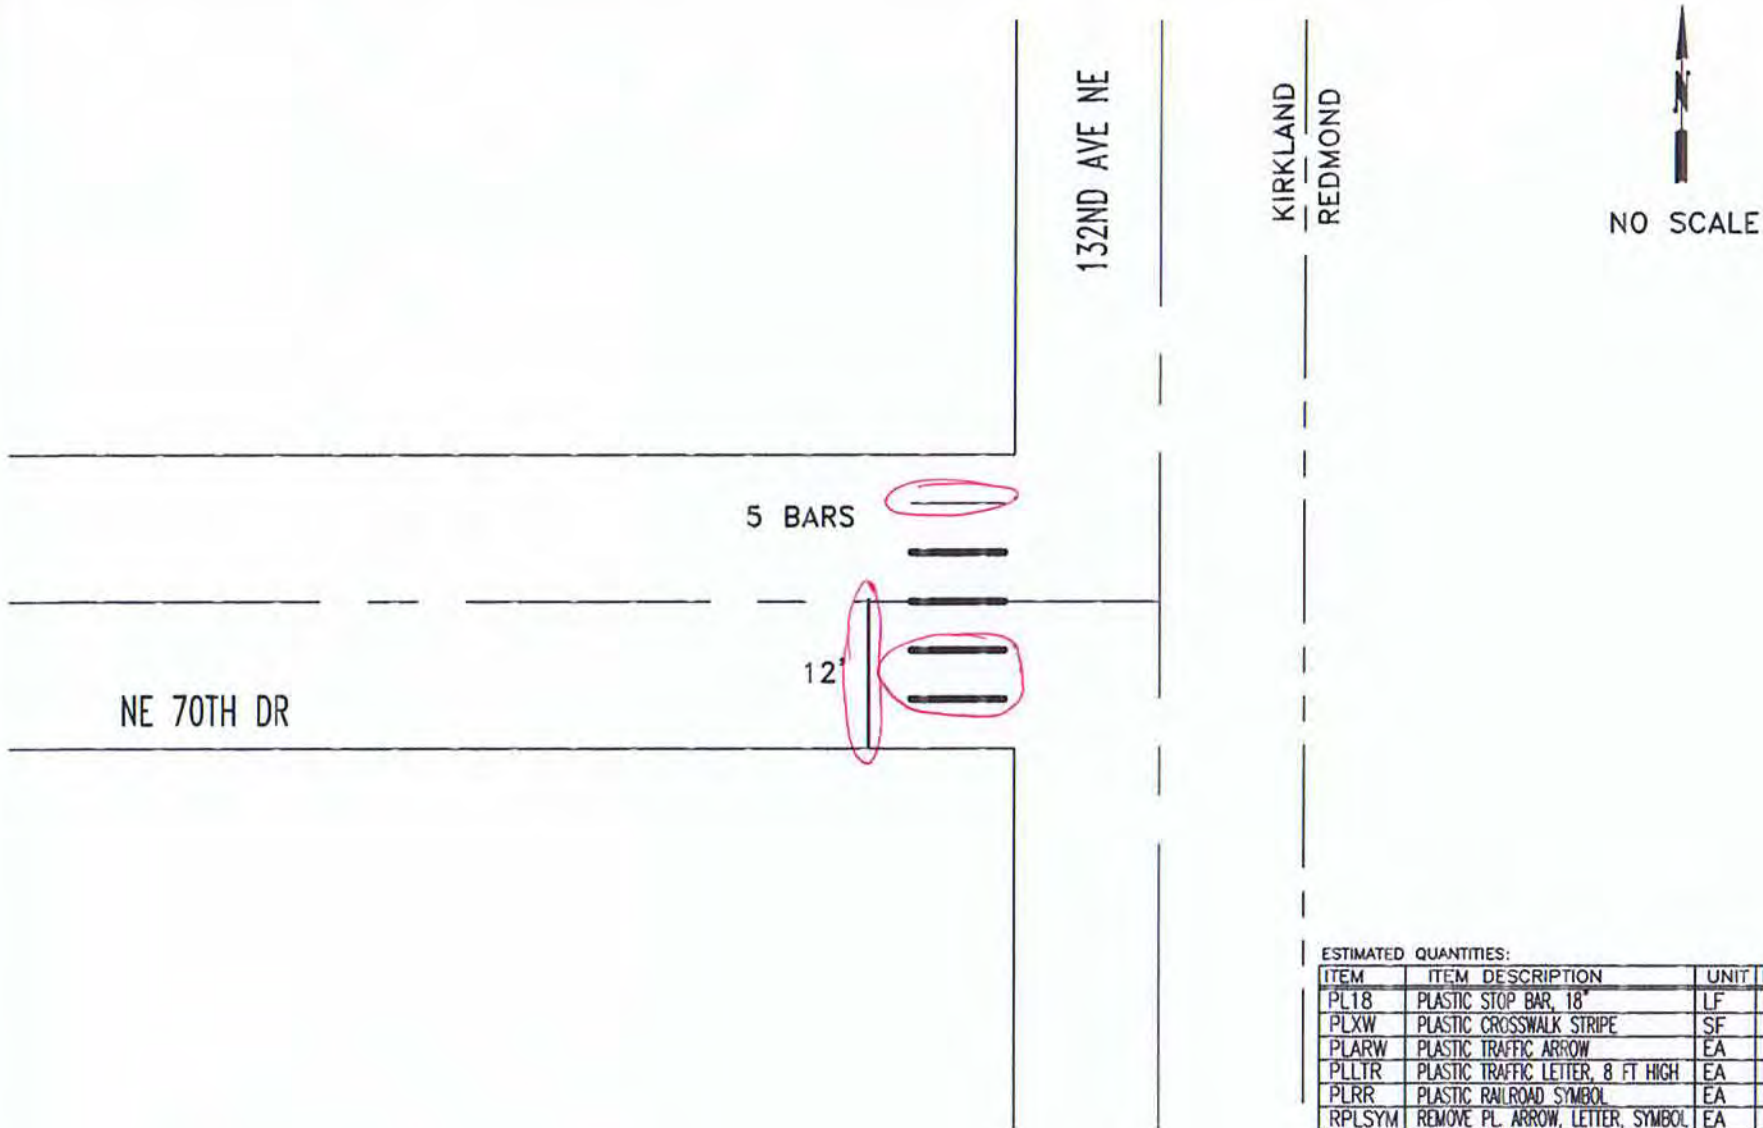

ESTIMATED QUANTITIES:

ITEM	ITEM DESCRIPTION	UNIT	INVENTORY	REPAIR QTY
PL18	PLASTIC STOP BAR, 18"	LF	12	
PLXW	PLASTIC CROSSWALK STRIPE	SF	90	55
PLARW	PLASTIC TRAFFIC ARROW	EA		
PLLTR	PLASTIC TRAFFIC LETTER, 8 FT HIGH	EA		
PLRR	PLASTIC RAILROAD SYMBOL	EA		
RPLSYM	REMOVE PL. ARROW, LETTER, SYMBOL	EA		
RRPM	REMOVE RPM	EA		
RPLXW	REMOVE PLASTIC STRIPE	SF		
PLLGD	PLASTIC SPEED LEGEND BARS	EA		

CITY OF KIRKLAND WASHINGTON

CITY OF KIRKLAND
DEPARTMENT OF PUBLIC WORKS
123 FIFTH AVENUE KIRKLAND, WA 98033
(425) 587-3800 www.kirklandwa.gov

D. GRILLEY 2/2003
DESIGNED BY: DATE

J.JENNINGS 2/2004
DRAWN BY: DATE

CHECKED BY: DATE

2020 PAVEMENT MARKING PROGRAM

STREET: NE 70TH DR

CROSS STREET: 132ND AVE NE

SEGMENT:

SCALE: N.T.S.

FILENAME: Page 12-21

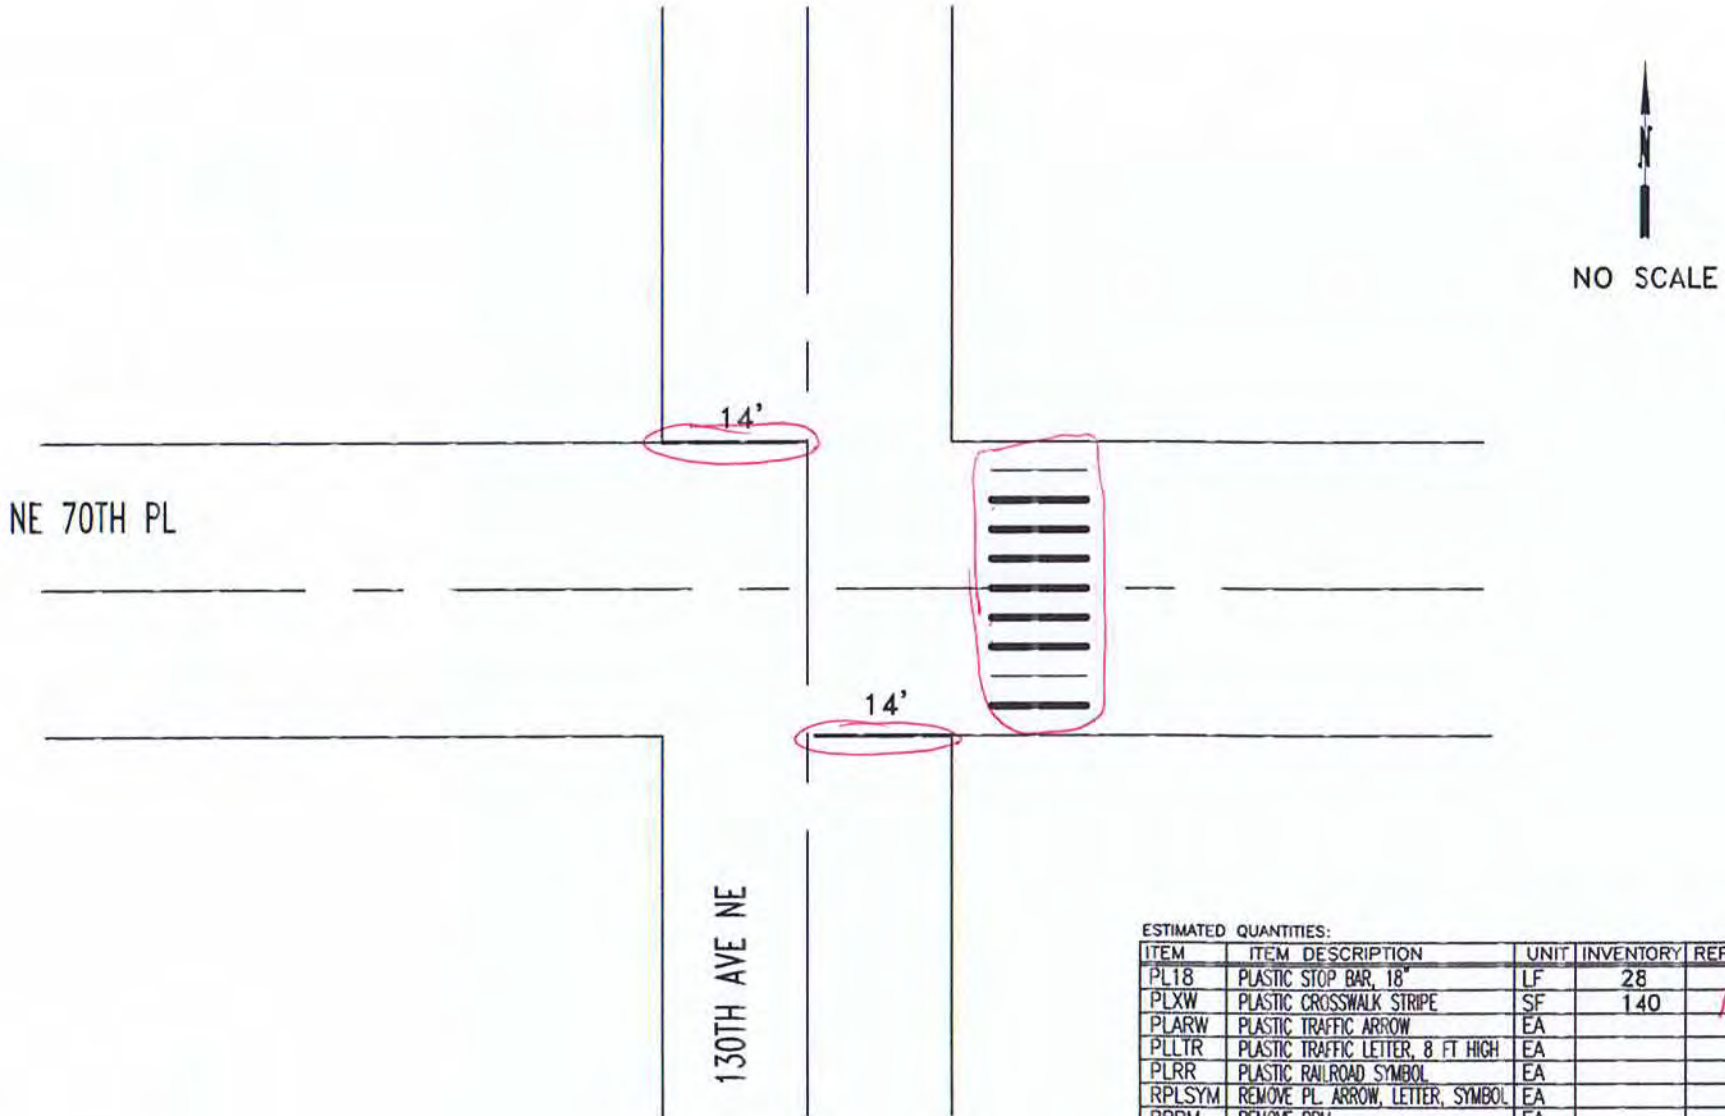

ESTIMATED QUANTITIES:

ITEM	ITEM DESCRIPTION	UNIT	INVENTORY	REPAIR QTY
PL18	PLASTIC STOP BAR, 18"	LF	28	28
PLXW	PLASTIC CROSSWALK STRIPE	SF	140	120
PLARW	PLASTIC TRAFFIC ARROW	EA		
PLLTR	PLASTIC TRAFFIC LETTER, 8 FT HIGH	EA		
PLRR	PLASTIC RAILROAD SYMBOL	EA		
RPLSYM	REMOVE PL. ARROW, LETTER, SYMBOL	EA		
RRPM	REMOVE RPM	EA		
RPLXW	REMOVE PLASTIC STRIPE	SF		60

CITY OF KIRKLAND WASHINGTON

CITY OF KIRKLAND
DEPARTMENT OF PUBLIC WORKS
123 FIFTH AVENUE KIRKLAND, WA 98033
(425) 587-3800 www.kirklandwa.gov

D.GRILLEY 1/2000
DESIGNED BY: DATE

J.JENNINGS 1/2000
DRAWN BY: DATE

CHECKED BY: DATE

2022 PAVEMENT MARKING PROGRAM

STREET: NE 70TH PL

CROSS STREET: 130TH AVE NE

SEGMENT:

SCALE: N.T.S.

FILENAME:

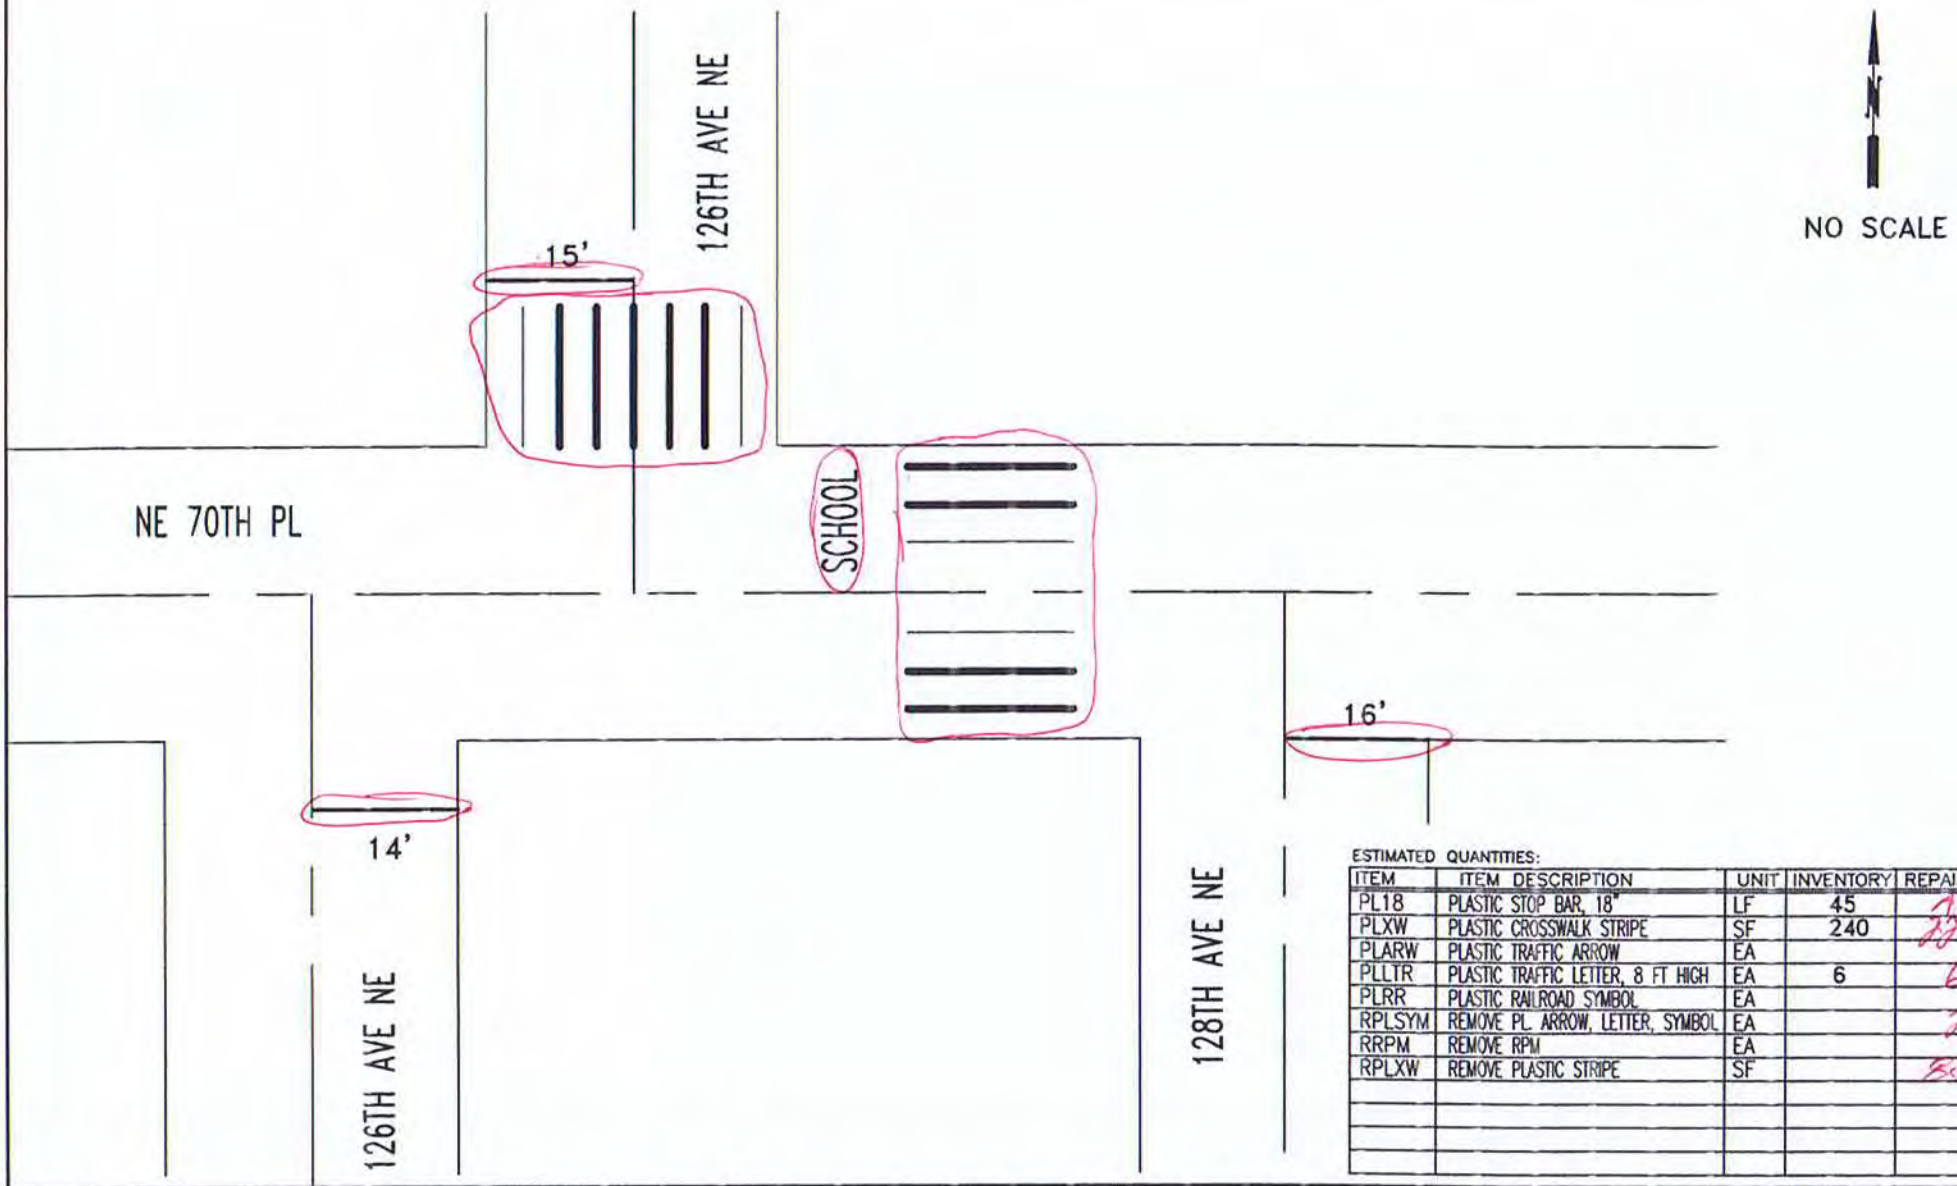

ESTIMATED QUANTITIES:

ITEM	ITEM DESCRIPTION	UNIT	INVENTORY	REPAIR QTY
PL18	PLASTIC STOP BAR, 18"	LF	45	25
PLXW	PLASTIC CROSSWALK STRIPE	SF	240	220
PLARW	PLASTIC TRAFFIC ARROW	EA		
PLLTR	PLASTIC TRAFFIC LETTER, 8 FT HIGH	EA	6	6
PLRR	PLASTIC RAILROAD SYMBOL	EA		
RPLSYM	REMOVE PL. ARROW, LETTER, SYMBOL	EA		2
RRPM	REMOVE RPM	EA		
RPLXW	REMOVE PLASTIC STRIPE	SF		50

CITY OF KIRKLAND
DEPARTMENT OF PUBLIC WORKS
123 FIFTH AVENUE KIRKLAND, WA 98033
(425) 587-3800 www.kirklandwa.gov

G. HORTILLOSA 3/2009
DESIGNED BY: DATE

J.JENNINGS 3/2009
DRAWN BY: DATE

CHECKED BY: DATE

2022 PAVEMENT MARKING PROGRAM

STREET: NE 70TH PL

CROSS STREET: 126TH AND 128TH AVES NE

SEGMENT:

SCALE: N.T.S.

FILENAME:

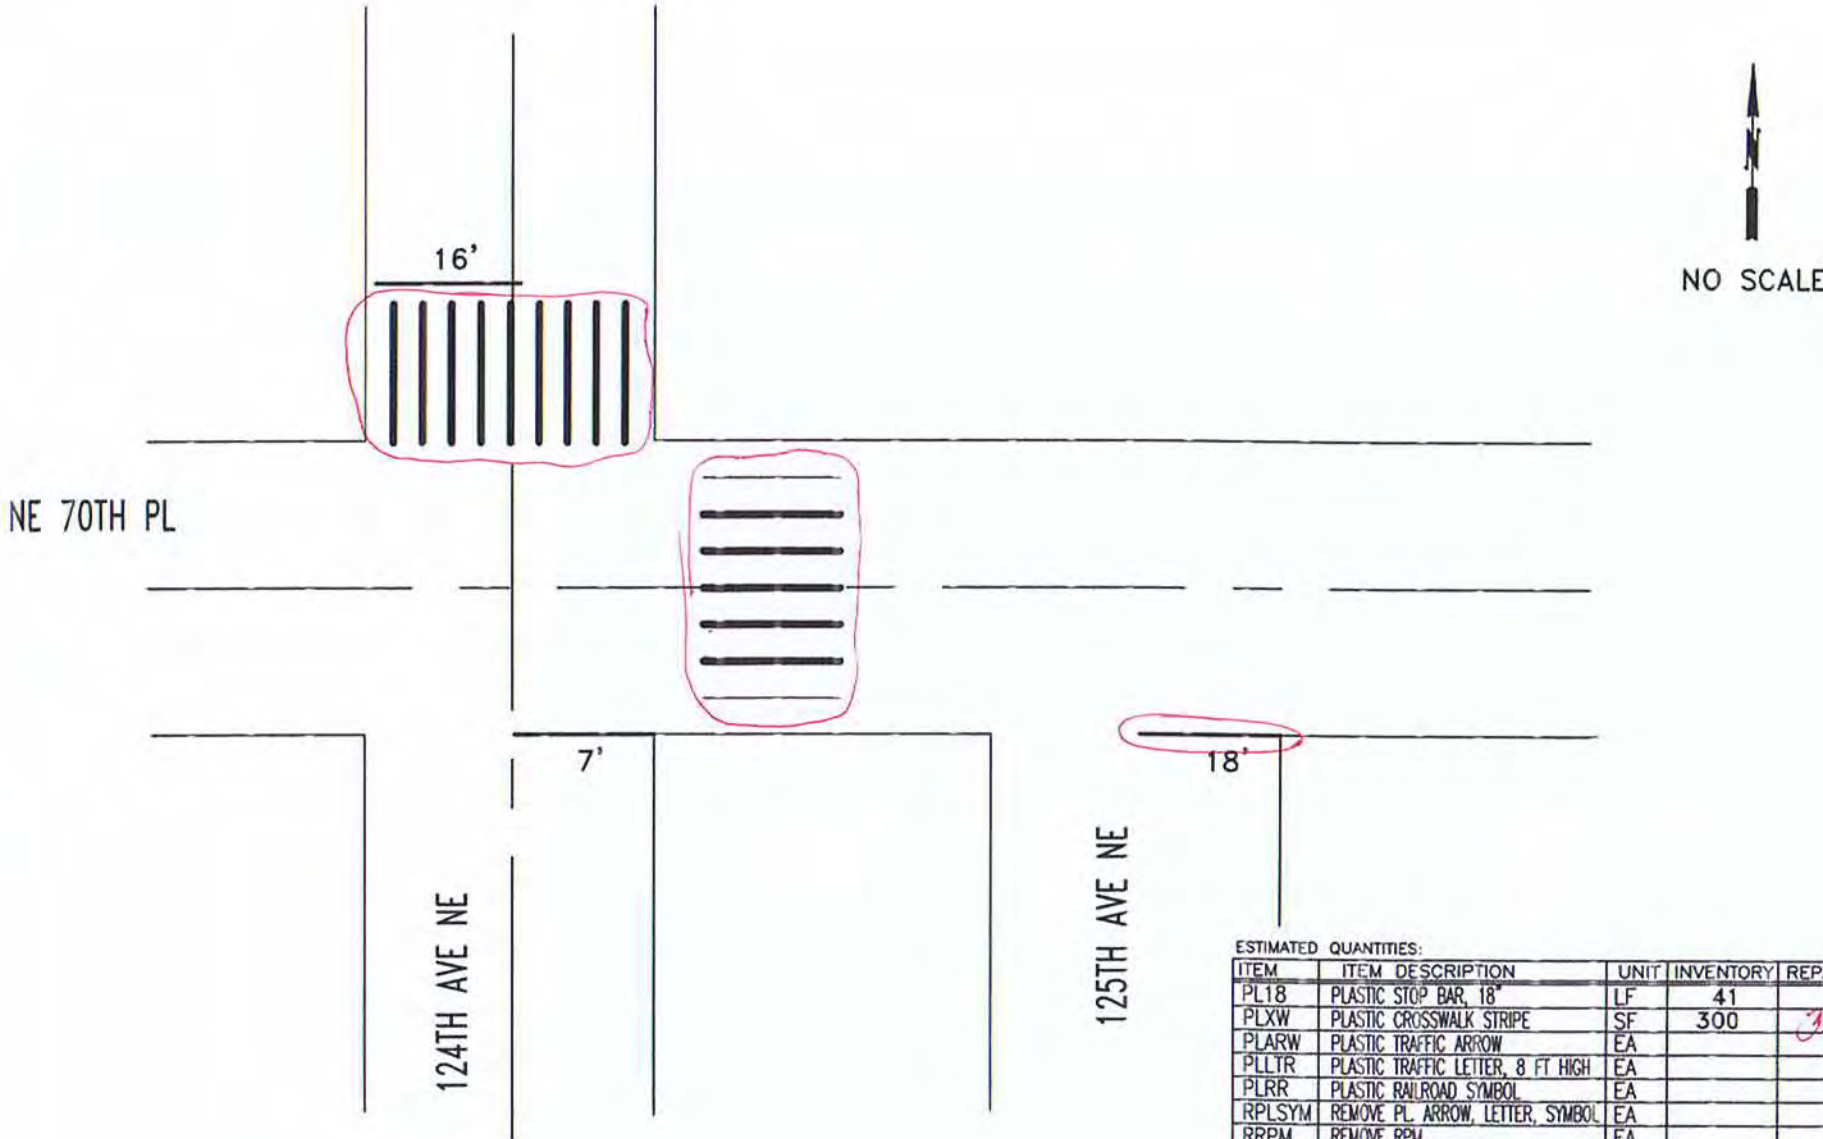

ESTIMATED QUANTITIES:

ITEM	ITEM DESCRIPTION	UNIT	INVENTORY	REPAIR QTY
PL18	PLASTIC STOP BAR, 18"	LF	41	18
PLXW	PLASTIC CROSSWALK STRIPE	SF	300	300
PLARW	PLASTIC TRAFFIC ARROW	EA		
PLLTR	PLASTIC TRAFFIC LETTER, 8 FT HIGH	EA		
PLRR	PLASTIC RAILROAD SYMBOL	EA		
RPLSYM	REMOVE PL. ARROW, LETTER, SYMBOL	EA		
RRPM	REMOVE RPM	EA		
RPLXW	REMOVE PLASTIC STRIPE	SF		100
	RAISED PAVEMENT MARKER TYPE 2	EA		

CITY OF KIRKLAND WASHINGTON

CITY OF KIRKLAND
DEPARTMENT OF PUBLIC WORKS
123 FIFTH AVENUE KIRKLAND, WA 98033
(425) 587-3800 www.kirklandwa.gov

G. HORTILLOSA 10/2006
DESIGNED BY: DATE

J.JENNINGS 10/2006
DRAWN BY: DATE

CHECKED BY: DATE

2022 PAVEMENT MARKING PROGRAM

STREET: NE 70TH PL

CROSS STREET: 124TH AND 125TH AVES NE

SEGMENT:

SCALE: N.T.S.

FILENAME: Page 12-24

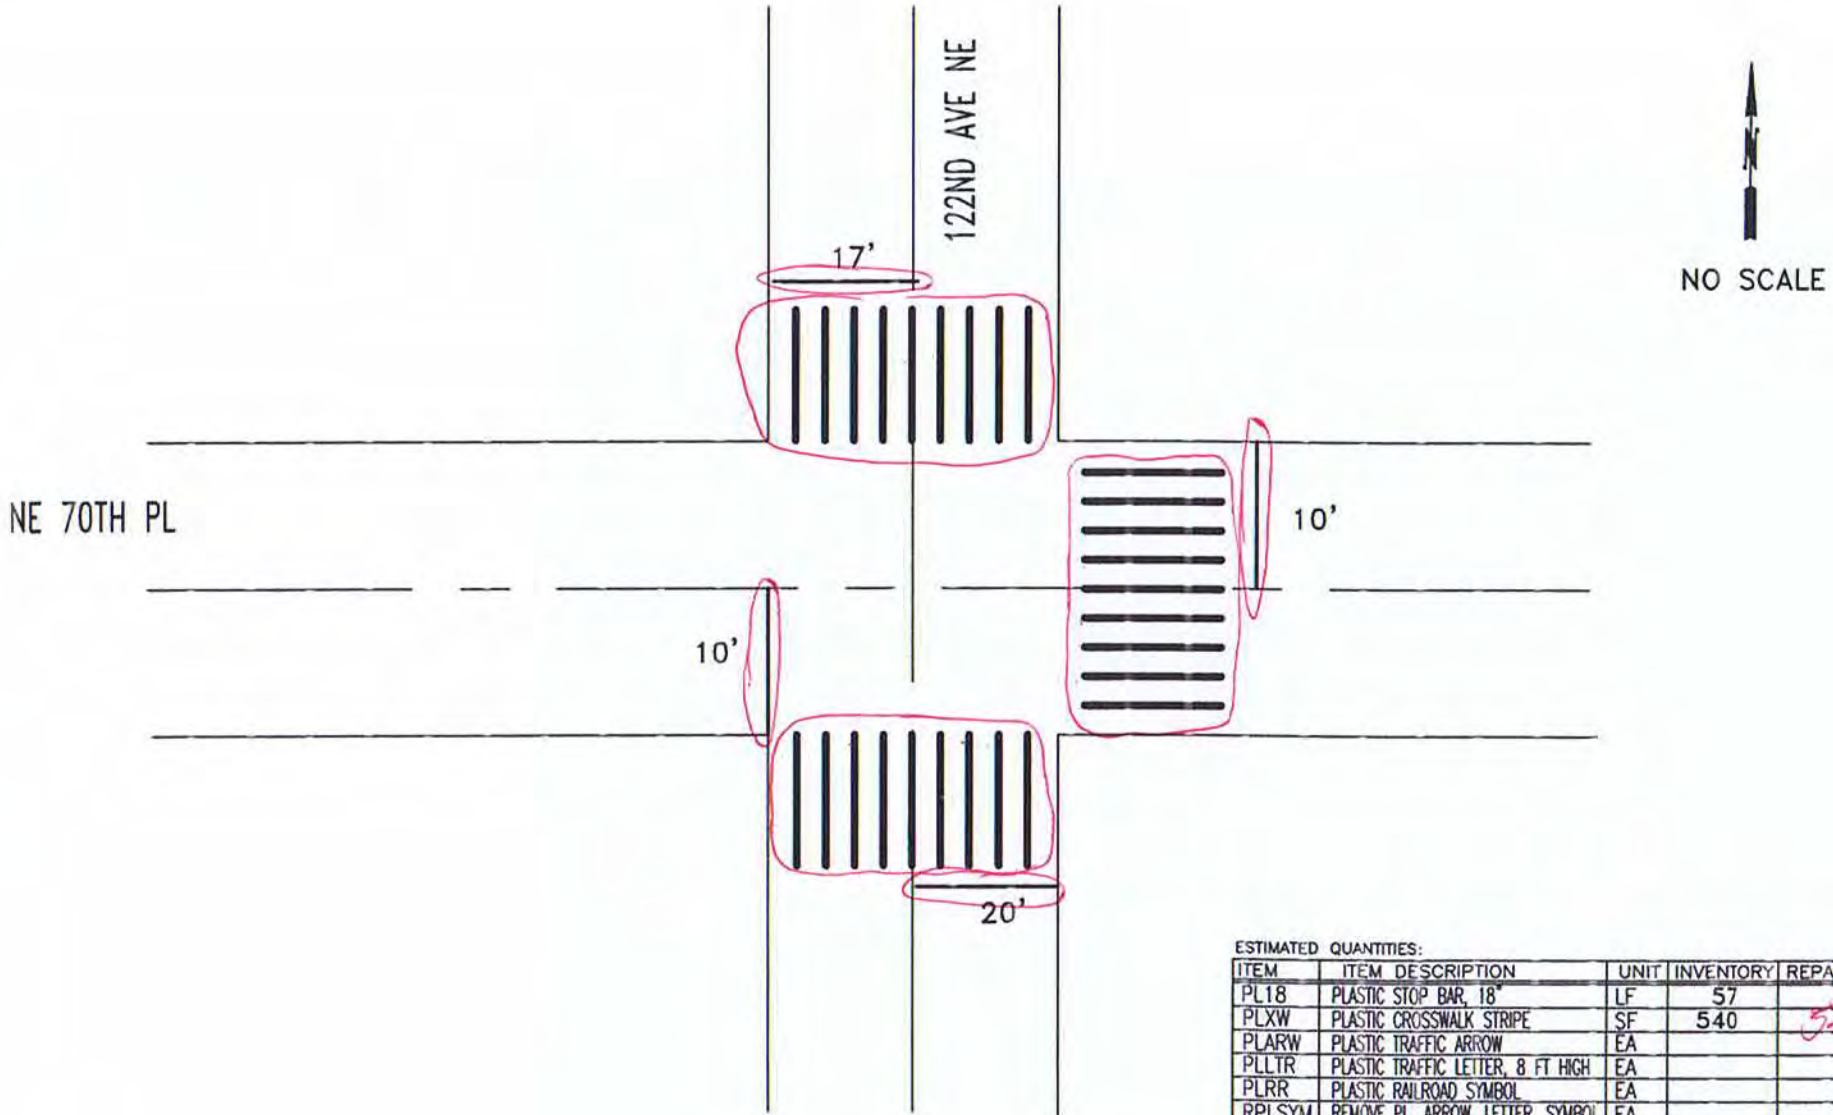

ESTIMATED QUANTITIES:

ITEM	ITEM DESCRIPTION	UNIT	INVENTORY	REPAIR QTY
PL18	PLASTIC STOP BAR, 18"	LF	57	57
PLXW	PLASTIC CROSSWALK STRIPE	SF	540	540
PLARW	PLASTIC TRAFFIC ARROW	EA		
PLLTR	PLASTIC TRAFFIC LETTER, 8 FT HIGH	EA		
PLRR	PLASTIC RAILROAD SYMBOL	EA		
RPLSYM	REMOVE PL. ARROW, LETTER, SYMBOL	EA		
RRPM	REMOVE RPM	EA		
RPLXW	REMOVE PLASTIC STRIPE	SF		000

CITY OF KIRKLAND WASHINGTON

CITY OF KIRKLAND
DEPARTMENT OF PUBLIC WORKS
123 FIFTH AVENUE KIRKLAND, WA 98033
(425) 587-3800 www.kirklandwa.gov

P. HERBIG 4/2014
DESIGNED BY: DATE

J.JENNINGS 4/2014
DRAWN BY: DATE

CHECKED BY: DATE

2022 PAVEMENT MARKING PROGRAM

STREET: NE 70TH STREET

CROSS STREET: 122ND AVE NE

SEGMENT:

SCALE: N.T.S.

FILENAME: Page 12-25

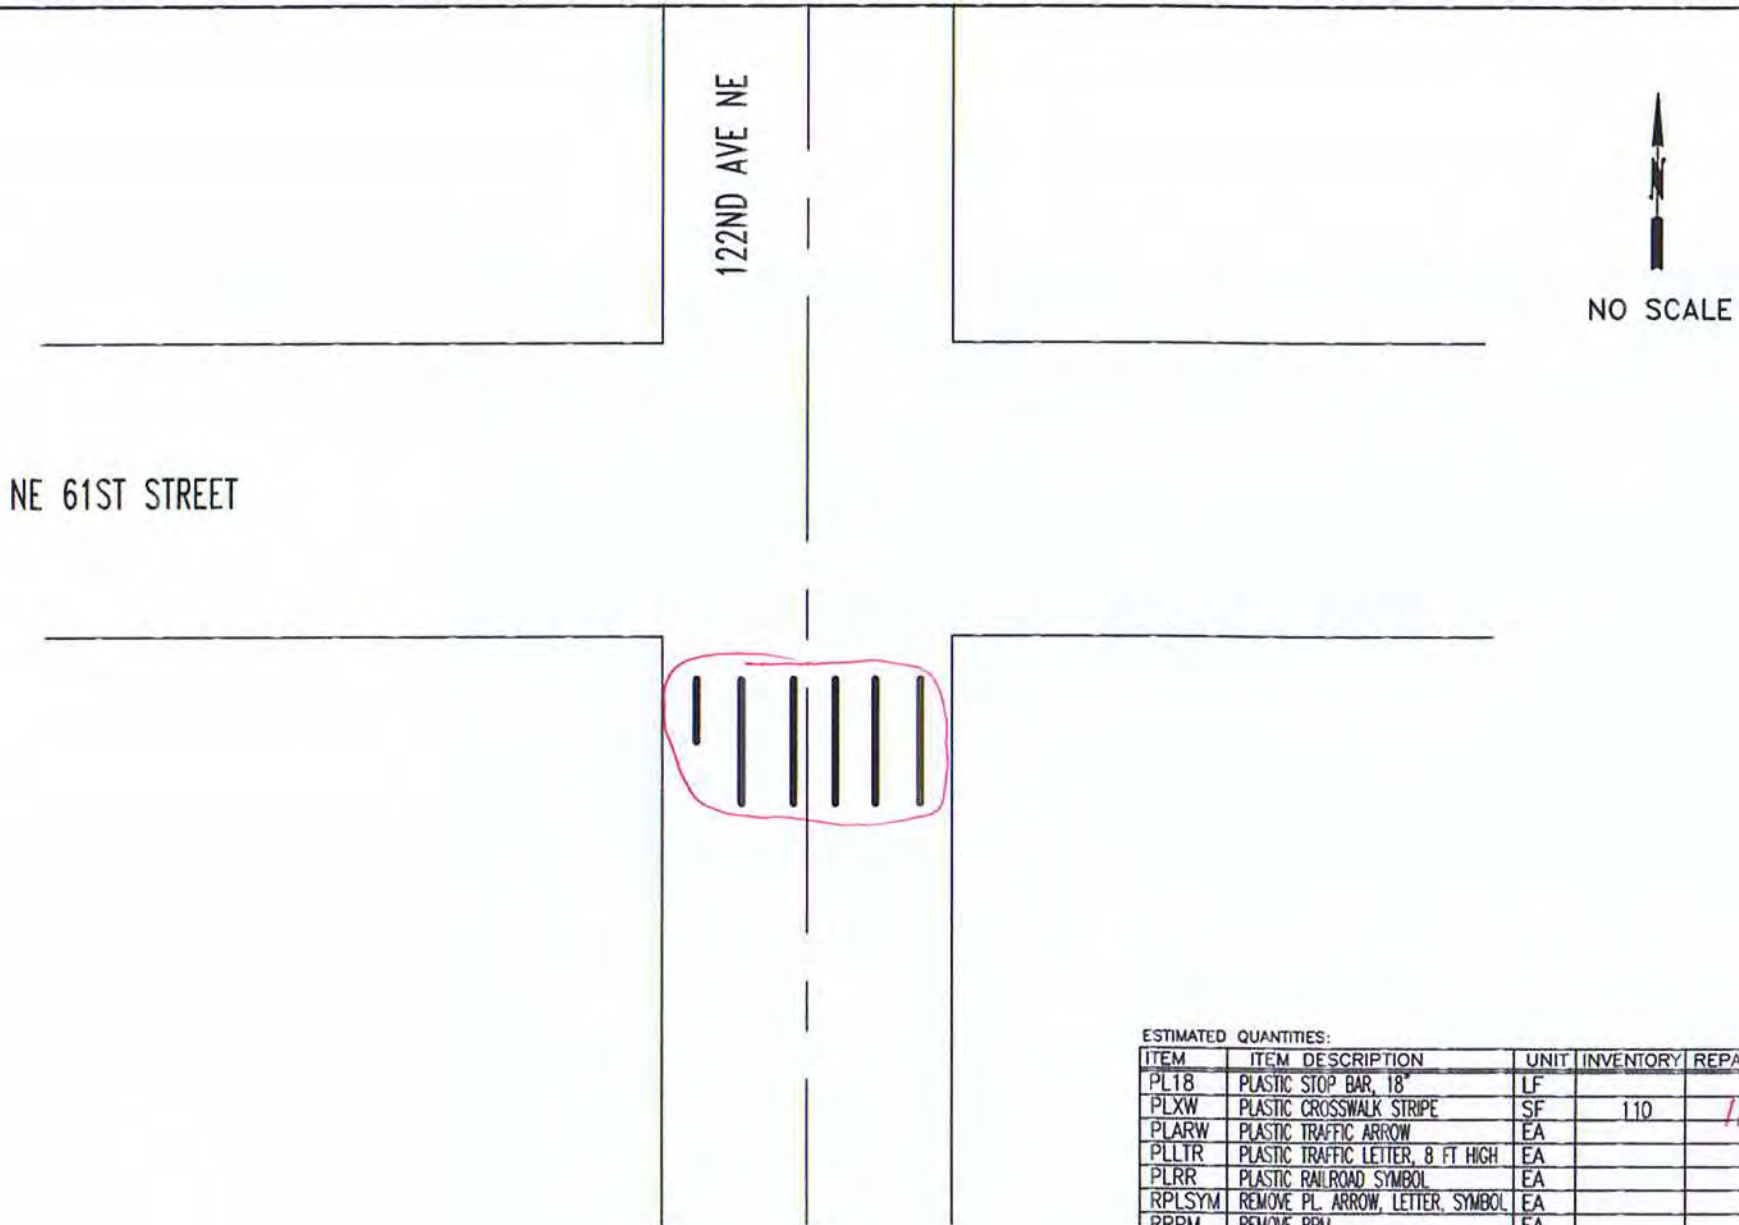

ESTIMATED QUANTITIES:

ITEM	ITEM DESCRIPTION	UNIT	INVENTORY	REPAIR QTY
PL18	PLASTIC STOP BAR, 18"	LF		
PLXW	PLASTIC CROSSWALK STRIPE	SF	110	110
PLARW	PLASTIC TRAFFIC ARROW	EA		
PLLTR	PLASTIC TRAFFIC LETTER, 8 FT HIGH	EA		
PLRR	PLASTIC RAILROAD SYMBOL	EA		
RPLSYM	REMOVE PL. ARROW, LETTER, SYMBOL	EA		
RRPM	REMOVE RPM	EA		
RPLXW	REMOVE PLASTIC STRIPE	SF		

CITY OF KIRKLAND
DEPARTMENT OF PUBLIC WORKS
123 FIFTH AVENUE KIRKLAND, WA 98033
(425) 587-3800 www.kirklandwa.gov

S. GONSAR 1/2019
DESIGNED BY: DATE

J.JENNINGS 1/2019
DRAWN BY: DATE

CHECKED BY: DATE

2022 PAVEMENT MARKING PROGRAM

STREET: NE 61ST STREET

CROSS STREET: 122ND AVE NE

SEGMENT:

SCALE: N.T.S.

FILENAME: Page 12-25B

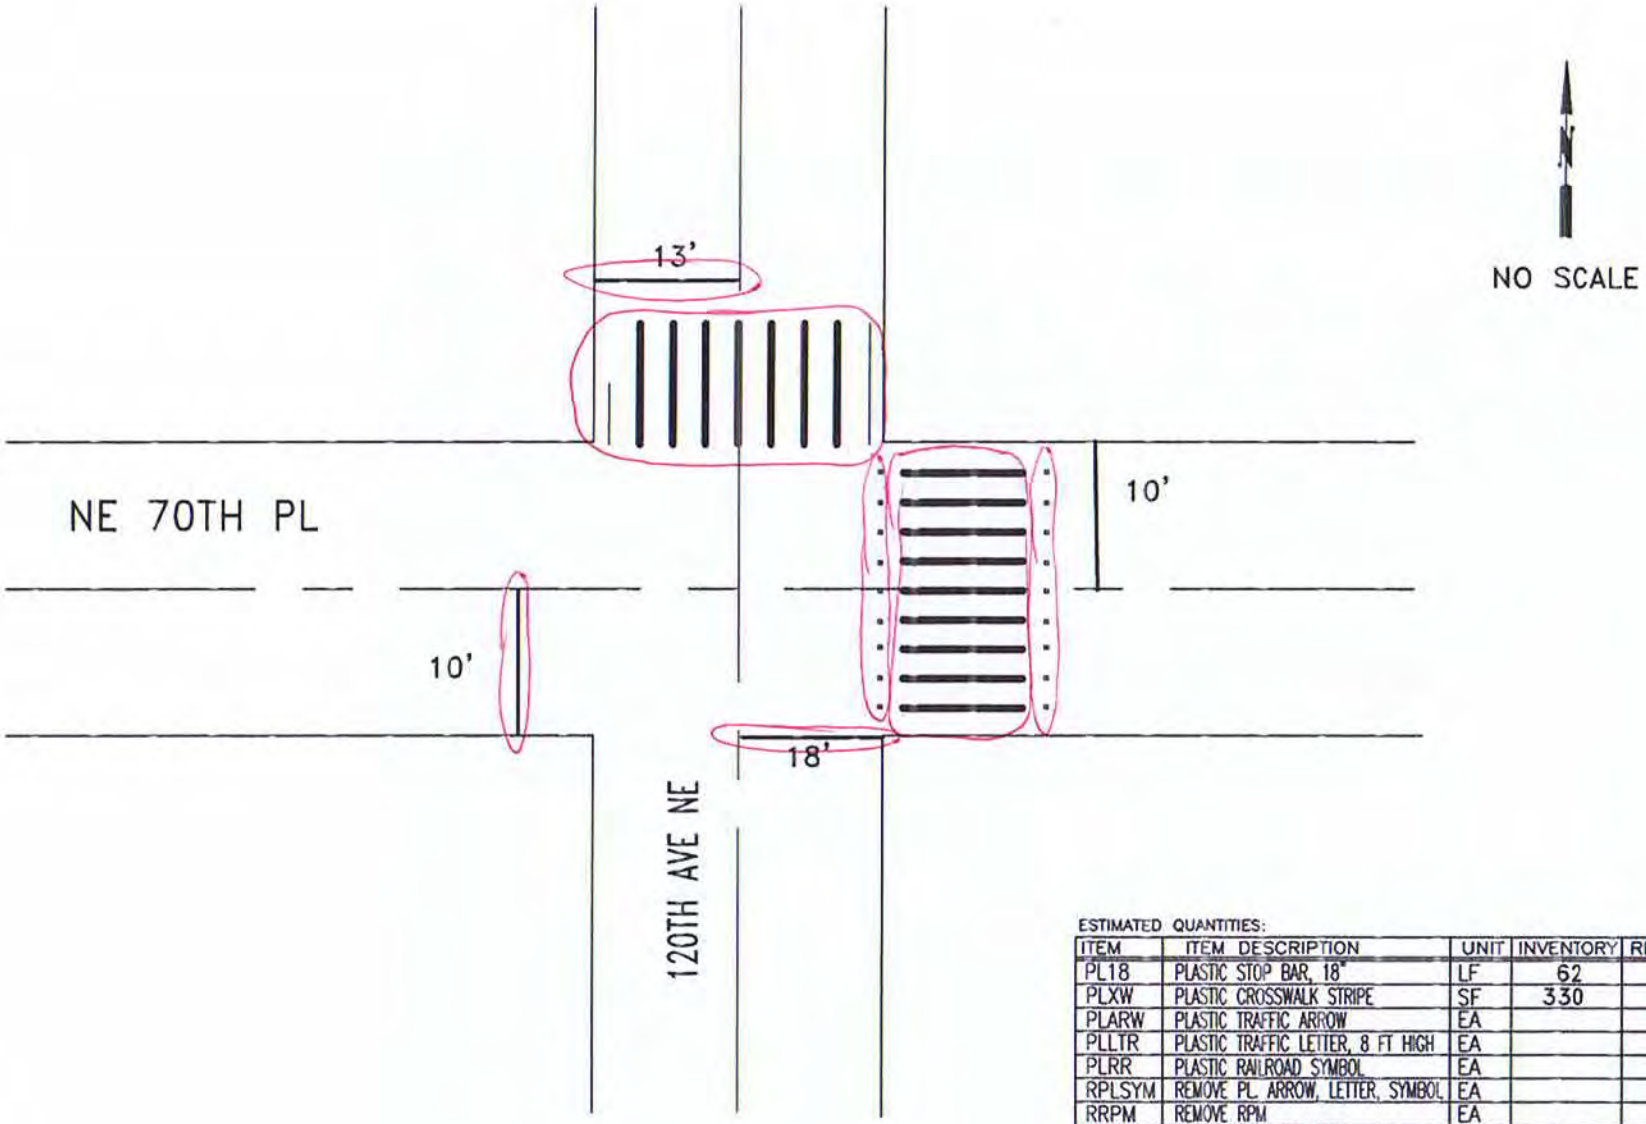

ESTIMATED QUANTITIES:

ITEM	ITEM DESCRIPTION	UNIT	INVENTORY	REPAIR QTY
PL18	PLASTIC STOP BAR, 18"	LF	62	52
PLXW	PLASTIC CROSSWALK STRIPE	SF	330	320
PLARW	PLASTIC TRAFFIC ARROW	EA		
PLLTR	PLASTIC TRAFFIC LETTER, 8 FT HIGH	EA		
PLRR	PLASTIC RAILROAD SYMBOL	EA		
RPLSYM	REMOVE PL. ARROW, LETTER, SYMBOL	EA		
RRPM	REMOVE RPM	EA		9
RPLXW	REMOVE PLASTIC STRIPE	SF		288
	RPM TYPE 2	EA	18	18

CITY OF KIRKLAND
DEPARTMENT OF PUBLIC WORKS
123 FIFTH AVENUE KIRKLAND, WA 98033
(425) 587-3800 www.kirklandwa.gov

G. HORTILLOSA 10/2006
DESIGNED BY: DATE

J.JENNINGS 10/2006
DRAWN BY: DATE

CHECKED BY: DATE

2020 PAVEMENT MARKING PROGRAM

STREET: NE 70TH STREET

CROSS STREET: 120TH AVE NE

SEGMENT:

SCALE: N.T.S.

FILENAME:

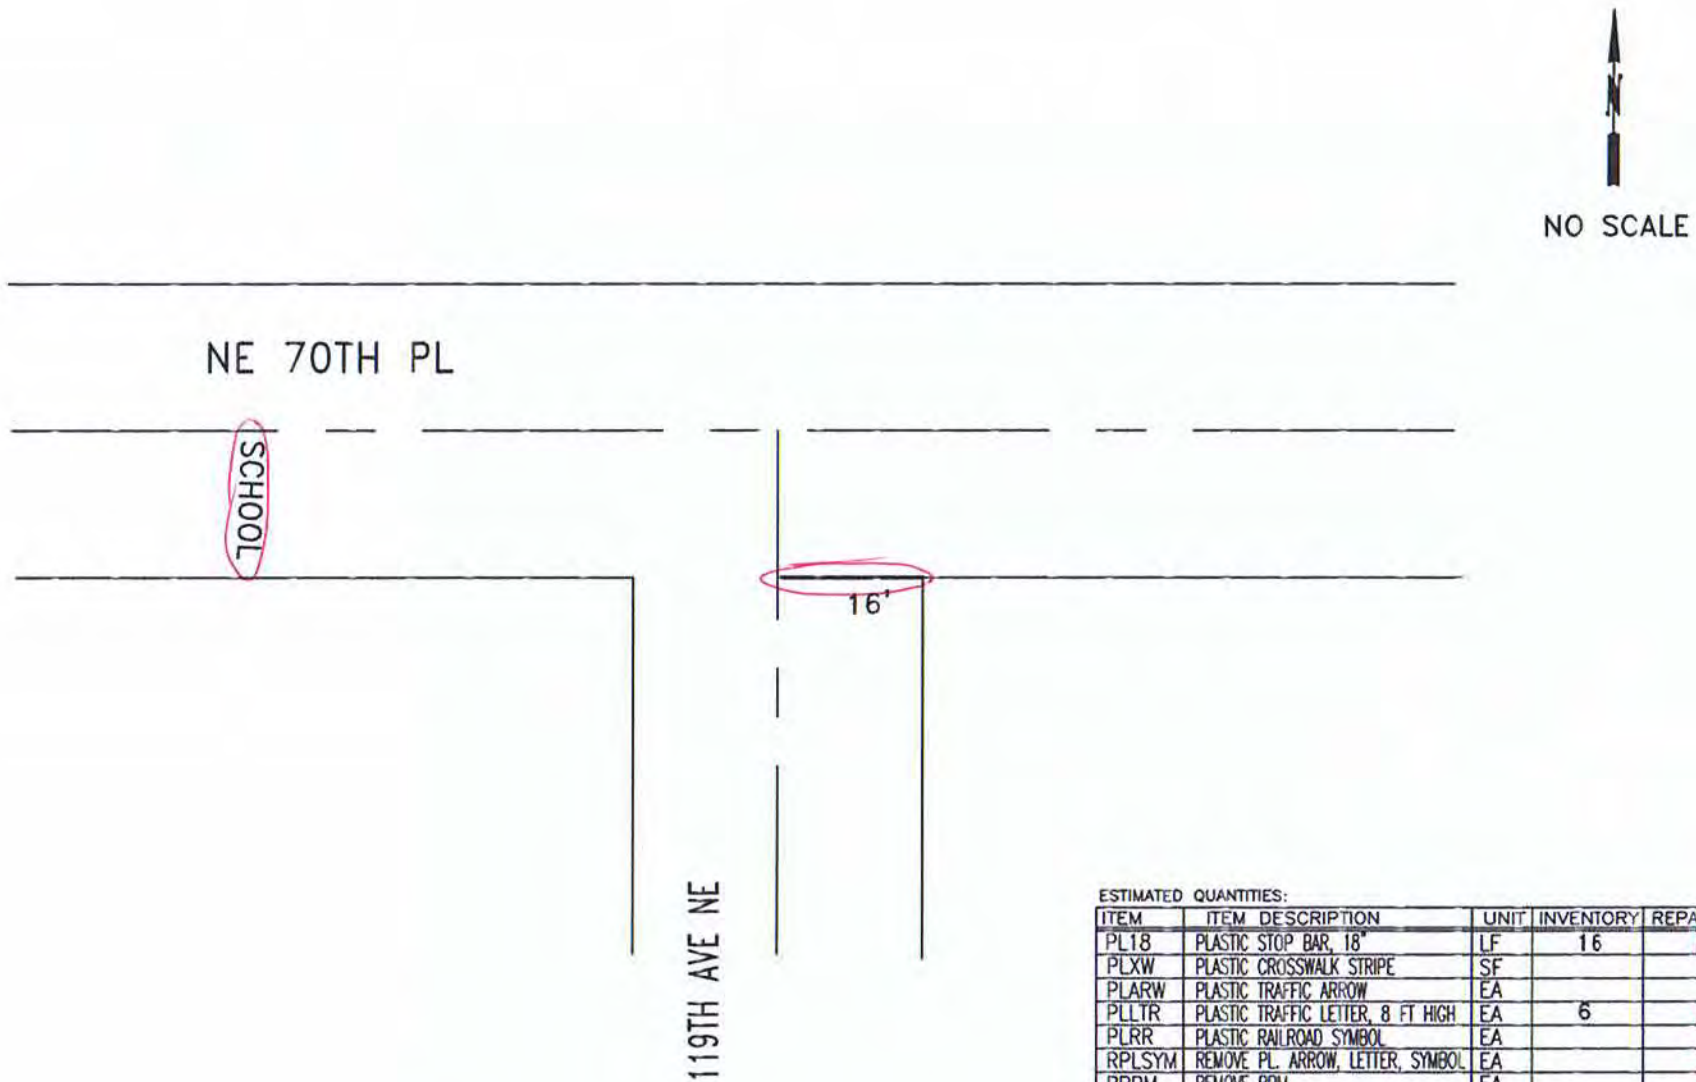

ESTIMATED QUANTITIES:

ITEM	ITEM DESCRIPTION	UNIT	INVENTORY	REPAIR QTY
PL18	PLASTIC STOP BAR, 18"	LF	16	16
PLXW	PLASTIC CROSSWALK STRIPE	SF		
PLARW	PLASTIC TRAFFIC ARROW	EA		
PLLTR	PLASTIC TRAFFIC LETTER, 8 FT HIGH	EA	6	6
PLRR	PLASTIC RAILROAD SYMBOL	EA		
RPLSYM	REMOVE PL. ARROW, LETTER, SYMBOL	EA		2
RRPM	REMOVE RPM	EA		
RPLXW	REMOVE PLASTIC STRIPE	SF		24

CITY OF KIRKLAND
DEPARTMENT OF PUBLIC WORKS
123 FIFTH AVENUE KIRKLAND, WA 98033
(425) 587-3800 www.kirklandwa.gov

D.GRILLEY 1/2000
DESIGNED BY: DATE

J.JENNINGS 1/2000
DRAWN BY: DATE

CHECKED BY: DATE

2022 PAVEMENT MARKING PROGRAM

STREET: NE 70TH PL

CROSS STREET: 119TH AVE NE

SEGMENT:

SCALE: N.T.S.

FILENAME:

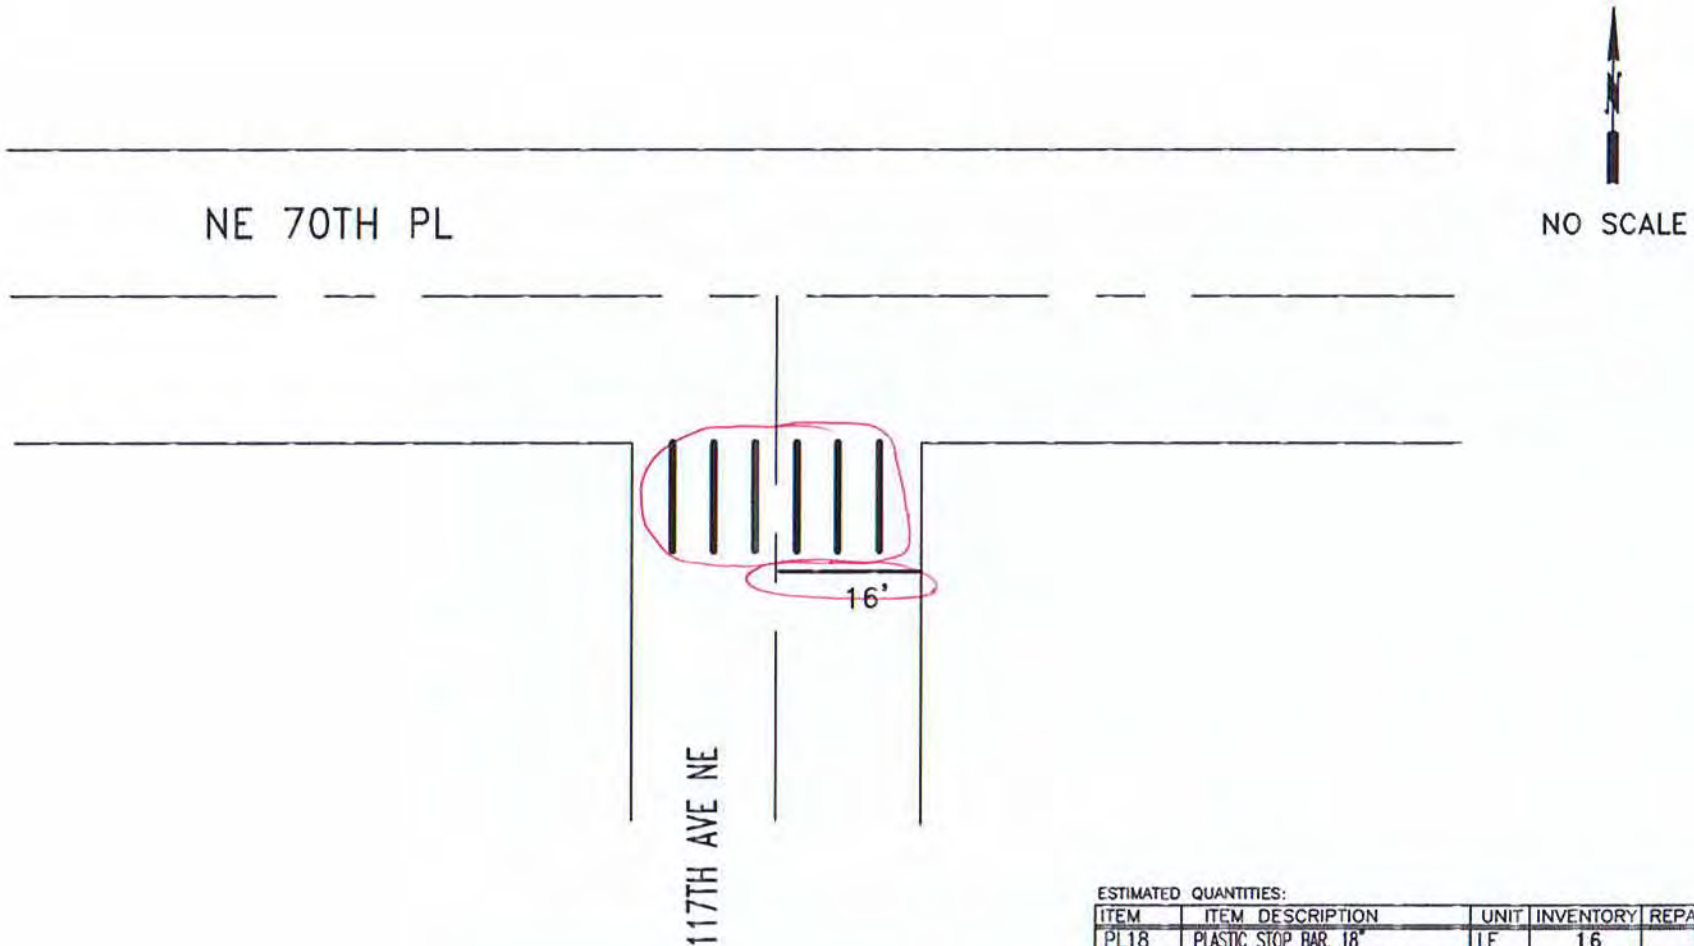

ESTIMATED QUANTITIES:

ITEM	ITEM DESCRIPTION	UNIT	INVENTORY	REPAIR QTY
PL18	PLASTIC STOP BAR, 18"	LF	16	16
PLXW	PLASTIC CROSSWALK STRIPE	SF	120	120
PLARW	PLASTIC TRAFFIC ARROW	EA		
PLLTR	PLASTIC TRAFFIC LETTER, 8 FT HIGH	EA		
PLRR	PLASTIC RAILROAD SYMBOL	EA		
RPLSYM	REMOVE PL. ARROW, LETTER, SYMBOL	EA		
RRPM	REMOVE RPM	EA		
RPLXW	REMOVE PLASTIC STRIPE	SF		140

CITY OF KIRKLAND
DEPARTMENT OF PUBLIC WORKS
123 FIFTH AVENUE KIRKLAND, WA 98033
(425) 587-3800 www.kirklandwa.gov

R. STEITZER 8/2005
DESIGNED BY: DATE

J.JENNINGS 8/2005
DRAWN BY: DATE

CHECKED BY: DATE

2022 PAVEMENT MARKING PROGRAM

STREET: NE 70TH PL

CROSS STREET: 117TH AVE NE

SEGMENT:

SCALE: N.T.S.

FILENAME:

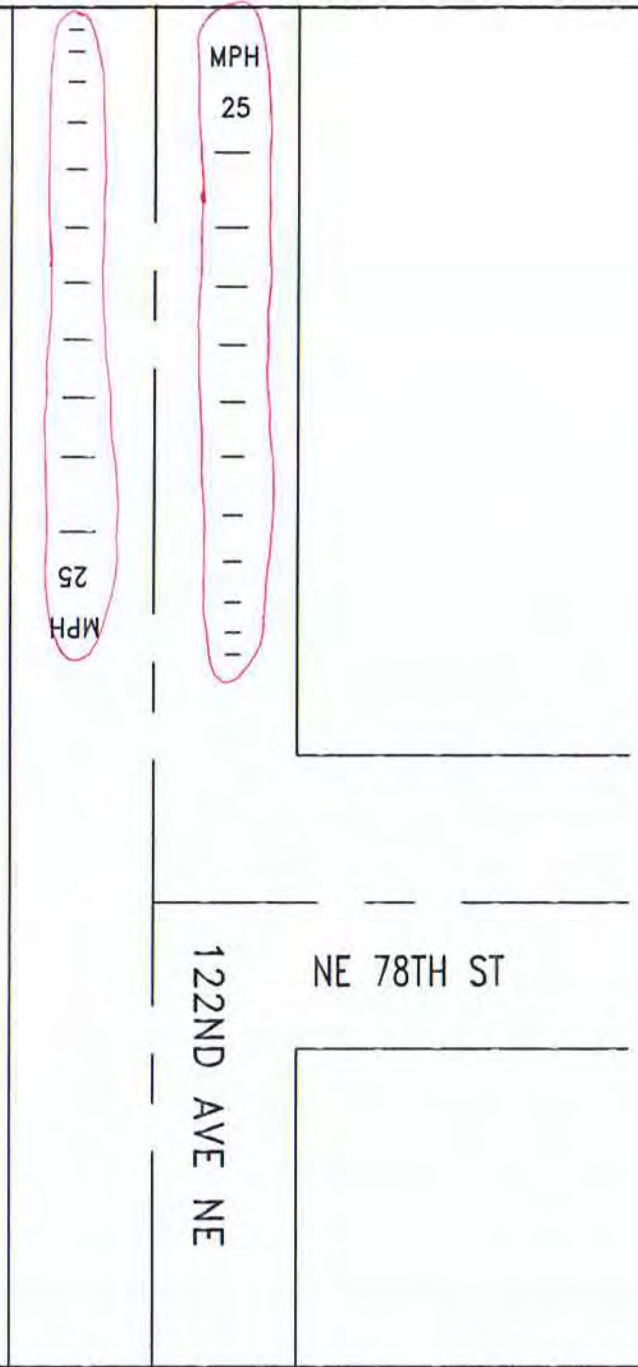

NO SCALE

ESTIMATED QUANTITIES:

ITEM	ITEM DESCRIPTION	UNIT	INVENTORY	REPAIR QTY
PL18	PLASTIC STOP BAR, 18"	LF		
PLXW	PLASTIC CROSSWALK STRIPE	SF		
PLARW	PLASTIC TRAFFIC ARROW	EA		
PLLTR	PLASTIC TRAFFIC LETTER, 8 FT HIGH	EA	10	10
PLRR	PLASTIC RAILROAD SYMBOL	EA		
RPLSYM	REMOVE PL. ARROW, LETTER, SYMBOL	EA		4
RRPM	REMOVE RPM	EA		
RPLXW	REMOVE PLASTIC STRIPE	SF		
PLLGD	PLASTIC SPEED LEGEND BARS	SF	124	124

CITY OF KIRKLAND
DEPARTMENT OF PUBLIC WORKS
123 FIFTH AVENUE KIRKLAND, WA 98033
(425) 587-3800 www.kirklandwa.gov

L. KAWOAKA 3/2016
DESIGNED BY: DATE

J.JENNINGS 3/2016
DRAWN BY: DATE

CHECKED BY: DATE

2020 PAVEMENT MARKING PROGRAM

STREET: 122ND AVE NE

CROSS STREET: NE 78TH ST

SEGMENT:

SCALE: N.T.S.

FILENAME:

CENTRAL HOUGHTON INTERSECTION PLANS

CITY OF KIRKLAND
DEPARTMENT OF PUBLIC WORKS
123 FIFTH AVENUE KIRKLAND, WA 98033
(425) 587-3800 www.kirklandwa.gov

S GONSAR	1/2020	DESIGNED BY: DATE
J.JENNINGS	1/2020	DRAWN BY: DATE
		CHECKED BY: DATE

2020 PAVEMENT MARKING PROGRAM

STREET:

CROSS STREET:

SEGMENT:

SCALE: N.T.S.

FILENAME: 14-0

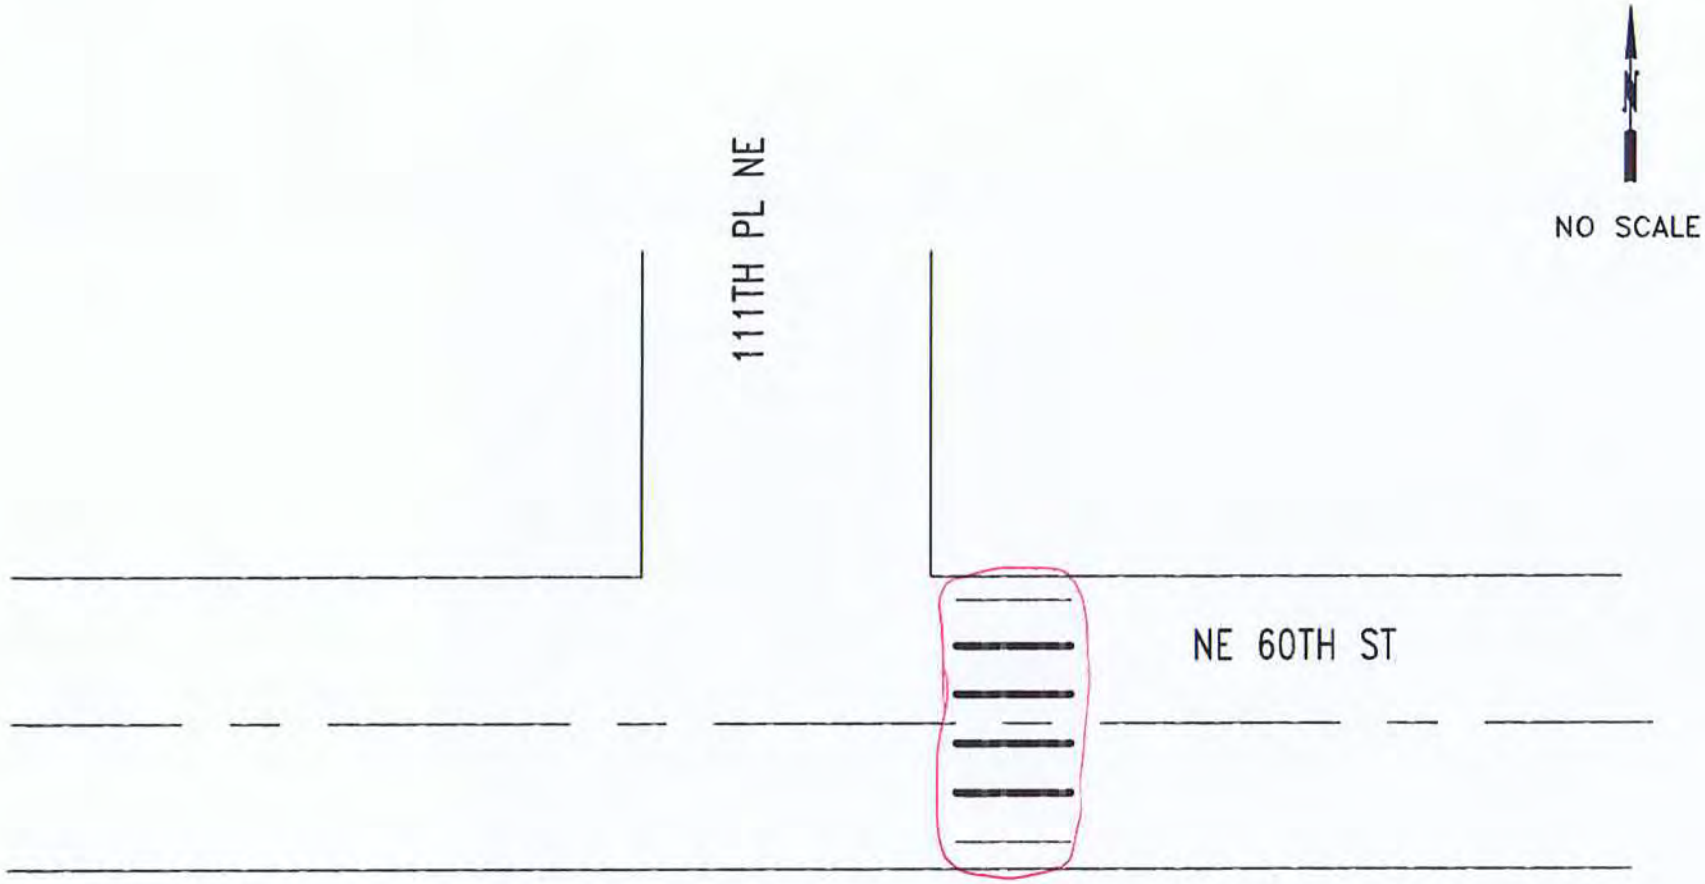

ESTIMATED QUANTITIES:

ITEM	ITEM DESCRIPTION	UNIT	INVENTORY	REPAIR QTY
PL18	PLASTIC STOP BAR, 18"	LF		
PLXW	PLASTIC CROSSWALK STRIPE	SF	100	100
PLARW	PLASTIC TRAFFIC ARROW	EA		
PLLTR	PLASTIC TRAFFIC LETTER, 8 FT HIGH	EA		
PLRR	PLASTIC RAILROAD SYMBOL	EA		
RPLSYM	REMOVE PL. ARROW, LETTER, SYMBOL	EA		
RRPM	REMOVE RPM	EA		
RPLXW	REMOVE PLASTIC STRIPE	SF		

CITY OF KIRKLAND
DEPARTMENT OF PUBLIC WORKS
123 FIFTH AVENUE KIRKLAND, WA 98033
(425) 587-3800 www.kirklandwa.gov

D.GRILLEY 1/2000
DESIGNED BY: DATE

J.JENNINGS 11/2000
DRAWN BY: DATE

CHECKED BY: DATE

2020 PAVEMENT MARKING PROGRAM

STREET: NE 60TH ST

CROSS STREET: 111TH PL NE

SEGMENT:

SCALE: N.T.S.

FILENAME: Page 14-1

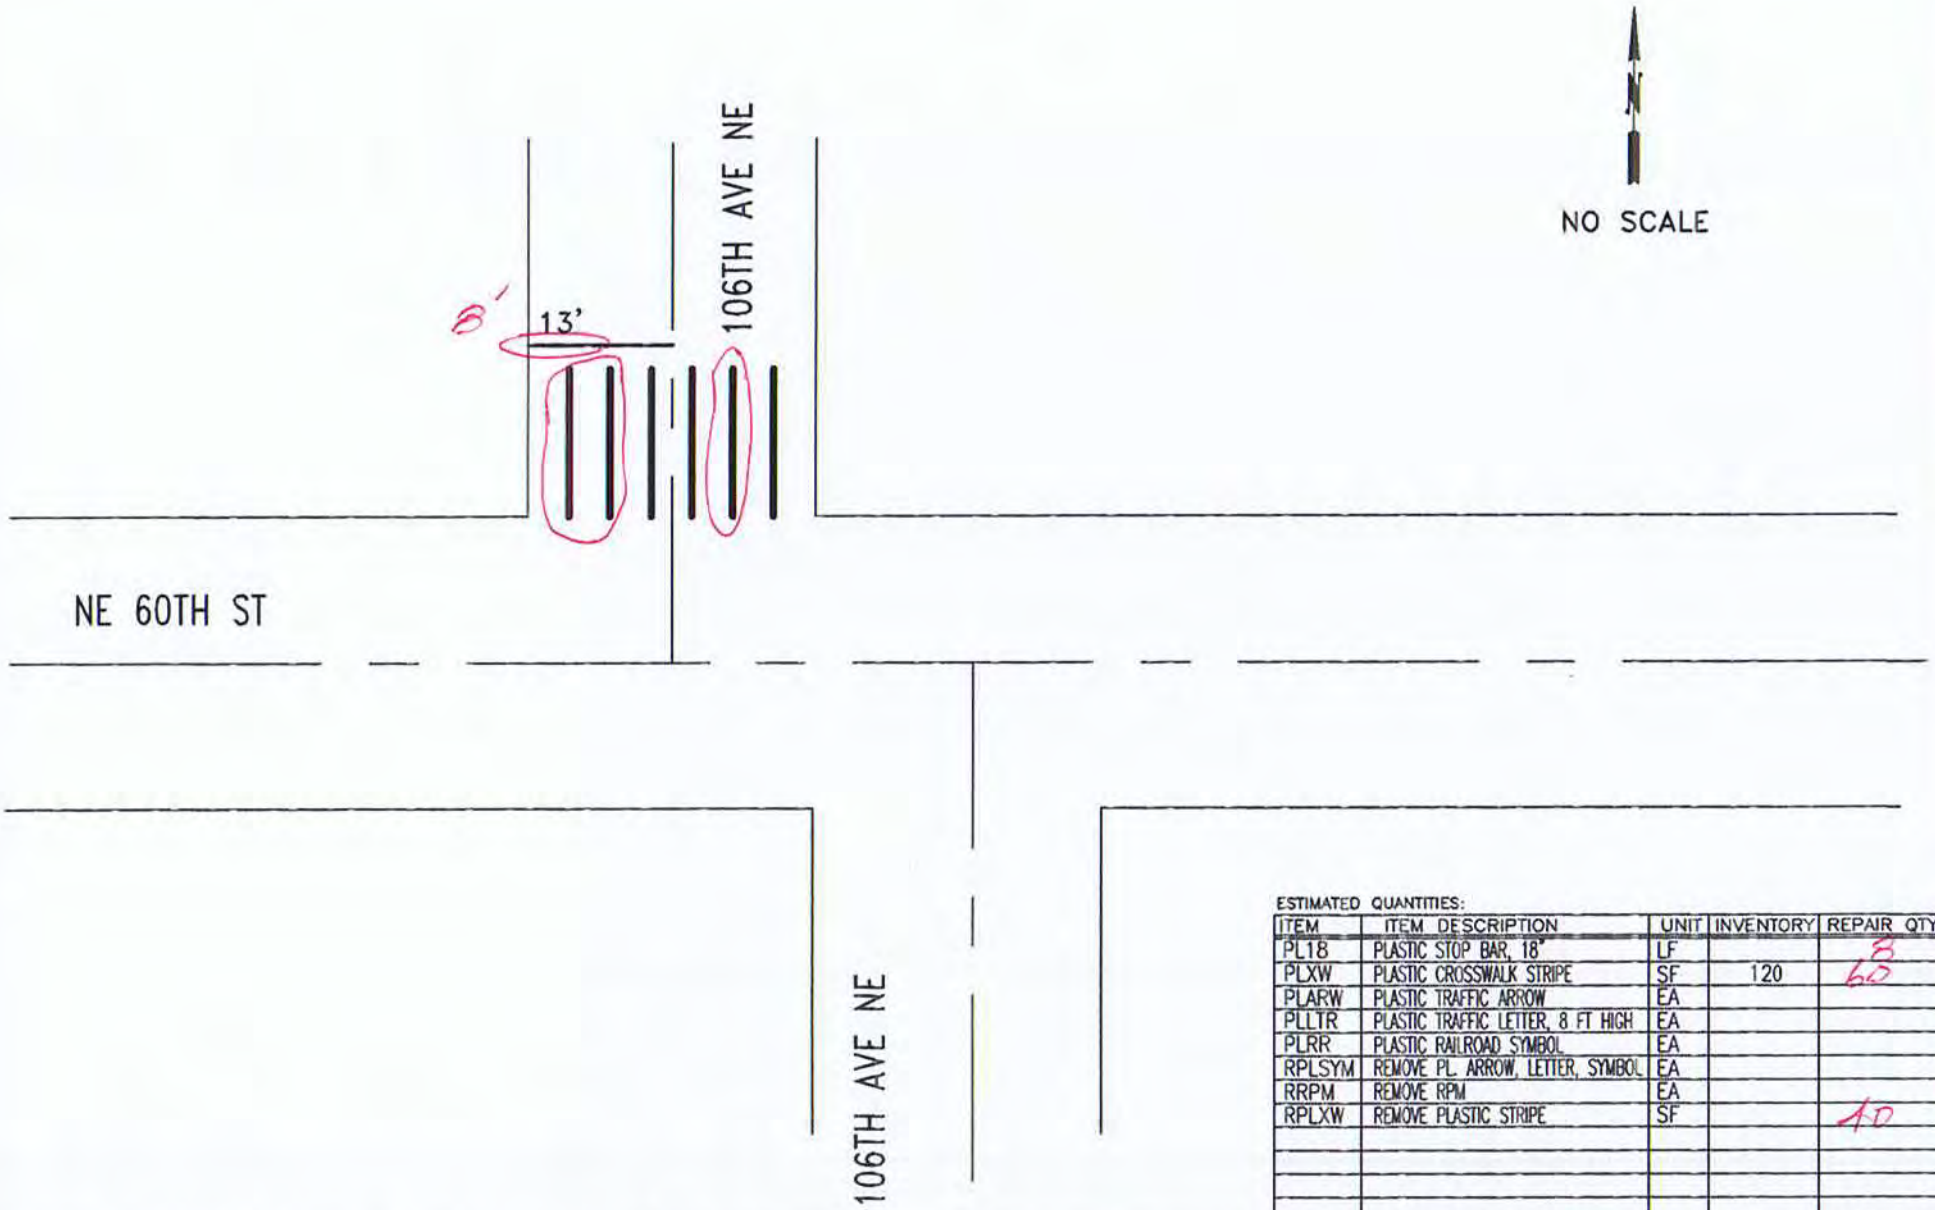

ESTIMATED QUANTITIES:

ITEM	ITEM DESCRIPTION	UNIT	INVENTORY	REPAIR QTY
PL18	PLASTIC STOP BAR, 18"	LF		8
PLXW	PLASTIC CROSSWALK STRIPE	SF	120	60
PLARW	PLASTIC TRAFFIC ARROW	EA		
PLLTR	PLASTIC TRAFFIC LETTER, 8 FT HIGH	EA		
PLRR	PLASTIC RAILROAD SYMBOL	EA		
RPLSYM	REMOVE PL. ARROW, LETTER, SYMBOL	EA		
RRPM	REMOVE RPM	EA		
RPLXW	REMOVE PLASTIC STRIPE	SF		10

CITY OF KIRKLAND WASHINGTON

CITY OF KIRKLAND
DEPARTMENT OF PUBLIC WORKS
123 FIFTH AVENUE KIRKLAND, WA 98033
(425) 587-3800 www.kirklandwa.gov

D.GRILLEY 1/2000
DESIGNED BY: DATE

J.JENNINGS 5/2001
DRAWN BY: DATE

CHECKED BY: DATE


STREET: NE 60TH ST

CROSS STREET: 106TH AVE NE

SEGMENT:

SCALE: N.T.S.

FILENAME: Page 14-3

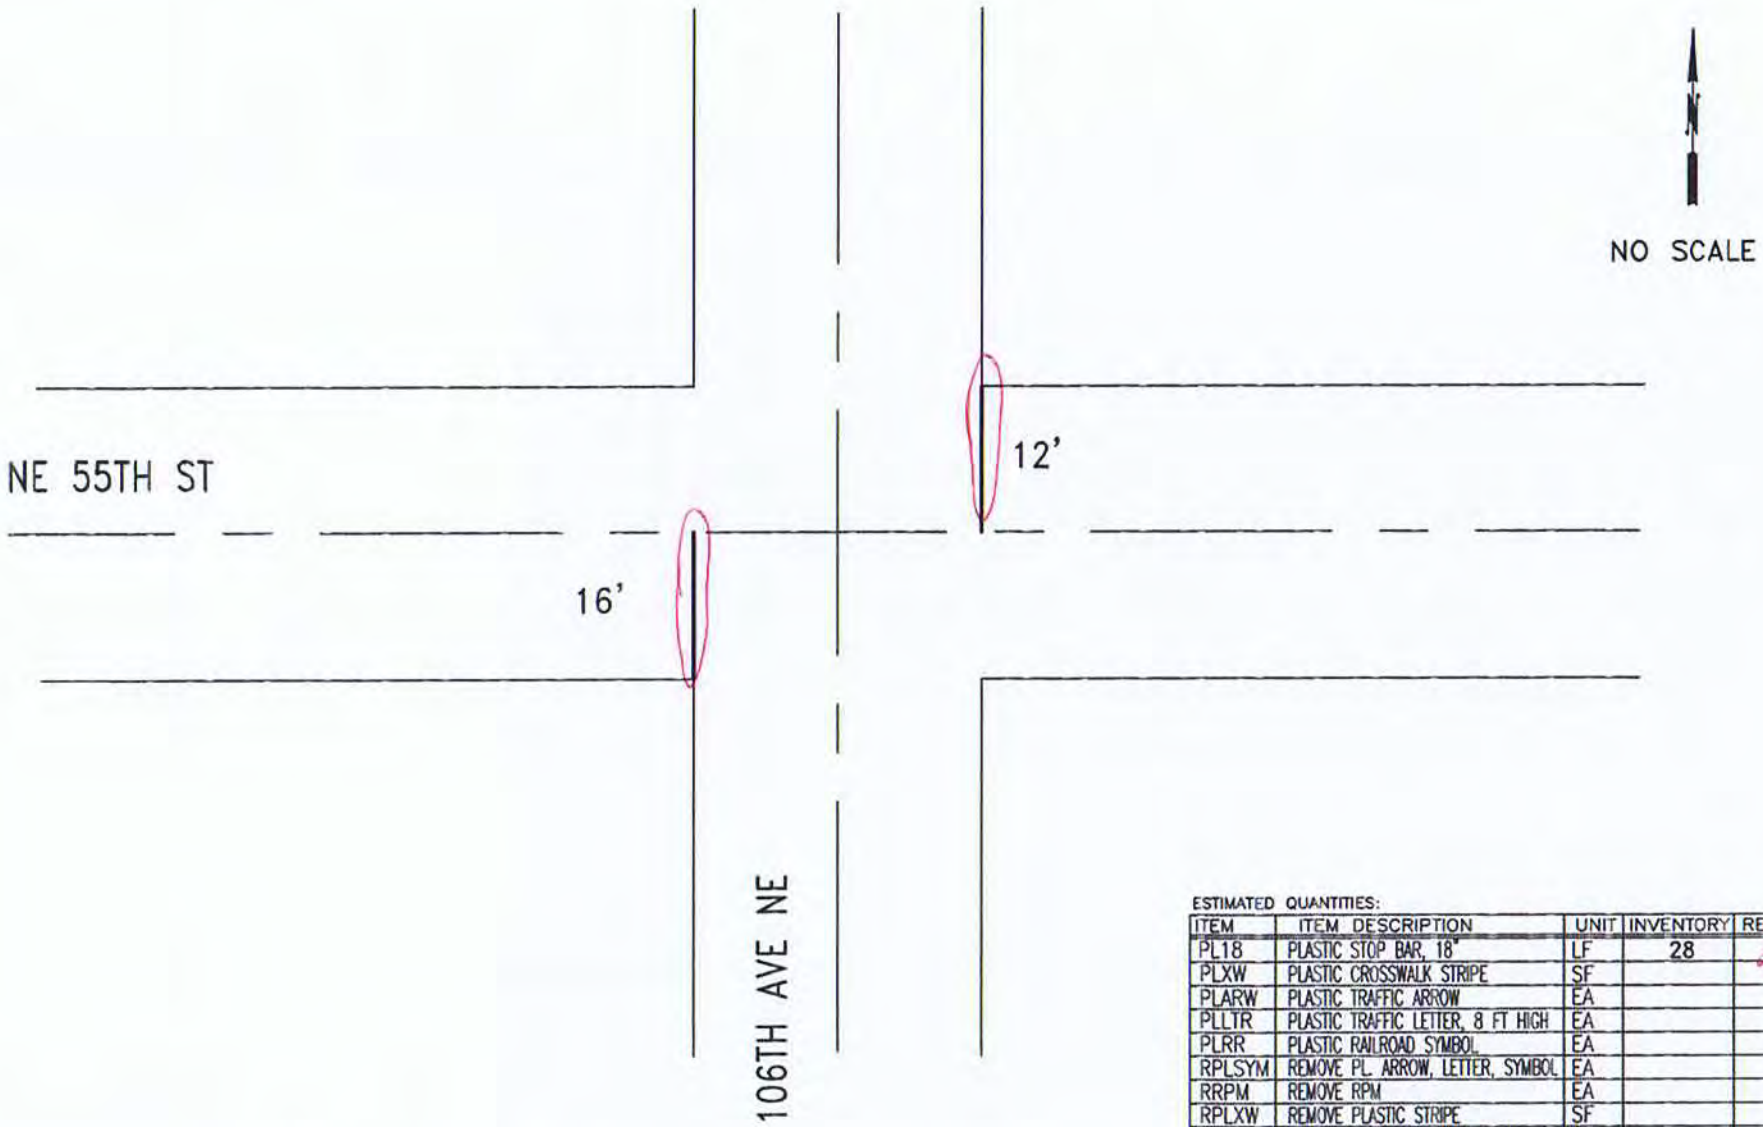

ESTIMATED QUANTITIES:

ITEM	ITEM DESCRIPTION	UNIT	INVENTORY	REPAIR QTY
PL18	PLASTIC STOP BAR, 18"	LF	28	28
PLXW	PLASTIC CROSSWALK STRIPE	SF		
PLARW	PLASTIC TRAFFIC ARROW	EA		
PLLTR	PLASTIC TRAFFIC LETTER, 8 FT HIGH	EA		
PLRR	PLASTIC RAILROAD SYMBOL	EA		
RPLSYM	REMOVE PL. ARROW, LETTER, SYMBOL	EA		
RRPM	REMOVE RPM	EA		
RPLXW	REMOVE PLASTIC STRIPE	SF		
	PAINT STRIPE, 12" TRANSVERSE	LF		
	PAINTED TRAFFIC LETTER, 8'	EA		

CITY OF KIRKLAND
DEPARTMENT OF PUBLIC WORKS
123 FIFTH AVENUE KIRKLAND, WA 98033
(425) 587-3800 www.kirklandwa.gov

R. STEITZER 10/2003
DESIGNED BY: DATE

J.JENNINGS 2/2004
DRAWN BY: DATE

CHECKED BY: DATE

2020 PAVEMENT MARKING PROGRAM

STREET: NE 55TH ST

CROSS STREET: 106TH AVE NE

SEGMENT:

SCALE: N.T.S.

FILENAME: Page 14-4

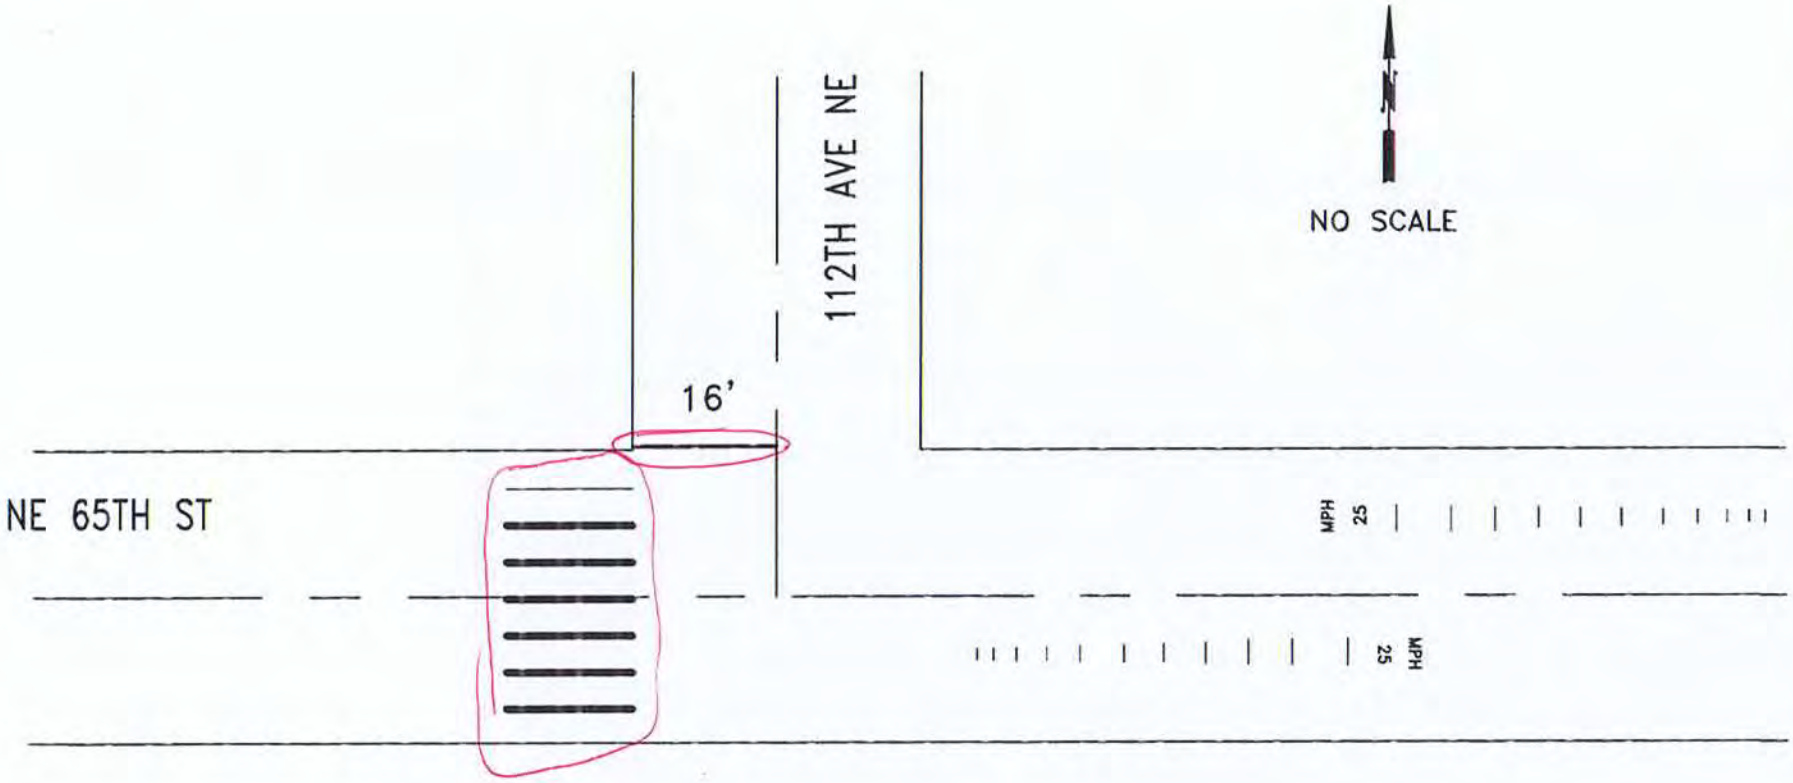

ESTIMATED QUANTITIES:

ITEM	ITEM DESCRIPTION	UNIT	INVENTORY	REPAIR QTY
PL18	PLASTIC STOP BAR, 18"	LF	24	
PLXW	PLASTIC CROSSWALK STRIPE	SF	130	130
PLARW	PLASTIC TRAFFIC ARROW	EA		
PLLTR	PLASTIC TRAFFIC LETTER, 8 FT HIGH	EA		
PLRR	PLASTIC RAILROAD SYMBOL	EA		
RPLSYM	REMOVE PL. ARROW, LETTER, SYMBOL	EA	10	
RRPM	REMOVE RPM	EA		
RPLXW	REMOVE PLASTIC STRIPE	SF		130
	PLASTIC SPEED LEGEND BARS		24	

CITY OF KIRKLAND
DEPARTMENT OF PUBLIC WORKS
123 FIFTH AVENUE KIRKLAND, WA 98033
(425) 587-3800 www.kirklandwa.gov

G. HORTILLOSA 10/2011
DESIGNED BY: DATE

J.JENNINGS 10/2011
DRAWN BY: DATE

CHECKED BY: DATE

2020 PAVEMENT MARKING PROGRAM

STREET: NE 65TH ST

CROSS STREET: 112TH AVE NE

SEGMENT:

SCALE: N.T.S.

FILENAME: Page 14-5

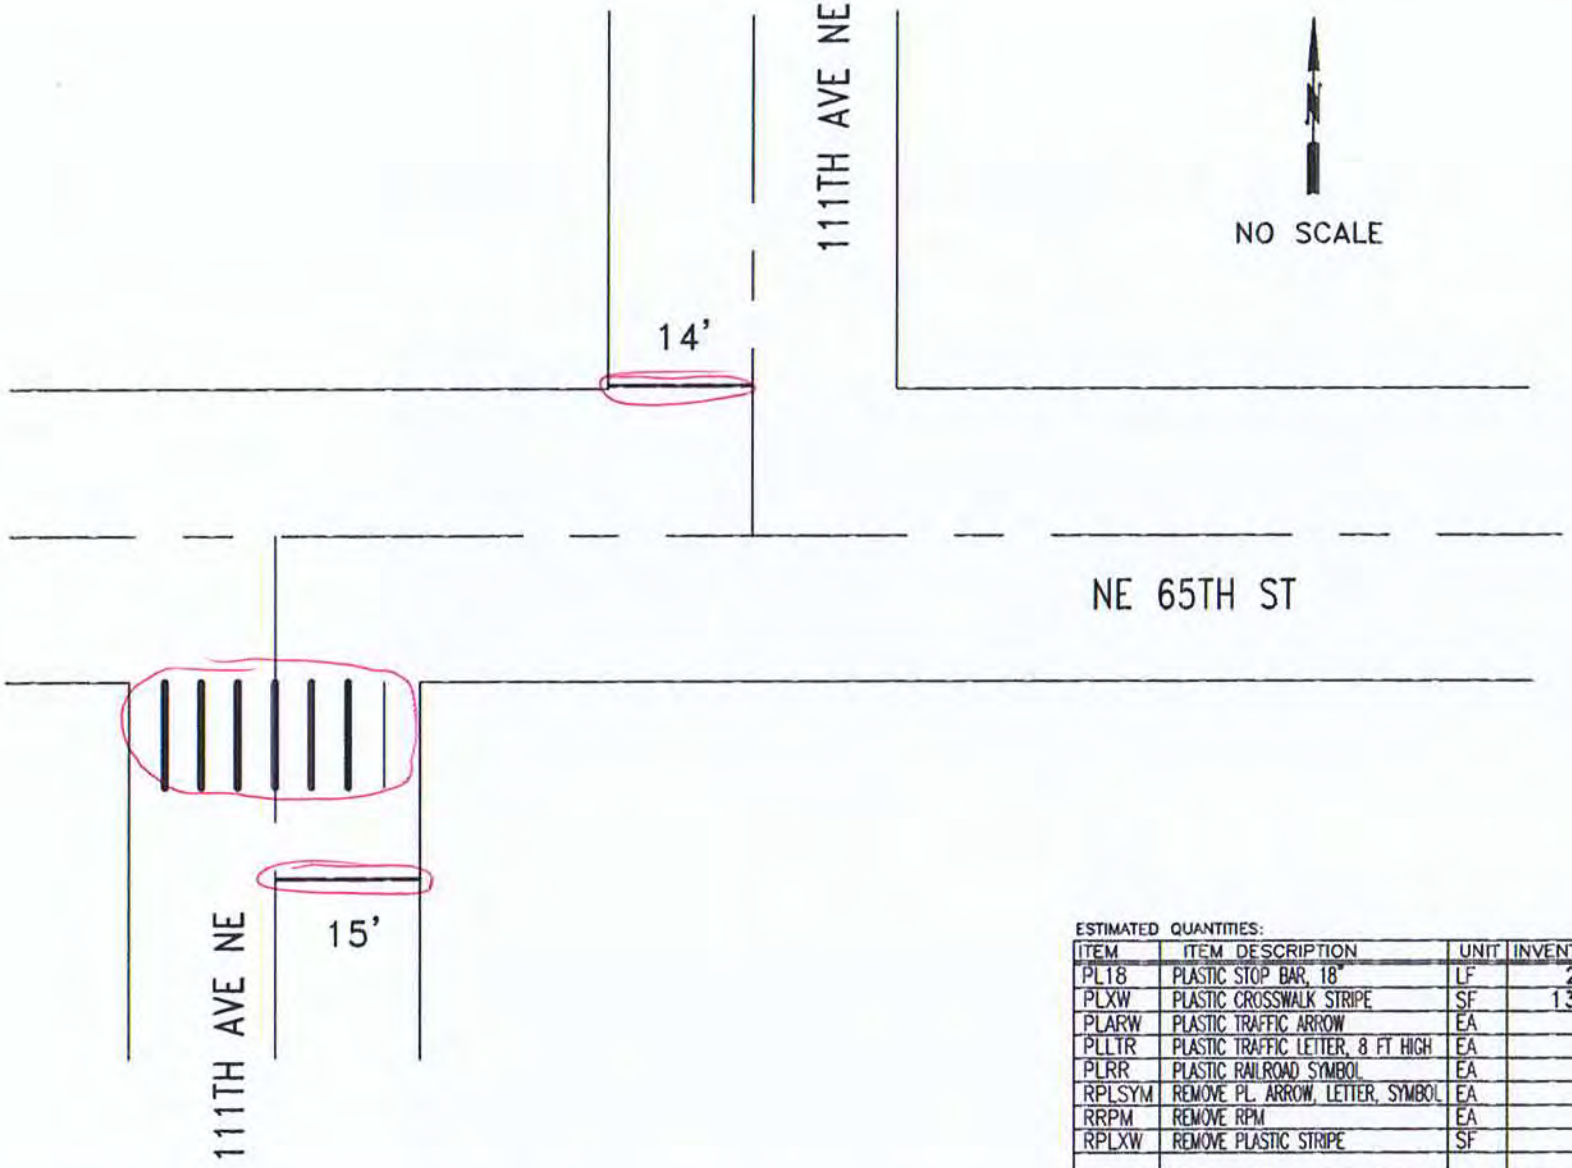

ESTIMATED QUANTITIES:

ITEM	ITEM DESCRIPTION	UNIT	INVENTORY	REPAIR QTY
PL18	PLASTIC STOP BAR, 18"	LF	29	
PLXW	PLASTIC CROSSWALK STRIPE	SF	130	135
PLARW	PLASTIC TRAFFIC ARROW	EA		
PLLTR	PLASTIC TRAFFIC LETTER, 8 FT HIGH	EA		
PLRR	PLASTIC RAILROAD SYMBOL	EA		
RPLSYM	REMOVE PL. ARROW, LETTER, SYMBOL	EA		
RRPM	REMOVE RPM	EA		
RPLXW	REMOVE PLASTIC STRIPE	SF		

CITY OF KIRKLAND
DEPARTMENT OF PUBLIC WORKS
123 FIFTH AVENUE KIRKLAND, WA 98033
(425) 587-3800 www.kirklandwa.gov

G. HORTILLOSA 10/2011
DESIGNED BY: DATE

J.JENNINGS 10/2011
DRAWN BY: DATE

CHECKED BY: DATE

2022 PAVEMENT MARKING PROGRAM

STREET: NE 65TH ST

CROSS STREET: 111TH AVE NE

SEGMENT:

SCALE: N.T.S.

FILENAME:

NO SCALE

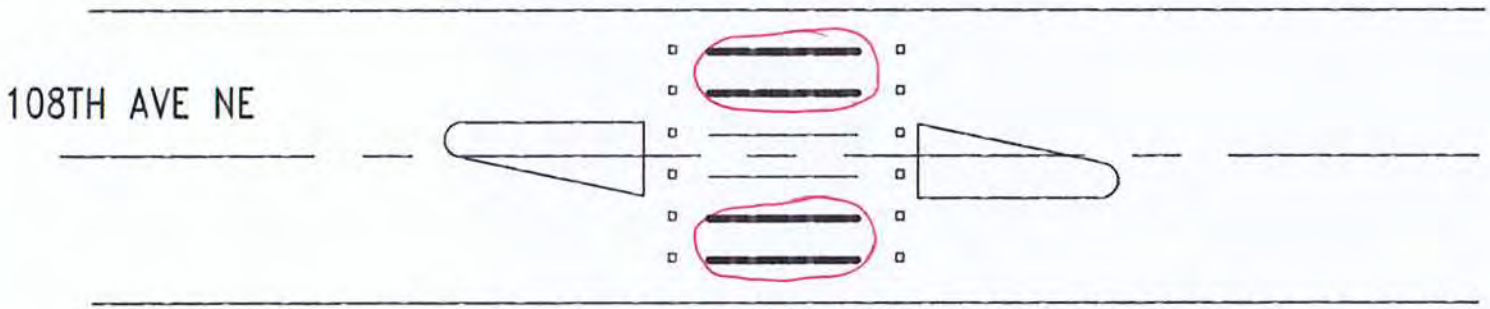

ESTIMATED QUANTITIES:

ITEM	ITEM DESCRIPTION	UNIT	INVENTORY	REPAIR QTY
PL18	PLASTIC STOP BAR, 18"	LF		
PLXW	PLASTIC CROSSWALK STRIPE	SF	80	80
PLARW	PLASTIC TRAFFIC ARROW	EA		
PLLTR	PLASTIC TRAFFIC LETTER, 8 FT HIGH	EA		
PLRR	PLASTIC RAILROAD SYMBOL	EA		
RPLSYM	REMOVE PL. ARROW, LETTER, SYMBOL	EA		
RRPM	REMOVE RPM	EA		
RPLXW	REMOVE PLASTIC STRIPE	SF		
RPM11	TYPE II RPM	EA	12	

CITY OF KIRKLAND WASHINGTON

CITY OF KIRKLAND
DEPARTMENT OF PUBLIC WORKS
123 FIFTH AVENUE KIRKLAND, WA 98033
(425) 587-3800 www.kirklandwa.gov

G. HORTILLOSA 10/2011
DESIGNED BY: DATE

J.JENNINGS 10/2011
DRAWN BY: DATE

CHECKED BY: DATE

20__ PAVEMENT MARKING PROGRAM

STREET: 108TH AVE NE

CROSS STREET: X-WALK N OF 62ND AVE NE

SEGMENT:

SCALE: N.T.S.

FILENAME: Page 14-7

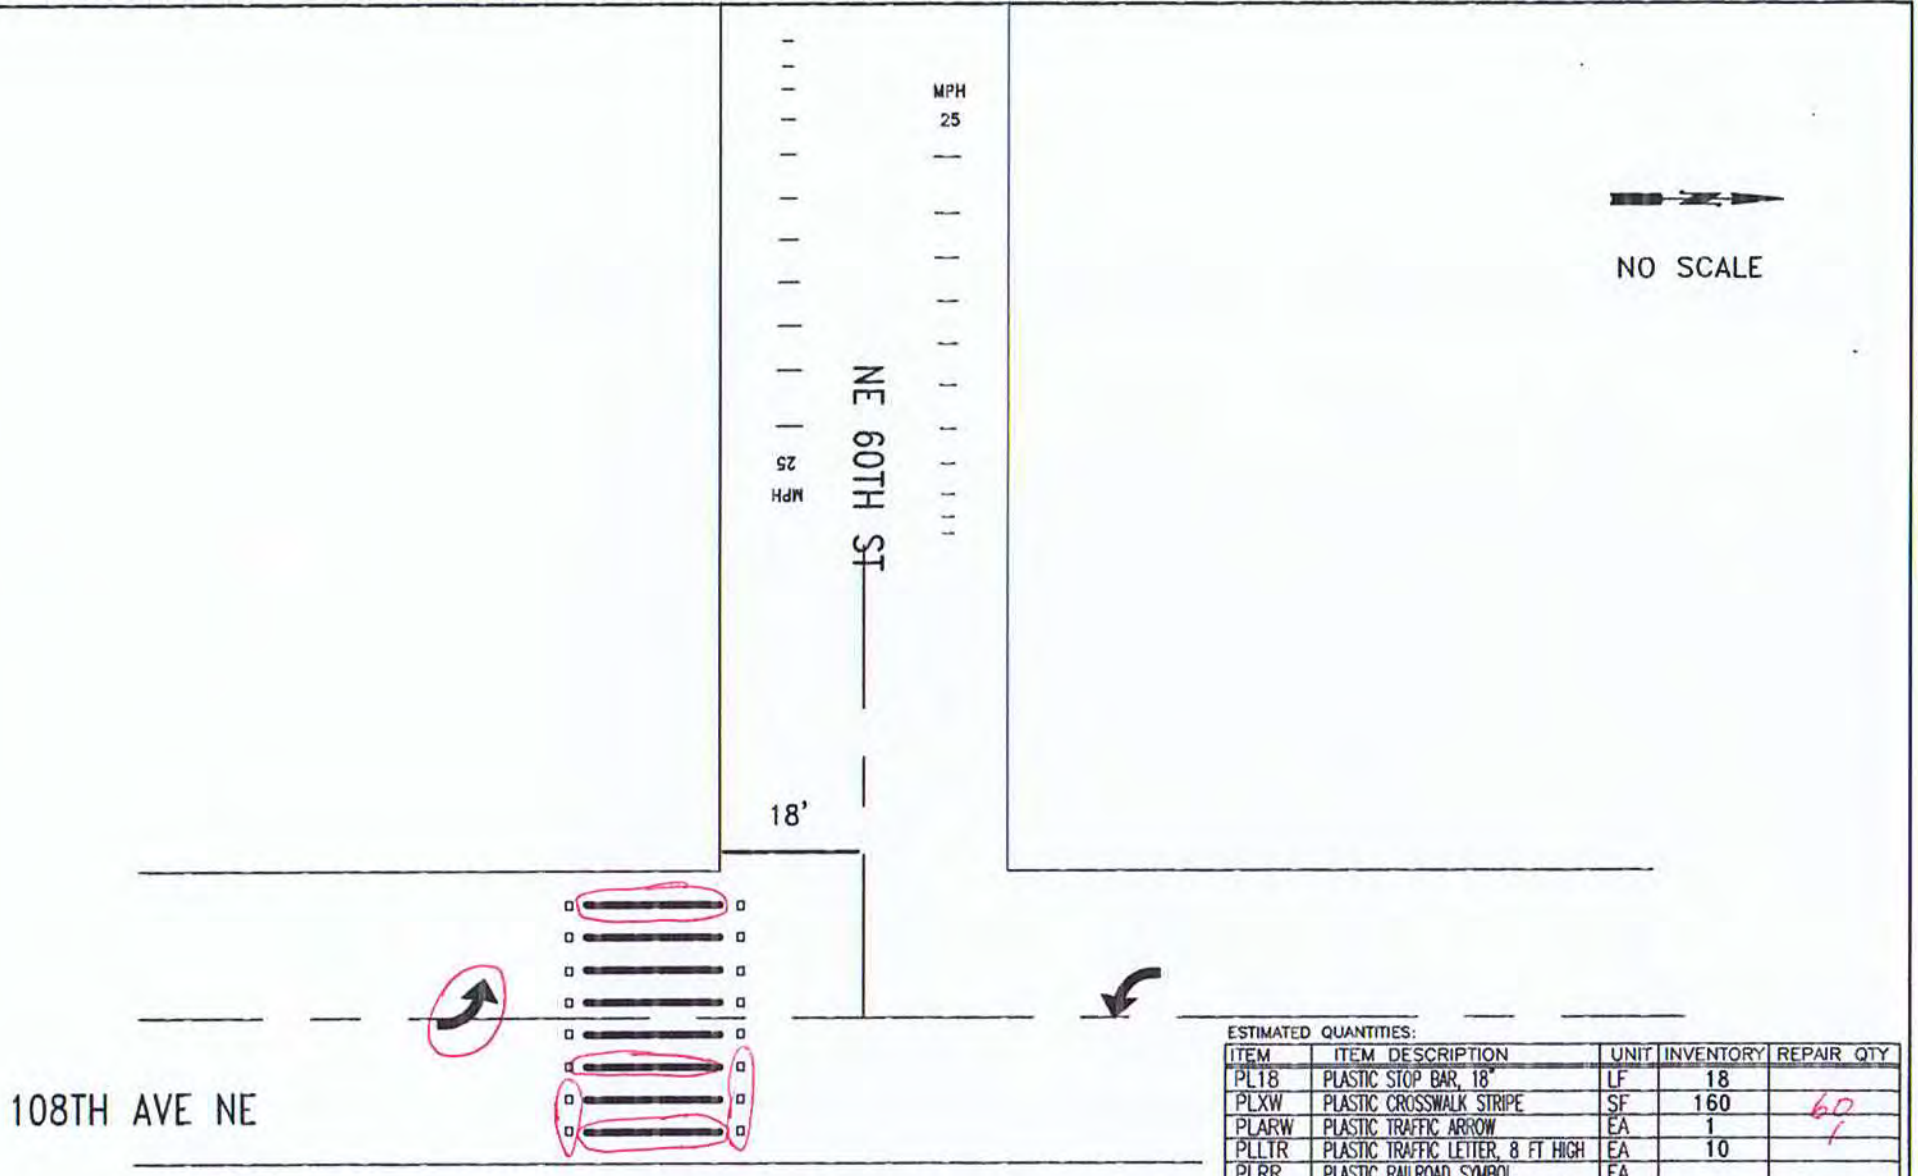

ESTIMATED QUANTITIES:

ITEM	ITEM DESCRIPTION	UNIT	INVENTORY	REPAIR QTY
PL18	PLASTIC STOP BAR, 18"	LF	18	
PLXW	PLASTIC CROSSWALK STRIPE	SF	160	60
PLARW	PLASTIC TRAFFIC ARROW	EA	1	1
PLLTR	PLASTIC TRAFFIC LETTER, 8 FT HIGH	EA	10	
PLRR	PLASTIC RAILROAD SYMBOL	EA		
RPLSYM	REMOVE PL. ARROW, LETTER, SYMBOL	EA		
RRPM	REMOVE RPM	EA		
RPLXW	REMOVE PLASTIC STRIPE	SF		40
	RAISED PAVEMENT MARKER TYPE 2	EA	16	8
	PLASTIC SPEED LEGEND BARS		124	

CITY OF KIRKLAND
DEPARTMENT OF PUBLIC WORKS
123 FIFTH AVENUE KIRKLAND, WA 98033
(425) 587-3800 www.kirklandwa.gov

D.GRILLEY 1/2000
DESIGNED BY: DATE

J.JENNINGS 2/2004
DRAWN BY: DATE

CHECKED BY: DATE

20~~20~~ PAVEMENT MARKING PROGRAM

STREET: 108TH AVE NE

CROSS STREET: NE 60TH ST

SEGMENT:

SCALE: N.T.S.

FILENAME: Page 14-8

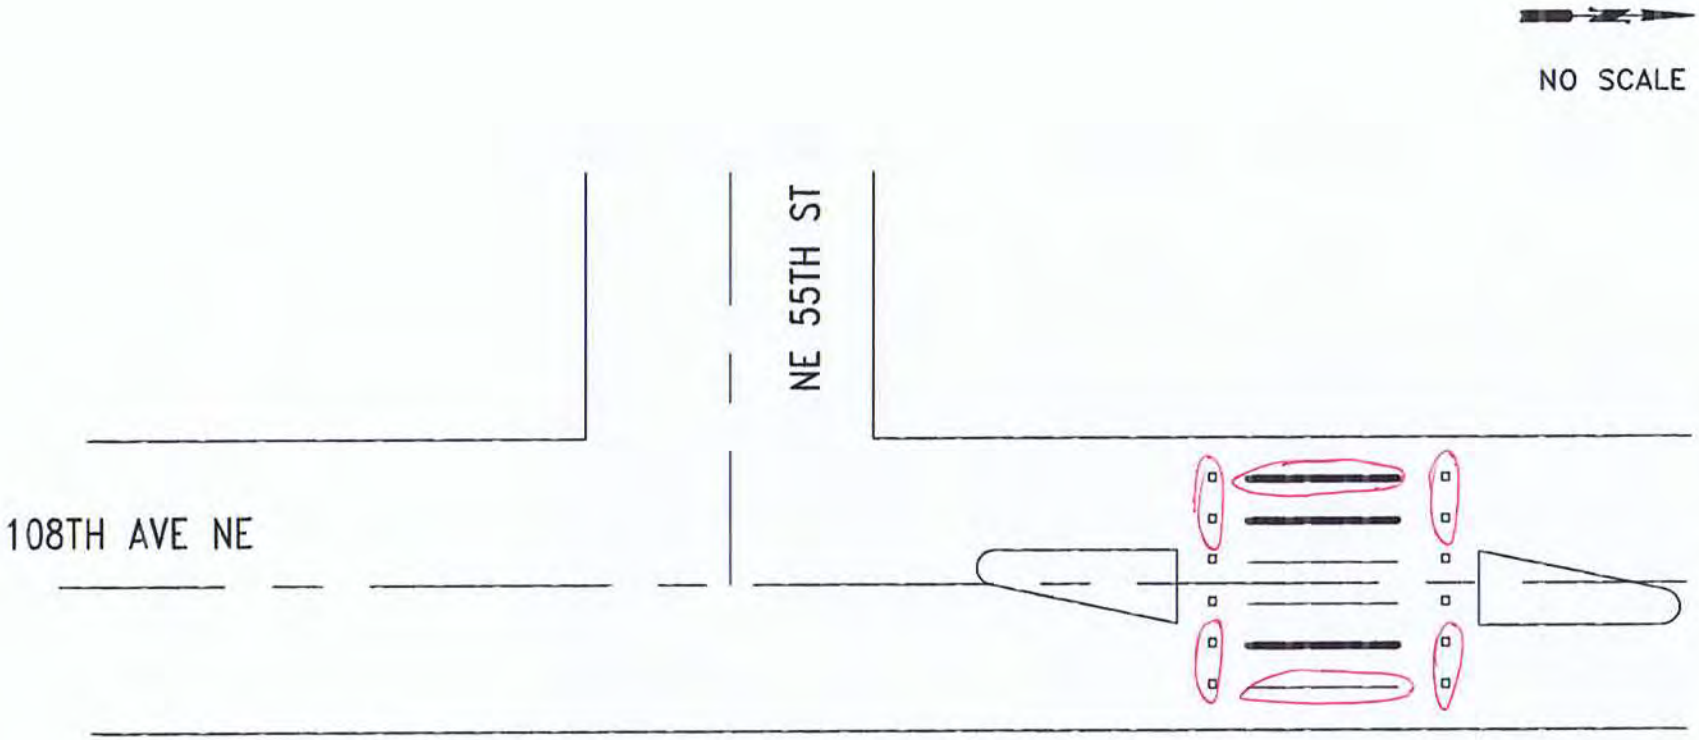

ESTIMATED QUANTITIES:

ITEM	ITEM DESCRIPTION	UNIT	INVENTORY	REPAIR QTY
PL18	PLASTIC STOP BAR, 18"	LF		
PLXW	PLASTIC CROSSWALK STRIPE	SF	100	30
PLARW	PLASTIC TRAFFIC ARROW	EA		
PLLTR	PLASTIC TRAFFIC LETTER, 8 FT HIGH	EA		
PLRR	PLASTIC RAILROAD SYMBOL	EA		
RPLSYM	REMOVE PL. ARROW, LETTER, SYMBOL	EA		
RRPM	REMOVE RPM	EA		3
RPLXW	REMOVE PLASTIC STRIPE	SF		30
RPM11	TYPE II RPM	EA	12	3

CITY OF KIRKLAND
DEPARTMENT OF PUBLIC WORKS
123 FIFTH AVENUE KIRKLAND, WA 98033
(425) 587-3800 www.kirklandwa.gov

D.GRILLEY 1/2000
DESIGNED BY: DATE

J.JENNINGS 1/2000
DRAWN BY: DATE

CHECKED BY: DATE

2020 PAVEMENT MARKING PROGRAM

STREET: 108TH AVE NE

CROSS STREET: X-WALK N OF NE 55TH ST

SEGMENT:

SCALE: N.T.S.

FILENAME: Page 14-9

NO SCALE

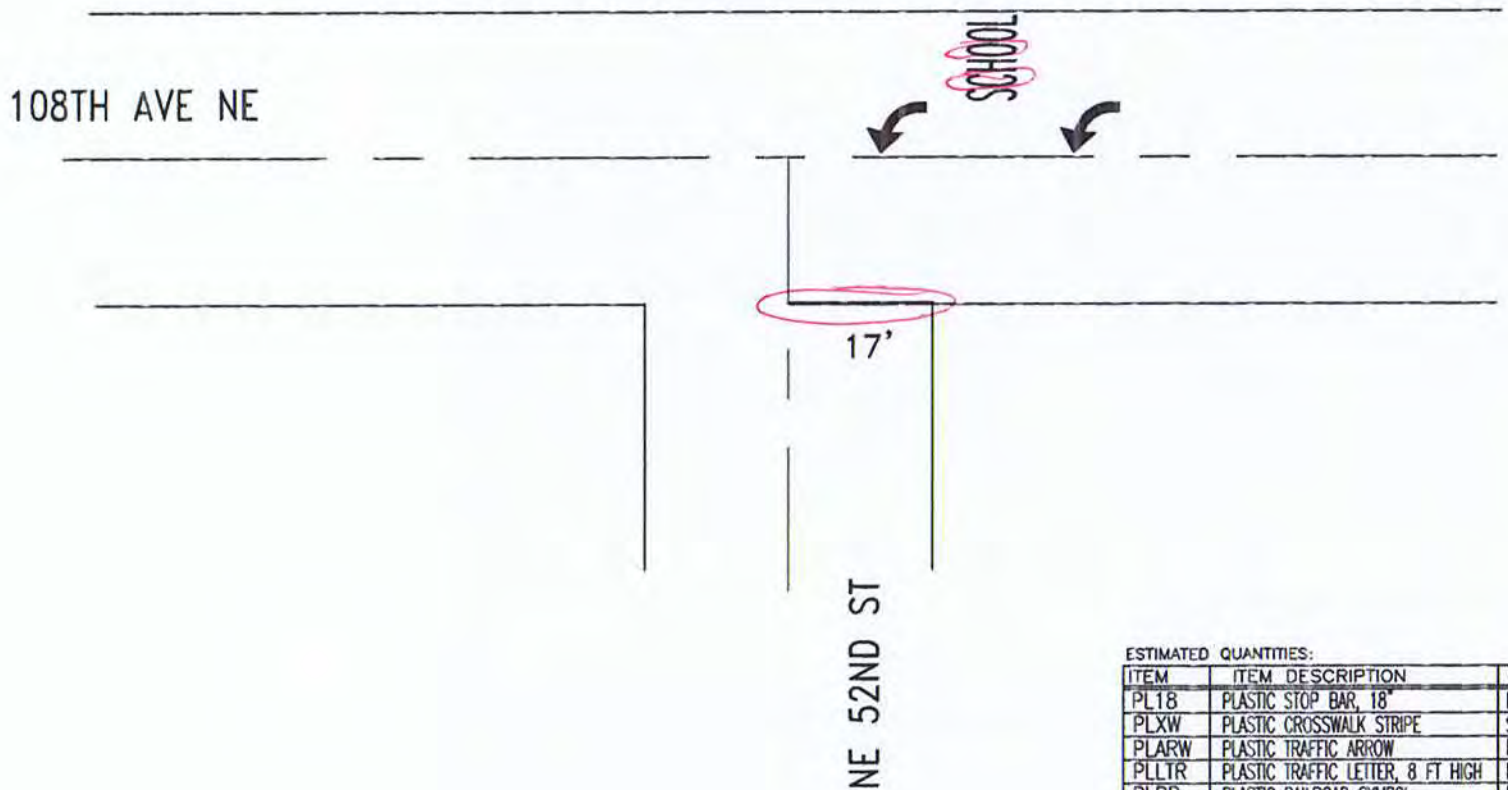

ESTIMATED QUANTITIES:

ITEM	ITEM DESCRIPTION	UNIT	INVENTORY	REPAIR QTY
PL18	PLASTIC STOP BAR, 18"	LF	17	17
PLXW	PLASTIC CROSSWALK STRIPE	SF		
PLARW	PLASTIC TRAFFIC ARROW	EA	2	
PLLTR	PLASTIC TRAFFIC LETTER, 8 FT HIGH	EA	6	2
PLRR	PLASTIC RAILROAD SYMBOL	EA		
RPLSYM	REMOVE PL. ARROW, LETTER, SYMBOL	EA		
RRPM	REMOVE RPM	EA		
RPLXW	REMOVE PLASTIC STRIPE	SF		

CITY OF KIRKLAND
DEPARTMENT OF PUBLIC WORKS
123 FIFTH AVENUE KIRKLAND, WA 98033
(425) 587-3800 www.kirklandwa.gov

S. GONSAR 11/2017
DESIGNED BY: DATE

J.JENNINGS 11/2017
DRAWN BY: DATE

CHECKED BY: DATE

20__ PAVEMENT MARKING PROGRAM

STREET: 108TH AVE NE

CROSS STREET: NE 52ND ST

SEGMENT:

SCALE: N.T.S.

FILENAME: Page 14-10

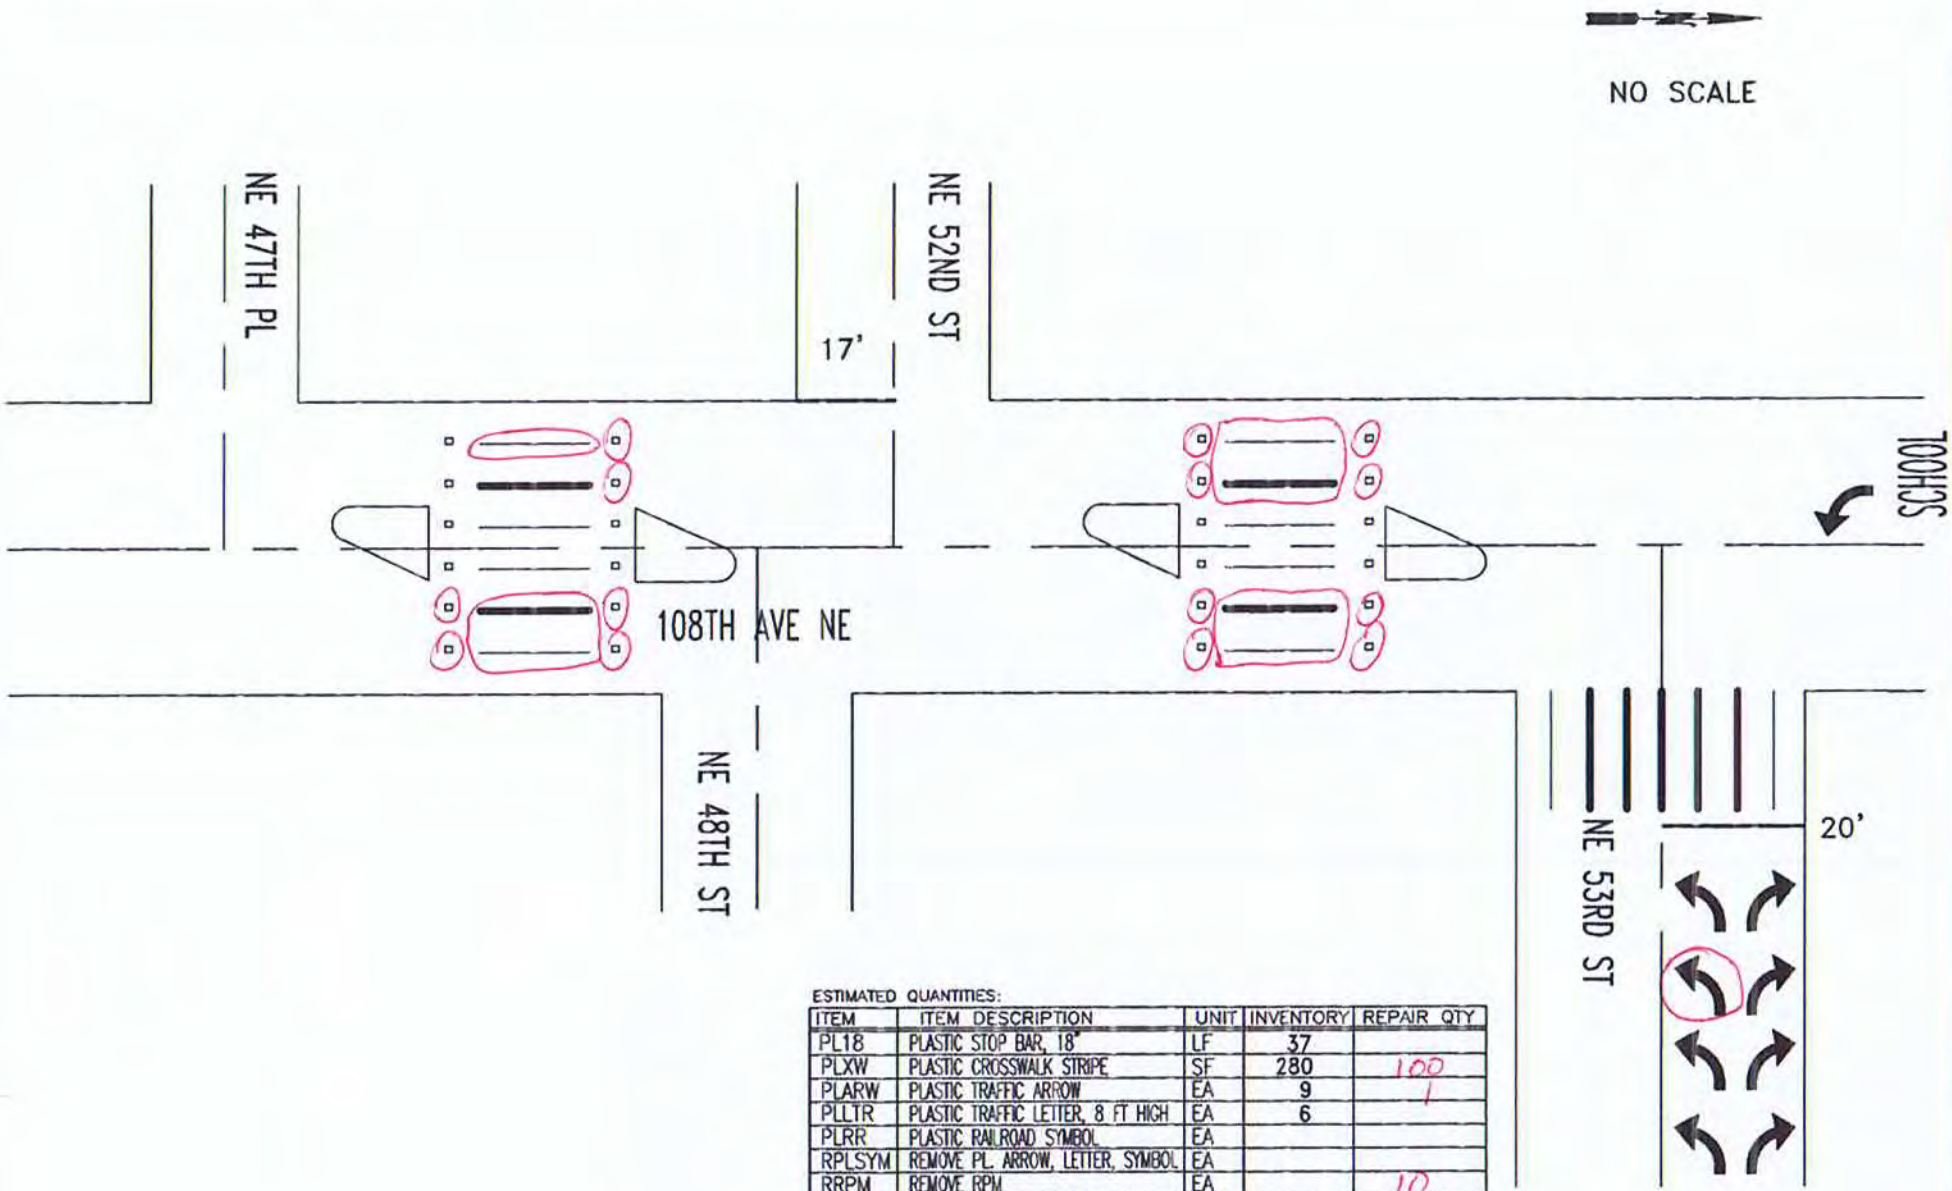

ESTIMATED QUANTITIES:

ITEM	ITEM DESCRIPTION	UNIT	INVENTORY	REPAIR QTY
PL18	PLASTIC STOP BAR, 18"	LF	37	
PLXW	PLASTIC CROSSWALK STRIPE	SF	280	100
PLARW	PLASTIC TRAFFIC ARROW	EA	9	1
PLLTR	PLASTIC TRAFFIC LETTER, 8 FT HIGH	EA	6	
PLRR	PLASTIC RAILROAD SYMBOL	EA		
RPLSYM	REMOVE PL. ARROW, LETTER, SYMBOL	EA		
RRPM	REMOVE RPM	EA		10
RPLXW	REMOVE PLASTIC STRIPE	SF		
RPM11	TYPE II RPM	EA	24	14

CITY OF KIRKLAND
DEPARTMENT OF PUBLIC WORKS
123 FIFTH AVENUE KIRKLAND, WA 98033
(425) 587-3800 www.kirklandwa.gov

D.GRILLEY 4/2007
DESIGNED BY: DATE

J.JENNINGS 4/2007
DRAWN BY: DATE

CHECKED BY: DATE

2022 PAVEMENT MARKING PROGRAM

STREET: 108TH AVE NE

CROSS STREET: NE 53RD ST TO NE 46TH ST

SEGMENT:

SCALE: N.T.S.

FILENAME:

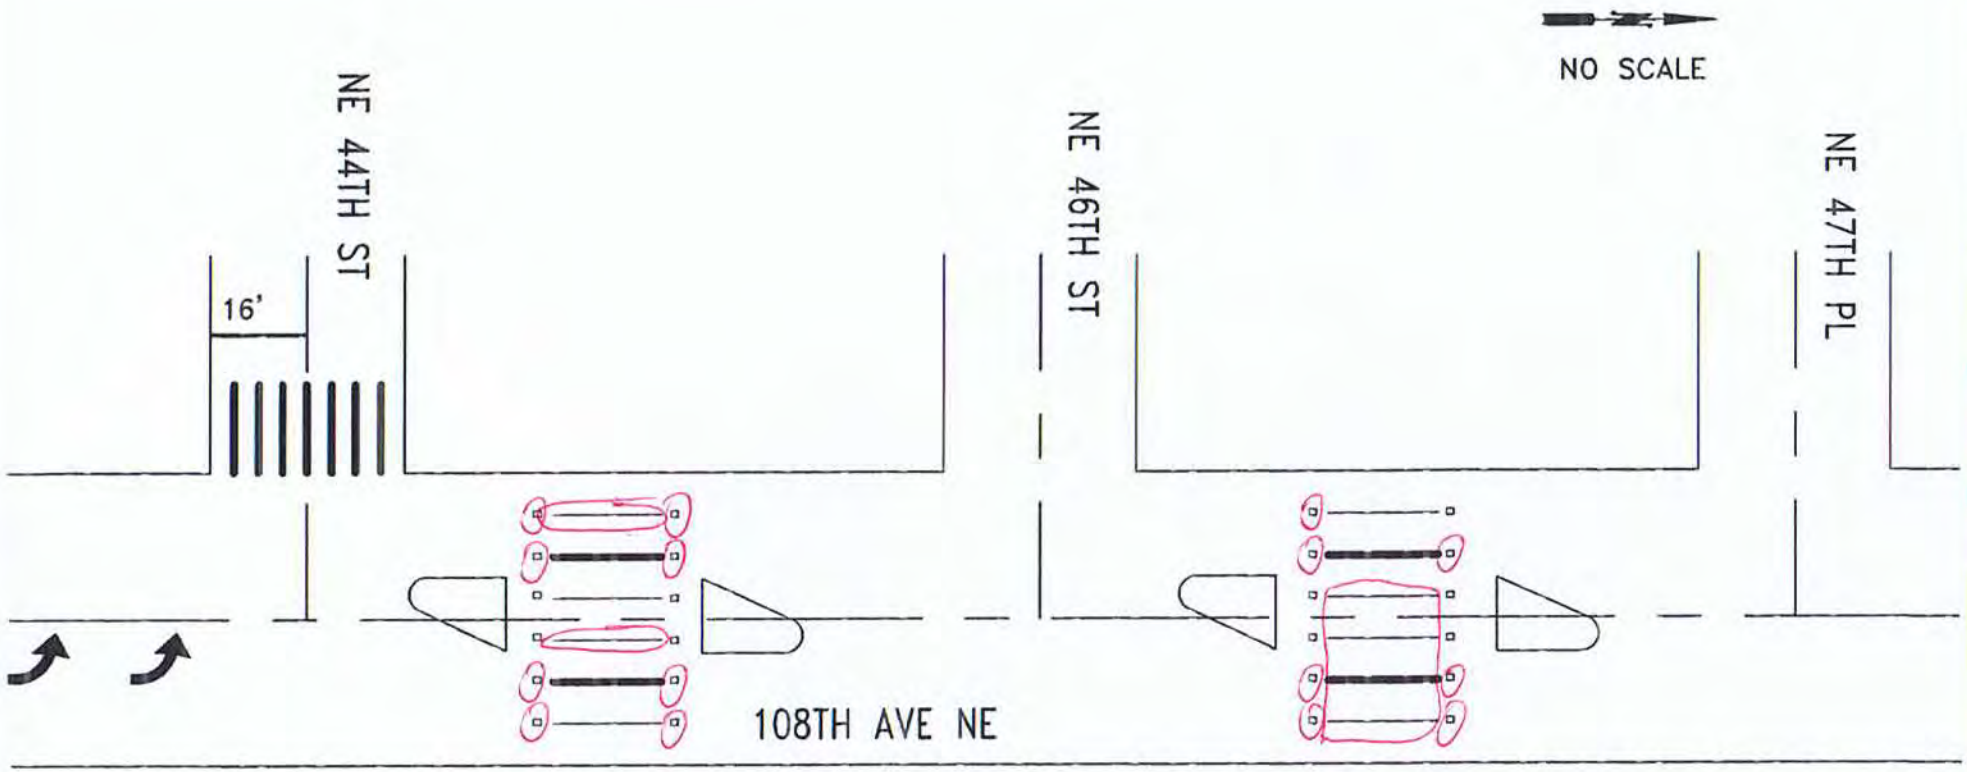

ESTIMATED QUANTITIES:

ITEM	ITEM DESCRIPTION	UNIT	INVENTORY	REPAIR QTY
PL18	PLASTIC STOP BAR, 18"	LF	16	
PLXW	PLASTIC CROSSWALK STRIPE	SF	300	70
PLARW	PLASTIC TRAFFIC ARROW	EA	2	
PLLTR	PLASTIC TRAFFIC LETTER, 8 FT HIGH	EA		
PLRR	PLASTIC RAILROAD SYMBOL	EA		
RPLSYM	REMOVE PL. ARROW, LETTER, SYMBOL	EA		
RRPM	REMOVE RPM	EA		7
RPLXW	REMOVE PLASTIC STRIPE	SF		
RPM11	TYPE II RPM	EA	24	15

CITY OF KIRKLAND
DEPARTMENT OF PUBLIC WORKS
123 FIFTH AVENUE KIRKLAND, WA 98033
(425) 587-3800 www.kirklandwa.gov

G. HORTILLOSA 2/2011
DESIGNED BY: DATE

J.JENNINGS 10/2011
DRAWN BY: DATE

CHECKED BY: DATE

2020 PAVEMENT MARKING PROGRAM

STREET: 108TH AVE NE

CROSS STREET: NE 47TH TO NE 44TH ST

SEGMENT:

SCALE: N.T.S.

FILENAME: Page 14-12

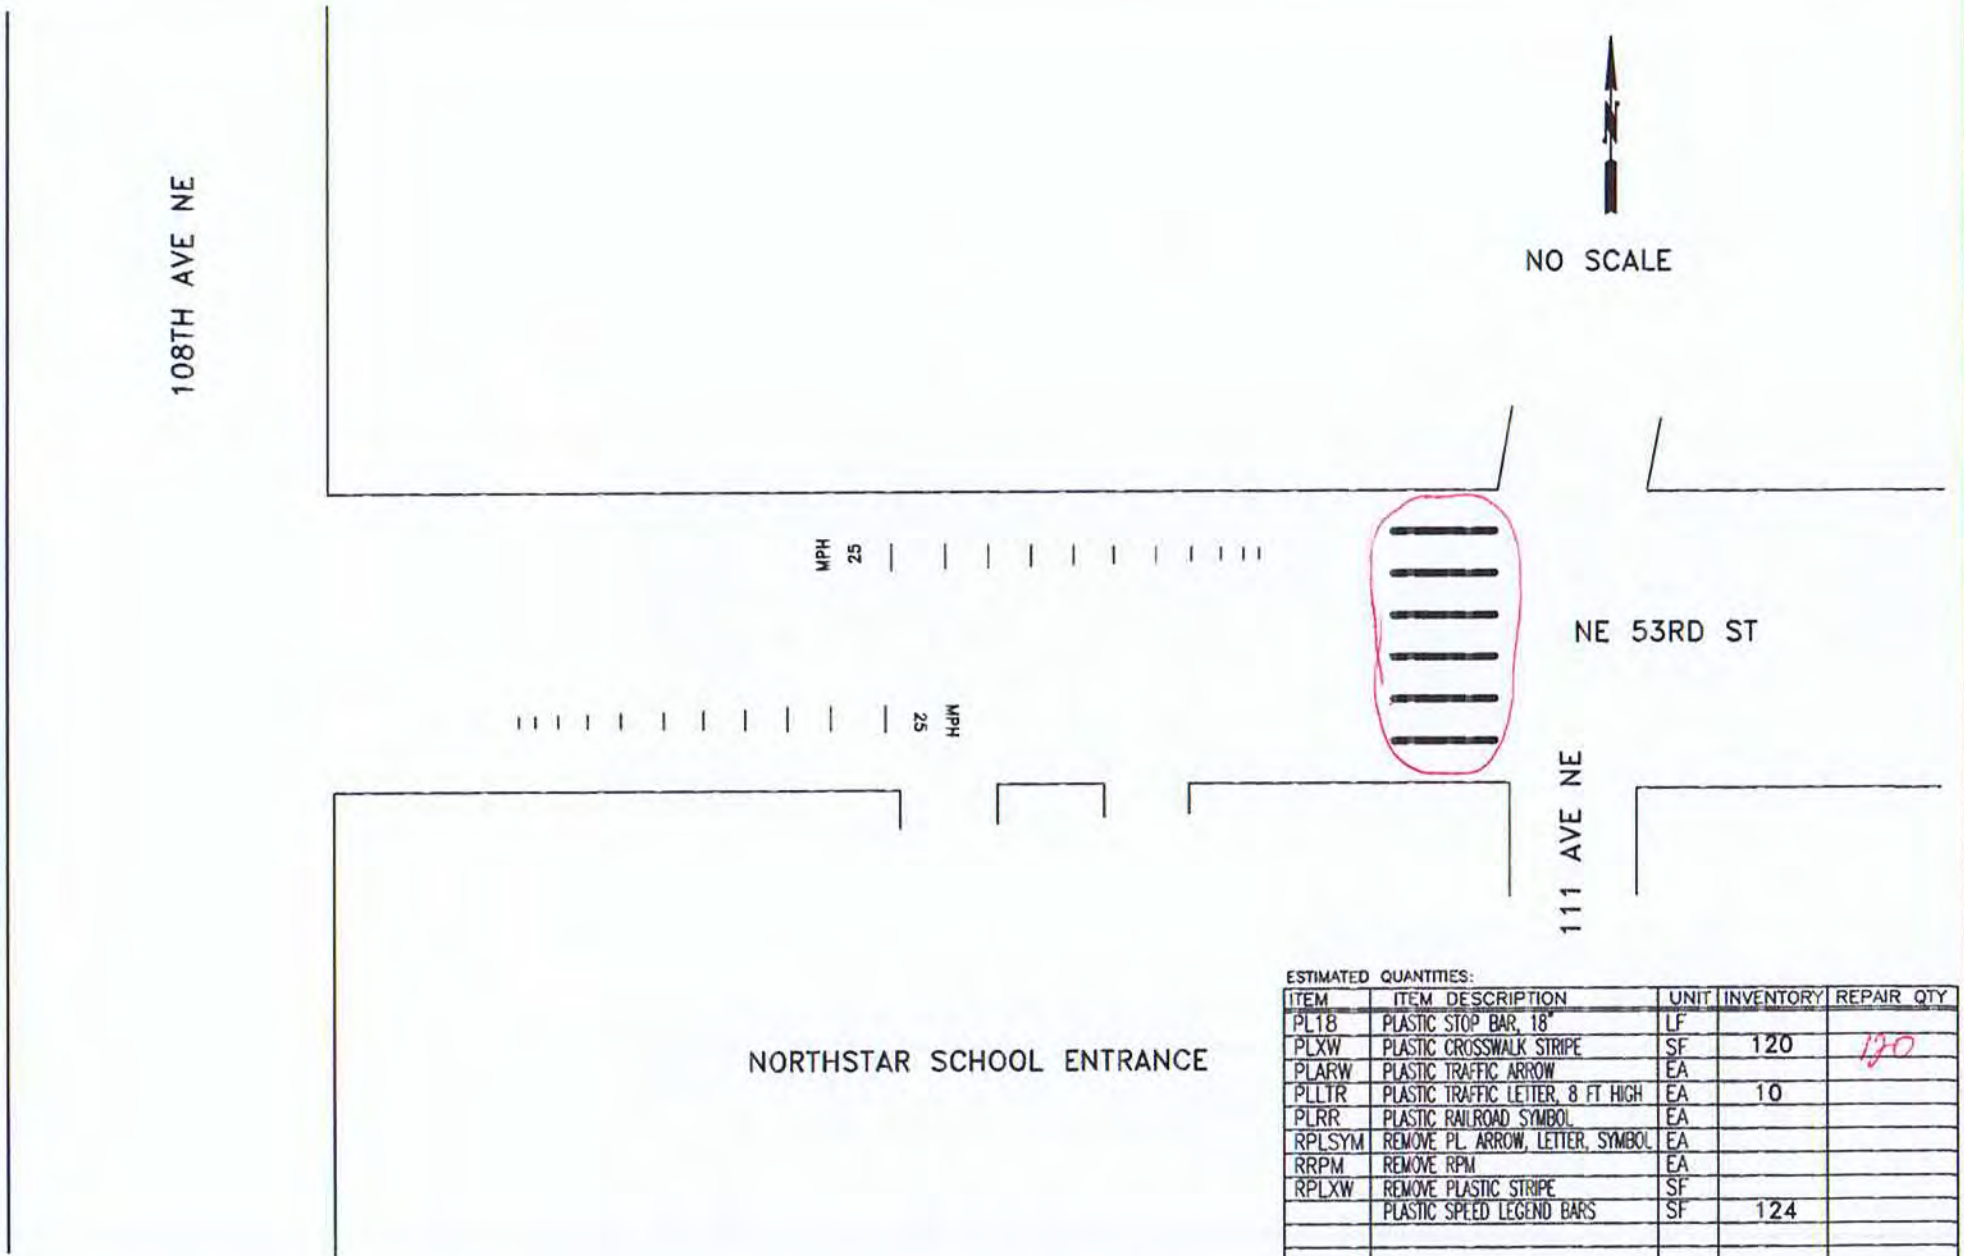

ESTIMATED QUANTITIES:

ITEM	ITEM DESCRIPTION	UNIT	INVENTORY	REPAIR QTY
PL18	PLASTIC STOP BAR, 18"	LF		
PLXW	PLASTIC CROSSWALK STRIPE	SF	120	120
PLARW	PLASTIC TRAFFIC ARROW	EA		
PLLTR	PLASTIC TRAFFIC LETTER, 8 FT HIGH	EA	10	
PLRR	PLASTIC RAILROAD SYMBOL	EA		
RPLSYM	REMOVE PL. ARROW, LETTER, SYMBOL	EA		
RRPM	REMOVE RPM	EA		
RPLXW	REMOVE PLASTIC STRIPE	SF		
	PLASTIC SPEED LEGEND BARS	SF	124	

CITY OF KIRKLAND
DEPARTMENT OF PUBLIC WORKS
123 FIFTH AVENUE KIRKLAND, WA 98033
(425) 587-3800 www.kirklandwa.gov

G. HORTILLOSA 5/2007
DESIGNED BY: DATE

J.JENNINGS 5/2007
DRAWN BY: DATE

CHECKED BY: DATE

2020 PAVEMENT MARKING PROGRAM

STREET: NE 53RD ST

CROSS STREET: 108–111 AVE NE

SEGMENT:

SCALE: N.T.S.

FILENAME: page 14–13

NO SCALE

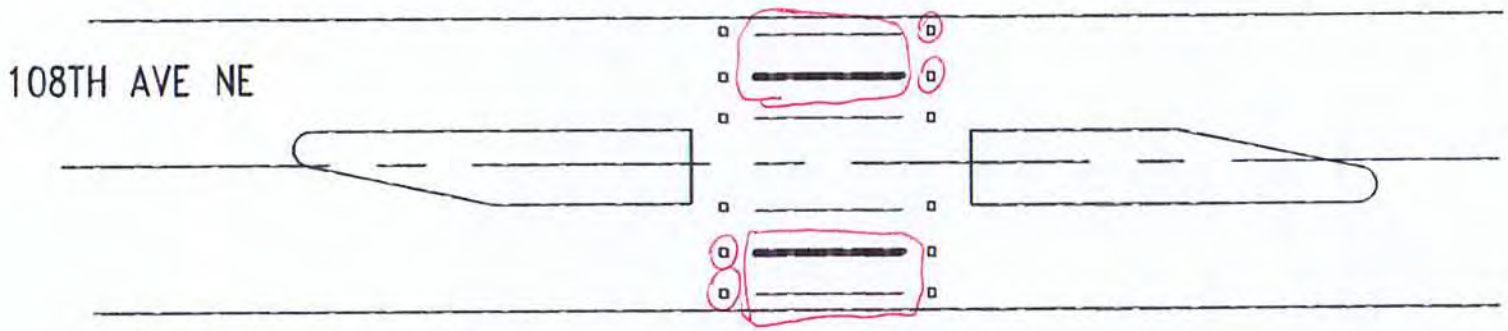

ESTIMATED QUANTITIES:

ITEM	ITEM DESCRIPTION	UNIT	INVENTORY	REPAIR QTY
PL18	PLASTIC STOP BAR, 18"	LF		
PLXW	PLASTIC CROSSWALK STRIPE	SF	100	60
PLARW	PLASTIC TRAFFIC ARROW	EA		
PLLTR	PLASTIC TRAFFIC LETTER, 8 FT HIGH	EA		
PLRR	PLASTIC RAILROAD SYMBOL	EA		
RPLSYM	REMOVE PL. ARROW, LETTER, SYMBOL	EA		
RRPM	REMOVE RPM	EA		4
RPLXW	REMOVE PLASTIC STRIPE	SF		
RPM11	TYPE II RPM	EA	12	4

CITY OF KIRKLAND
DEPARTMENT OF PUBLIC WORKS
123 FIFTH AVENUE KIRKLAND, WA 98033
(425) 587-3800 www.kirklandwa.gov

D.GRILLEY 1/2000
DESIGNED BY: DATE

J.JENNINGS 1/2000
DRAWN BY: DATE

CHECKED BY: DATE

2020 PAVEMENT MARKING PROGRAM

STREET: 108TH AVE NE

CROSS STREET: 44TH - 41ST CROSSWALK

SEGMENT:

SCALE: N.T.S.

FILENAME: Page 14-15

APPENDIX C

SCHEDULE C – PLAN SHEETS

NORTH JUANITA INTERSECTION PLANS

CITY OF KIRKLAND
DEPARTMENT OF PUBLIC WORKS
123 FIFTH AVENUE KIRKLAND, WA 98033
(425) 587-3800 www.kirklandwa.gov

S GONSAR 1/2019	2020 PAVEMENT MARKING PROGRAM	SEGMENT:
DESIGNED BY: DATE	STREET:	SCALE: N.T.S.
J.JENNINGS 1/2019		
DRAWN BY: DATE	CROSS STREET:	FILENAME: 2-0
CHECKED BY: DATE		

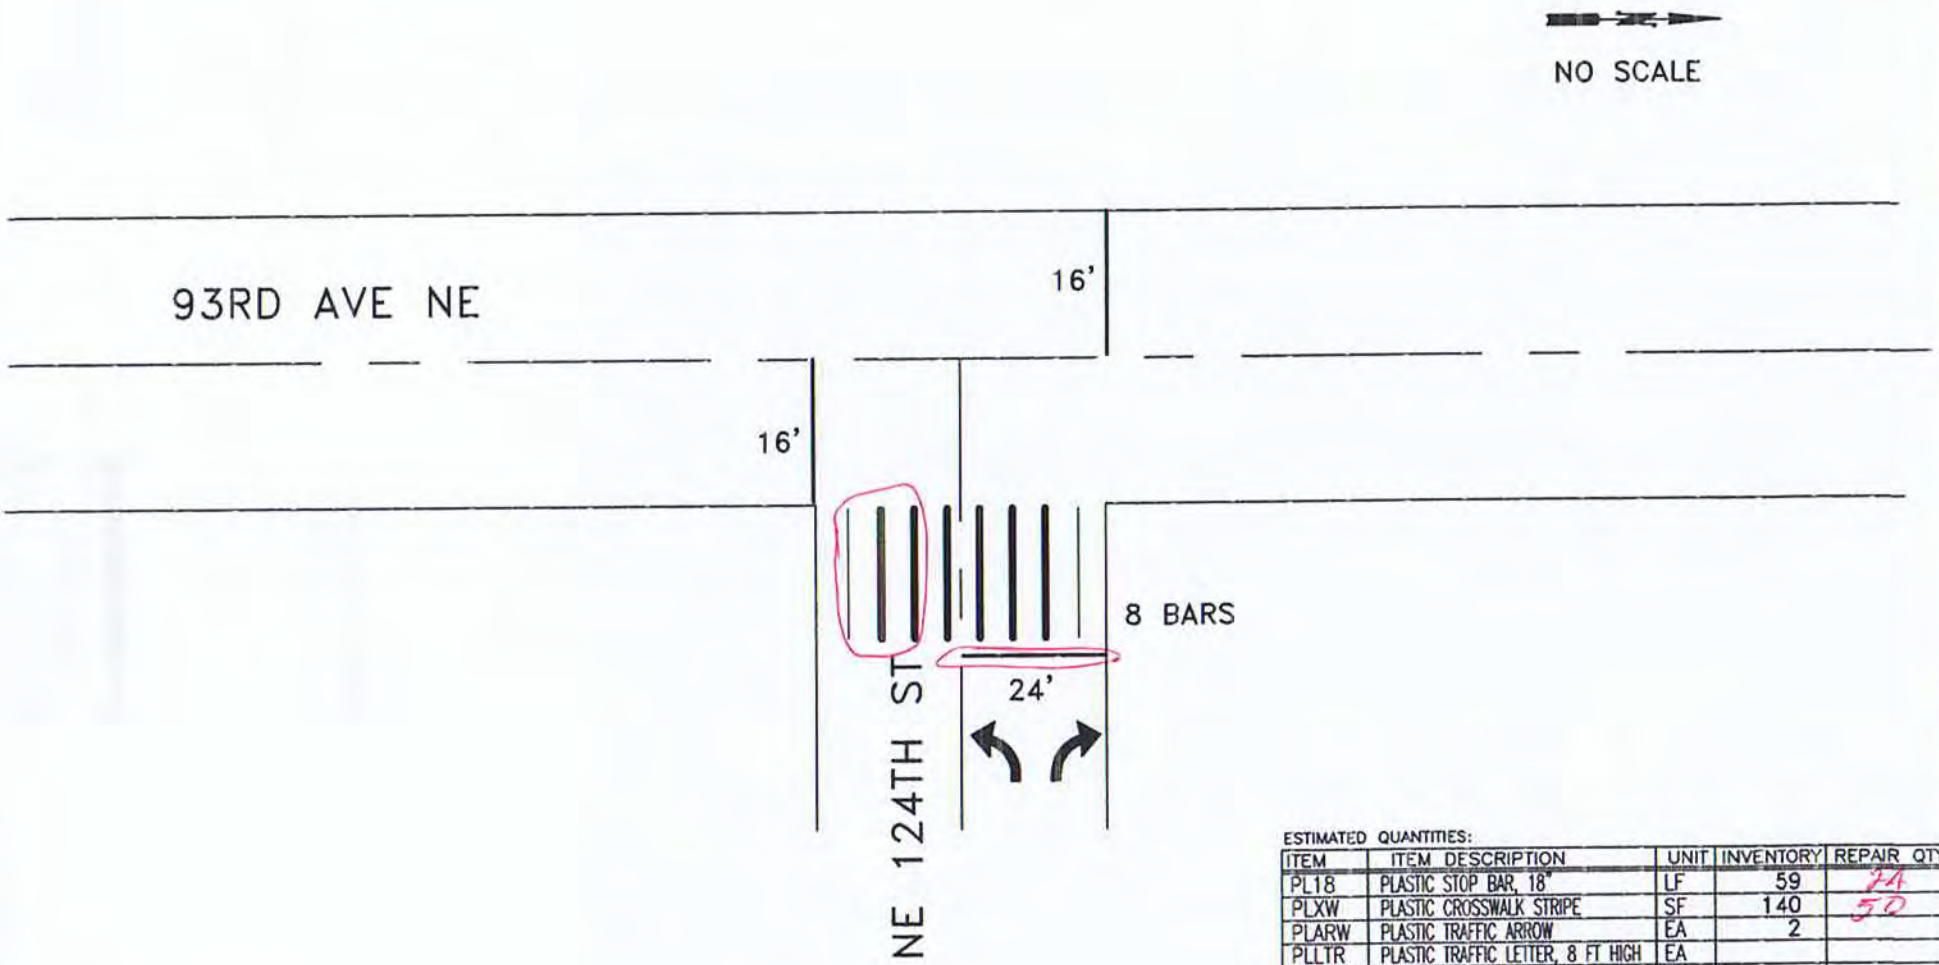

ESTIMATED QUANTITIES:

ITEM	ITEM DESCRIPTION	UNIT	INVENTORY	REPAIR QTY
PL18	PLASTIC STOP BAR, 18"	LF	59	24
PLXW	PLASTIC CROSSWALK STRIPE	SF	140	50
PLARW	PLASTIC TRAFFIC ARROW	EA	2	
PLLTR	PLASTIC TRAFFIC LETTER, 8 FT HIGH	EA		
PLRR	PLASTIC RAILROAD SYMBOL	EA		
RPLSYM	REMOVE PL. ARROW, LETTER, SYMBOL	EA		
RRPM	REMOVE RPM	EA		
RPLXW	REMOVE PLASTIC STRIPE	SF		

CITY OF KIRKLAND
DEPARTMENT OF PUBLIC WORKS
123 FIFTH AVENUE KIRKLAND, WA 98033
(425) 587-3800 www.kirklandwa.gov

G. HORTILLOSA 10/2012
DESIGNED BY: DATE

J.JENNINGS 10/2012
DRAWN BY: DATE

CHECKED BY: DATE

2020 PAVEMENT MARKING PROGRAM

STREET: NE 124TH ST

CROSS STREET: 93RD AVE NE

SEGMENT:

SCALE: N.T.S.

FILENAME: Page 2-1

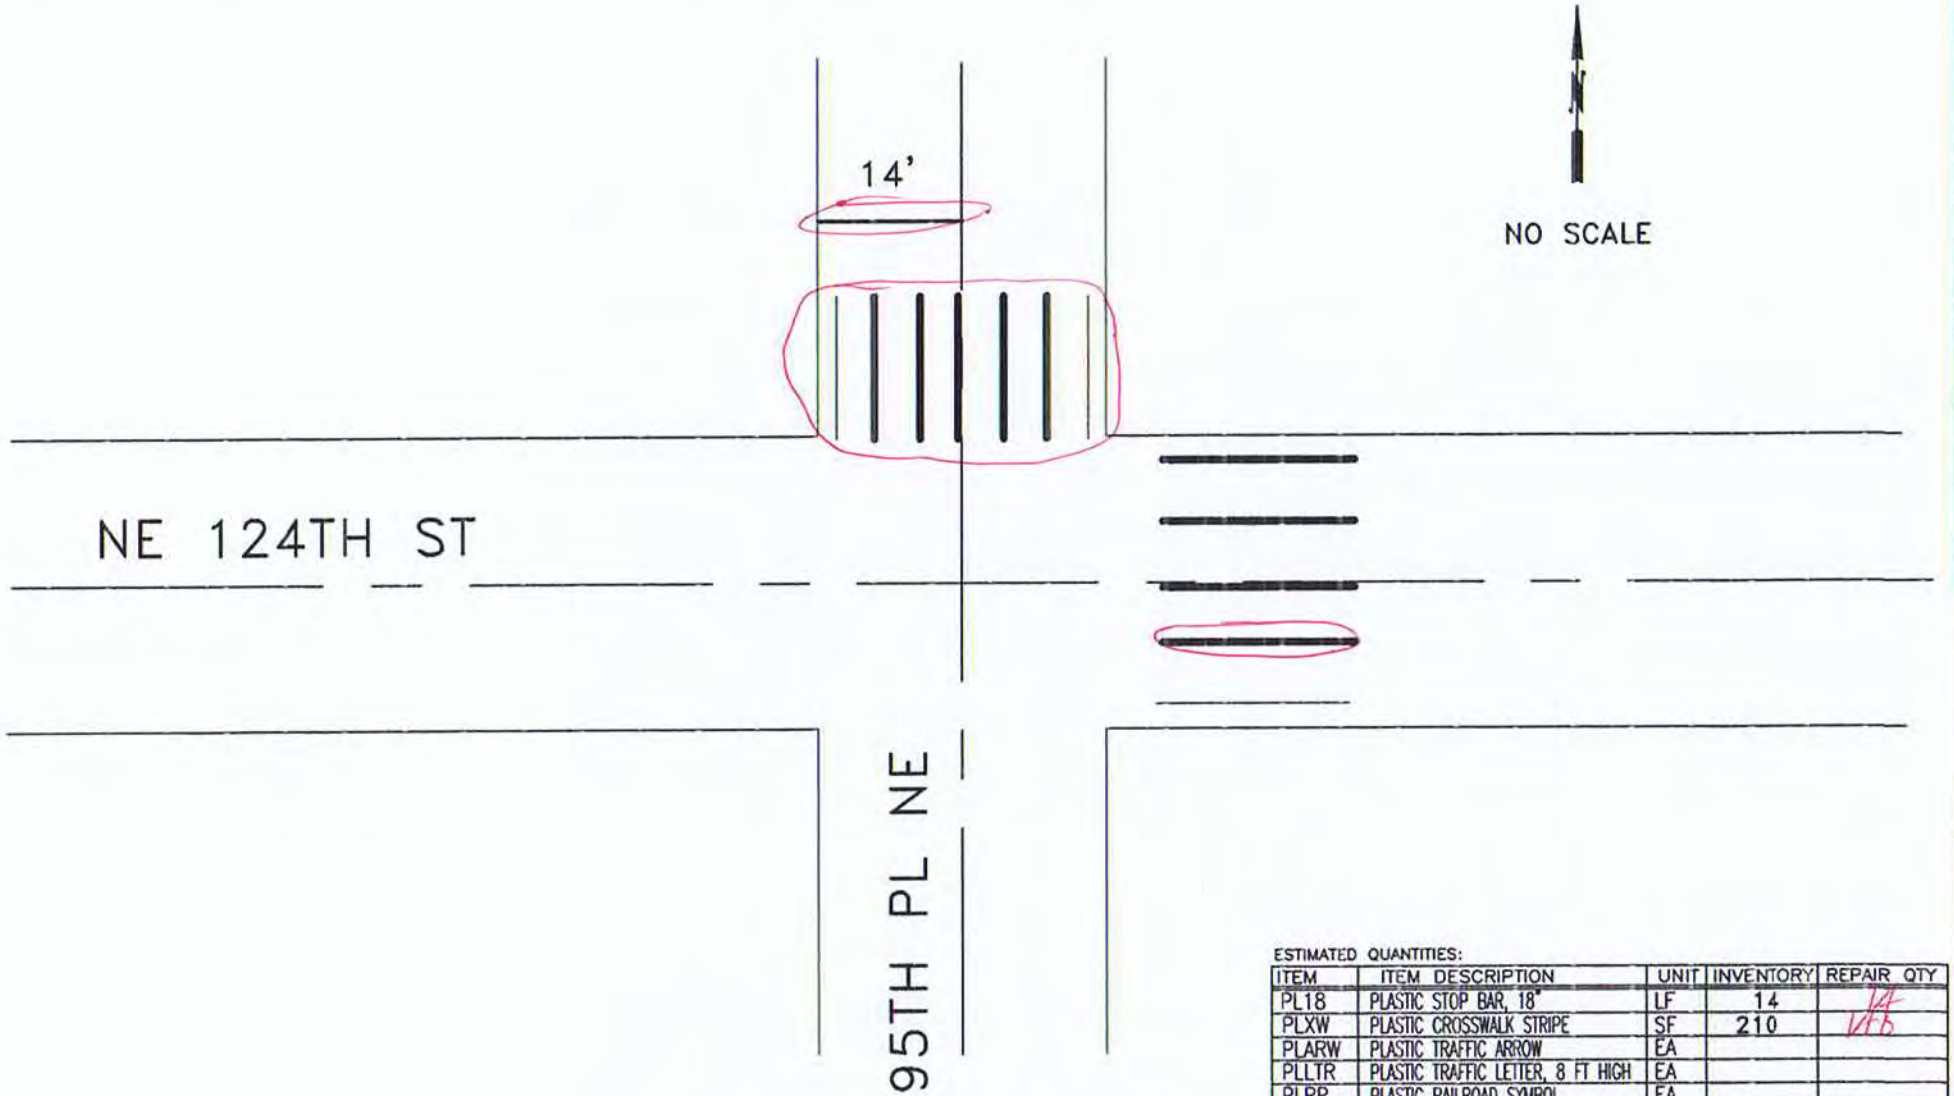

ESTIMATED QUANTITIES:

ITEM	ITEM DESCRIPTION	UNIT	INVENTORY	REPAIR QTY
PL18	PLASTIC STOP BAR, 18"	LF	14	14
PLXW	PLASTIC CROSSWALK STRIPE	SF	210	176
PLARW	PLASTIC TRAFFIC ARROW	EA		
PLLTR	PLASTIC TRAFFIC LETTER, 8 FT HIGH	EA		
PLRR	PLASTIC RAILROAD SYMBOL	EA		
RPLSYM	REMOVE PL. ARROW, LETTER, SYMBOL	EA		
RRPM	REMOVE RPM	EA		
RPLXW	REMOVE PLASTIC STRIPE	SF		140

CITY OF KIRKLAND WASHINGTON

CITY OF KIRKLAND
DEPARTMENT OF PUBLIC WORKS
123 FIFTH AVENUE KIRKLAND, WA 98033
(425) 587-3800 www.kirklandwa.gov

G. HORTILLOSA 10/2012
DESIGNED BY: DATE

J.JENNINGS 10/2012
DRAWN BY: DATE

CHECKED BY: DATE

2020 PAVEMENT MARKING PROGRAM

STREET: NE 124TH ST

CROSS STREET: 95TH PL NE

SEGMENT: 3040-#150

SCALE: N.T.S.

FILENAME: Page 2-2

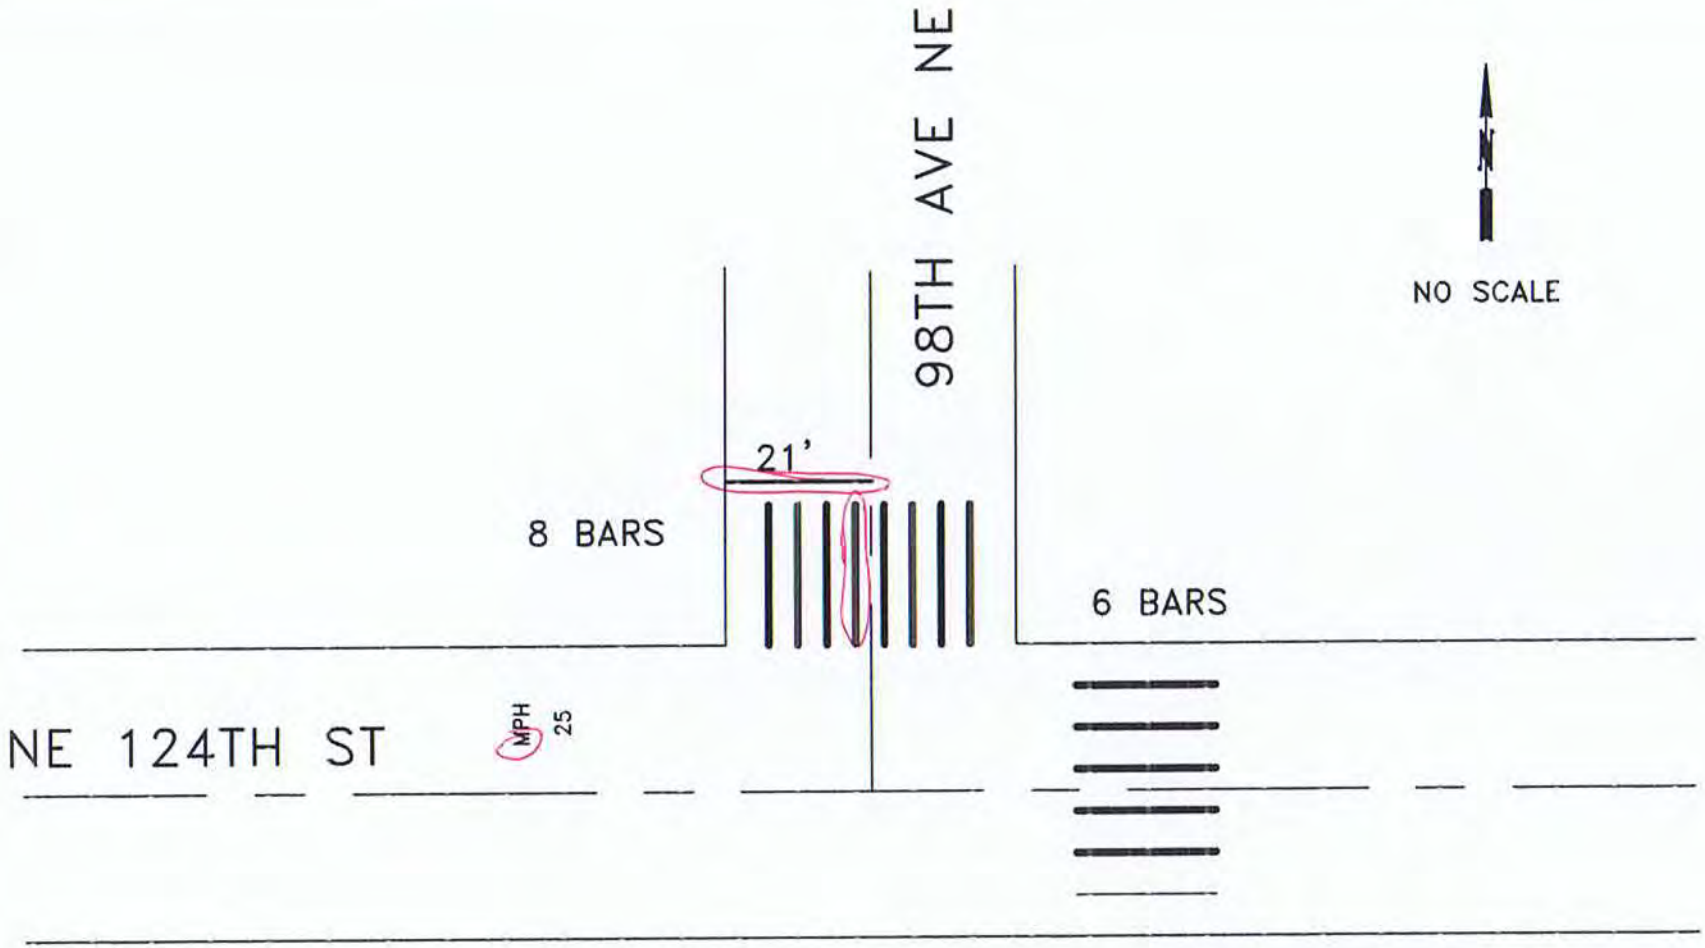

ESTIMATED QUANTITIES:

ITEM	ITEM DESCRIPTION	UNIT	INVENTORY	REPAIR QTY
PL18	PLASTIC STOP BAR, 18"	LF	16	21
PLXW	PLASTIC CROSSWALK STRIPE	SF	260	20
PLARW	PLASTIC TRAFFIC ARROW	EA		
PLLTR	PLASTIC TRAFFIC LETTER, 8 FT HIGH	EA	5	1
PLRR	PLASTIC RAILROAD SYMBOL	EA		
RPLSYM	REMOVE PL. ARROW, LETTER, SYMBOL	EA		
RRPM	REMOVE RPM	EA		
RPLXW	REMOVE PLASTIC STRIPE	SF		

CITY OF KIRKLAND WASHINGTON

CITY OF KIRKLAND
DEPARTMENT OF PUBLIC WORKS
123 FIFTH AVENUE KIRKLAND, WA 98033
(425) 587-3800 www.kirklandwa.gov

G. HORTILLOSA 10/2012
DESIGNED BY: DATE

J.JENNINGS 10/2012
DRAWN BY: DATE

CHECKED BY: DATE

2022 PAVEMENT MARKING PROGRAM

STREET: NE 124TH ST

CROSS STREET: 98TH AVE NE

SEGMENT: 3040-#130

SCALE: N.T.S.

FILENAME: Page 2-3

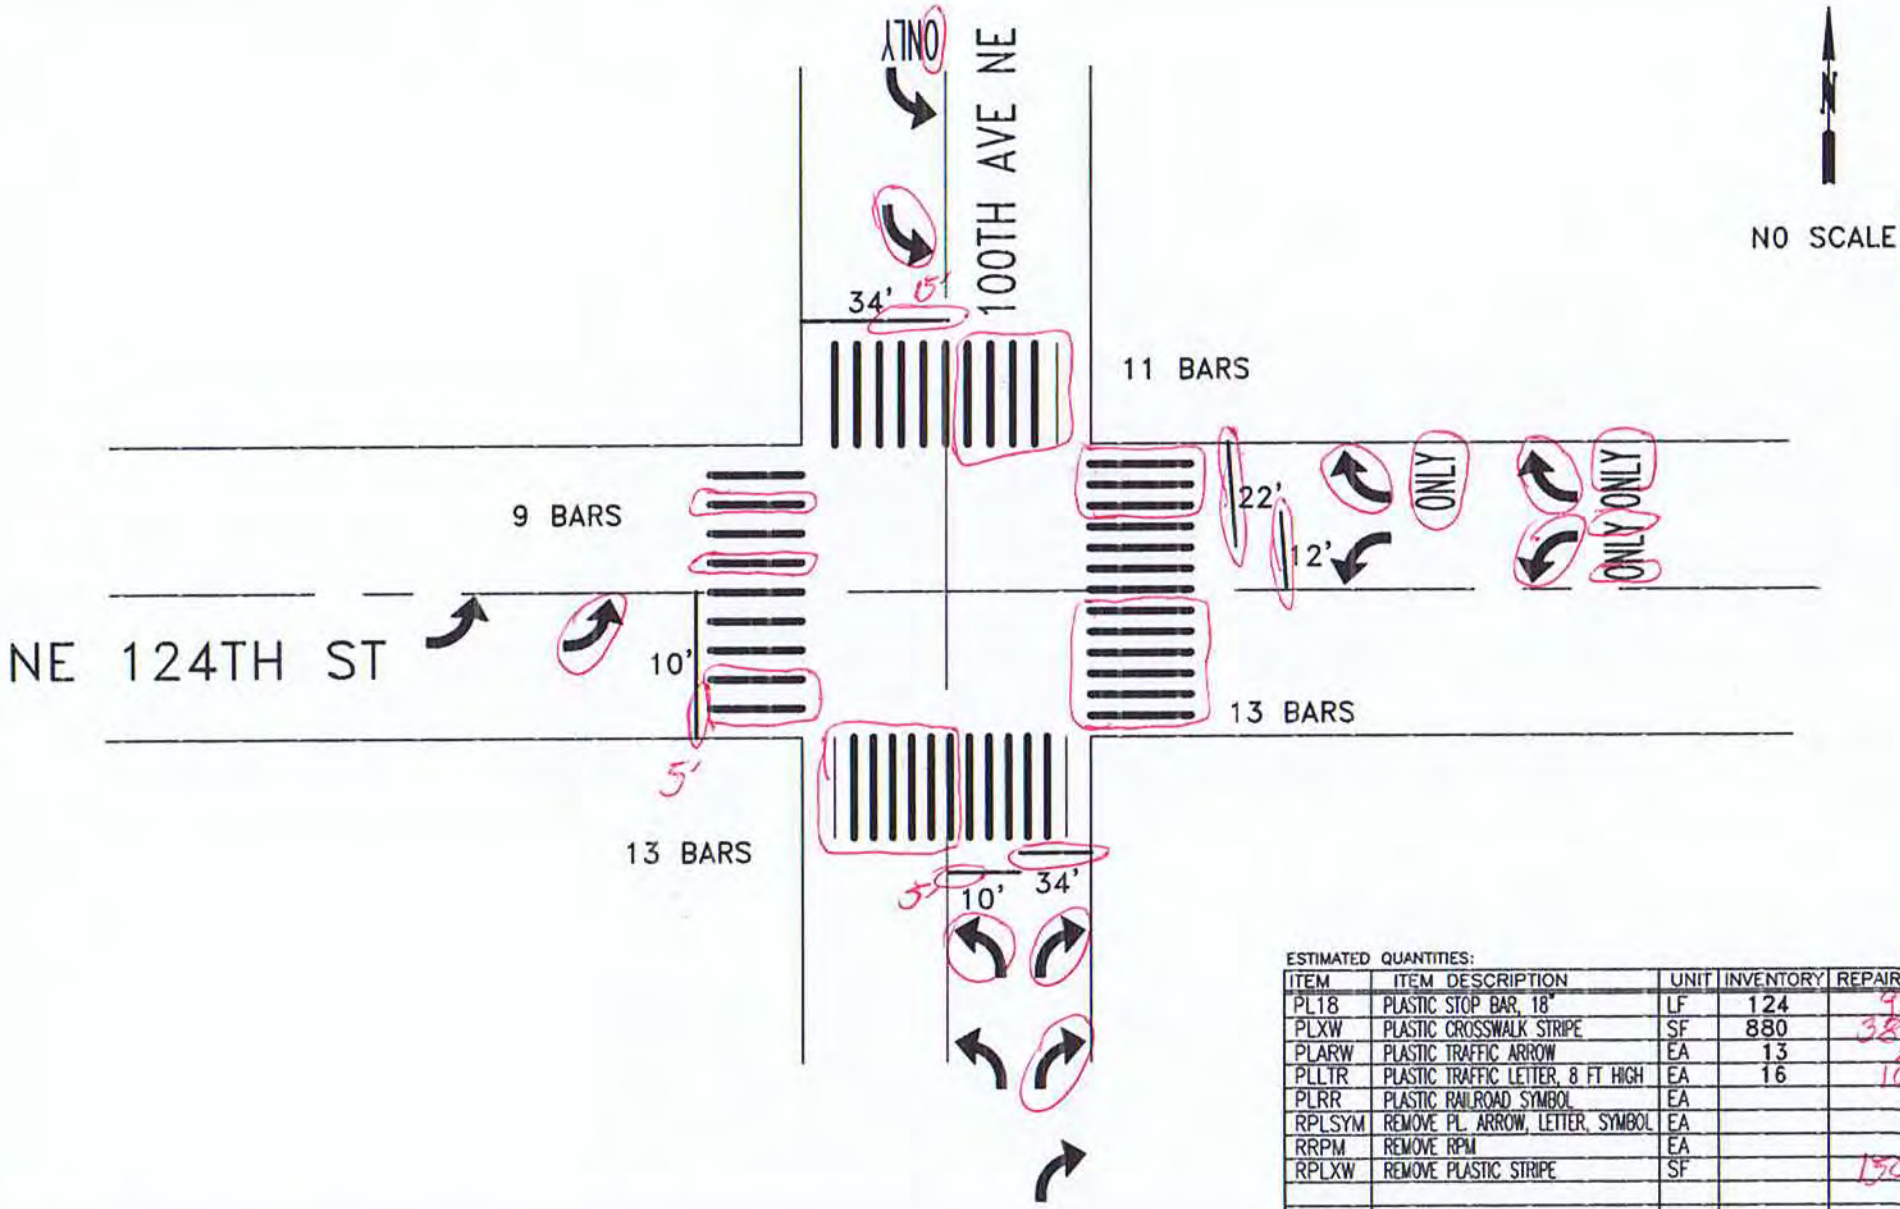

ESTIMATED QUANTITIES:

ITEM	ITEM DESCRIPTION	UNIT	INVENTORY	REPAIR QTY
PL18	PLASTIC STOP BAR, 18"	LF	124	93
PLXW	PLASTIC CROSSWALK STRIPE	SF	880	320
PLARW	PLASTIC TRAFFIC ARROW	EA	13	8
PLLTR	PLASTIC TRAFFIC LETTER, 8 FT HIGH	EA	16	10
PLRR	PLASTIC RAILROAD SYMBOL	EA		
RPLSYM	REMOVE PL. ARROW, LETTER, SYMBOL	EA		
RRPM	REMOVE RPM	EA		
RPLXW	REMOVE PLASTIC STRIPE	SF		150

CITY OF KIRKLAND
DEPARTMENT OF PUBLIC WORKS
123 FIFTH AVENUE KIRKLAND, WA 98033
(425) 587-3800 www.kirklandwa.gov

D.GRILLEY 1/2000
DESIGNED BY: DATE

J.JENNINGS 10/2009
DRAWN BY: DATE

CHECKED BY: DATE

2022 PAVEMENT MARKING PROGRAM

STREET: NE 124TH ST

CROSS STREET: 100TH AVE NE

SEGMENT: 3040-#130

SCALE: N.T.S.

FILENAME: Page 2-4

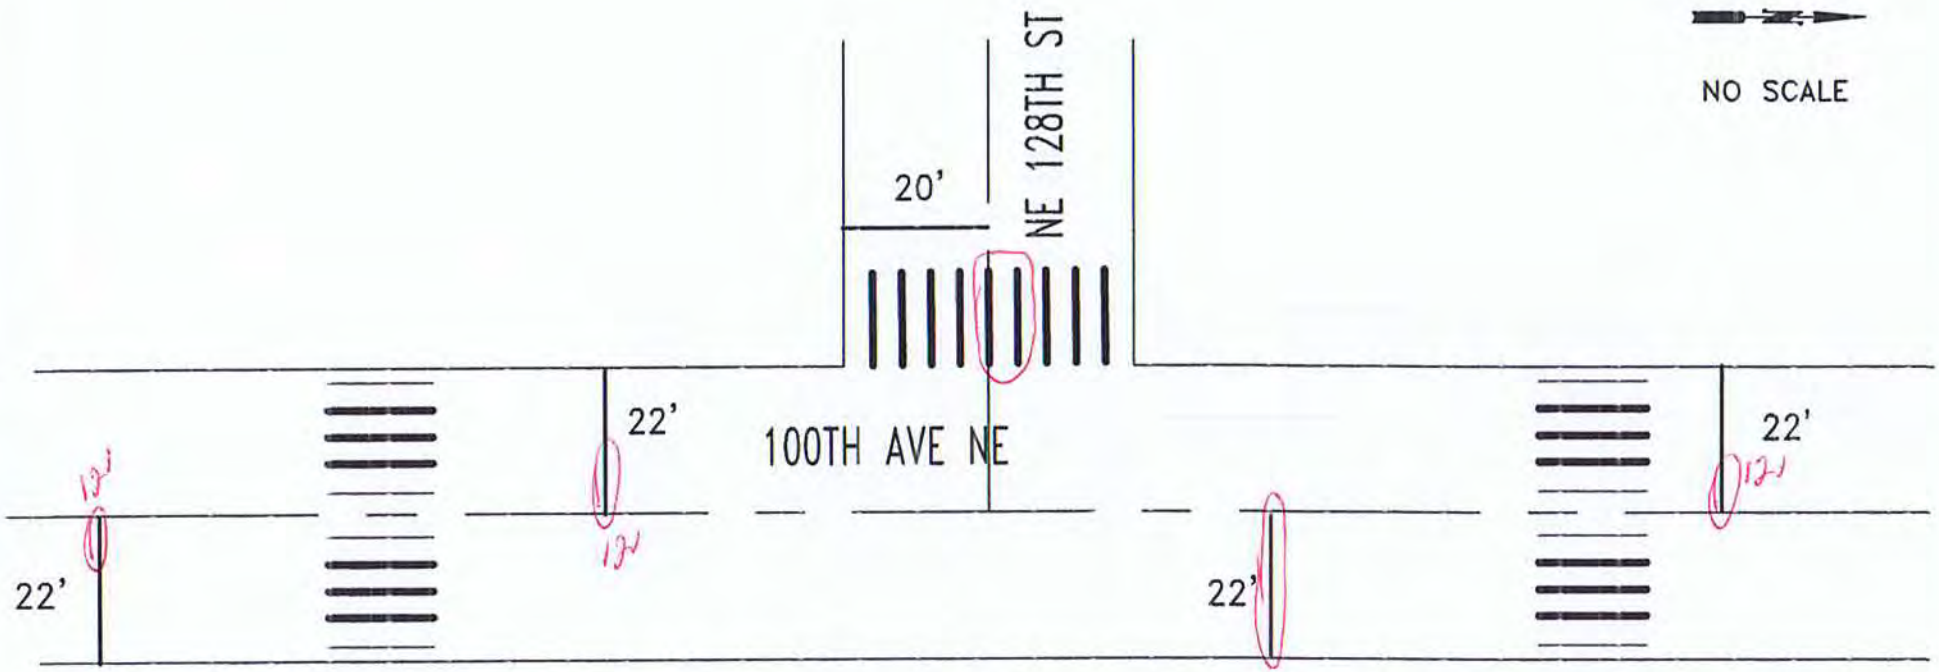

ESTIMATED QUANTITIES:

ITEM	ITEM DESCRIPTION	UNIT	INVENTORY	REPAIR QTY
PL18	PLASTIC STOP BAR, 18"	LF	108	58
PLXW	PLASTIC CROSSWALK STRIPE	SF	500	40
PLARW	PLASTIC TRAFFIC ARROW	EA		
PLLTR	PLASTIC TRAFFIC LETTER, 8 FT HIGH	EA		
PLRR	PLASTIC RAILROAD SYMBOL	EA		
RPLSYM	REMOVE PL. ARROW, LETTER, SYMBOL	EA		
RRPM	REMOVE RPM	EA		
RPLXW	REMOVE PLASTIC STRIPE	SF		40
RPMII	TYPE II RPM	EA	40	

CITY OF KIRKLAND WASHINGTON

CITY OF KIRKLAND
DEPARTMENT OF PUBLIC WORKS
123 FIFTH AVENUE KIRKLAND, WA 98033
(425) 587-3800 www.kirklandwa.gov

G. HORTILLOSA 10/2006
DESIGNED BY: DATE

J.JENNINGS 10/2009
DRAWN BY: DATE

CHECKED BY: DATE

2020 PAVEMENT MARKING PROGRAM

STREET: 100TH AVE NE

CROSS STREET: NE 128TH ST

SEGMENT: 1880-#40

SCALE: N.T.S.

FILENAME: Page 2-5

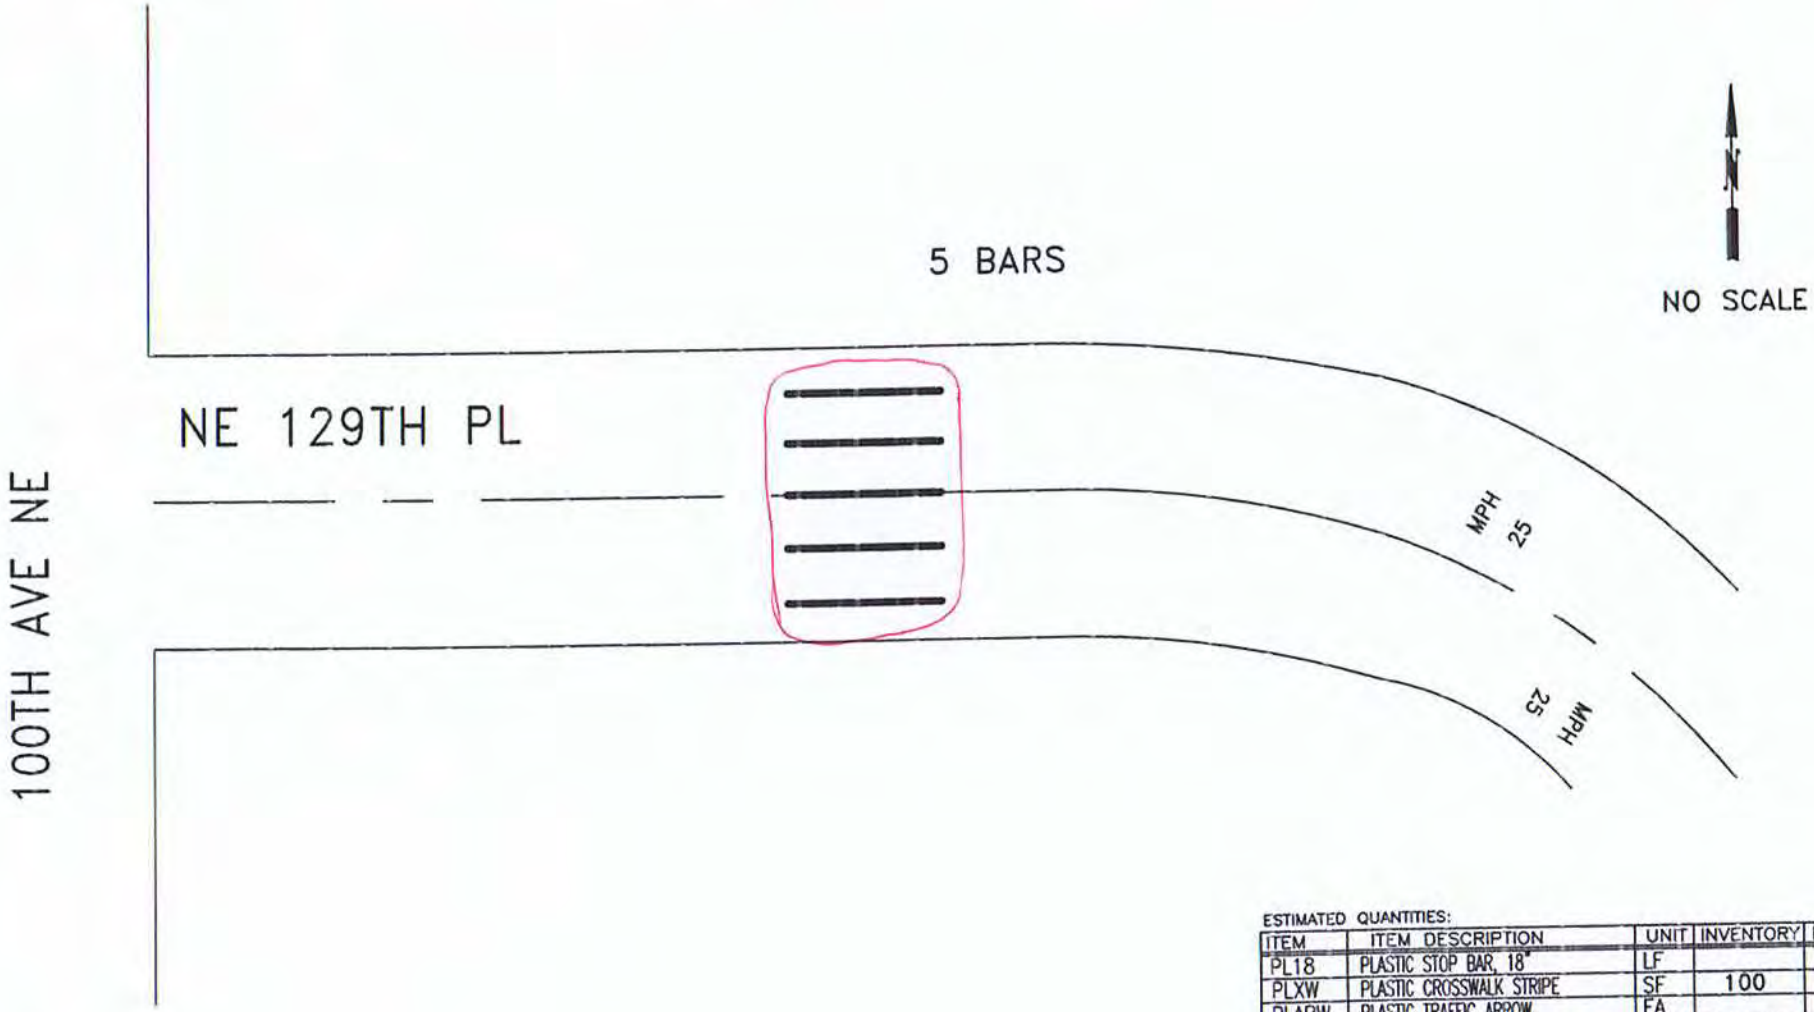

ESTIMATED QUANTITIES:

ITEM	ITEM DESCRIPTION	UNIT	INVENTORY	REPAIR QTY
PL18	PLASTIC STOP BAR, 18"	LF		
PLXW	PLASTIC CROSSWALK STRIPE	SF	100	100
PLARW	PLASTIC TRAFFIC ARROW	EA		
PLLTR	PLASTIC TRAFFIC LETTER, 8 FT HIGH	EA	10	
PLRR	PLASTIC RAILROAD SYMBOL	EA		
RPLSYM	REMOVE PL. ARROW, LETTER, SYMBOL	EA		
RRPM	REMOVE RPM	EA		
RPLXW	REMOVE PLASTIC STRIPE	SF		100
PLLGD	PLASTIC SPEED LEGEND BARS	EA		

CITY OF KIRKLAND WASHINGTON

CITY OF KIRKLAND
DEPARTMENT OF PUBLIC WORKS
123 FIFTH AVENUE KIRKLAND, WA 98033
(425) 587-3800 www.kirklandwa.gov

D.GRILLEY 5/2003
DESIGNED BY: DATE

J.JENNINGS 5/2003
DRAWN BY: DATE

CHECKED BY: DATE

2020 PAVEMENT MARKING PROGRAM

STREET: NE 129TH PL

CROSS STREET: 100TH AVE NE

SEGMENT:

SCALE: N.T.S.

FILENAME: Page 2-6

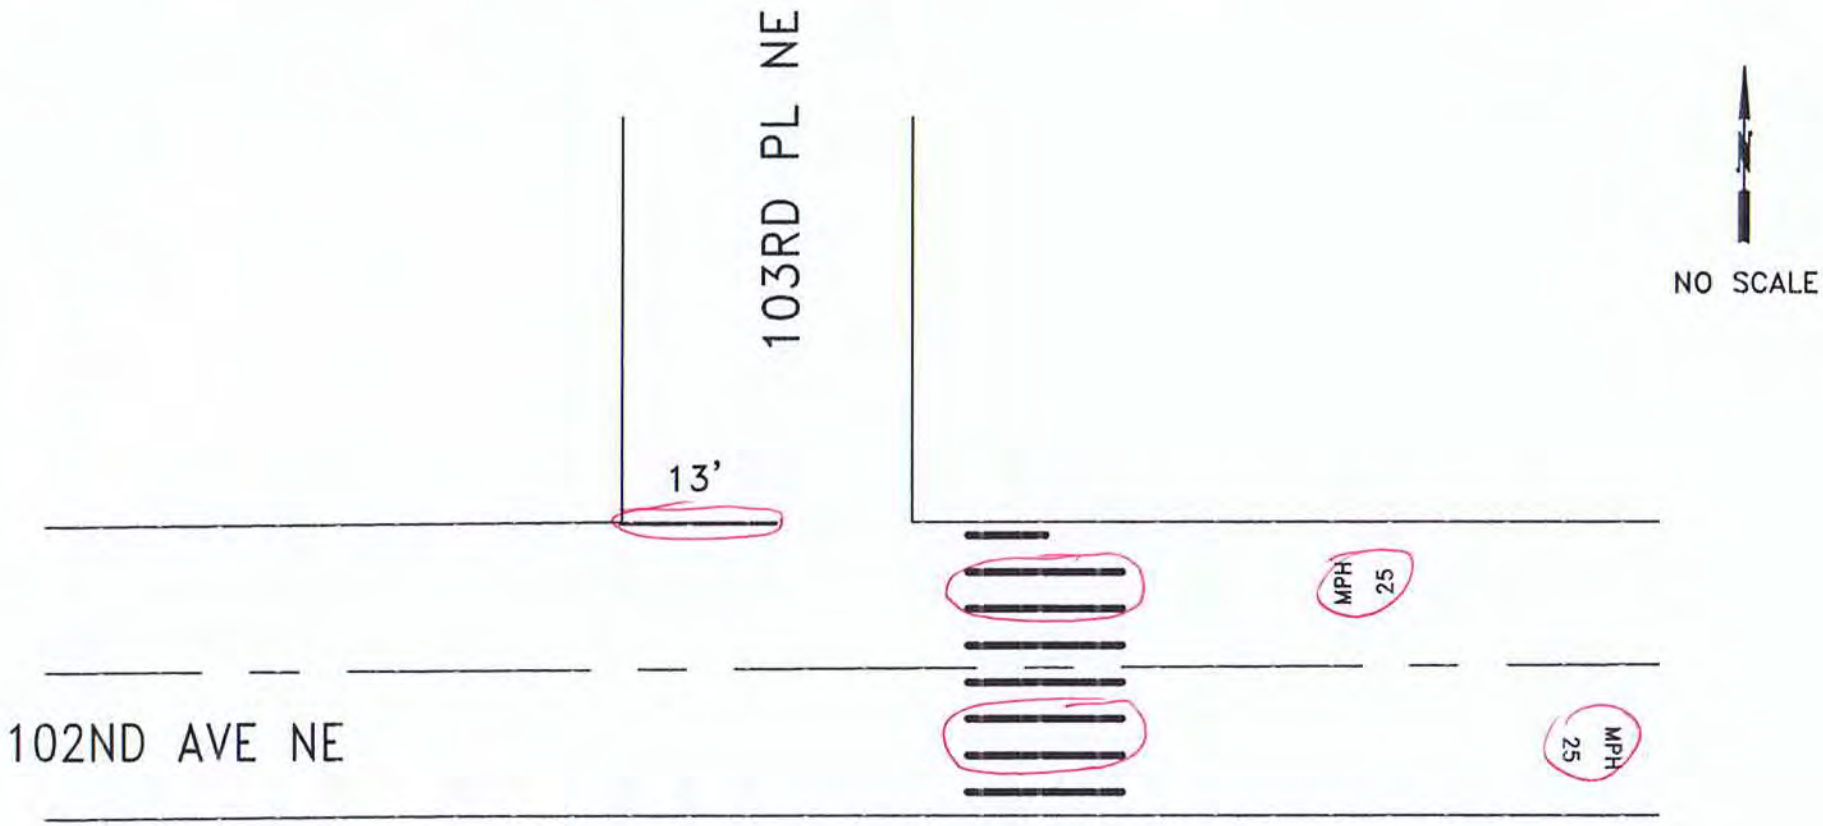

ESTIMATED QUANTITIES:

ITEM	ITEM DESCRIPTION	UNIT	INVENTORY	REPAIR QTY
PL18	PLASTIC STOP BAR, 18"	LF	13	13
PLXW	PLASTIC CROSSWALK STRIPE	SF	150	85
PLARW	PLASTIC TRAFFIC ARROW	EA		
PLLTR	PLASTIC TRAFFIC LETTER, 8 FT HIGH	EA	10	10
PLRR	PLASTIC RAILROAD SYMBOL	EA		
RPLSYM	REMOVE PL. ARROW, LETTER, SYMBOL	EA		
RRPM	REMOVE RPM	EA		
RPLXW	REMOVE PLASTIC STRIPE	SF		85
PLLGD	PLASTIC SPEED LEGEND BARS	SF		

CITY OF KIRKLAND WASHINGTON

CITY OF KIRKLAND
DEPARTMENT OF PUBLIC WORKS
123 FIFTH AVENUE KIRKLAND, WA 98033
(425) 587-3800 www.kirklandwa.gov

G. HORTILLOSA 3/2006
DESIGNED BY: DATE

J.JENNINGS 10/2009
DRAWN BY: DATE

CHECKED BY: DATE

2020 PAVEMENT MARKING PROGRAM

STREET: 102ND AVE NE

CROSS STREET: 103RD PL NE

SEGMENT:

SCALE: N.T.S.

FILENAME: Page 2-7

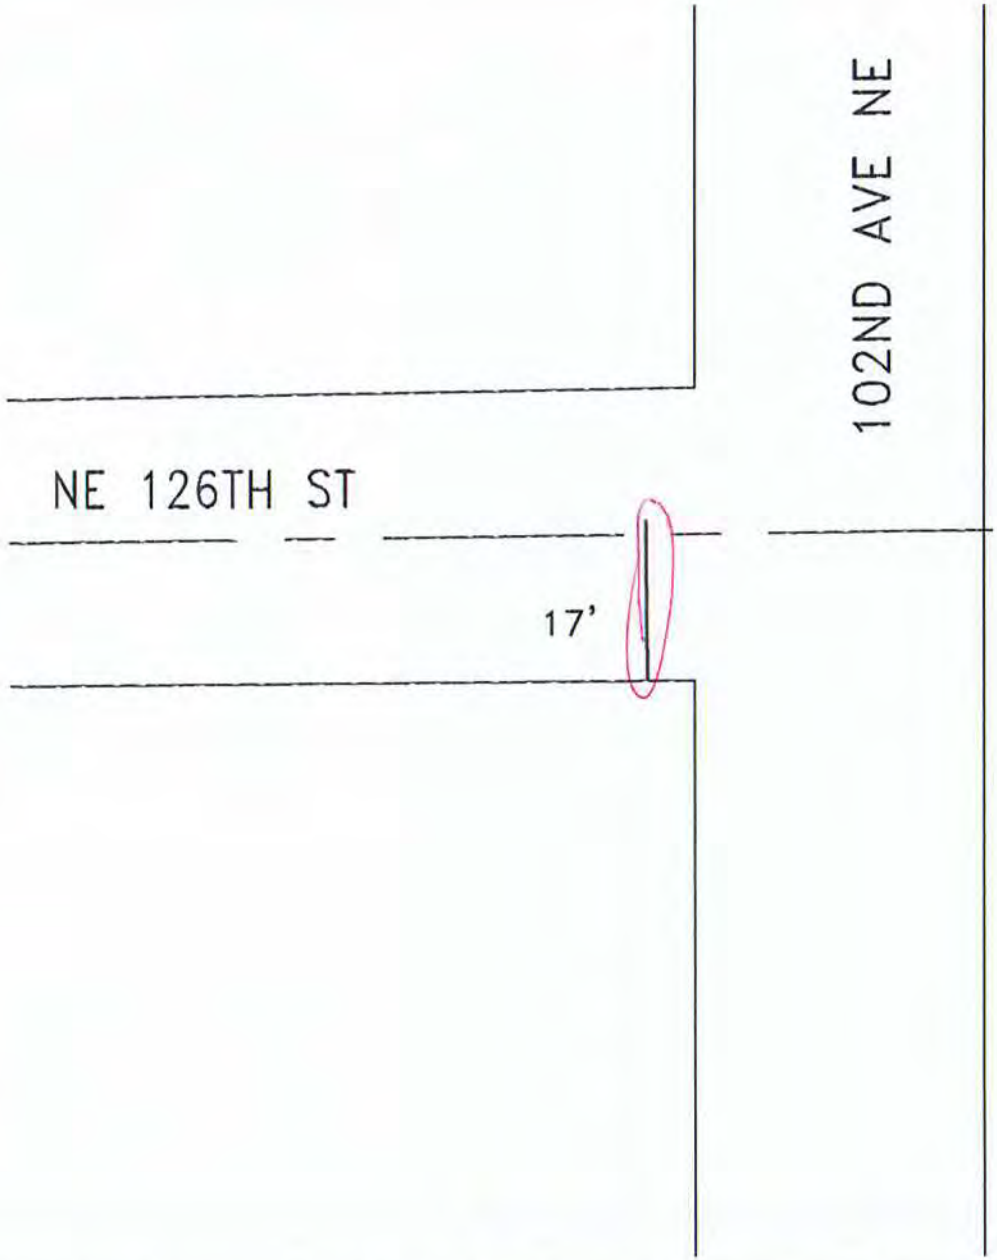

NO SCALE

ESTIMATED QUANTITIES:

ITEM	ITEM DESCRIPTION	UNIT	INVENTORY	REPAIR QTY
PL18	PLASTIC STOP BAR, 18"	LF	17	17
PLXW	PLASTIC CROSSWALK STRIPE	SF		
PLARW	PLASTIC TRAFFIC ARROW	EA		
PLLTR	PLASTIC TRAFFIC LETTER, 8 FT HIGH	EA		
PLRR	PLASTIC RAILROAD SYMBOL	EA		
RPLSYM	REMOVE PL. ARROW, LETTER, SYMBOL	EA		
RRPM	REMOVE RPM	EA		
RPLXW	REMOVE PLASTIC STRIPE	SF		26
PLLGD	PLASTIC SPEED LEGEND BARS	SF		

CITY OF KIRKLAND
DEPARTMENT OF PUBLIC WORKS
123 FIFTH AVENUE KIRKLAND, WA 98033
(425) 587-3800 www.kirklandwa.gov

S. GONSAR 2/2020
DESIGNED BY: DATE

J.JENNINGS 2/2020
DRAWN BY: DATE

CHECKED BY: DATE

2020 PAVEMENT MARKING PROGRAM

STREET: NE 126TH ST

CROSS STREET: 102ND AVE NE

SEGMENT:

SCALE: N.T.S.

FILENAME: Page 2-7A

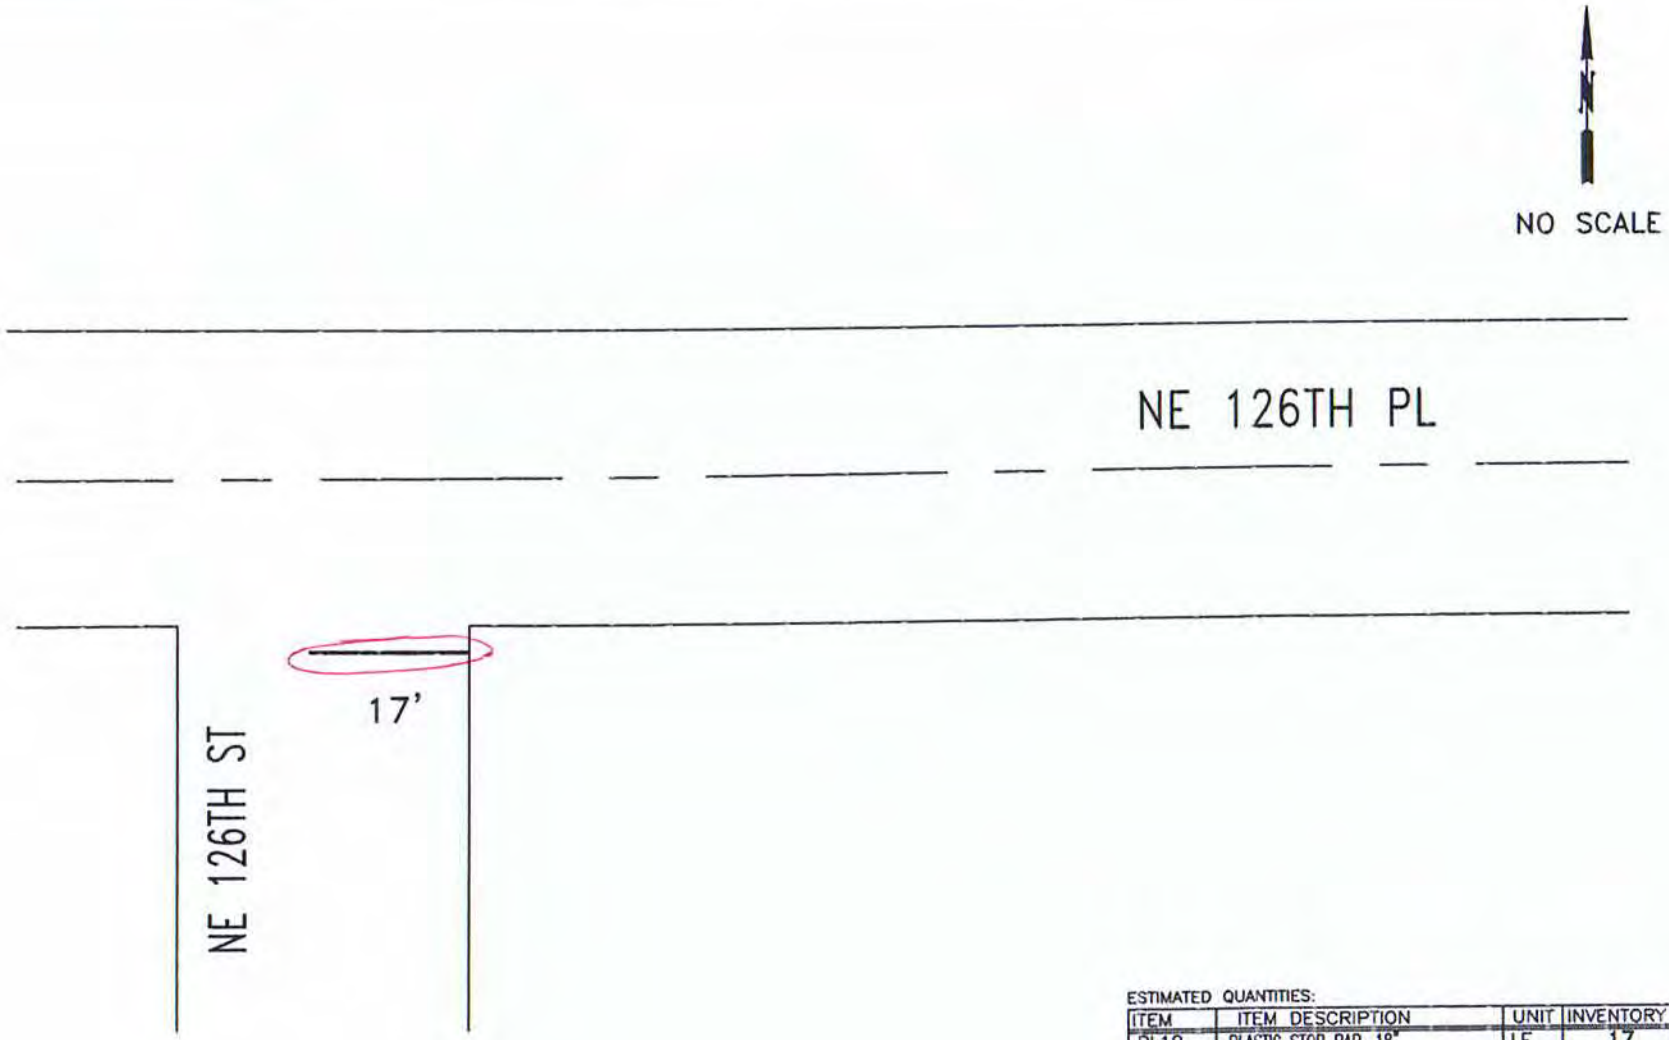

ESTIMATED QUANTITIES:

ITEM	ITEM DESCRIPTION	UNIT	INVENTORY	REPAIR QTY
PL18	PLASTIC STOP BAR, 18"	LF	17	17
PLXW	PLASTIC CROSSWALK STRIPE	SF		
PLARW	PLASTIC TRAFFIC ARROW	EA		
PLLTR	PLASTIC TRAFFIC LETTER, 8 FT HIGH	EA		
PLRR	PLASTIC RAILROAD SYMBOL	EA		
RPLSYM	REMOVE PL. ARROW, LETTER, SYMBOL	EA		
RRPM	REMOVE RPM	EA		
RPLXW	REMOVE PLASTIC STRIPE	SF		
PLLGD	PLASTIC SPEED LEGEND BARS	SF		

CITY OF KIRKLAND WASHINGTON

CITY OF KIRKLAND
DEPARTMENT OF PUBLIC WORKS
123 FIFTH AVENUE KIRKLAND, WA 98033
(425) 587-3800 www.kirklandwa.gov

G. HORTILLOSA 2/2012
DESIGNED BY: DATE

J.JENNINGS 2/2012
DRAWN BY: DATE

CHECKED BY: DATE

2020 PAVEMENT MARKING PROGRAM

STREET: NE 126TH PL

CROSS STREET: NE 126TH ST

SEGMENT:

SCALE: N.T.S.

FILENAME: Page 2-8

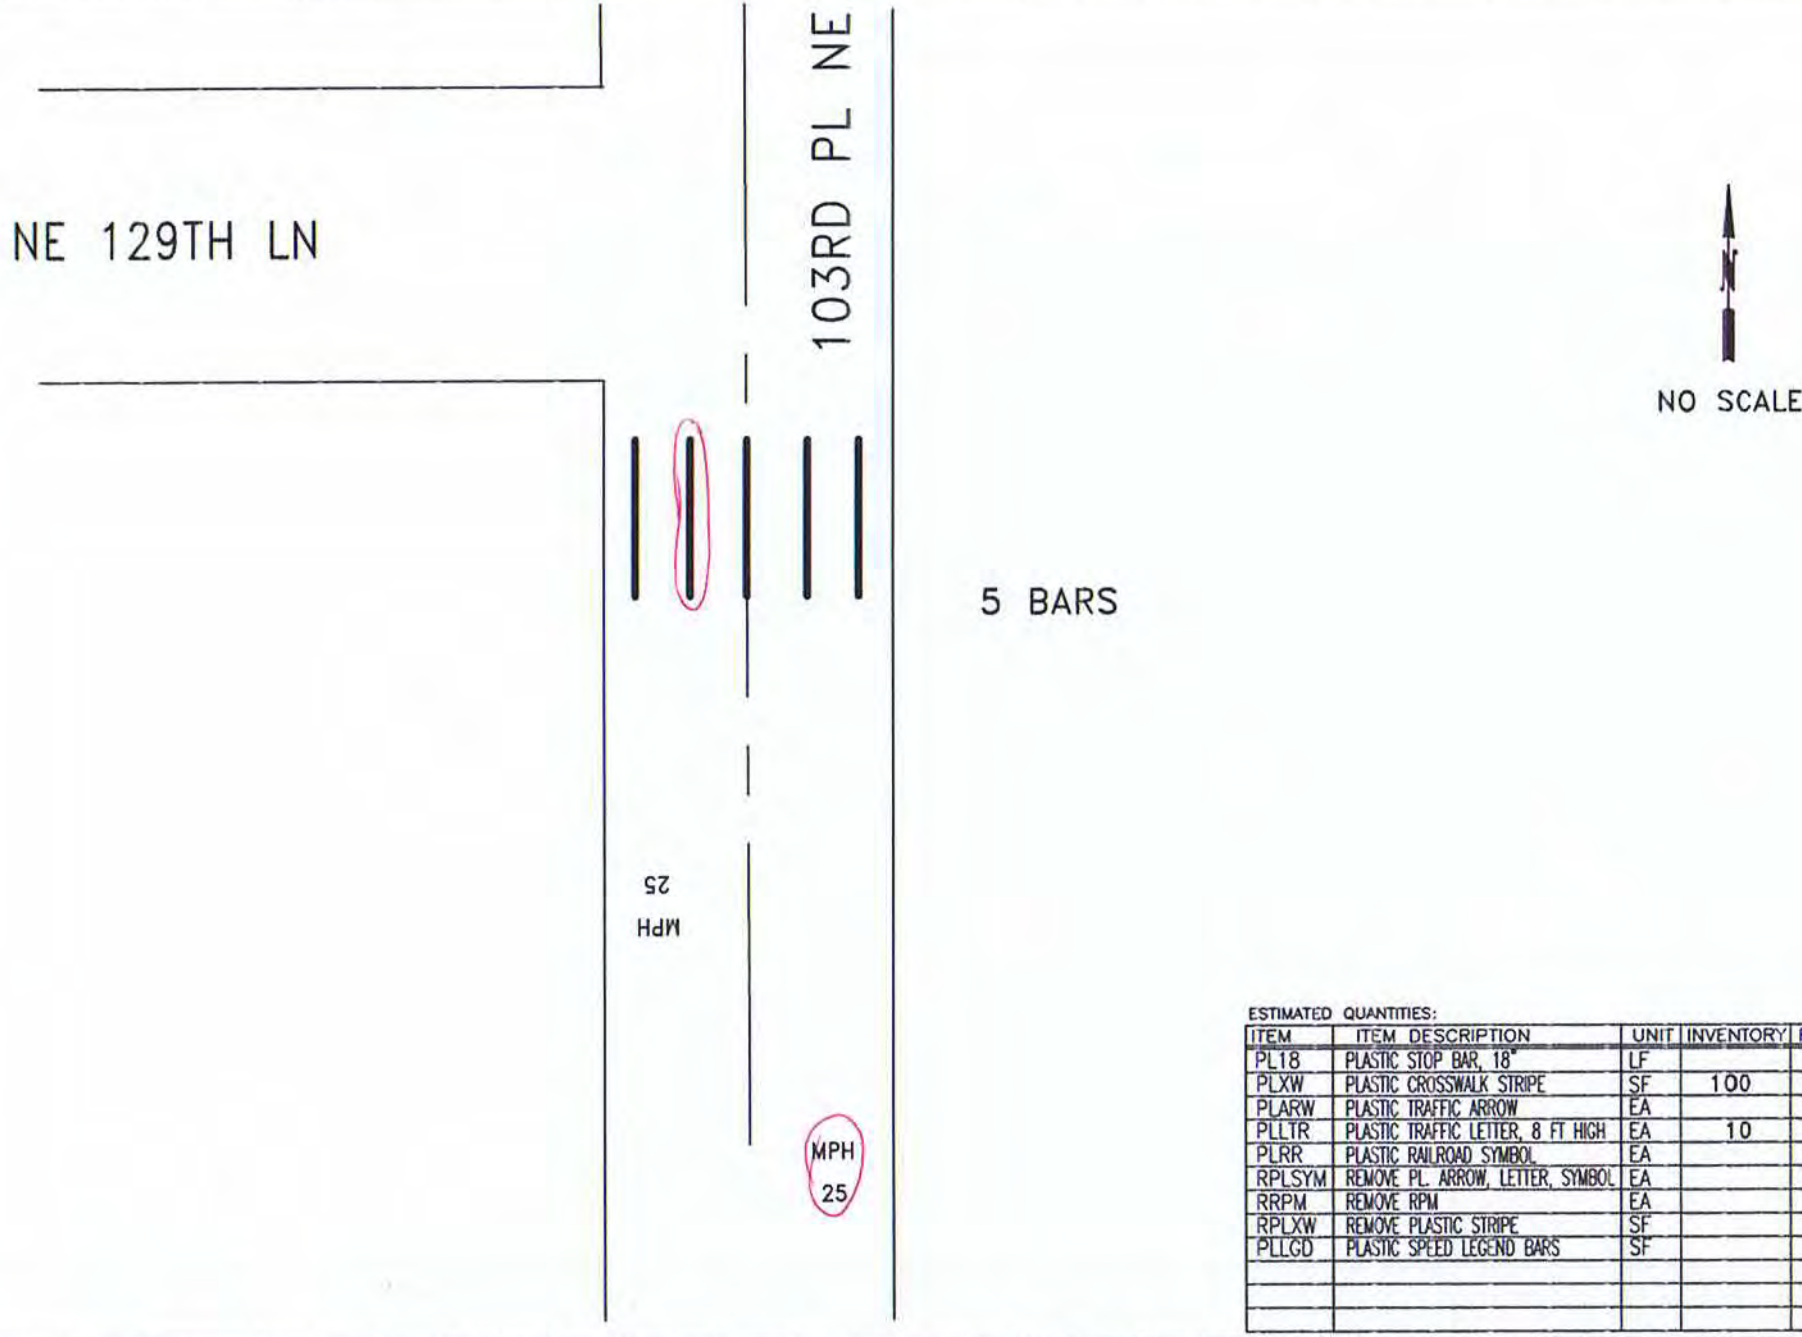

ESTIMATED QUANTITIES:

ITEM	ITEM DESCRIPTION	UNIT	INVENTORY	REPAIR QTY
PL18	PLASTIC STOP BAR, 18"	LF		
PLXW	PLASTIC CROSSWALK STRIPE	SF	100	20
PLARW	PLASTIC TRAFFIC ARROW	EA		
PLLTR	PLASTIC TRAFFIC LETTER, 8 FT HIGH	EA	10	5
PLRR	PLASTIC RAILROAD SYMBOL	EA		
RPLSYM	REMOVE PL. ARROW, LETTER, SYMBOL	EA		
RRPM	REMOVE RPM	EA		
RPLXW	REMOVE PLASTIC STRIPE	SF		
PLLGD	PLASTIC SPEED LEGEND BARS	SF		

CITY OF KIRKLAND
DEPARTMENT OF PUBLIC WORKS
123 FIFTH AVENUE KIRKLAND, WA 98033
(425) 587-3800 www.kirklandwa.gov

D.GRILLEY 5/2003
DESIGNED BY: DATE

J.JENNINGS 5/2003
DRAWN BY: DATE

CHECKED BY: DATE

2020 PAVEMENT MARKING PROGRAM

STREET: 103RD PL NE

CROSS STREET: NE 129TH LN

SEGMENT:

SCALE: N.T.S.

FILENAME: Page 2-9

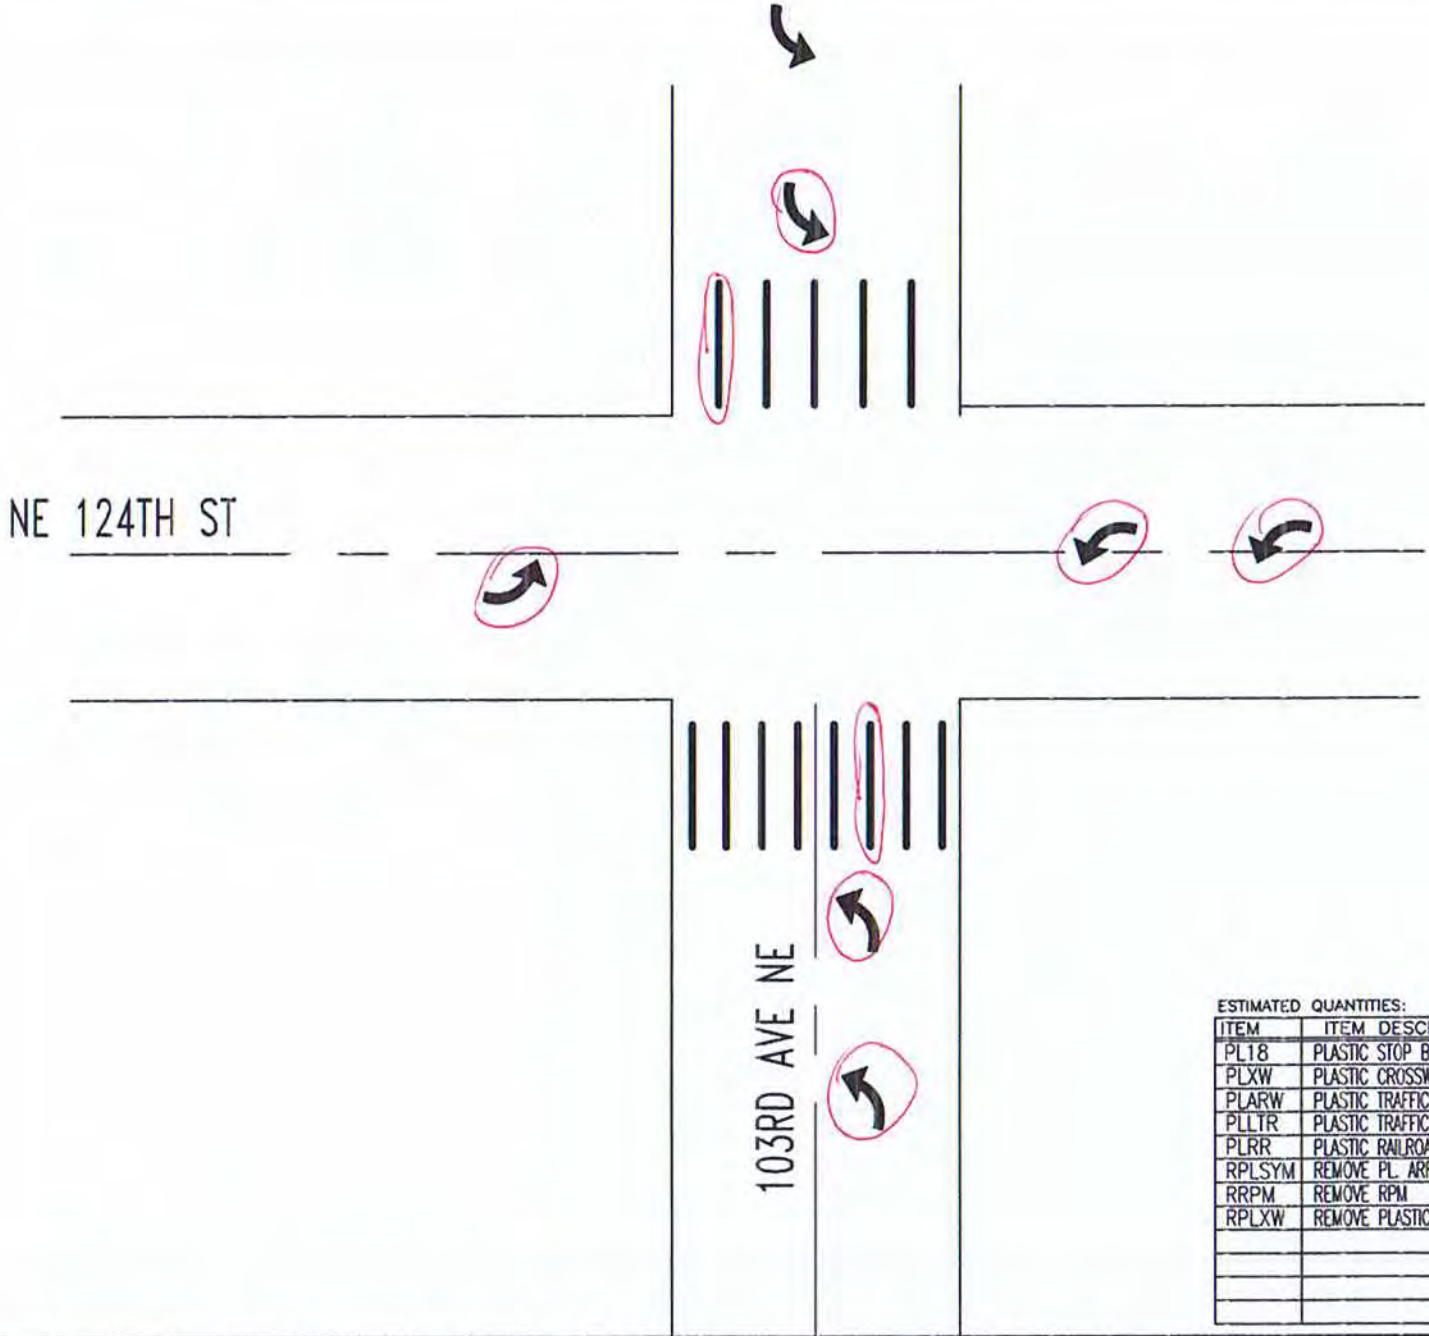

NO SCALE

ESTIMATED QUANTITIES:

ITEM	ITEM DESCRIPTION	UNIT	INVENTORY	REPAIR QTY
PL18	PLASTIC STOP BAR, 18"	LF		
PLXW	PLASTIC CROSSWALK STRIPE	SF	260	40
PLARW	PLASTIC TRAFFIC ARROW	EA	7	6
PLLTR	PLASTIC TRAFFIC LETTER, 8 FT HIGH	EA		
PLRR	PLASTIC RAILROAD SYMBOL	EA		
RPLSYM	REMOVE PL. ARROW, LETTER, SYMBOL	EA		
RRPM	REMOVE RPM	EA		
RPLXW	REMOVE PLASTIC STRIPE	SF		70

CITY OF KIRKLAND
DEPARTMENT OF PUBLIC WORKS
123 FIFTH AVENUE KIRKLAND, WA 98033
(425) 587-3800 www.kirklandwa.gov

L KAWAOKA 8/2016
DESIGNED BY: DATE

J.JENNINGS 8/2016
DRAWN BY: DATE

CHECKED BY: DATE

2020 PAVEMENT MARKING PROGRAM

STREET: NE 124TH ST

CROSS STREET: 103RD AVE NE

SEGMENT: 30-#10

SCALE: N.T.S.

FILENAME: Page 2-10

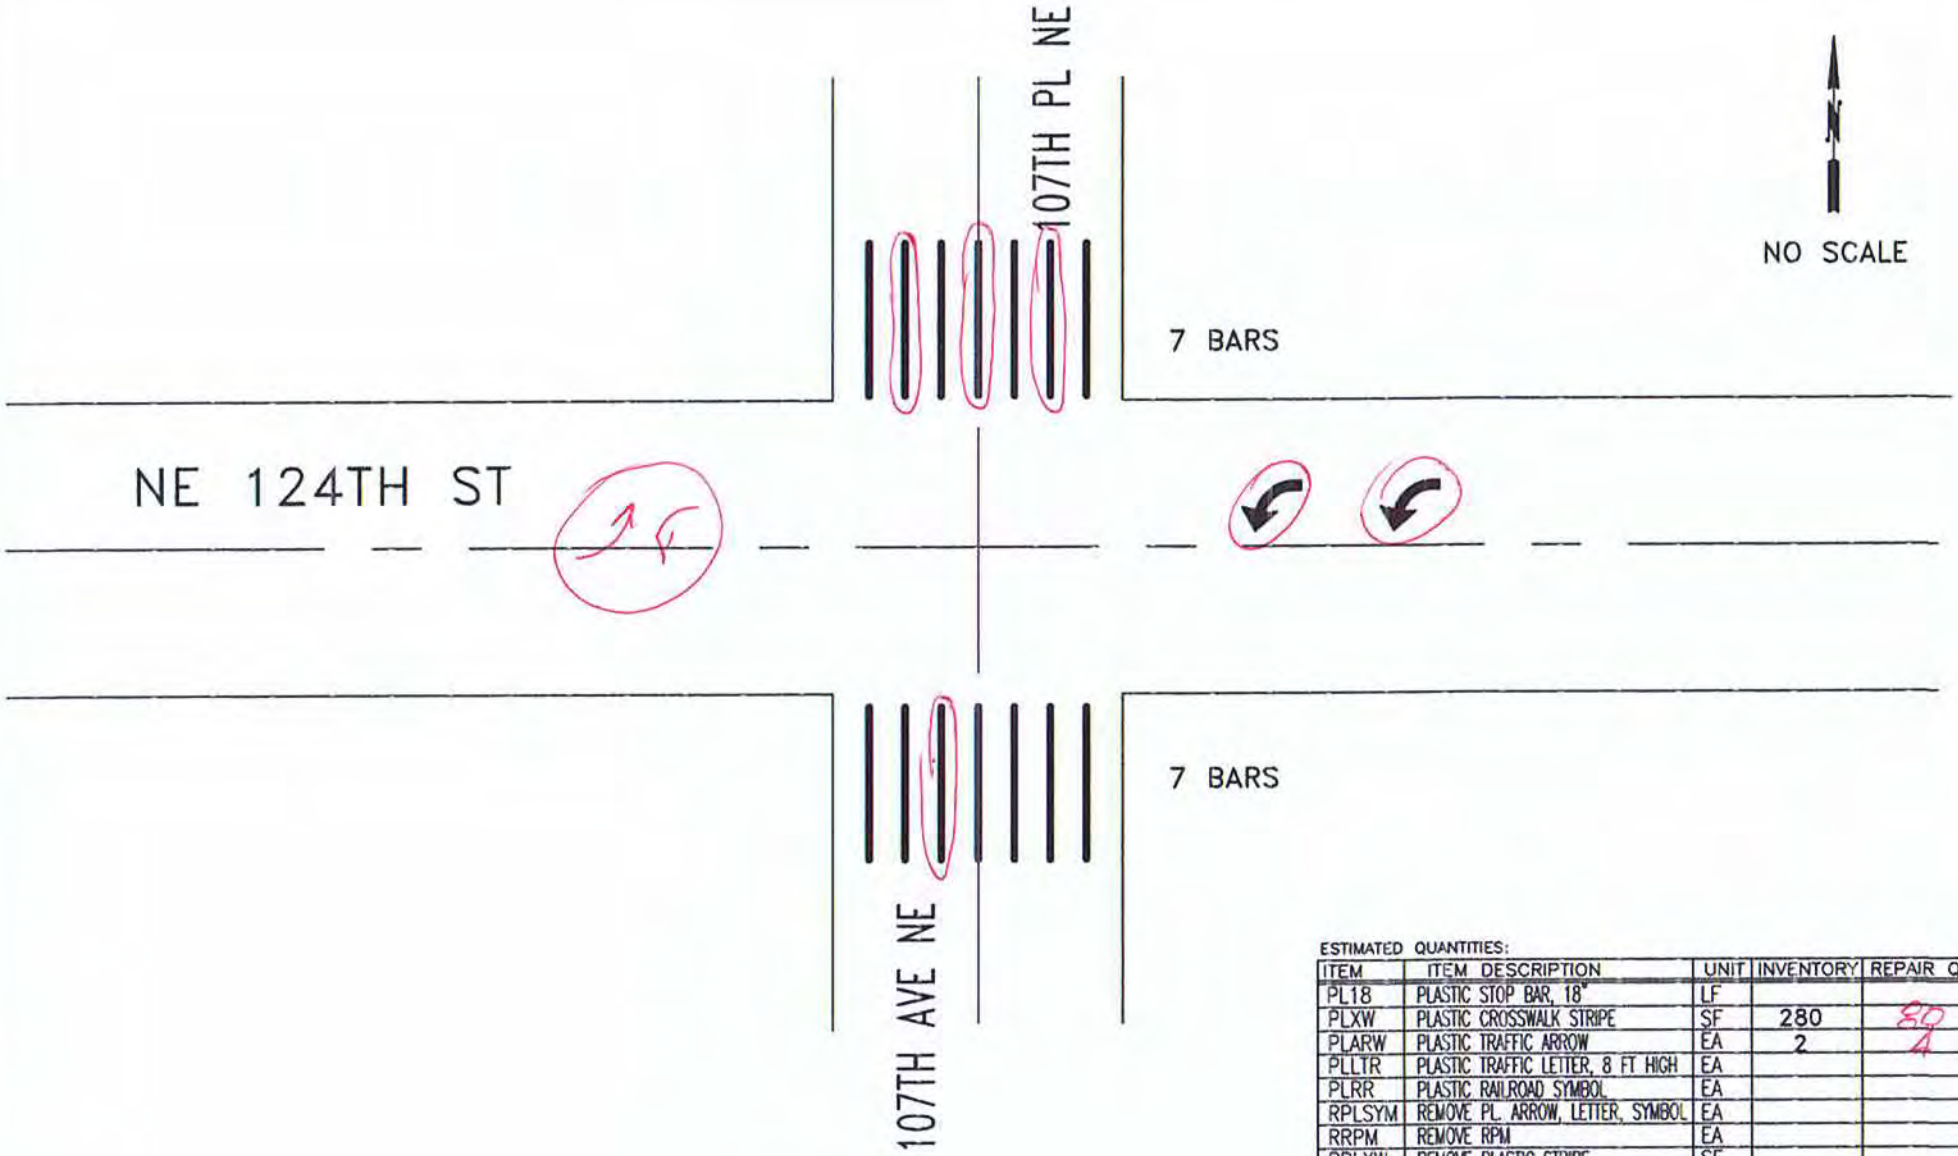

ESTIMATED QUANTITIES:

ITEM	ITEM DESCRIPTION	UNIT	INVENTORY	REPAIR QTY
PL18	PLASTIC STOP BAR, 18"	LF		
PLXW	PLASTIC CROSSWALK STRIPE	SF	280	80
PLARW	PLASTIC TRAFFIC ARROW	EA	2	4
PLLTR	PLASTIC TRAFFIC LETTER, 8 FT HIGH	EA		
PLRR	PLASTIC RAILROAD SYMBOL	EA		
RPLSYM	REMOVE PL. ARROW, LETTER, SYMBOL	EA		
RRPM	REMOVE RPM	EA		
RPLXW	REMOVE PLASTIC STRIPE	SF		

CITY OF KIRKLAND
DEPARTMENT OF PUBLIC WORKS
123 FIFTH AVENUE KIRKLAND, WA 98033
(425) 587-3800 www.kirklandwa.gov

G. HORTILLOSA 10/2011
DESIGNED BY: DATE

J.JENNINGS 10/2011
DRAWN BY: DATE

CHECKED BY: DATE


STREET: NE 124TH ST

CROSS STREET: 107TH AVE NE

SEGMENT: 3040-#80

SCALE: N.T.S.

FILENAME: Page 2-11

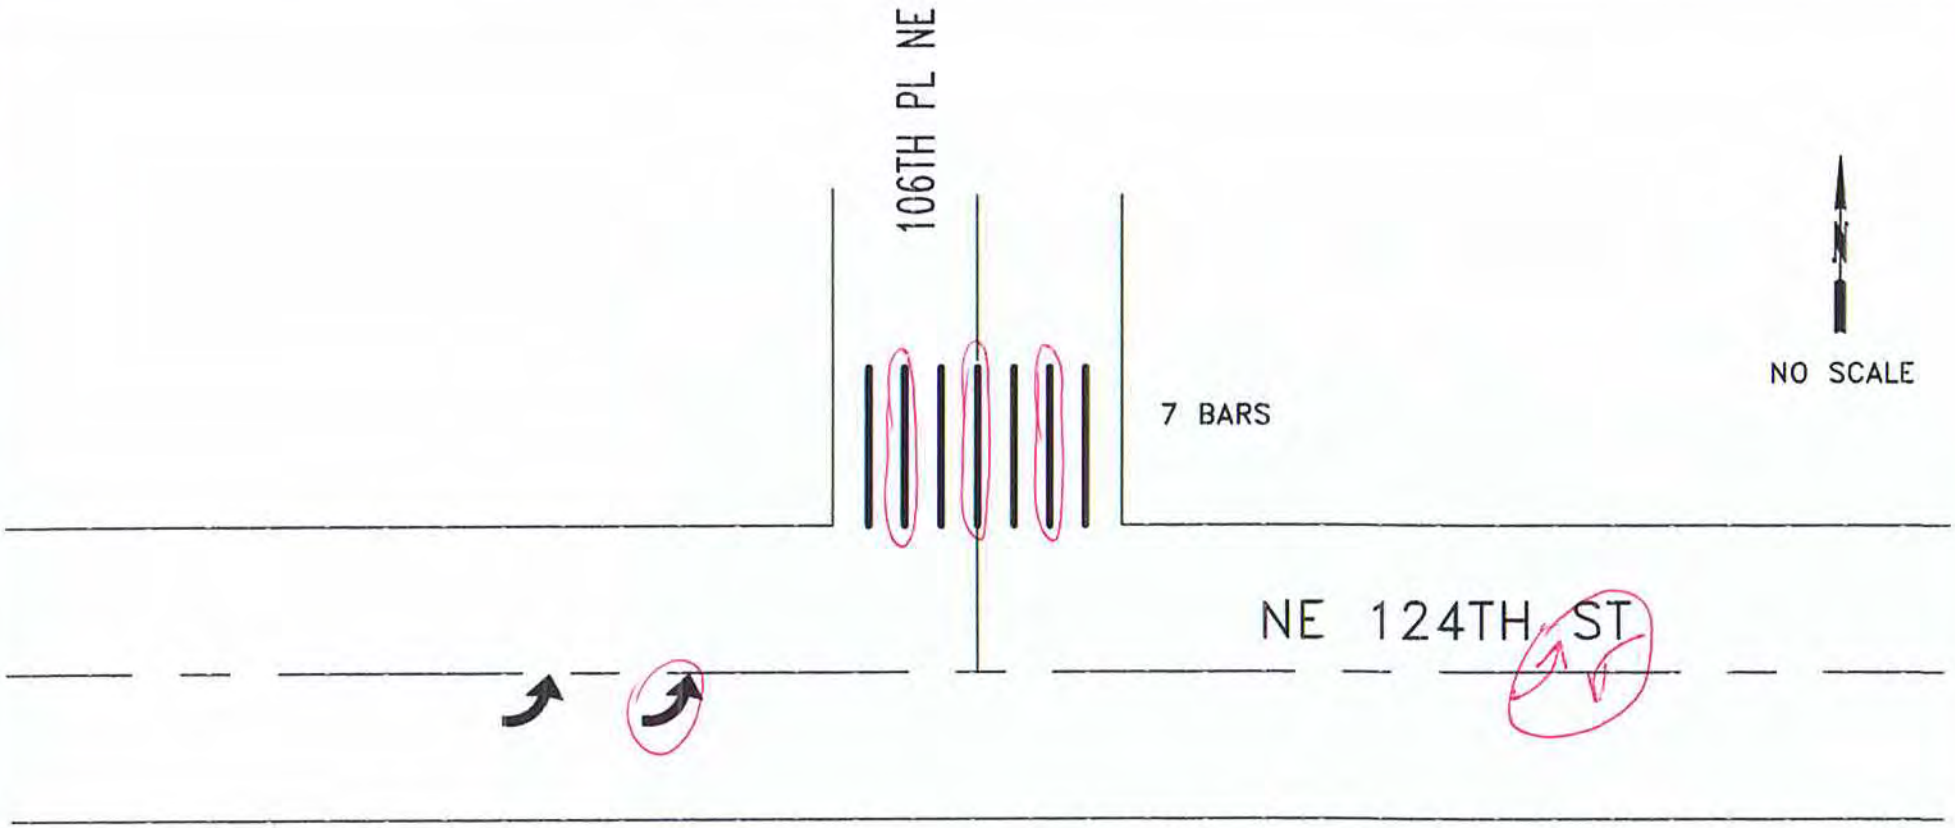

ESTIMATED QUANTITIES:

ITEM	ITEM DESCRIPTION	UNIT	INVENTORY	REPAIR QTY
PL18	PLASTIC STOP BAR, 18"	LF		
PLXW	PLASTIC CROSSWALK STRIPE	SF	140	50
PLARW	PLASTIC TRAFFIC ARROW	EA	2	3
PLLTR	PLASTIC TRAFFIC LETTER, 8 FT HIGH	EA		
PLRR	PLASTIC RAILROAD SYMBOL	EA		
RPLSYM	REMOVE PL. ARROW, LETTER, SYMBOL	EA		
RRPM	REMOVE RPM	EA		
RPLXW	REMOVE PLASTIC STRIPE	SF		

CITY OF KIRKLAND
DEPARTMENT OF PUBLIC WORKS
123 FIFTH AVENUE KIRKLAND, WA 98033
(425) 587-3800 www.kirklandwa.gov

G. HORTILLOSA 10/2011
DESIGNED BY: DATE

J.JENNINGS 10/2011
DRAWN BY: DATE

CHECKED BY: DATE

2020 PAVEMENT MARKING PROGRAM

STREET: NE 124TH ST

CROSS STREET: 106TH PL NE

SEGMENT: 3040-#60

SCALE: N.T.S.

FILENAME: Page 2-12

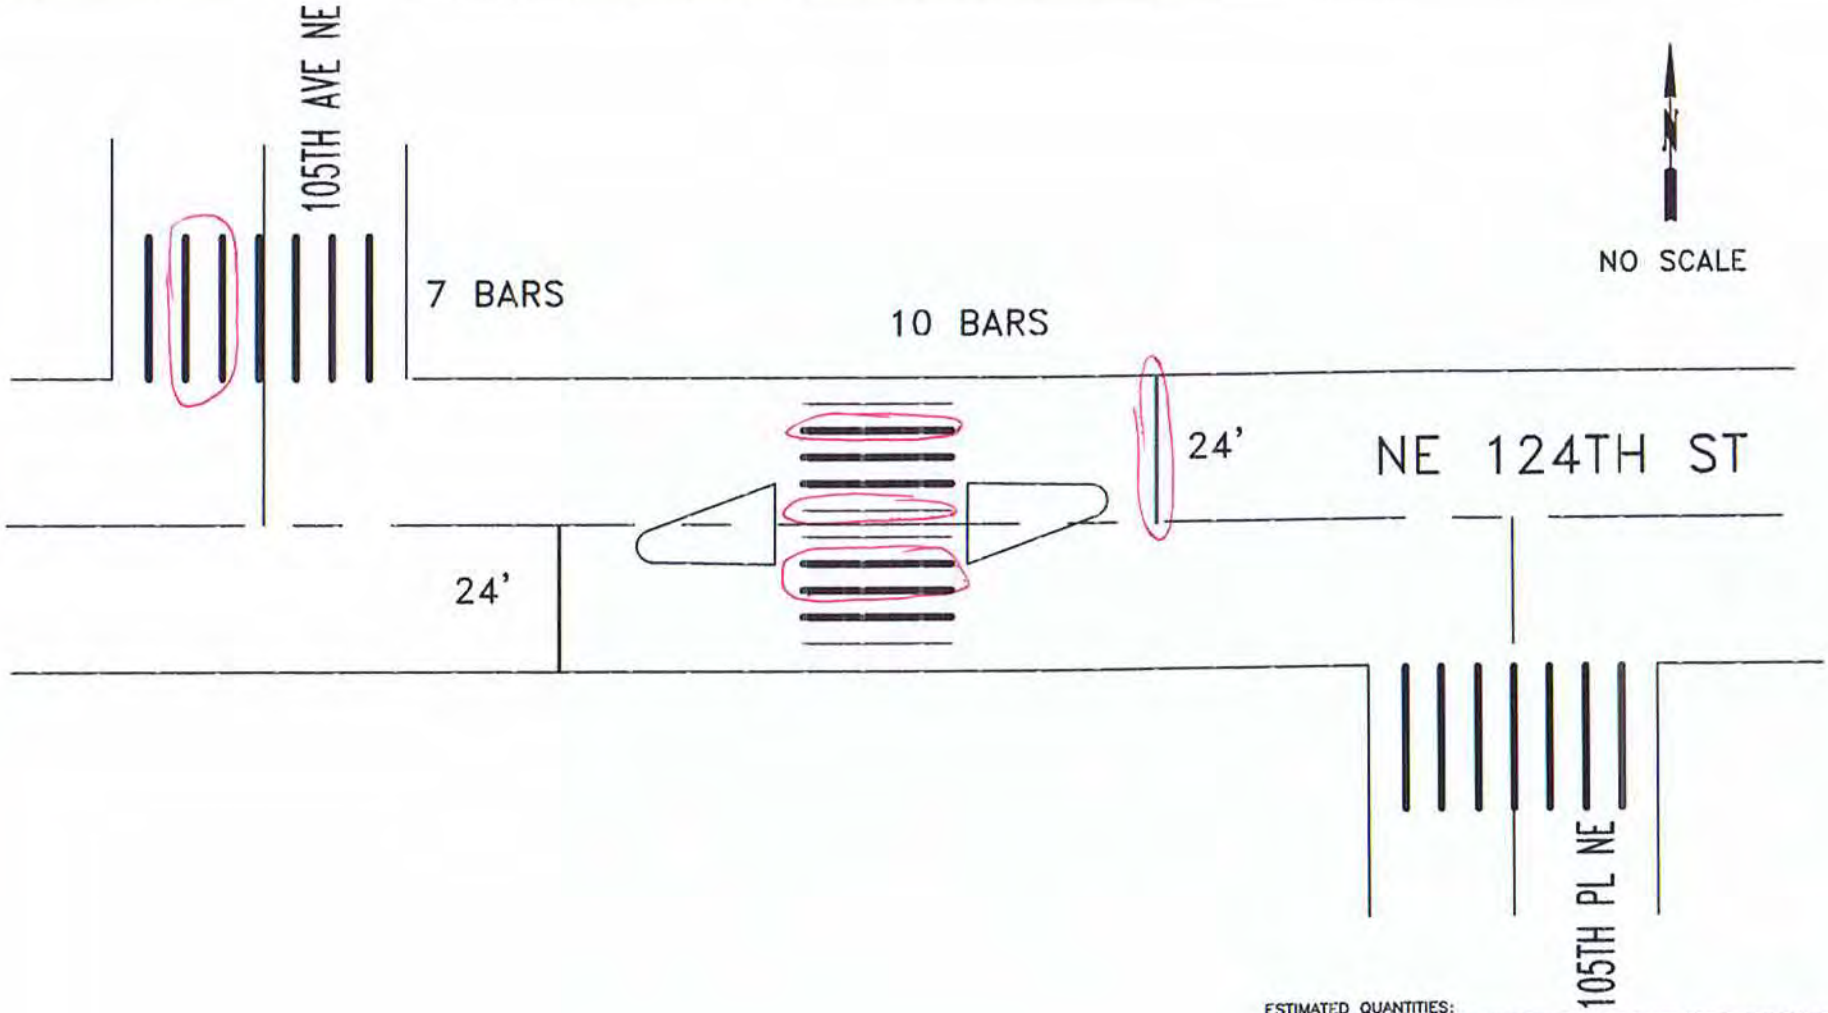

ESTIMATED QUANTITIES:

ITEM	ITEM DESCRIPTION	UNIT	INVENTORY	REPAIR QTY
PL18	PLASTIC STOP BAR, 18"	LF	48	24
PLXW	PLASTIC CROSSWALK STRIPE	SF	440	110
PLARW	PLASTIC TRAFFIC ARROW	EA		
PLLTR	PLASTIC TRAFFIC LETTER, 8 FT HIGH	EA		
PLRR	PLASTIC RAILROAD SYMBOL	EA		
RPLSYM	REMOVE PL. ARROW, LETTER, SYMBOL	EA		
RRPM	REMOVE RPM	EA		
RPLXW	REMOVE PLASTIC STRIPE	SF		40

CITY OF KIRKLAND WASHINGTON

CITY OF KIRKLAND
DEPARTMENT OF PUBLIC WORKS
123 FIFTH AVENUE KIRKLAND, WA 98033
(425) 587-3800 www.kirklandwa.gov

G. HORTILLOSA 10/2006
DESIGNED BY: DATE

J.JENNINGS 10/2006
DRAWN BY: DATE

CHECKED BY: DATE

2020 PAVEMENT MARKING PROGRAM

STREET: NE 124TH ST

CROSS STREET: 105TH PL NE & 105TH AVE NE

SEGMENT: 3040-#50

SCALE: N.T.S.

FILENAME: Page 2-13

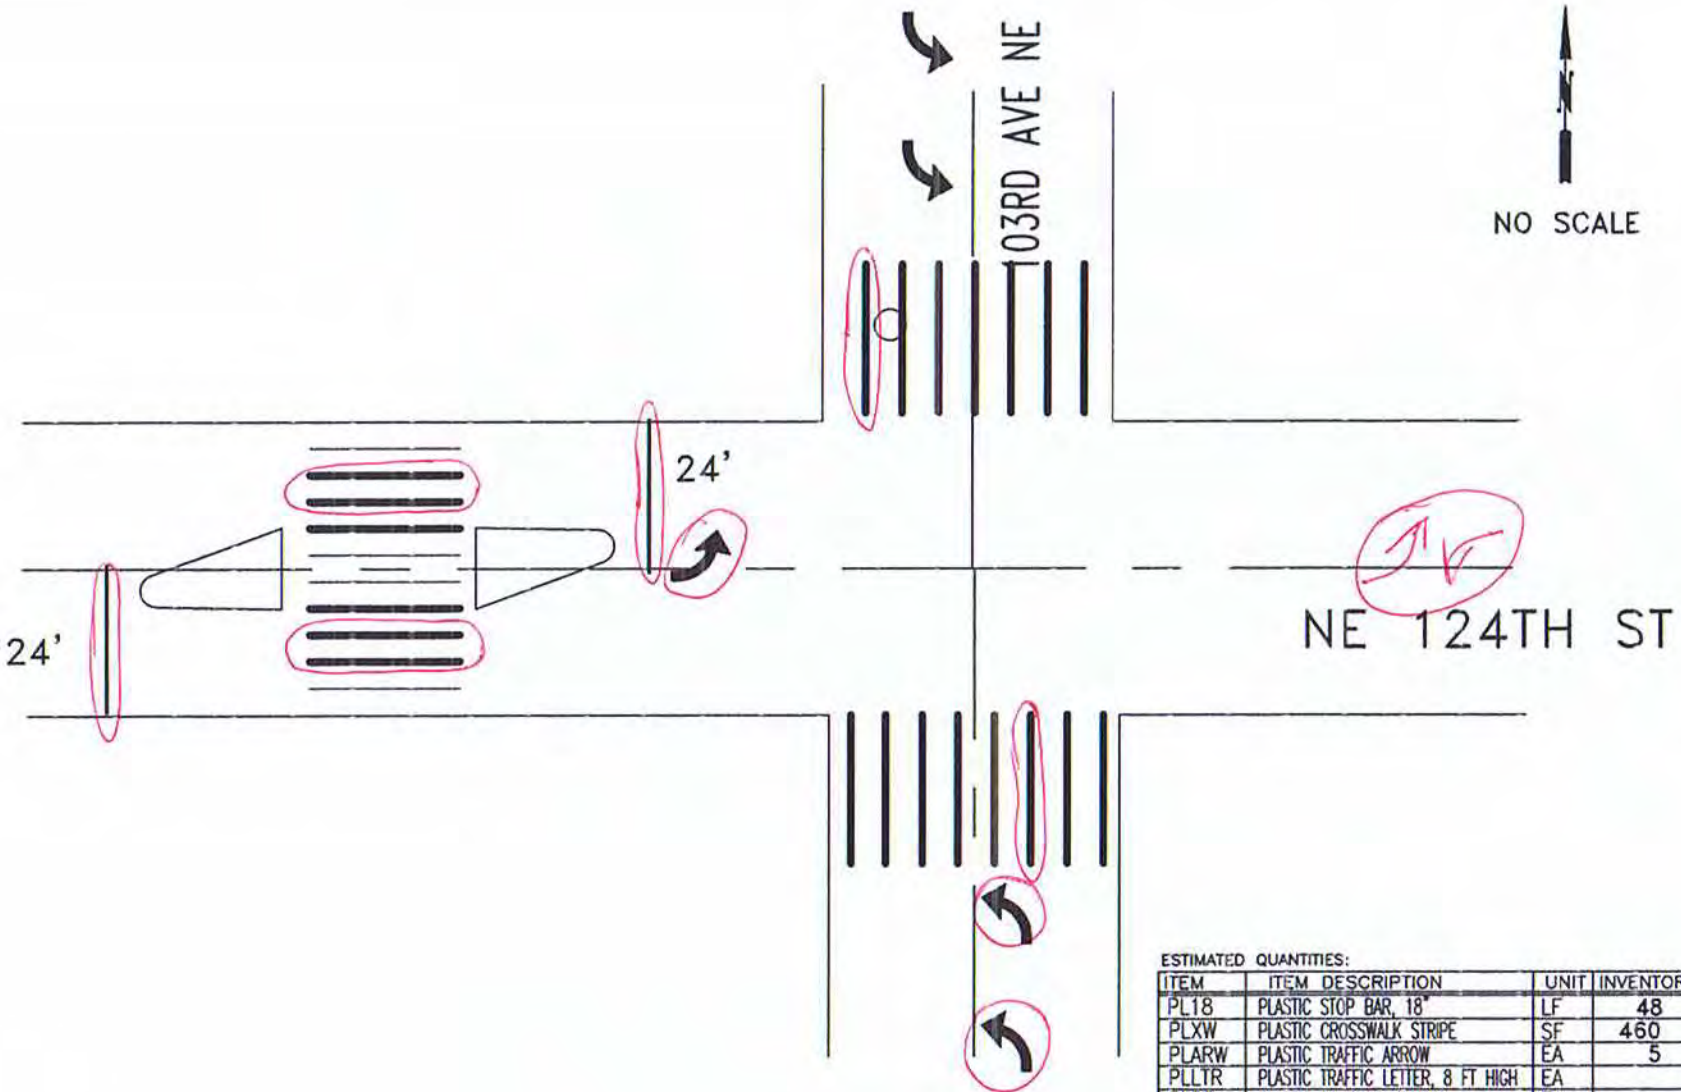

ESTIMATED QUANTITIES:

ITEM	ITEM DESCRIPTION	UNIT	INVENTORY	REPAIR QTY
PL18	PLASTIC STOP BAR, 18"	LF	48	48
PLXW	PLASTIC CROSSWALK STRIPE	SF	460	120
PLARW	PLASTIC TRAFFIC ARROW	EA	5	5
PLLTR	PLASTIC TRAFFIC LETTER, 8 FT HIGH	EA		
PLRR	PLASTIC RAILROAD SYMBOL	EA		
RPLSYM	REMOVE PL. ARROW, LETTER, SYMBOL	EA		
RRPM	REMOVE RPM	EA		
RPLXW	REMOVE PLASTIC STRIPE	SF		40

CITY OF KIRKLAND
DEPARTMENT OF PUBLIC WORKS
123 FIFTH AVENUE KIRKLAND, WA 98033
(425) 587-3800 www.kirklandwa.gov

G. HORTILLOSA 2/2011
DESIGNED BY: DATE

J.JENNINGS 11/2004
DRAWN BY: DATE

CHECKED BY: DATE

2020 PAVEMENT MARKING PROGRAM

STREET: NE 124TH ST

CROSS STREET: 103RD AVE NE

SEGMENT: 3040-#40

SCALE: N.T.S.

FILENAME: Page 2-14

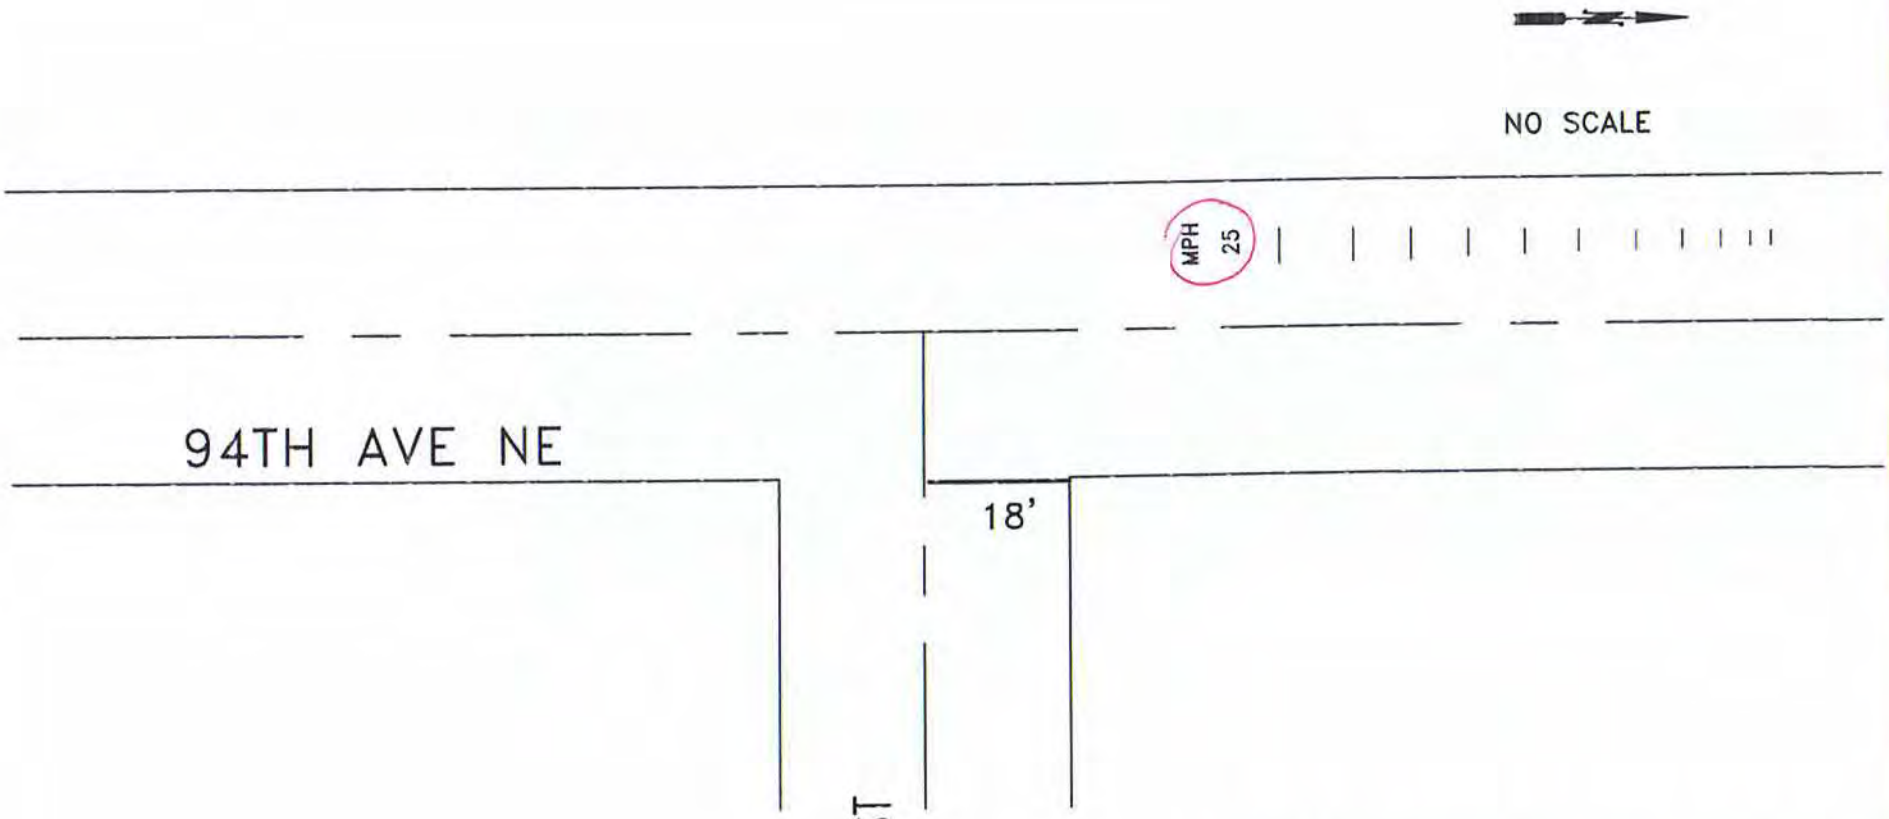

ESTIMATED QUANTITIES:

ITEM	ITEM DESCRIPTION	UNIT	INVENTORY	REPAIR QTY
PL18	PLASTIC STOP BAR, 18"	LF	18	
PLXW	PLASTIC CROSSWALK STRIPE	SF		
PLARW	PLASTIC TRAFFIC ARROW	EA		
PLLTR	PLASTIC TRAFFIC LETTER, 8 FT HIGH	EA	5	5
PLRR	PLASTIC RAILROAD SYMBOL	EA		
RPLSYM	REMOVE PL. ARROW, LETTER, SYMBOL	EA		
RRPM	REMOVE RPM	EA		
RPLXW	REMOVE PLASTIC STRIPE	SF		
PLLGD	PLASTIC SPEED LEGEND BARS	SF	62	

CITY OF KIRKLAND
DEPARTMENT OF PUBLIC WORKS
123 FIFTH AVENUE KIRKLAND, WA 98033
(425) 587-3800 www.kirklandwa.gov

D.GRILLEY 1/2000
DESIGNED BY: DATE

J.JENNINGS 1/2000
DRAWN BY: DATE

CHECKED BY: DATE

2020 PAVEMENT MARKING PROGRAM

STREET: 94TH AVE NE

CROSS STREET: NE 128TH ST

SEGMENT:

SCALE: N.T.S.

FILENAME: Page 2-15

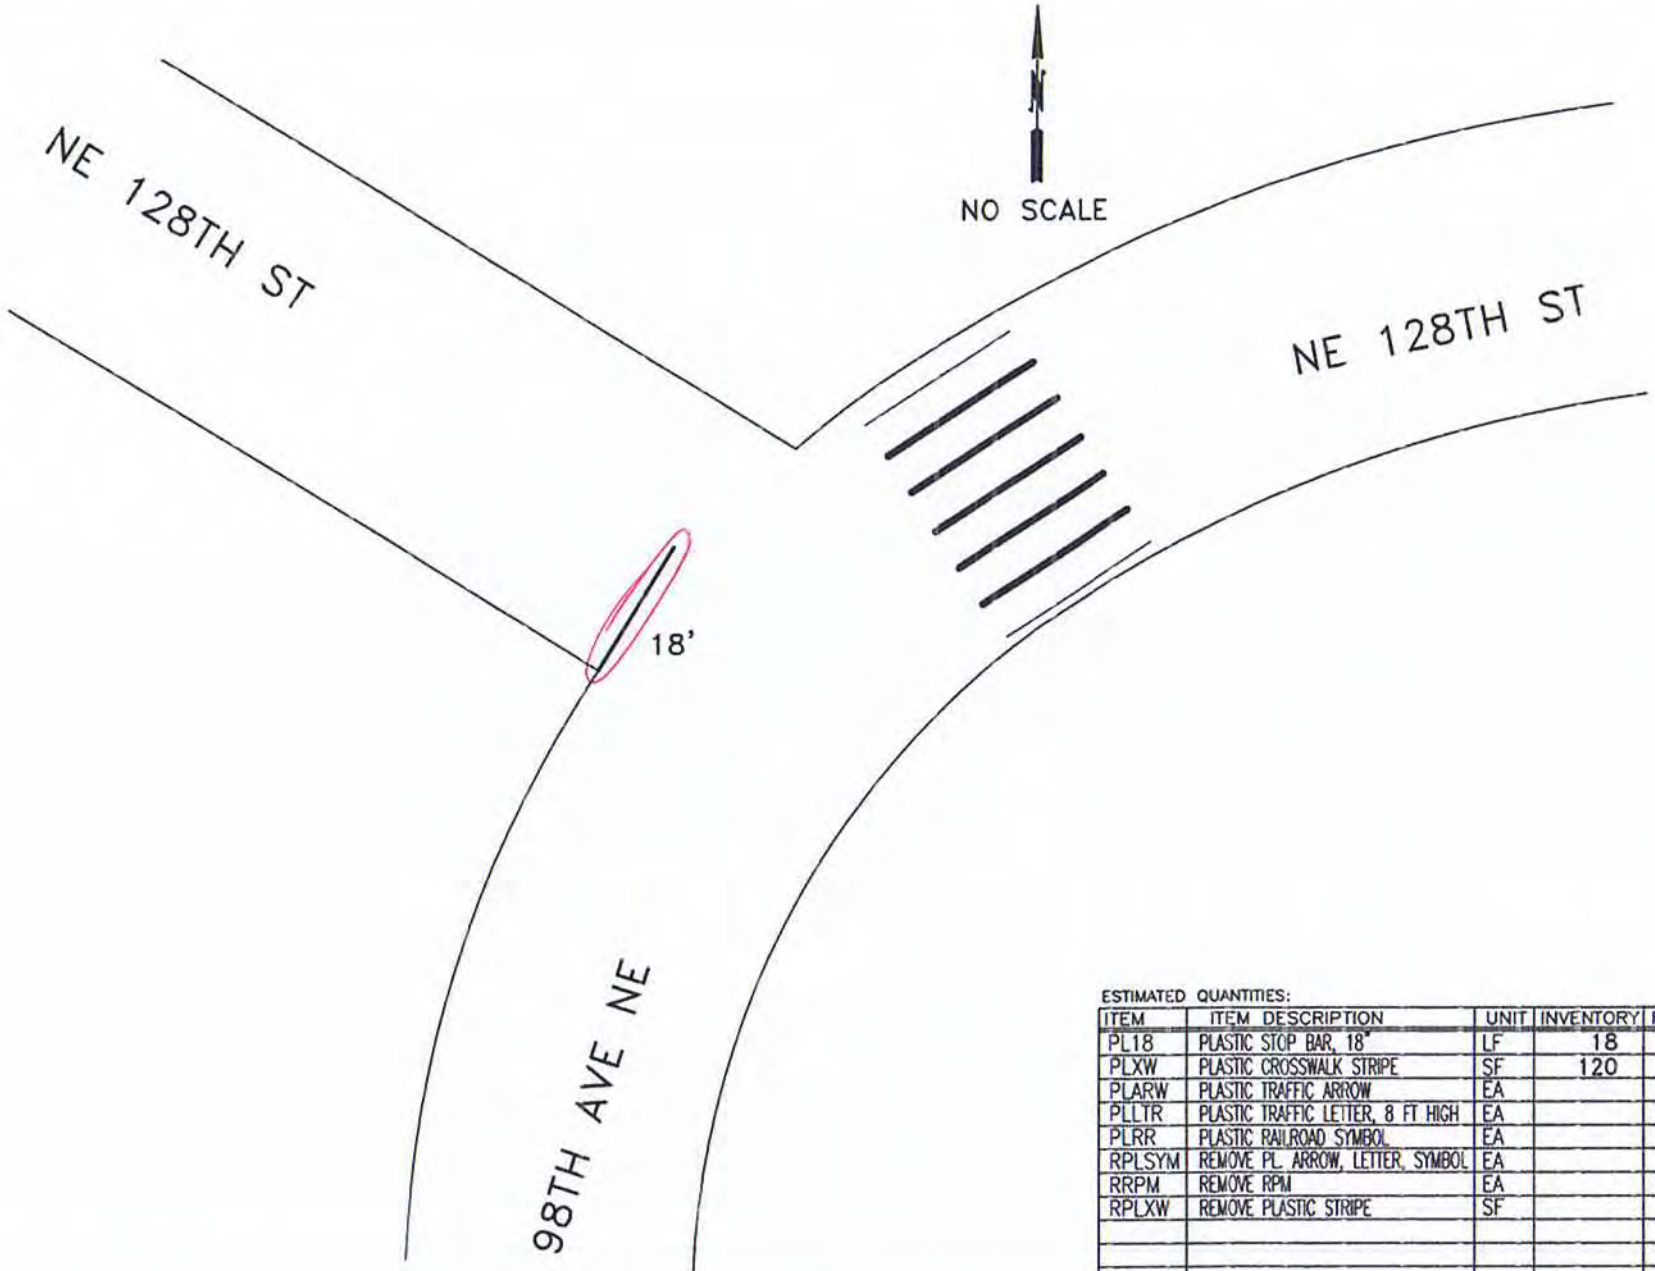

ESTIMATED QUANTITIES:

ITEM	ITEM DESCRIPTION	UNIT	INVENTORY	REPAIR QTY
PL18	PLASTIC STOP BAR, 18"	LF	18	18
PLXW	PLASTIC CROSSWALK STRIPE	SF	120	
PLARW	PLASTIC TRAFFIC ARROW	EA		
PLLTR	PLASTIC TRAFFIC LETTER, 8 FT HIGH	EA		
PLRR	PLASTIC RAILROAD SYMBOL	EA		
RPLSYM	REMOVE PL. ARROW, LETTER, SYMBOL	EA		
RRPM	REMOVE RPM	EA		
RPLXW	REMOVE PLASTIC STRIPE	SF		

CITY OF KIRKLAND
DEPARTMENT OF PUBLIC WORKS
123 FIFTH AVENUE KIRKLAND, WA 98033
(425) 587-3800 www.kirklandwa.gov

G. HORTILLOSA 3/2009
DESIGNED BY: DATE

J.JENNINGS 3/2009
DRAWN BY: DATE

CHECKED BY: DATE

2018 PAVEMENT MARKING PROGRAM

STREET: NE 128TH ST

CROSS STREET: 98TH AVE NE

SEGMENT:

SCALE: N.T.S.

FILENAME:

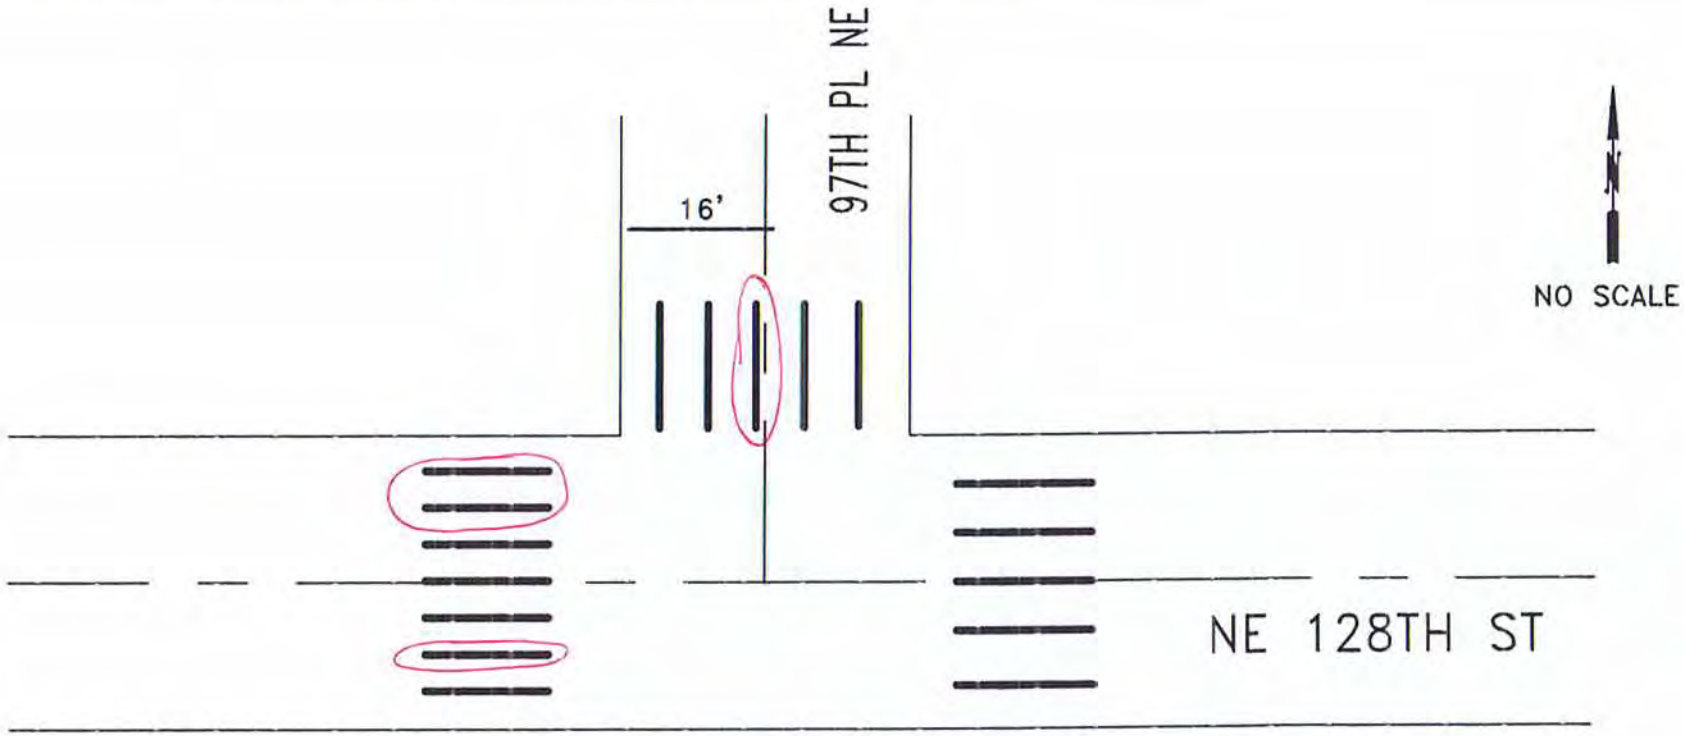

ESTIMATED QUANTITIES:

ITEM	ITEM DESCRIPTION	UNIT	INVENTORY	REPAIR QTY
PL18	PLASTIC STOP BAR, 18"	LF	16	
PLXW	PLASTIC CROSSWALK STRIPE	SF	100	80
PLARW	PLASTIC TRAFFIC ARROW	EA		
PLLTR	PLASTIC TRAFFIC LETTER, 8 FT HIGH	EA		
PLSHM	PLASTIC SPEED HUMP MARKNG	EA	1	
PLRR	PLASTIC RAILROAD SYMBOL	EA		
RPLSYM	REMOVE PL. ARROW, LETTER, SYMBOL	EA		
RRPM	REMOVE RPM	EA		
RPLXW	REMOVE PLASTIC STRIPE	SF		60

CITY OF KIRKLAND
DEPARTMENT OF PUBLIC WORKS
123 FIFTH AVENUE KIRKLAND, WA 98033
(425) 587-3800 www.kirklandwa.gov

D.GRILLEY 1/2000
DESIGNED BY: DATE

J.JENNINGS 1/2000
DRAWN BY: DATE

CHECKED BY: DATE

2022 PAVEMENT MARKING PROGRAM

STREET: NE 128TH ST

CROSS STREET: 97TH PL NE

SEGMENT:

SCALE: N.T.S.

FILENAME: page 2-17

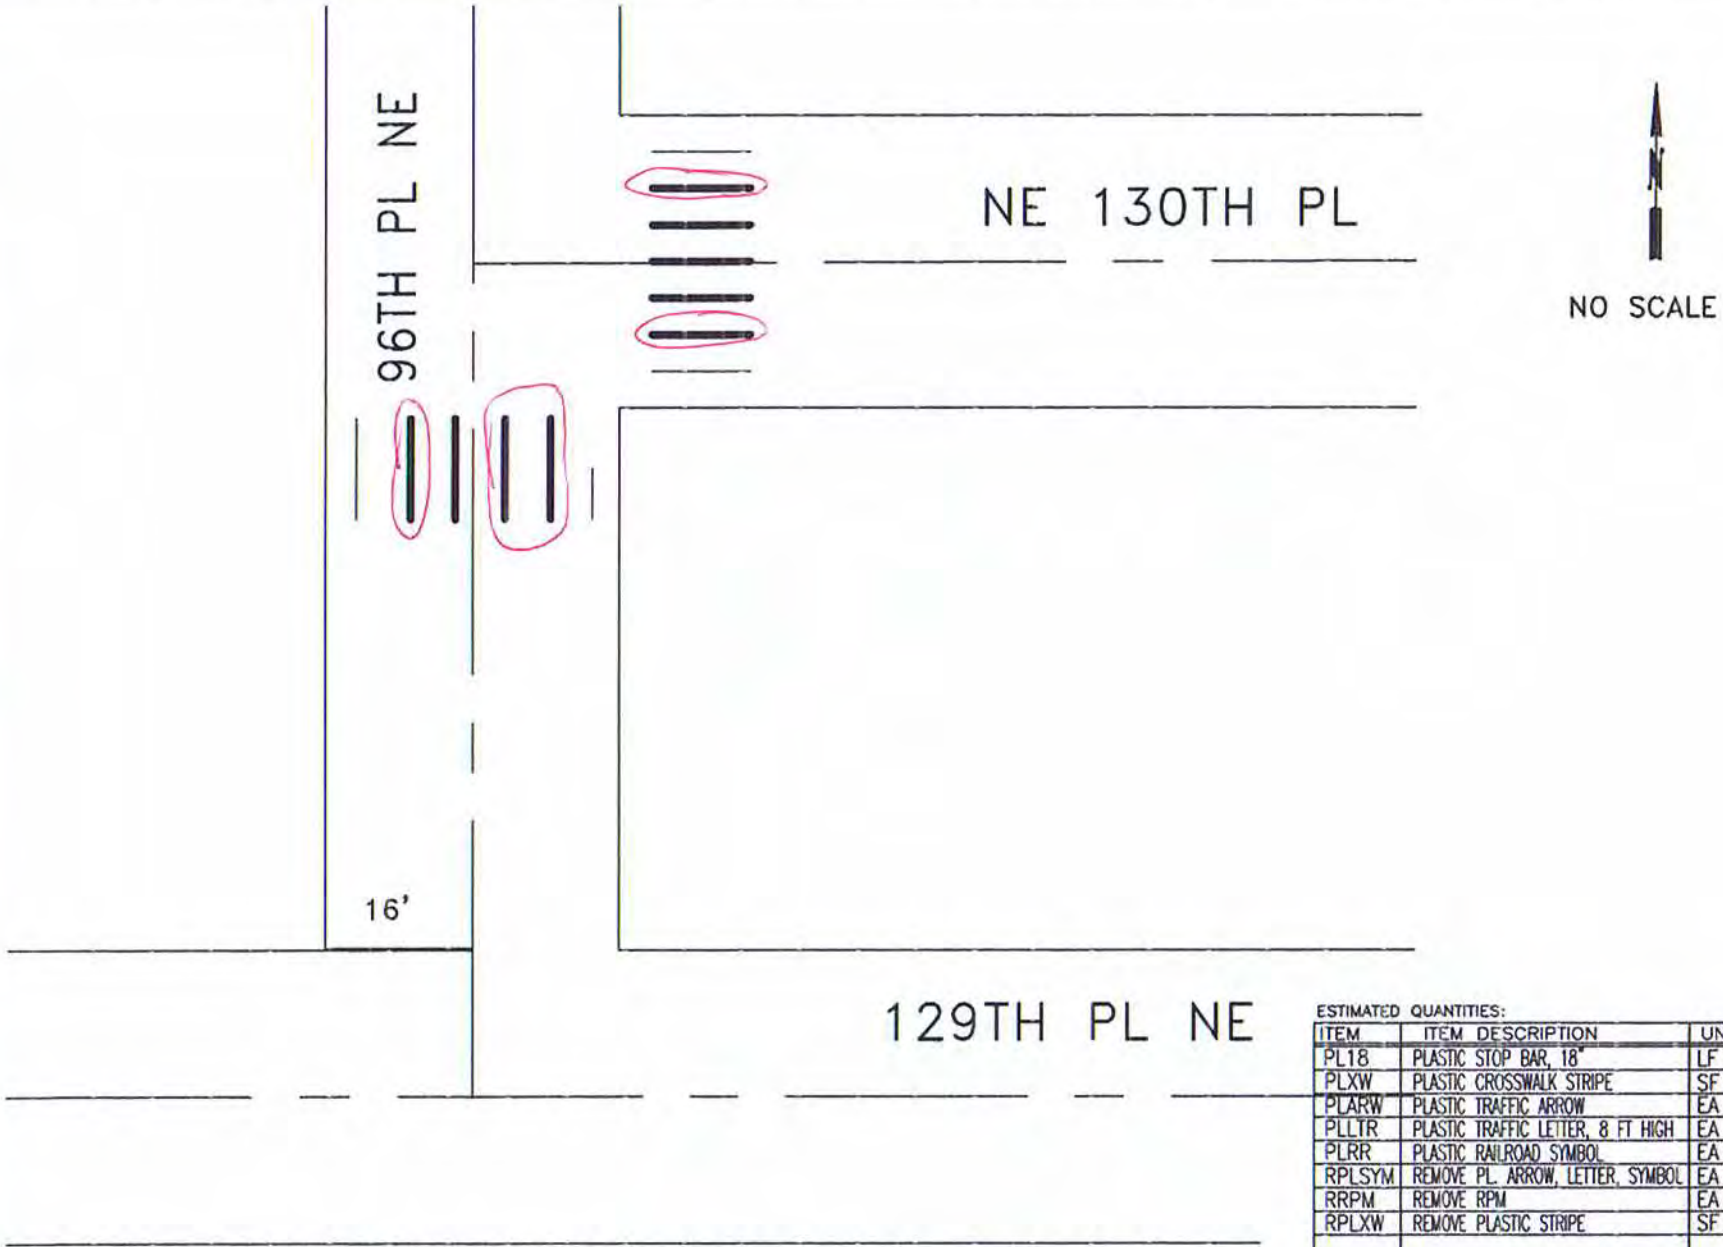

ESTIMATED QUANTITIES:

ITEM	ITEM DESCRIPTION	UNIT	INVENTORY	REPAIR QTY
PL18	PLASTIC STOP BAR, 18"	LF	16	
PLXW	PLASTIC CROSSWALK STRIPE	SF	230	100
PLARW	PLASTIC TRAFFIC ARROW	EA		
PLLTR	PLASTIC TRAFFIC LETTER, 8 FT HIGH	EA		
PLRR	PLASTIC RAILROAD SYMBOL	EA		
RPLSYM	REMOVE PL. ARROW, LETTER, SYMBOL	EA		
RRPM	REMOVE RPM	EA		
RPLXW	REMOVE PLASTIC STRIPE	SF		100

CITY OF KIRKLAND
DEPARTMENT OF PUBLIC WORKS
123 FIFTH AVENUE KIRKLAND, WA 98033
(425) 587-3800 www.kirklandwa.gov

G. HORTILLOSA 10/2011
DESIGNED BY: DATE

J.JENNINGS 10/2011
DRAWN BY: DATE

CHECKED BY: DATE

2020 PAVEMENT MARKING PROGRAM

STREET: 96TH PL NE

CROSS STREET: NE 130TH PL

SEGMENT:

SCALE: N.T.S.

FILENAME: Page 2-18

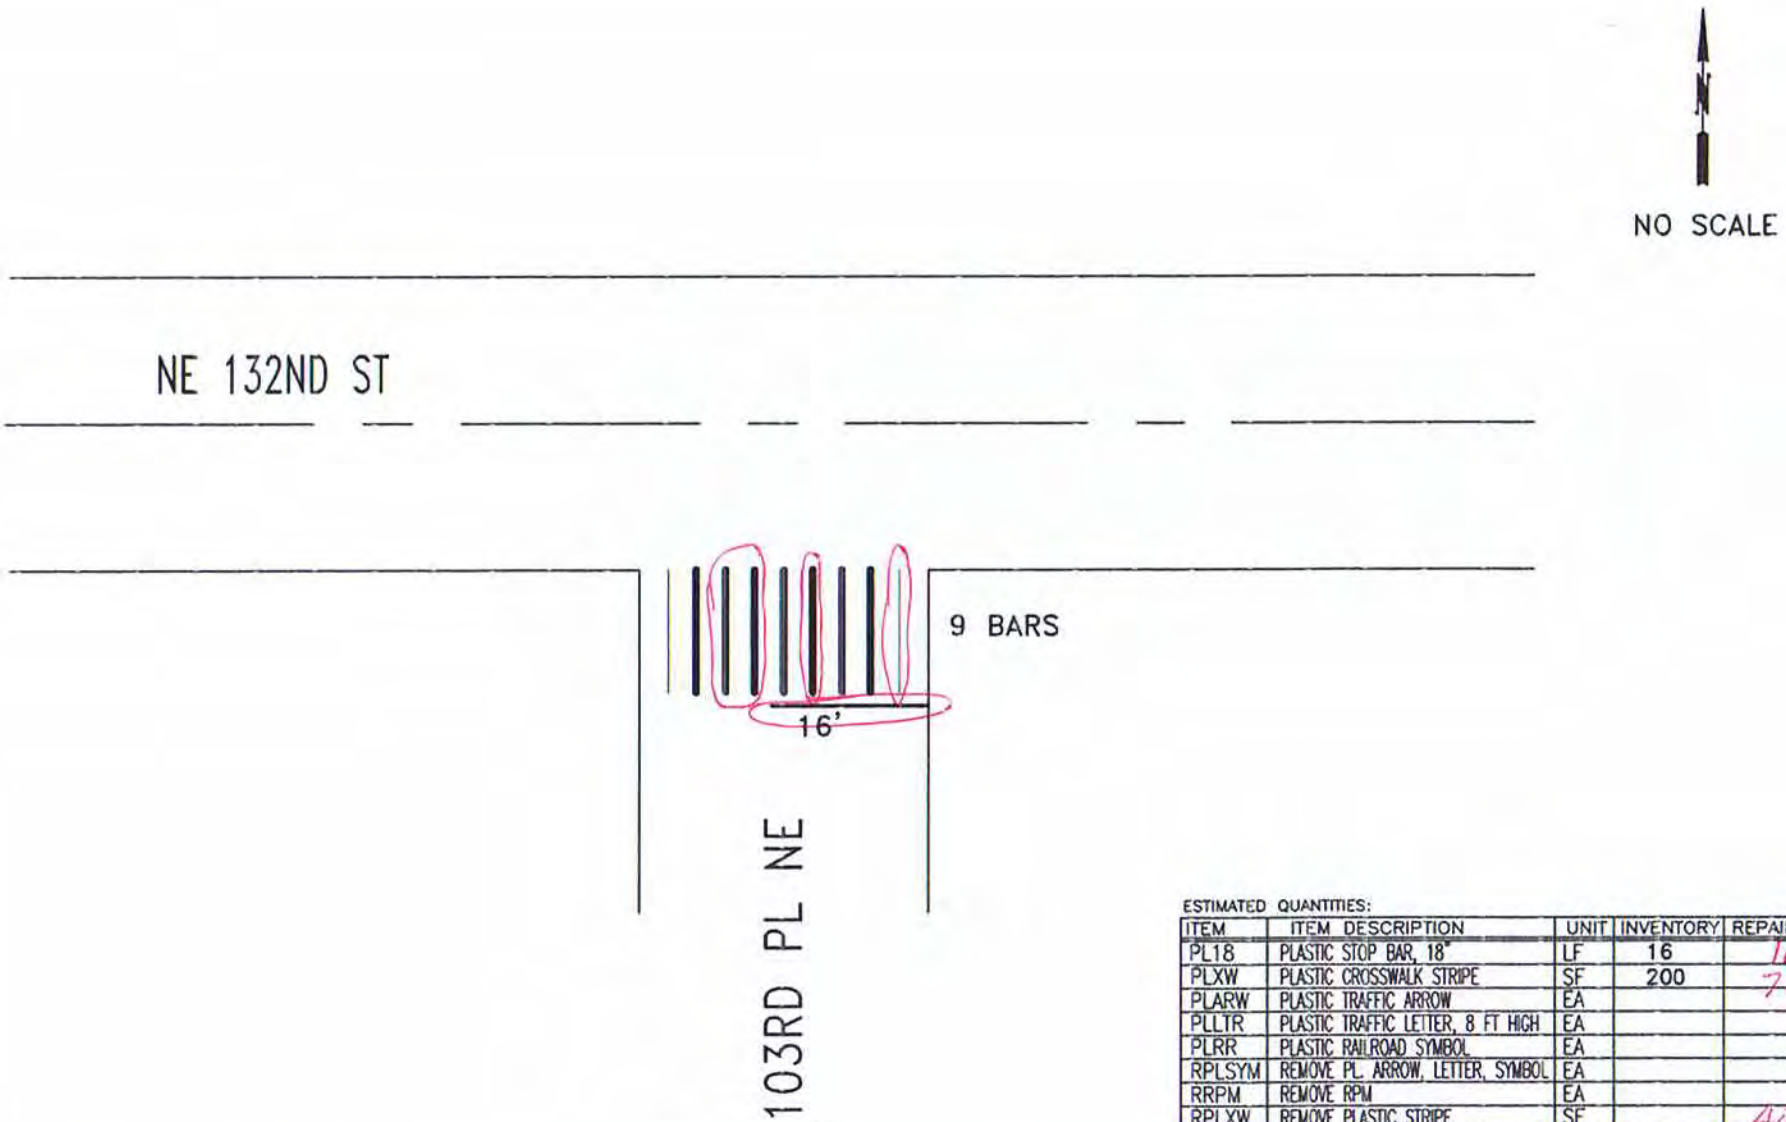

ESTIMATED QUANTITIES:

ITEM	ITEM DESCRIPTION	UNIT	INVENTORY	REPAIR QTY
PL18	PLASTIC STOP BAR, 18"	LF	16	16
PLXW	PLASTIC CROSSWALK STRIPE	SF	200	70
PLARW	PLASTIC TRAFFIC ARROW	EA		
PLLTR	PLASTIC TRAFFIC LETTER, 8 FT HIGH	EA		
PLRR	PLASTIC RAILROAD SYMBOL	EA		
RPLSYM	REMOVE PL. ARROW, LETTER, SYMBOL	EA		
RRPM	REMOVE RPM	EA		
RPLXW	REMOVE PLASTIC STRIPE	SF		40

CITY OF KIRKLAND
DEPARTMENT OF PUBLIC WORKS
123 FIFTH AVENUE KIRKLAND, WA 98033
(425) 587-3800 www.kirklandwa.gov

G. HORTILLOSA 10/2011
DESIGNED BY: DATE

J.JENNINGS 10/2011
DRAWN BY: DATE

CHECKED BY: DATE

2020 PAVEMENT MARKING PROGRAM

STREET: NE 132ND ST

CROSS STREET: 103RD PL NE

SEGMENT:

SCALE: N.T.S.

FILENAME: Page 2-19

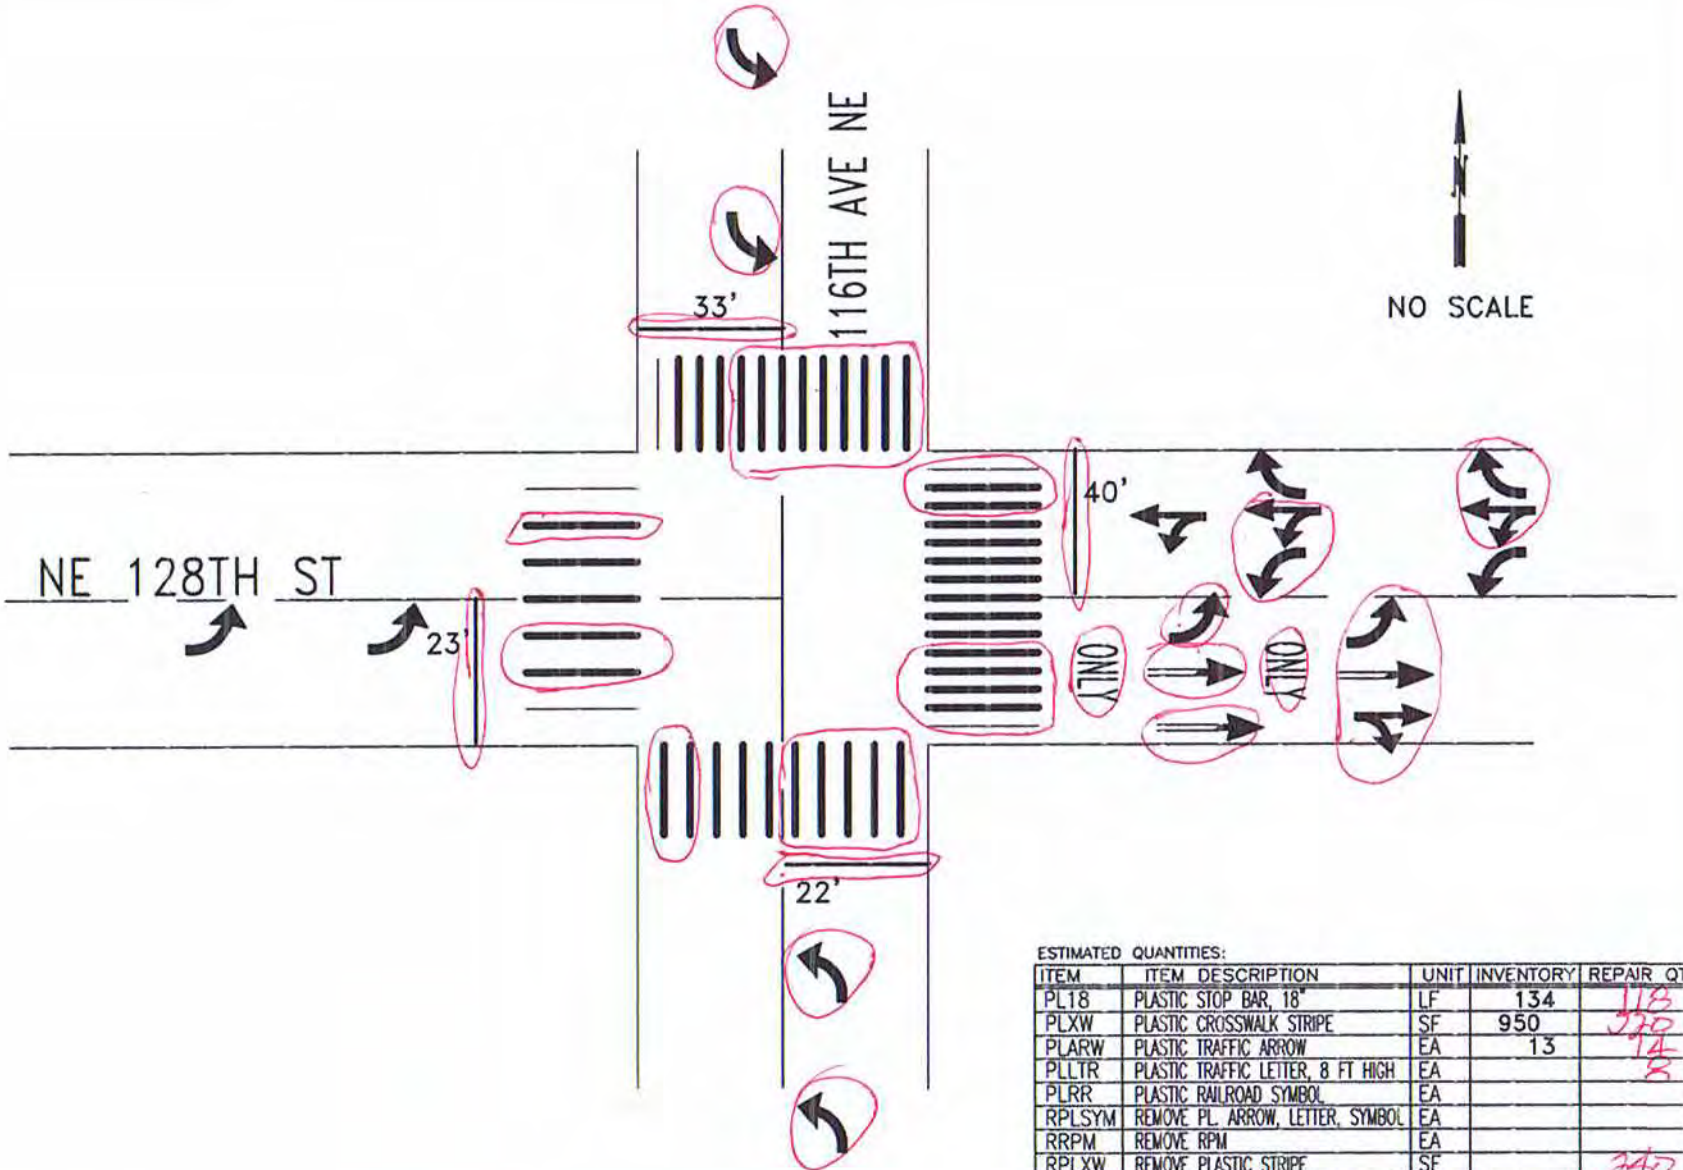

ESTIMATED QUANTITIES:

ITEM	ITEM DESCRIPTION	UNIT	INVENTORY	REPAIR QTY
PL18	PLASTIC STOP BAR, 18"	LF	134	118
PLXW	PLASTIC CROSSWALK STRIPE	SF	950	370
PLARW	PLASTIC TRAFFIC ARROW	EA	13	14
PLLTR	PLASTIC TRAFFIC LETTER, 8 FT HIGH	EA		8
PLRR	PLASTIC RAILROAD SYMBOL	EA		
RPLSYM	REMOVE PL. ARROW, LETTER, SYMBOL	EA		
RRPM	REMOVE RPM	EA		
RPLXW	REMOVE PLASTIC STRIPE	SF		340

CITY OF KIRKLAND
DEPARTMENT OF PUBLIC WORKS
123 FIFTH AVENUE KIRKLAND, WA 98033
(425) 587-3800 www.kirklandwa.gov

G. HORTILLOSA 3/2010
DESIGNED BY: DATE

J.JENNINGS 3/2010
DRAWN BY: DATE

CHECKED BY: DATE

2020 PAVEMENT MARKING PROGRAM

STREET: NE 128TH ST

CROSS STREET: 116TH AVE NE

SEGMENT:

SCALE: N.T.S.

FILENAME: Page 2-20

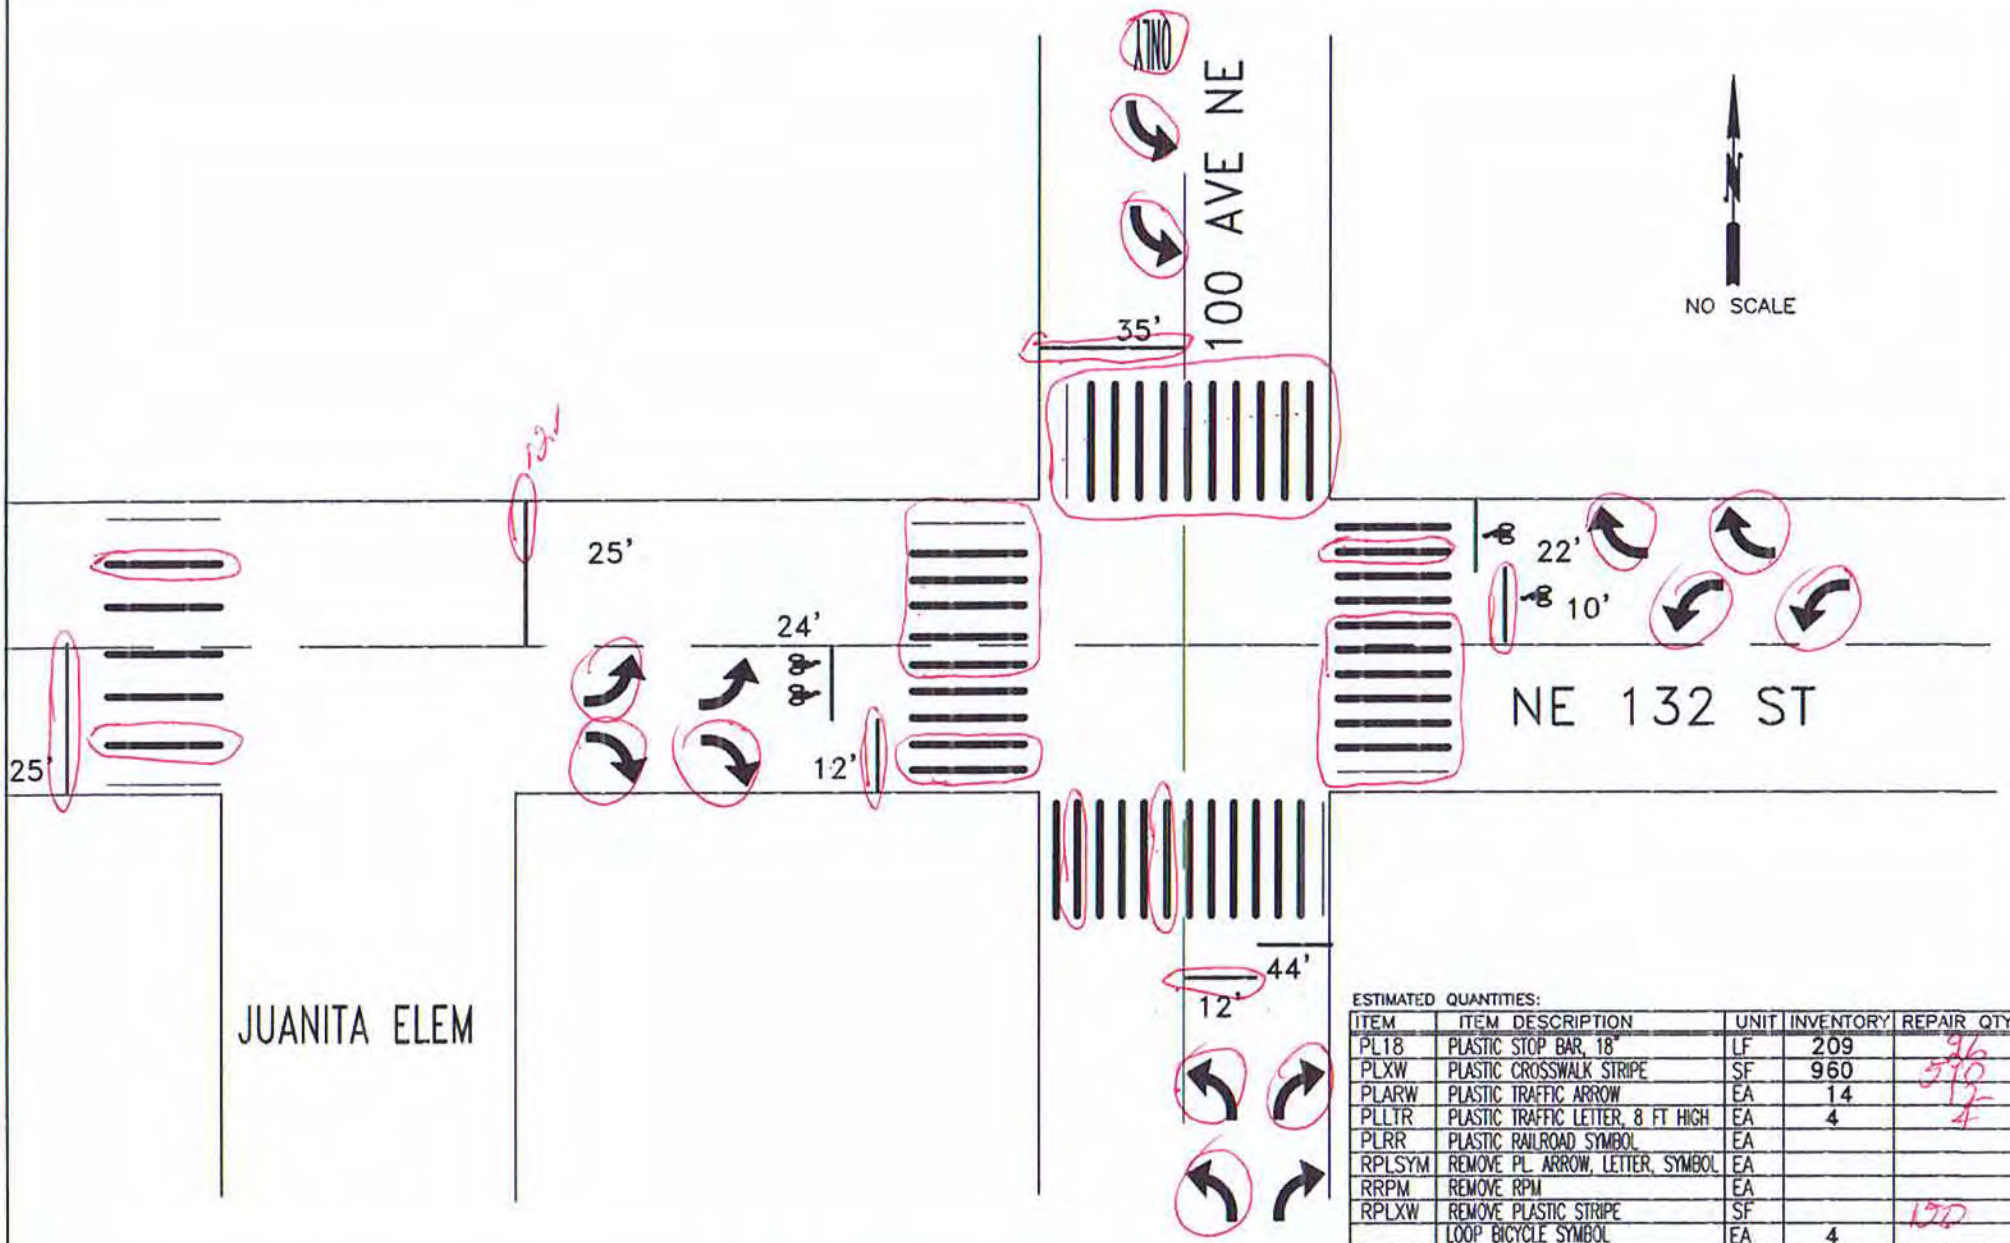

ESTIMATED QUANTITIES:

ITEM	ITEM DESCRIPTION	UNIT	INVENTORY	REPAIR QTY
PL18	PLASTIC STOP BAR, 18"	LF	209	96
PLXW	PLASTIC CROSSWALK STRIPE	SF	960	570
PLARW	PLASTIC TRAFFIC ARROW	EA	14	12
PLLTR	PLASTIC TRAFFIC LETTER, 8 FT HIGH	EA	4	4
PLRR	PLASTIC RAILROAD SYMBOL	EA		
RPLSYM	REMOVE PL. ARROW, LETTER, SYMBOL	EA		
RRPM	REMOVE RPM	EA		
RPLXW	REMOVE PLASTIC STRIPE	SF		170
	LOOP BICYCLE SYMBOL	EA	4	

CITY OF KIRKLAND WASHINGTON

CITY OF KIRKLAND
DEPARTMENT OF PUBLIC WORKS
123 FIFTH AVENUE KIRKLAND, WA 98033
(425) 587-3800 www.kirklandwa.gov

G. HORTILLOSA 2/2012
DESIGNED BY: DATE

J.JENNINGS 2/2012
DRAWN BY: DATE

CHECKED BY: DATE

2022 PAVEMENT MARKING PROGRAM

STREET: 100 AVE NE

CROSS STREET: NE 132ND STREET

SEGMENT:

SCALE: N.T.S.

FILENAME:

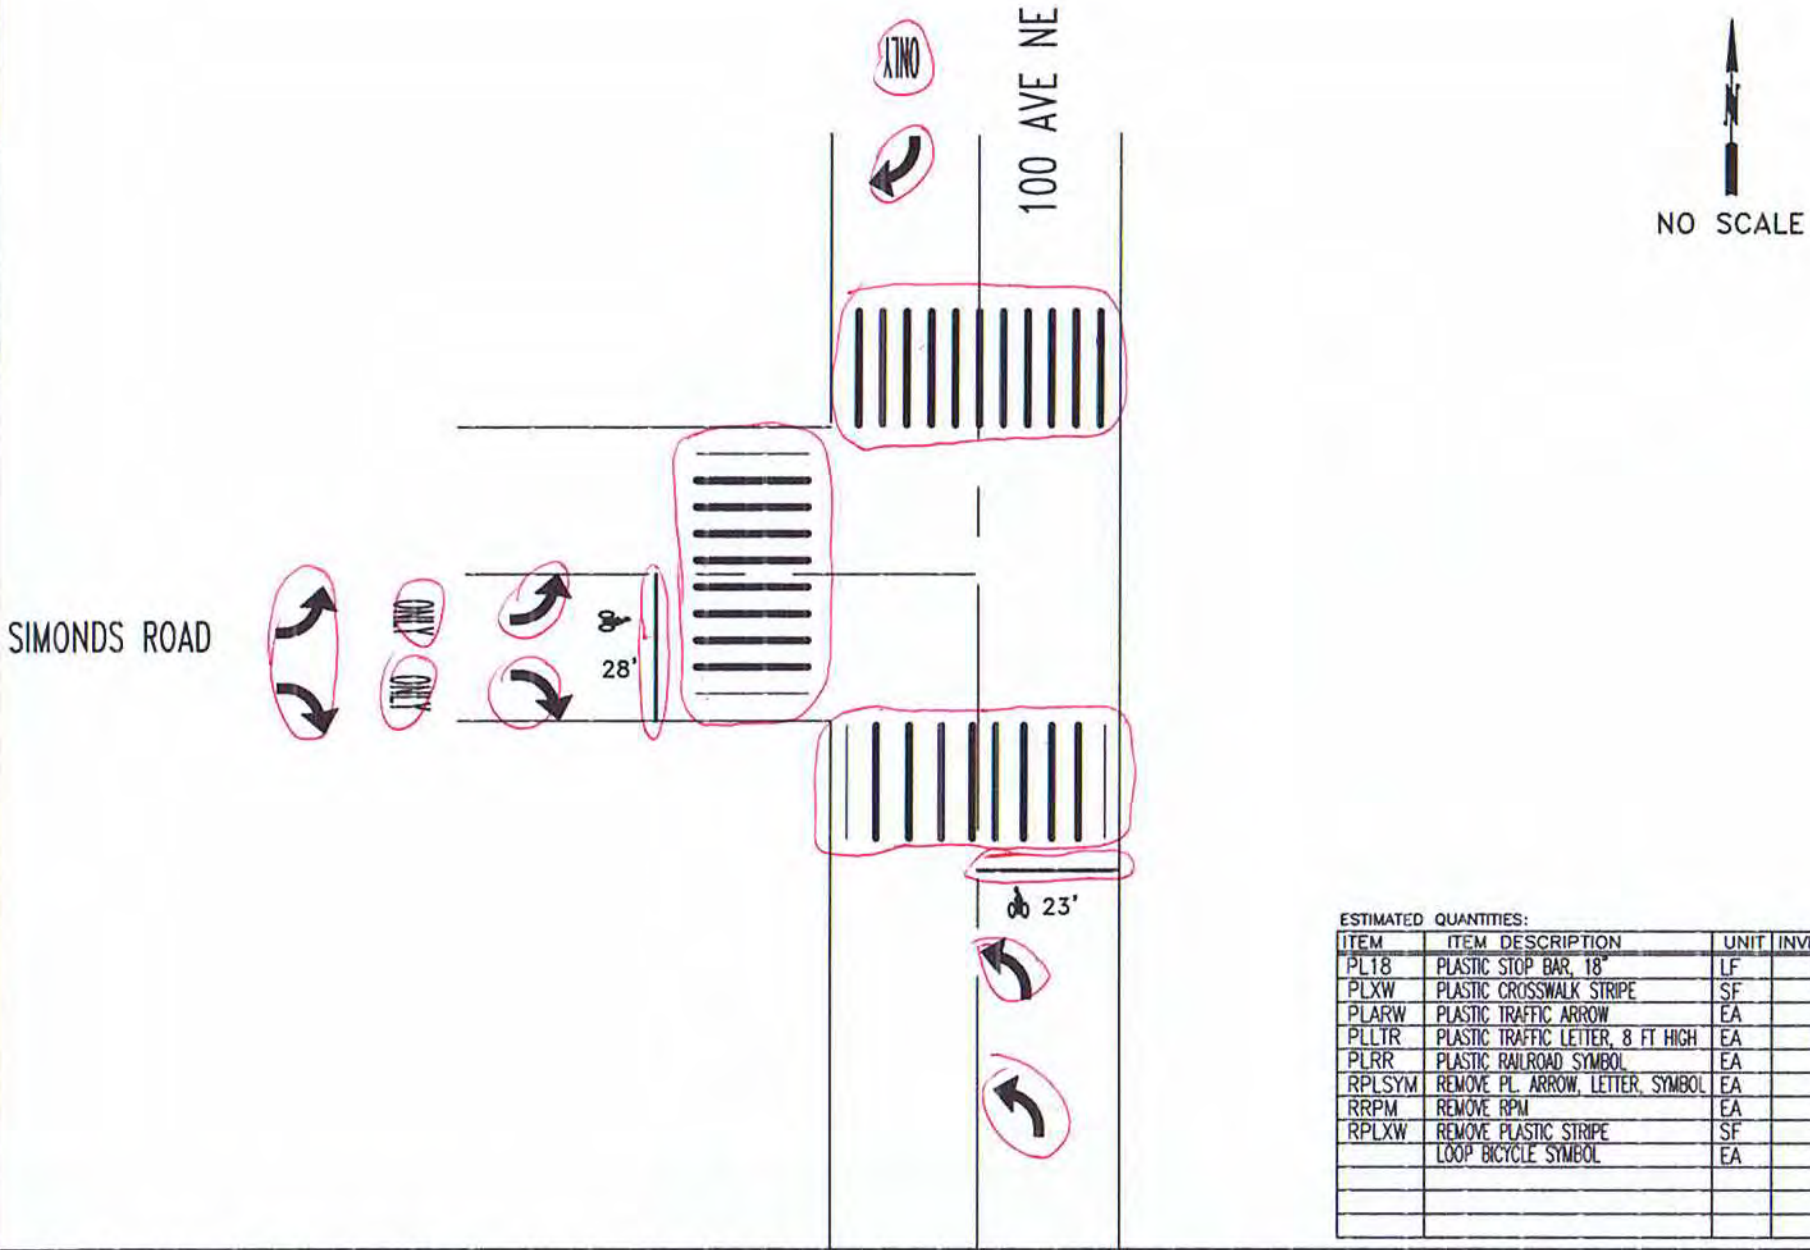

ESTIMATED QUANTITIES:

ITEM	ITEM DESCRIPTION	UNIT	INVENTORY	REPAIR QTY
PL18	PLASTIC STOP BAR, 18"	LF	54	31
PLXW	PLASTIC CROSSWALK STRIPE	SF	600	382
PLARW	PLASTIC TRAFFIC ARROW	EA	7	
PLLTR	PLASTIC TRAFFIC LETTER, 8 FT HIGH	EA	12	12
PLRR	PLASTIC RAILROAD SYMBOL	EA		
RPLSYM	REMOVE PL. ARROW, LETTER, SYMBOL	EA		
RRPM	REMOVE RPM	EA		
RPLXW	REMOVE PLASTIC STRIPE	SF		100
	LOOP BICYCLE SYMBOL	EA	2	

CITY OF KIRKLAND
DEPARTMENT OF PUBLIC WORKS
123 FIFTH AVENUE KIRKLAND, WA 98033
(425) 587-3800 www.kirklandwa.gov

G. HORTILLOSA 2/2012
DESIGNED BY: DATE

J.JENNINGS 2/2012
DRAWN BY: DATE

CHECKED BY: DATE

2012 PAVEMENT MARKING PROGRAM

STREET: 100 AVE NE

CROSS STREET: SIMONDS ROAD

SEGMENT:

SCALE: N.T.S.

SHEET: PAGE 2-22

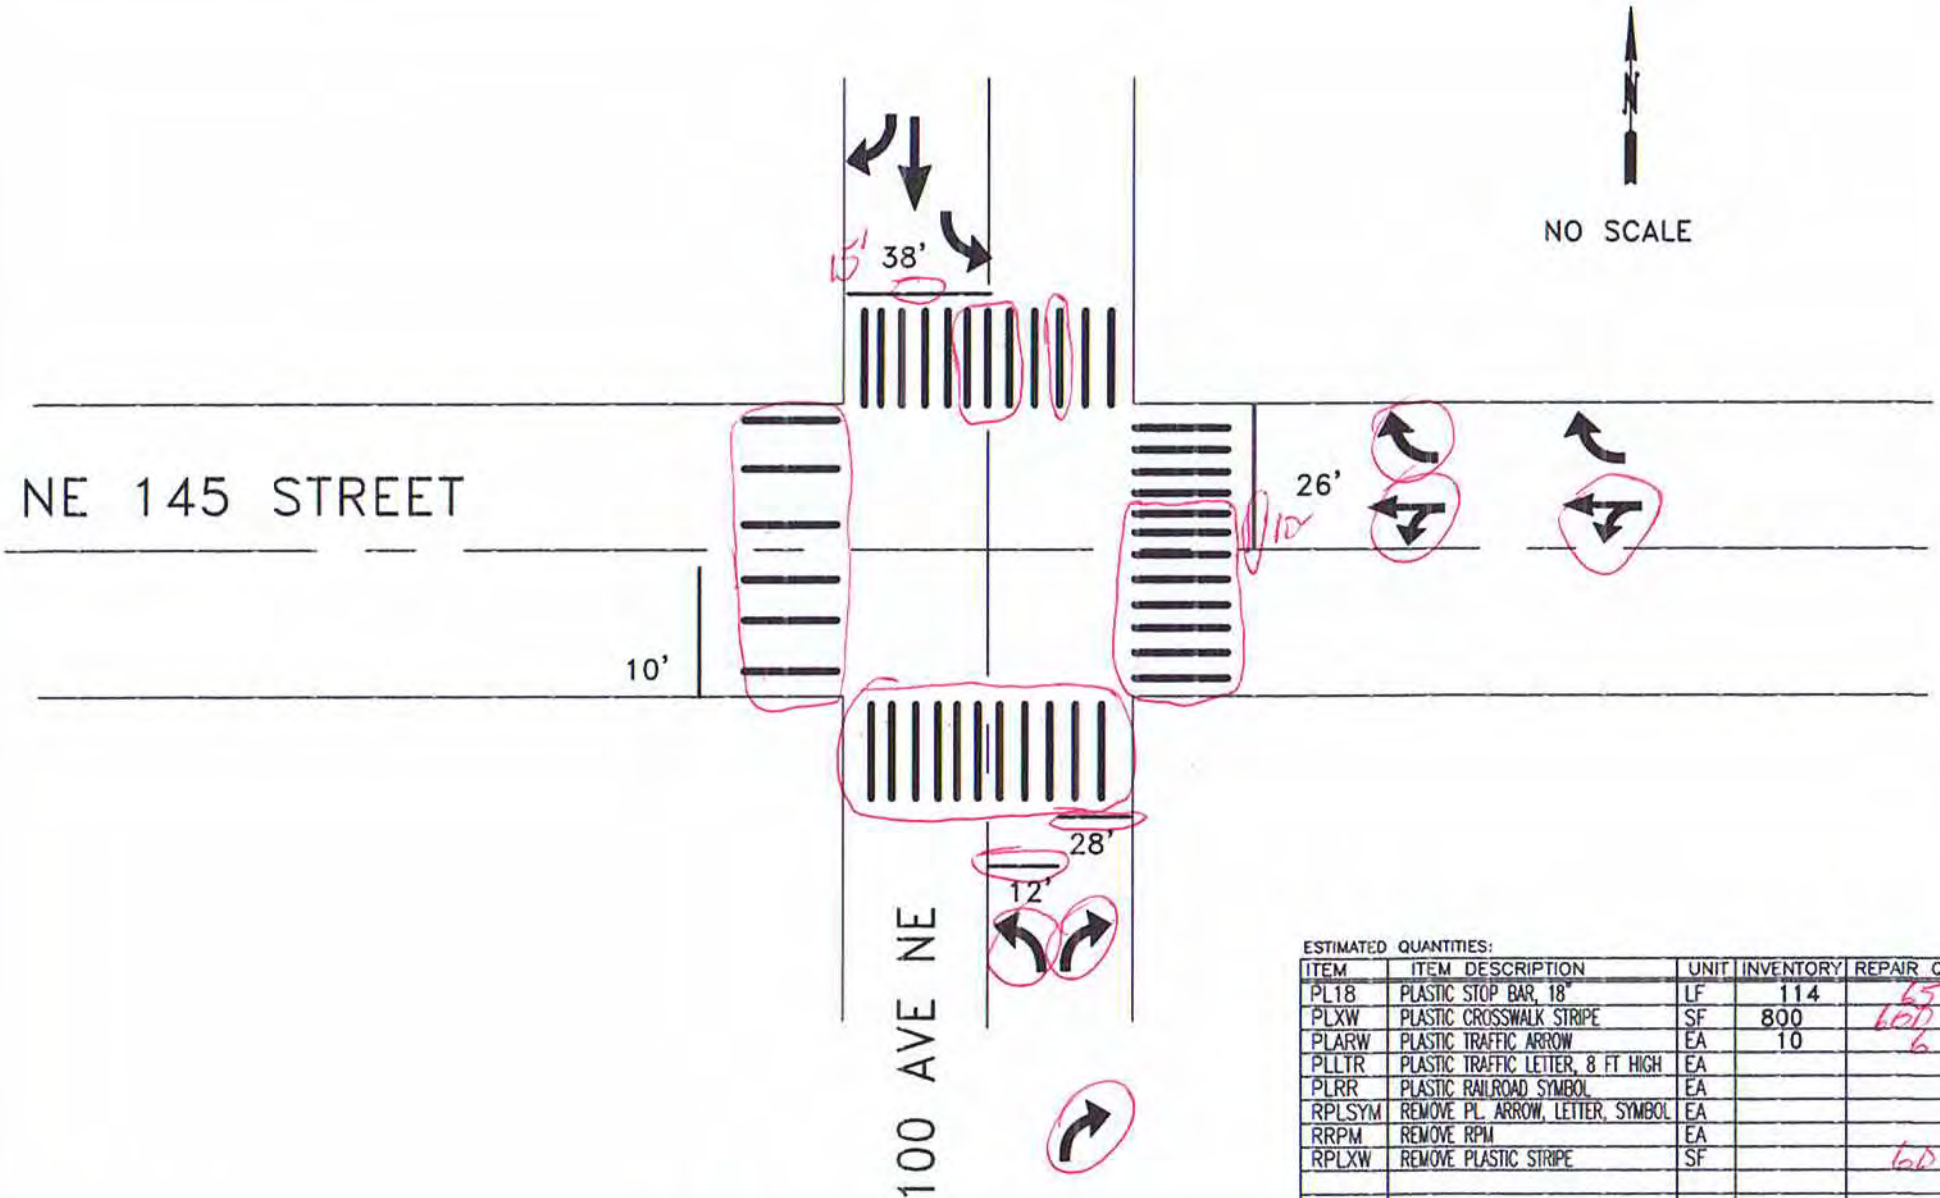

ESTIMATED QUANTITIES:

ITEM	ITEM DESCRIPTION	UNIT	INVENTORY	REPAIR QTY
PL18	PLASTIC STOP BAR, 18"	LF	114	65
PLXW	PLASTIC CROSSWALK STRIPE	SF	800	60
PLARW	PLASTIC TRAFFIC ARROW	EA	10	6
PLLTR	PLASTIC TRAFFIC LETTER, 8 FT HIGH	EA		
PLRR	PLASTIC RAILROAD SYMBOL	EA		
RPLSYM	REMOVE PL. ARROW, LETTER, SYMBOL	EA		
RRPM	REMOVE RPM	EA		
RPLXW	REMOVE PLASTIC STRIPE	SF		60

CITY OF KIRKLAND
DEPARTMENT OF PUBLIC WORKS
123 FIFTH AVENUE KIRKLAND, WA 98033
(425) 587-3800 www.kirklandwa.gov

G. HORTILLOSA 2/2012
DESIGNED BY: DATE

J.JENNINGS 2/2012
DRAWN BY: DATE

CHECKED BY: DATE

2020 PAVEMENT MARKING PROGRAM

STREET: 100 AVE NE

CROSS STREET: NE 145TH STREET

SEGMENT:

SCALE: N.T.S.

FILENAME:

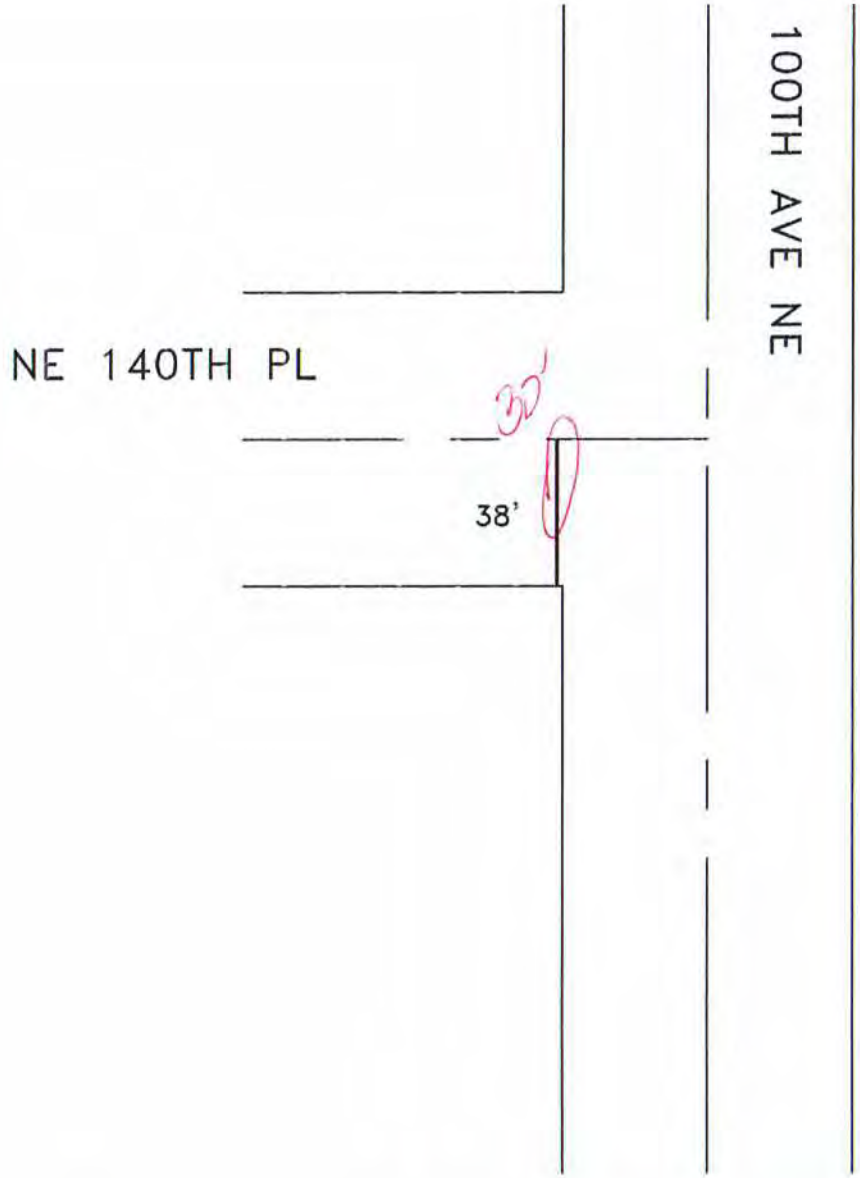

NO SCALE

ESTIMATED QUANTITIES:

ITEM	ITEM DESCRIPTION	UNIT	INVENTORY	REPAIR QTY
PL18	PLASTIC STOP BAR, 18"	LF	38	35
PLXW	PLASTIC CROSSWALK STRIPE	SF		
PLARW	PLASTIC TRAFFIC ARROW	EA		
PLLTR	PLASTIC TRAFFIC LETTER, 8 FT HIGH	EA		
PLRR	PLASTIC RAILROAD SYMBOL	EA		
RPLSYM	REMOVE PL. ARROW, LETTER, SYMBOL	EA		
RRPM	REMOVE RPM	EA		
RPLXW	REMOVE PLASTIC STRIPE	SF		

CITY OF KIRKLAND
DEPARTMENT OF PUBLIC WORKS
123 FIFTH AVENUE KIRKLAND, WA 98033
(425) 587-3800 www.kirklandwa.gov

L. KAWAOKA 3/2017
DESIGNED BY: DATE

J.JENNINGS 3/2017
DRAWN BY: DATE

CHECKED BY: DATE

2032 PAVEMENT MARKING PROGRAM

STREET: 100TH AVE NE

CROSS STREET: NE 140TH PL

SEGMENT:

SCALE: N.T.S.

FILENAME: Page 2-23A

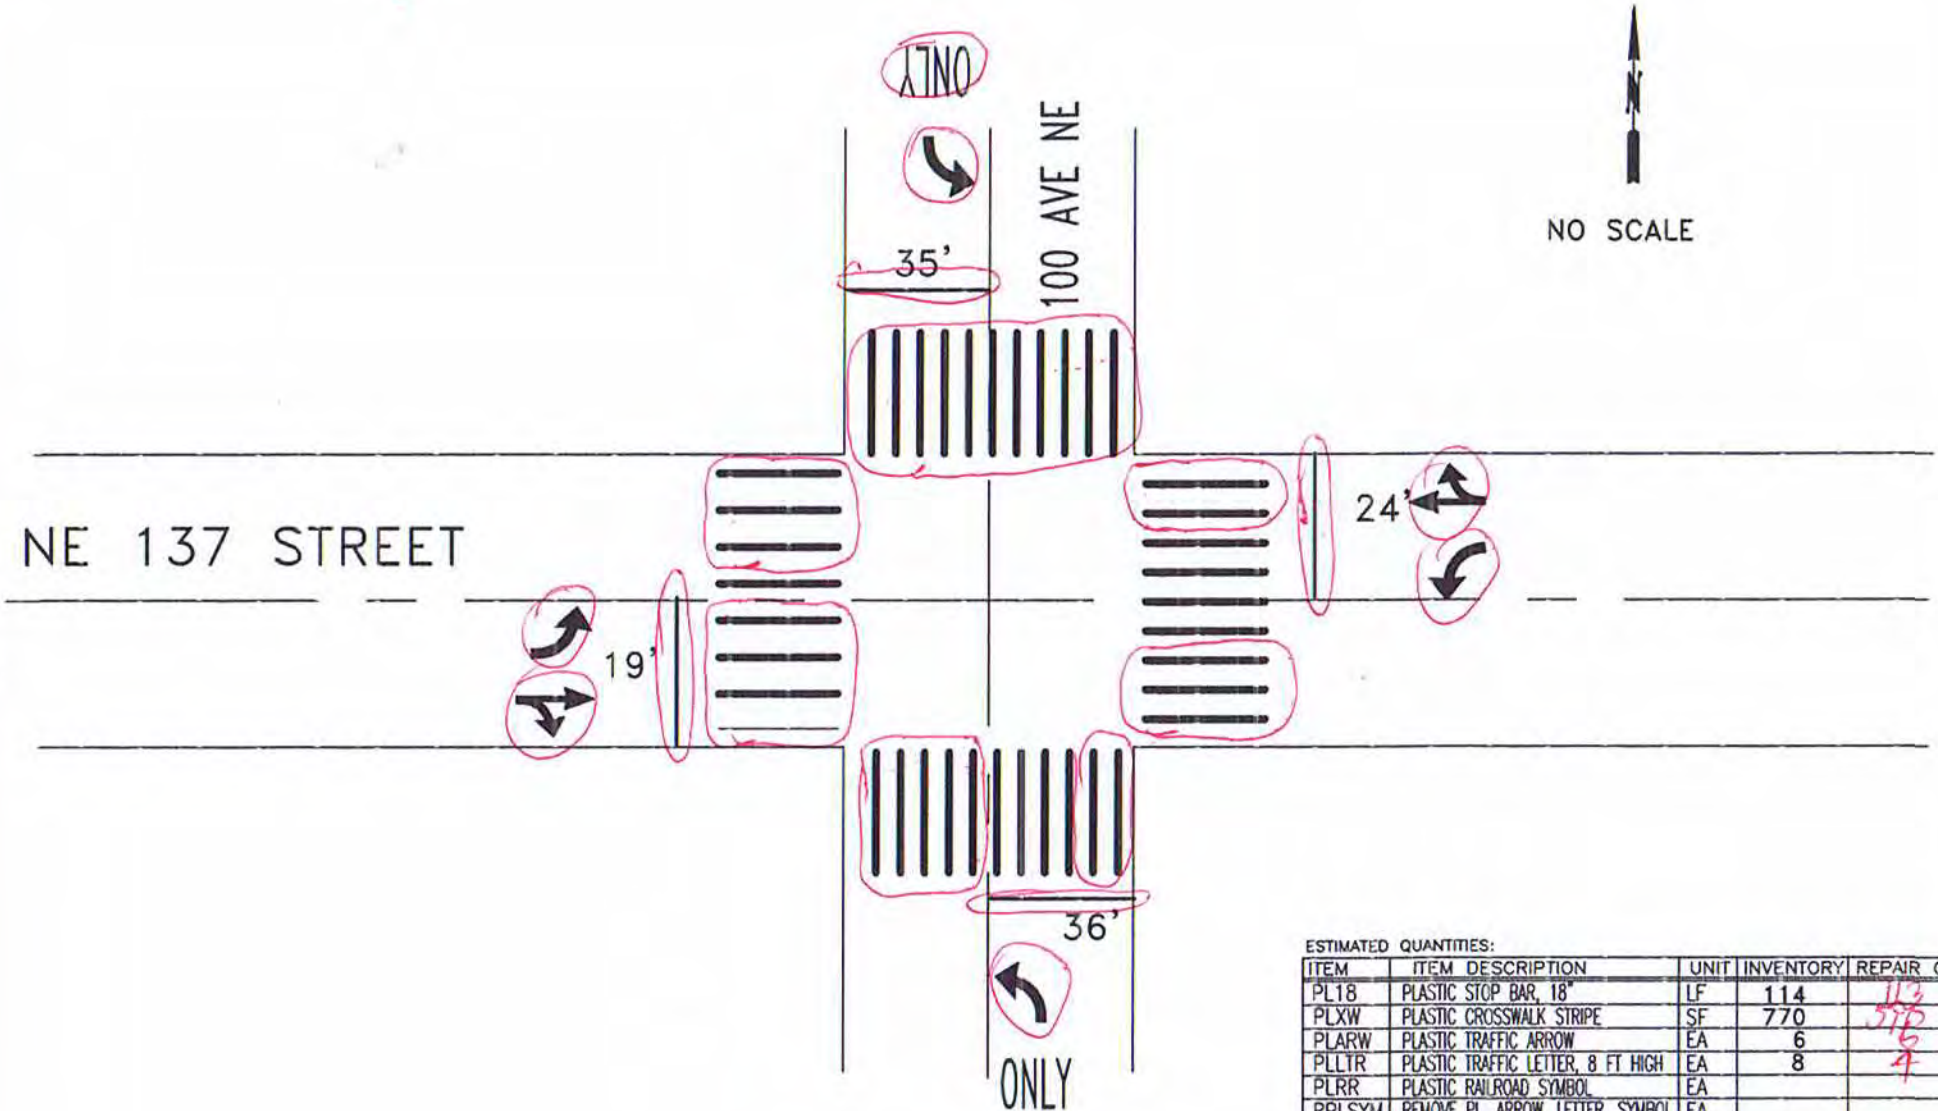

ESTIMATED QUANTITIES:

ITEM	ITEM DESCRIPTION	UNIT	INVENTORY	REPAIR QTY
PL18	PLASTIC STOP BAR, 18"	LF	114	113
PLXW	PLASTIC CROSSWALK STRIPE	SF	770	576
PLARW	PLASTIC TRAFFIC ARROW	EA	6	6
PLLTR	PLASTIC TRAFFIC LETTER, 8 FT HIGH	EA	8	4
PLRR	PLASTIC RAILROAD SYMBOL	EA		
RPLSYM	REMOVE PL. ARROW, LETTER, SYMBOL	EA		
RRPM	REMOVE RPM	EA		
RPLXW	REMOVE PLASTIC STRIPE	SF		500

CITY OF KIRKLAND WASHINGTON

CITY OF KIRKLAND
DEPARTMENT OF PUBLIC WORKS
123 FIFTH AVENUE KIRKLAND, WA 98033
(425) 587-3800 www.kirklandwa.gov

G. HORTILLOSA 2/2012
DESIGNED BY: DATE

J.JENNINGS 2/2012
DRAWN BY: DATE

CHECKED BY: DATE

2012 PAVEMENT MARKING PROGRAM

STREET: 100 AVE NE

CROSS STREET: NE 137 STREET

SEGMENT:

SCALE: N.T.S.

FILENAME: Page 2-24

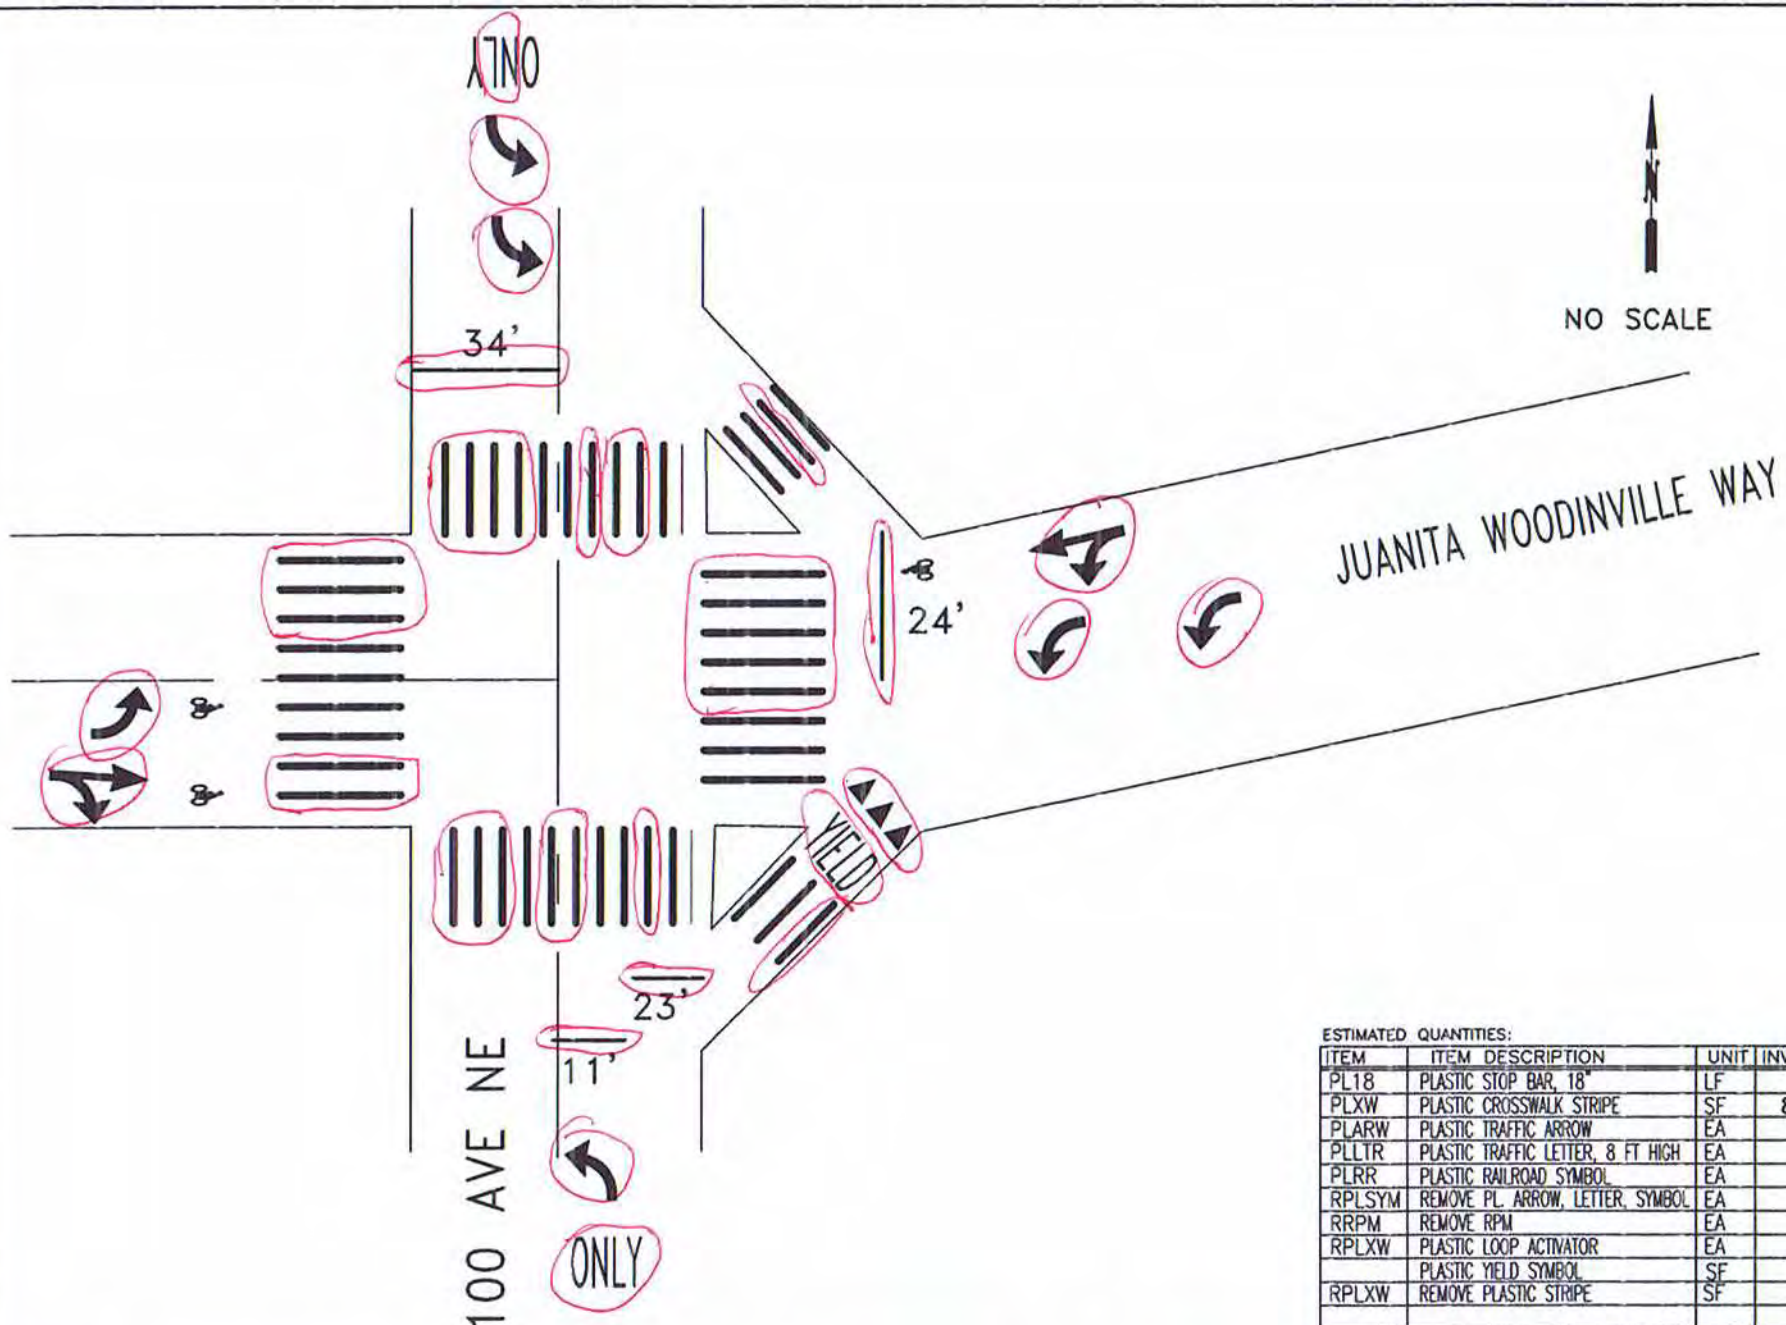

ESTIMATED QUANTITIES:

ITEM	ITEM DESCRIPTION	UNIT	INVENTORY	REPAIR QTY
PL18	PLASTIC STOP BAR, 18"	LF	92	92
PLXW	PLASTIC CROSSWALK STRIPE	SF	870	305
PLARW	PLASTIC TRAFFIC ARROW	EA	8	8
PLLTR	PLASTIC TRAFFIC LETTER, 8 FT HIGH	EA	13	9
PLRR	PLASTIC RAILROAD SYMBOL	EA		
RPLSYM	REMOVE PL. ARROW, LETTER, SYMBOL	EA		2
RRPM	REMOVE RPM	EA		
RPLXW	PLASTIC LOOP ACTIVATOR	EA	8	
	PLASTIC YIELD SYMBOL	SF	14	14
RPLXW	REMOVE PLASTIC STRIPE	SF		2410

CITY OF KIRKLAND
DEPARTMENT OF PUBLIC WORKS
123 FIFTH AVENUE KIRKLAND, WA 98033
(425) 587-3800 www.kirklandwa.gov

L. KAWAOKA 3/2016
DESIGNED BY: DATE

J.JENNINGS 3/2016
DRAWN BY: DATE

CHECKED BY: DATE

2022 PAVEMENT MARKING PROGRAM

STREET: 100 AVE NE

CROSS STREET: JUANITA WOODINVILLE WAY

SEGMENT:

SCALE: N.T.S.

FILENAME: Page 2-25

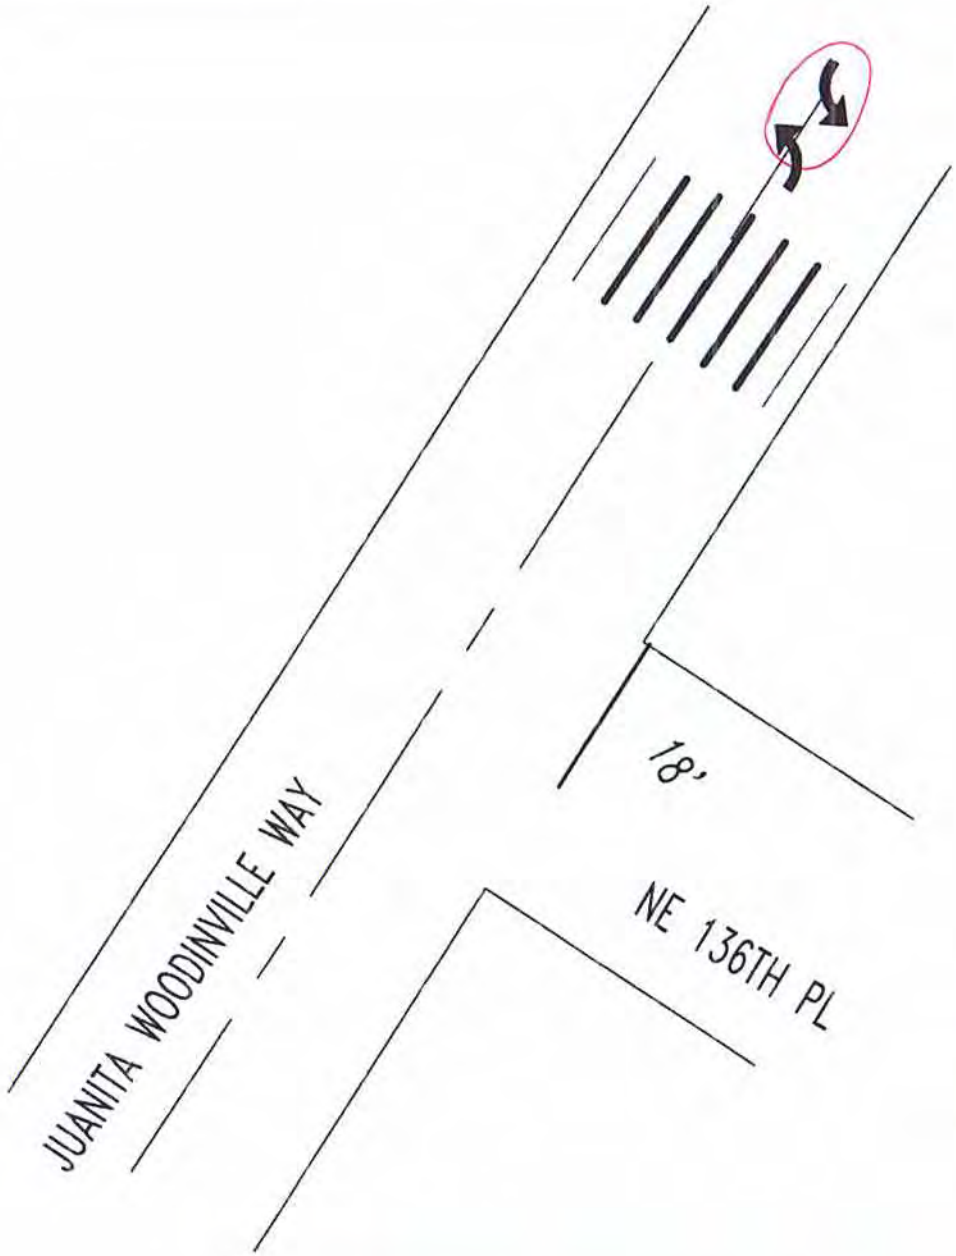

NO SCALE

ESTIMATED QUANTITIES:

ITEM	ITEM DESCRIPTION	UNIT	INVENTORY	REPAIR QTY
PL18	PLASTIC STOP BAR, 18"	LF	18	
PLXW	PLASTIC CROSSWALK STRIPE	SF	120	
PLARW	PLASTIC TRAFFIC ARROW	EA	2	2
PLLTR	PLASTIC TRAFFIC LETTER, 8 FT HIGH	EA		
PLRR	PLASTIC RAILROAD SYMBOL	EA		
RPLSYM	REMOVE PL. ARROW, LETTER, SYMBOL	EA		
RRPM	REMOVE RPM	EA		
RPLXW	REMOVE PLASTIC STRIPE	SF		

CITY OF KIRKLAND
DEPARTMENT OF PUBLIC WORKS
123 FIFTH AVENUE KIRKLAND, WA 98033
(425) 587-3800 www.kirklandwa.gov

G. HORTILLOSA 2/2012
DESIGNED BY: DATE

J.JENNINGS 2/2012
DRAWN BY: DATE

CHECKED BY: DATE

2020 PAVEMENT MARKING PROGRAM

STREET: JUANITA WOODINVILLE WAY

CROSS STREET: NE 136TH PL

SEGMENT:

SCALE: N.T.S.

FILENAME: Page 2-26

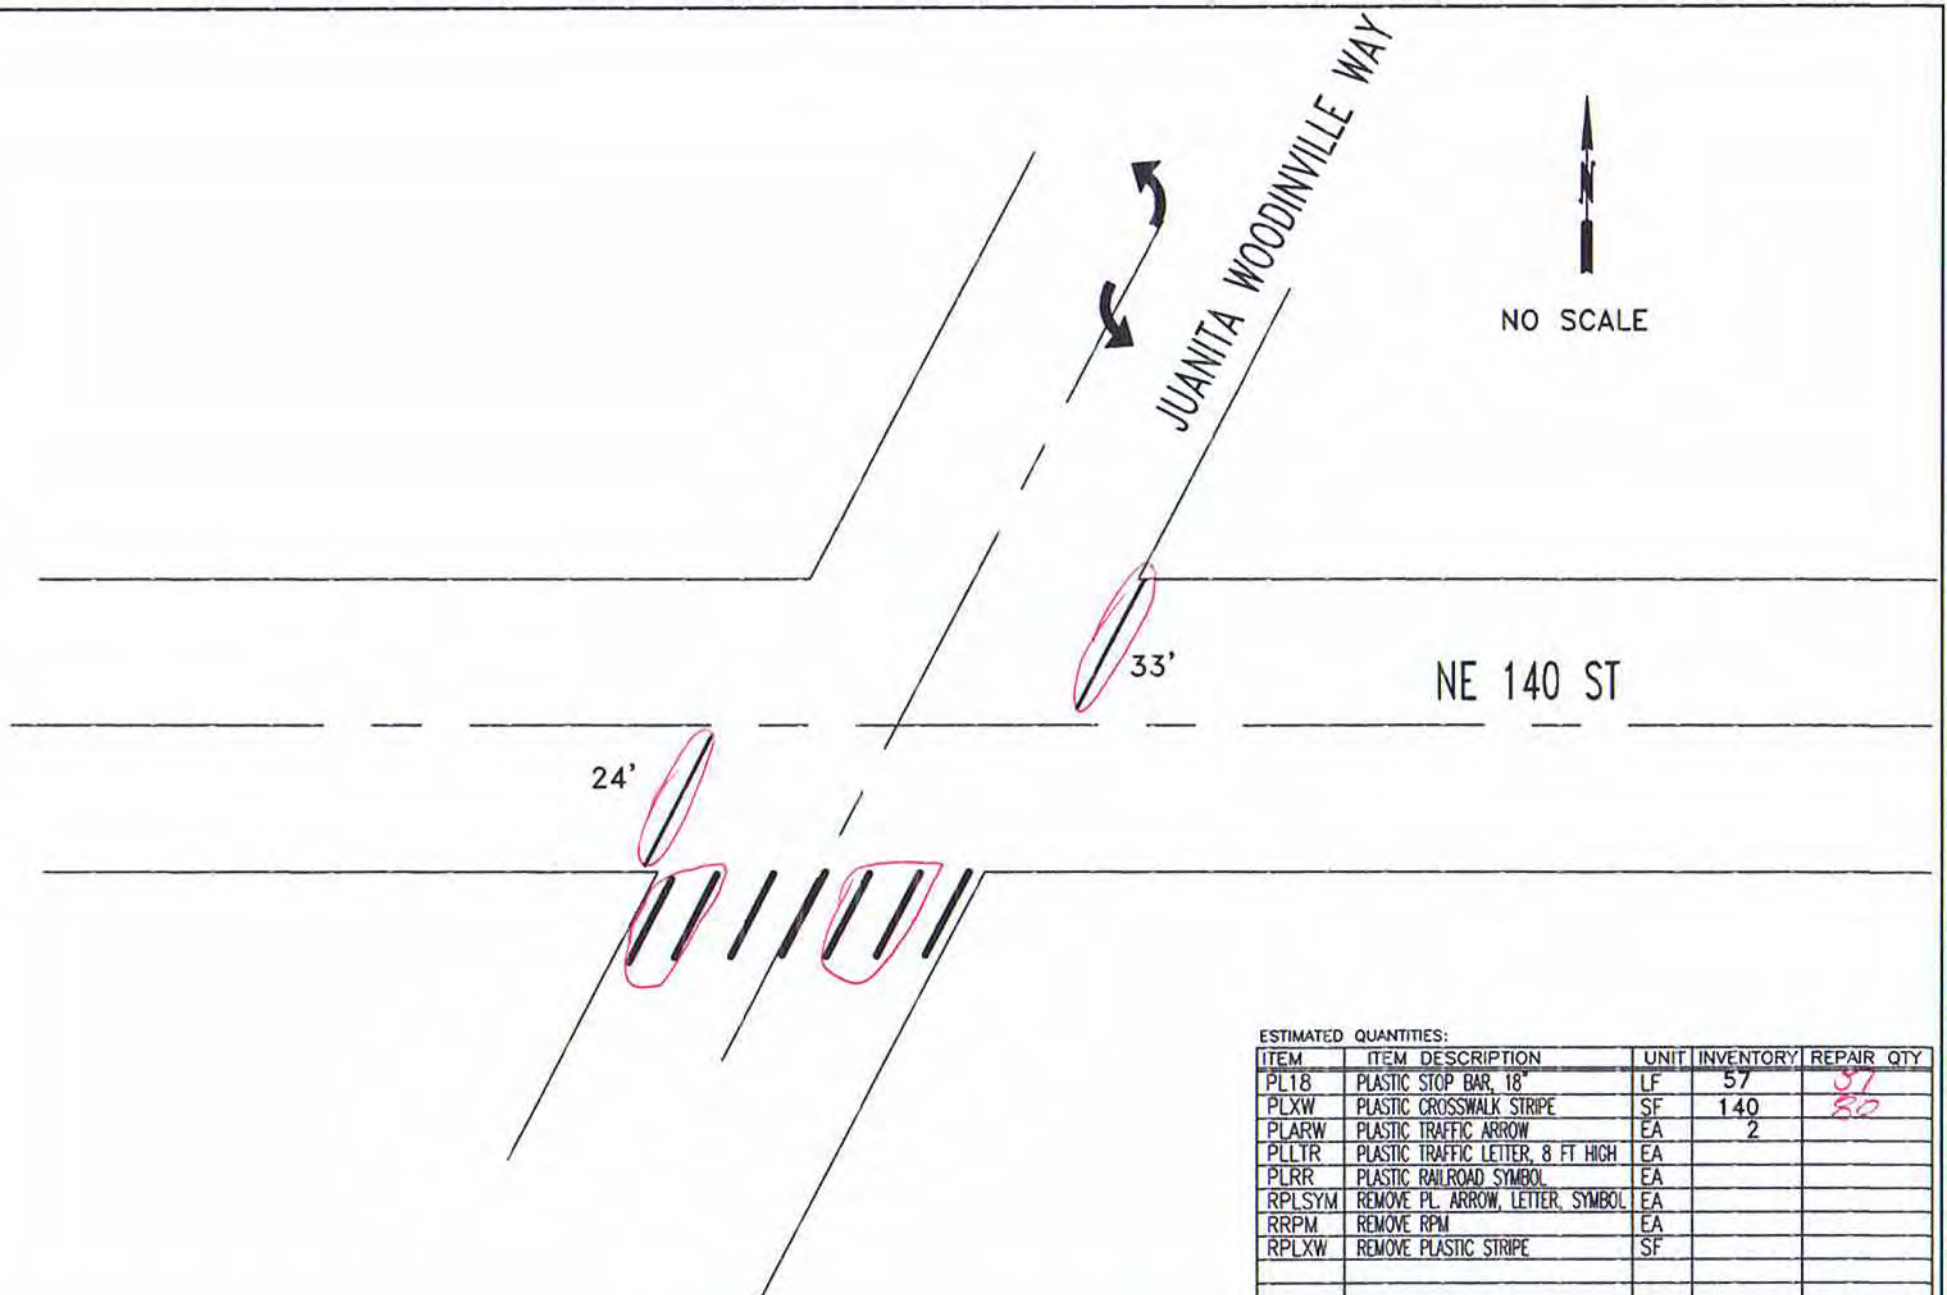

ESTIMATED QUANTITIES:

ITEM	ITEM DESCRIPTION	UNIT	INVENTORY	REPAIR QTY
PL18	PLASTIC STOP BAR, 18"	LF	57	57
PLXW	PLASTIC CROSSWALK STRIPE	SF	140	80
PLARW	PLASTIC TRAFFIC ARROW	EA	2	
PLLTR	PLASTIC TRAFFIC LETTER, 8 FT HIGH	EA		
PLRR	PLASTIC RAILROAD SYMBOL	EA		
RPLSYM	REMOVE PL. ARROW, LETTER, SYMBOL	EA		
RRPM	REMOVE RPM	EA		
RPLXW	REMOVE PLASTIC STRIPE	SF		

CITY OF KIRKLAND
DEPARTMENT OF PUBLIC WORKS
123 FIFTH AVENUE KIRKLAND, WA 98033
(425) 587-3800 www.kirklandwa.gov

G. HORTILLOSA 8/2013
DESIGNED BY: DATE

J.JENNINGS 10/2009
DRAWN BY: DATE

CHECKED BY: DATE

2020 PAVEMENT MARKING PROGRAM

STREET: JUANITA WOODINVILLE WAY

CROSS STREET: NE 140 ST

SEGMENT: 30-#20

SCALE: N.T.S.

FILENAME: Page 2-28

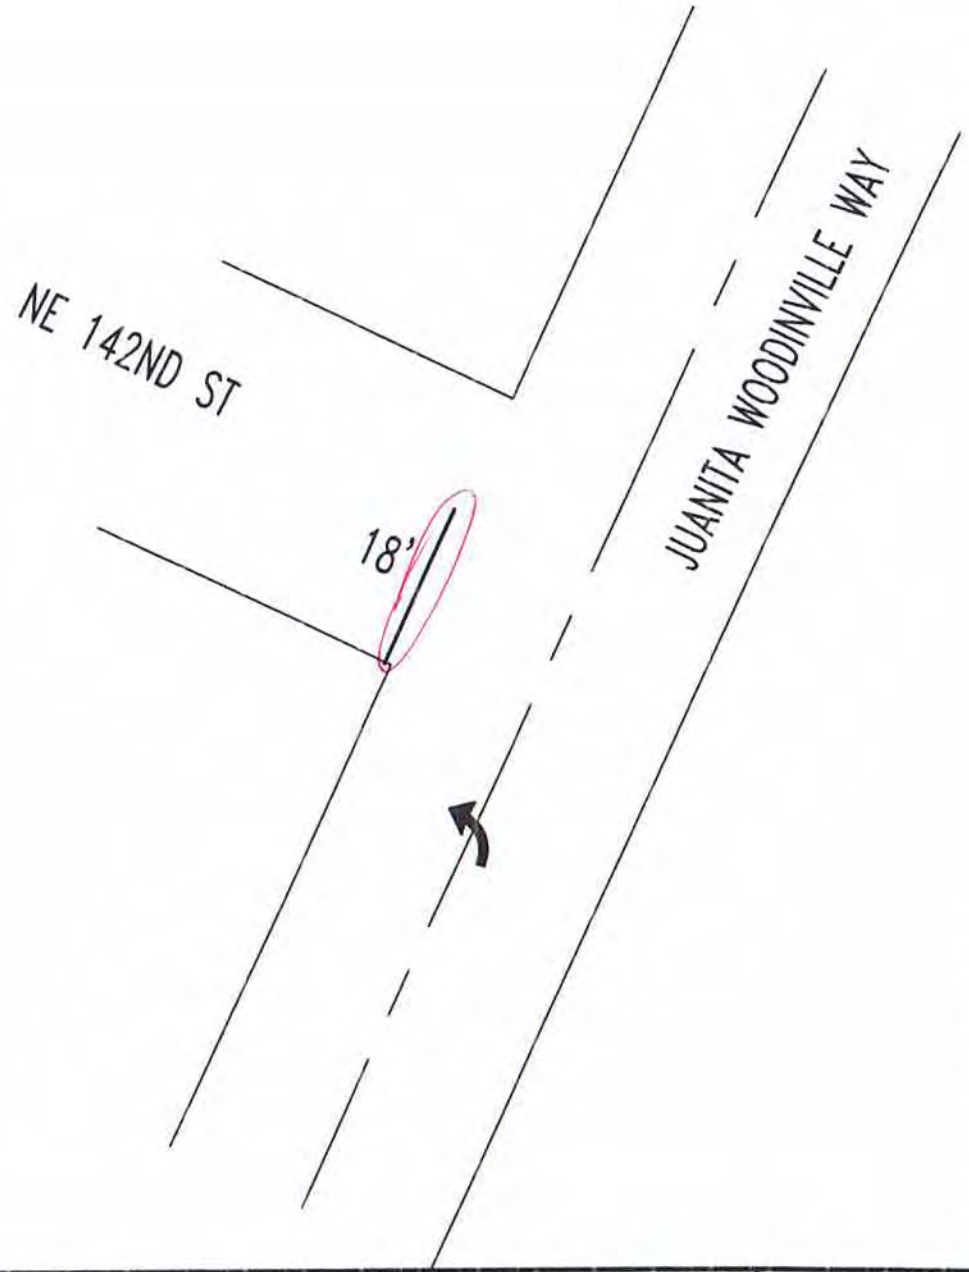

NO SCALE

ESTIMATED QUANTITIES:

ITEM	ITEM DESCRIPTION	UNIT	INVENTORY	REPAIR QTY
PL18	PLASTIC STOP BAR, 18"	LF	16	16
PLXW	PLASTIC CROSSWALK STRIPE	SF		
PLARW	PLASTIC TRAFFIC ARROW	EA	1	
PLLTR	PLASTIC TRAFFIC LETTER, 8 FT HIGH	EA		
PLRR	PLASTIC RAILROAD SYMBOL	EA		
RPLSYM	REMOVE PL. ARROW, LETTER, SYMBOL	EA		
RRPM	REMOVE RPM	EA		
RPLXW	REMOVE PLASTIC STRIPE	SF		

CITY OF KIRKLAND
DEPARTMENT OF PUBLIC WORKS
123 FIFTH AVENUE KIRKLAND, WA 98033
(425) 587-3800 www.kirklandwa.gov

G. HORTILLOSA 2/2012
DESIGNED BY: DATE

J.JENNINGS 2/2012
DRAWN BY: DATE

CHECKED BY: DATE

20__ PAVEMENT MARKING PROGRAM

STREET: JUANITA WOODINVILLE WAY

CROSS STREET: NE 142ND ST

SEGMENT:

SCALE: N.T.S.

FILENAME:

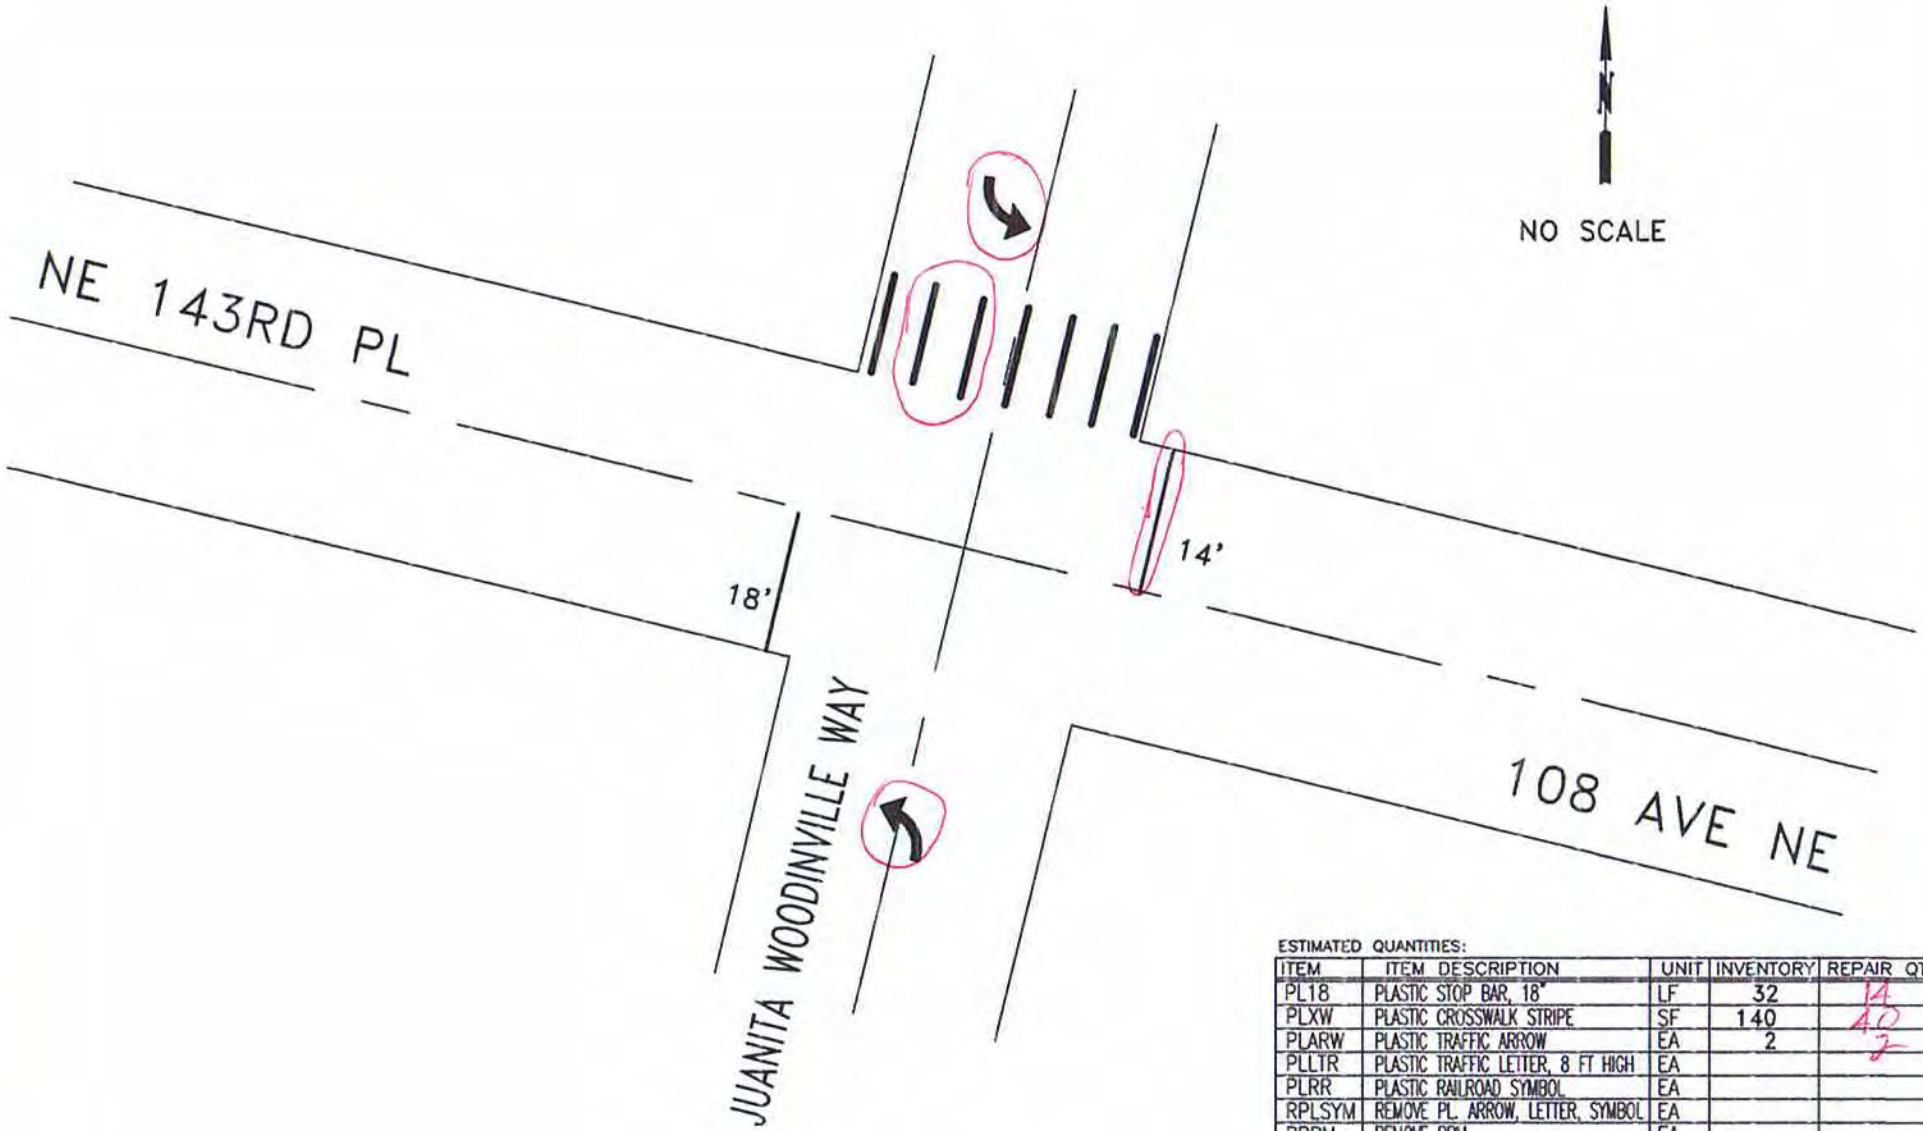

ESTIMATED QUANTITIES:

ITEM	ITEM DESCRIPTION	UNIT	INVENTORY	REPAIR QTY
PLXW	PLASTIC CROSSWALK STRIPE	SF	140	40
PLARW	PLASTIC TRAFFIC ARROW	EA	2	2
PLLTR	PLASTIC TRAFFIC LETTER, 8 FT HIGH	EA		
PLRR	PLASTIC RAILROAD SYMBOL	EA		
RPLSYM	REMOVE PL. ARROW, LETTER, SYMBOL	EA		
RRPM	REMOVE RPM	EA		
RPLXW	REMOVE PLASTIC STRIPE	SF		

CITY OF KIRKLAND WASHINGTON

CITY OF KIRKLAND
DEPARTMENT OF PUBLIC WORKS
123 FIFTH AVENUE KIRKLAND, WA 98033
(425) 587-3800 www.kirklandwa.gov

G. HORTILLOSA 2/2012
DESIGNED BY: DATE

J.JENNINGS 2/2012
DRAWN BY: DATE

CHECKED BY: DATE

20~~22~~ PAVEMENT MARKING PROGRAM

STREET: JUANITA WOODINVILLE WAY

CROSS STREET: NE 143 PL

SEGMENT:

SCALE: N.T.S.

FILENAME: Page 2-31

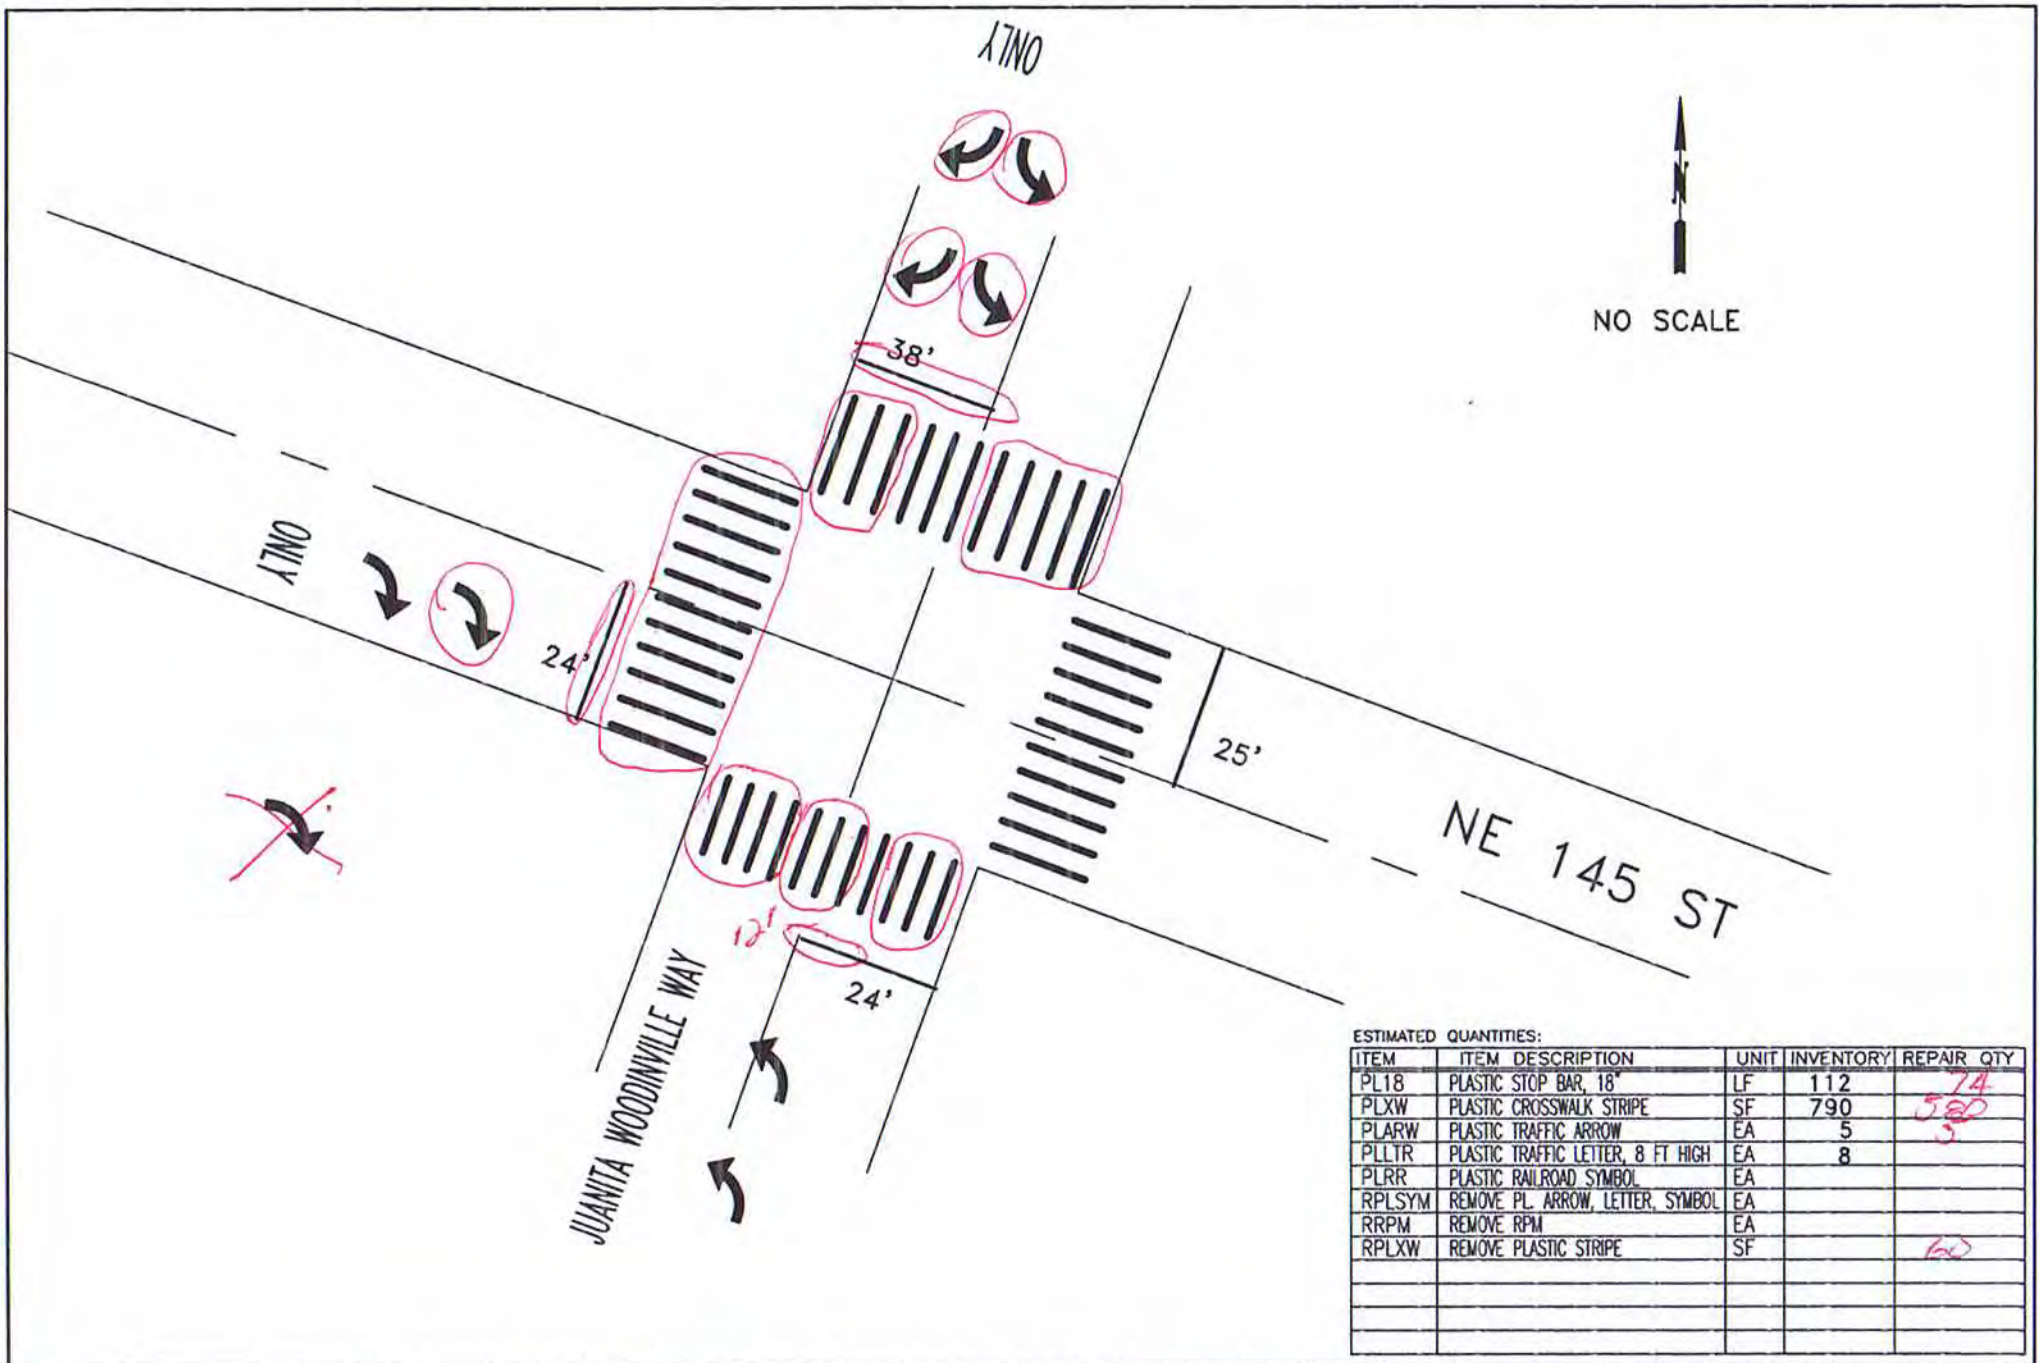

ESTIMATED QUANTITIES:

ITEM	ITEM DESCRIPTION	UNIT	INVENTORY	REPAIR QTY
PL18	PLASTIC STOP BAR, 18"	LF	112	74
PLXW	PLASTIC CROSSWALK STRIPE	SF	790	580
PLARW	PLASTIC TRAFFIC ARROW	EA	5	3
PLLTR	PLASTIC TRAFFIC LETTER, 8 FT HIGH	EA	8	
PLRR	PLASTIC RAILROAD SYMBOL	EA		
RPLSYM	REMOVE PL. ARROW, LETTER, SYMBOL	EA		
RRPM	REMOVE RPM	EA		
RPLXW	REMOVE PLASTIC STRIPE	SF		60

CITY OF KIRKLAND
DEPARTMENT OF PUBLIC WORKS
123 FIFTH AVENUE KIRKLAND, WA 98033
(425) 587-3800 www.kirklandwa.gov

G. HORTILLOSA 2/2012
DESIGNED BY: DATE

J.JENNINGS 2/2012
DRAWN BY: DATE

CHECKED BY: DATE

2020 PAVEMENT MARKING PROGRAM

STREET: JUANITA WOODINVILLE WAY

CROSS STREET: NE 145TH STREET

SEGMENT:

SCALE: N.T.S.

FILENAME:

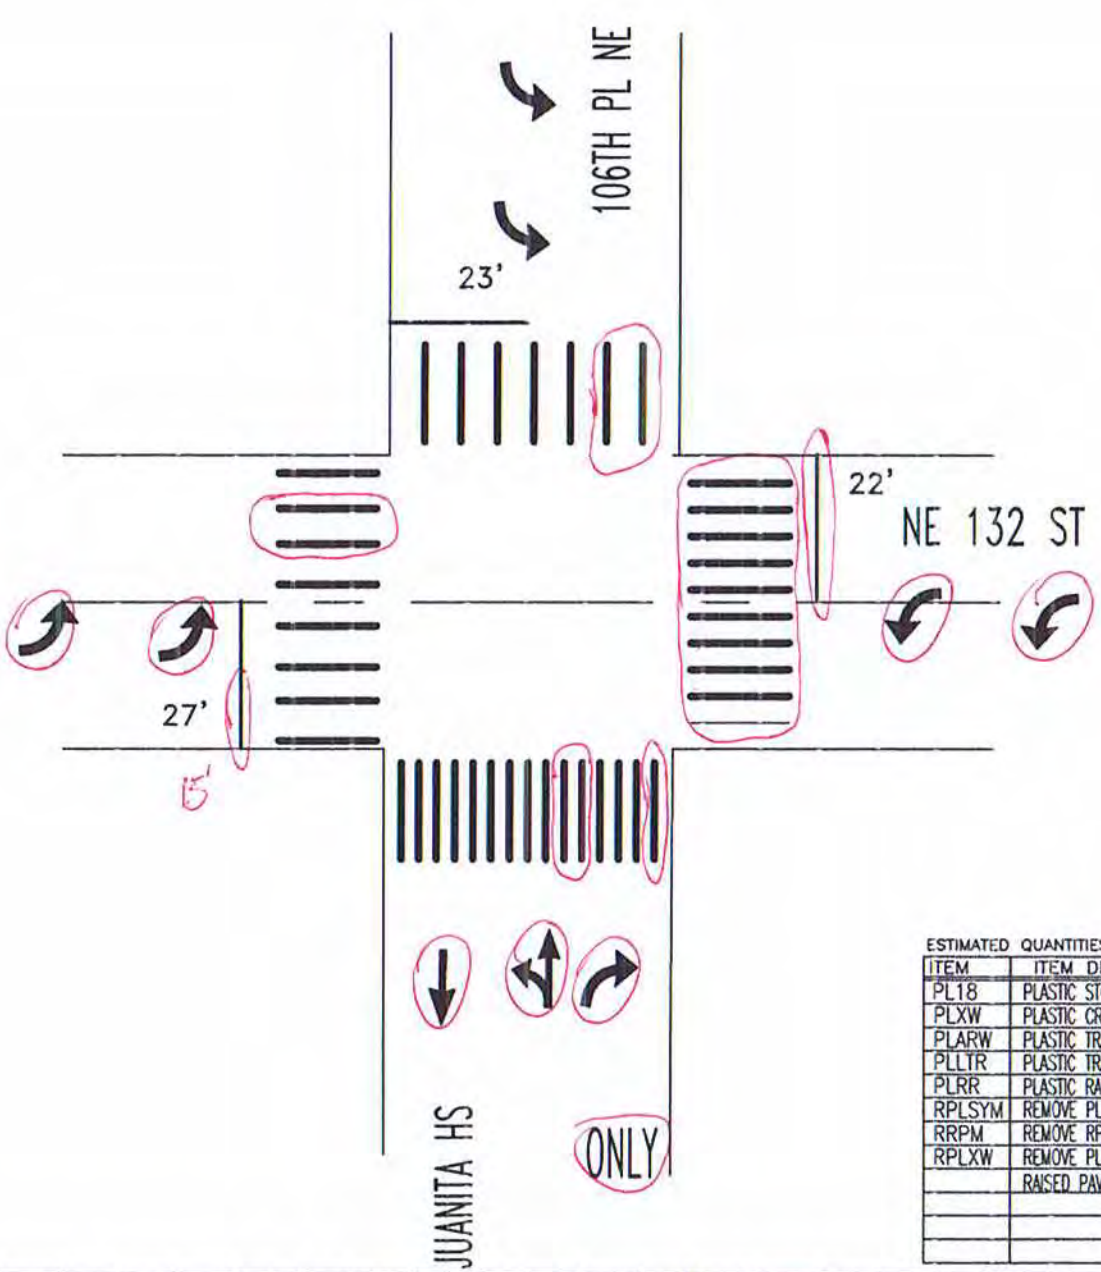

ESTIMATED QUANTITIES:

ITEM	ITEM DESCRIPTION	UNIT	INVENTORY	REPAIR QTY
PL18	PLASTIC STOP BAR, 18"	LF	72	37
PLXW	PLASTIC CROSSWALK STRIPE	SF	780	336
PLARW	PLASTIC TRAFFIC ARROW	EA		7
PLLTR	PLASTIC TRAFFIC LETTER, 8 FT HIGH	EA		4
PLRR	PLASTIC RAILROAD SYMBOL	EA		
RPLSYM	REMOVE PL. ARROW, LETTER, SYMBOL	EA		
RRPM	REMOVE RPM	EA		
RPLXW	REMOVE PLASTIC STRIPE	SF		100
	RAISED PAVEMENT MARKER TYPE 2	EA		

CITY OF KIRKLAND WASHINGTON

CITY OF KIRKLAND
DEPARTMENT OF PUBLIC WORKS
123 FIFTH AVENUE KIRKLAND, WA 98033
(425) 587-3800 www.kirklandwa.gov

G. HORTILLOSA 2/2012
DESIGNED BY: DATE

J.JENNINGS 2/2012
DRAWN BY: DATE

CHECKED BY: DATE

2012 PAVEMENT MARKING PROGRAM

STREET: NE 132 ST

CROSS STREET: JUANITA HIGH SCHOOL

SEGMENT:

SCALE: N.T.S.

FILENAME: Page 2-33

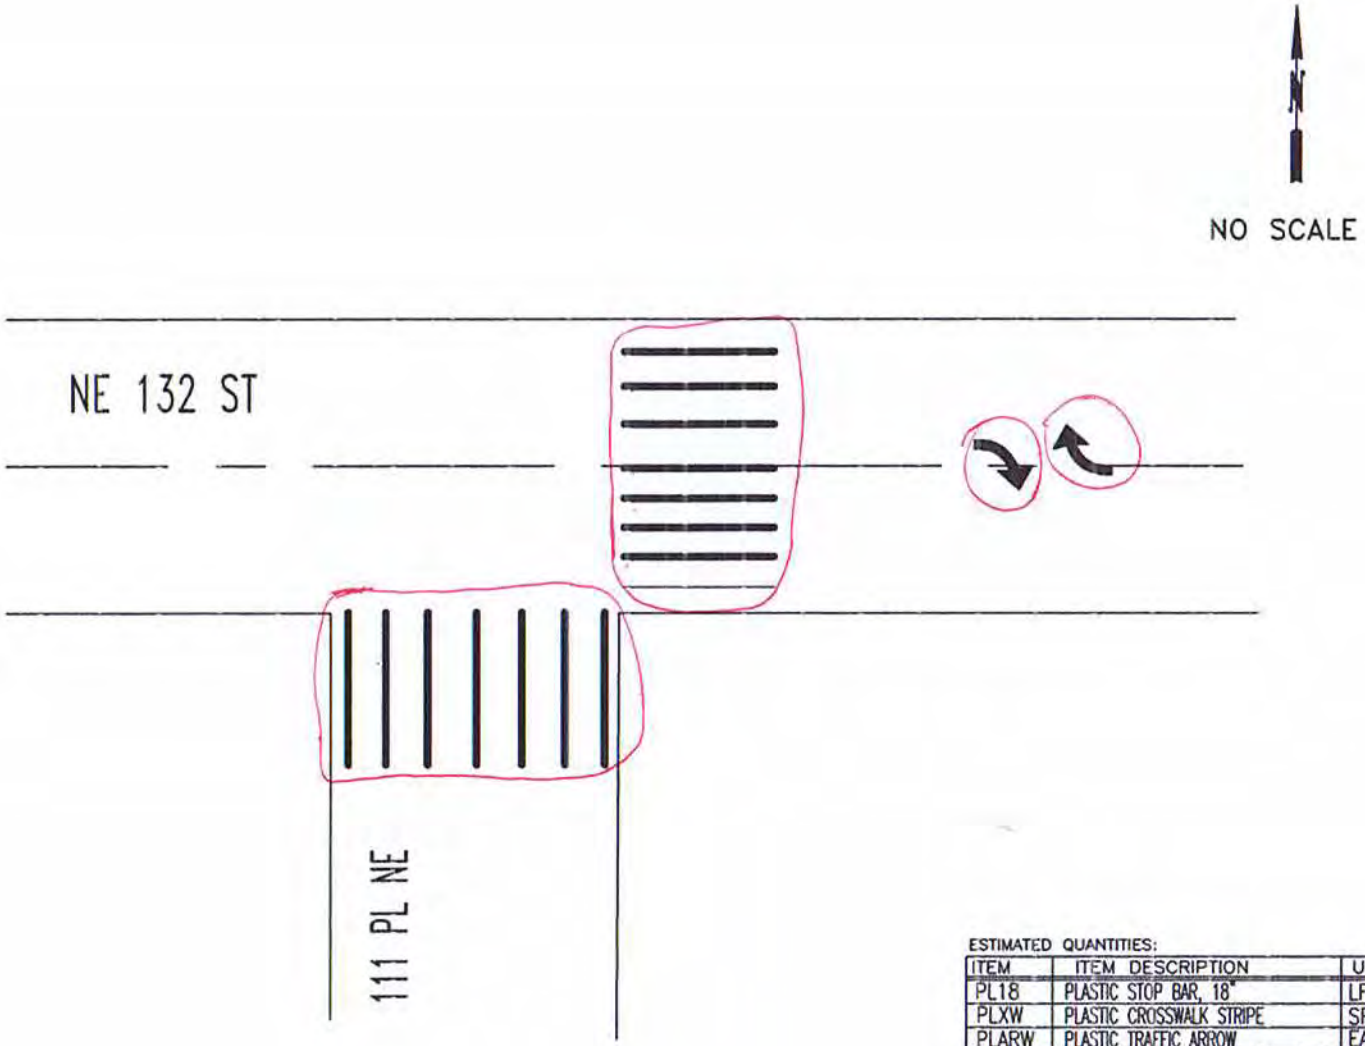

ESTIMATED QUANTITIES:

ITEM	ITEM DESCRIPTION	UNIT	INVENTORY	REPAIR QTY
PL18	PLASTIC STOP BAR, 18"	LF		
PLXW	PLASTIC CROSSWALK STRIPE	SF	290	292
PLARW	PLASTIC TRAFFIC ARROW	EA	2	2
PLLTR	PLASTIC TRAFFIC LETTER, 8 FT HIGH	EA		
PLRR	PLASTIC RAILROAD SYMBOL	EA		
RPLSYM	REMOVE PL. ARROW, LETTER, SYMBOL	EA		
RRPM	REMOVE RPM	EA		
RPLXW	REMOVE PLASTIC STRIPE	SF		

CITY OF KIRKLAND
DEPARTMENT OF PUBLIC WORKS
123 FIFTH AVENUE KIRKLAND, WA 98033
(425) 587-3800 www.kirklandwa.gov

G. HORTILLOSA 2/2012
DESIGNED BY: DATE

J.JENNINGS 2/2012
DRAWN BY: DATE

CHECKED BY: DATE

2020 PAVEMENT MARKING PROGRAM

STREET: NE 132ND ST

CROSS STREET: 111 PL NE

SEGMENT:

SCALE: N.T.S.

FILENAME:

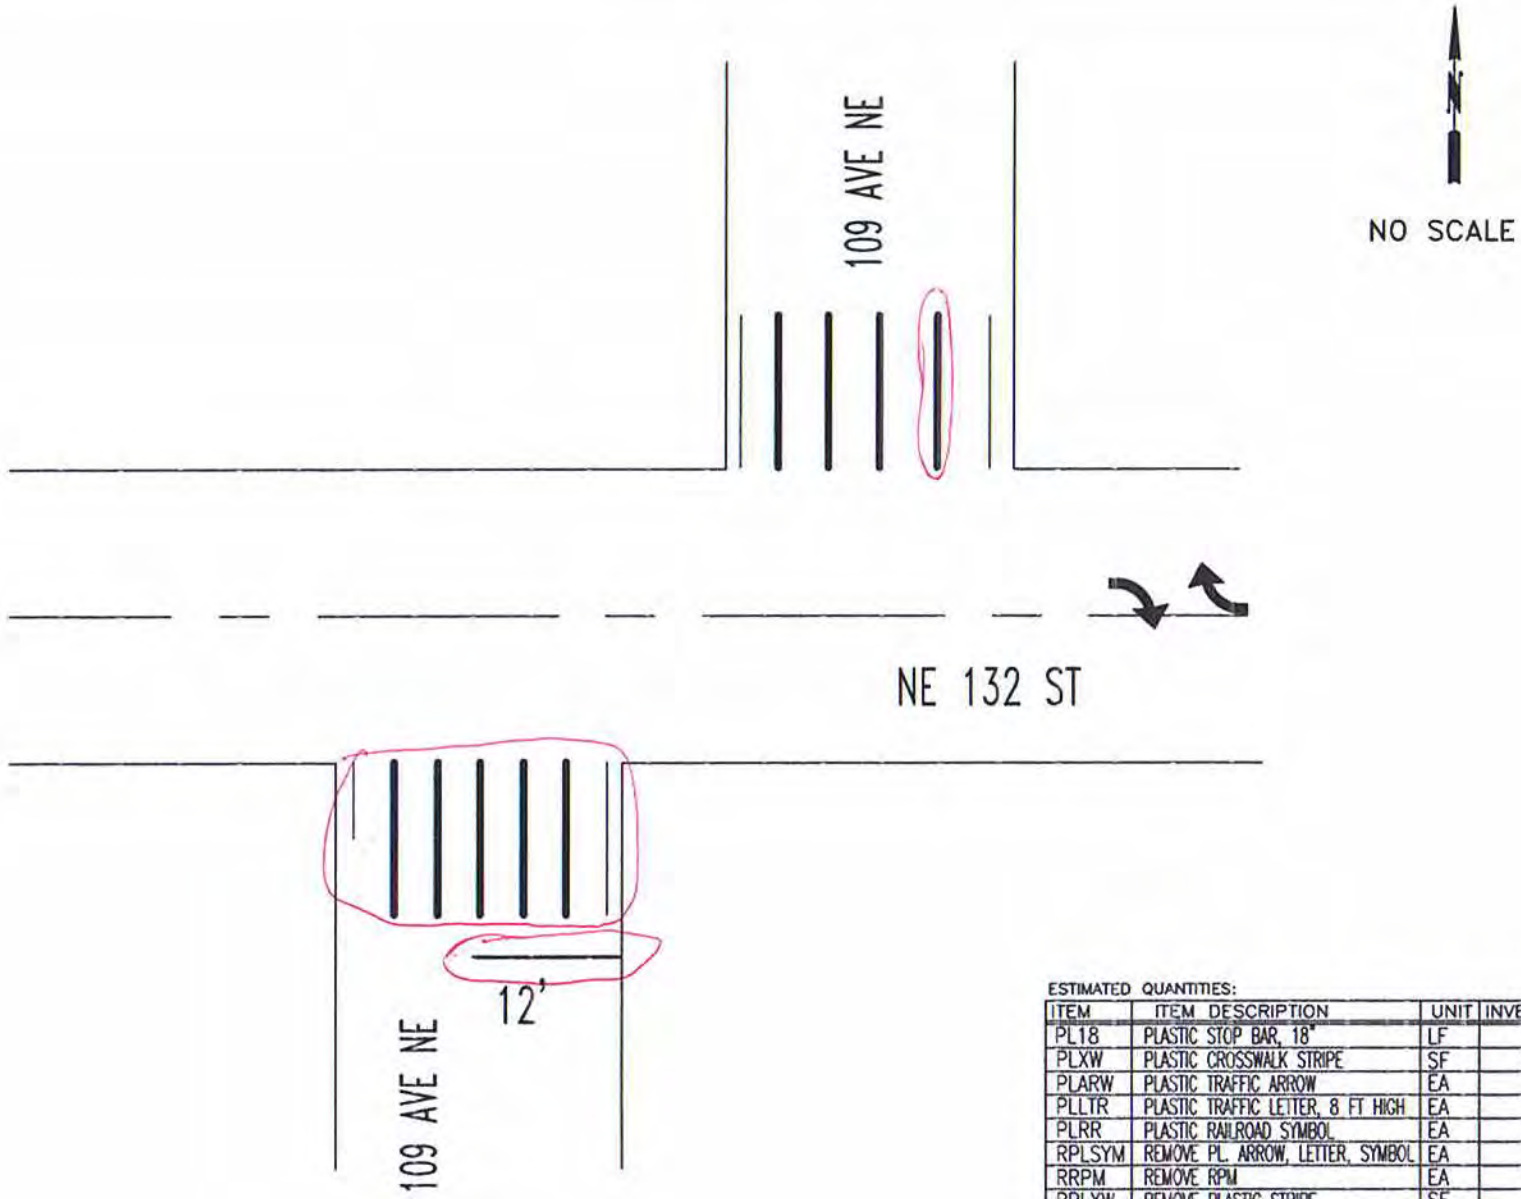

ESTIMATED QUANTITIES:

ITEM	ITEM DESCRIPTION	UNIT	INVENTORY	REPAIR QTY
PL18	PLASTIC STOP BAR, 18"	LF	12	15
PLXW	PLASTIC CROSSWALK STRIPE	SF	215	140
PLARW	PLASTIC TRAFFIC ARROW	EA	2	
PLLTR	PLASTIC TRAFFIC LETTER, 8 FT HIGH	EA		
PLRR	PLASTIC RAILROAD SYMBOL	EA		
RPLSYM	REMOVE PL. ARROW, LETTER, SYMBOL	EA		
RRPM	REMOVE RPM	EA		
RPLXW	REMOVE PLASTIC STRIPE	SF		130

CITY OF KIRKLAND
DEPARTMENT OF PUBLIC WORKS
123 FIFTH AVENUE KIRKLAND, WA 98033
(425) 587-3800 www.kirklandwa.gov

G. HORTILLOSA 2/2012
DESIGNED BY: DATE

J.JENNINGS 2/2012
DRAWN BY: DATE

CHECKED BY: DATE

2020 PAVEMENT MARKING PROGRAM

STREET: NE 132ND ST

CROSS STREET: 109 AVE NE

SEGMENT:

SCALE: N.T.S.

FILENAME:

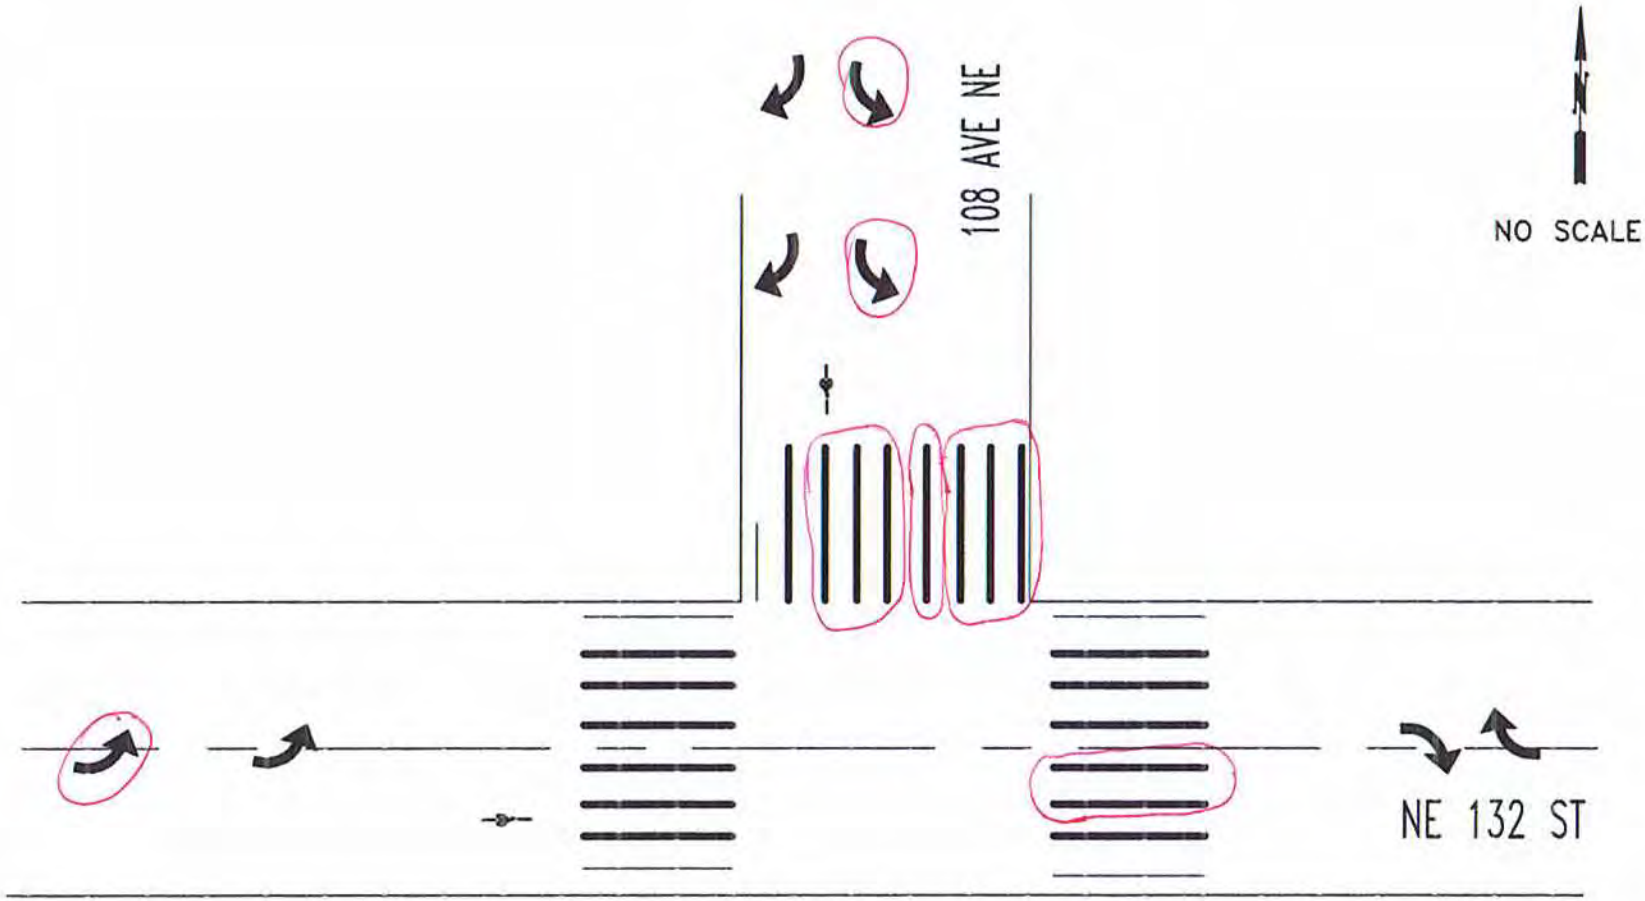

ESTIMATED QUANTITIES:

ITEM	ITEM DESCRIPTION	UNIT	INVENTORY	REPAIR QTY
PL18	PLASTIC STOP BAR, 18"	LF		
PLXW	PLASTIC CROSSWALK STRIPE	SF	480	
PLARW	PLASTIC TRAFFIC ARROW	EA	6	
PLLTR	PLASTIC TRAFFIC LETTER, 8 FT HIGH	EA		
PLRR	PLASTIC RAILROAD SYMBOL	EA		
RPLSYM	REMOVE PL. ARROW, LETTER, SYMBOL	EA		
RRPM	REMOVE RPM	EA		
RPLXW	REMOVE PLASTIC STRIPE	SF		
	PLASTIC BIKE DETECTION SYMBOL	EA	2	

CITY OF KIRKLAND WASHINGTON

CITY OF KIRKLAND
DEPARTMENT OF PUBLIC WORKS
123 FIFTH AVENUE KIRKLAND, WA 98033
(425) 587-3800 www.kirklandwa.gov

G. HORTILLOSA 2/2012
DESIGNED BY: DATE

J.JENNINGS 2/2012
DRAWN BY: DATE

CHECKED BY: DATE

2020 PAVEMENT MARKING PROGRAM

STREET: NE 132ND ST

CROSS STREET: 108 AVE NE

SEGMENT:

SCALE: N.T.S.

FILENAME: Page 2-36

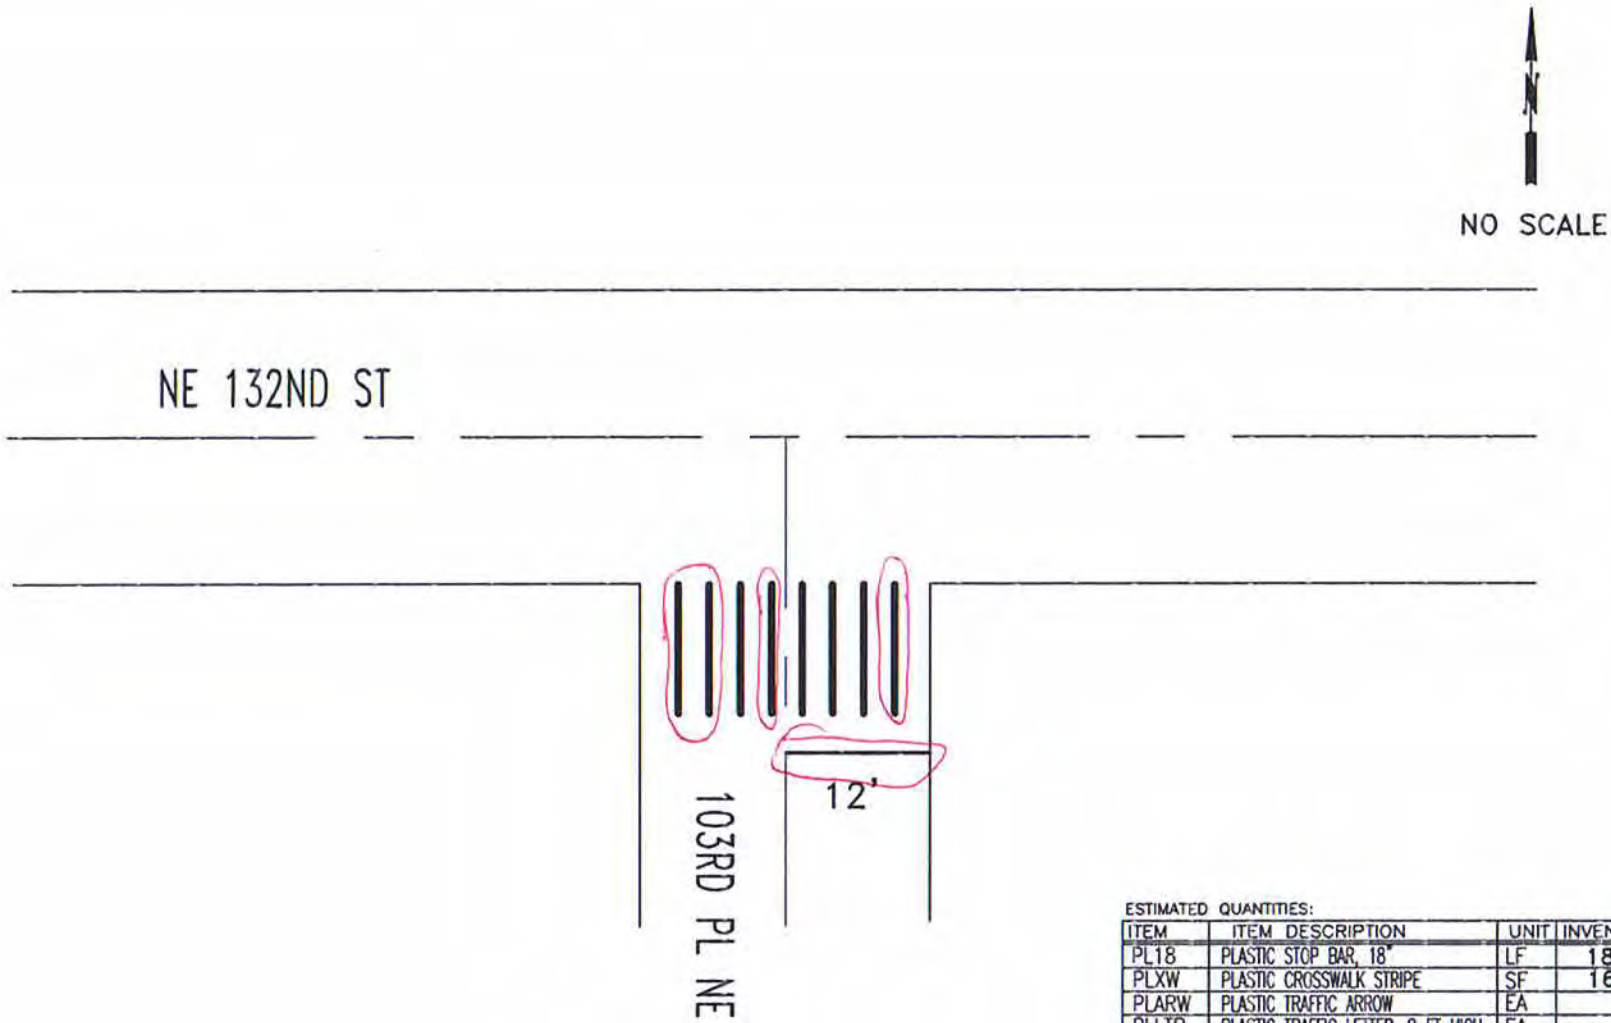

ESTIMATED QUANTITIES:

ITEM	ITEM DESCRIPTION	UNIT	INVENTORY	REPAIR QTY
PL18	PLASTIC STOP BAR, 18"	LF	18	12
PLXW	PLASTIC CROSSWALK STRIPE	SF	160	80
PLARW	PLASTIC TRAFFIC ARROW	EA		
PLLTR	PLASTIC TRAFFIC LETTER, 8 FT HIGH	EA		
PLRR	PLASTIC RAILROAD SYMBOL	EA		
RPLSYM	REMOVE PL. ARROW, LETTER, SYMBOL	EA		
RRPM	REMOVE RPM	EA		
RPLXW	REMOVE PLASTIC STRIPE	SF		40

CITY OF KIRKLAND WASHINGTON

CITY OF KIRKLAND
DEPARTMENT OF PUBLIC WORKS
123 FIFTH AVENUE KIRKLAND, WA 98033
(425) 587-3800 www.kirklandwa.gov

L KAWAOKA 3/2017
DESIGNED BY: DATE

J.JENNINGS 3/2017
DRAWN BY: DATE

CHECKED BY: DATE

2020 PAVEMENT MARKING PROGRAM

STREET: NE 132ND ST

CROSS STREET: 103RD PL NE

SEGMENT:

SCALE: N.T.S.

FILENAME: Page 2-38A

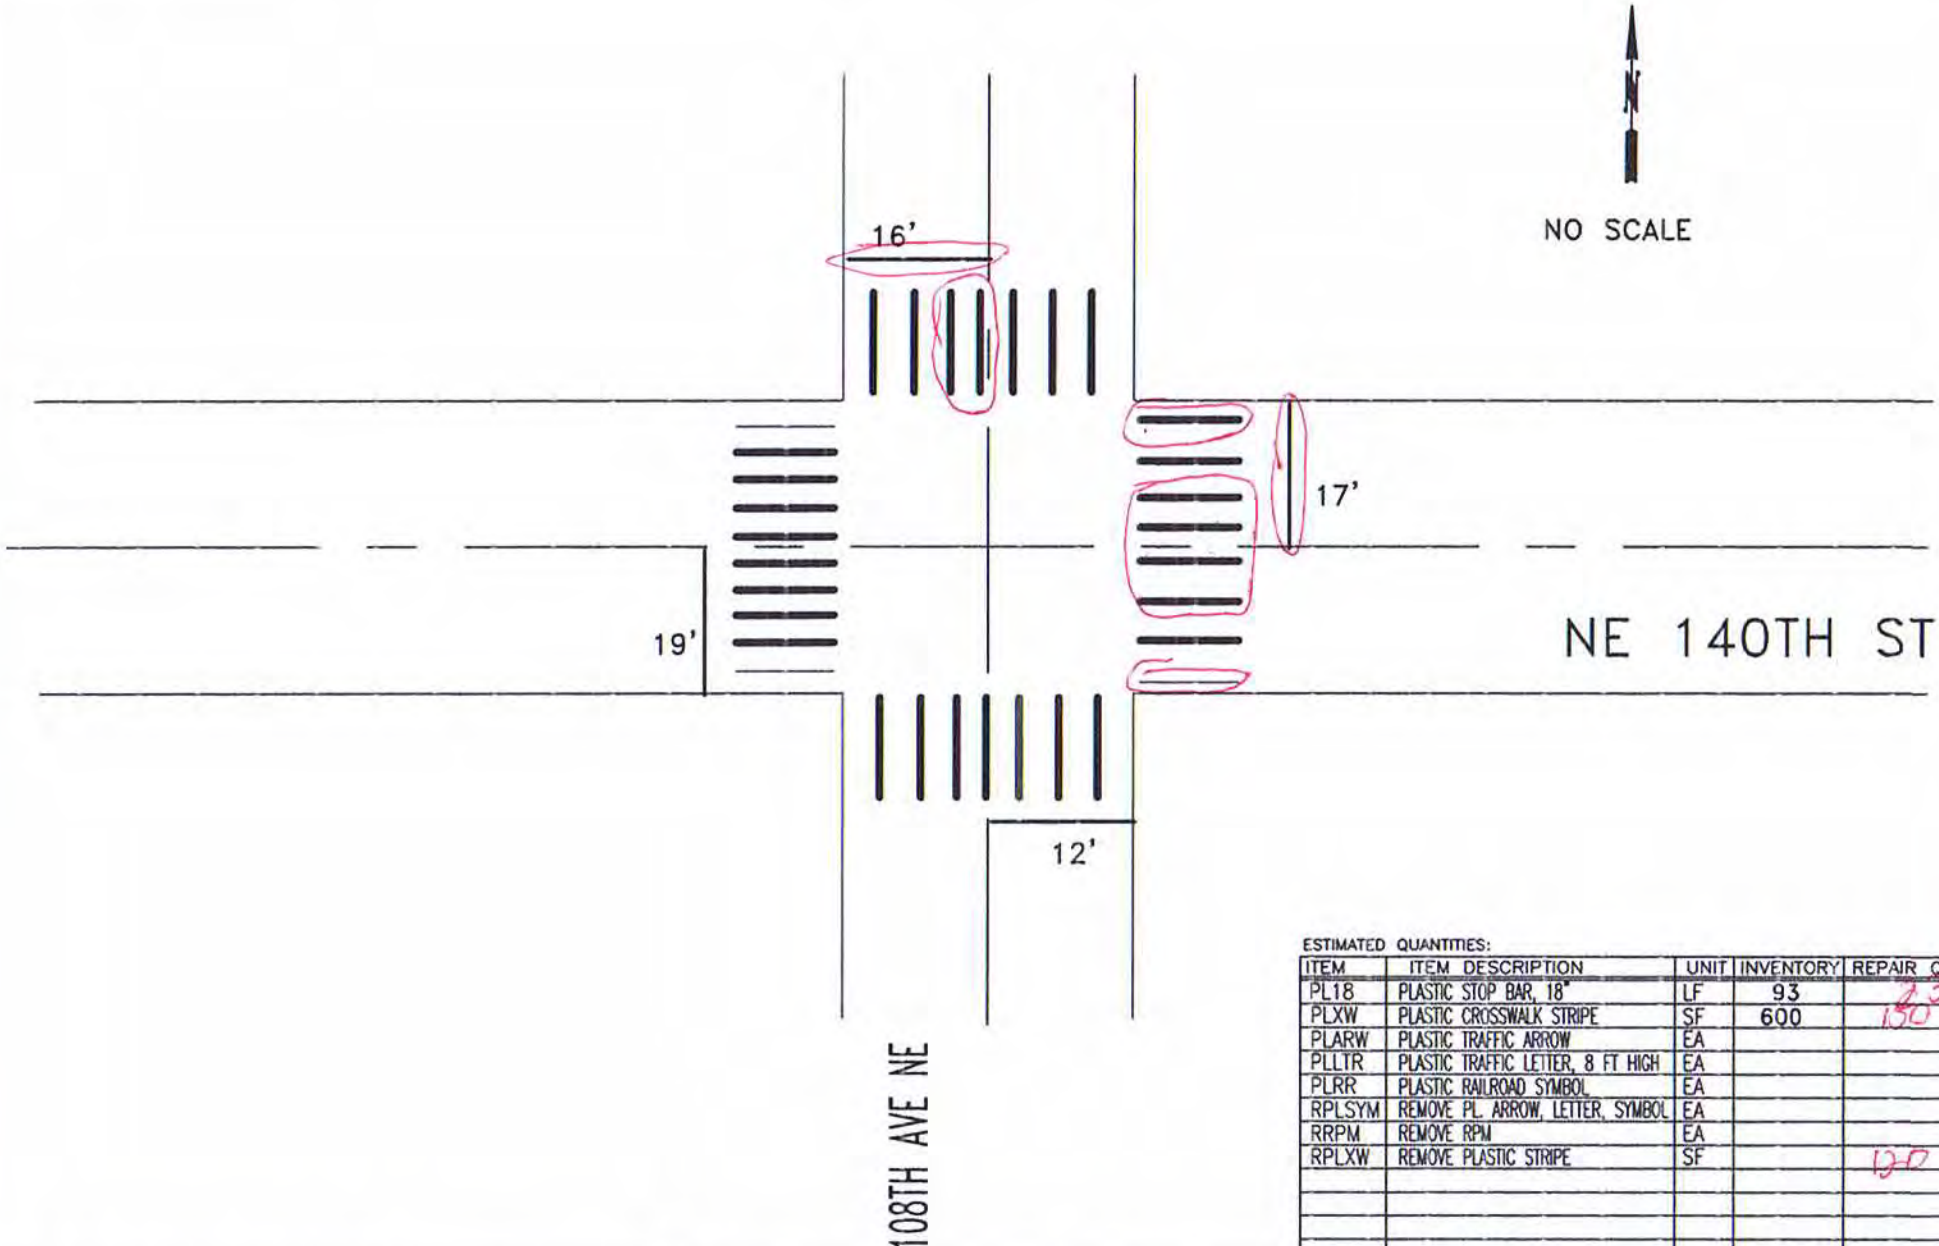

ESTIMATED QUANTITIES:

ITEM	ITEM DESCRIPTION	UNIT	INVENTORY	REPAIR QTY
PL18	PLASTIC STOP BAR, 18"	LF	93	83
PLXW	PLASTIC CROSSWALK STRIPE	SF	600	130
PLARW	PLASTIC TRAFFIC ARROW	EA		
PLLTR	PLASTIC TRAFFIC LETTER, 8 FT HIGH	EA		
PLRR	PLASTIC RAILROAD SYMBOL	EA		
RPLSYM	REMOVE PL. ARROW, LETTER, SYMBOL	EA		
RRPM	REMOVE RPM	EA		
RPLXW	REMOVE PLASTIC STRIPE	SF		120

CITY OF KIRKLAND
DEPARTMENT OF PUBLIC WORKS
123 FIFTH AVENUE KIRKLAND, WA 98033
(425) 587-3800 www.kirklandwa.gov

P. HERBIG 5/2014
DESIGNED BY: DATE

J.JENNINGS 5/2014
DRAWN BY: DATE

CHECKED BY: DATE

2020 PAVEMENT MARKING PROGRAM

STREET: NE 140TH ST

CROSS STREET: 108TH AVE NE

SEGMENT:

SCALE: N.T.S.

FILENAME: Page 2-39

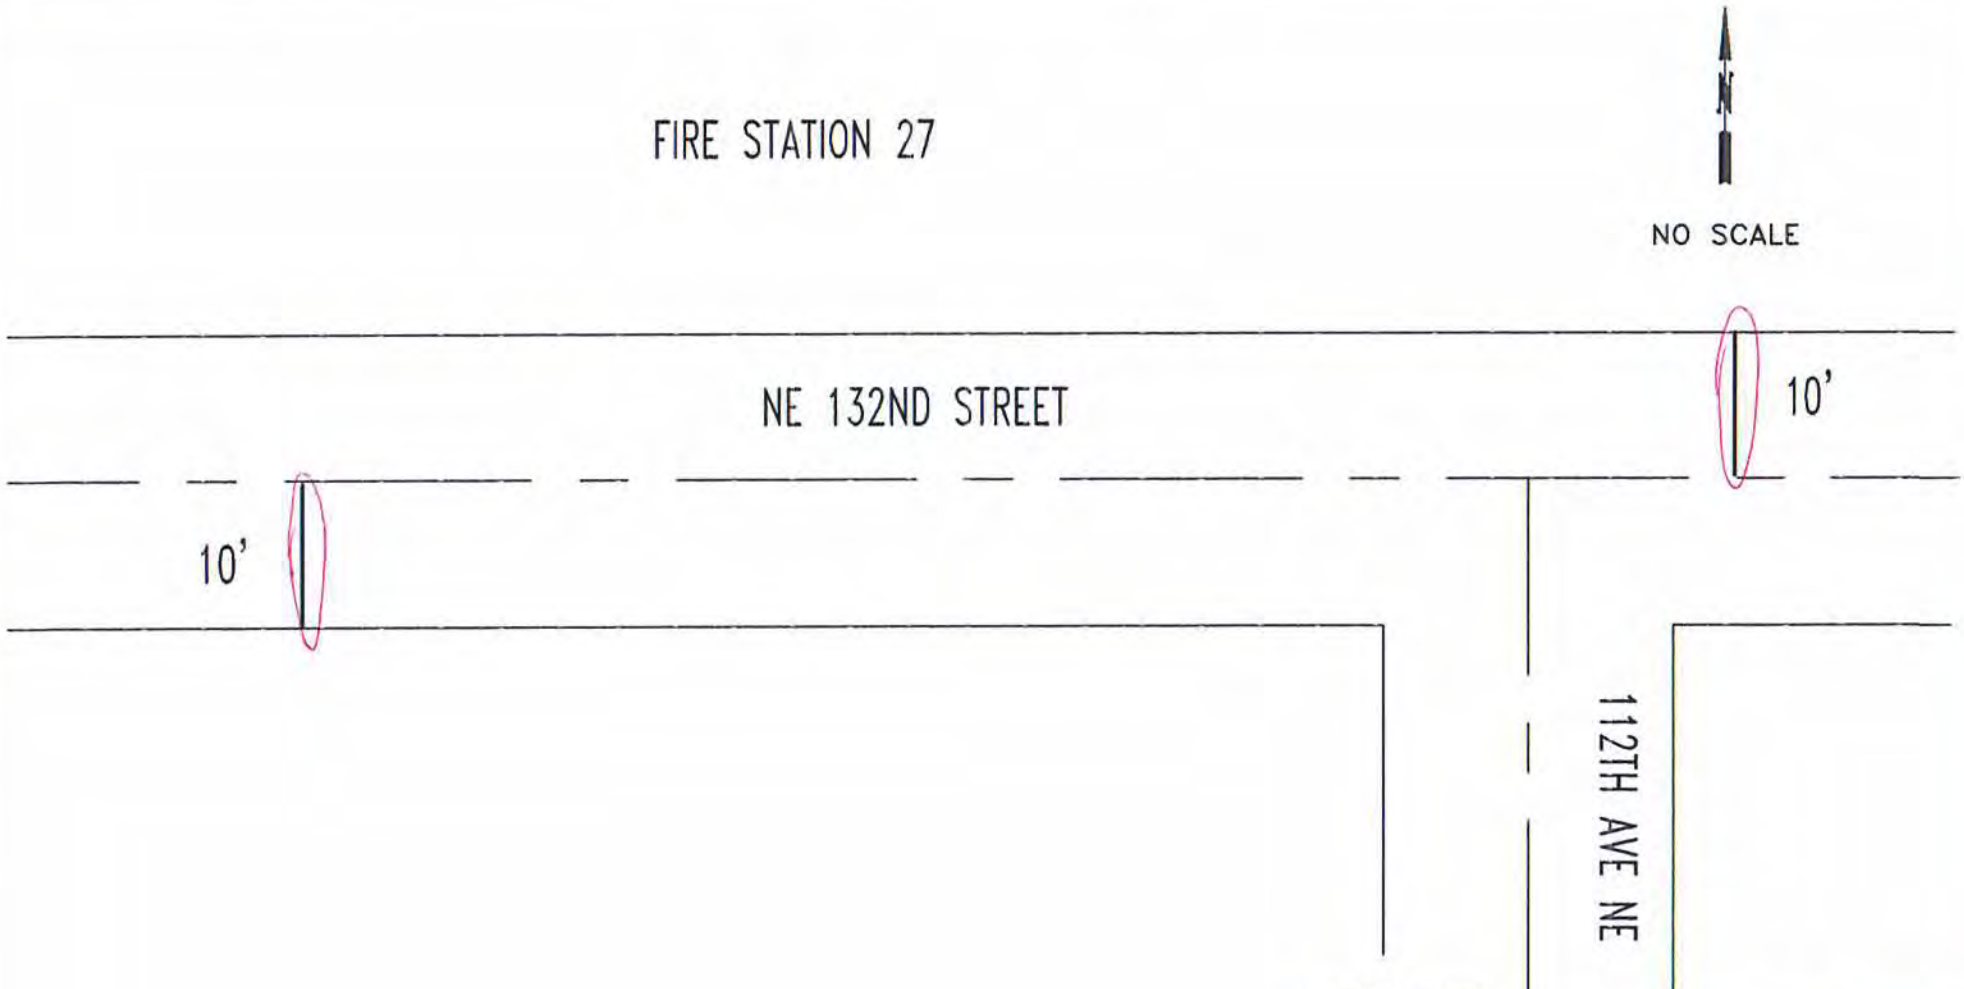

ESTIMATED QUANTITIES:

ITEM	ITEM DESCRIPTION	UNIT	INVENTORY	REPAIR QTY
PL18	PLASTIC STOP BAR, 18"	LF	20	20
PLXW	PLASTIC CROSSWALK STRIPE	SF		
PLARW	PLASTIC TRAFFIC ARROW	EA		
PLLTR	PLASTIC TRAFFIC LETTER, 8 FT HIGH	EA		
PLRR	PLASTIC RAILROAD SYMBOL	EA		
RPLSYM	REMOVE PL. ARROW, LETTER, SYMBOL	EA		
RRPM	REMOVE RPM	EA		
RPLXW	REMOVE PLASTIC STRIPE	SF		

CITY OF KIRKLAND WASHINGTON

CITY OF KIRKLAND
DEPARTMENT OF PUBLIC WORKS
123 FIFTH AVENUE KIRKLAND, WA 98033
(425) 587-3800 www.kirklandwa.gov

P. HERBIG 5/2014
DESIGNED BY: DATE

J.JENNINGS 5/2014
DRAWN BY: DATE

REVISED BY: DATE

2022 PAVEMENT MARKING PROGRAM

STREET: NE 132ND STREET

CROSS STREET: 112TH AVE NE

SEGMENT:

SCALE: N.T.S.

FILENAME: Page 2-41

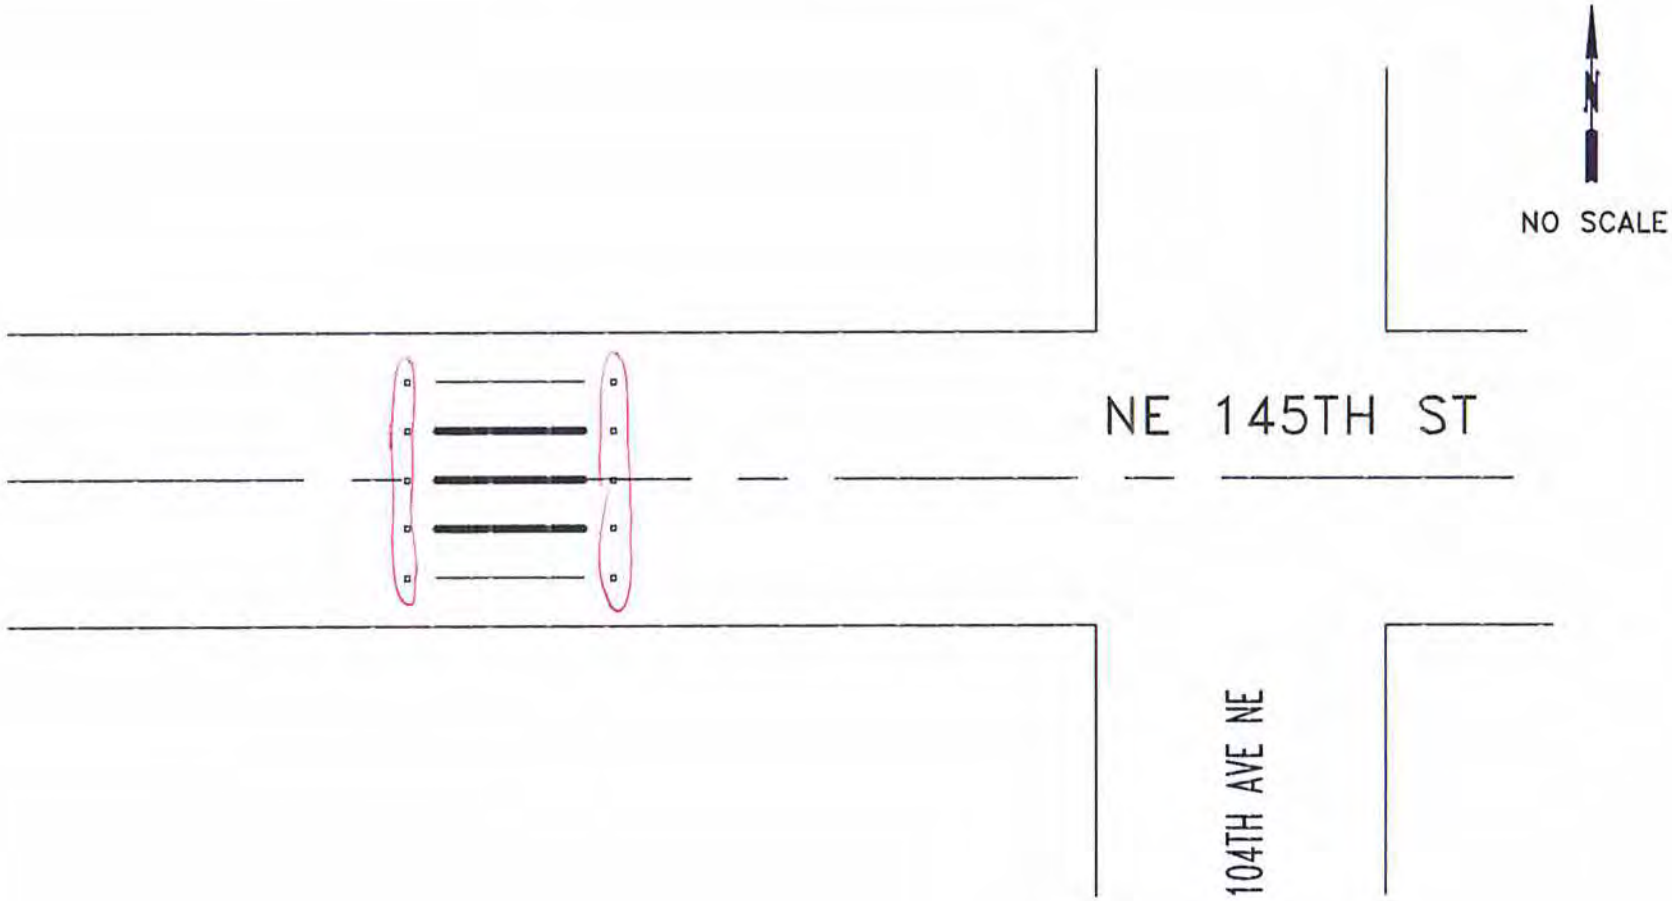

ESTIMATED QUANTITIES:

ITEM	ITEM DESCRIPTION	UNIT	INVENTORY	REPAIR QTY
PL18	PLASTIC STOP BAR, 18"	LF		
PLXW	PLASTIC CROSSWALK STRIPE	SF	440	
PLARW	PLASTIC TRAFFIC ARROW	EA		
PLLTR	PLASTIC TRAFFIC LETTER, 8 FT HIGH	EA		
PLRR	PLASTIC RAILROAD SYMBOL	EA		
RPLSYM	REMOVE PL. ARROW, LETTER, SYMBOL	EA		
RRPM	REMOVE RPM	EA		
RPLXW	REMOVE PLASTIC STRIPE	SF		
	RAISED PAVEMENT MARKER TYPE 2	EA	10	10

CITY OF KIRKLAND WASHINGTON

CITY OF KIRKLAND
DEPARTMENT OF PUBLIC WORKS
123 FIFTH AVENUE KIRKLAND, WA 98033
(425) 587-3800 www.kirklandwa.gov

L KAWAOKA 3/2016
DESIGNED BY: DATE

J.JENNINGS 3/2016
DRAWN BY: DATE

CHECKED BY: DATE

20~~22~~ PAVEMENT MARKING PROGRAM

STREET: NE 145TH ST

CROSS STREET: 104TH AVE NE

SEGMENT:

SCALE: N.T.S.

FILENAME: 2-42

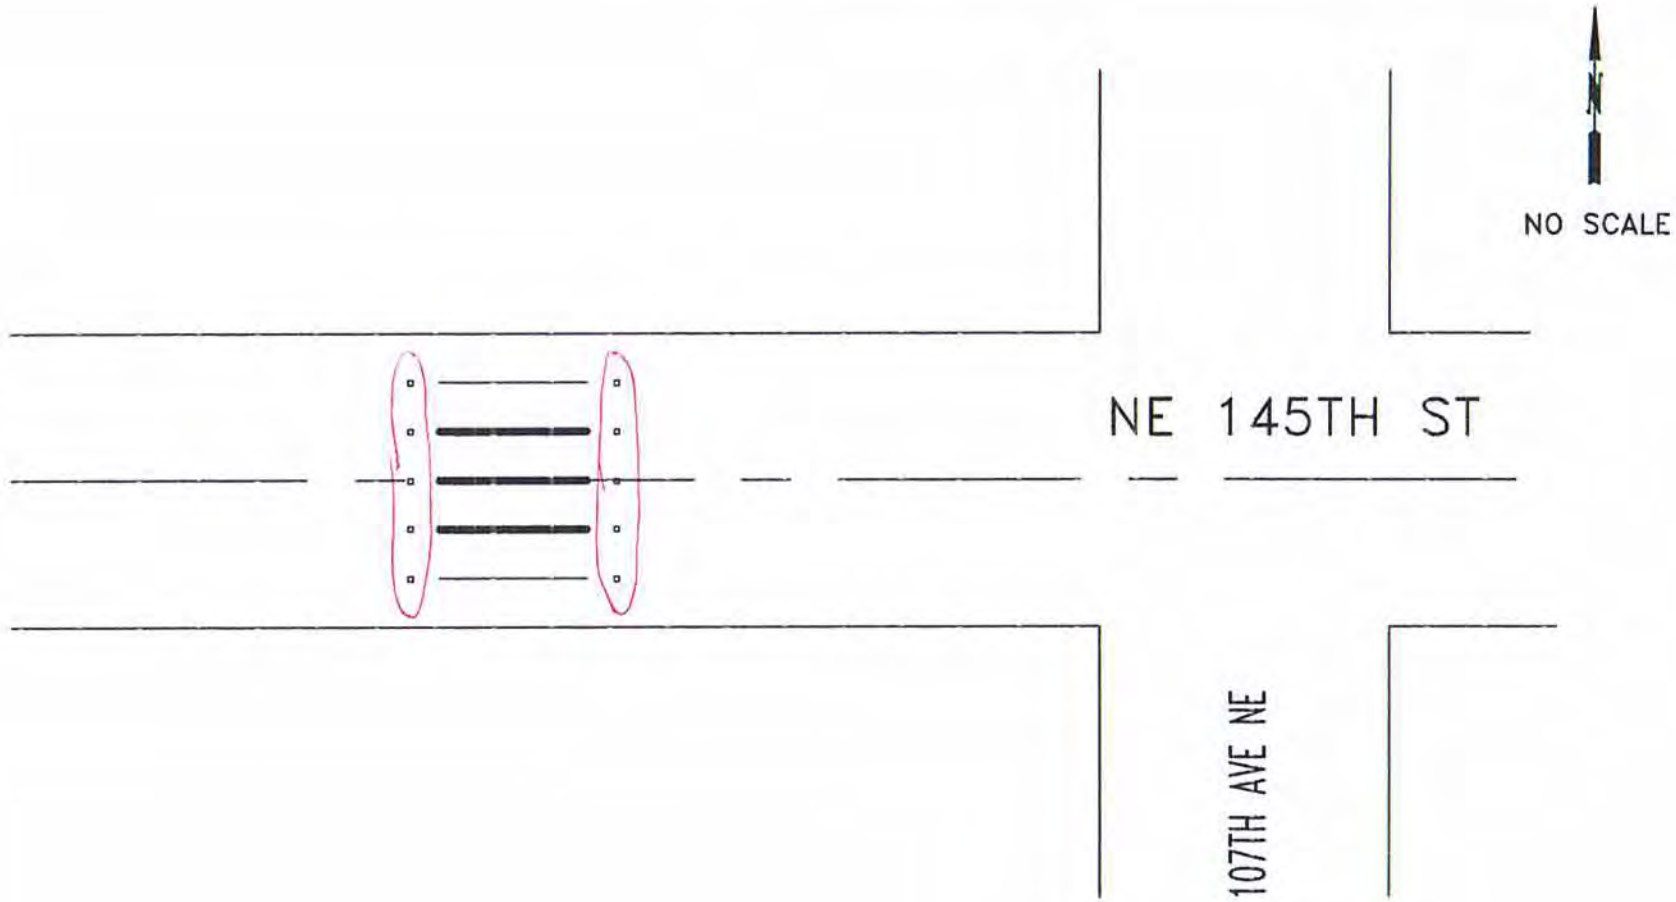

ESTIMATED QUANTITIES:

ITEM	ITEM DESCRIPTION	UNIT	INVENTORY	REPAIR QTY
PL18	PLASTIC STOP BAR, 18"	LF		
PLXW	PLASTIC CROSSWALK STRIPE	SF	440	
PLARW	PLASTIC TRAFFIC ARROW	EA		
PLLTR	PLASTIC TRAFFIC LETTER, 8 FT HIGH	EA		
PLRR	PLASTIC RAILROAD SYMBOL	EA		
RPLSYM	REMOVE PL. ARROW, LETTER, SYMBOL	EA		
RRPM	REMOVE RPM	EA		8
RPLXW	REMOVE PLASTIC STRIPE	SF		
	RAISED PAVEMENT MARKER TYPE 2	EA	10	10

CITY OF KIRKLAND WASHINGTON

CITY OF KIRKLAND
DEPARTMENT OF PUBLIC WORKS
123 FIFTH AVENUE KIRKLAND, WA 98033
(425) 587-3800 www.kirklandwa.gov

L KAWAOKA 3/2016
DESIGNED BY: DATE

J.JENNINGS 3/2016
DRAWN BY: DATE

CHECKED BY: DATE

20__ PAVEMENT MARKING PROGRAM

STREET: NE 145TH ST

CROSS STREET: 107TH AVE NE

SEGMENT: 3040-#50

SCALE: N.T.S.

FILENAME: 2-43

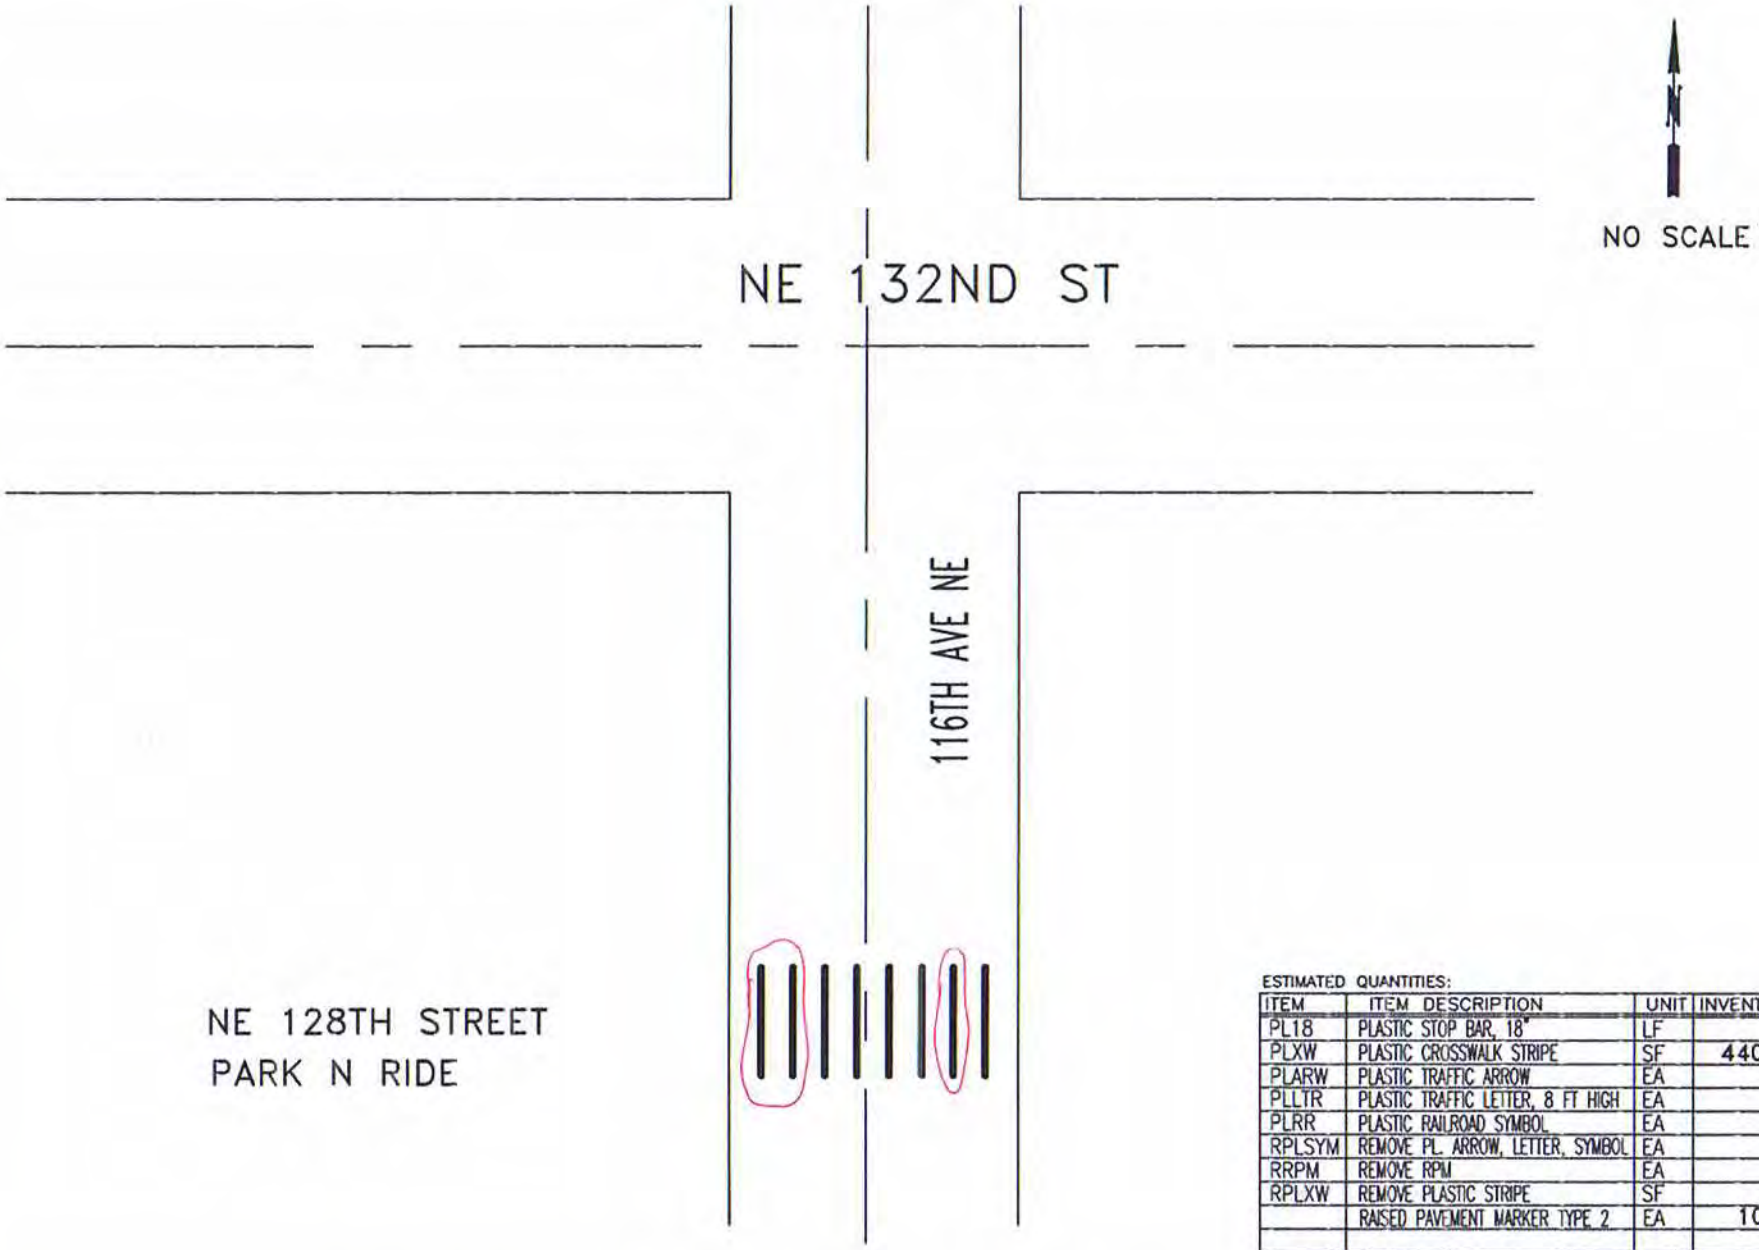

ESTIMATED QUANTITIES:

ITEM	ITEM DESCRIPTION	UNIT	INVENTORY	REPAIR QTY
PL18	PLASTIC STOP BAR, 18"	LF		
PLXW	PLASTIC CROSSWALK STRIPE	SF	440	60
PLARW	PLASTIC TRAFFIC ARROW	EA		
PLLTR	PLASTIC TRAFFIC LETTER, 8 FT HIGH	EA		
PLRR	PLASTIC RAILROAD SYMBOL	EA		
RPLSYM	REMOVE PL. ARROW, LETTER, SYMBOL	EA		
RRPM	REMOVE RPM	EA		
RPLXW	REMOVE PLASTIC STRIPE	SF		40
	RAISED PAVEMENT MARKER TYPE 2	EA	10	

CITY OF KIRKLAND WASHINGTON

CITY OF KIRKLAND
DEPARTMENT OF PUBLIC WORKS
123 FIFTH AVENUE KIRKLAND, WA 98033
(425) 587-3800 www.kirklandwa.gov

L. KAWAOKA 3/2017
DESIGNED BY: DATE

J.JENNINGS 3/2017
DRAWN BY: DATE

CHECKED BY: DATE

20__ PAVEMENT MARKING PROGRAM

STREET: 116TH AVE NE

CROSS STREET: 128TH ST PARK N RIDE

SEGMENT:

SCALE: N.T.S.

FILENAME: 2-44

SOUTH JUANITA INTERSECTION PLANS

CITY OF KIRKLAND
DEPARTMENT OF PUBLIC WORKS
123 FIFTH AVENUE KIRKLAND, WA 98033
(425) 587-3800 www.kirklandwa.gov

S GONSAR	1/2019	DESIGNED BY: DATE
J.JENNINGS	1/2019	DRAWN BY: DATE
		CHECKED BY: DATE

2020 PAVEMENT MARKING PROGRAM

STREET:

CROSS STREET:

SEGMENT:

SCALE: N.T.S.

FILENAME: 4-0

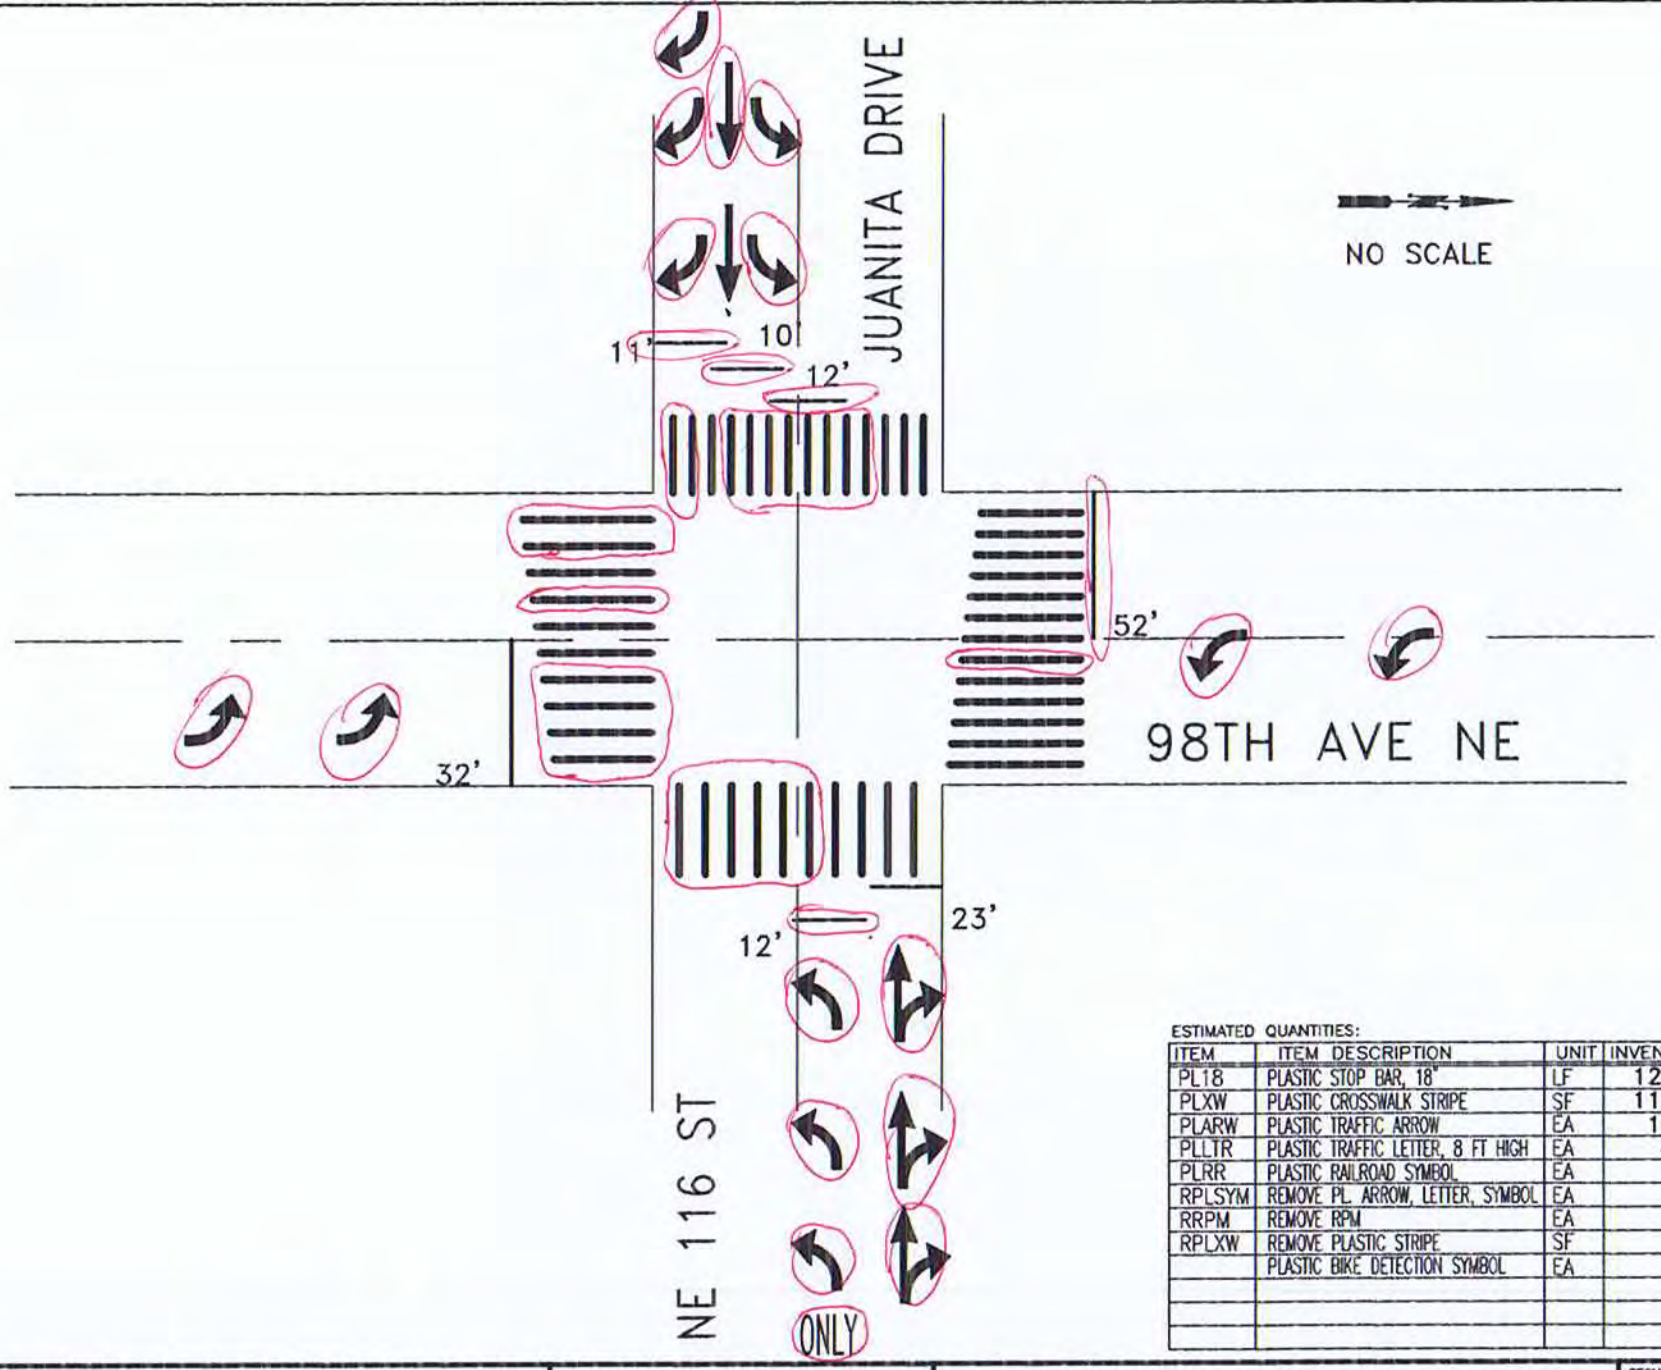

ESTIMATED QUANTITIES:

ITEM	ITEM DESCRIPTION	UNIT	INVENTORY	REPAIR QTY
PL18	PLASTIC STOP BAR, 18"	LF	128	93
PLXW	PLASTIC CROSSWALK STRIPE	SF	1162	582
PLARW	PLASTIC TRAFFIC ARROW	EA	17	1
PLLTR	PLASTIC TRAFFIC LETTER, 8 FT HIGH	EA	4	4
PLRR	PLASTIC RAILROAD SYMBOL	EA		
RPLSYM	REMOVE PL. ARROW, LETTER, SYMBOL	EA		2
RRPM	REMOVE RPM	EA		
RPLXW	REMOVE PLASTIC STRIPE	SF		140
	PLASTIC BIKE DETECTION SYMBOL	EA	6	

CITY OF KIRKLAND
DEPARTMENT OF PUBLIC WORKS
123 FIFTH AVENUE KIRKLAND, WA 98033
(425) 587-3800 www.kirklandwa.gov

G. HORTILLOSA 10/2012
DESIGNED BY: DATE

J.JENNINGS 10/2012
DRAWN BY: DATE

CHECKED BY: DATE

2012 PAVEMENT MARKING PROGRAM

STREET: JUANITA DRIVE

CROSS STREET: 98TH AVE NE

SEGMENT:

SCALE: N.T.S.

FILENAME: Page 4-1

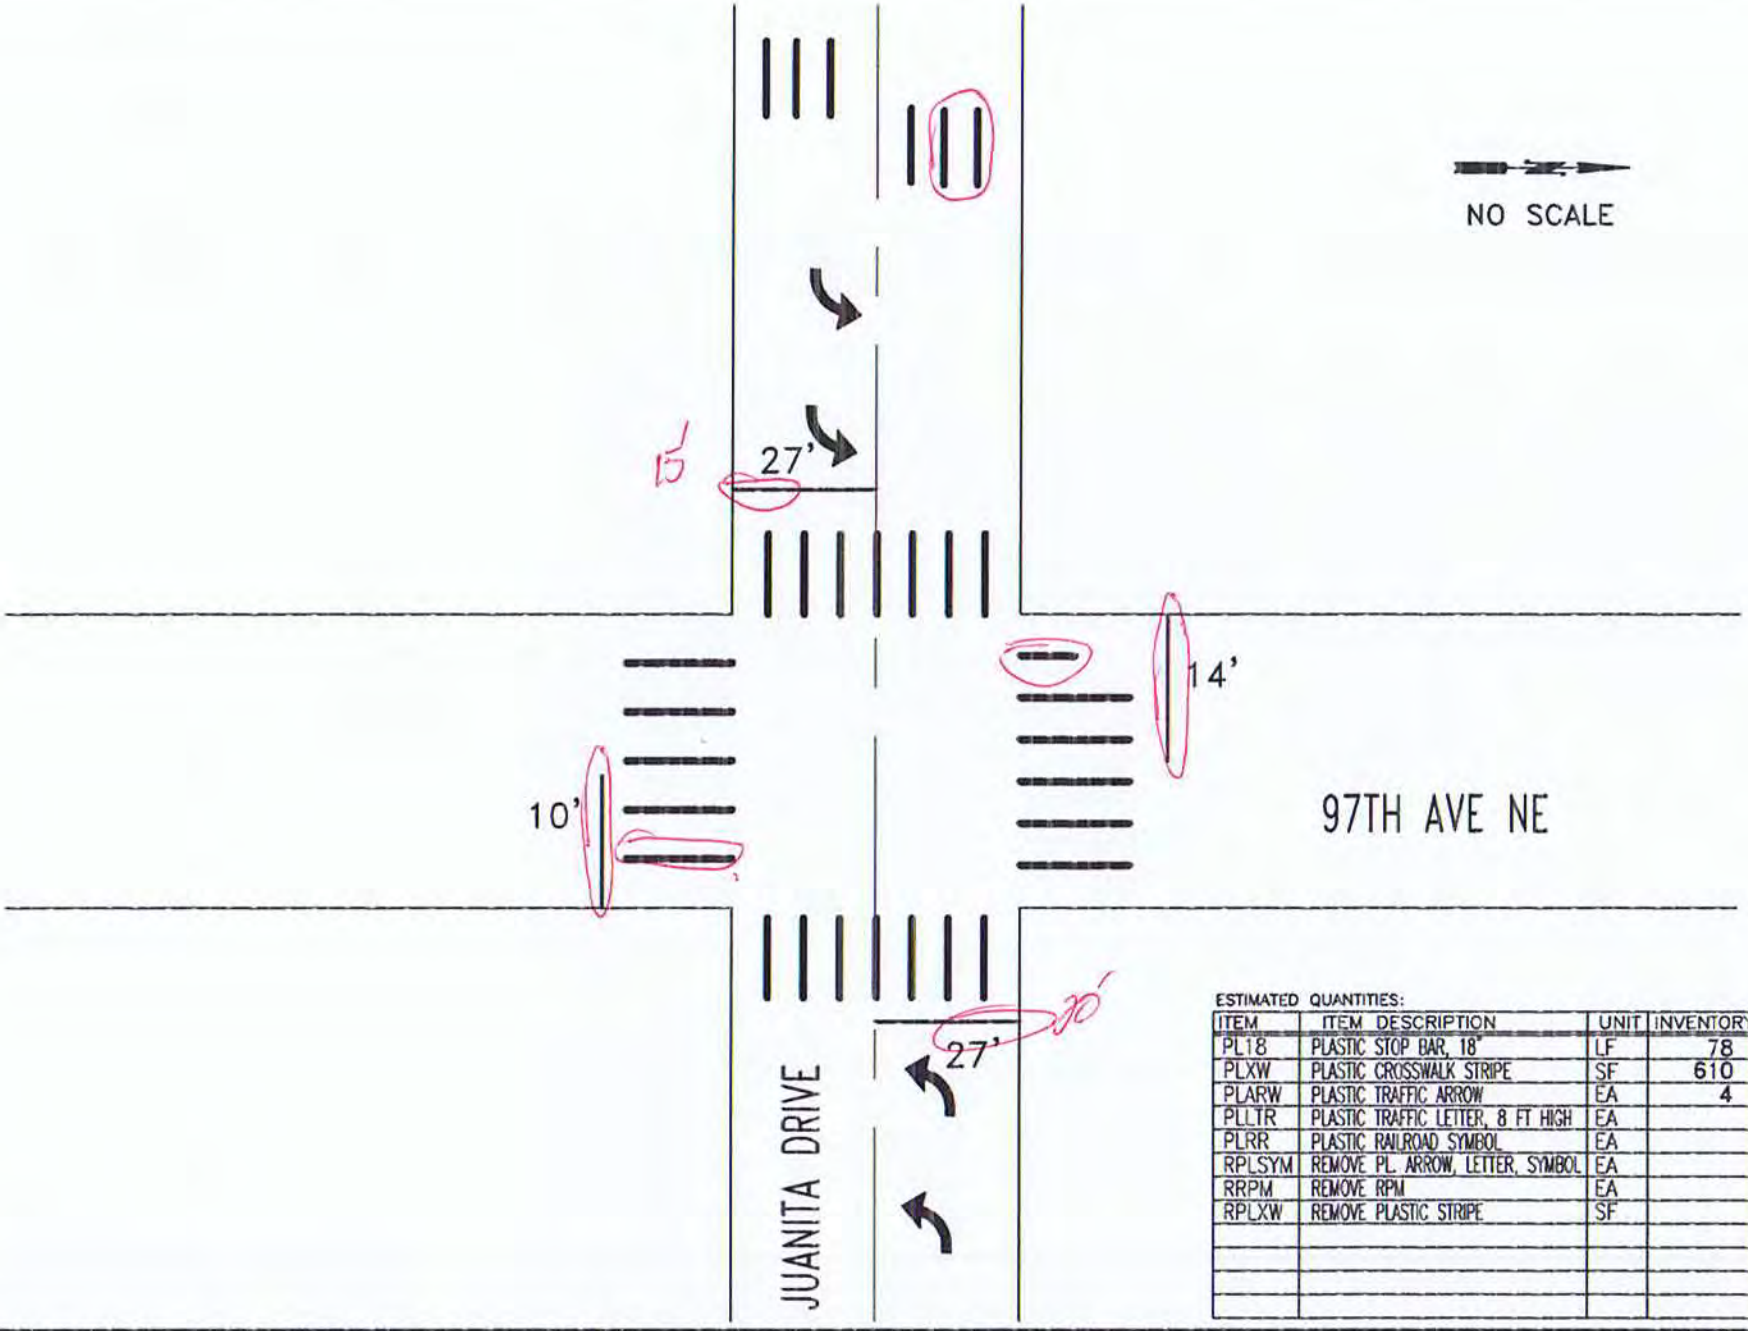

ESTIMATED QUANTITIES:

ITEM	ITEM DESCRIPTION	UNIT	INVENTORY	REPAIR QTY
PL18	PLASTIC STOP BAR, 18"	LF	78	36
PLXW	PLASTIC CROSSWALK STRIPE	SF	610	30
PLARW	PLASTIC TRAFFIC ARROW	EA	4	
PLLTR	PLASTIC TRAFFIC LETTER, 8 FT HIGH	EA		
PLRR	PLASTIC RAILROAD SYMBOL	EA		
RPLSYM	REMOVE PL. ARROW, LETTER, SYMBOL	EA		
RRPM	REMOVE RPM	EA		
RPLXW	REMOVE PLASTIC STRIPE	SF		

CITY OF KIRKLAND
DEPARTMENT OF PUBLIC WORKS
123 FIFTH AVENUE KIRKLAND, WA 98033
(425) 587-3800 www.kirklandwa.gov

S.GONSAR 2/2019
DESIGNED BY: DATE

J.JENNINGS 2/2019
DRAWN BY: DATE

CHECKED BY: DATE

2022 PAVEMENT MARKING PROGRAM

STREET: JUANITA DRIVE

CROSS STREET: 97TH AVE NE

SEGMENT:

SCALE: N.T.S.

FILENAME: Page 4-2

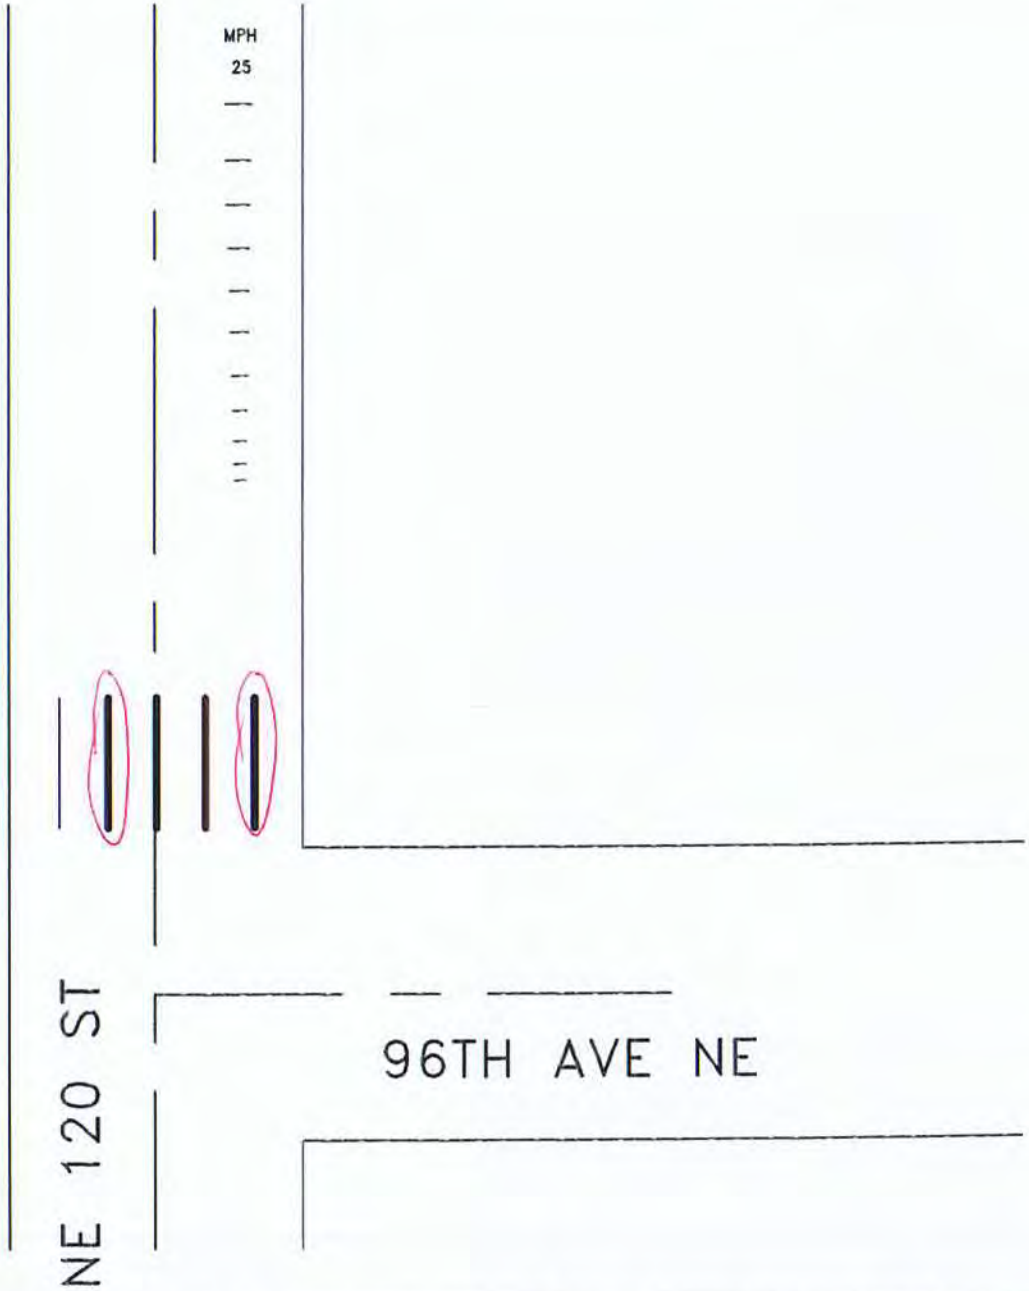

NO SCALE

ESTIMATED QUANTITIES:

ITEM	ITEM DESCRIPTION	UNIT	INVENTORY	REPAIR QTY
PL18	PLASTIC STOP BAR, 18"	LF		
PLXW	PLASTIC CROSSWALK STRIPE	SF	90	40
PLARW	PLASTIC TRAFFIC ARROW	EA		
PLLTR	PLASTIC TRAFFIC LETTER, 8 FT HIGH	EA	5	
PLRR	PLASTIC RAILROAD SYMBOL	EA		
RPLSYM	REMOVE PL. ARROW, LETTER, SYMBOL	EA		
RRPM	REMOVE RPM	EA		
RPLXW	REMOVE PLASTIC STRIPE	SF		
PLLGD	PLASTIC SPEED LEGEND BARS	SF	62	

CITY OF KIRKLAND
DEPARTMENT OF PUBLIC WORKS
123 FIFTH AVENUE KIRKLAND, WA 98033
(425) 587-3800 www.kirklandwa.gov

G. HORTILLOSA 3/2010
DESIGNED BY: DATE

J.JENNINGS 3/2010
DRAWN BY: DATE

CHECKED BY: DATE

2022 PAVEMENT MARKING PROGRAM

STREET: NE 120 ST

CROSS STREET: 96TH AVE NE

SEGMENT:

SCALE: N.T.S.

FILENAME: Page 4-3

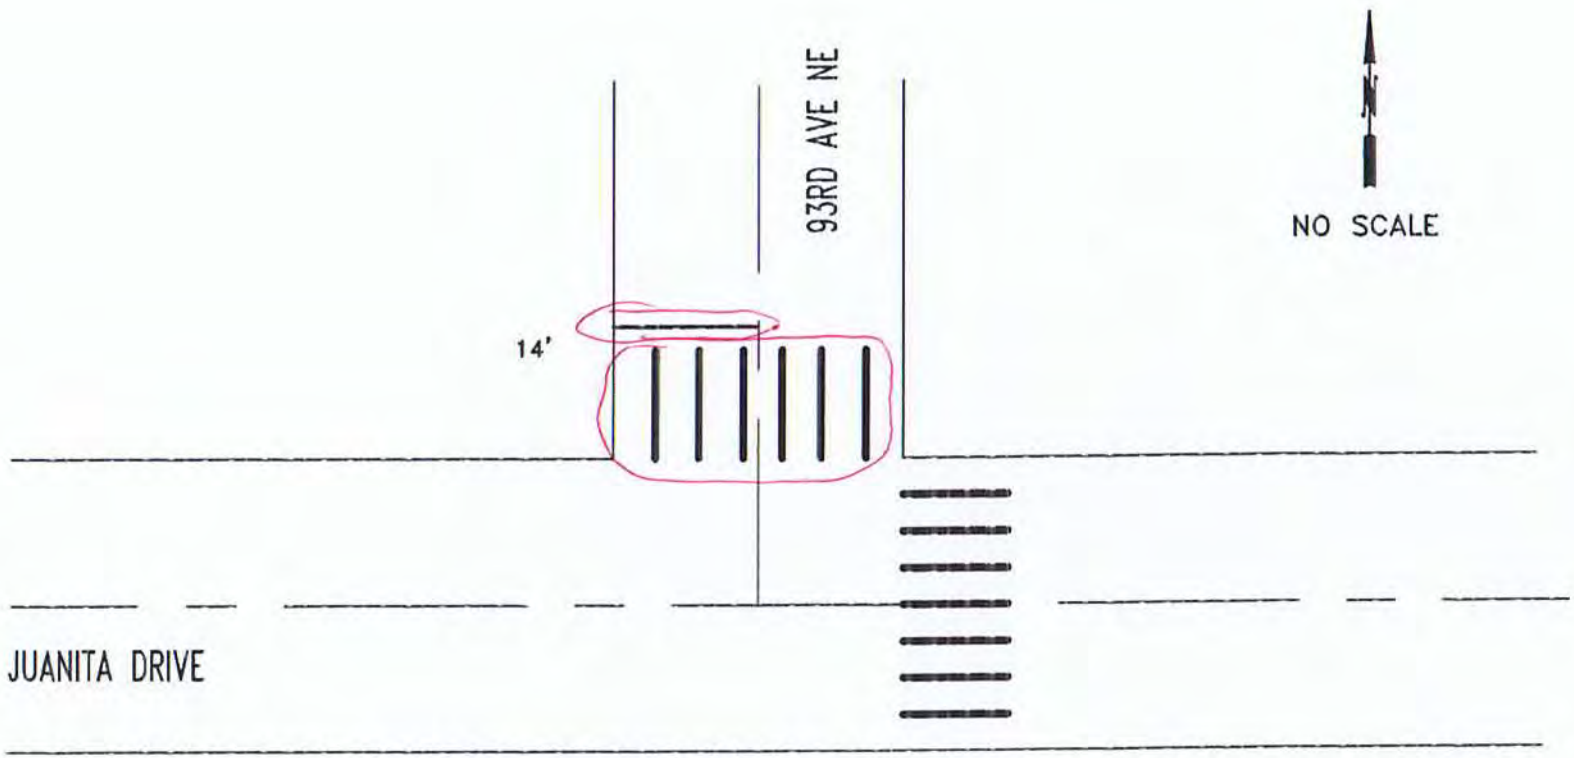

ESTIMATED QUANTITIES:

ITEM	ITEM DESCRIPTION	UNIT	INVENTORY	REPAIR QTY
PL18	PLASTIC STOP BAR, 18"	LF	14	14
PLXW	PLASTIC CROSSWALK STRIPE	SF	260	260
PLARW	PLASTIC TRAFFIC ARROW	EA		
PLLTR	PLASTIC TRAFFIC LETTER, 8 FT HIGH	EA		
PLRR	PLASTIC RAILROAD SYMBOL	EA		
RPLSYM	REMOVE PL. ARROW, LETTER, SYMBOL	EA		
RRPM	REMOVE RPM	EA		
RPLXW	REMOVE PLASTIC STRIPE	SF		40

CITY OF KIRKLAND
DEPARTMENT OF PUBLIC WORKS
123 FIFTH AVENUE KIRKLAND, WA 98033
(425) 587-3800 www.kirklandwa.gov

G. HORTILLOSA 10/2011
DESIGNED BY: DATE

J.JENNINGS 10/2011
DRAWN BY: DATE

CHECKED BY: DATE

2020 PAVEMENT MARKING PROGRAM

STREET: JUANITA DRIVE

CROSS STREET: 93RD AVE NE

SEGMENT: 1690-#10

SCALE: N.T.S.

FILENAME: Page 4-4

NO SCALE

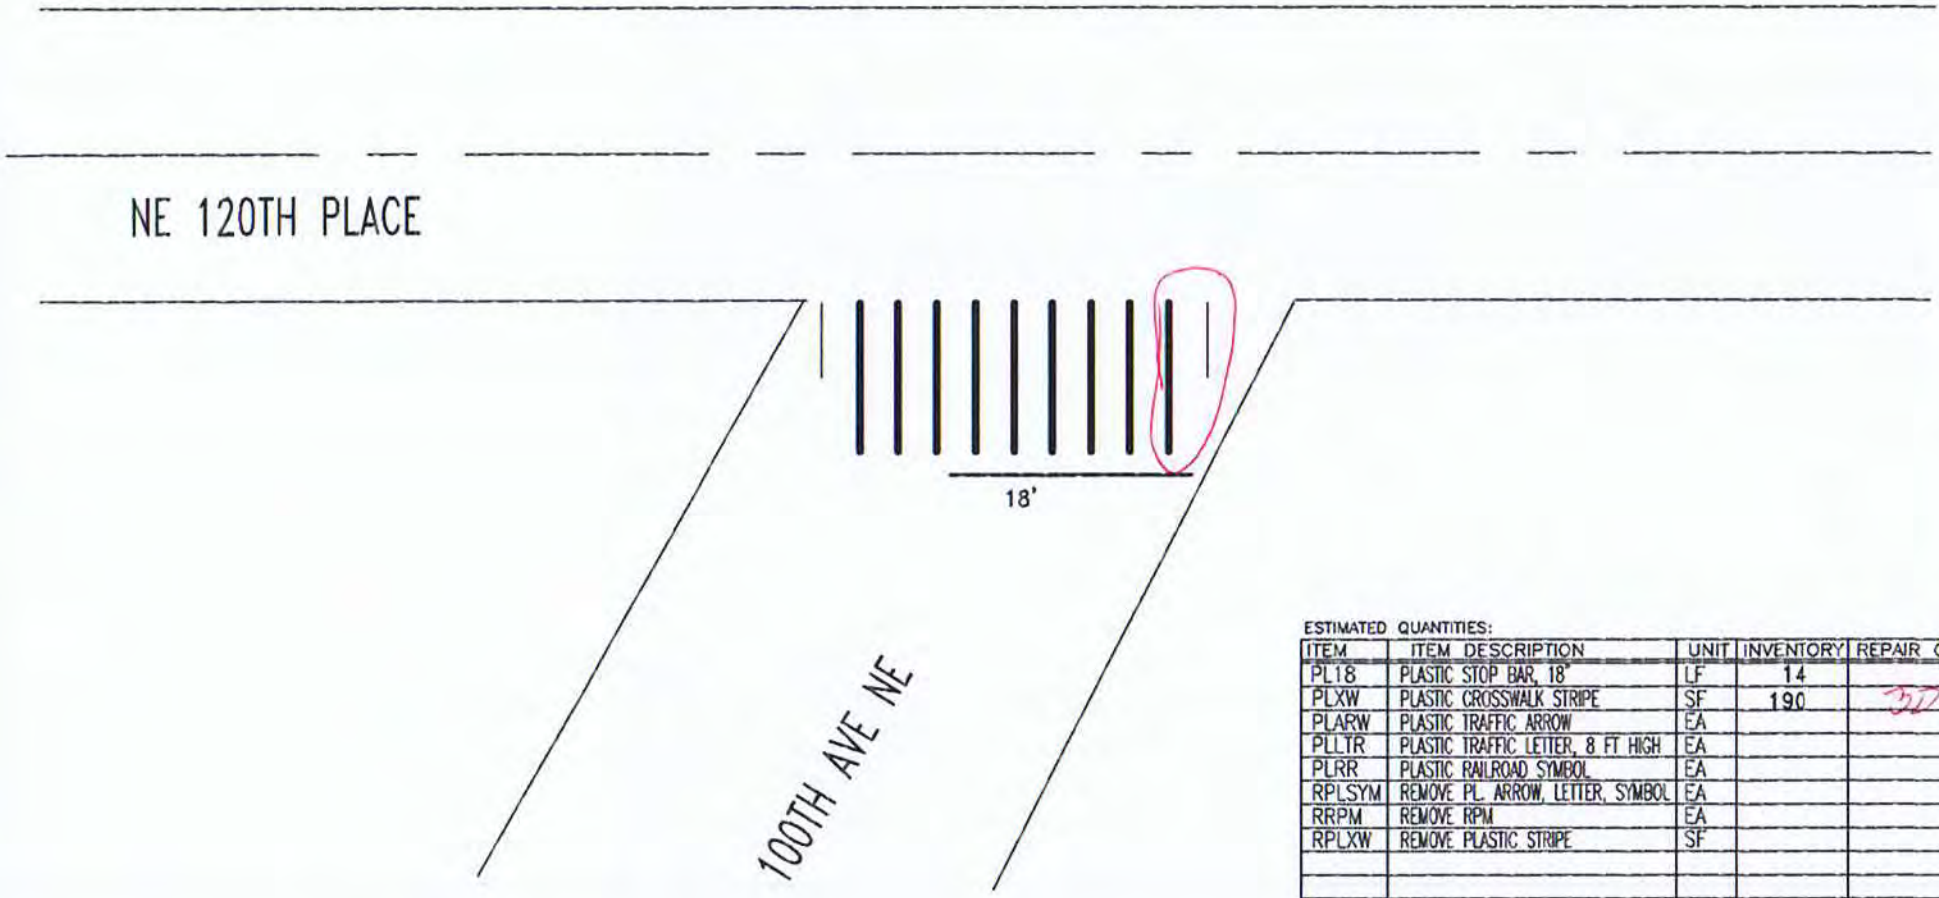

ESTIMATED QUANTITIES:

ITEM	ITEM DESCRIPTION	UNIT	INVENTORY	REPAIR QTY
PL18	PLASTIC STOP BAR, 18"	LF	14	
PLXW	PLASTIC CROSSWALK STRIPE	SF	190	30
PLARW	PLASTIC TRAFFIC ARROW	EA		
PLLTR	PLASTIC TRAFFIC LETTER, 8 FT HIGH	EA		
PLRR	PLASTIC RAILROAD SYMBOL	EA		
RPLSYM	REMOVE PL. ARROW, LETTER, SYMBOL	EA		
RRPM	REMOVE RPM	EA		
RPLXW	REMOVE PLASTIC STRIPE	SF		

CITY OF KIRKLAND WASHINGTON

CITY OF KIRKLAND
DEPARTMENT OF PUBLIC WORKS
123 FIFTH AVENUE KIRKLAND, WA 98033
(425) 587-3800 www.kirklandwa.gov

G. HORTILOSA 10/2011
DESIGNED BY: DATE

J.JENNINGS 10/2011
DRAWN BY: DATE

CHECKED BY: DATE

2020 PAVEMENT MARKING PROGRAM

STREET: 100TH AVE NE

CROSS STREET: NE 120TH PL

SEGMENT:

SCALE: N.T.S.

FILENAME: Page 4-5

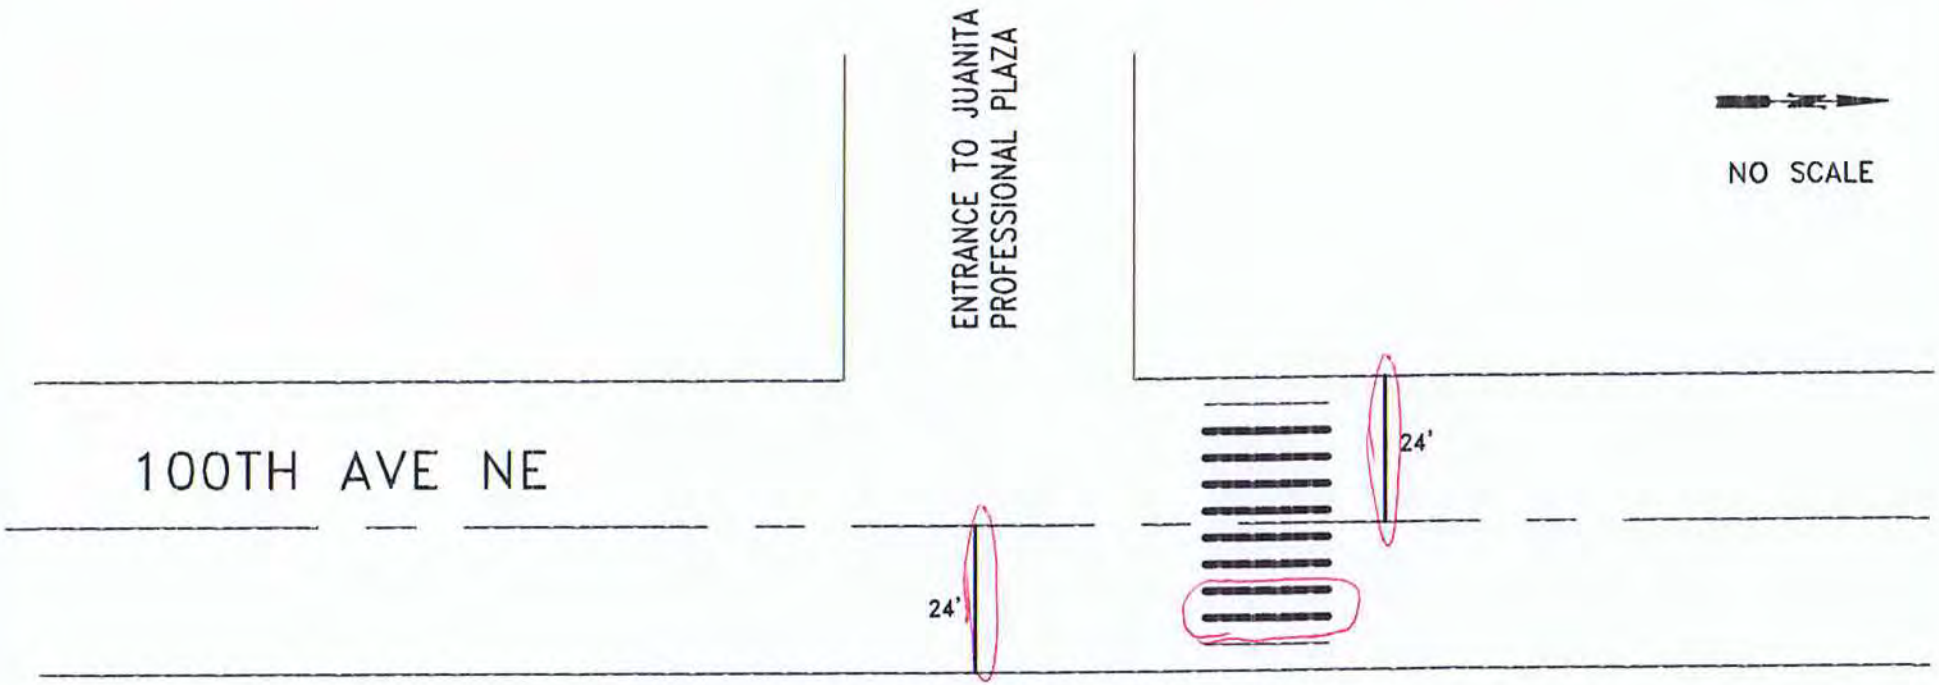

ESTIMATED QUANTITIES:

ITEM	ITEM DESCRIPTION	UNIT	INVENTORY	REPAIR QTY
PL18	PLASTIC STOP BAR, 18"	LF	48	48
PLXW	PLASTIC CROSSWALK STRIPE	SF	180	180
PLARW	PLASTIC TRAFFIC ARROW	EA		
PLLTR	PLASTIC TRAFFIC LETTER, 8 FT HIGH	EA		
PLRR	PLASTIC RAILROAD SYMBOL	EA		
RPLSYM	REMOVE PL. ARROW, LETTER, SYMBOL	EA		
RRPM	REMOVE RPM	EA		
RPLXW	REMOVE PLASTIC STRIPE	SF		
	RAISED PAVEMENT MARKER TYPE 2	EA		

CITY OF KIRKLAND WASHINGTON

CITY OF KIRKLAND
DEPARTMENT OF PUBLIC WORKS
123 FIFTH AVENUE KIRKLAND, WA 98033
(425) 587-3800 www.kirklandwa.gov

G. HORTILLOSA 2/2011
DESIGNED BY: DATE

J.JENNINGS 10/2011
DRAWN BY: DATE

CHECKED BY: DATE

2020 PAVEMENT MARKING PROGRAM

STREET: 100TH AVE NE

CROSS STREET: JUANITA PROFESSIONAL PLAZA

SEGMENT:

SCALE: N.T.S.

FILENAME: Page 4-6

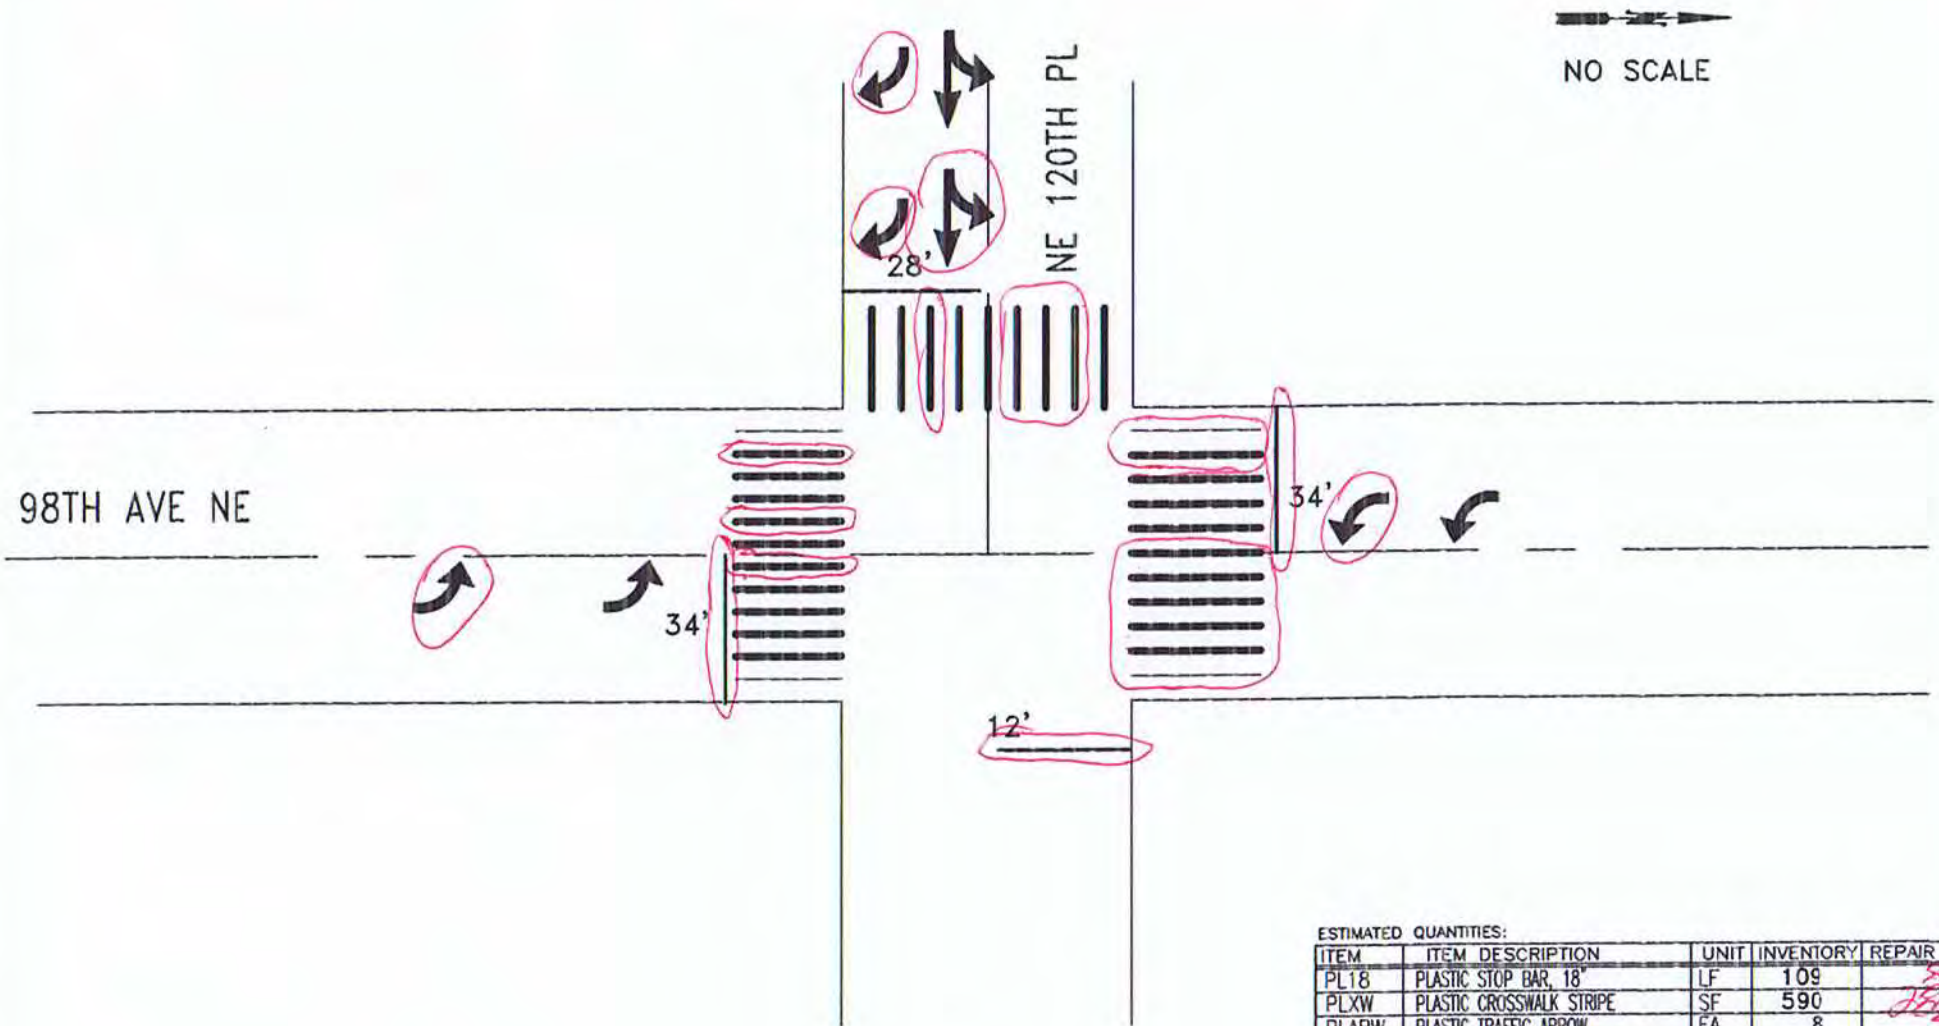

ESTIMATED QUANTITIES:

ITEM	ITEM DESCRIPTION	UNIT	INVENTORY	REPAIR QTY
PL18	PLASTIC STOP BAR, 18"	LF	109	30
PLXW	PLASTIC CROSSWALK STRIPE	SF	590	250
PLARW	PLASTIC TRAFFIC ARROW	EA	8	3
PLLTR	PLASTIC TRAFFIC LETTER, 8 FT HIGH	EA		
PLRR	PLASTIC RAILROAD SYMBOL	EA		
RPLSYM	REMOVE PL. ARROW, LETTER, SYMBOL	EA		
RRPM	REMOVE RPM	EA		
RPLXW	REMOVE PLASTIC STRIPE	SF		100

CITY OF KIRKLAND
DEPARTMENT OF PUBLIC WORKS
123 FIFTH AVENUE KIRKLAND, WA 98033
(425) 587-3800 www.kirklandwa.gov

R. STEITZER 10/2005
DESIGNED BY: DATE

J.JENNINGS 10/2009
DRAWN BY: DATE

CHECKED BY: DATE

2020 PAVEMENT MARKING PROGRAM

STREET: 98TH AVE NE

CROSS STREET: NE 120TH PL

SEGMENT:

SCALE: N.T.S.

FILENAME: Page 4-7

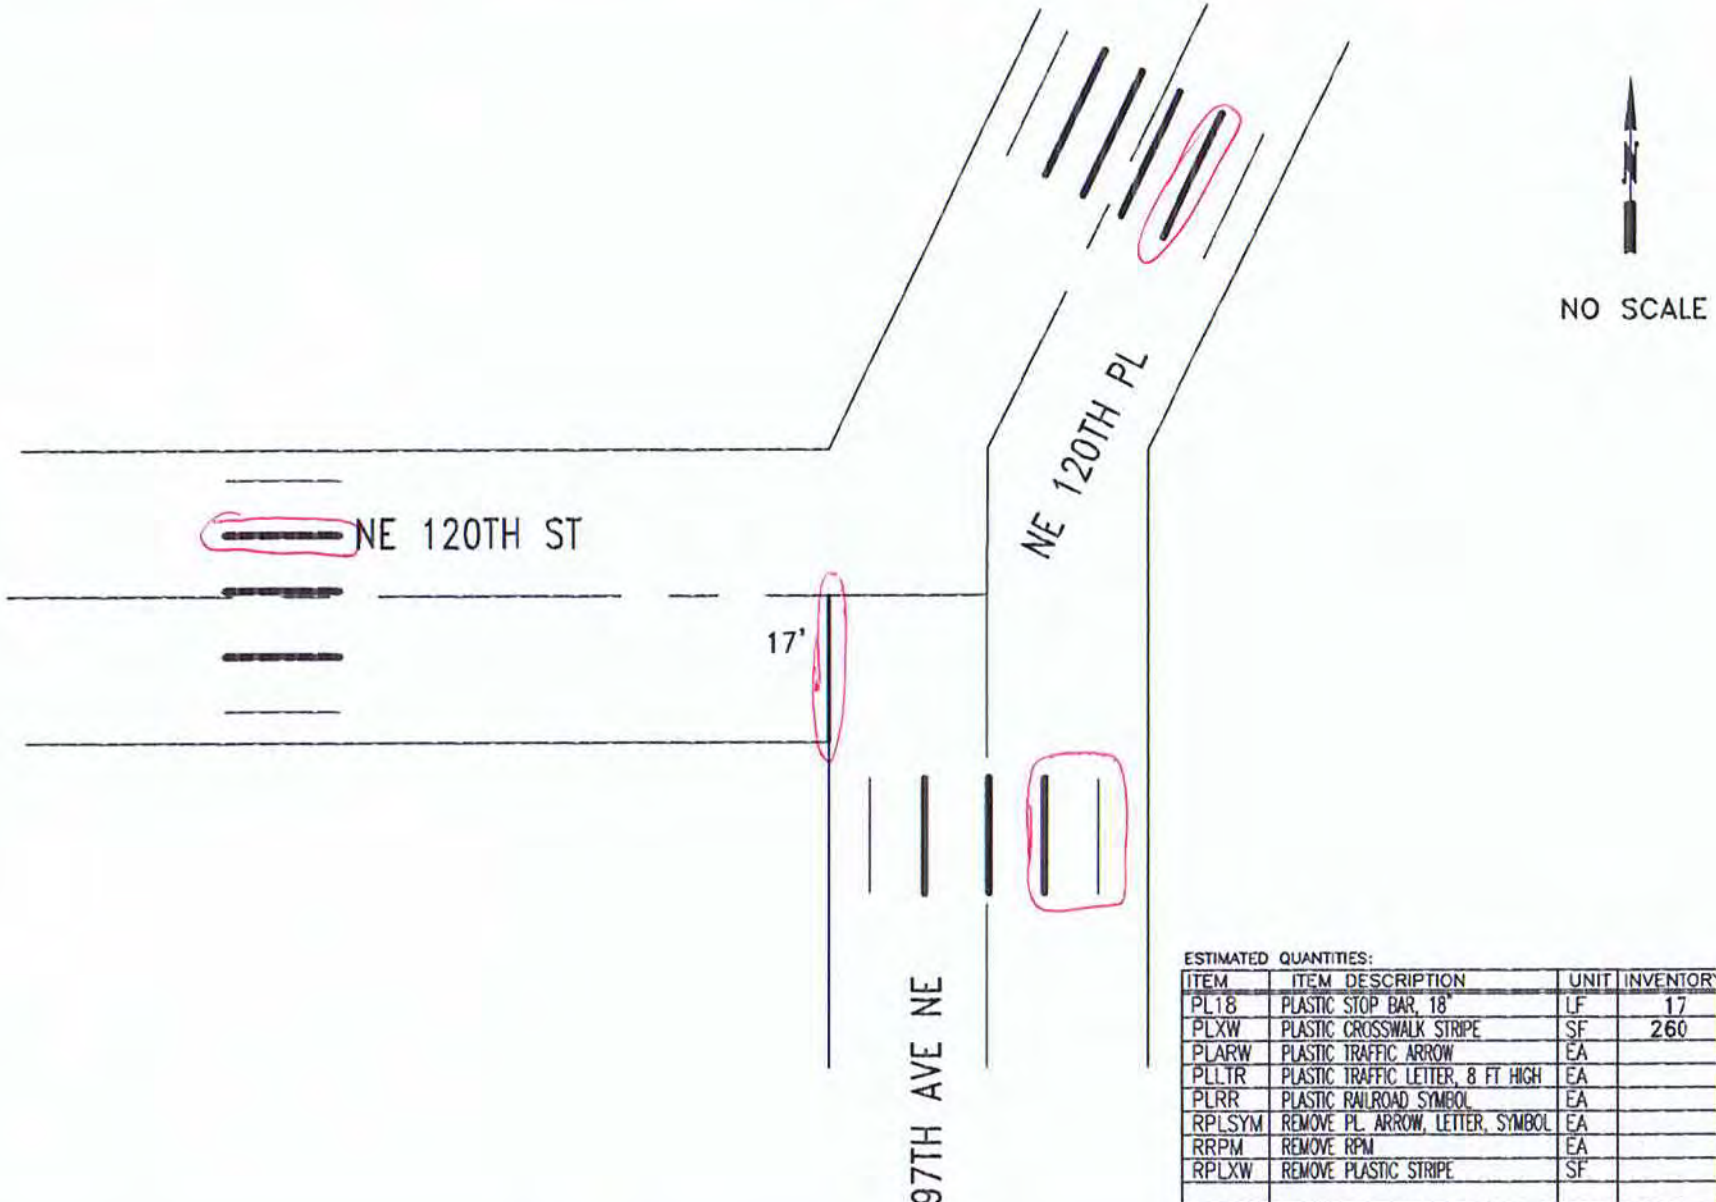

ESTIMATED QUANTITIES:

ITEM	ITEM DESCRIPTION	UNIT	INVENTORY	REPAIR QTY
PL18	PLASTIC STOP BAR, 18"	LF	17	18
PLXW	PLASTIC CROSSWALK STRIPE	SF	260	75
PLARW	PLASTIC TRAFFIC ARROW	EA		
PLLTR	PLASTIC TRAFFIC LETTER, 8 FT HIGH	EA		
PLRR	PLASTIC RAILROAD SYMBOL	EA		
RPLSYM	REMOVE PL. ARROW, LETTER, SYMBOL	EA		
RRPM	REMOVE RPM	EA		
RPLXW	REMOVE PLASTIC STRIPE	SF		

CITY OF KIRKLAND
DEPARTMENT OF PUBLIC WORKS
123 FIFTH AVENUE KIRKLAND, WA 98033
(425) 587-3800 www.kirklandwa.gov

G. HORTILLOSA 2/2011
DESIGNED BY: DATE

J.JENNINGS 10/2011
DRAWN BY: DATE

CHECKED BY: DATE

2020 PAVEMENT MARKING PROGRAM

STREET: NE 120TH PL

CROSS STREET: 97TH AVE NE

SEGMENT: 1800-#10

SCALE: N.T.S.

FILENAME: Page 4-8

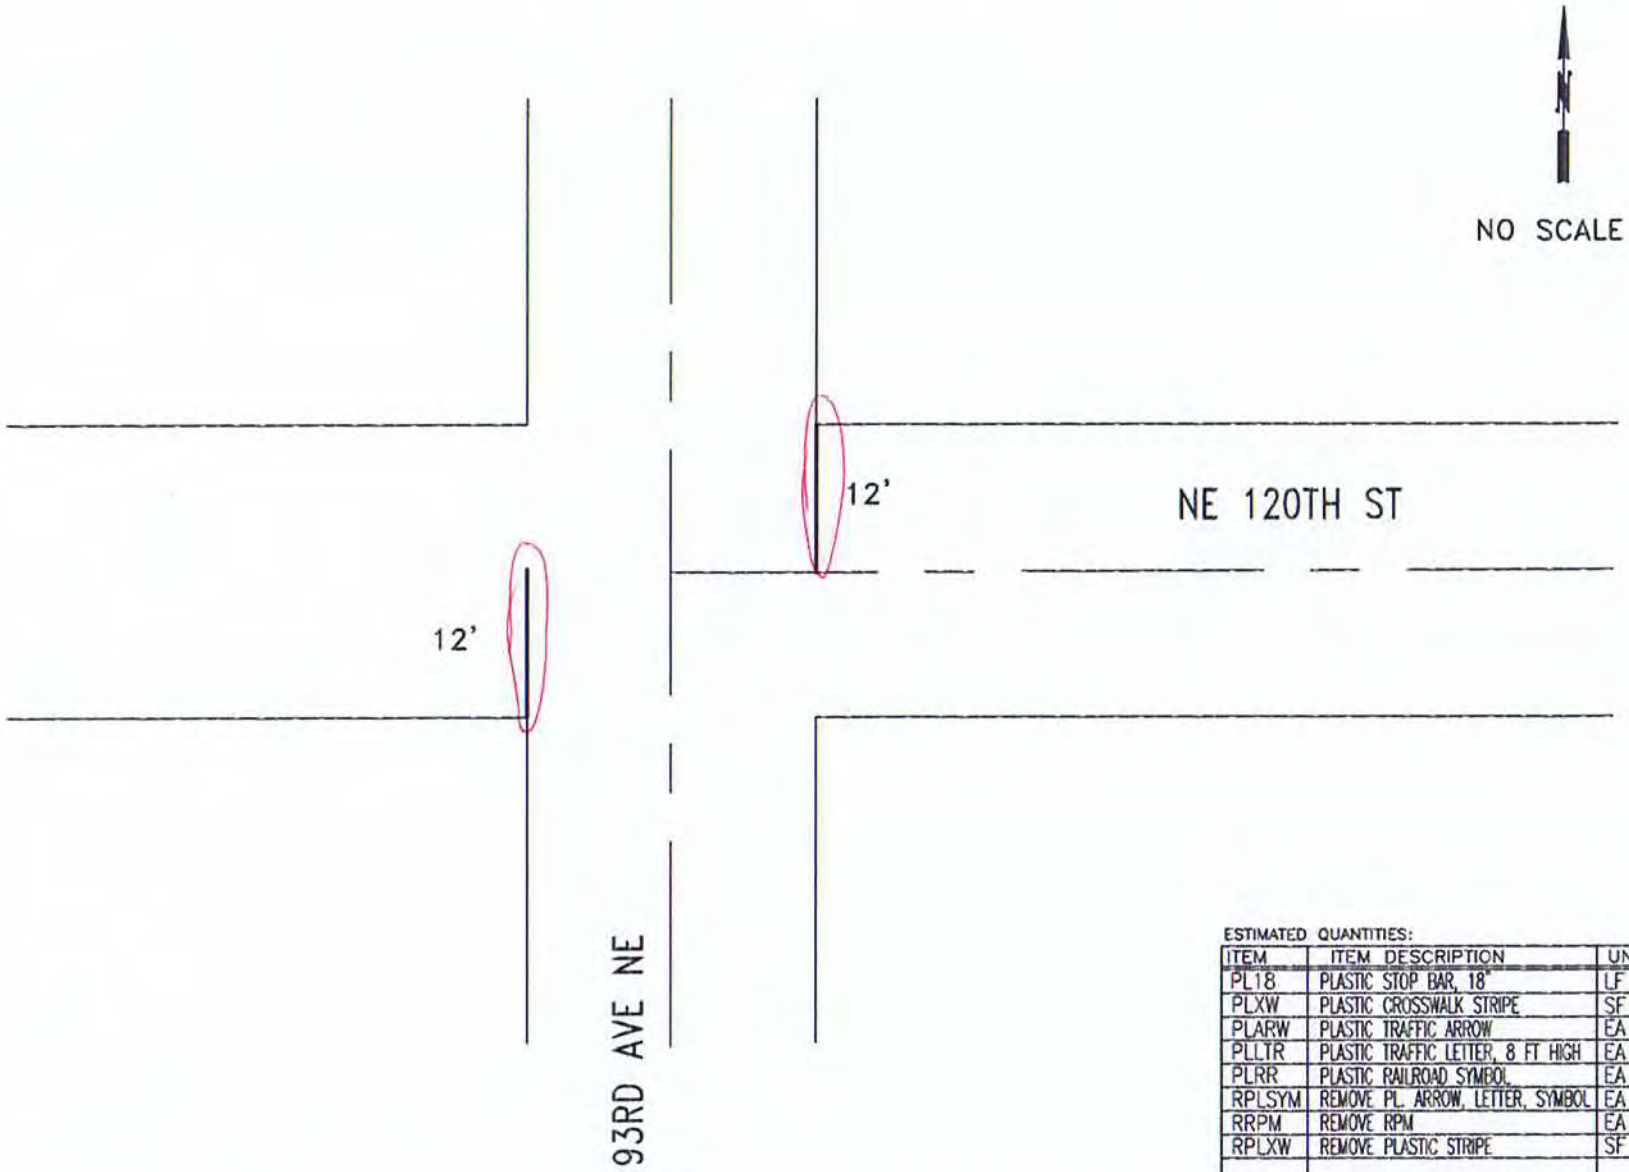

ESTIMATED QUANTITIES:

ITEM	ITEM DESCRIPTION	UNIT	INVENTORY	REPAIR QTY
PL18	PLASTIC STOP BAR, 18"	LF	22	34
PLXW	PLASTIC CROSSWALK STRIPE	SF		
PLARW	PLASTIC TRAFFIC ARROW	EA		
PLLTR	PLASTIC TRAFFIC LETTER, 8 FT HIGH	EA		
PLRR	PLASTIC RAILROAD SYMBOL	EA		
RPLSYM	REMOVE PL. ARROW, LETTER, SYMBOL	EA		
RRPM	REMOVE RPM	EA		
RPLXW	REMOVE PLASTIC STRIPE	SF		

CITY OF KIRKLAND
DEPARTMENT OF PUBLIC WORKS
123 FIFTH AVENUE KIRKLAND, WA 98033
(425) 587-3800 www.kirklandwa.gov

G. HORTILLOSA 10/2011
DESIGNED BY: DATE

J.JENNINGS 10/2011
DRAWN BY: DATE

CHECKED BY: DATE

2022 PAVEMENT MARKING PROGRAM

STREET: 93RD AVE NE

CROSS STREET: NE 120TH ST

SEGMENT:

SCALE: N.T.S.

FILENAME: Page 4-9

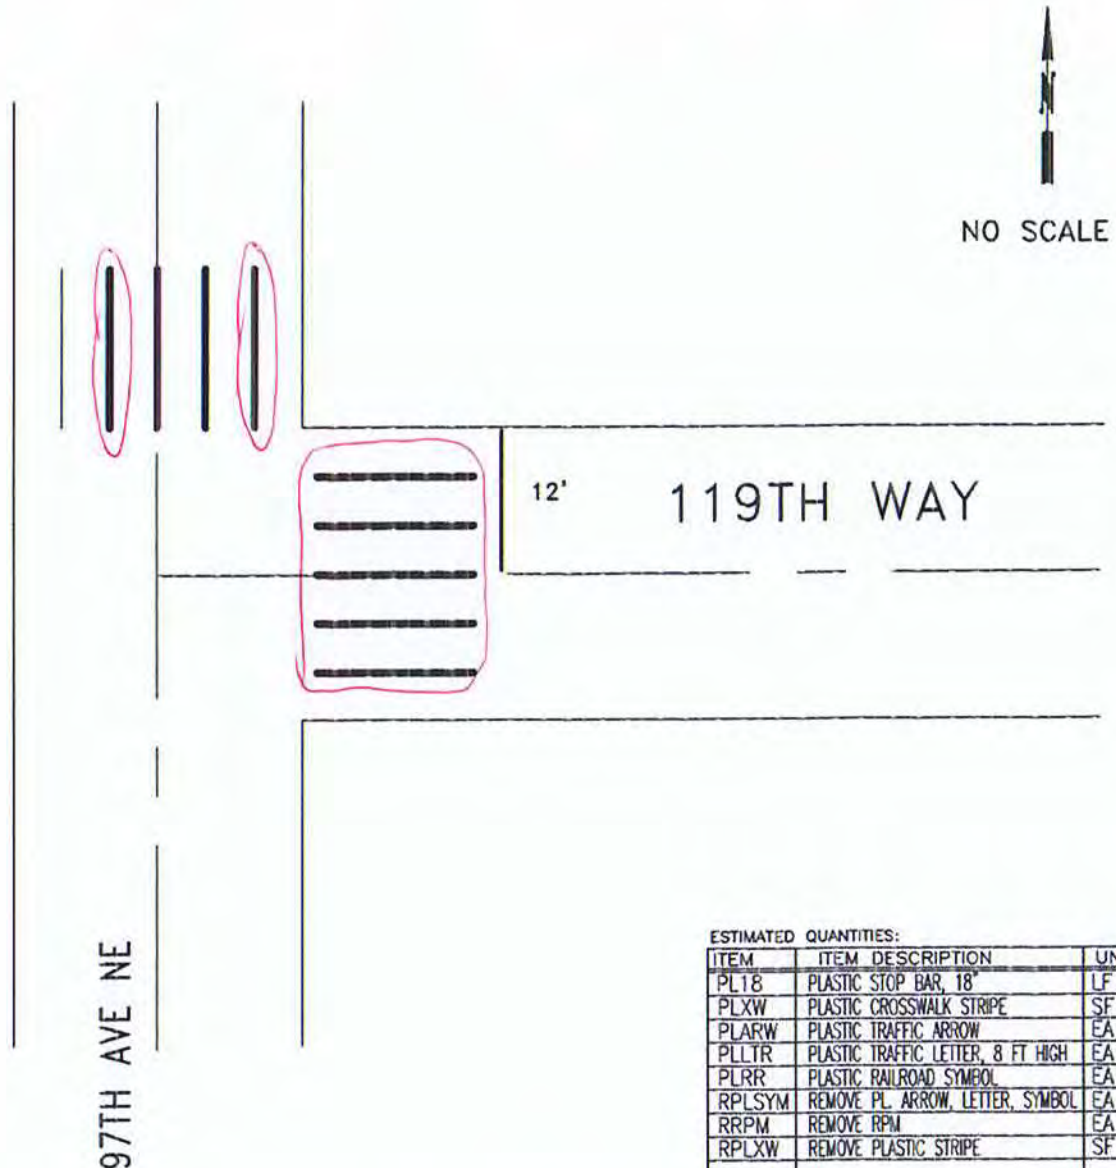

ESTIMATED QUANTITIES:

ITEM	ITEM DESCRIPTION	UNIT	INVENTORY	REPAIR QTY
PL18	PLASTIC STOP BAR, 18"	LF	12	
PLXW	PLASTIC CROSSWALK STRIPE	SF	190	PAD
PLARW	PLASTIC TRAFFIC ARROW	EA		
PLLTR	PLASTIC TRAFFIC LETTER, 8 FT HIGH	EA		
PLRR	PLASTIC RAILROAD SYMBOL	EA		
RPLSYM	REMOVE PL. ARROW, LETTER, SYMBOL	EA		
RRPM	REMOVE RPM	EA		
RPLXW	REMOVE PLASTIC STRIPE	SF		

CITY OF KIRKLAND
DEPARTMENT OF PUBLIC WORKS
123 FIFTH AVENUE KIRKLAND, WA 98033
(425) 587-3800 www.kirklandwa.gov

G. HORTILLOSA 2/2011
DESIGNED BY: DATE

J.JENNINGS 10/2011
DRAWN BY: DATE

CHECKED BY: DATE

2020 PAVEMENT MARKING PROGRAM

STREET: 97TH AVE NE

CROSS STREET: 119TH WAY

SEGMENT:

SCALE: N.T.S.

FILENAME: Page 4-10

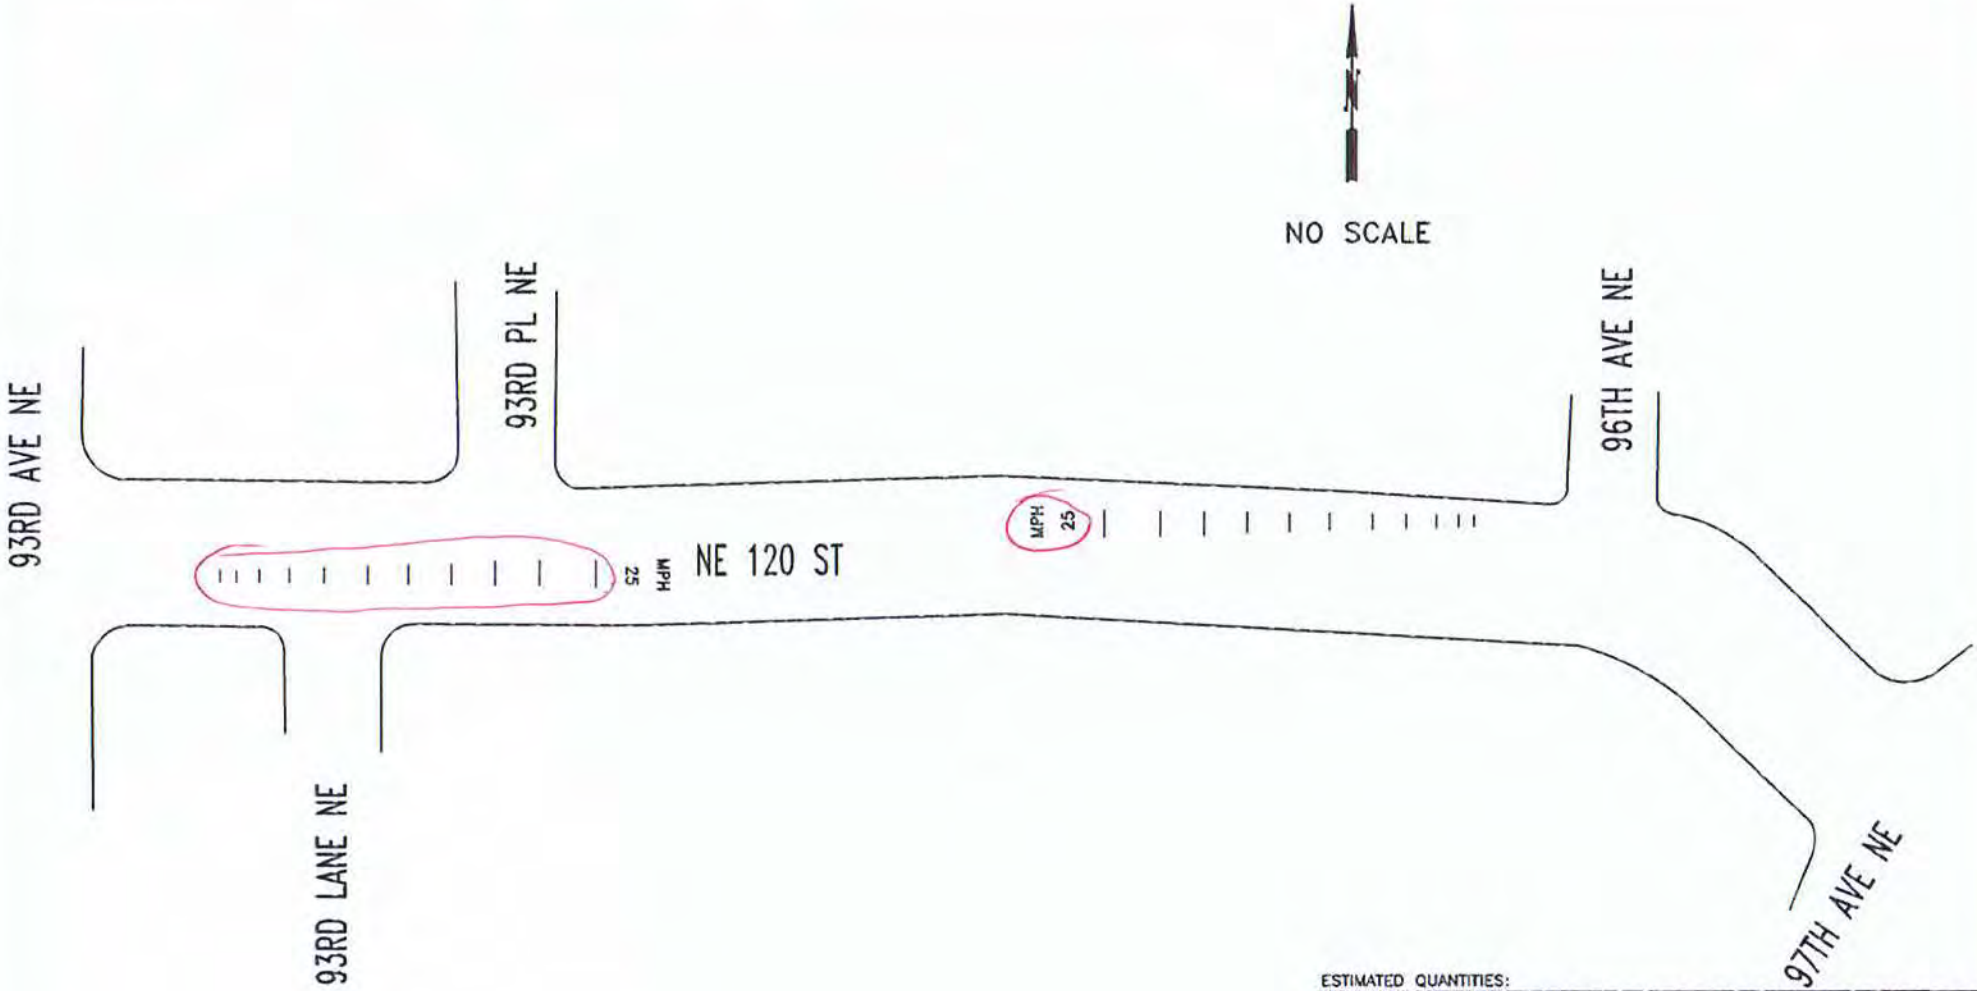

ESTIMATED QUANTITIES:

ITEM	ITEM DESCRIPTION	UNIT	INVENTORY	REPAIR QTY
PL18	PLASTIC STOP BAR, 18"	LF		
PLXW	PLASTIC CROSSWALK STRIPE	SF		
PLARW	PLASTIC TRAFFIC ARROW	EA		
PLLTR	PLASTIC TRAFFIC LETTER, 8 FT HIGH	EA	10	5
PLRR	PLASTIC RAILROAD SYMBOL	EA		
RPLSYM	REMOVE PL. ARROW, LETTER, SYMBOL	EA		
RRPM	REMOVE RPM	EA		
RPLXW	REMOVE PLASTIC STRIPE	SF		
	PLASTIC SPEED LEGEND	SF	124	65

CITY OF KIRKLAND
DEPARTMENT OF PUBLIC WORKS
123 FIFTH AVENUE KIRKLAND, WA 98033
(425) 587-3800 www.kirklandwa.gov

G. HORTILLOSA 4/2007
DESIGNED BY: DATE

J.JENNINGS 4/2007
DRAWN BY: DATE

CHECKED BY: DATE

2020 PAVEMENT MARKING PROGRAM

STREET: NE 120 ST

CROSS STREET: 93RD TO 96TH AVE NE

SEGMENT:

SCALE: N.T.S.

FILENAME: 4-11

NO SCALE

JUANITA VILLAGE

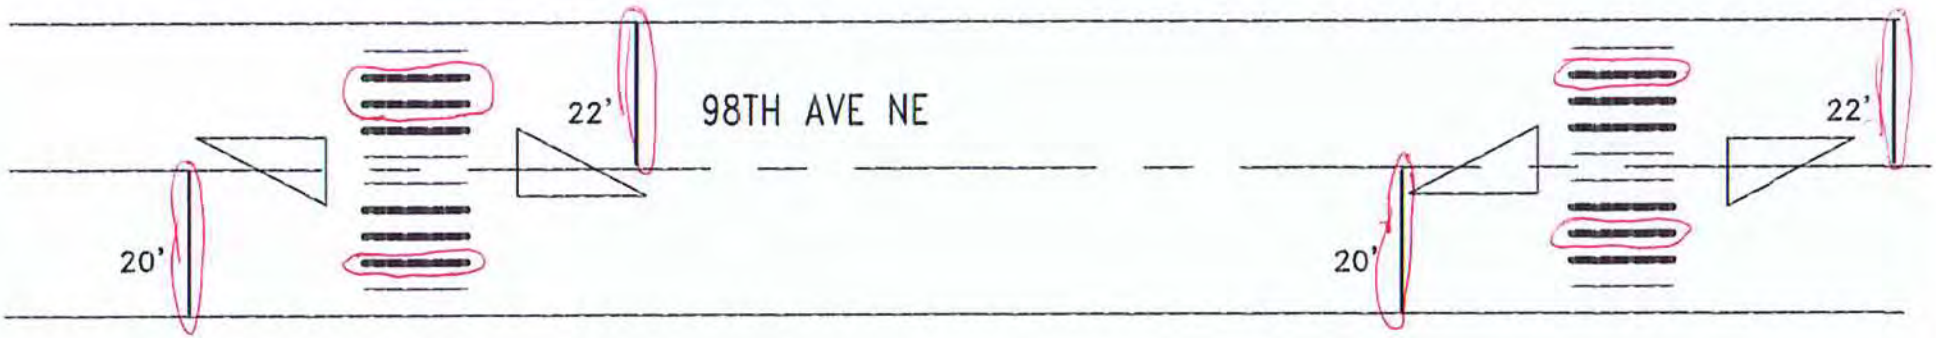

ESTIMATED QUANTITIES:

ITEM	ITEM DESCRIPTION	UNIT	INVENTORY	REPAIR QTY
PL18	PLASTIC STOP BAR, 18"	LF	84	84
PLXW	PLASTIC CROSSWALK STRIPE	SF	320	100
PLARW	PLASTIC TRAFFIC ARROW	EA		
PLLTR	PLASTIC TRAFFIC LETTER, 8 FT HIGH	EA		
PLRR	PLASTIC RAILROAD SYMBOL	EA		
RPLSYM	REMOVE PL. ARROW, LETTER, SYMBOL	EA		
RRPM	REMOVE RPM	EA		
RPLXW	REMOVE PLASTIC STRIPE	SF		80

CITY OF KIRKLAND WASHINGTON

CITY OF KIRKLAND
DEPARTMENT OF PUBLIC WORKS
123 FIFTH AVENUE KIRKLAND, WA 98033
(425) 587-3800 www.kirklandwa.gov

R STEITZER 4/2004
DESIGNED BY: DATE

J.JENNINGS 10/2009
DRAWN BY: DATE

CHECKED BY: DATE

2010 PAVEMENT MARKING PROGRAM

STREET: 98TH AVE NE

CROSS STREET: JUANITA VILLAGE

SEGMENT:

SCALE: N.T.S.

FILENAME: Page 4-12

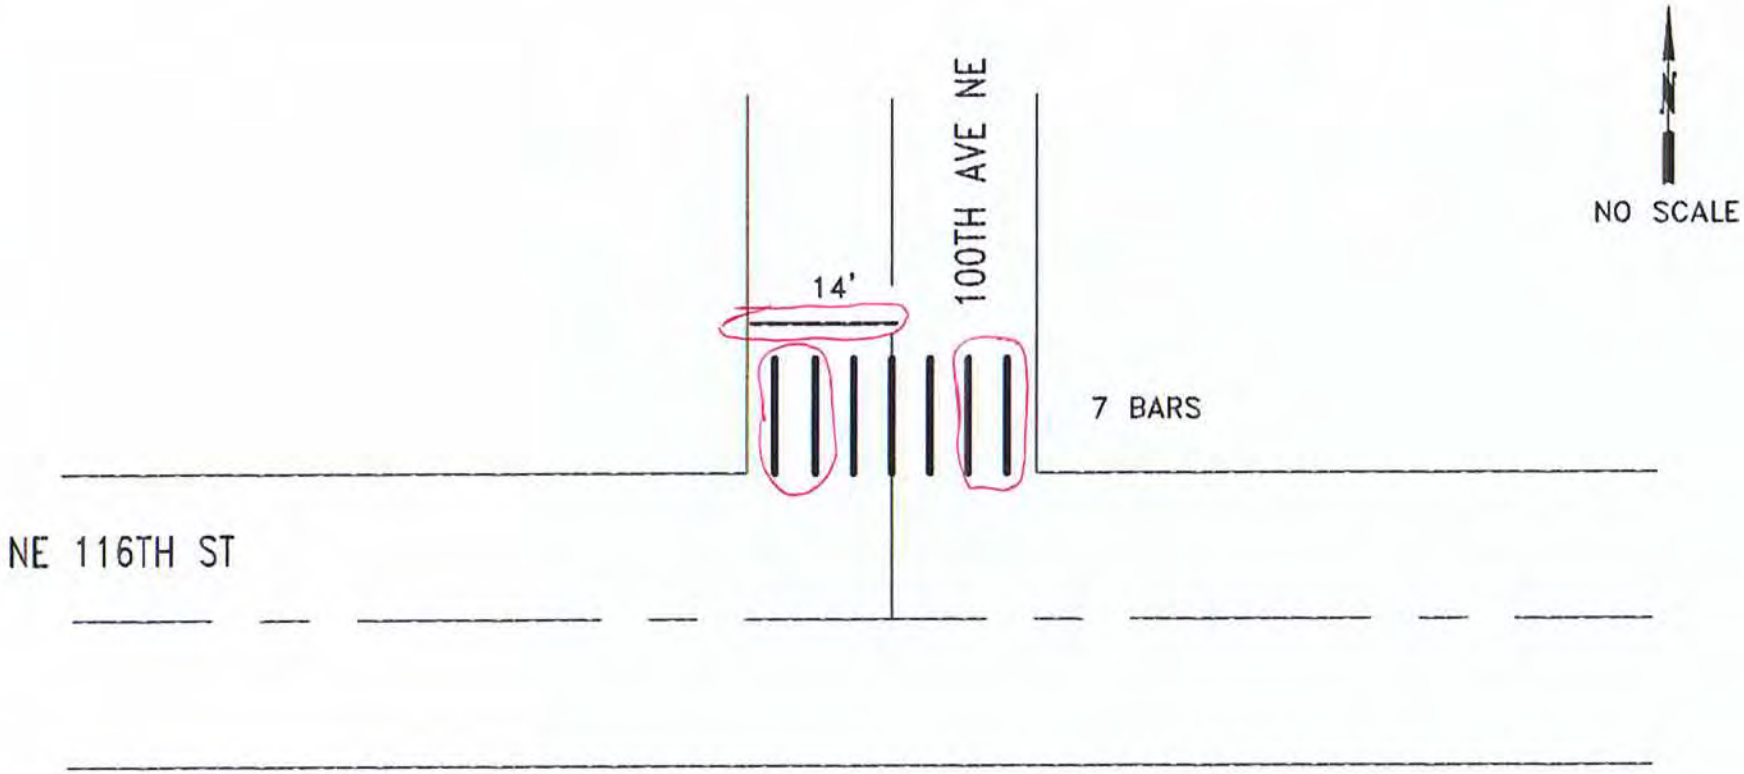

ESTIMATED QUANTITIES:

ITEM	ITEM DESCRIPTION	UNIT	INVENTORY	REPAIR QTY
PL18	PLASTIC STOP BAR, 18"	LF	14	14
PLXW	PLASTIC CROSSWALK STRIPE	SF	140	80
PLARW	PLASTIC TRAFFIC ARROW	EA		
PLLTR	PLASTIC TRAFFIC LETTER, 8 FT HIGH	EA		
PLRR	PLASTIC RAILROAD SYMBOL	EA		
RPLSYM	REMOVE PL. ARROW, LETTER, SYMBOL	EA		
RRPM	REMOVE RPM	EA		
RPLXW	REMOVE PLASTIC STRIPE	SF		

CITY OF KIRKLAND WASHINGTON

CITY OF KIRKLAND
DEPARTMENT OF PUBLIC WORKS
123 FIFTH AVENUE KIRKLAND, WA 98033
(425) 587-3800 www.kirklandwa.gov

G. HORTILLOSA 10/2012
DESIGNED BY: DATE

J.JENNINGS 10/2012
DRAWN BY: DATE

CHECKED BY: DATE

2020 PAVEMENT MARKING PROGRAM

STREET: NE 116TH ST

CROSS STREET: 100TH AVE NE

SEGMENT:

SCALE: N.T.S.

FILENAME: Page 4-13

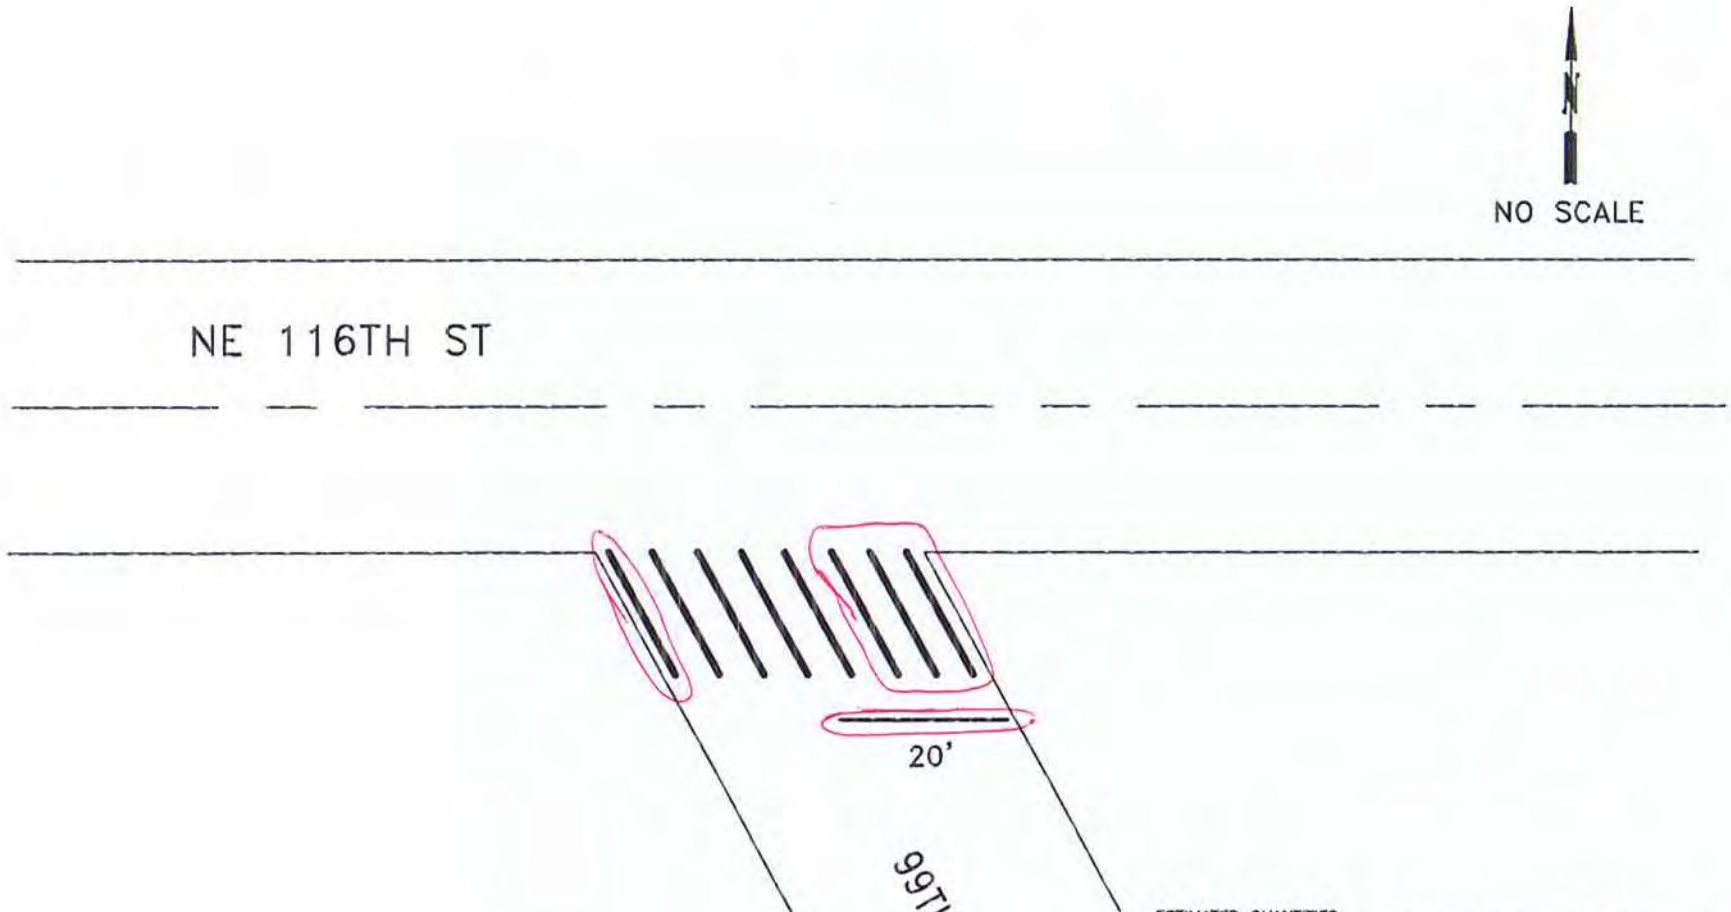

ESTIMATED QUANTITIES:

ITEM	ITEM DESCRIPTION	UNIT	INVENTORY	REPAIR QTY
PL18	PLASTIC STOP BAR, 18"	LF	21	
PLXW	PLASTIC CROSSWALK STRIPE	SF	176	
PLARW	PLASTIC TRAFFIC ARROW	EA		
PLLTR	PLASTIC TRAFFIC LETTER, 8 FT HIGH	EA		
PLRR	PLASTIC RAILROAD SYMBOL	EA		
RPLSYM	REMOVE PL. ARROW, LETTER, SYMBOL	EA		
RRPM	REMOVE RPM	EA		
RPLXW	REMOVE PLASTIC STRIPE	SF		

CITY OF KIRKLAND
DEPARTMENT OF PUBLIC WORKS
123 FIFTH AVENUE KIRKLAND, WA 98033
(425) 587-3800 www.kirklandwa.gov

D.GRILLEY 1/2000
DESIGNED BY: DATE

J.JENNINGS 1/2000
DRAWN BY: DATE

CHECKED BY: DATE

2022 PAVEMENT MARKING PROGRAM

STREET: NE 116TH ST

CROSS STREET: 99TH PL NE

SEGMENT:

SCALE: N.T.S.

FILENAME: Page 4-14

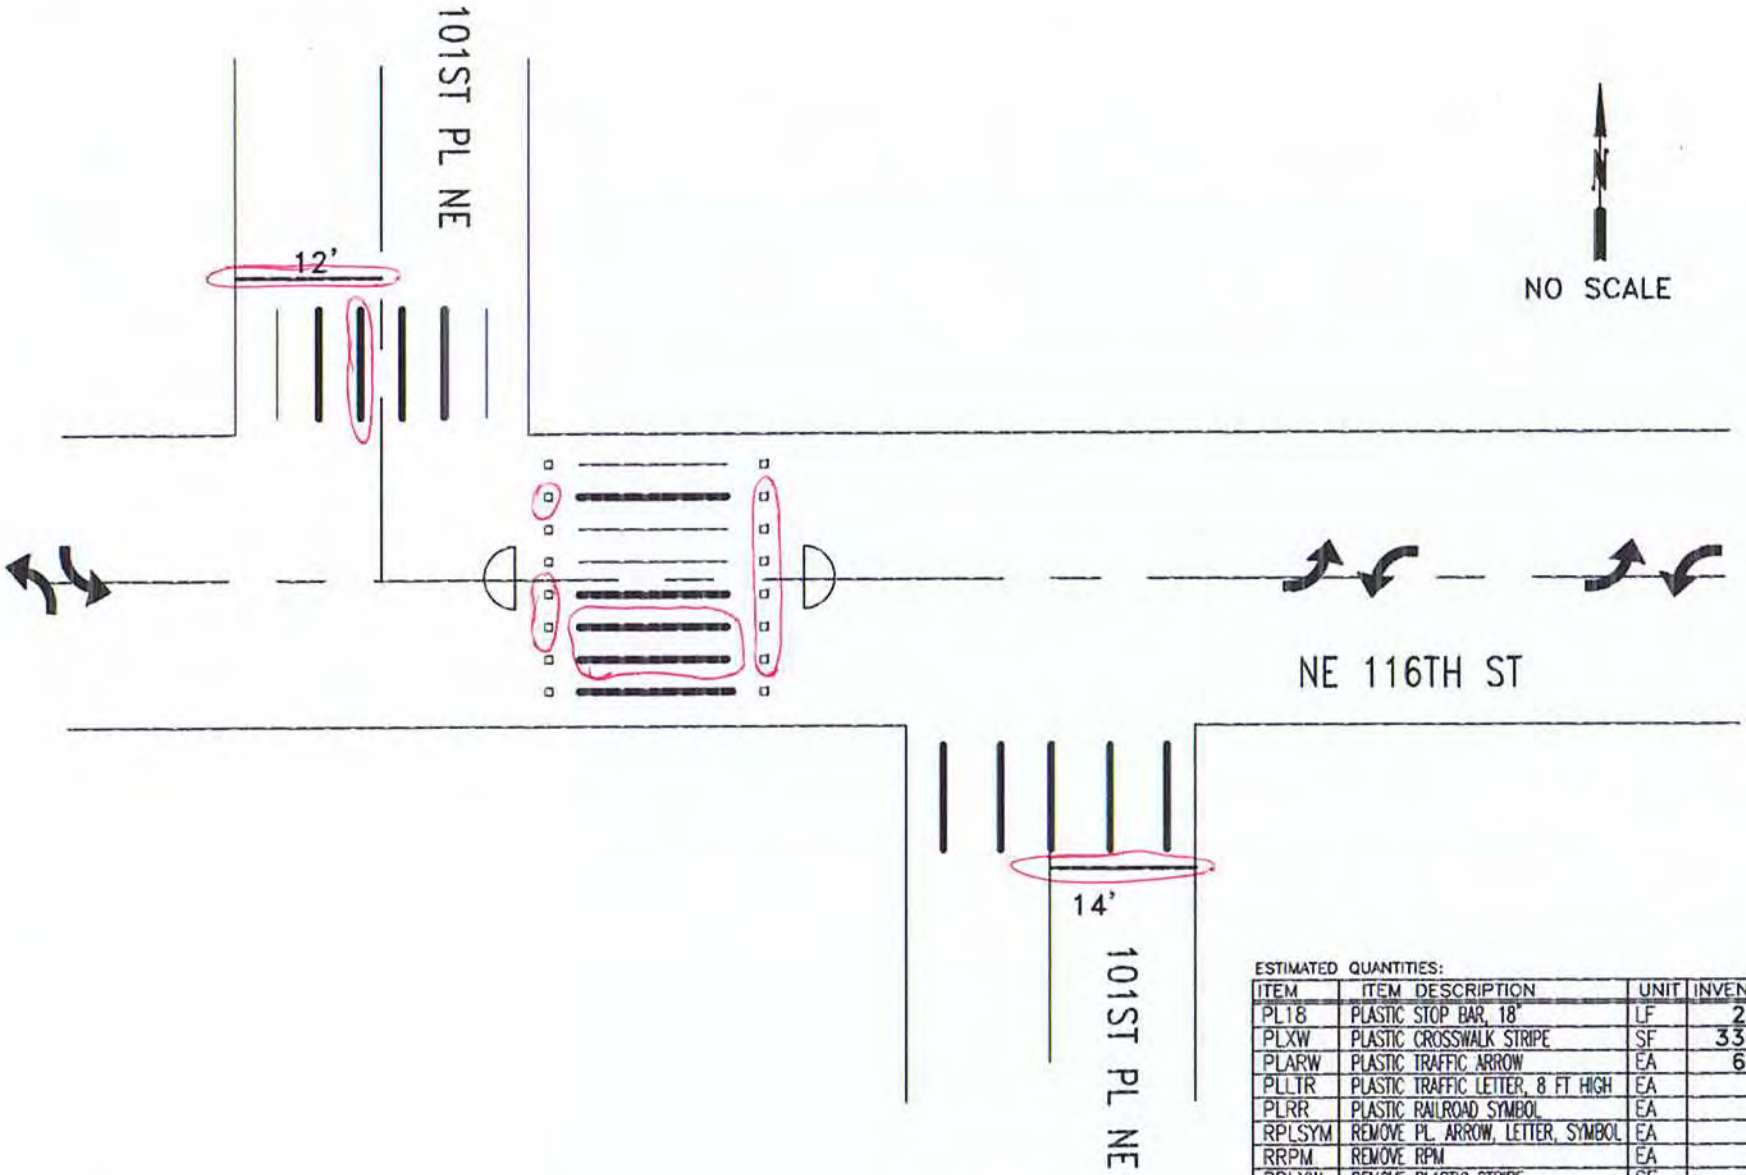

ESTIMATED QUANTITIES:

ITEM	ITEM DESCRIPTION	UNIT	INVENTORY	REPAIR QTY
PL18	PLASTIC STOP BAR, 18"	LF	26	36
PLXW	PLASTIC CROSSWALK STRIPE	SF	330	60
PLARW	PLASTIC TRAFFIC ARROW	EA	6	
PLLTR	PLASTIC TRAFFIC LETTER, 8 FT HIGH	EA		
PLRR	PLASTIC RAILROAD SYMBOL	EA		
RPLSYM	REMOVE PL. ARROW, LETTER, SYMBOL	EA		
RRPM	REMOVE RPM	EA		
RPLXW	REMOVE PLASTIC STRIPE	SF		48
	RAISED PAVEMENT MARKER, TYPE 2	EA	16	

CITY OF KIRKLAND
DEPARTMENT OF PUBLIC WORKS
123 FIFTH AVENUE KIRKLAND, WA 98033
(425) 587-3800 www.kirklandwa.gov

G. HORTILLOSA 4/2007
DESIGNED BY: DATE

J.JENNINGS 10/2009
DRAWN BY: DATE

CHECKED BY: DATE

2020 PAVEMENT MARKING PROGRAM

STREET: NE 116TH ST

CROSS STREET: 101ST PL NE

SEGMENT:

SCALE: N.T.S.

FILENAME: Page 4-15

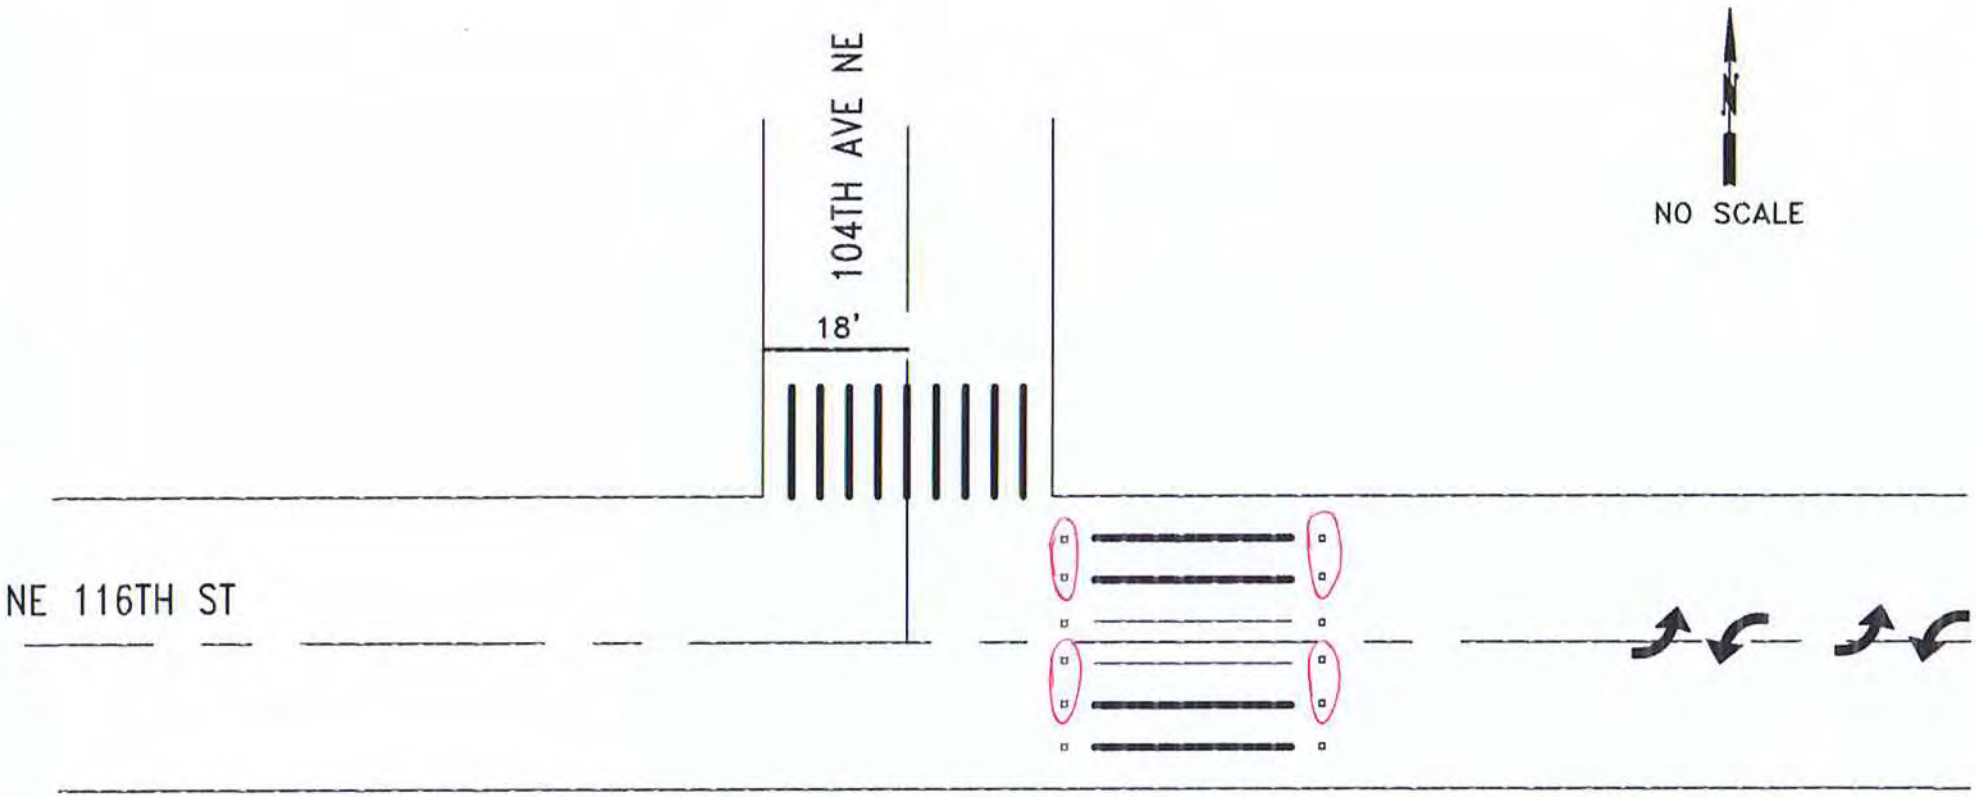

ESTIMATED QUANTITIES:

ITEM	ITEM DESCRIPTION	UNIT	INVENTORY	REPAIR QTY
PL18	PLASTIC STOP BAR, 18"	LF	18	
PLXW	PLASTIC CROSSWALK STRIPE	SF	240	
PLARW	PLASTIC TRAFFIC ARROW	EA		
PLLTR	PLASTIC TRAFFIC LETTER, 8 FT HIGH	EA		
PLRR	PLASTIC RAILROAD SYMBOL	EA		
RPLSYM	REMOVE PL. ARROW, LETTER, SYMBOL	EA		
RRPM	REMOVE RPM	EA		
RPLXW	REMOVE PLASTIC STRIPE	SF		
	RAISED PAVMENT MARKER TYPE 2	EA	14	8

CITY OF KIRKLAND
DEPARTMENT OF PUBLIC WORKS
123 FIFTH AVENUE KIRKLAND, WA 98033
(425) 587-3800 www.kirklandwa.gov

G. HORTILLOSA 10/2011
DESIGNED BY: DATE

J.JENNINGS 10/2011
DRAWN BY: DATE

CHECKED BY: DATE

20 22 PAVEMENT MARKING PROGRAM

STREET: NE 116TH ST

CROSS STREET: 104TH AVE NE

SEGMENT:

SCALE: N.T.S.

FILENAME:

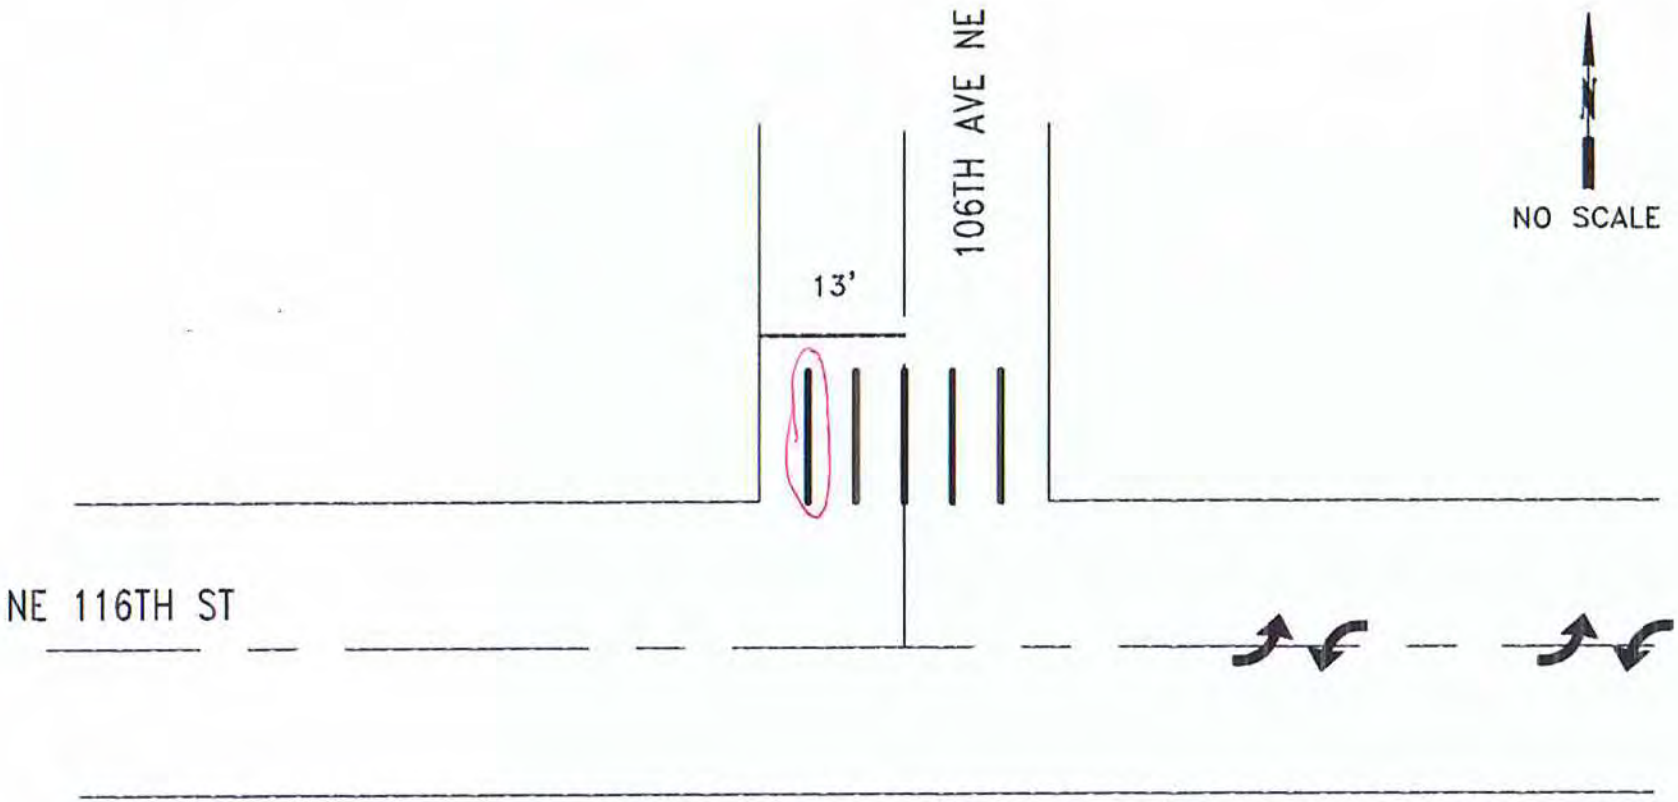

ESTIMATED QUANTITIES:

ITEM	ITEM DESCRIPTION	UNIT	INVENTORY	REPAIR QTY
PL18	PLASTIC STOP BAR, 18"	LF	13	
PLXW	PLASTIC CROSSWALK STRIPE	SF	100	70
PLARW	PLASTIC TRAFFIC ARROW	EA		
PLLTR	PLASTIC TRAFFIC LETTER, 8 FT HIGH	EA		
PLRR	PLASTIC RAILROAD SYMBOL	EA		
RPLSYM	REMOVE PL. ARROW, LETTER, SYMBOL	EA		
RRPM	REMOVE RPM	EA		
RPLXW	REMOVE PLASTIC STRIPE	SF		

CITY OF KIRKLAND WASHINGTON

CITY OF KIRKLAND
DEPARTMENT OF PUBLIC WORKS
123 FIFTH AVENUE KIRKLAND, WA 98033
(425) 587-3800 www.kirklandwa.gov

G. HORTILLOSA 2/2011
DESIGNED BY: DATE

J.JENNINGS 10/2011
DRAWN BY: DATE

CHECKED BY: DATE

2020 PAVEMENT MARKING PROGRAM

STREET: NE 116TH ST

CROSS STREET: 106TH AVE NE

SEGMENT:

SCALE: N.T.S.

FILENAME: Page 4-17

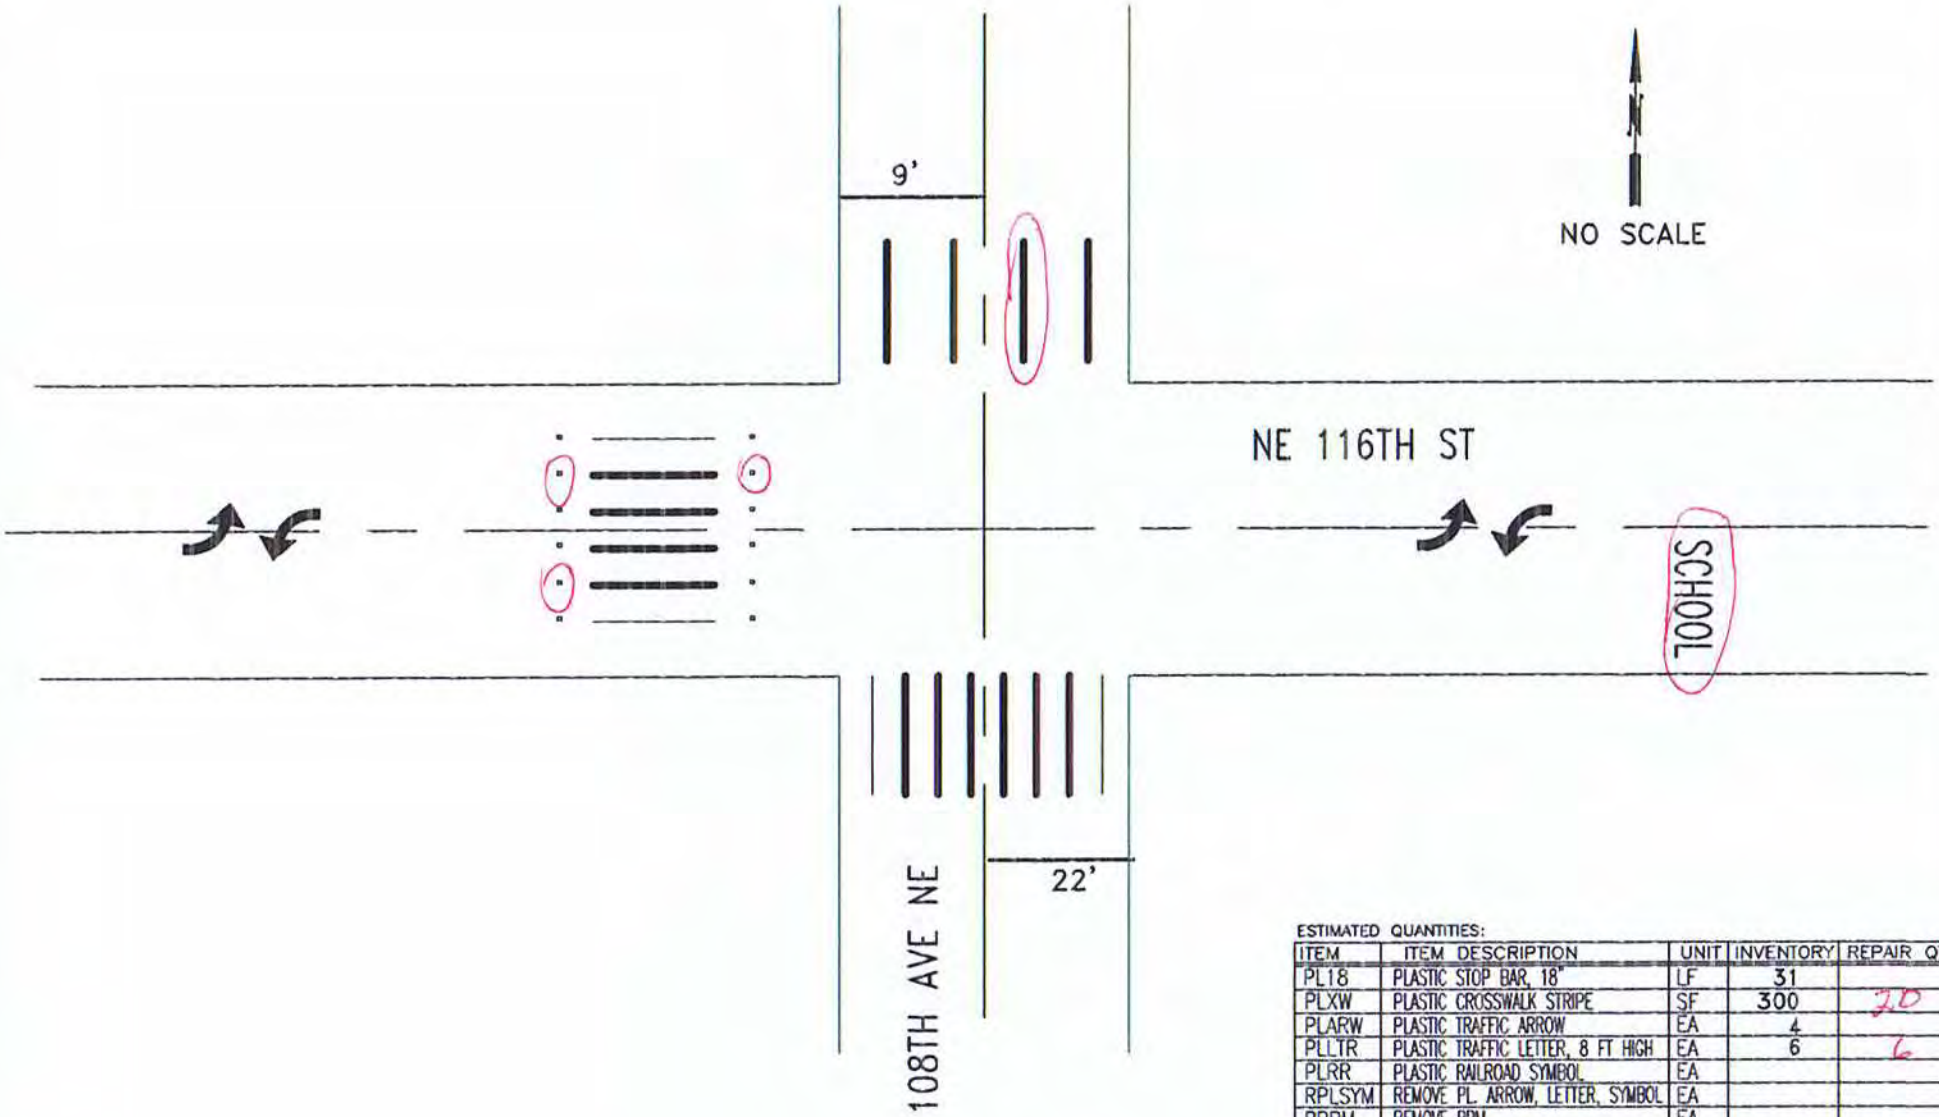

ESTIMATED QUANTITIES:

ITEM	ITEM DESCRIPTION	UNIT	INVENTORY	REPAIR QTY
PL18	PLASTIC STOP BAR, 18"	LF	31	
PLXW	PLASTIC CROSSWALK STRIPE	SF	300	20
PLARW	PLASTIC TRAFFIC ARROW	EA	4	
PLLTR	PLASTIC TRAFFIC LETTER, 8 FT HIGH	EA	6	6
PLRR	PLASTIC RAILROAD SYMBOL	EA		
RPLSYM	REMOVE PL. ARROW, LETTER, SYMBOL	EA		
RRPM	REMOVE RPM	EA		
RPLXW	REMOVE PLASTIC STRIPE	SF		
	REMOVE RPM	EA		
	RAISED PAVEMENT MARKER TYPE 2	EA	12	3

CITY OF KIRKLAND
DEPARTMENT OF PUBLIC WORKS
123 FIFTH AVENUE KIRKLAND, WA 98033
(425) 587-3800 www.kirklandwa.gov

G. HORTILLOSA 10/2012
DESIGNED BY: DATE

J.JENNINGS 10/2012
DRAWN BY: DATE

CHECKED BY: DATE

2020 PAVEMENT MARKING PROGRAM

STREET: NE 116TH ST

CROSS STREET: 108TH AVE NE

SEGMENT:

SCALE: N.T.S.

FILENAME:

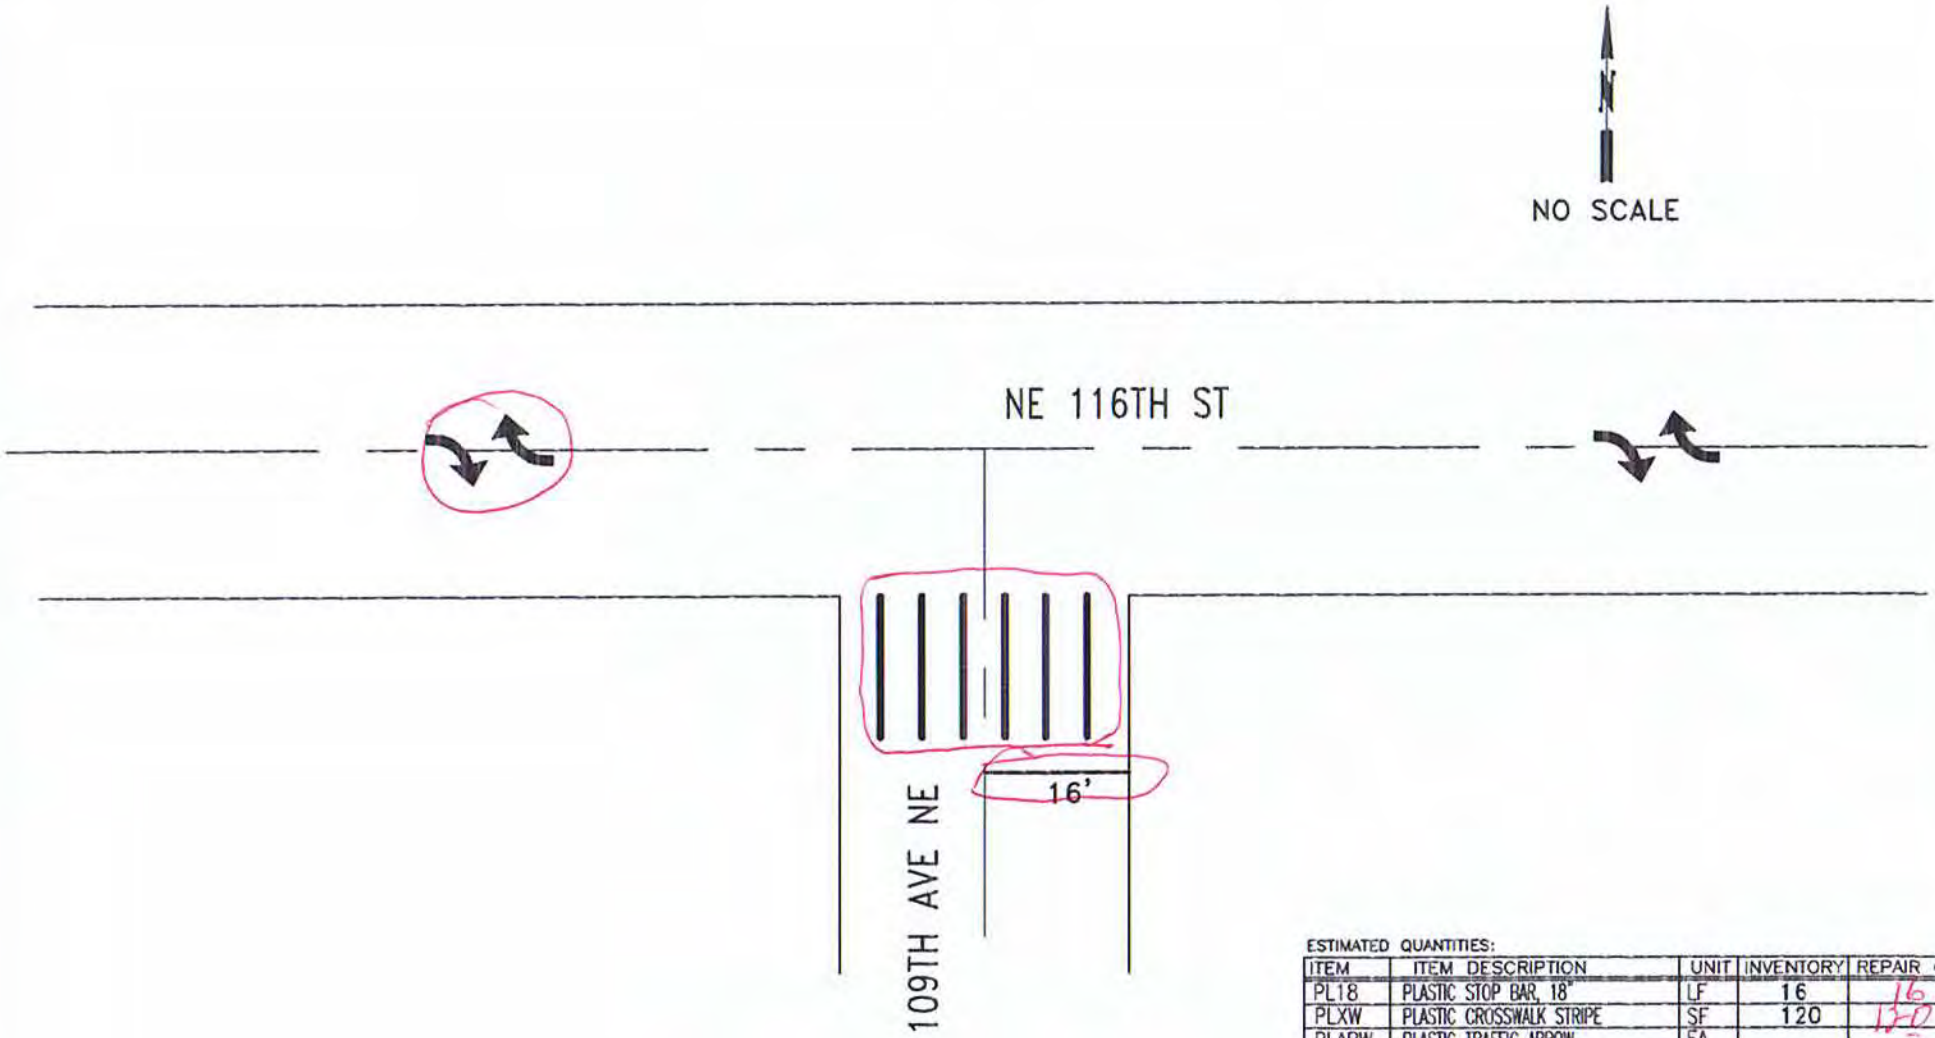

ESTIMATED QUANTITIES:

ITEM	ITEM DESCRIPTION	UNIT	INVENTORY	REPAIR QTY
PL18	PLASTIC STOP BAR, 18"	LF	16	16
PLXW	PLASTIC CROSSWALK STRIPE	SF	120	120
PLARW	PLASTIC TRAFFIC ARROW	EA		2
PLLTR	PLASTIC TRAFFIC LETTER, 8 FT HIGH	EA		
PLRR	PLASTIC RAILROAD SYMBOL	EA		
RPLSYM	REMOVE PL ARROW, LETTER, SYMBOL	EA		
RRPM	REMOVE RPM	EA		
RPLXW	REMOVE PLASTIC STRIPE	SF		

CITY OF KIRKLAND
DEPARTMENT OF PUBLIC WORKS
123 FIFTH AVENUE KIRKLAND, WA 98033
(425) 587-3800 www.kirklandwa.gov

G. HORTILLOSA 2/2011
DESIGNED BY: DATE

J.JENNINGS 10/2011
DRAWN BY: DATE

CHECKED BY: DATE

2020 PAVEMENT MARKING PROGRAM

STREET: NE 116TH ST

CROSS STREET: 109TH AVE NE

SEGMENT:

SCALE: N.T.S.

FILENAME:

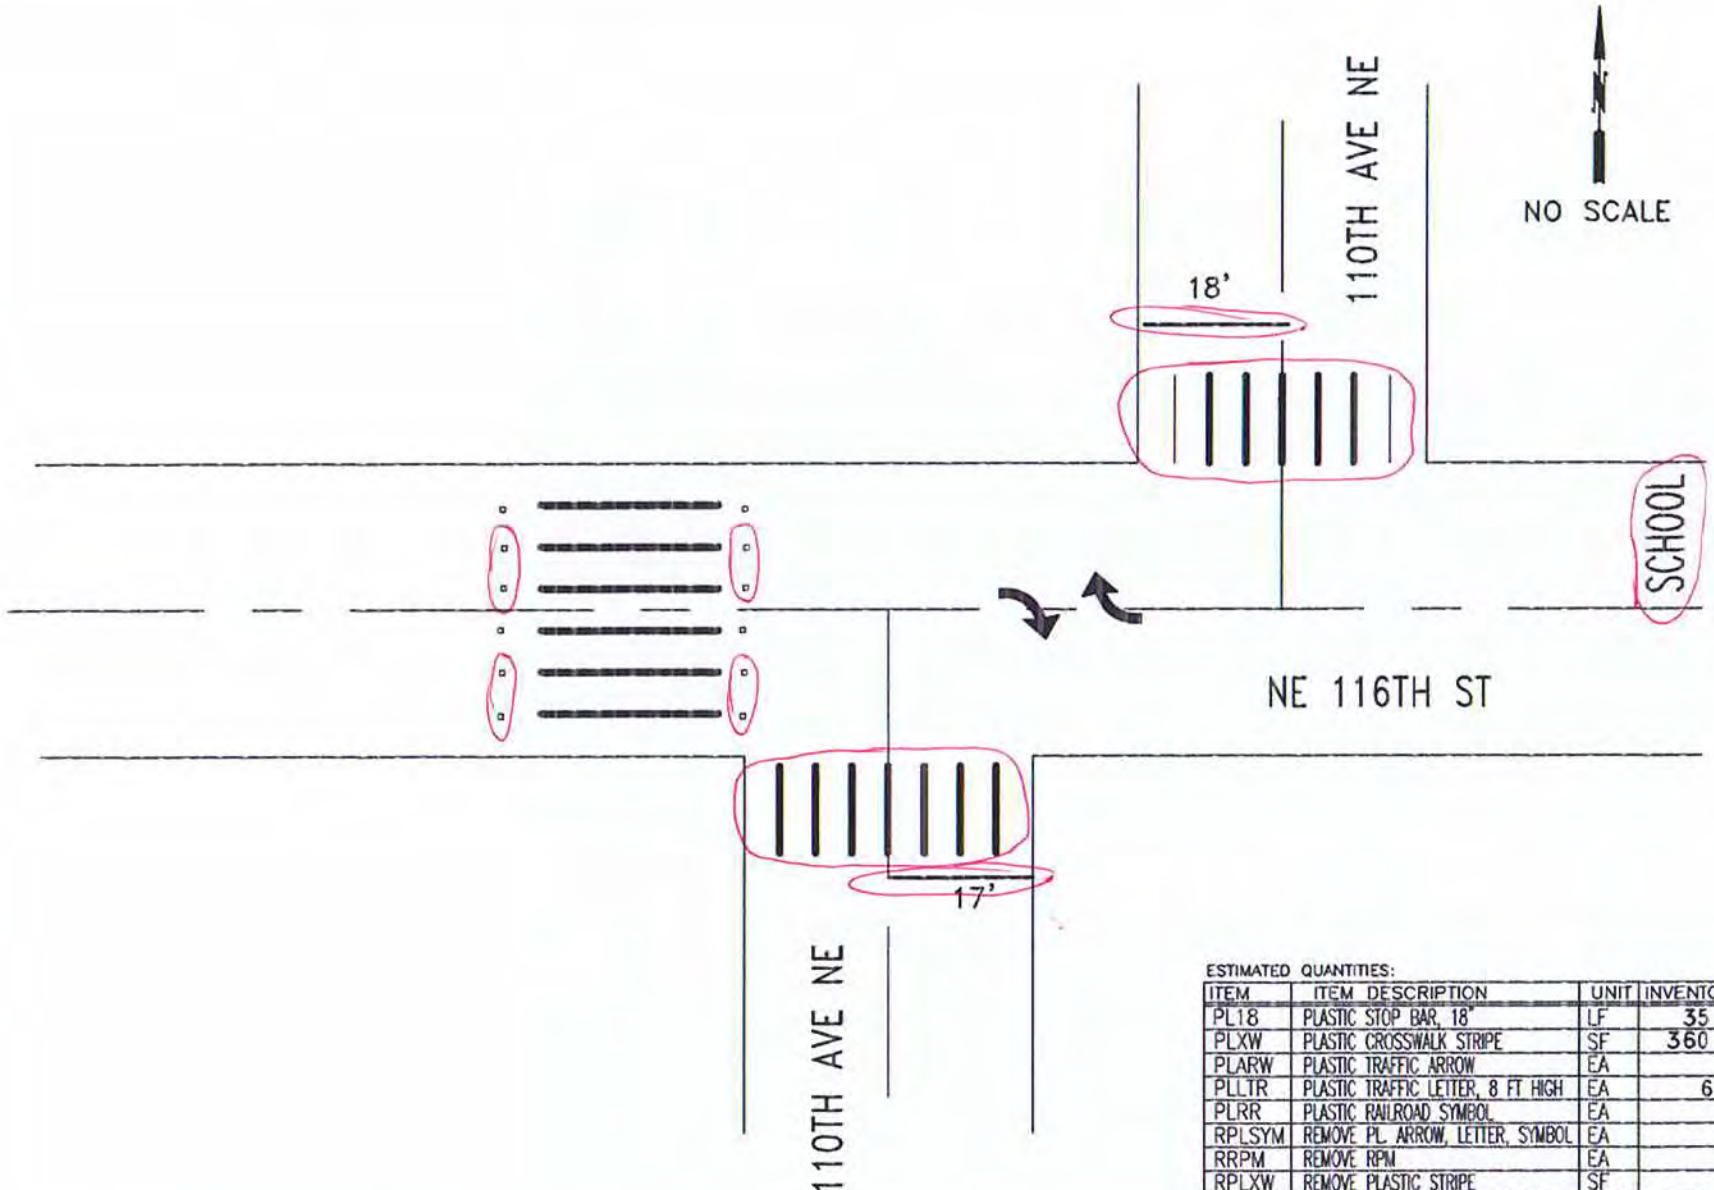

ESTIMATED QUANTITIES:

ITEM	ITEM DESCRIPTION	UNIT	INVENTORY	REPAIR QTY
PL18	PLASTIC STOP BAR, 18"	LF	35	33
PLXW	PLASTIC CROSSWALK STRIPE	SF	360	360
PLARW	PLASTIC TRAFFIC ARROW	EA		
PLLTR	PLASTIC TRAFFIC LETTER, 8 FT HIGH	EA	6	6
PLRR	PLASTIC RAILROAD SYMBOL	EA		
RPLSYM	REMOVE PL ARROW, LETTER, SYMBOL	EA		
RRPM	REMOVE RPM	EA		
RPLXW	REMOVE PLASTIC STRIPE	SF		
	RAISED PAVEMENT MARKER TYPE 2	EA	12	8

CITY OF KIRKLAND
DEPARTMENT OF PUBLIC WORKS
123 FIFTH AVENUE KIRKLAND, WA 98033
(425) 587-3800 www.kirklandwa.gov

G. HORTILLOSA 10/2012
DESIGNED BY: DATE

J.JENNINGS 10/2012
DRAWN BY: DATE

CHECKED BY: DATE

2020 PAVEMENT MARKING PROGRAM

STREET: NE 116TH ST

CROSS STREET: 110TH AVE NE

SEGMENT:

SCALE: N.T.S.

FILENAME:

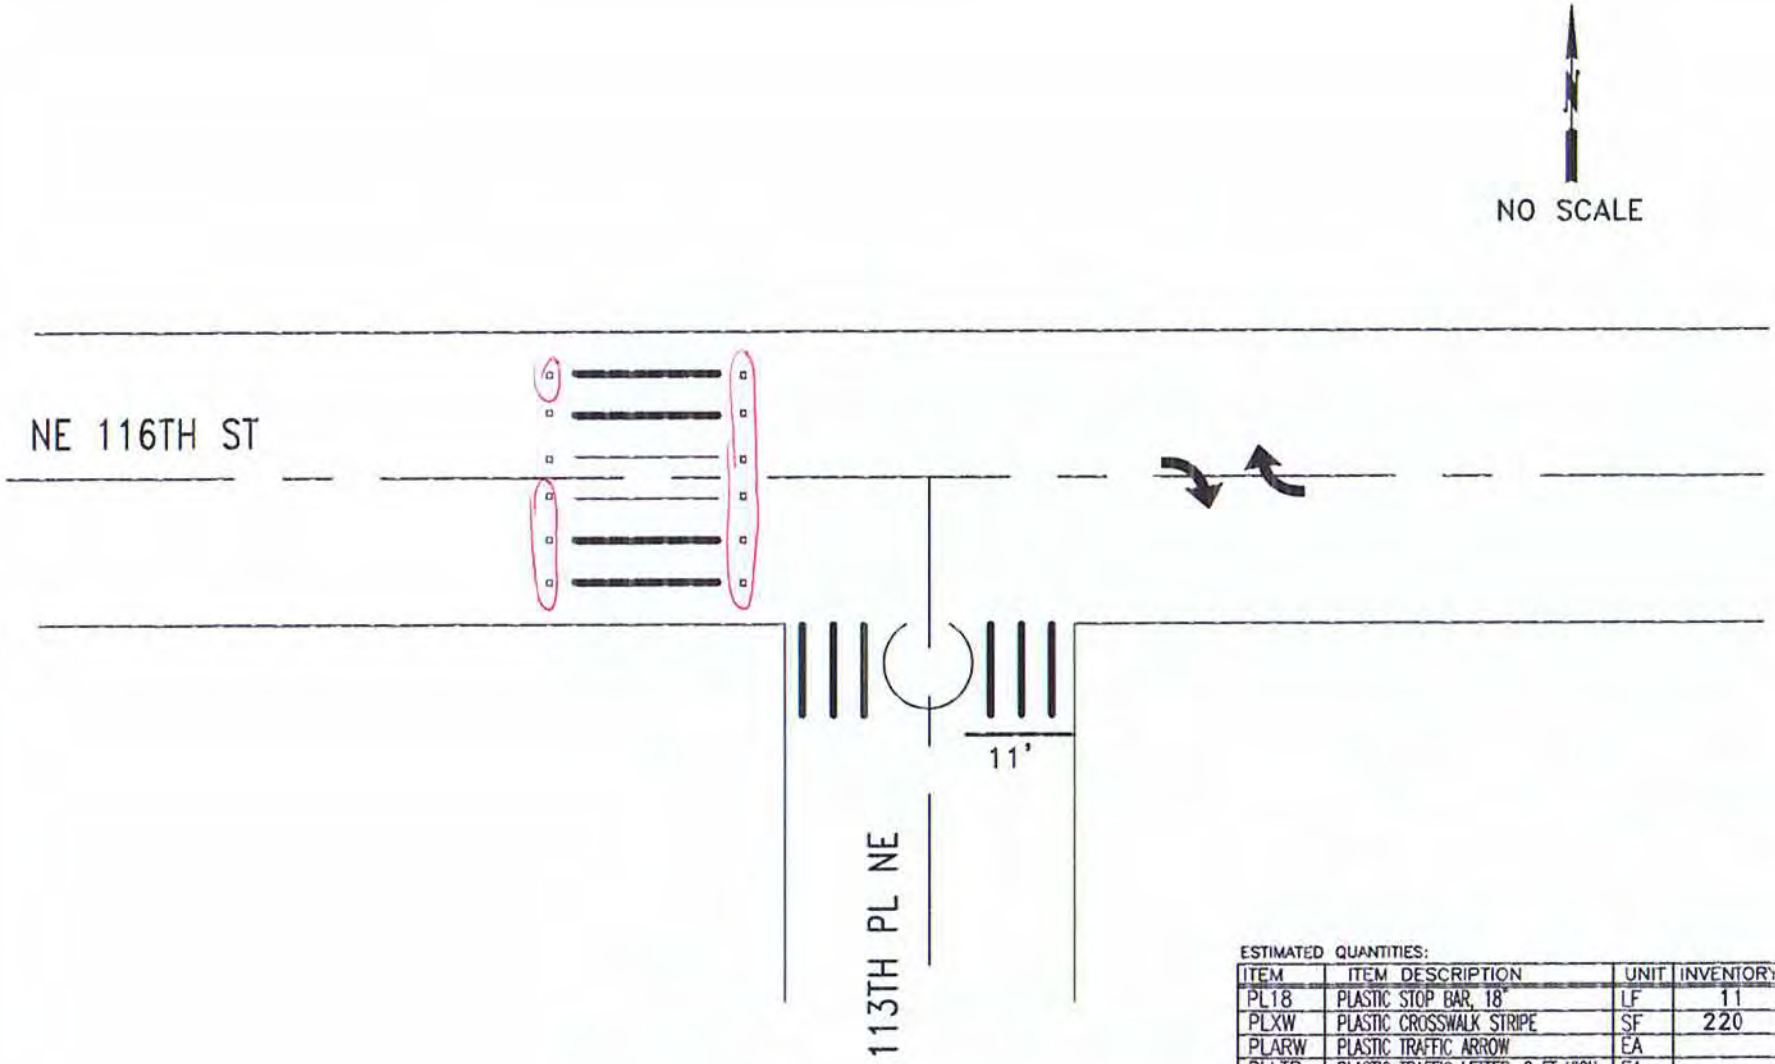

ESTIMATED QUANTITIES:

ITEM	ITEM DESCRIPTION	UNIT	INVENTORY	REPAIR QTY
PL18	PLASTIC STOP BAR, 18"	LF	11	
PLXW	PLASTIC CROSSWALK STRIPE	SF	220	
PLARW	PLASTIC TRAFFIC ARROW	EA		
PLLTR	PLASTIC TRAFFIC LETTER, 8 FT HIGH	EA		
PLRR	PLASTIC RAILROAD SYMBOL	EA		
RPLSYM	REMOVE PL. ARROW, LETTER, SYMBOL	EA		
RRPM	REMOVE RPM	EA		
RPLXW	REMOVE PLASTIC STRIPE	SF		
	RAISED PAVEMENT MARKER TYPE 2	EA	12	10

CITY OF KIRKLAND WASHINGTON

CITY OF KIRKLAND
DEPARTMENT OF PUBLIC WORKS
123 FIFTH AVENUE KIRKLAND, WA 98033
(425) 587-3800 www.kirklandwa.gov

G. HORTILLOSA 2/2011
DESIGNED BY: DATE

J.JENNINGS 1/2000
DRAWN BY: DATE

CHECKED BY: DATE

2020 PAVEMENT MARKING PROGRAM

STREET: NE 116TH ST

CROSS STREET: 113TH PL NE

SEGMENT:

SCALE: N.T.S.

FILENAME:

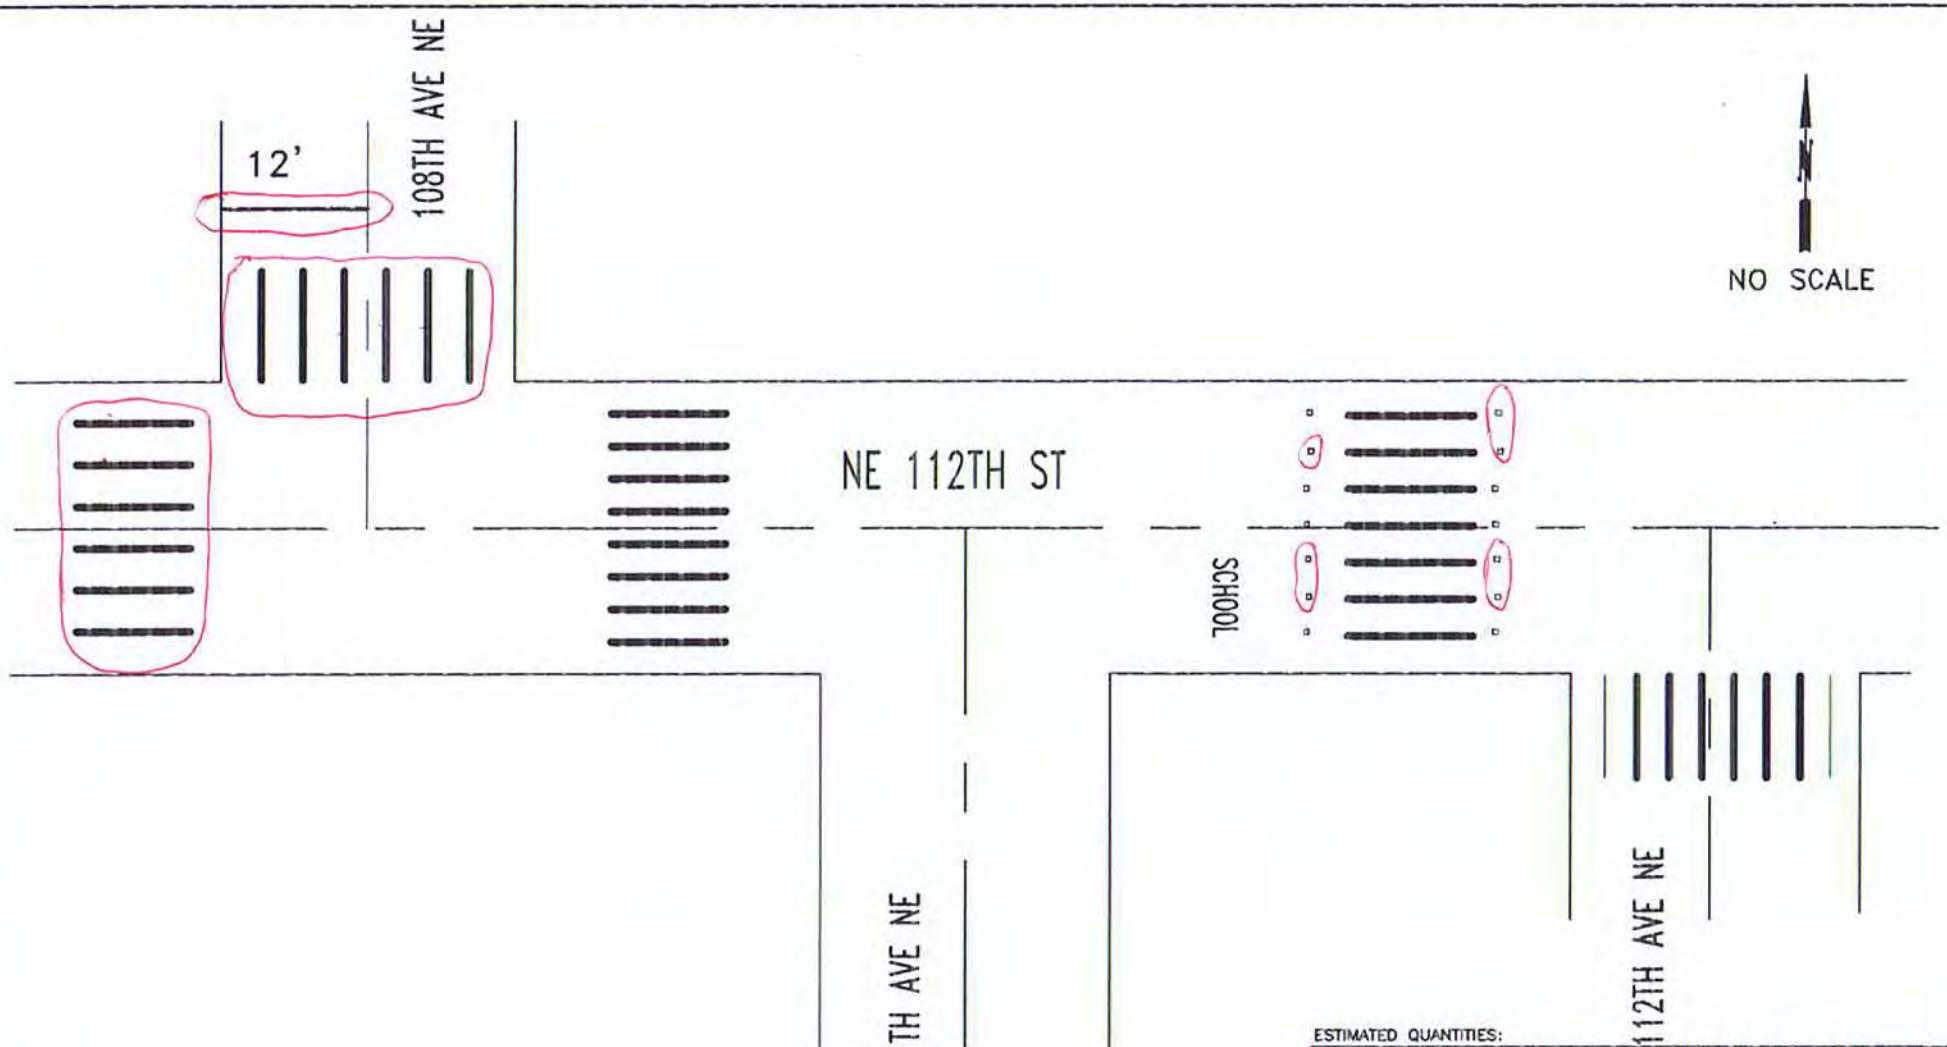

ESTIMATED QUANTITIES:

ITEM	ITEM DESCRIPTION	UNIT	INVENTORY	REPAIR QTY
PL18	PLASTIC STOP BAR, 18"	LF	12	
PLXW	PLASTIC CROSSWALK STRIPE	SF	720	215
PLARW	PLASTIC TRAFFIC ARROW	EA		
PLLTR	PLASTIC TRAFFIC LETTER, 8 FT HIGH	EA	6	
PLRR	PLASTIC RAILROAD SYMBOL	EA		
RPLSYM	REMOVE PL. ARROW, LETTER, SYMBOL	EA		
RRPM	REMOVE RPM	EA		
RPLXW	REMOVE PLASTIC STRIPE	SF		
	RAISED PAVEMENT MARKER TYPE 2	EA	16	7

CITY OF KIRKLAND
DEPARTMENT OF PUBLIC WORKS
123 FIFTH AVENUE KIRKLAND, WA 98033
(425) 587-3800 www.kirklandwa.gov

G.. HORTILLOSA 4/2009
DESIGNED BY: DATE

J.JENNINGS 4/2009
DRAWN BY: DATE

CHECKED BY: DATE

2022 PAVEMENT MARKING PROGRAM

STREET: NE 112TH ST

CROSS STREET: 108TH 111TH & 112TH AVES NE

SEGMENT:

SCALE: N.T.S.

FILENAME: Page 4-25

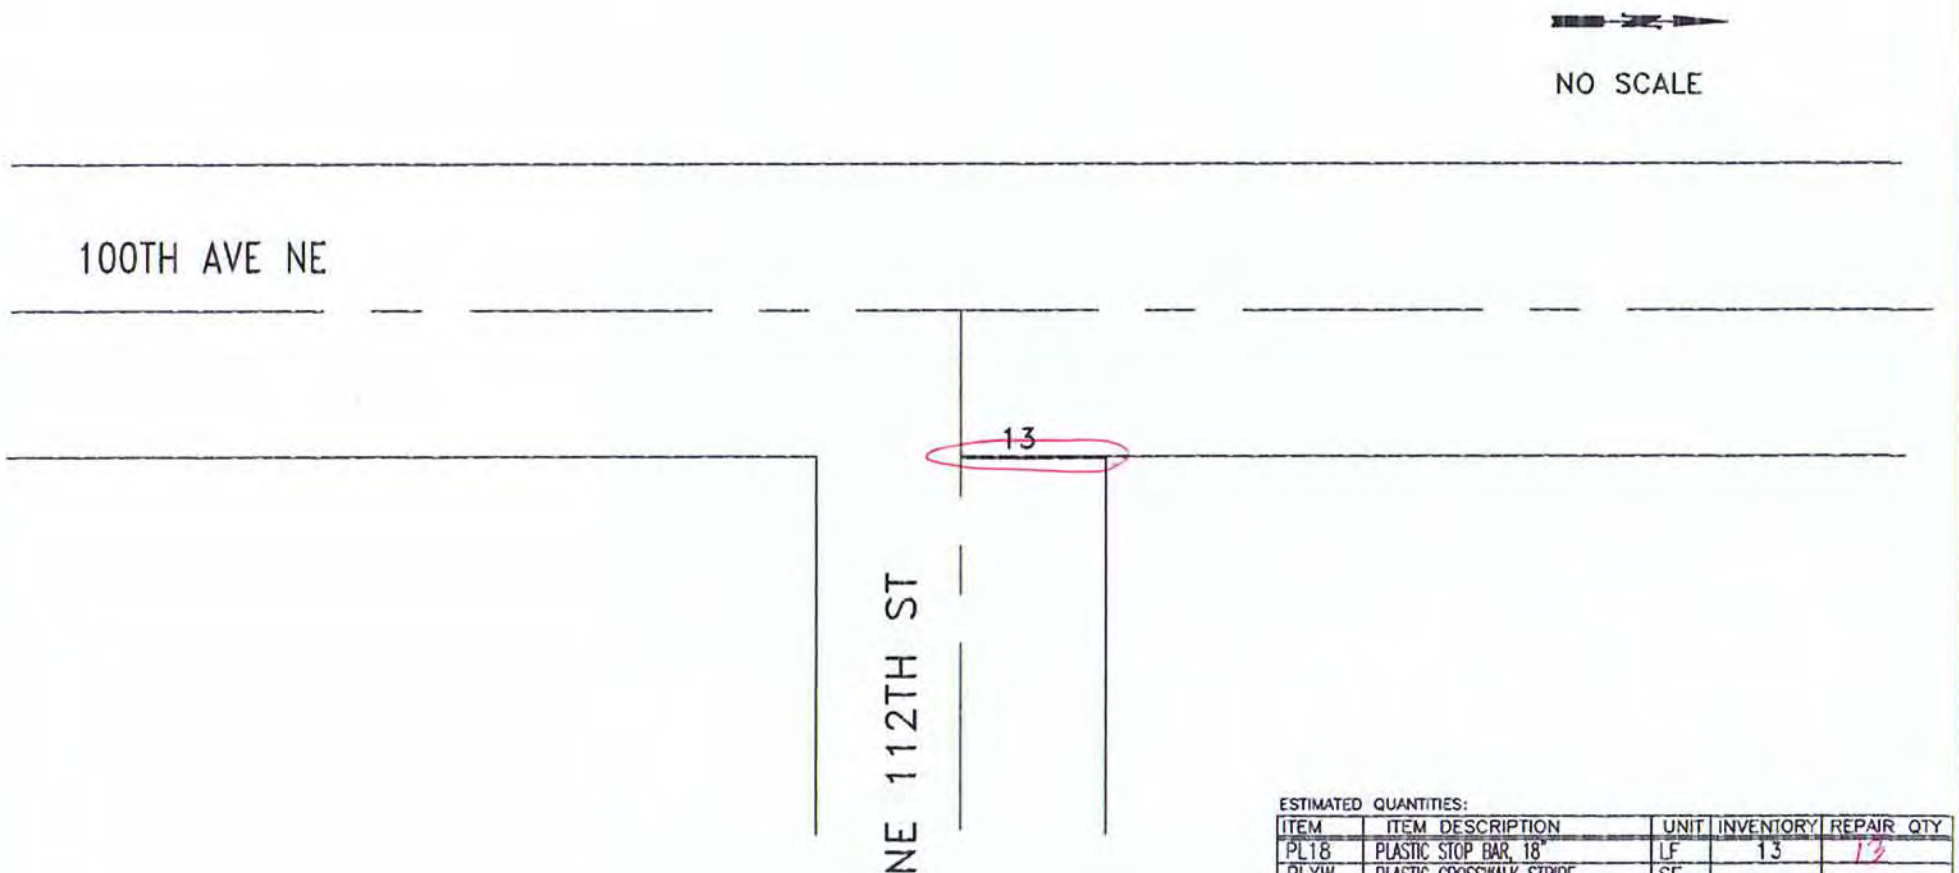

ESTIMATED QUANTITIES:

ITEM	ITEM DESCRIPTION	UNIT	INVENTORY	REPAIR QTY
PL18	PLASTIC STOP BAR, 18"	LF	13	13
PLXW	PLASTIC CROSSWALK STRIPE	SF		
PLARW	PLASTIC TRAFFIC ARROW	EA		
PLLTR	PLASTIC TRAFFIC LETTER, 8 FT HIGH	EA		
PLRR	PLASTIC RAILROAD SYMBOL	EA		
RPLSYM	REMOVE PL. ARROW, LETTER, SYMBOL	EA		
RRPM	REMOVE RPM	EA		
RPLXW	REMOVE PLASTIC STRIPE	SF		

CITY OF KIRKLAND
DEPARTMENT OF PUBLIC WORKS
123 FIFTH AVENUE KIRKLAND, WA 98033
(425) 587-3800 www.kirklandwa.gov

D.GRILLEY 2/2003
DESIGNED BY: DATE

J.JENNINGS 2/2003
DRAWN BY: DATE

CHECKED BY: DATE

2020 PAVEMENT MARKING PROGRAM

STREET: NE 112TH ST

CROSS STREET: 100TH AVE NE

SEGMENT:

SCALE: N.T.S.

FILENAME:

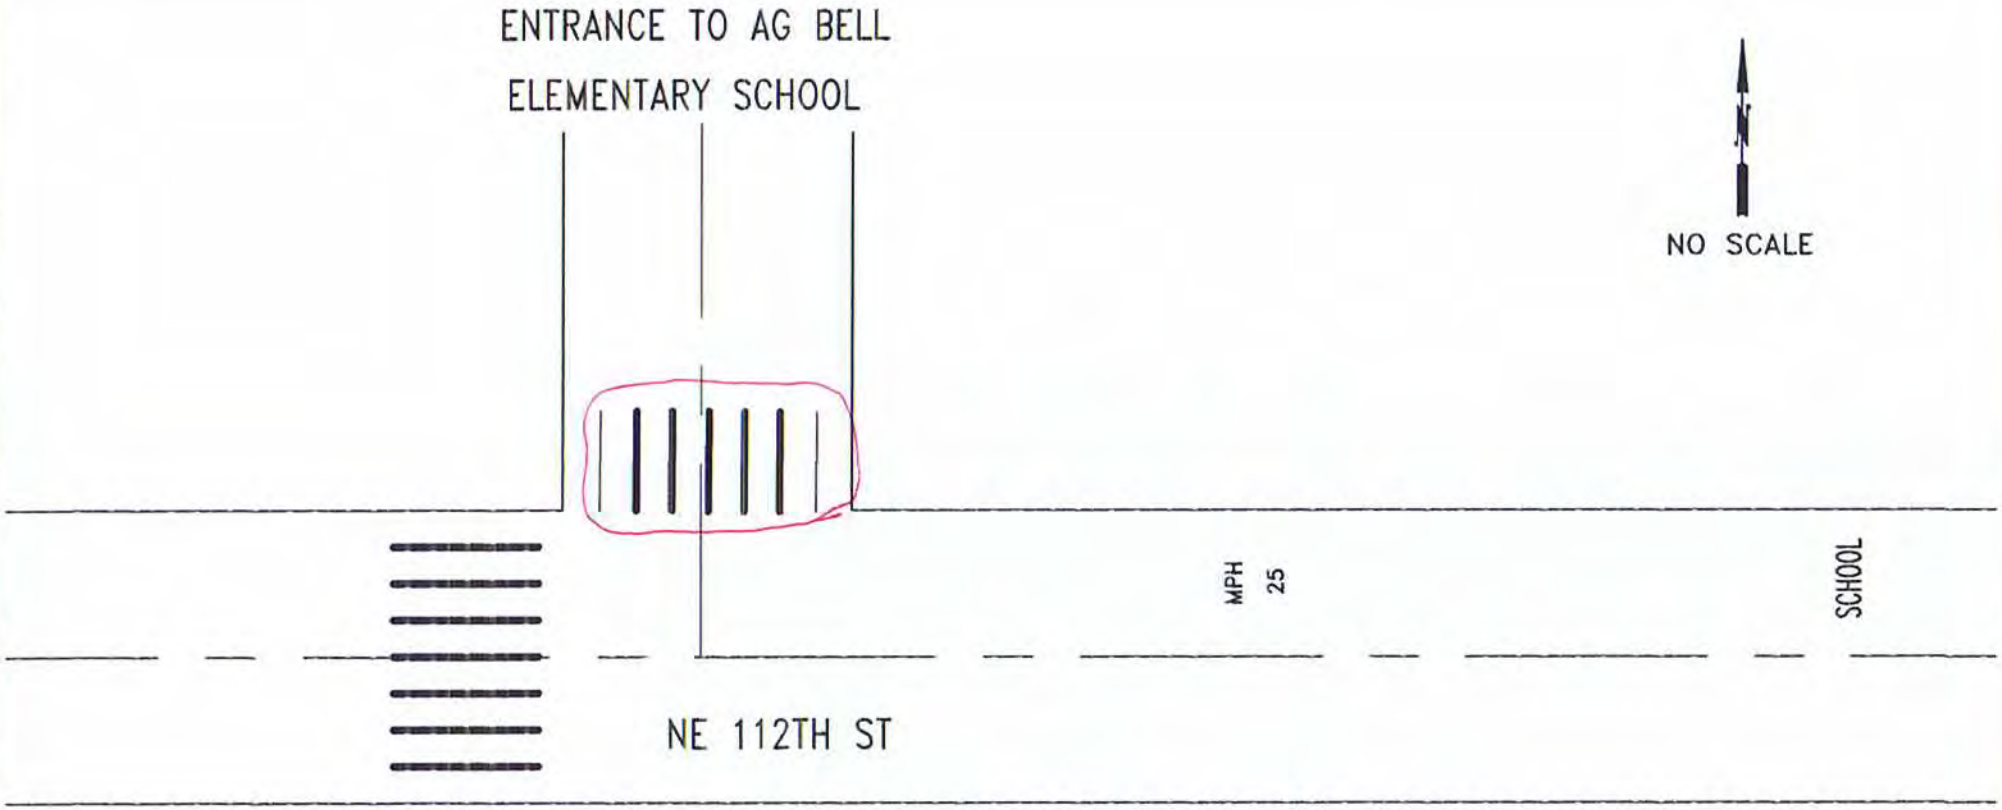

ESTIMATED QUANTITIES:

ITEM	ITEM DESCRIPTION	UNIT	INVENTORY	REPAIR QTY
PL18	PLASTIC STOP BAR, 18"	LF		
PLXW	PLASTIC CROSSWALK STRIPE	SF	260	120
PLARW	PLASTIC TRAFFIC ARROW	EA		
PLLTR	PLASTIC TRAFFIC LETTER, 8 FT HIGH	EA	11	
PLRR	PLASTIC RAILROAD SYMBOL	EA		
RPLSYM	REMOVE PL. ARROW, LETTER, SYMBOL	EA		
RRPM	REMOVE RPM	EA		
RPLXW	REMOVE PLASTIC STRIPE	SF		
PLLGD	PLASTIC SPEED LEGEND BARS	EA		

CITY OF KIRKLAND WASHINGTON

CITY OF KIRKLAND
DEPARTMENT OF PUBLIC WORKS
123 FIFTH AVENUE KIRKLAND, WA 98033
(425) 587-3800 www.kirklandwa.gov

D.GRILLEY 1/2000
DESIGNED BY: DATE

J.JENNINGS 1/2000
DRAWN BY: DATE

CHECKED BY: DATE

2020 PAVEMENT MARKING PROGRAM

STREET: NE 112TH ST

CROSS STREET: ENTRANCE TO AG BELL SCHOOL

SEGMENT:

SCALE: N.T.S.

FILENAME: Page 4-29

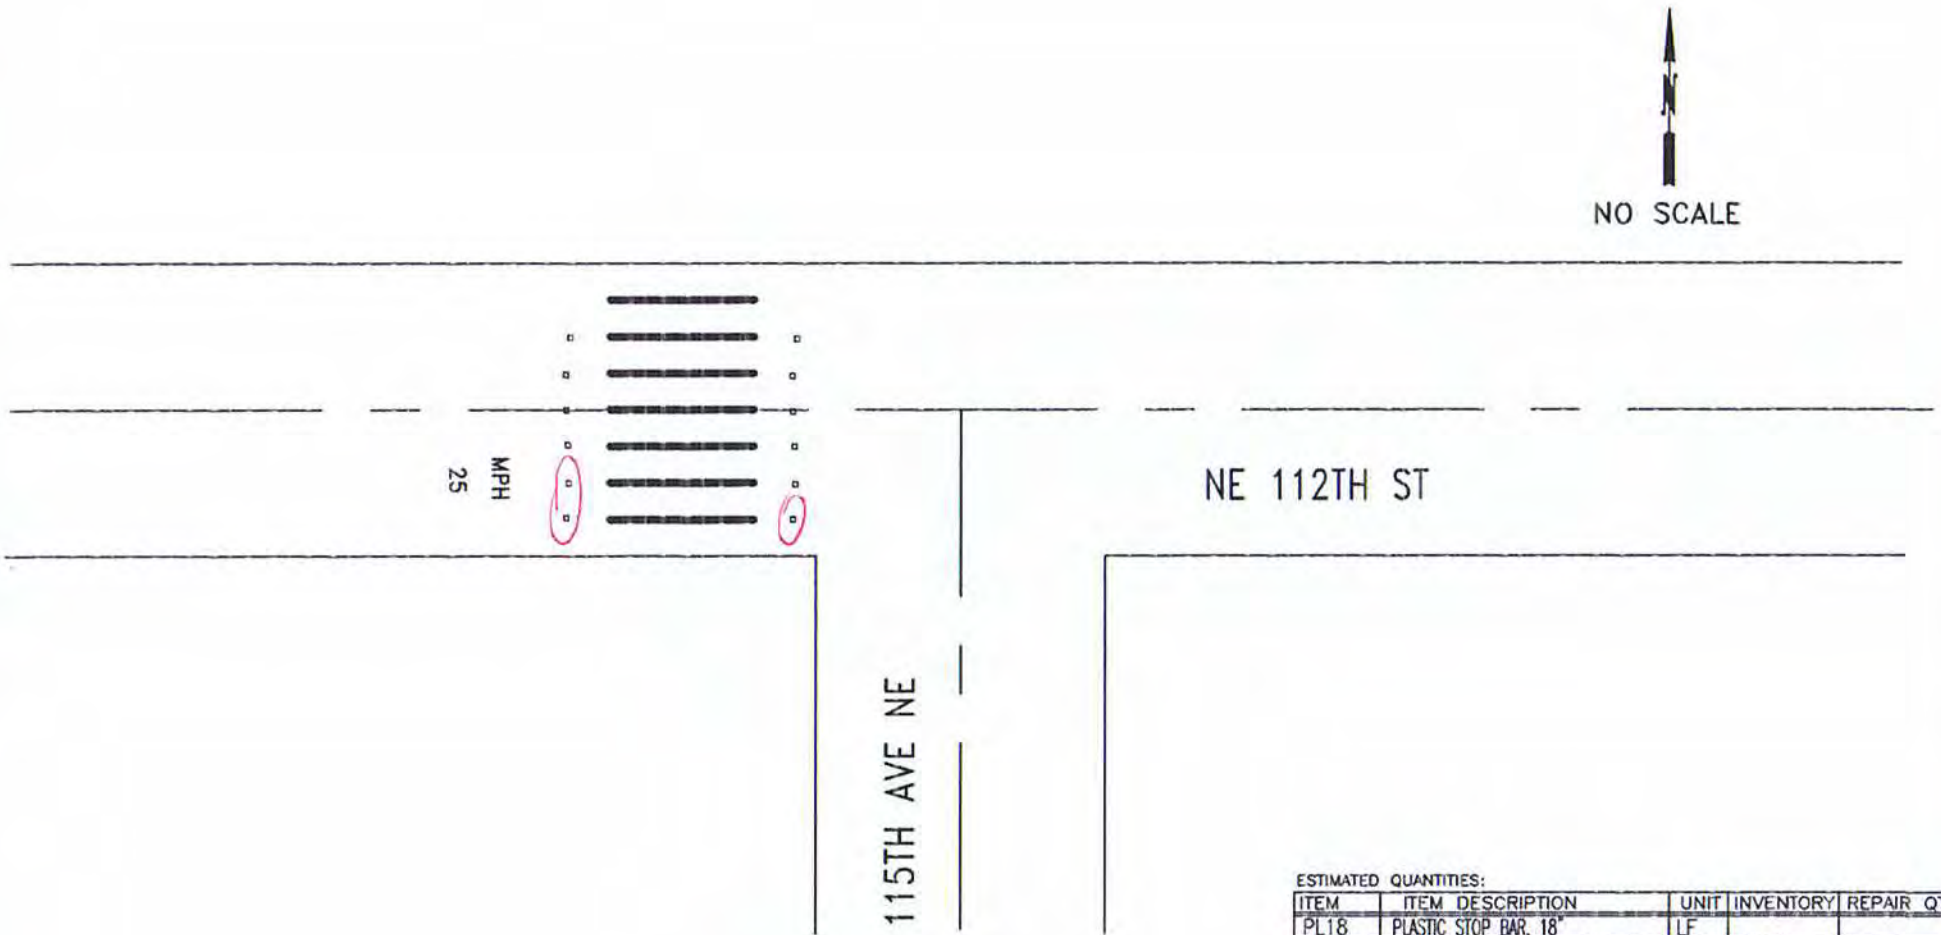

ESTIMATED QUANTITIES:

ITEM	ITEM DESCRIPTION	UNIT	INVENTORY	REPAIR QTY
PL18	PLASTIC STOP BAR, 18"	LF		
PLXW	PLASTIC CROSSWALK STRIPE	SF	140	
PLARW	PLASTIC TRAFFIC ARROW	EA		
PLLTR	PLASTIC TRAFFIC LETTER, 8 FT HIGH	EA	8	
PLRR	PLASTIC RAILROAD SYMBOL	EA		
RPLSYM	REMOVE PL. ARROW, LETTER, SYMBOL	EA		
RRPM	REMOVE RPM	EA		
RPLXW	REMOVE PLASTIC STRIPE	SF		
	RAISED PAVEMENT MARKER TYPE 2	EA	12	3

CITY OF KIRKLAND WASHINGTON

CITY OF KIRKLAND
DEPARTMENT OF PUBLIC WORKS
123 FIFTH AVENUE KIRKLAND, WA 98033
(425) 587-3800 www.kirklandwa.gov

L. KAWAOKA 1/2000
DESIGNED BY: DATE

J.JENNINGS 1/2000
DRAWN BY: DATE

CHECKED BY: DATE

2022 PAVEMENT MARKING PROGRAM

STREET: NE 112TH ST

CROSS STREET: 115TH AVE NE

SEGMENT:

SCALE: N.T.S.

FILENAME: Page 4-30

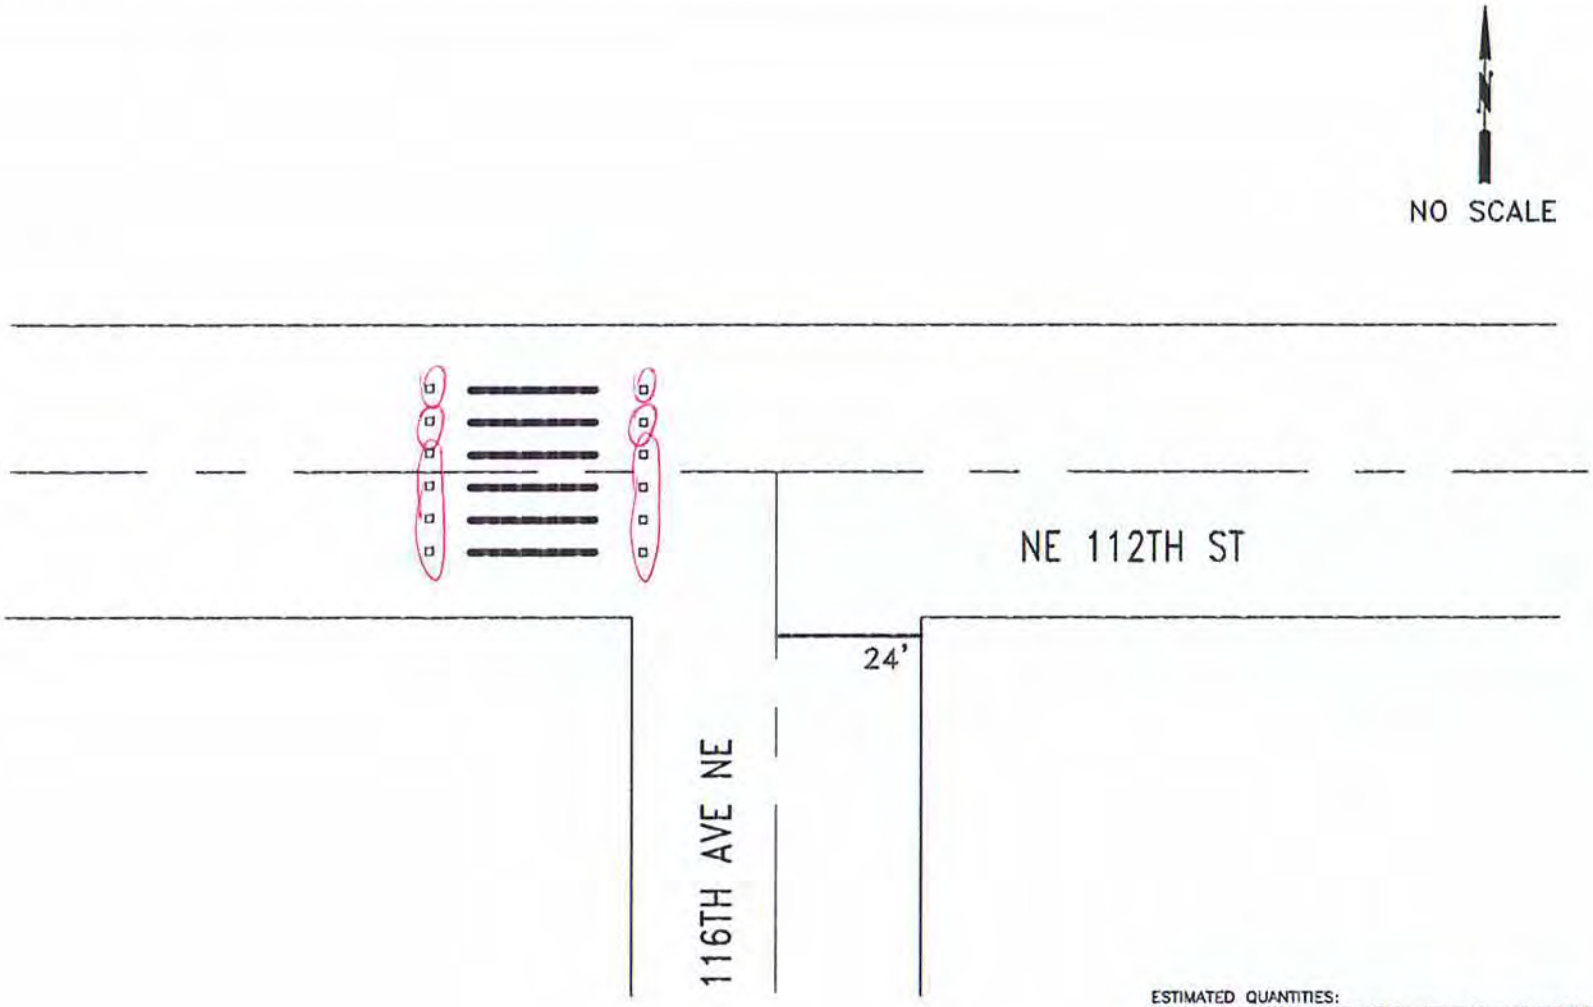

ESTIMATED QUANTITIES:

ITEM	ITEM DESCRIPTION	UNIT	INVENTORY	REPAIR QTY
PL18	PLASTIC STOP BAR, 18"	LF	24	
PLXW	PLASTIC CROSSWALK STRIPE	SF	120	
PLARW	PLASTIC TRAFFIC ARROW	EA		
PLLTR	PLASTIC TRAFFIC LETTER, 8 FT HIGH	EA		
PLRR	PLASTIC RAILROAD SYMBOL	EA		
RPLSYM	REMOVE PL. ARROW, LETTER, SYMBOL	EA		
RRPM	REMOVE RPM	EA		2
RPLXW	REMOVE PLASTIC STRIPE	SF		
	RAISED PAVEMENT MARKER TYPE 2	EA	12	12

CITY OF KIRKLAND
DEPARTMENT OF PUBLIC WORKS
123 FIFTH AVENUE KIRKLAND, WA 98033
(425) 587-3800 www.kirklandwa.gov

S. GONSAR 2/2018
DESIGNED BY: DATE

J.JENNINGS 2/2018
DRAWN BY: DATE

CHECKED BY: DATE

2022 PAVEMENT MARKING PROGRAM

STREET: NE 112TH ST

CROSS STREET: 116TH AVE NE

SEGMENT:

SCALE: N.T.S.

FILENAME:

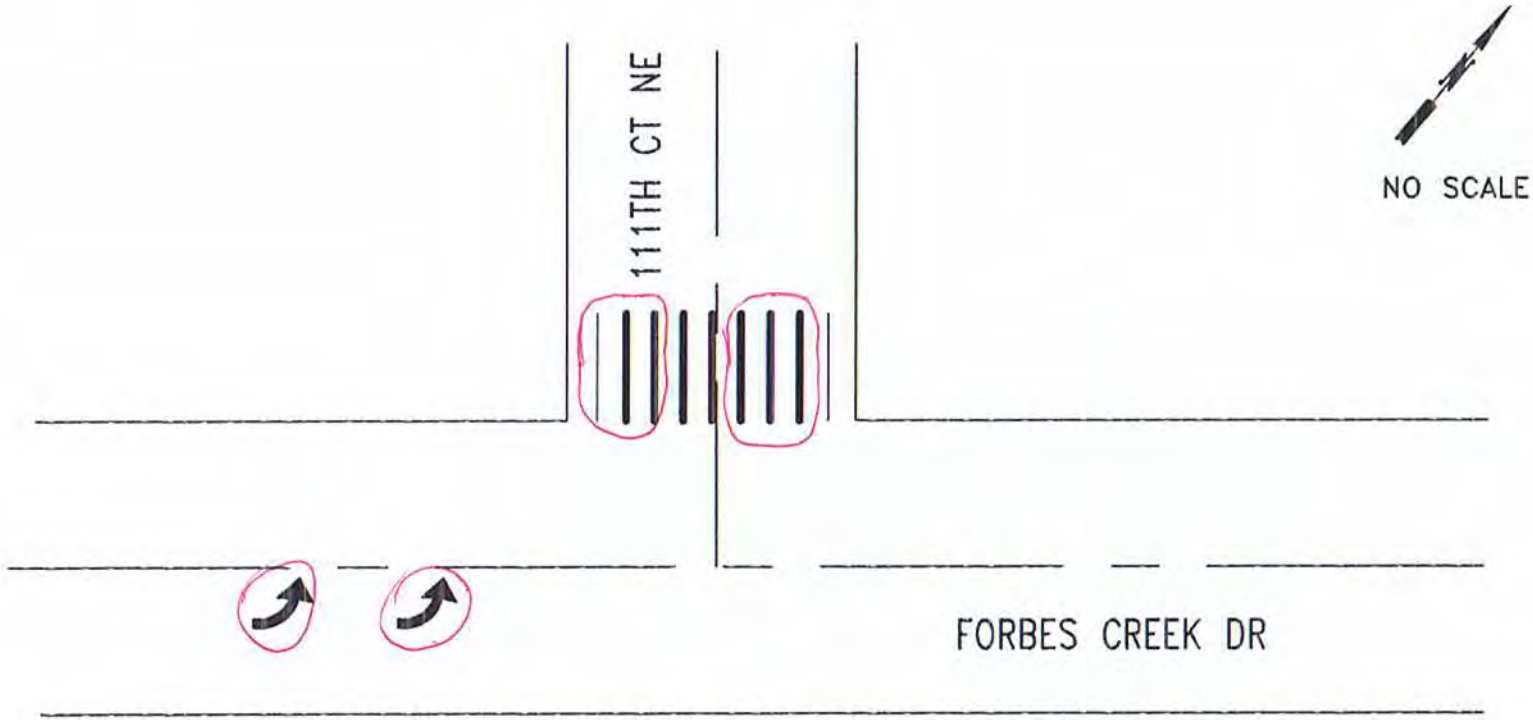

ESTIMATED QUANTITIES:

ITEM	ITEM DESCRIPTION	UNIT	INVENTORY	REPAIR QTY
PL18	PLASTIC STOP BAR, 18"	LF		
PLXW	PLASTIC CROSSWALK STRIPE	SF	160	110
PLARW	PLASTIC TRAFFIC ARROW	EA	2	
PLLTR	PLASTIC TRAFFIC LETTER, 8 FT HIGH	EA		
PLRR	PLASTIC RAILROAD SYMBOL	EA		
RPLSYM	REMOVE PL. ARROW, LETTER, SYMBOL	EA		
RRPM	REMOVE RPM	EA		
RPLXW	REMOVE PLASTIC STRIPE	SF		110

CITY OF KIRKLAND
DEPARTMENT OF PUBLIC WORKS
123 FIFTH AVENUE KIRKLAND, WA 98033
(425) 587-3800 www.kirklandwa.gov

D.GRILLEY 1/2000
DESIGNED BY: DATE

J.JENNINGS 1/2000
DRAWN BY: DATE

CHECKED BY: DATE

2020 PAVEMENT MARKING PROGRAM

STREET: FORBES CREEK DR

CROSS STREET: 111TH CT NE

SEGMENT:

SCALE: N.T.S.

FILENAME:

FINN HILL
INTERSECTION PLANS

CITY OF KIRKLAND
DEPARTMENT OF PUBLIC WORKS
123 FIFTH AVENUE KIRKLAND, WA 98033
(425) 587-3800 www.kirklandwa.gov

S GONSAR	1/2019	DESIGNED BY: DATE
J.JENNINGS	1/2019	DRAWN BY: DATE
		CHECKED BY: DATE

2020 PAVEMENT MARKING PROGRAM

STREET:

CROSS STREET:

SEGMENT:

SCALE: N.T.S.

FILENAME: 1-0

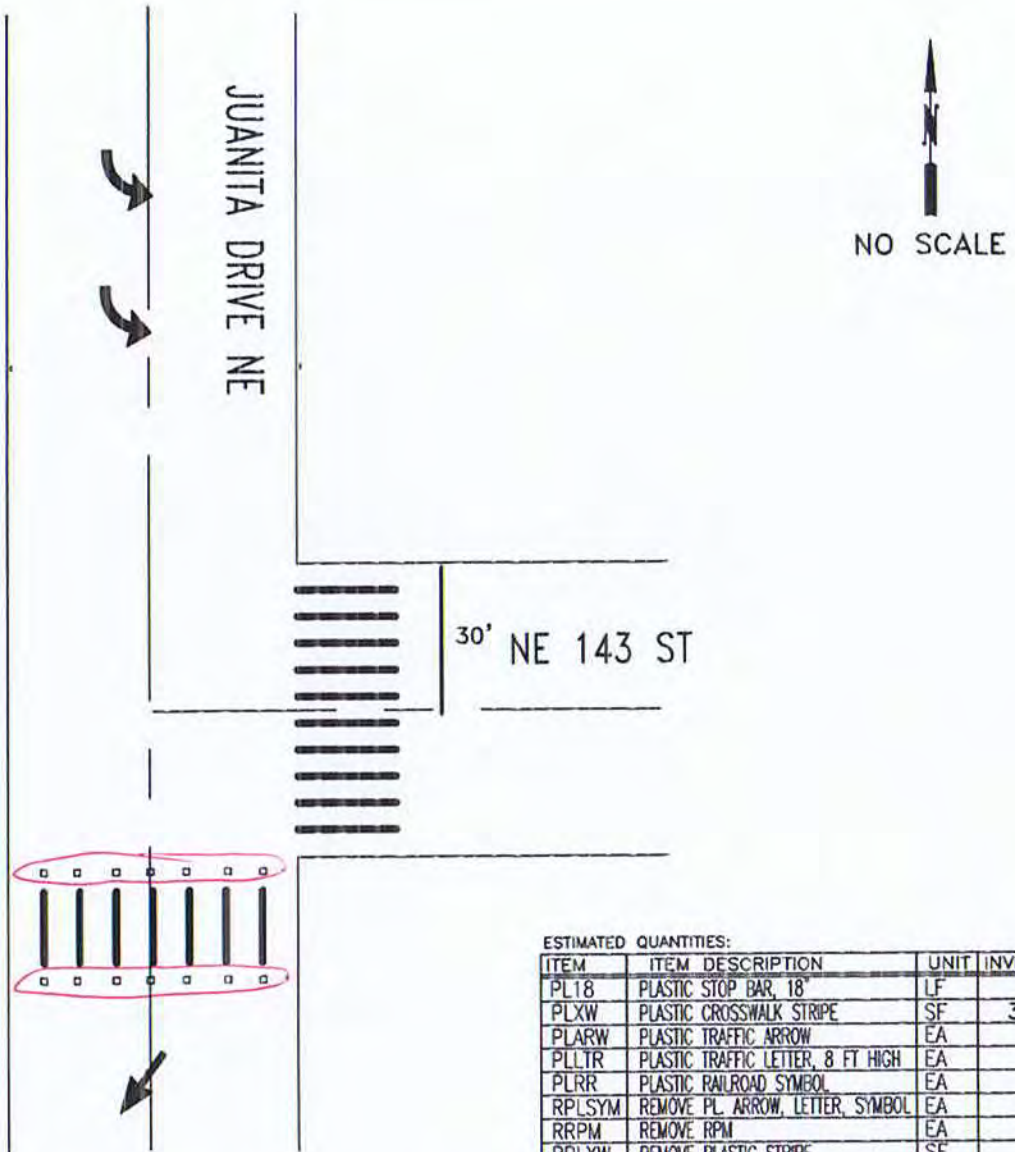

ESTIMATED QUANTITIES:

ITEM	ITEM DESCRIPTION	UNIT	INVENTORY	REPAIR QTY
PL18	PLASTIC STOP BAR, 18"	LF	30	
PLXW	PLASTIC CROSSWALK STRIPE	SF	340	
PLARW	PLASTIC TRAFFIC ARROW	EA	3	
PLLTR	PLASTIC TRAFFIC LETTER, 8 FT HIGH	EA		
PLRR	PLASTIC RAILROAD SYMBOL	EA		
RPLSYM	REMOVE PL. ARROW, LETTER, SYMBOL	EA		
RRPM	REMOVE RPM	EA		1
RPLXW	REMOVE PLASTIC STRIPE	SF		
	RAISED PAVEMENT MARKER TYPE 2	EA	14	14

CITY OF KIRKLAND
DEPARTMENT OF PUBLIC WORKS
123 FIFTH AVENUE KIRKLAND, WA 98033
(425) 587-3800 www.kirklandwa.gov

S. GONSAR 4/2019
DESIGNED BY: DATE

J.JENNINGS 4/2019
DRAWN BY: DATE

CHECKED BY: DATE

2022 PAVEMENT MARKING PROGRAM

STREET: JUANITA DRIVE NE

CROSS STREET: NE 143 STREET

SEGMENT:

SCALE: N.T.S.

SHEET: PAGE 1-1

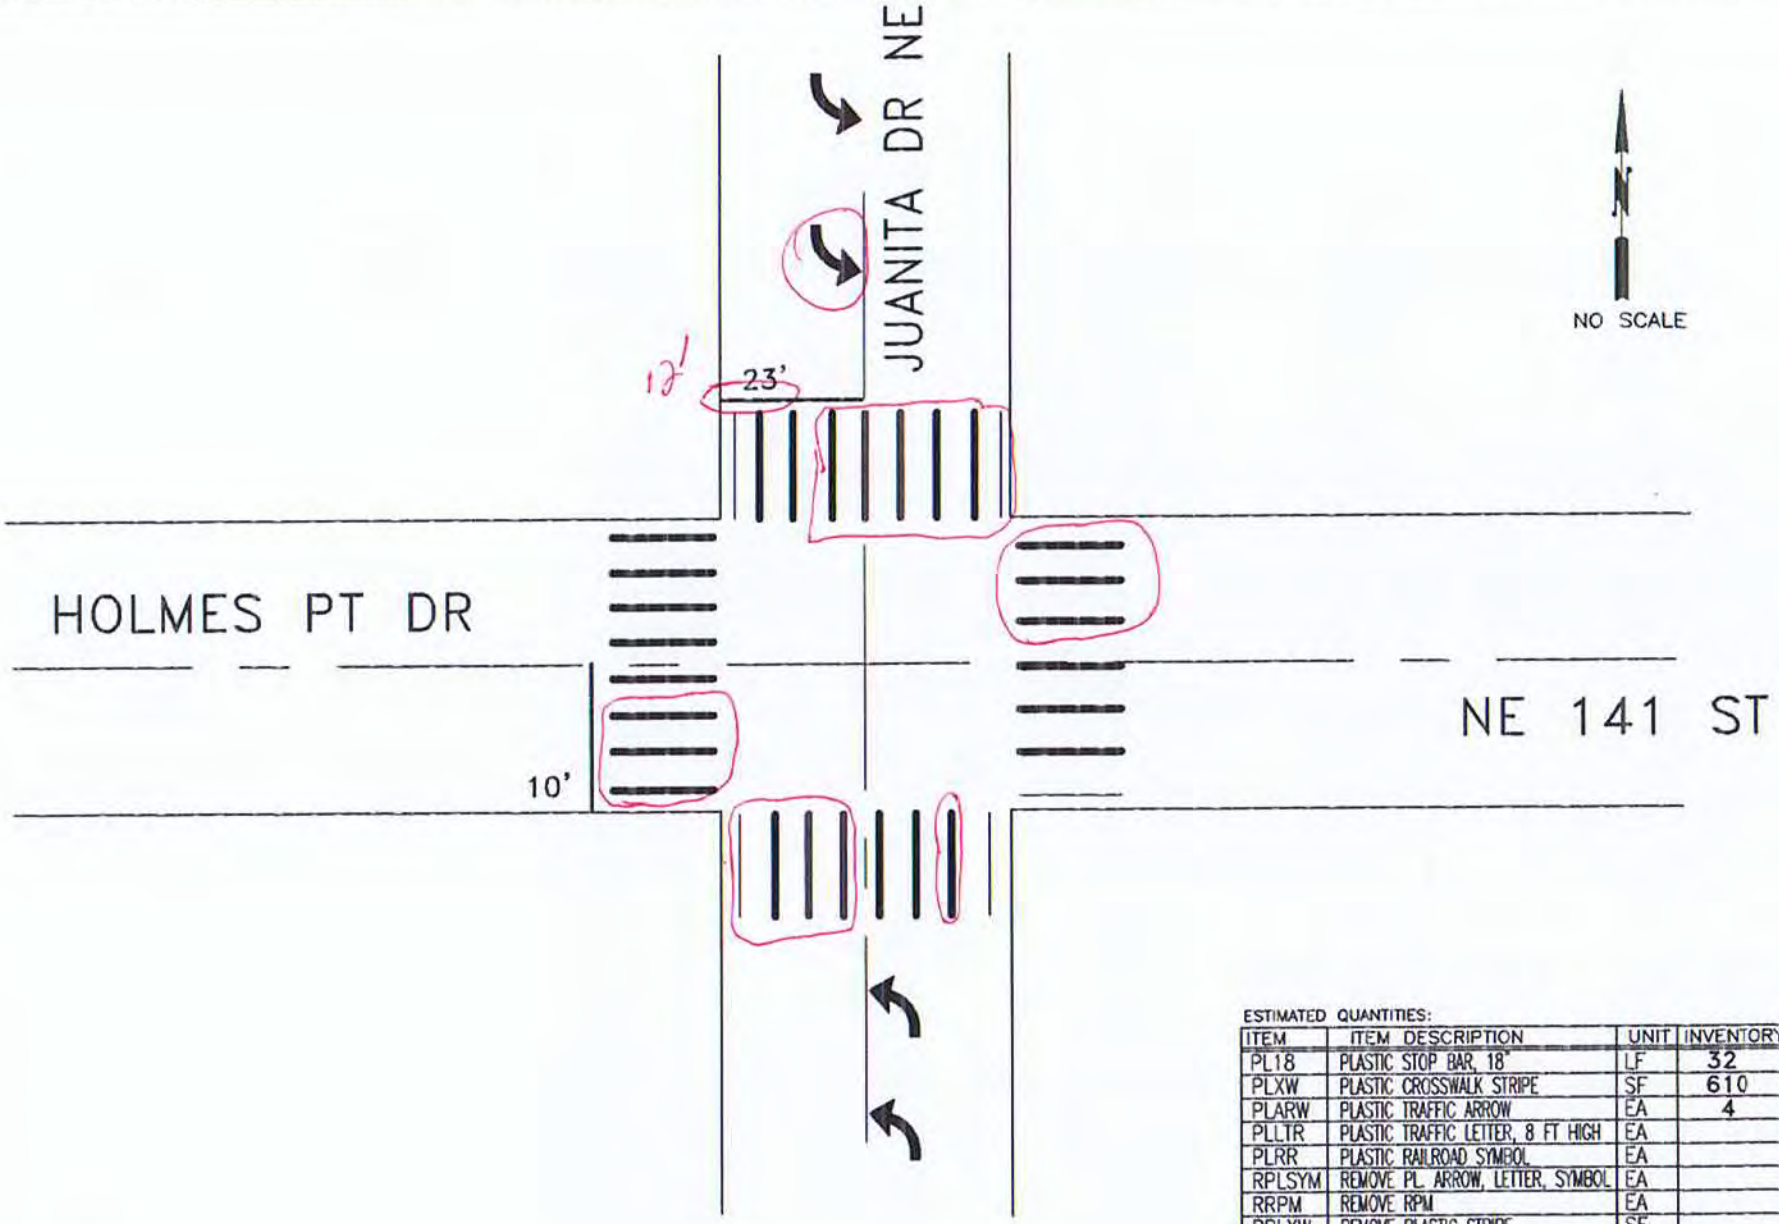

ESTIMATED QUANTITIES:

ITEM	ITEM DESCRIPTION	UNIT	INVENTORY	REPAIR QTY
PL18	PLASTIC STOP BAR, 18"	LF	32	12
PLXW	PLASTIC CROSSWALK STRIPE	SF	610	320
PLARW	PLASTIC TRAFFIC ARROW	EA	4	
PLLTR	PLASTIC TRAFFIC LETTER, 8 FT HIGH	EA		
PLRR	PLASTIC RAILROAD SYMBOL	EA		
RPLSYM	REMOVE PL. ARROW, LETTER, SYMBOL	EA		
RRPM	REMOVE RPM	EA		
RPLXW	REMOVE PLASTIC STRIPE	SF		130
	PLASTIC BIKE DETECTION SYMBOL	EA		

CITY OF KIRKLAND
DEPARTMENT OF PUBLIC WORKS
123 FIFTH AVENUE KIRKLAND, WA 98033
(425) 587-3800 www.kirklandwa.gov

S. GONSAR 4/2019
DESIGNED BY: DATE

J.JENNINGS 4/2019
DRAWN BY: DATE

CHECKED BY: DATE

2020 PAVEMENT MARKING PROGRAM

STREET: JUANITA DRIVE NE

CROSS STREET: NE 141 ST

SEGMENT:

SCALE: N.T.S.

SHEET: PAGE 1-2

NO SCALE

ESTIMATED QUANTITIES:

ITEM	ITEM DESCRIPTION	UNIT	INVENTORY	REPAIR QTY
PL18	PLASTIC STOP BAR, 18"	LF	30	30
PLXW	PLASTIC CROSSWALK STRIPE	SF		
PLARW	PLASTIC TRAFFIC ARROW	EA	2	
PLLTR	PLASTIC TRAFFIC LETTER, 8 FT HIGH	EA		
PLRR	PLASTIC RAILROAD SYMBOL	EA		
RPLSYM	REMOVE PL. ARROW, LETTER, SYMBOL	EA		
RRPM	REMOVE RPM	EA		
RPLXW	REMOVE PLASTIC STRIPE	SF		

CITY OF KIRKLAND
DEPARTMENT OF PUBLIC WORKS
123 FIFTH AVENUE KIRKLAND, WA 98033
(425) 587-3800 www.kirklandwa.gov

S. GONSAR 4/2019
DESIGNED BY: DATE

J.JENNINGS 4/2019
DRAWN BY: DATE

CHECKED BY: DATE

2020 PAVEMENT MARKING PROGRAM

STREET: JUANITA DR NE

CROSS STREET: NE 138TH PL

SEGMENT:

SCALE: N.T.S.

FILENAME: Page 1-3

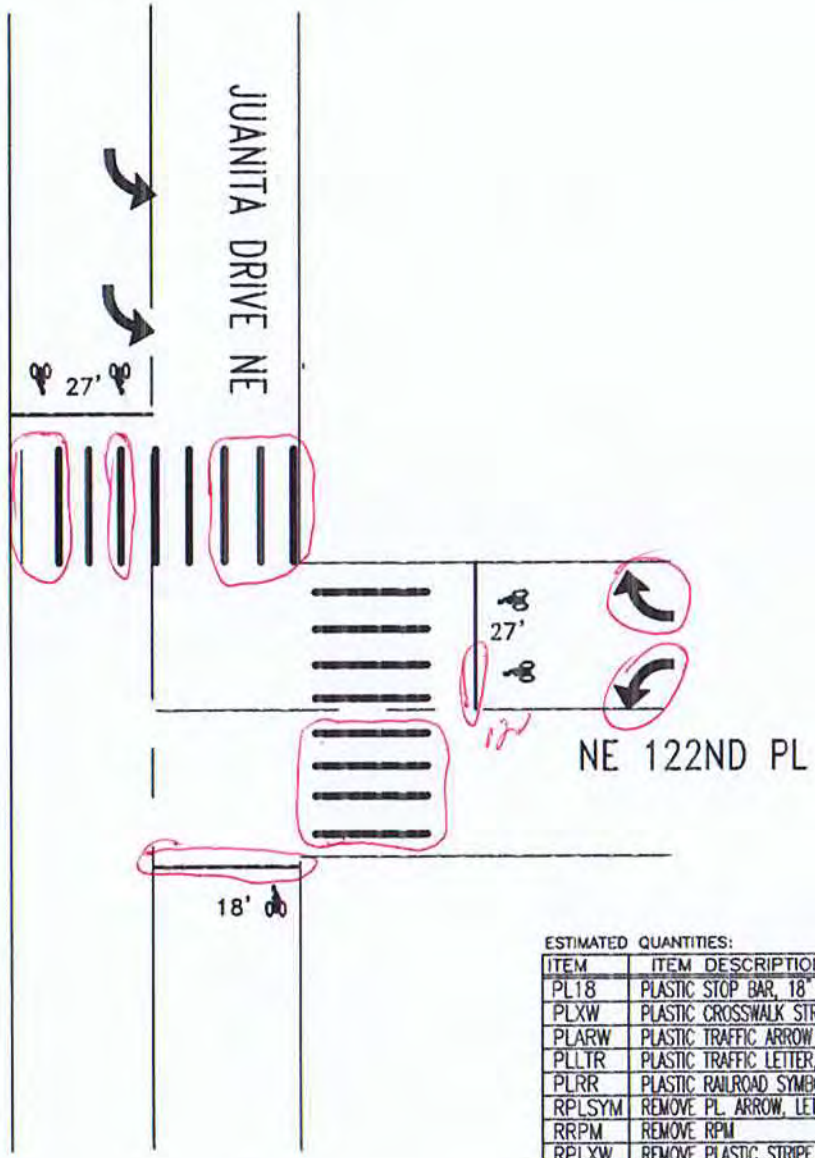

NO SCALE

ESTIMATED QUANTITIES:

ITEM	ITEM DESCRIPTION	UNIT	INVENTORY	REPAIR QTY
PL18	PLASTIC STOP BAR, 18"	LF	72	30
PLXW	PLASTIC CROSSWALK STRIPE	SF	214	112
PLARW	PLASTIC TRAFFIC ARROW	EA	4	2
PLLTR	PLASTIC TRAFFIC LETTER, 8 FT HIGH	EA		
PLRR	PLASTIC RAILROAD SYMBOL	EA		
RPLSYM	REMOVE PL. ARROW, LETTER, SYMBOL	EA		
RRPM	REMOVE RPM	EA		
RPLXW	REMOVE PLASTIC STRIPE	SF		
	PLASTIC BIKE DETECTION SYMBOL	EA	5	

CITY OF KIRKLAND
DEPARTMENT OF PUBLIC WORKS
123 FIFTH AVENUE KIRKLAND, WA 98033
(425) 587-3800 www.kirklandwa.gov

S. GONSAR 4/2019
DESIGNED BY: DATE

J.JENNINGS 4/2019
DRAWN BY: DATE

CHECKED BY: DATE

20__ PAVEMENT MARKING PROGRAM

STREET: JUANITA DRIVE NE

CROSS STREET: NE 122ND PL

SEGMENT:

SCALE: N.T.S.

SHEET: PAGE 1-4

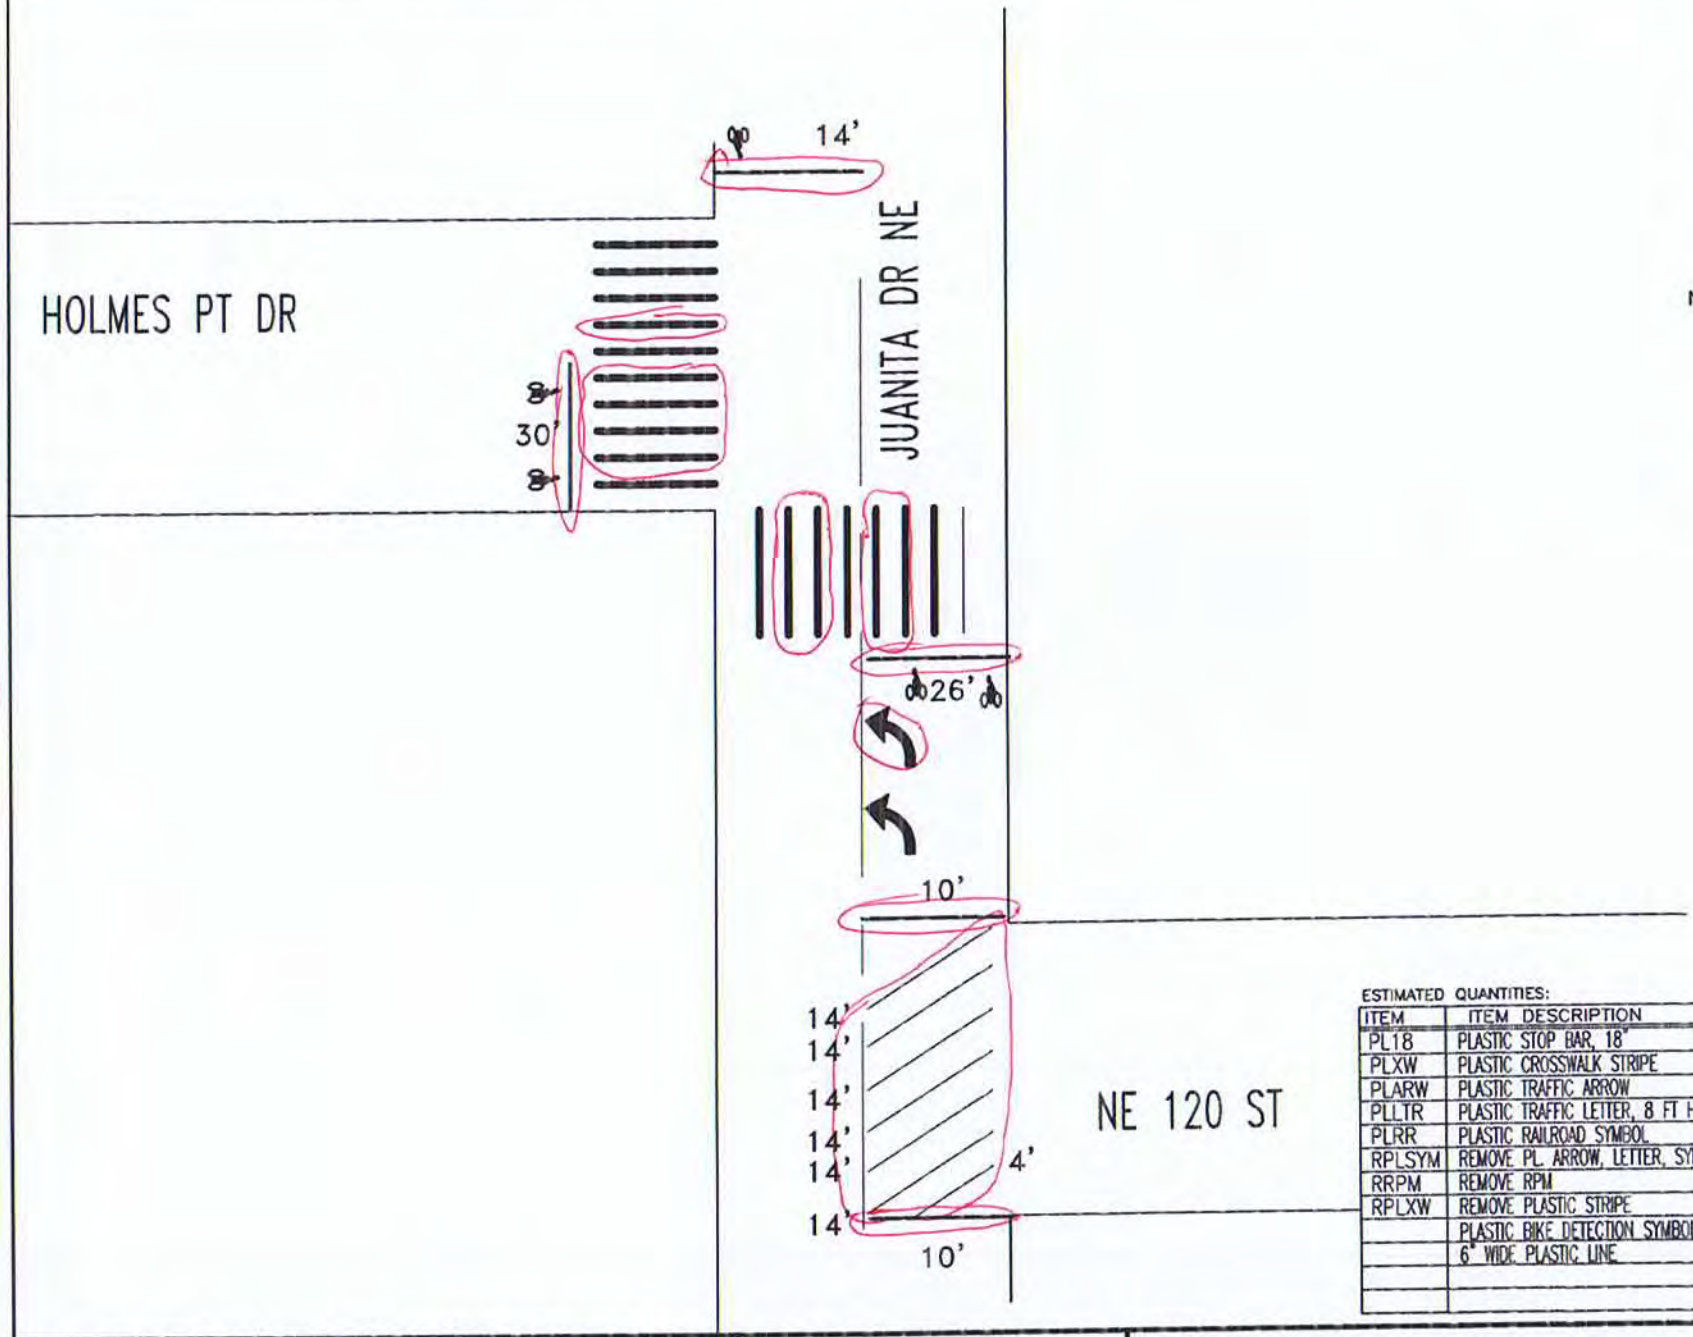

ESTIMATED QUANTITIES:

ITEM	ITEM DESCRIPTION	UNIT	INVENTORY	REPAIR QTY
PL18	PLASTIC STOP BAR, 18"	LF	90	120
PLXW	PLASTIC CROSSWALK STRIPE	SF	350	185
PLARW	PLASTIC TRAFFIC ARROW	EA	2	
PLLTR	PLASTIC TRAFFIC LETTER, 8 FT HIGH	EA		
PLRR	PLASTIC RAILROAD SYMBOL	EA		
RPLSYM	REMOVE PL. ARROW, LETTER, SYMBOL	EA		
RRPM	REMOVE RPM	EA		
RPLXW	REMOVE PLASTIC STRIPE	SF		120
	PLASTIC BIKE DETECTION SYMBOL	EA	5	
	6" WIDE PLASTIC LINE	LF	98	98

CITY OF KIRKLAND
DEPARTMENT OF PUBLIC WORKS
123 FIFTH AVENUE KIRKLAND, WA 98033
(425) 587-3800 www.kirklandwa.gov

S. GONSAR 4/2019
DESIGNED BY: DATE

J.JENNINGS 4/2019
DRAWN BY: DATE

CHECKED BY: DATE

2020 PAVEMENT MARKING PROGRAM

STREET: JUANITA DRIVE NE

CROSS STREET: NE 120TH STREET

SEGMENT:

SCALE: N.T.S.

SHEET: PAGE 1-5

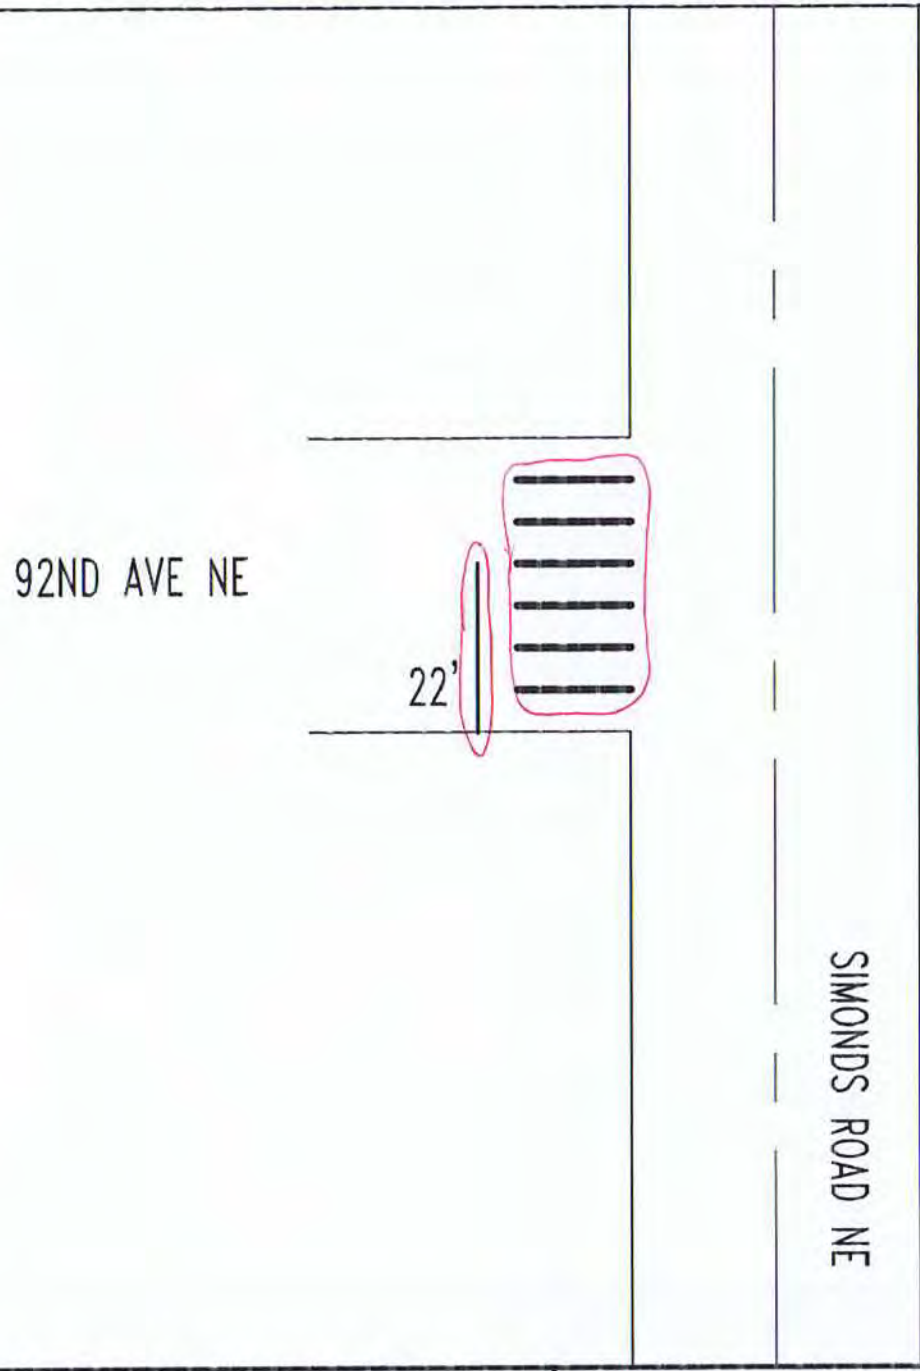

NO SCALE

ESTIMATED QUANTITIES:

ITEM	ITEM DESCRIPTION	UNIT	INVENTORY	REPAIR QTY
PL18	PLASTIC STOP BAR, 18"	LF	22	22
PLXW	PLASTIC CROSSWALK STRIPE	SF	120	135
PLARW	PLASTIC TRAFFIC ARROW	EA		
PLLTR	PLASTIC TRAFFIC LETTER, 8 FT HIGH	EA		
PLRR	PLASTIC RAILROAD SYMBOL	EA		
RPLSYM	REMOVE PL. ARROW, LETTER, SYMBOL	EA		
RRPM	REMOVE RPM	EA		
RPLXW	REMOVE PLASTIC STRIPE	SF		

CITY OF KIRKLAND
DEPARTMENT OF PUBLIC WORKS
123 FIFTH AVENUE KIRKLAND, WA 98033
(425) 587-3800 www.kirklandwa.gov

S. GONSAR 4/2019
DESIGNED BY: DATE

J.JENNINGS 4/2019
DRAWN BY: DATE

CHECKED BY: DATE

2020 PAVEMENT MARKING PROGRAM

STREET: SIMONDS ROAD NE

CROSS STREET: 92ND AVE NE

SEGMENT:

SCALE: N.T.S.

FILENAME:

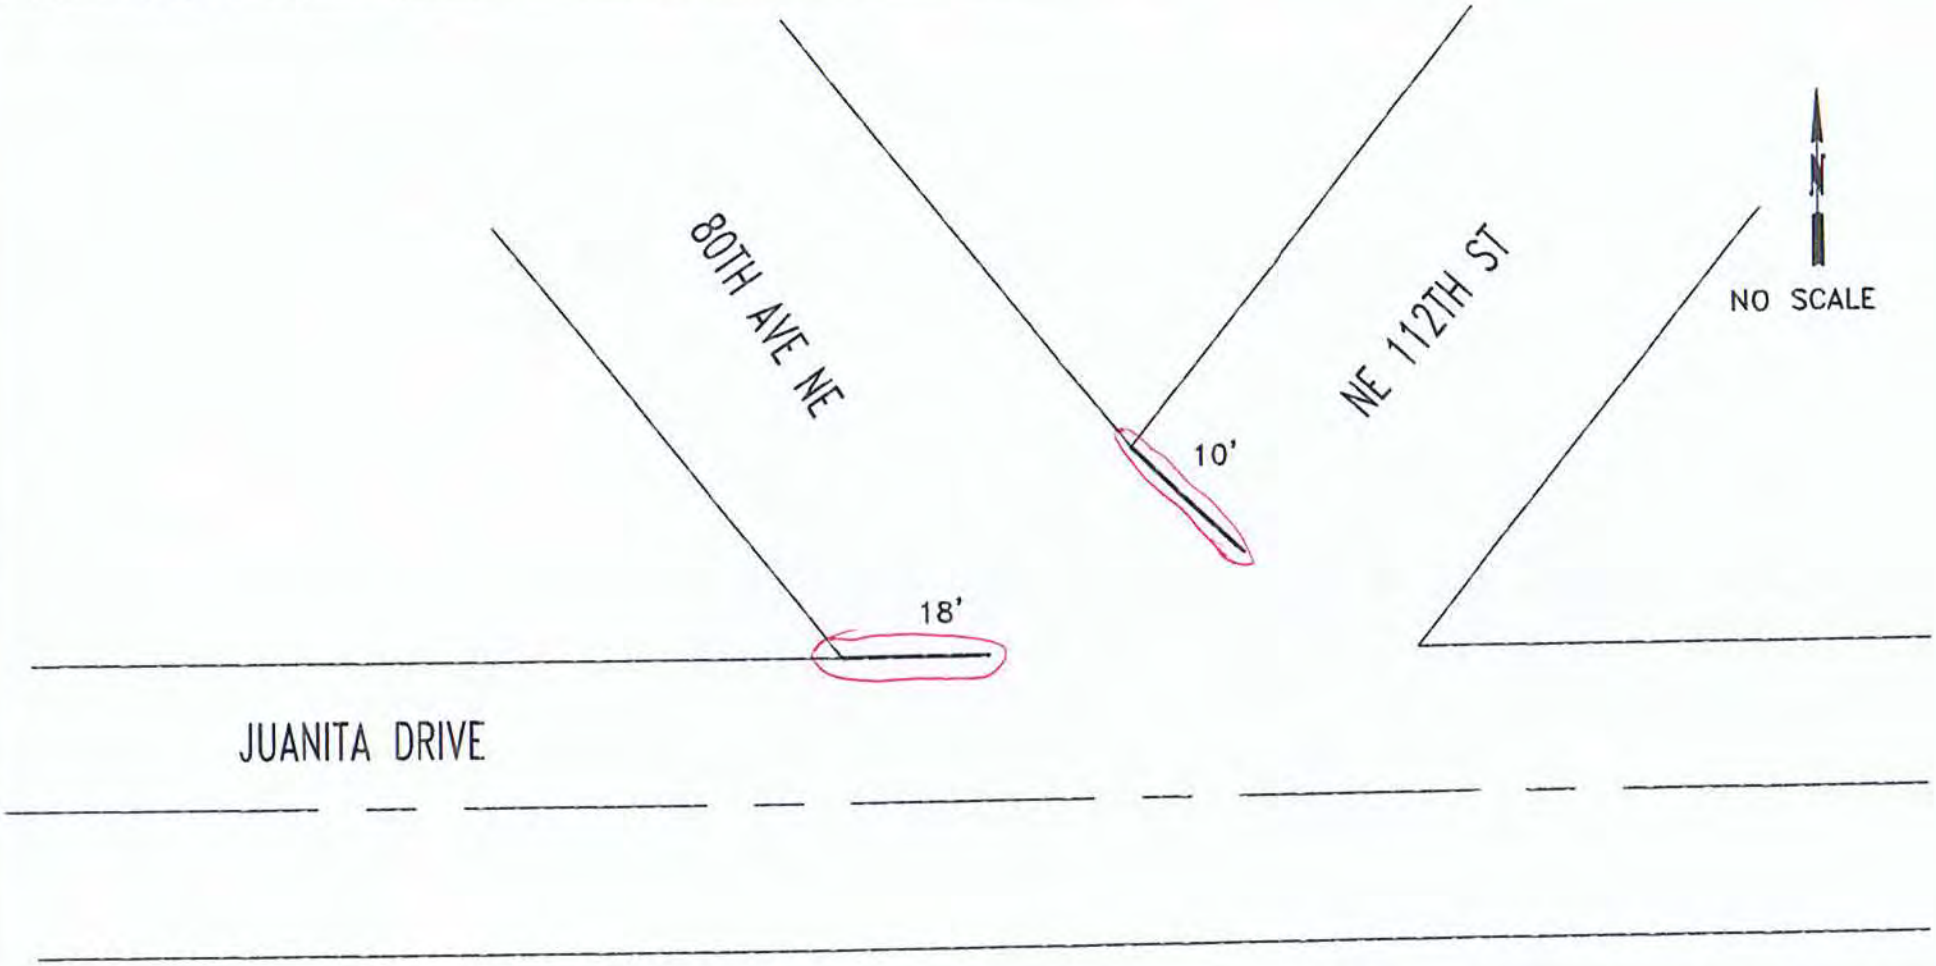

ESTIMATED QUANTITIES:

ITEM	ITEM DESCRIPTION	UNIT	INVENTORY	REPAIR QTY
PL18	PLASTIC STOP BAR, 18"	LF	28	28
PLXW	PLASTIC CROSSWALK STRIPE	SF		
PLARW	PLASTIC TRAFFIC ARROW	EA		
PLLTR	PLASTIC TRAFFIC LETTER, 8 FT HIGH	EA		
PLRR	PLASTIC RAILROAD SYMBOL	EA		
RPLSYM	REMOVE PL. ARROW, LETTER, SYMBOL	EA		
RRPM	REMOVE RPM	EA		
RPLXW	REMOVE PLASTIC STRIPE	SF		

CITY OF KIRKLAND
DEPARTMENT OF PUBLIC WORKS
123 FIFTH AVENUE KIRKLAND, WA 98033
(425) 587-3800 www.kirklandwa.gov

F. LEE 4/2019
DESIGNED BY: DATE

J.JENNINGS 4/2019
DRAWN BY: DATE

CHECKED BY: DATE

2022 PAVEMENT MARKING PROGRAM

STREET: JUANITA DRIVE NE

CROSS STREET: 80TH AVE NE

SEGMENT:

SCALE: N.T.S.

FILENAME: Page 1-7

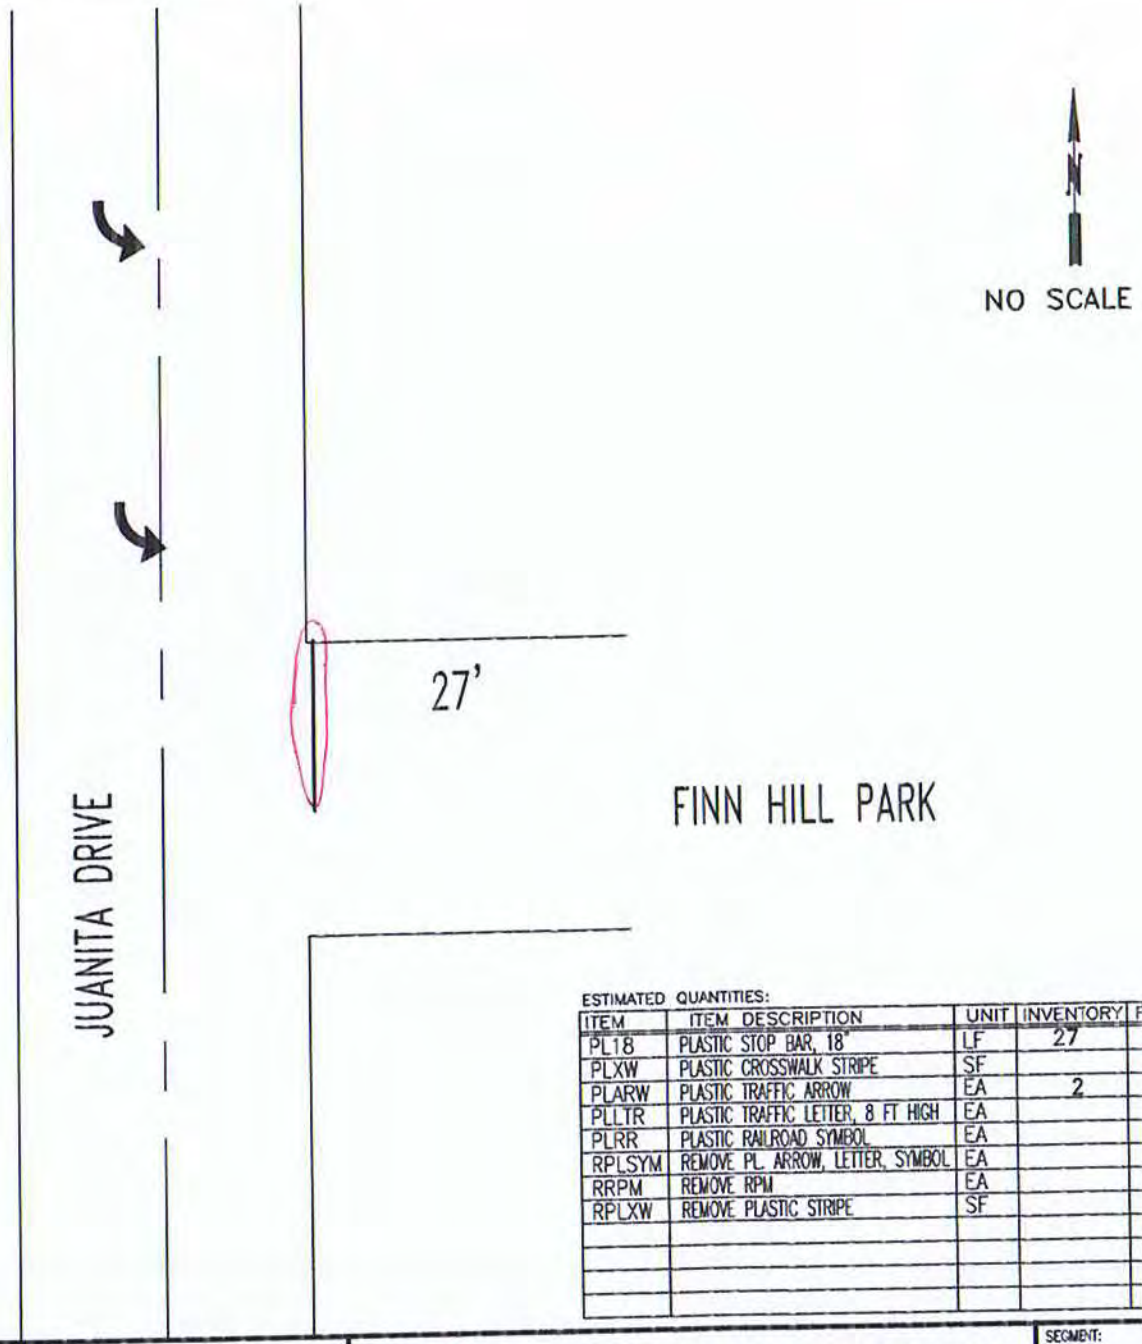

ESTIMATED QUANTITIES:

ITEM	ITEM DESCRIPTION	UNIT	INVENTORY	REPAIR QTY
PL18	PLASTIC STOP BAR, 18"	LF	27	27
PLXW	PLASTIC CROSSWALK STRIPE	SF		
PLARW	PLASTIC TRAFFIC ARROW	EA	2	
PLLTR	PLASTIC TRAFFIC LETTER, 8 FT HIGH	EA		
PLRR	PLASTIC RAILROAD SYMBOL	EA		
RPLSYM	REMOVE PL. ARROW, LETTER, SYMBOL	EA		
RRPM	REMOVE RPM	EA		
RPLXW	REMOVE PLASTIC STRIPE	SF		

CITY OF KIRKLAND
DEPARTMENT OF PUBLIC WORKS
123 FIFTH AVENUE KIRKLAND, WA 98033
(425) 587-3800 www.kirklandwa.gov

S. GONSAR 4/2019
DESIGNED BY: DATE

J.JENNINGS 4/2019
DRAWN BY: DATE

CHECKED BY: DATE

2022 PAVEMENT MARKING PROGRAM

STREET: JUANITA DRIVE

CROSS STREET: FINN HILL PARK ENTRANCE

SEGMENT:

SCALE: N.T.S.

FILENAME: 1-8

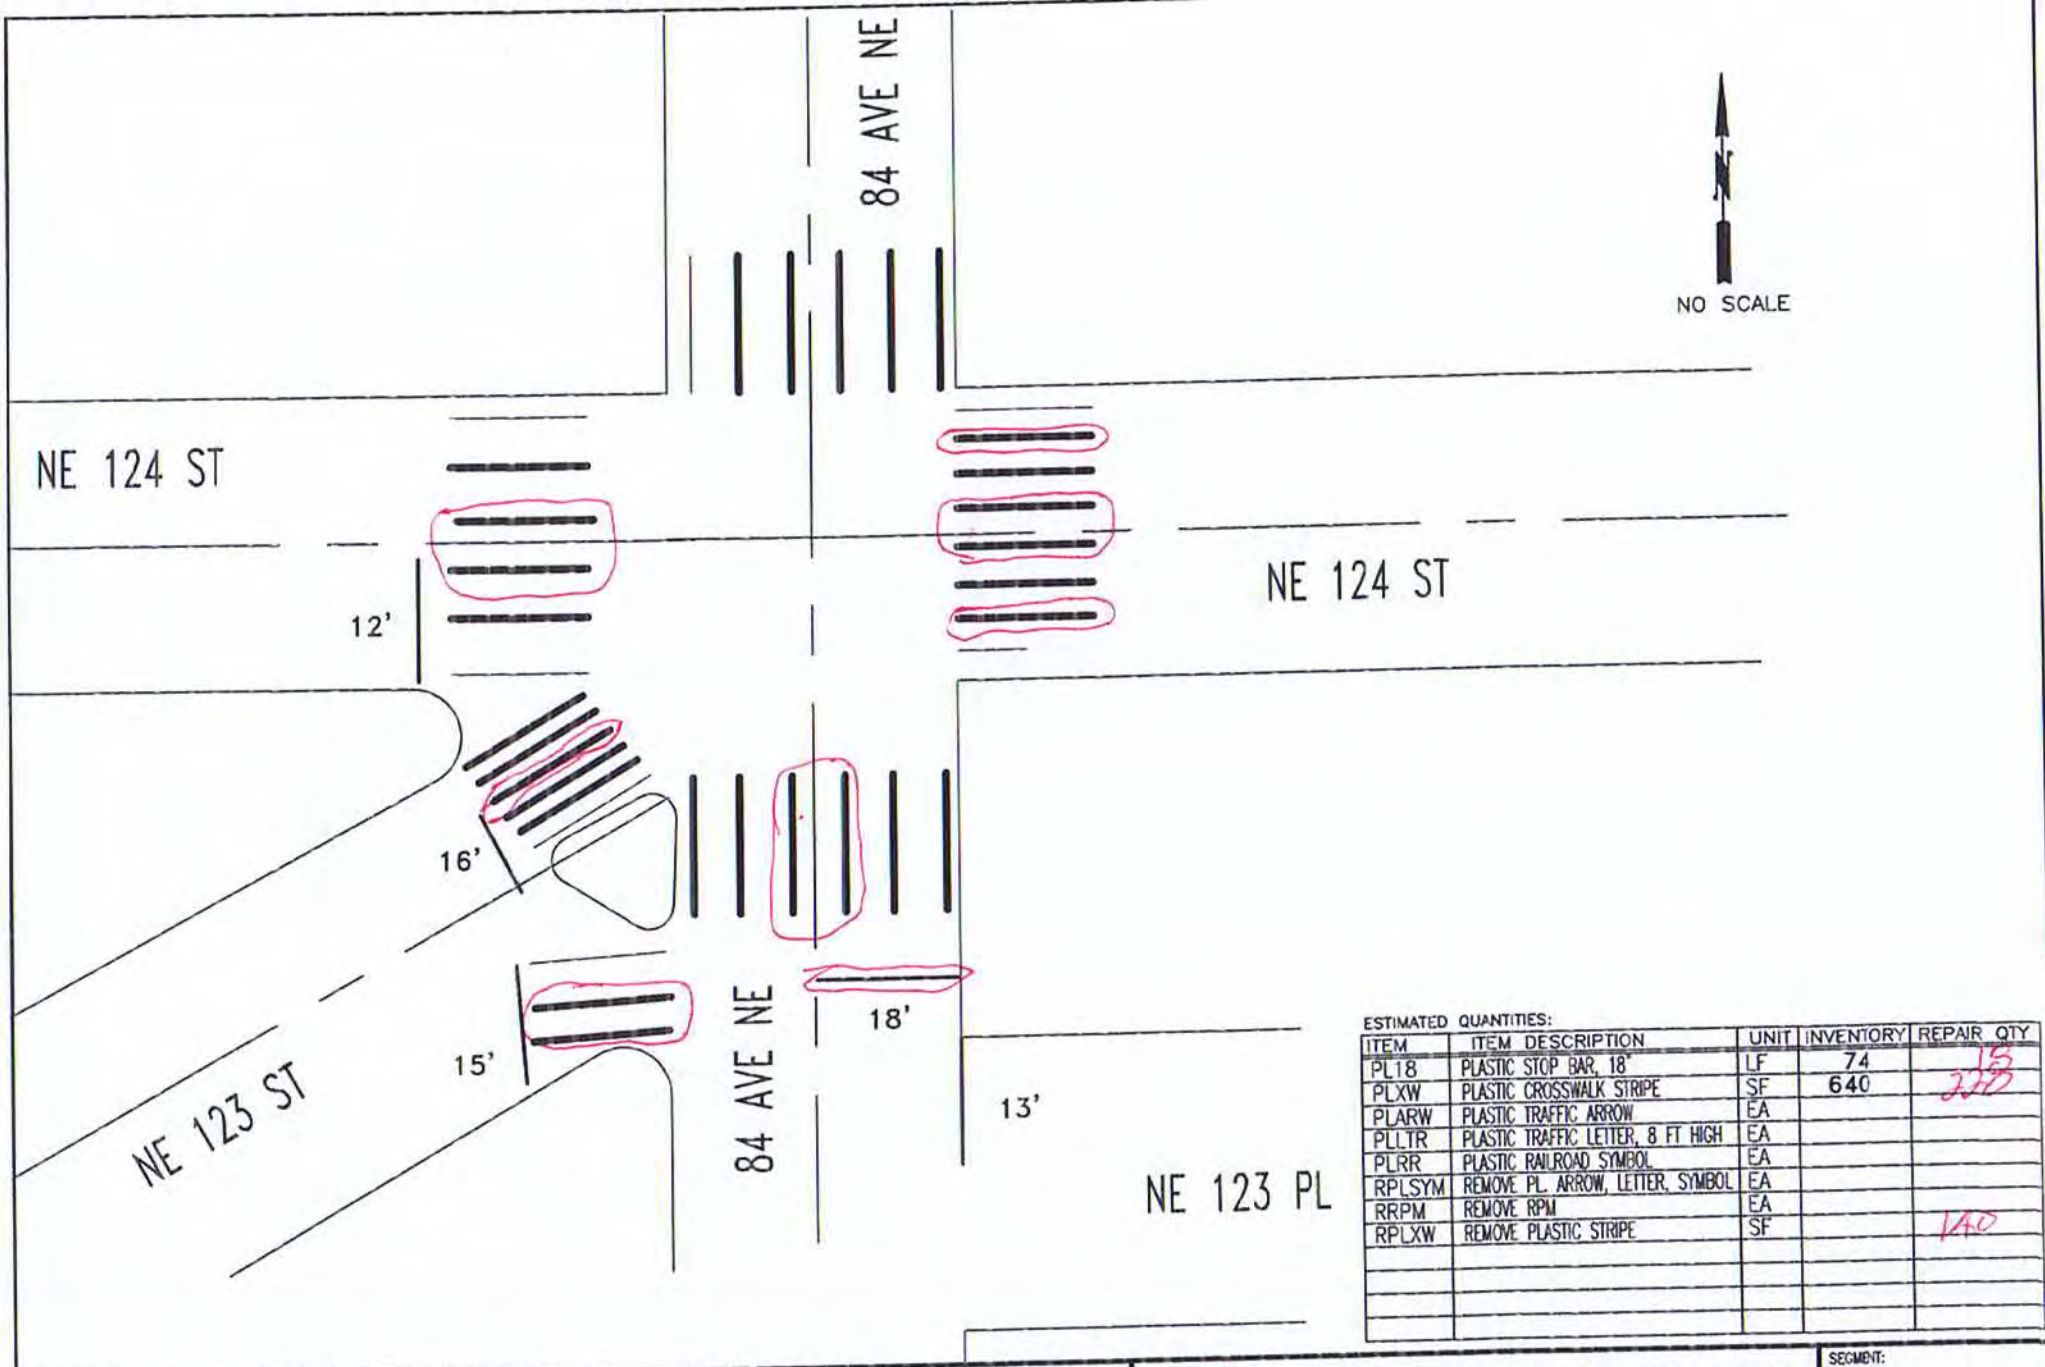

ESTIMATED QUANTITIES:

ITEM	ITEM DESCRIPTION	UNIT	INVENTORY	REPAIR QTY
PL18	PLASTIC STOP BAR, 18"	LF	74	15
PLXW	PLASTIC CROSSWALK STRIPE	SF	640	225
PLARW	PLASTIC TRAFFIC ARROW	EA		
PLLTR	PLASTIC TRAFFIC LETTER, 8 FT HIGH	EA		
PLRR	PLASTIC RAILROAD SYMBOL	EA		
RPLSYM	REMOVE PL. ARROW, LETTER, SYMBOL	EA		
RRPM	REMOVE RPM	EA		
RPLXW	REMOVE PLASTIC STRIPE	SF		140

CITY OF KIRKLAND WASHINGTON

CITY OF KIRKLAND
DEPARTMENT OF PUBLIC WORKS
123 FIFTH AVENUE KIRKLAND, WA 98033
(425) 587-3800 www.kirklandwa.gov

G. HORTILLOSA 2/2012
DESIGNED BY: DATE

J.JENNINGS 2/2012
DRAWN BY: DATE

REVISED: DATE

2020 PAVEMENT MARKING PROGRAM

STREET: NE 124TH ST

CROSS STREET: 84TH AVE NE

SEGMENT:

SCALE: N.T.S.

FILENAME: Page 1-9

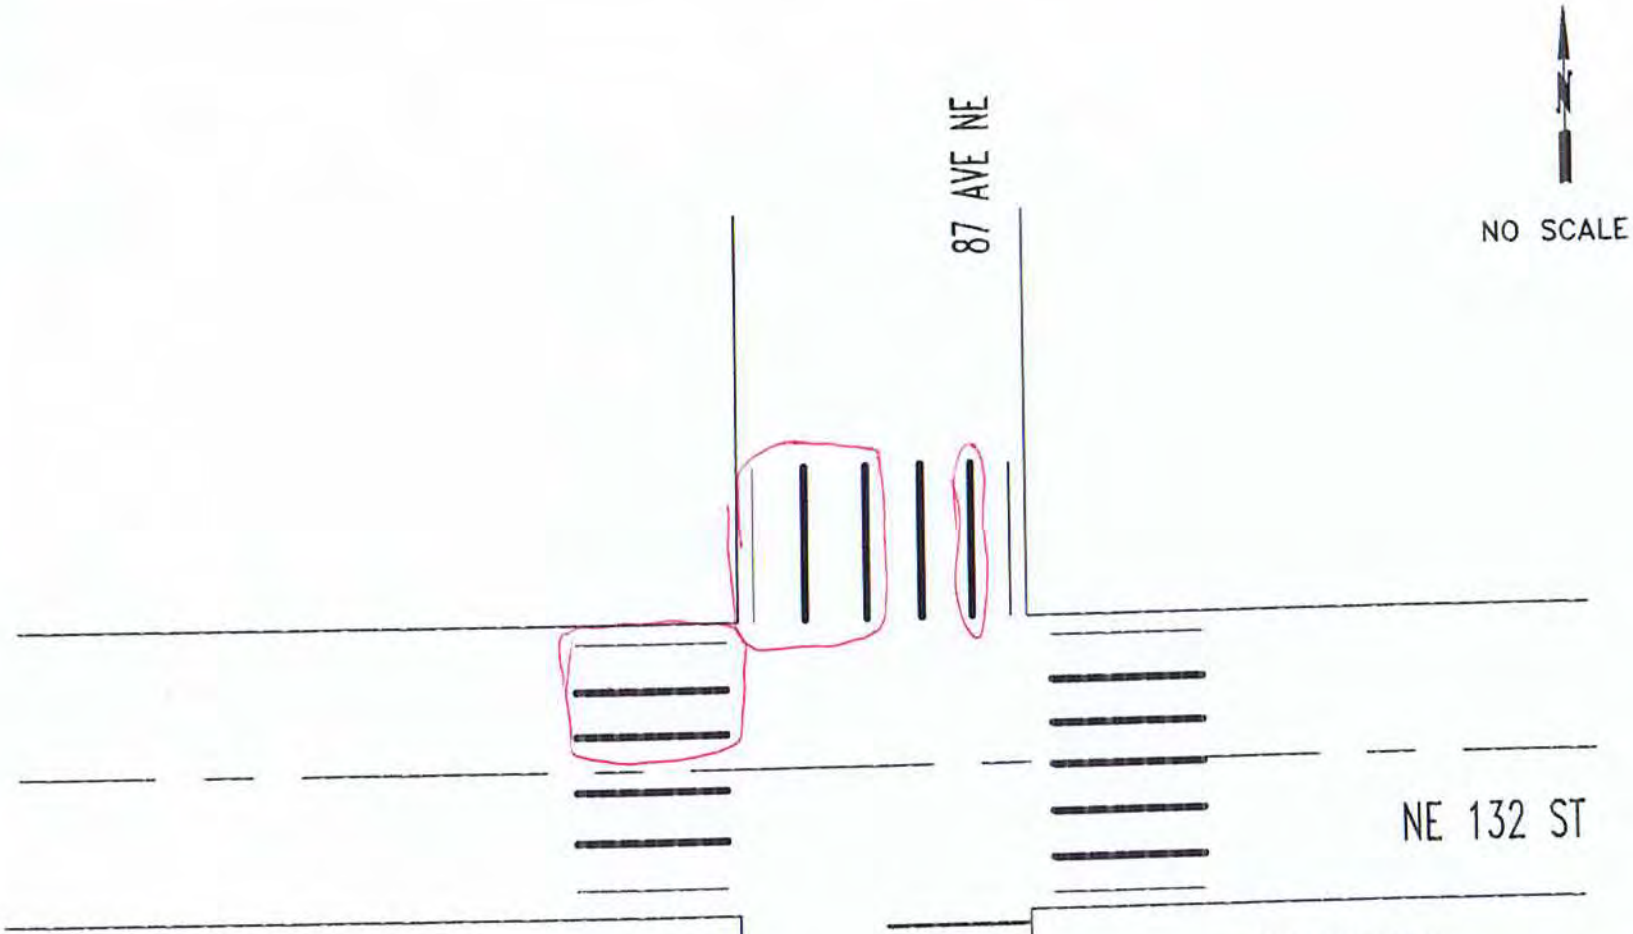

ESTIMATED QUANTITIES:

ITEM	ITEM DESCRIPTION	UNIT	INVENTORY	REPAIR QTY
PL18	PLASTIC STOP BAR, 18"	LF	22	
PLXW	PLASTIC CROSSWALK STRIPE	SF	272	120
PLARW	PLASTIC TRAFFIC ARROW	EA		
PLLTR	PLASTIC TRAFFIC LETTER, 8 FT HIGH	EA		
PLRR	PLASTIC RAILROAD SYMBOL	EA		
RPLSYM	REMOVE PL. ARROW, LETTER, SYMBOL	EA		
RRPM	REMOVE RPM	EA		
RPLXW	REMOVE PLASTIC STRIPE	SF		

CITY OF KIRKLAND
DEPARTMENT OF PUBLIC WORKS
123 FIFTH AVENUE KIRKLAND, WA 98033
(425) 587-3800 www.kirklandwa.gov

G. HORTILLOSA 2/2012
DESIGNED BY: DATE

J.JENNINGS 2/2012
DRAWN BY: DATE

CHECKED BY: DATE

2020 PAVEMENT MARKING PROGRAM

STREET: NE 132ND ST

CROSS STREET: 87 AVE NE

SEGMENT:

SCALE: N.T.S.

FILENAME: Page 1-10

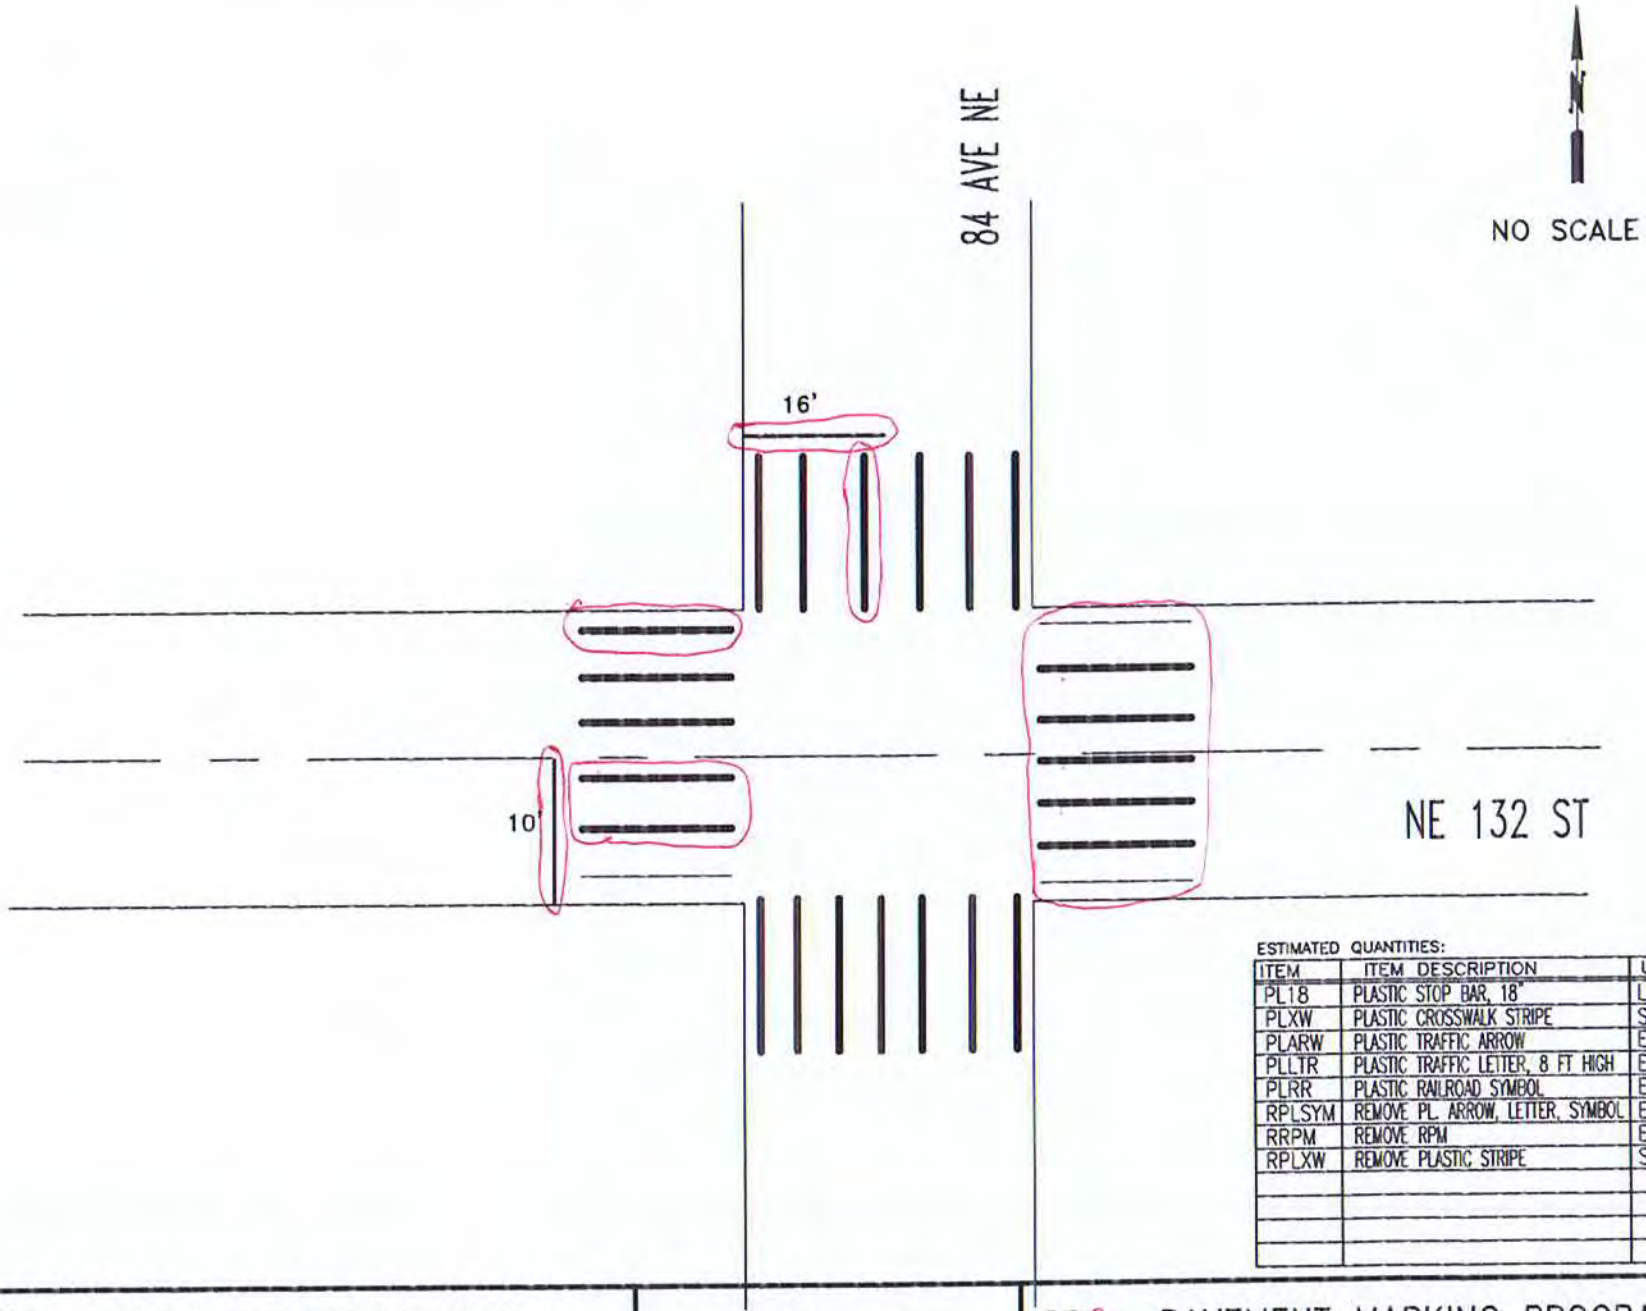

ESTIMATED QUANTITIES:

ITEM	ITEM DESCRIPTION	UNIT	INVENTORY	REPAIR QTY
PL18	PLASTIC STOP BAR, 18"	LF	26	26
PLXW	PLASTIC CROSSWALK STRIPE	SF	490	288
PLARW	PLASTIC TRAFFIC ARROW	EA		
PLLTR	PLASTIC TRAFFIC LETTER, 8 FT HIGH	EA		
PLRR	PLASTIC RAILROAD SYMBOL	EA		
RPLSYM	REMOVE PL. ARROW, LETTER, SYMBOL	EA		
RRPM	REMOVE RPM	EA		
RPLXW	REMOVE PLASTIC STRIPE	SF		150

CITY OF KIRKLAND
DEPARTMENT OF PUBLIC WORKS
123 FIFTH AVENUE KIRKLAND, WA 98033
(425) 587-3800 www.kirklandwa.gov

G. HORTILLOSA 2/2012
DESIGNED BY: DATE

J.JENNINGS 2/2012
DRAWN BY: DATE

CHECKED BY: DATE

2020 PAVEMENT MARKING PROGRAM

STREET: NE 132ND ST

CROSS STREET: 84 AVE NE

SEGMENT:

SCALE: N.T.S.

FILENAME: Page 1-11

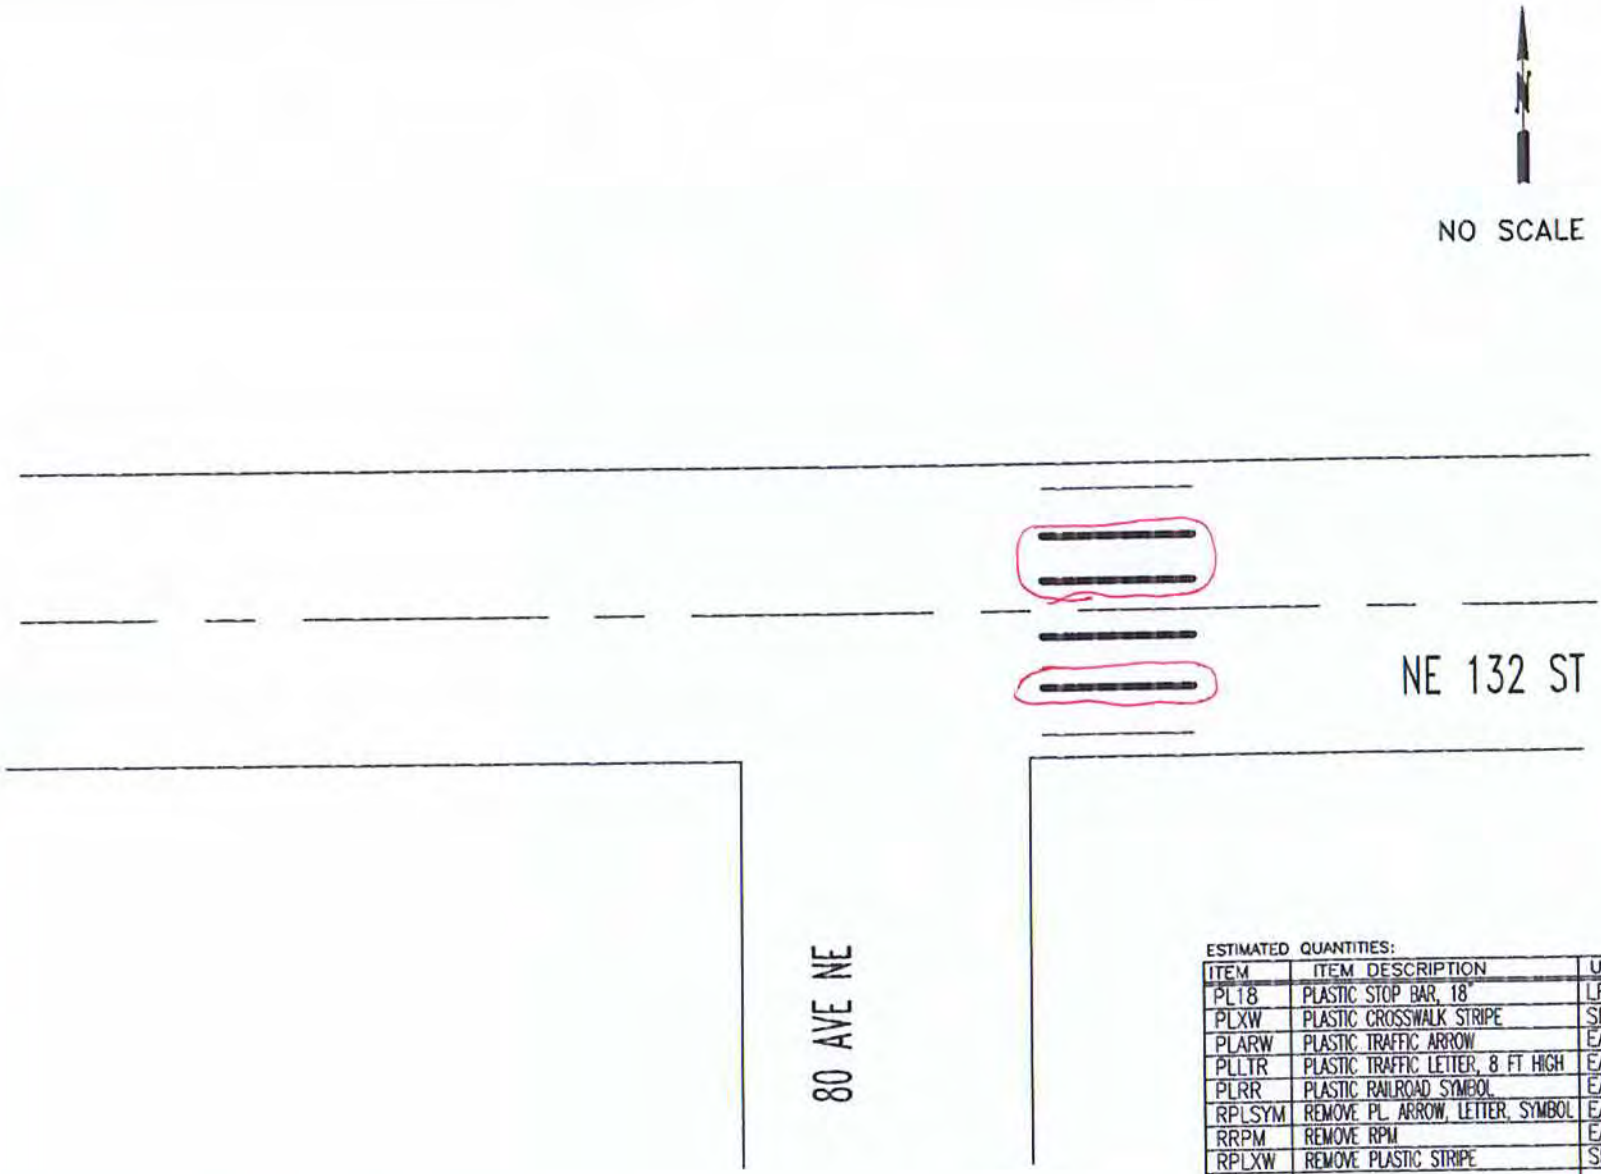

ESTIMATED QUANTITIES:

ITEM	ITEM DESCRIPTION	UNIT	INVENTORY	REPAIR QTY
PL18	PLASTIC STOP BAR, 18"	LF		
PLXW	PLASTIC CROSSWALK STRIPE	SF	120	60
PLARW	PLASTIC TRAFFIC ARROW	EA		
PLLTR	PLASTIC TRAFFIC LETTER, 8 FT HIGH	EA		
PLRR	PLASTIC RAILROAD SYMBOL	EA		
RPLSYM	REMOVE PL. ARROW, LETTER, SYMBOL	EA		
RRPM	REMOVE RPM	EA		
RPLXW	REMOVE PLASTIC STRIPE	SF		60

CITY OF KIRKLAND WASHINGTON

CITY OF KIRKLAND
DEPARTMENT OF PUBLIC WORKS
123 FIFTH AVENUE KIRKLAND, WA 98033
(425) 587-3800 www.kirklandwa.gov

G. HORTILLOSA 2/2012
DESIGNED BY: DATE

J.JENNINGS 2/2012
DRAWN BY: DATE

CHECKED BY: DATE

2020 PAVEMENT MARKING PROGRAM

STREET: NE 132ND ST


SEGMENT:

SCALE: N.T.S.

FILENAME:

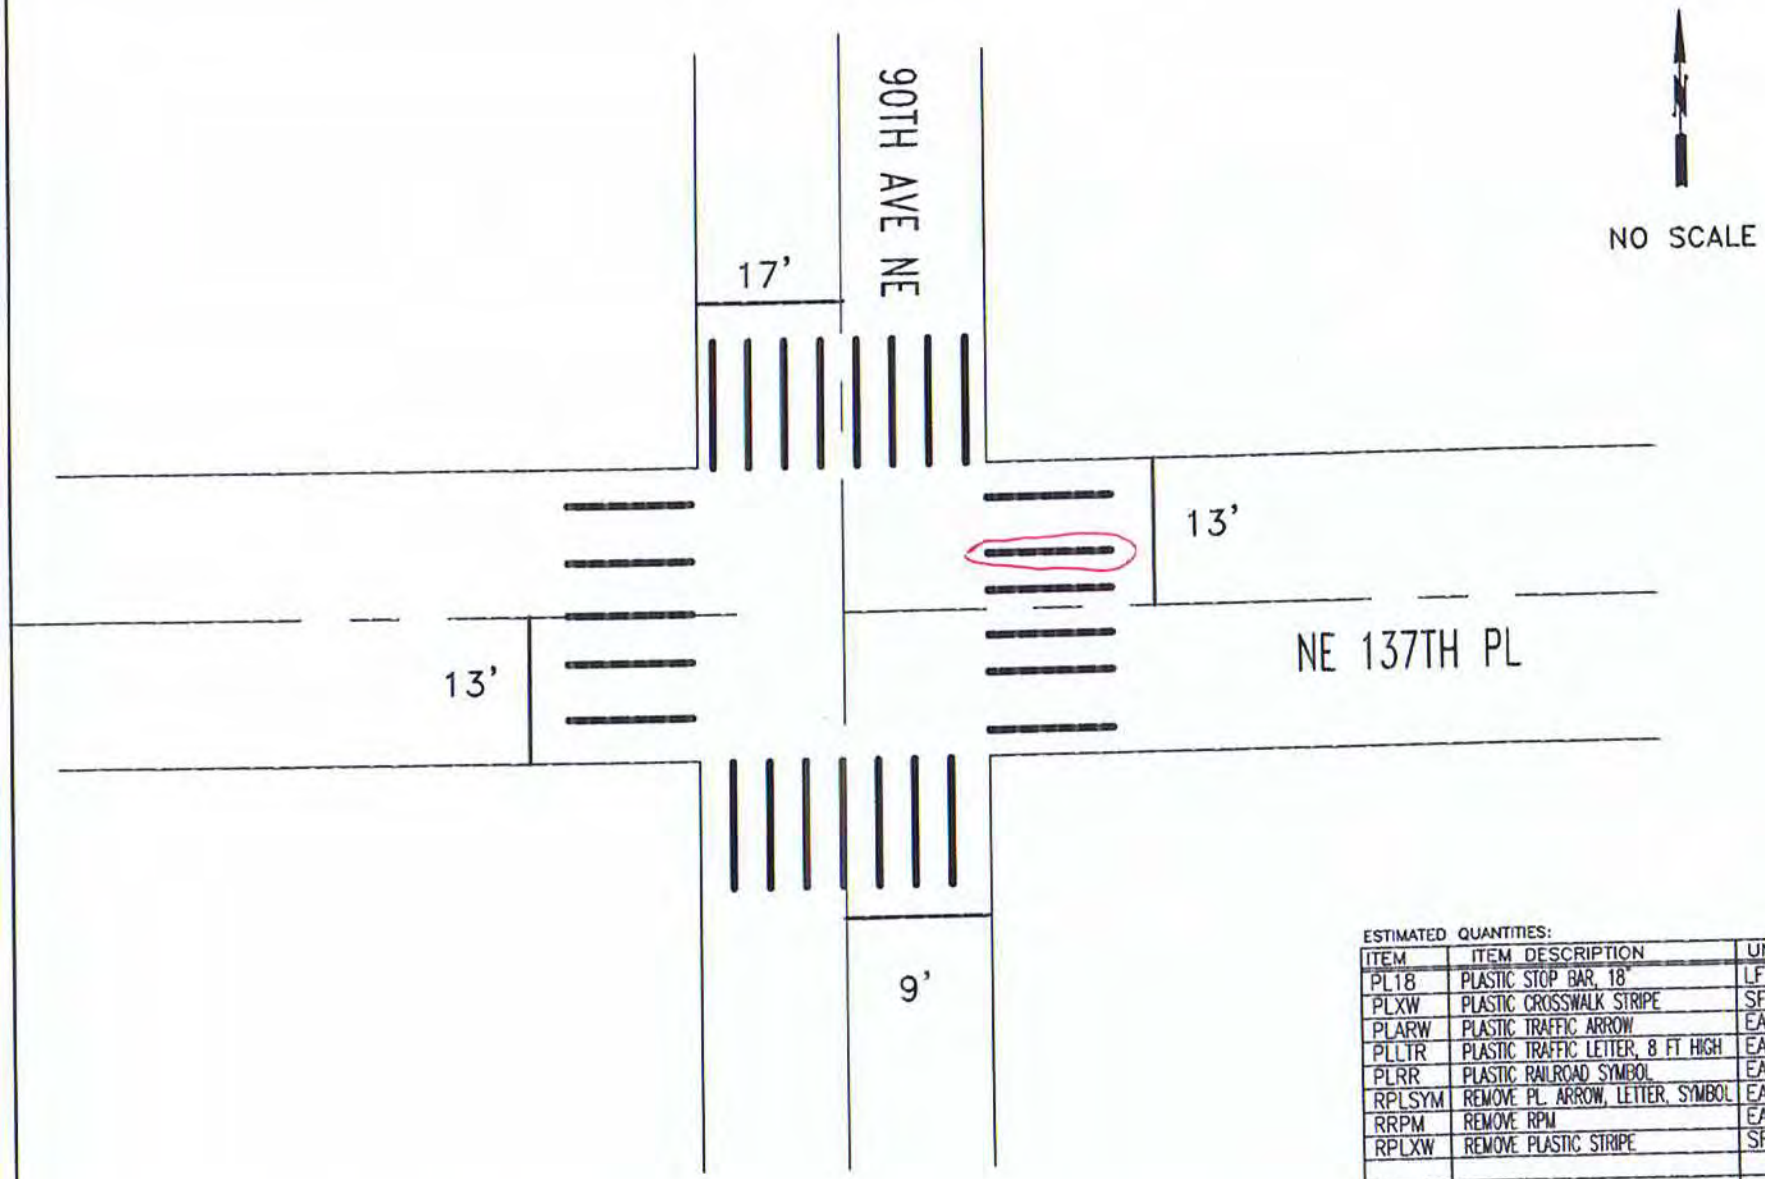

ESTIMATED QUANTITIES:

ITEM	ITEM DESCRIPTION	UNIT	INVENTORY	REPAIR QTY
PL18	PLASTIC STOP BAR, 18"	LF	66	
PLXW	PLASTIC CROSSWALK STRIPE	SF	500	20
PLARW	PLASTIC TRAFFIC ARROW	EA		
PLLTR	PLASTIC TRAFFIC LETTER, 8 FT HIGH	EA		
PLRR	PLASTIC RAILROAD SYMBOL	EA		
RPLSYM	REMOVE PL. ARROW, LETTER, SYMBOL	EA		
RRPM	REMOVE RPM	EA		
RPLXW	REMOVE PLASTIC STRIPE	SF		20

CITY OF KIRKLAND
DEPARTMENT OF PUBLIC WORKS
123 FIFTH AVENUE KIRKLAND, WA 98033
(425) 587-3800 www.kirklandwa.gov

A. KHANAL,PE 9/2014
DESIGNED BY: DATE

J.JENNINGS 9/2014
DRAWN BY: DATE

REVISED BY: DATE


STREET: 90TH AVE NE

CROSS STREET: NE 137TH PL

SEGMENT:

SCALE: N.T.S.

FILENAME:

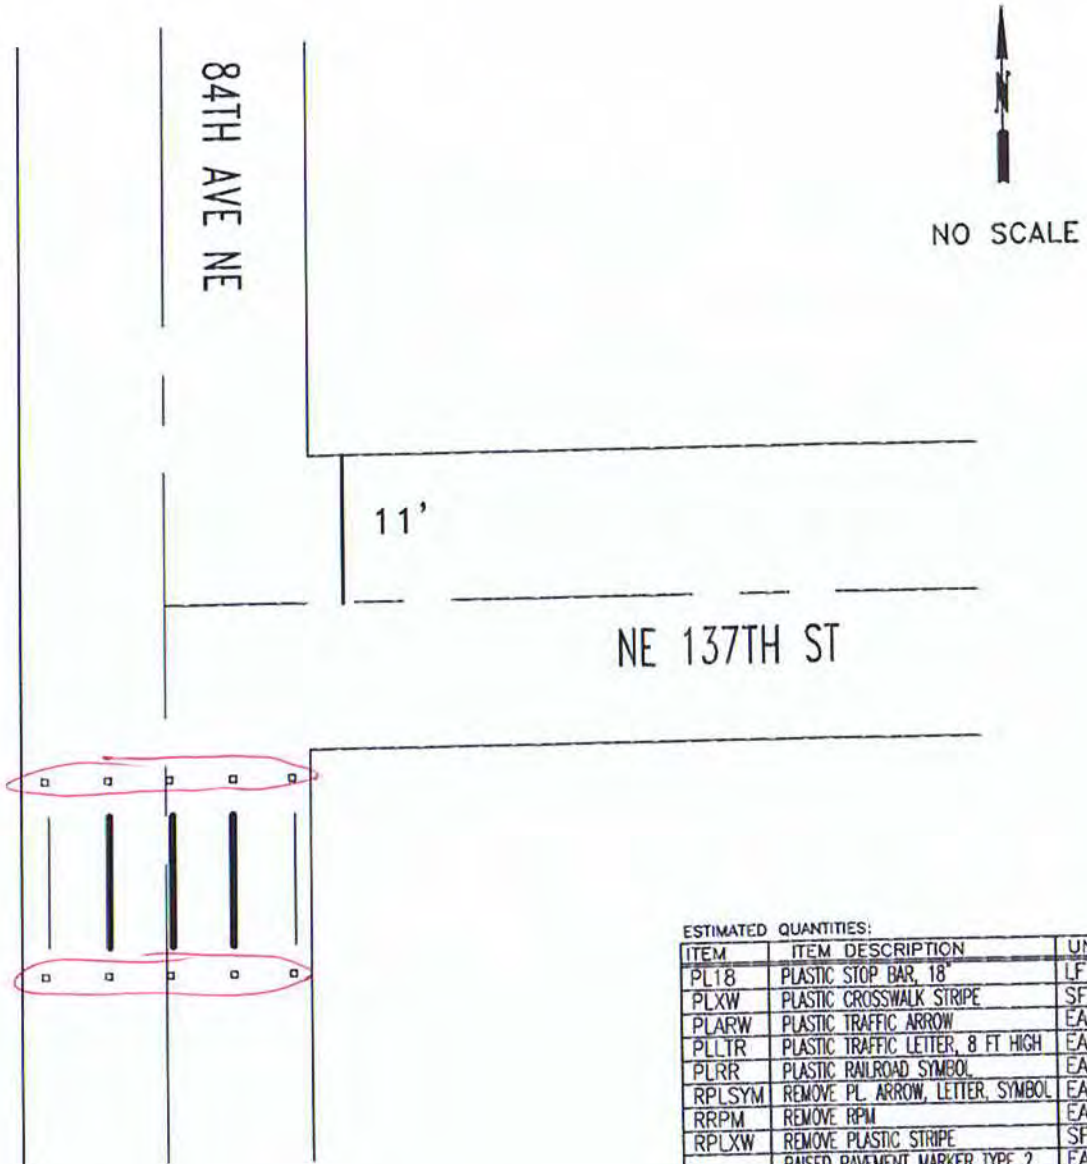

ESTIMATED QUANTITIES:

ITEM	ITEM DESCRIPTION	UNIT	INVENTORY	REPAIR QTY
PL18	PLASTIC STOP BAR, 18"	LF	11	
PLXW	PLASTIC CROSSWALK STRIPE	SF	80	
PLARW	PLASTIC TRAFFIC ARROW	EA		
PLLTR	PLASTIC TRAFFIC LETTER, 8 FT HIGH	EA		
PLRR	PLASTIC RAILROAD SYMBOL	EA		
RPLSYM	REMOVE PL. ARROW, LETTER, SYMBOL	EA		
RRPM	REMOVE RPM	EA		
RPLXW	REMOVE PLASTIC STRIPE	SF		
	RAISED PAVEMENT MARKER TYPE 2	EA	10	10

CITY OF KIRKLAND
DEPARTMENT OF PUBLIC WORKS
123 FIFTH AVENUE KIRKLAND, WA 98033
(425) 587-3800 www.kirklandwa.gov

G. HORTILLOSA 10/2013
DESIGNED BY: DATE

J.JENNINGS 10/2013
DRAWN BY: DATE

REVISED BY: DATE

2020 PAVEMENT MARKING PROGRAM

STREET: 84TH AVE NE

CROSS STREET: NE 137TH ST

SEGMENT:

SCALE: N.T.S.

FILENAME: Page 1-16

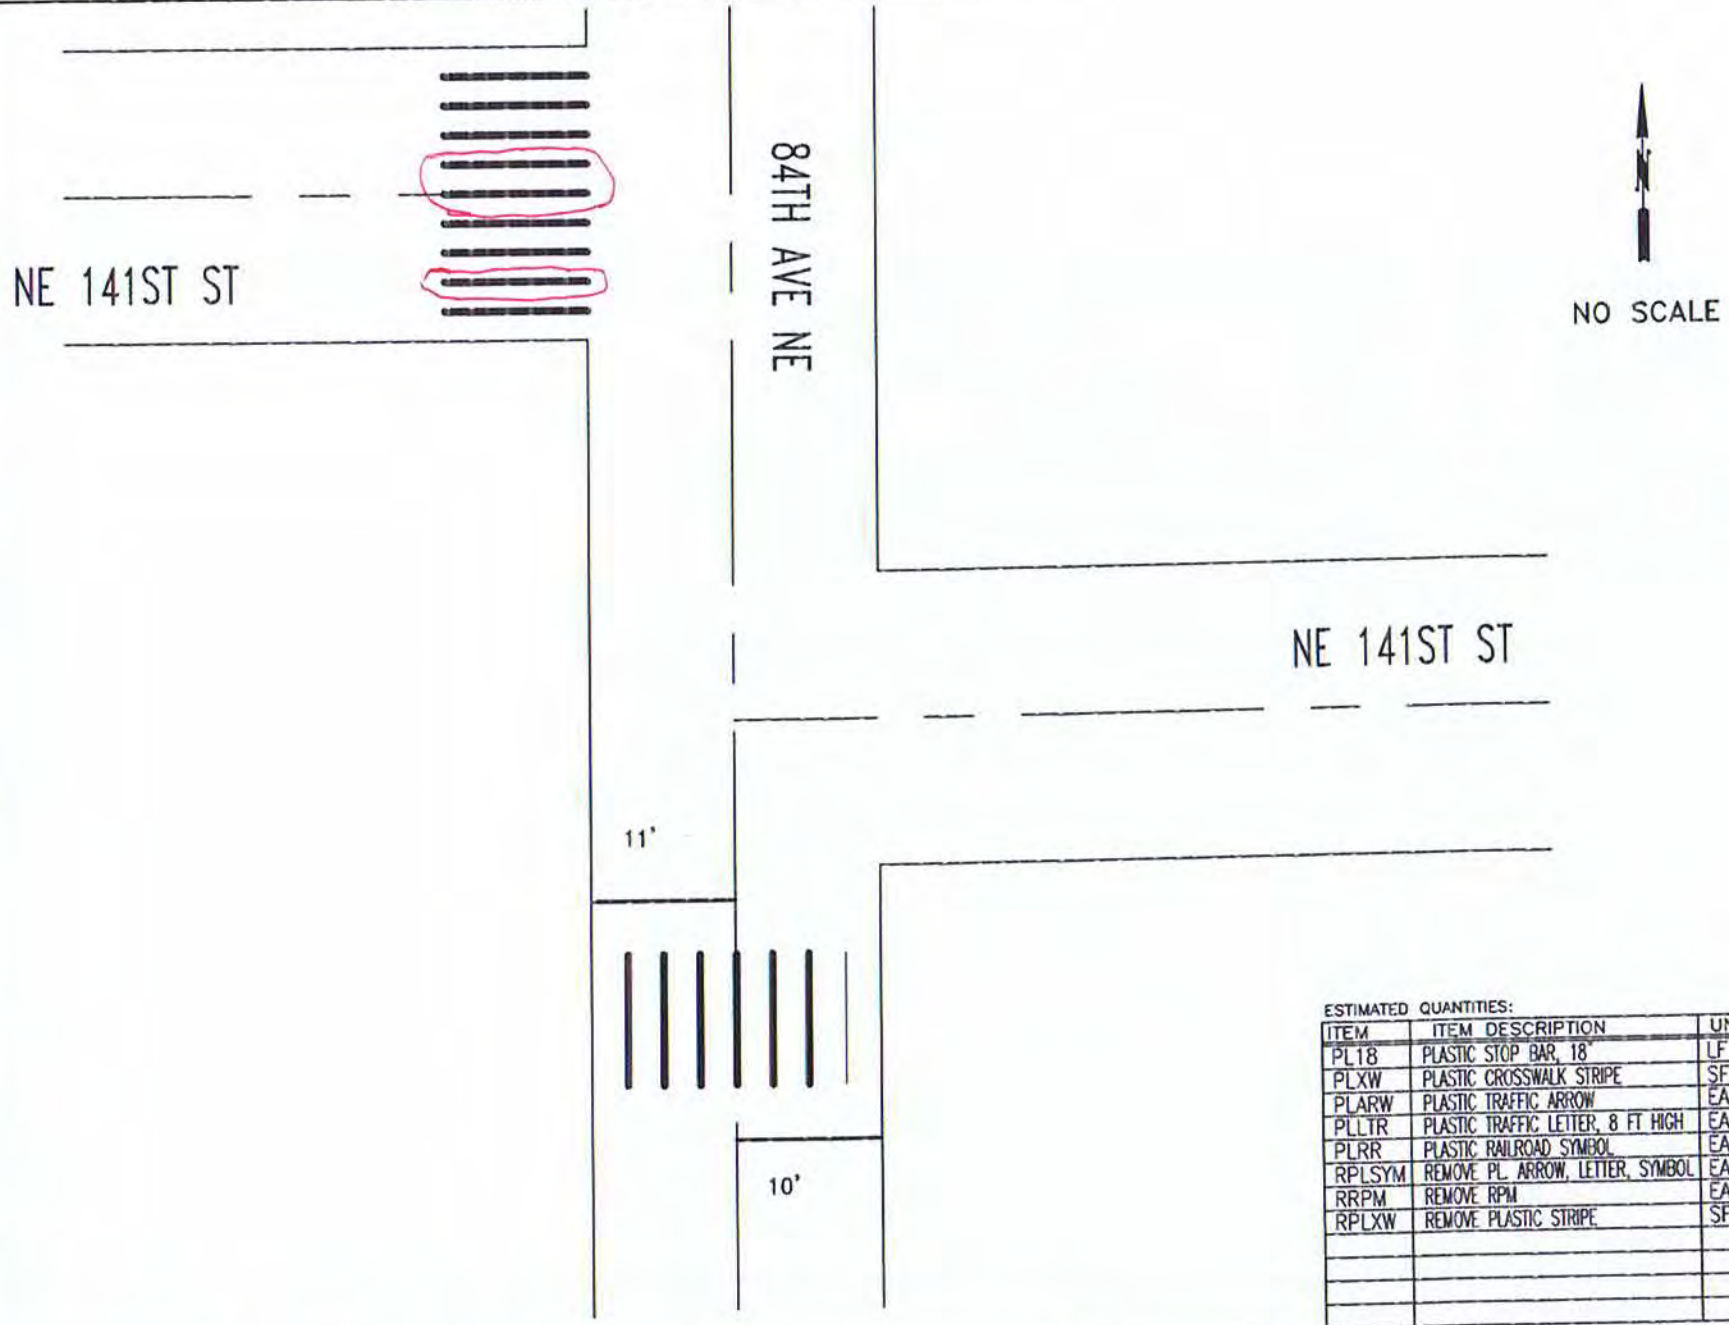

ESTIMATED QUANTITIES:

ITEM	ITEM DESCRIPTION	UNIT	INVENTORY	REPAIR QTY
PL18	PLASTIC STOP BAR, 18"	LF	21	
PLXW	PLASTIC CROSSWALK STRIPE	SF	410	60
PLARW	PLASTIC TRAFFIC ARROW	EA		
PLLTR	PLASTIC TRAFFIC LETTER, 8 FT HIGH	EA		
PLRR	PLASTIC RAILROAD SYMBOL	EA		
RPLSYM	REMOVE PL. ARROW, LETTER, SYMBOL	EA		
RRPM	REMOVE RPM	EA		
RPLXW	REMOVE PLASTIC STRIPE	SF		40

CITY OF KIRKLAND
DEPARTMENT OF PUBLIC WORKS
123 FIFTH AVENUE KIRKLAND, WA 98033
(425) 587-3800 www.kirklandwa.gov

A. KHANAL, PE 9/2014
DESIGNED BY: DATE

J.JENNINGS 9/2014
DRAWN BY: DATE

REVISED BY: DATE

2020 PAVEMENT MARKING PROGRAM

STREET: 84TH AVE NE

CROSS STREET: NE 141ST ST

SEGMENT:

SCALE: N.T.S.

FILENAME: Page 1-18

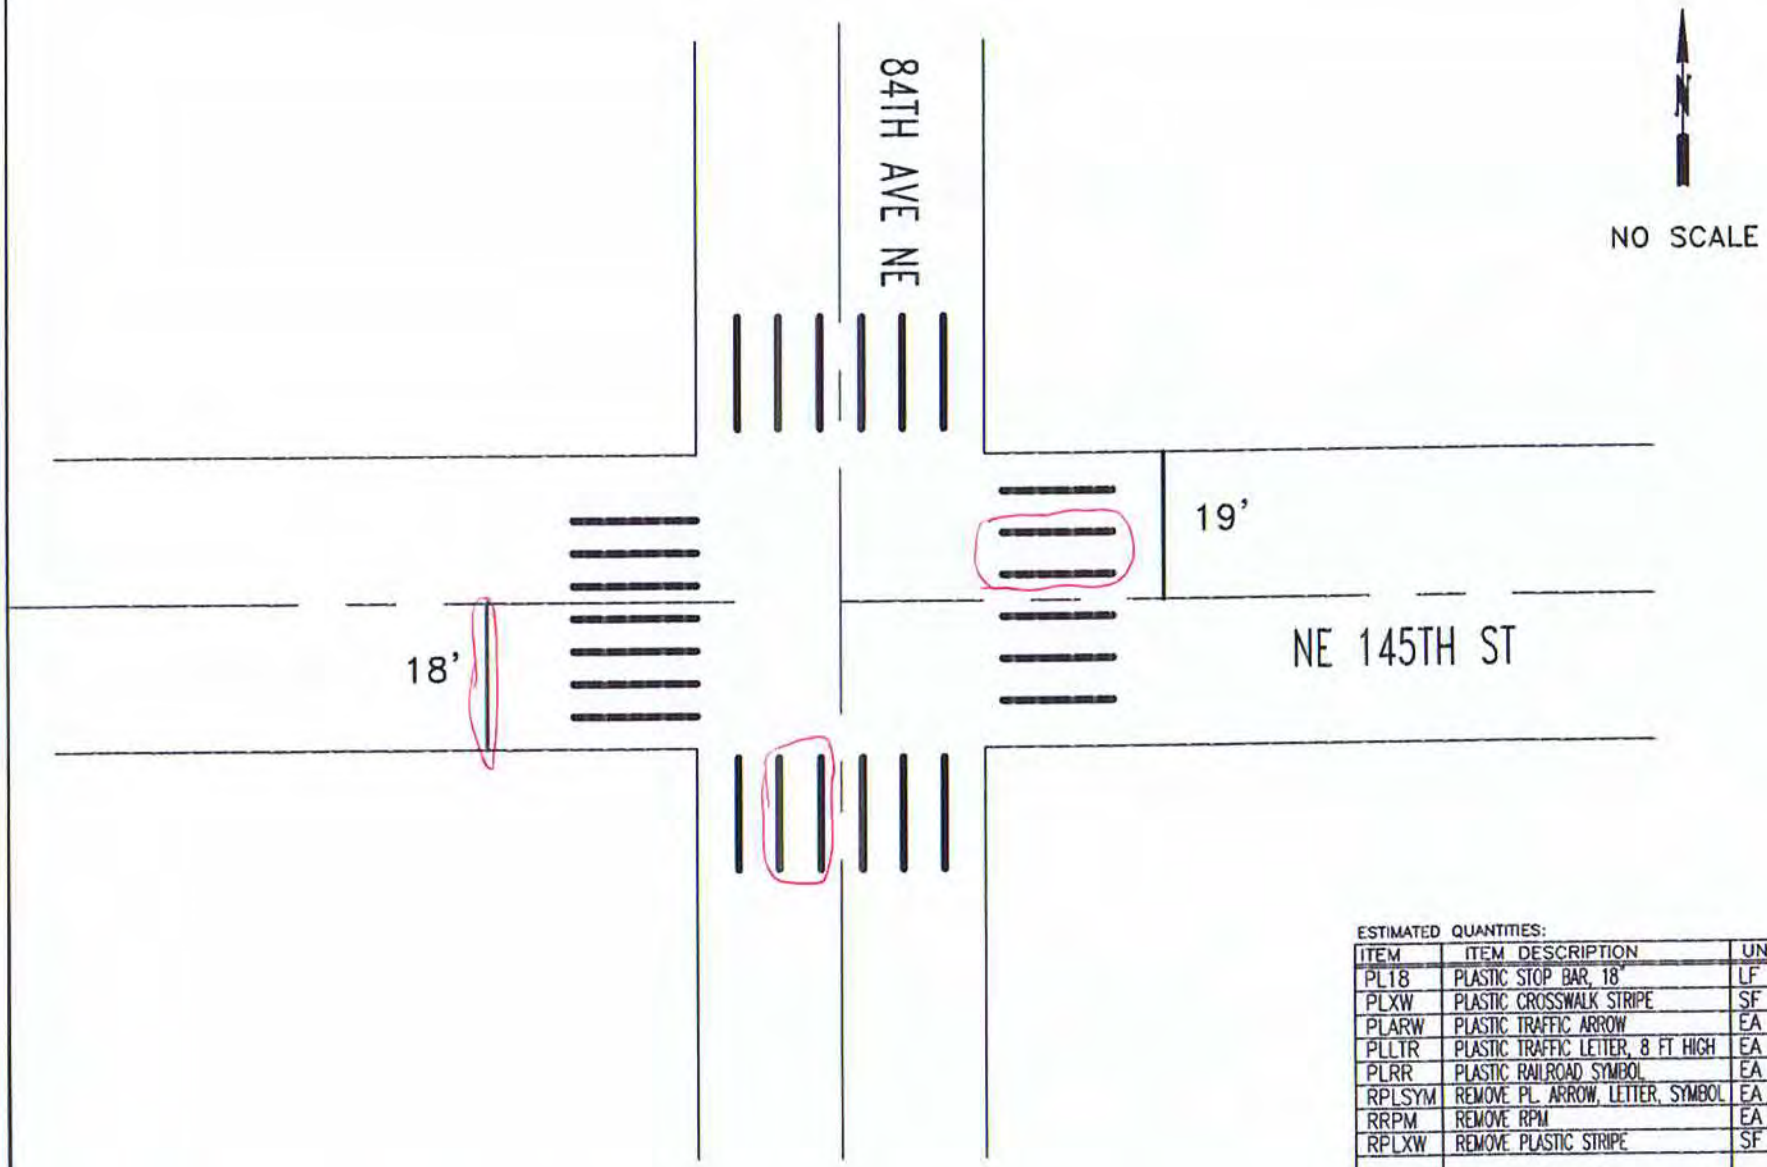

ESTIMATED QUANTITIES:

ITEM	ITEM DESCRIPTION	UNIT	INVENTORY	REPAIR QTY
PL18	PLASTIC STOP BAR, 18"	LF	37	18
PLXW	PLASTIC CROSSWALK STRIPE	SF	500	100
PLARW	PLASTIC TRAFFIC ARROW	EA		
PLLTR	PLASTIC TRAFFIC LETTER, 8 FT HIGH	EA		
PLRR	PLASTIC RAILROAD SYMBOL	EA		
RPLSYM	REMOVE PL. ARROW, LETTER, SYMBOL	EA		
RRPM	REMOVE RPM	EA		
RPLXW	REMOVE PLASTIC STRIPE	SF		80

CITY OF KIRKLAND WASHINGTON

CITY OF KIRKLAND
DEPARTMENT OF PUBLIC WORKS
123 FIFTH AVENUE KIRKLAND, WA 98033
(425) 587-3800 www.kirklandwa.gov

S. GONSAR 2/2018
DESIGNED BY: DATE

J.JENNINGS 2/2018
DRAWN BY: DATE

REVISED BY: DATE


STREET: 84TH AVE NE

CROSS STREET: NE 145TH ST

SEGMENT:

SCALE: N.T.S.

FILENAME: Page 1-19

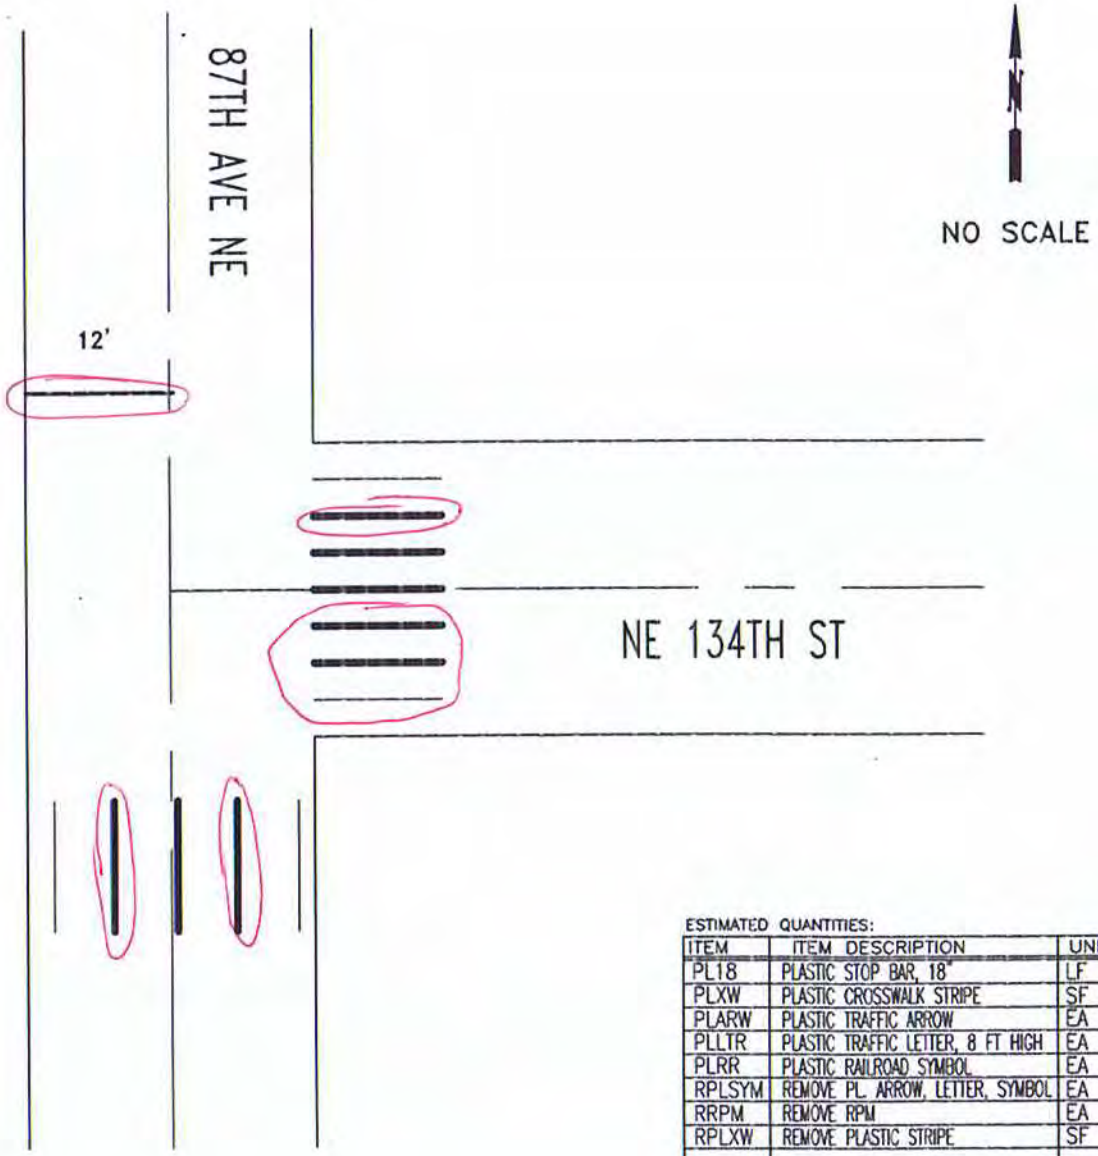

ESTIMATED QUANTITIES:

ITEM	ITEM DESCRIPTION	UNIT	INVENTORY	REPAIR QTY
PL18	PLASTIC STOP BAR, 18"	LF	12	12
PLXW	PLASTIC CROSSWALK STRIPE	SF	220	110
PLARW	PLASTIC TRAFFIC ARROW	EA		
PLLTR	PLASTIC TRAFFIC LETTER, 8 FT HIGH	EA		
PLRR	PLASTIC RAILROAD SYMBOL	EA		
RPLSYM	REMOVE PL. ARROW, LETTER, SYMBOL	EA		
RRPM	REMOVE RPM	EA		
RPLXW	REMOVE PLASTIC STRIPE	SF		70

CITY OF KIRKLAND
DEPARTMENT OF PUBLIC WORKS
123 FIFTH AVENUE KIRKLAND, WA 98033
(425) 587-3800 www.kirklandwa.gov

G. HORTILLOSA 10/2013
DESIGNED BY: DATE

J.JENNINGS 10/2013
DRAWN BY: DATE

REVISED BY: DATE

2020 PAVEMENT MARKING PROGRAM

STREET: 87TH AVE NE

CROSS STREET: NE 134TH ST

SEGMENT:

SCALE: N.T.S.

FILENAME: Page 1-20

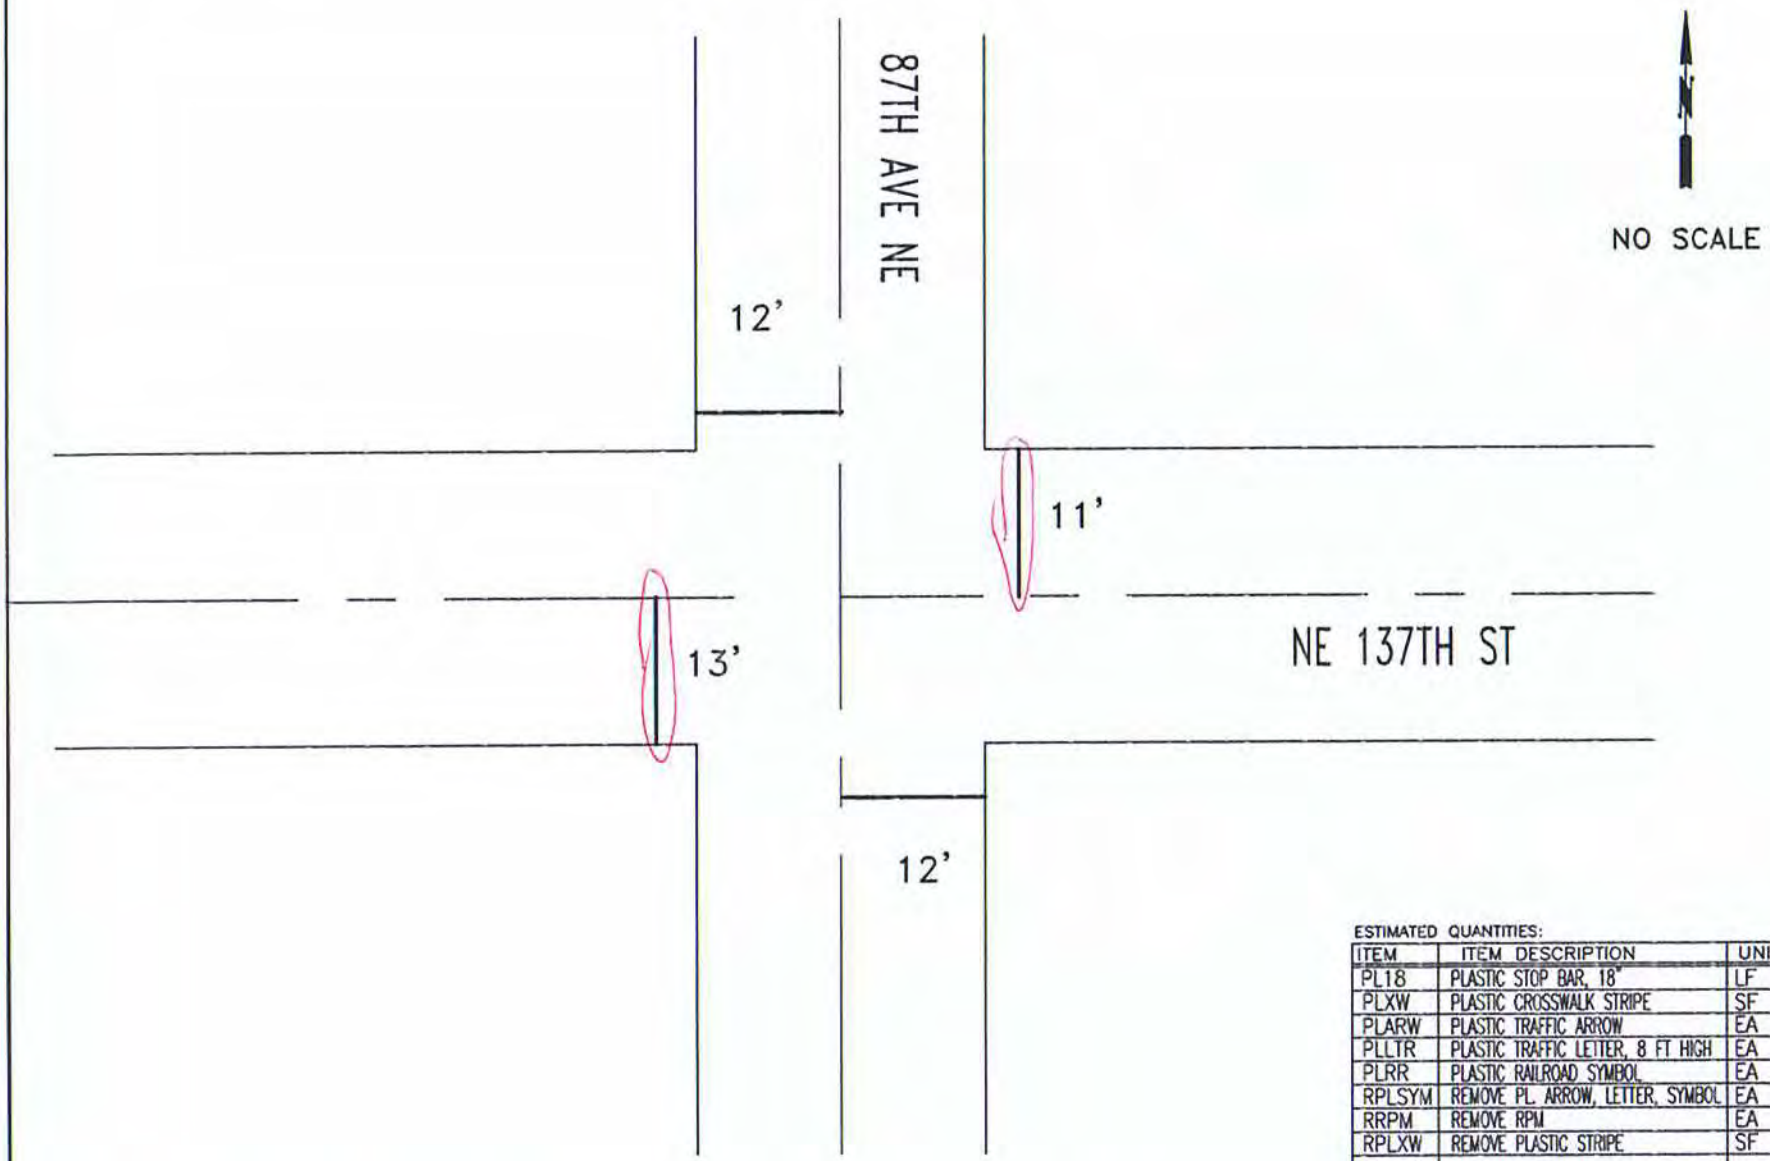

ESTIMATED QUANTITIES:

ITEM	ITEM DESCRIPTION	UNIT	INVENTORY	REPAIR QTY
PL18	PLASTIC STOP BAR, 18"	LF	48	24
PLXW	PLASTIC CROSSWALK STRIPE	SF		
PLARW	PLASTIC TRAFFIC ARROW	EA		
PLLTR	PLASTIC TRAFFIC LETTER, 8 FT HIGH	EA		
PLRR	PLASTIC RAILROAD SYMBOL	EA		
RPLSYM	REMOVE PL. ARROW, LETTER, SYMBOL	EA		
RRPM	REMOVE RPM	EA		
RPLXW	REMOVE PLASTIC STRIPE	SF		

CITY OF KIRKLAND
DEPARTMENT OF PUBLIC WORKS
123 FIFTH AVENUE KIRKLAND, WA 98033
(425) 587-3800 www.kirklandwa.gov

G. HORTILLOSA 10/2013
DESIGNED BY: DATE

J.JENNINGS 10/2013
DRAWN BY: DATE

REVISED BY: DATE

2020 PAVEMENT MARKING PROGRAM

STREET: 87TH AVE NE

CROSS STREET: NE 137TH ST

SEGMENT:

SCALE: N.T.S.

FILENAME: Page 1-21

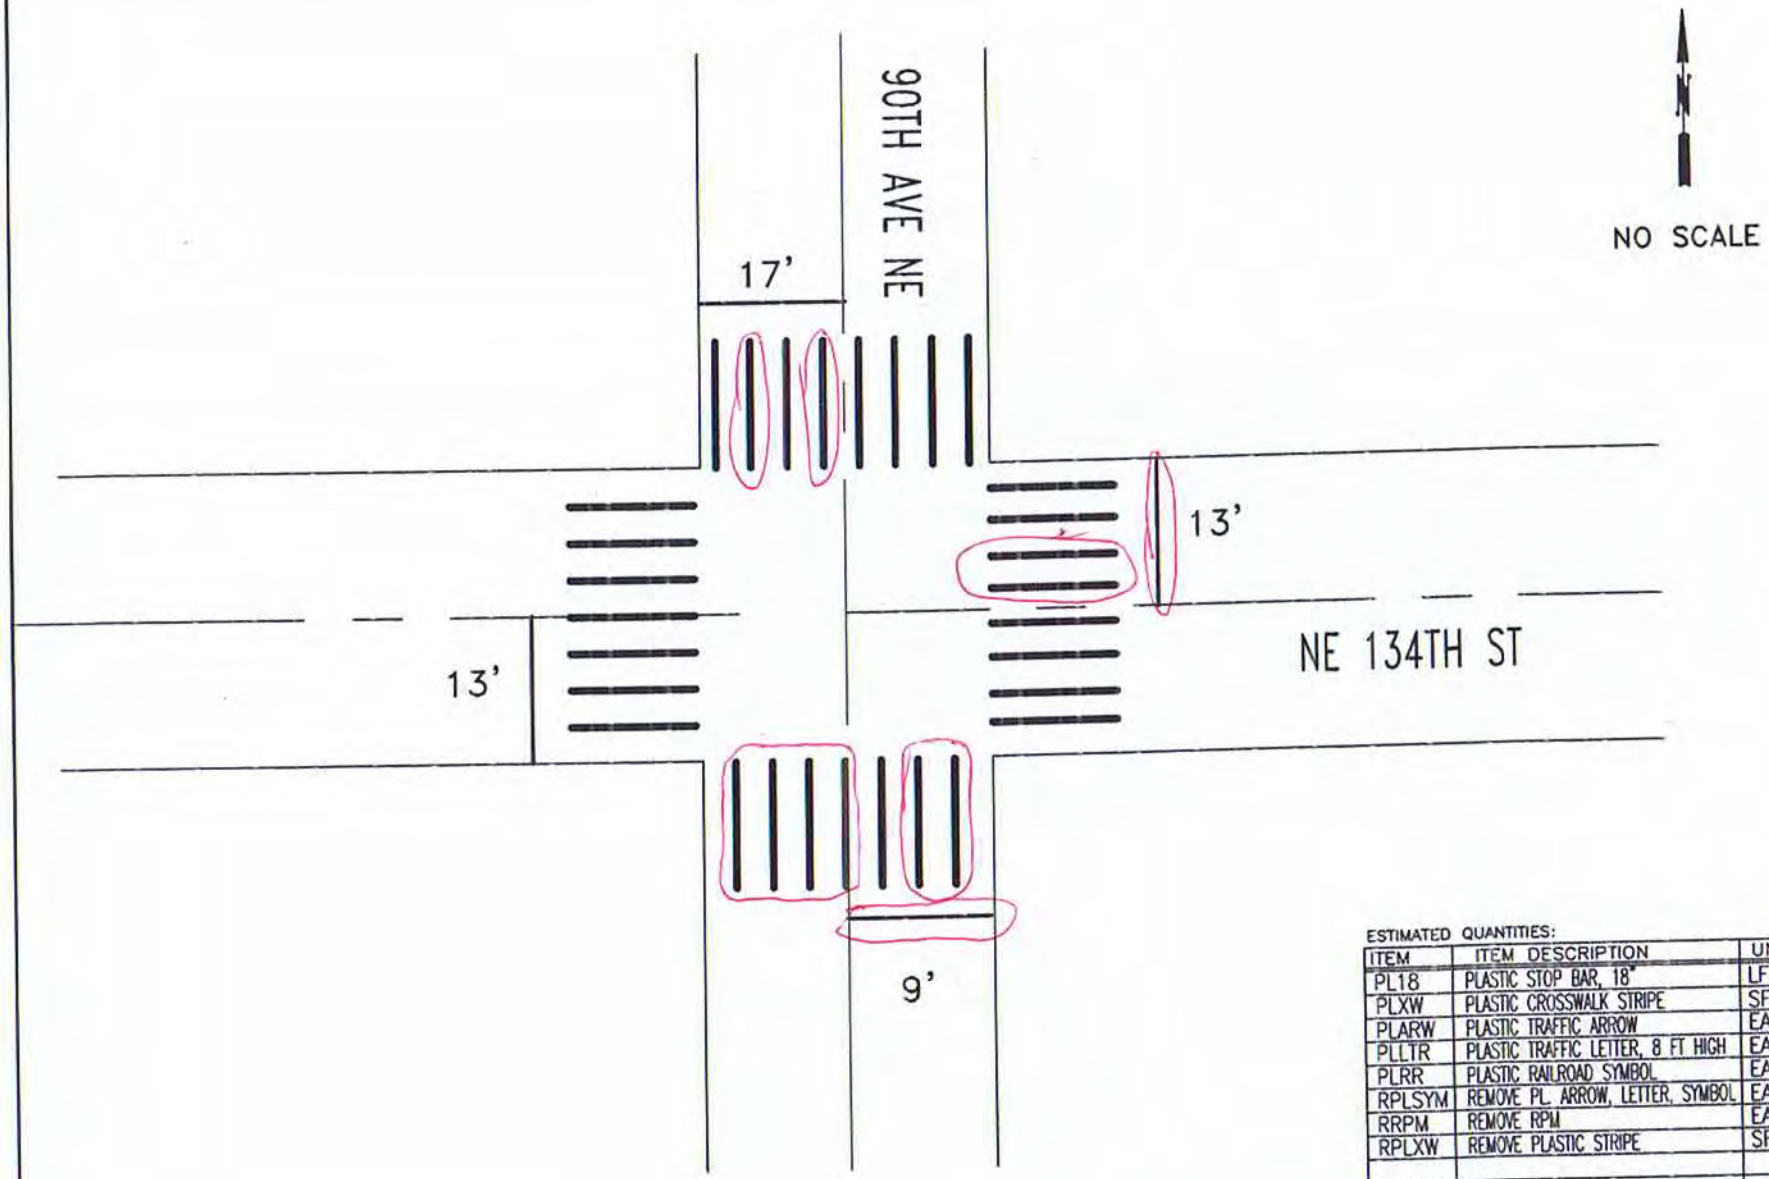

ESTIMATED QUANTITIES:

ITEM	ITEM DESCRIPTION	UNIT	INVENTORY	REPAIR QTY
PL18	PLASTIC STOP BAR, 18"	LF	89	61
PLXW	PLASTIC CROSSWALK STRIPE	SF	590	200
PLARW	PLASTIC TRAFFIC ARROW	EA		
PLLTR	PLASTIC TRAFFIC LETTER, 8 FT HIGH	EA		
PLRR	PLASTIC RAILROAD SYMBOL	EA		
RPLSYM	REMOVE PL. ARROW, LETTER, SYMBOL	EA		
RRPM	REMOVE RPM	EA		
RPLXW	REMOVE PLASTIC STRIPE	SF		120

CITY OF KIRKLAND
DEPARTMENT OF PUBLIC WORKS
123 FIFTH AVENUE KIRKLAND, WA 98033
(425) 587-3800 www.kirklandwa.gov

A. KHANAL,PE 9/2014
DESIGNED BY: DATE

J.JENNINGS 9/2014
DRAWN BY: DATE

REVISED BY: DATE

2020 PAVEMENT MARKING PROGRAM

STREET: 90TH AVE NE

CROSS STREET: NE 134TH ST

SEGMENT:

SCALE: N.T.S.

FILENAME: Page 1-22

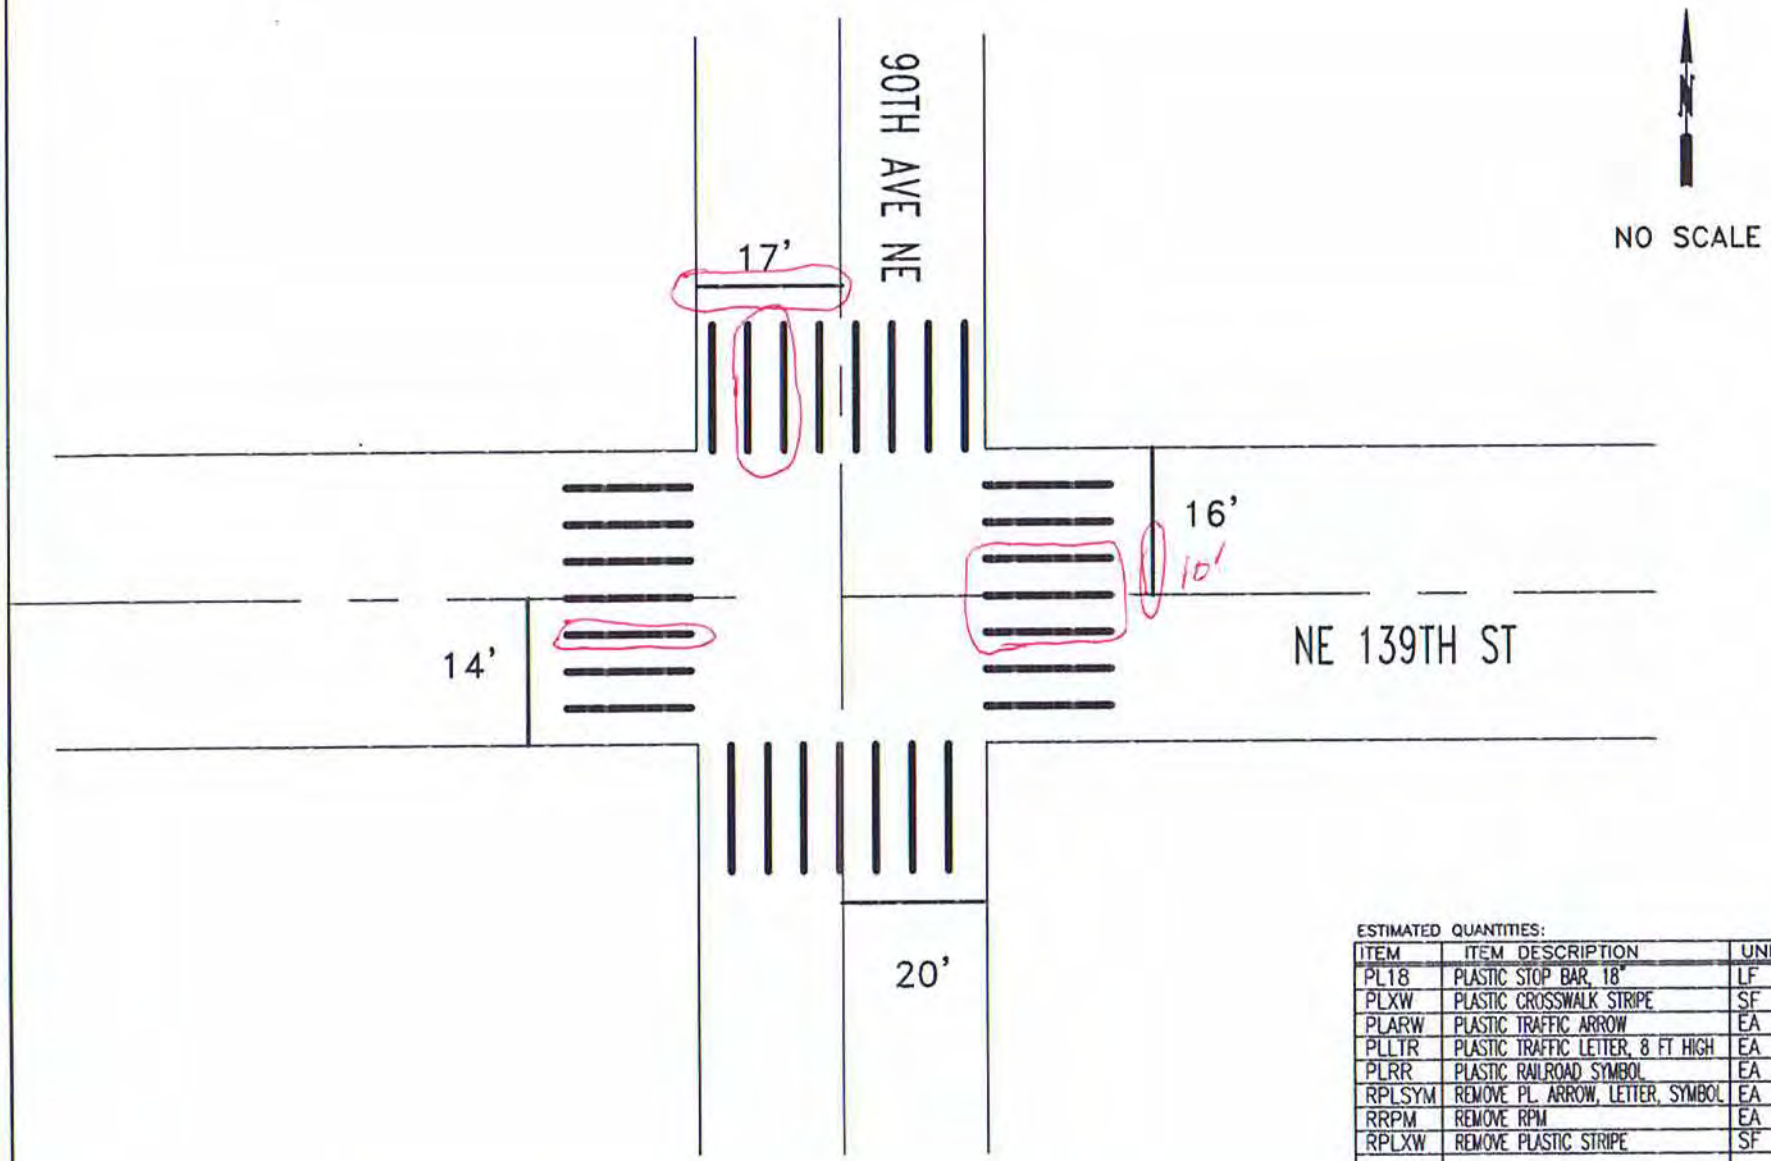

ESTIMATED QUANTITIES:

ITEM	ITEM DESCRIPTION	UNIT	INVENTORY	REPAIR QTY
PL18	PLASTIC STOP BAR, 18"	LF	67	33
PLXW	PLASTIC CROSSWALK STRIPE	SF	580	128
PLARW	PLASTIC TRAFFIC ARROW	EA		
PLLTR	PLASTIC TRAFFIC LETTER, 8 FT HIGH	EA		
PLRR	PLASTIC RAILROAD SYMBOL	EA		
RPLSYM	REMOVE PL. ARROW, LETTER, SYMBOL	EA		
RRPM	REMOVE RPM	EA		
RPLXW	REMOVE PLASTIC STRIPE	SF		40

CITY OF KIRKLAND
DEPARTMENT OF PUBLIC WORKS
123 FIFTH AVENUE KIRKLAND, WA 98033
(425) 587-3800 www.kirklandwa.gov

A. KHANAL,PE 9/2014
DESIGNED BY: DATE

J.JENNINGS 9/2014
DRAWN BY: DATE

REVISED BY: DATE

20__ PAVEMENT MARKING PROGRAM

STREET: 90TH AVE NE

CROSS STREET: NE 139TH ST

SEGMENT:

SCALE: N.T.S.

FILENAME:

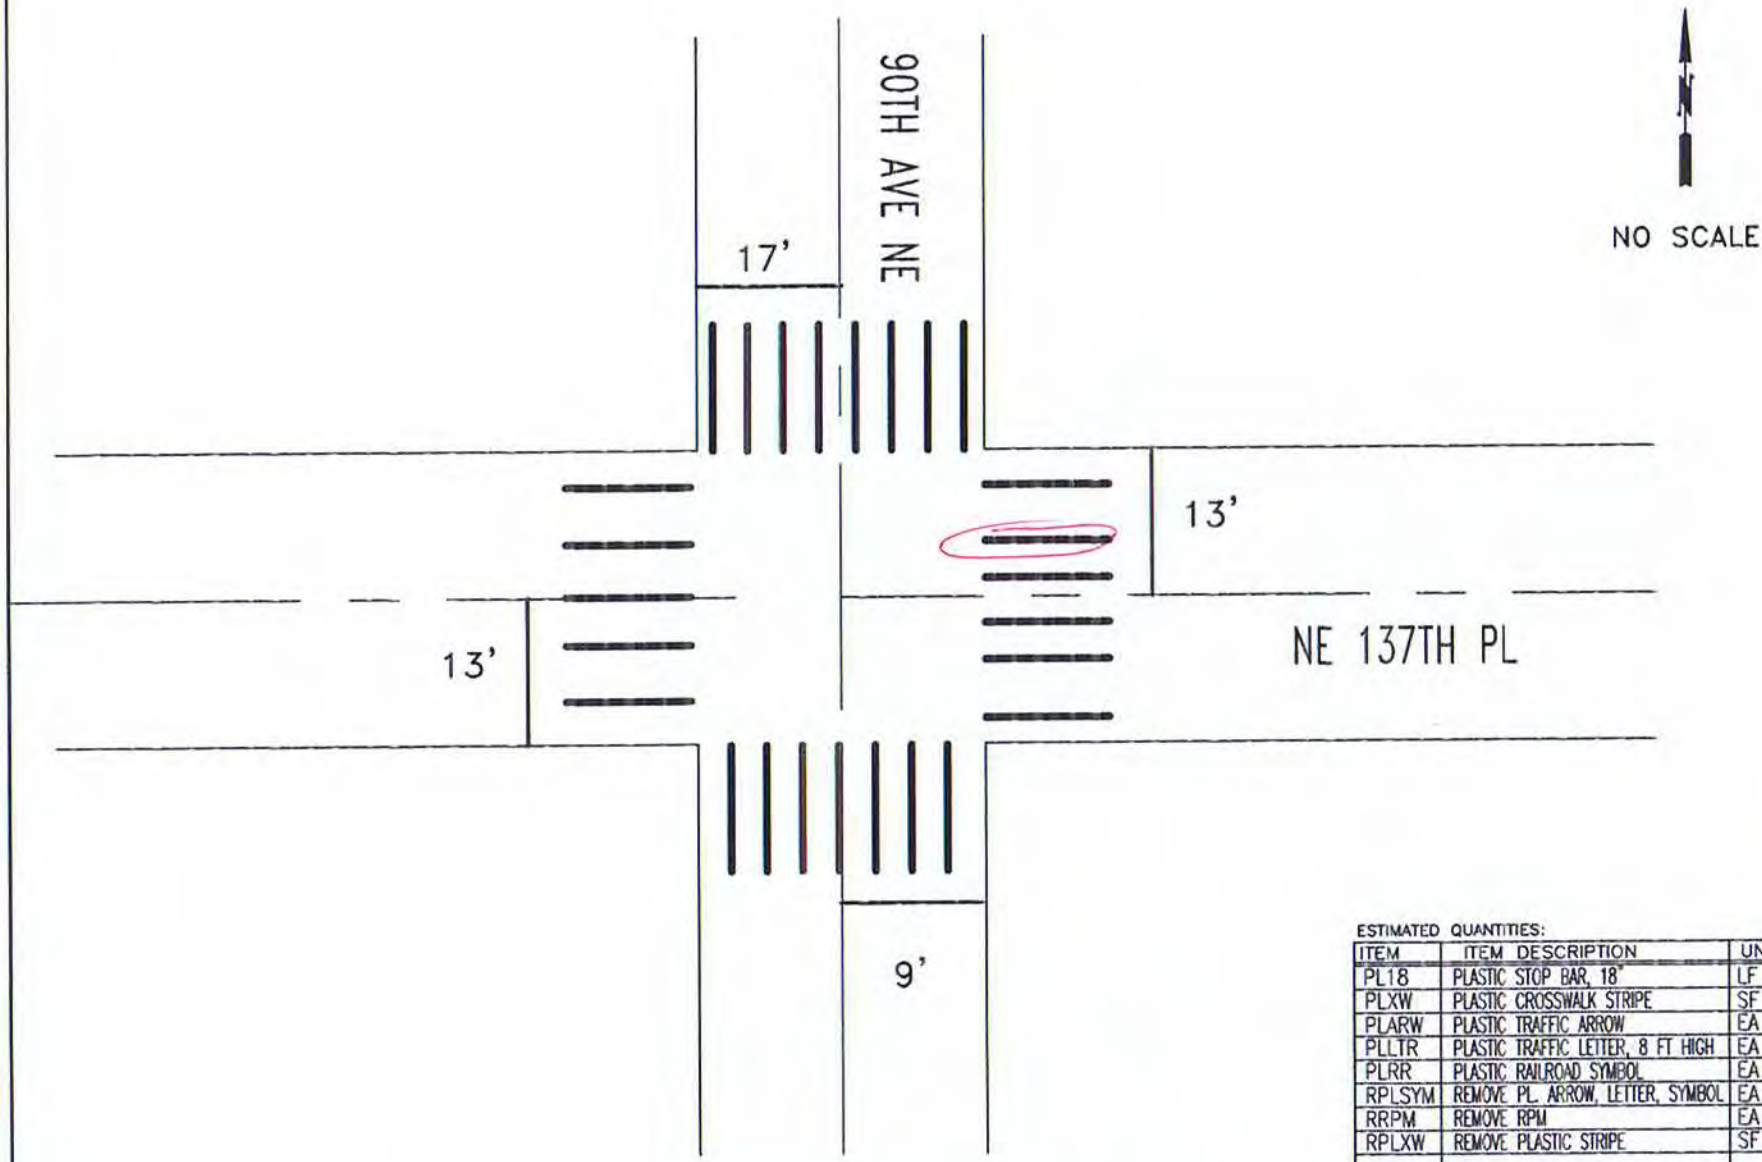

ESTIMATED QUANTITIES:

ITEM	ITEM DESCRIPTION	UNIT	INVENTORY	REPAIR QTY
PL18	PLASTIC STOP BAR, 18"	LF	66	
PLXW	PLASTIC CROSSWALK STRIPE	SF	500	30
PLARW	PLASTIC TRAFFIC ARROW	EA		
PLLTR	PLASTIC TRAFFIC LETTER, 8 FT HIGH	EA		
PLRR	PLASTIC RAILROAD SYMBOL	EA		
RPLSYM	REMOVE PL. ARROW, LETTER, SYMBOL	EA		
RRPM	REMOVE RPM	EA		
RPLXW	REMOVE PLASTIC STRIPE	SF		30

CITY OF KIRKLAND
DEPARTMENT OF PUBLIC WORKS
123 FIFTH AVENUE KIRKLAND, WA 98033
(425) 587-3800 www.kirklandwa.gov

A. KHANAL,PE 9/2014
DESIGNED BY: DATE

J.JENNINGS 9/2014
DRAWN BY: DATE

REVISED BY: DATE

2020 PAVEMENT MARKING PROGRAM

STREET: 90TH AVE NE

CROSS STREET: NE 137TH PL

SEGMENT:

SCALE: N.T.S.

FILENAME:

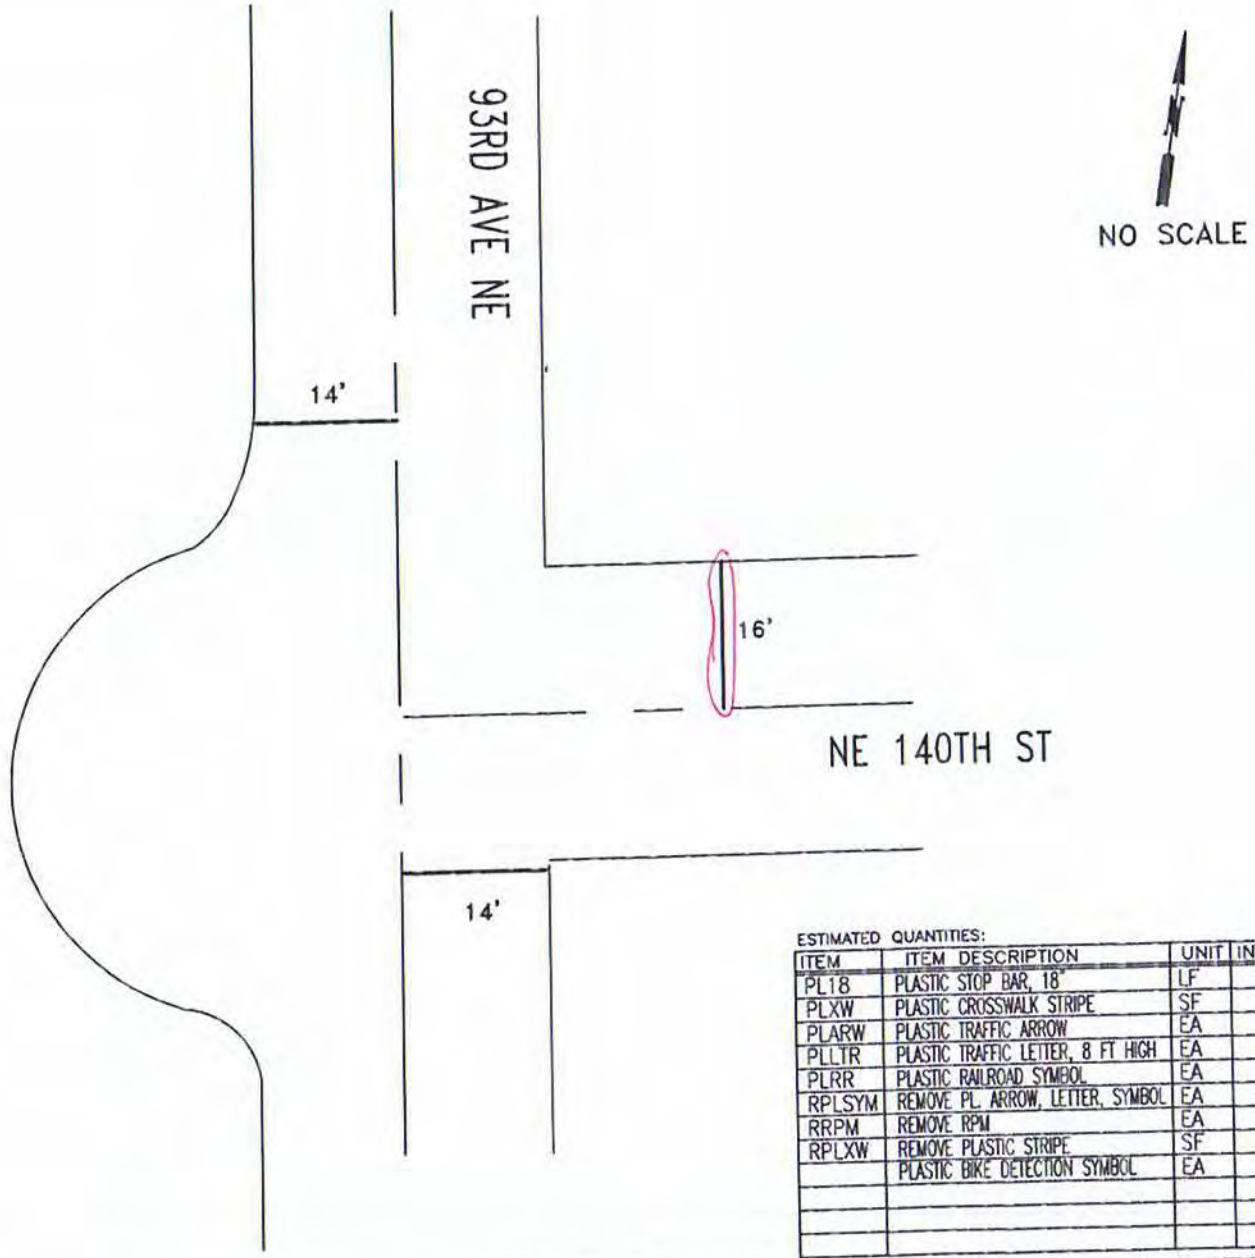

ESTIMATED QUANTITIES:

ITEM	ITEM DESCRIPTION	UNIT	INVENTORY	REPAIR QTY
PL18	PLASTIC STOP BAR, 18"	LF	44	16
PLXW	PLASTIC CROSSWALK STRIPE	SF		
PLARW	PLASTIC TRAFFIC ARROW	EA		
PLLTR	PLASTIC TRAFFIC LETTER, 8 FT HIGH	EA		
PLRR	PLASTIC RAILROAD SYMBOL	EA		
RPLSYM	REMOVE PL. ARROW, LETTER, SYMBOL	EA		
RRPM	REMOVE RPM	EA		
RPLXW	REMOVE PLASTIC STRIPE	SF		
	PLASTIC BIKE DETECTION SYMBOL	EA		

CITY OF KIRKLAND
DEPARTMENT OF PUBLIC WORKS
123 FIFTH AVENUE KIRKLAND, WA 98033
(425) 587-3800 www.kirklandwa.gov

S CONSAR/J JENNINGS 4/2018
DESIGNED BY: DATE

J.JENNINGS 4/2018
DRAWN BY: DATE

CHECKED BY: DATE

2020 PAVEMENT MARKING PROGRAM

STREET: 93RD AVE NE

CROSS STREET: NE 140TH ST

SEGMENT:

SCALE: N.T.S.

SHEET: PAGE 1-25A

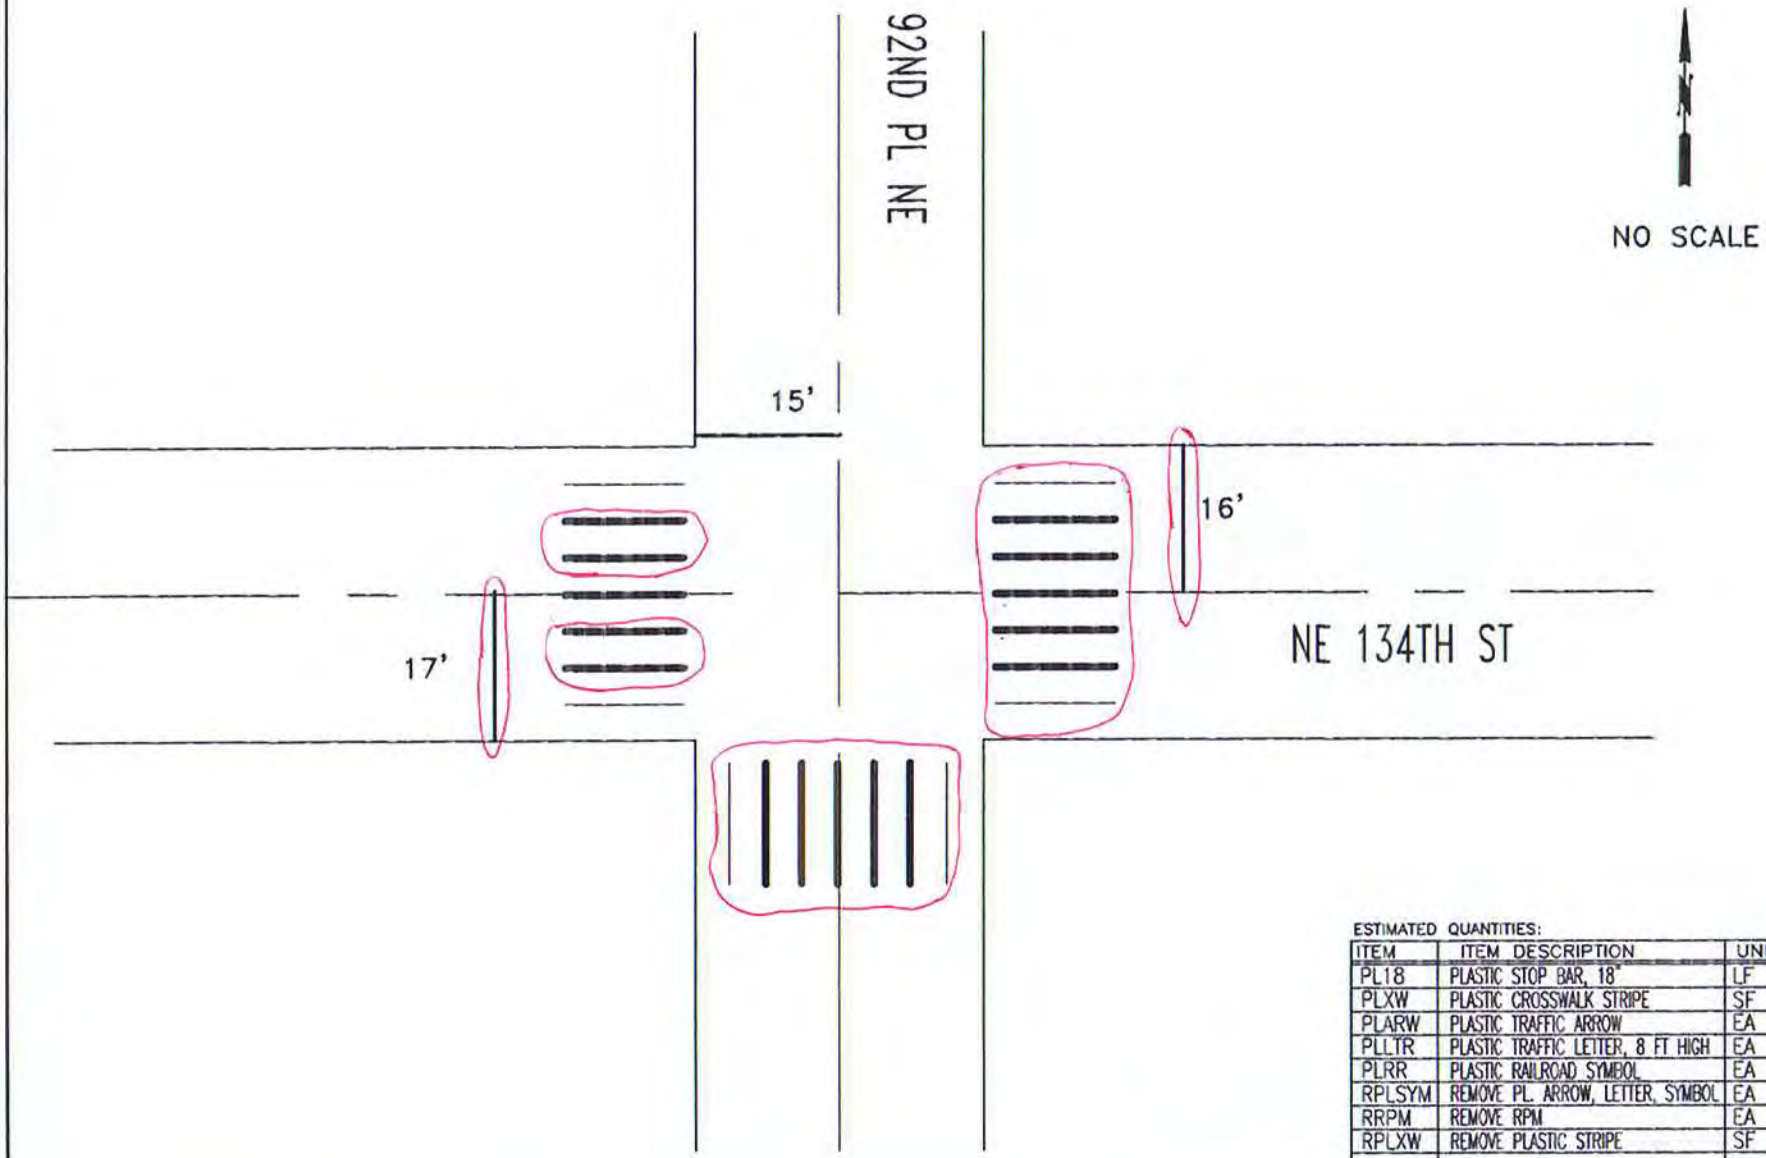

ESTIMATED QUANTITIES:

ITEM	ITEM DESCRIPTION	UNIT	INVENTORY	REPAIR QTY
PL18	PLASTIC STOP BAR, 18"	LF	48	33
PLXW	PLASTIC CROSSWALK STRIPE	SF	360	330
PLARW	PLASTIC TRAFFIC ARROW	EA		
PLLTR	PLASTIC TRAFFIC LETTER, 8 FT HIGH	EA		
PLRR	PLASTIC RAILROAD SYMBOL	EA		
RPLSYM	REMOVE PL. ARROW, LETTER, SYMBOL	EA		
RRPM	REMOVE RPM	EA		
RPLXW	REMOVE PLASTIC STRIPE	SF		740

CITY OF KIRKLAND
DEPARTMENT OF PUBLIC WORKS
123 FIFTH AVENUE KIRKLAND, WA 98033
(425) 587-3800 www.kirklandwa.gov

G. HORTILLOSA 10/2013
DESIGNED BY: DATE

J.JENNINGS 10/2013
DRAWN BY: DATE

REVISED BY: DATE

2022 PAVEMENT MARKING PROGRAM

STREET: 92ND PL NE

CROSS STREET: NE 134TH ST

SEGMENT:

SCALE: N.T.S.

FILENAME: Page 1-28

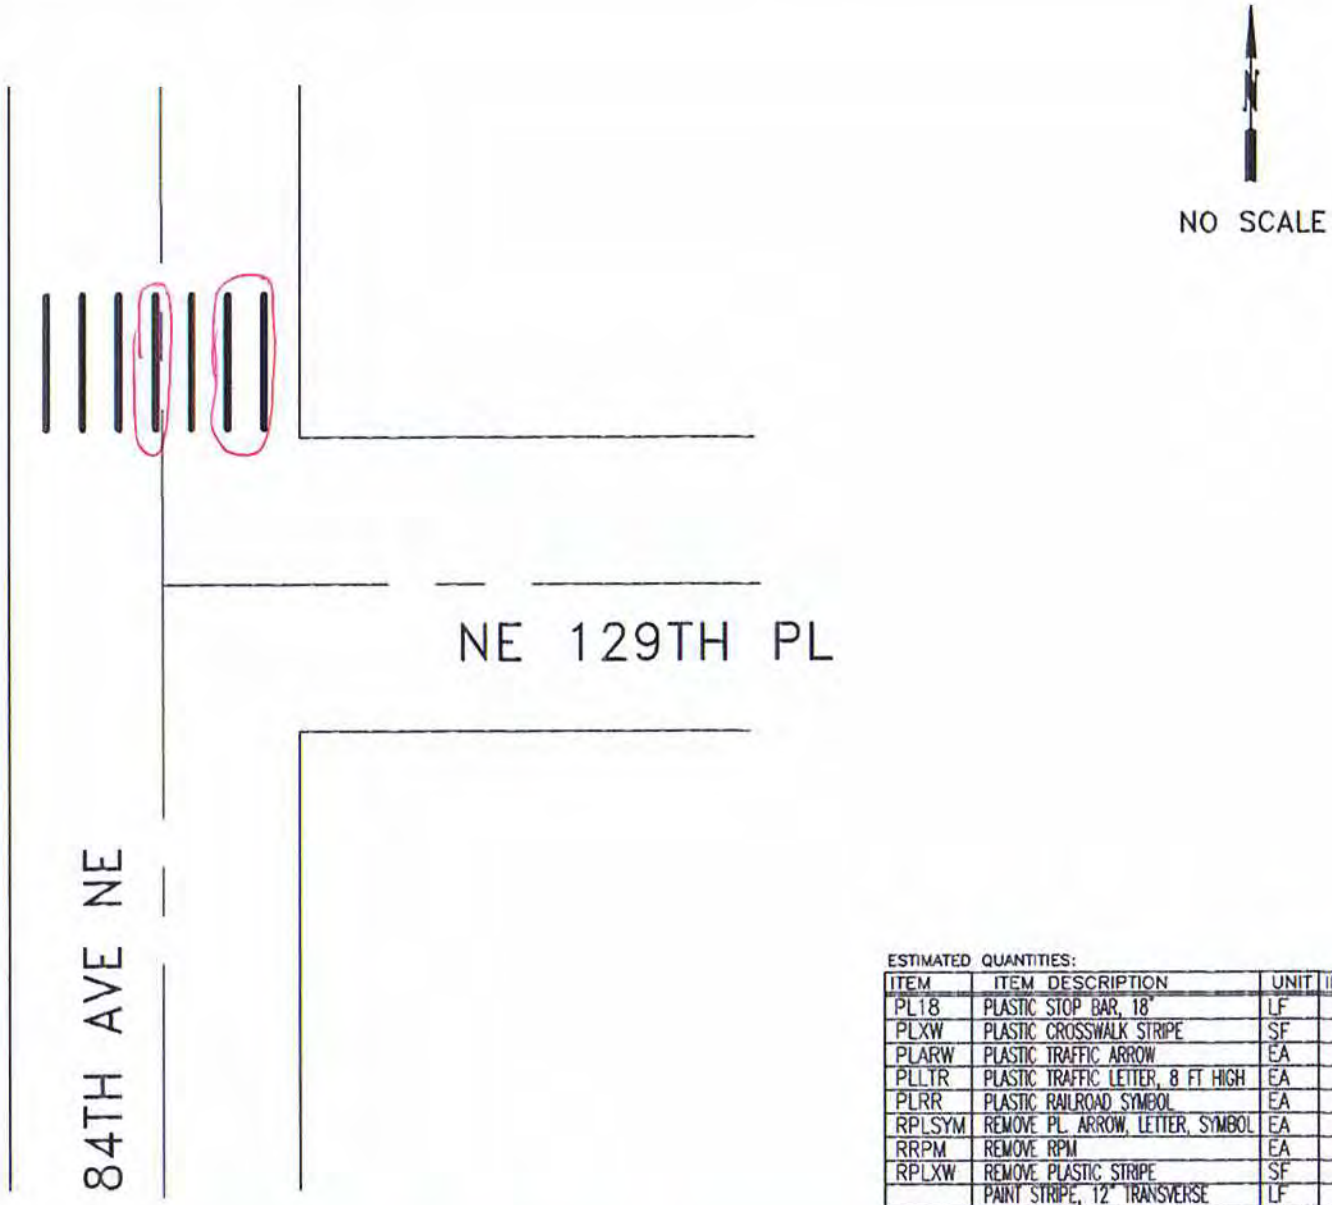

ESTIMATED QUANTITIES:

ITEM	ITEM DESCRIPTION	UNIT	INVENTORY	REPAIR QTY
PL18	PLASTIC STOP BAR, 18"	LF		
PLXW	PLASTIC CROSSWALK STRIPE	SF	140	60
PLARW	PLASTIC TRAFFIC ARROW	EA		
PLLTR	PLASTIC TRAFFIC LETTER, 8 FT HIGH	EA		
PLRR	PLASTIC RAILROAD SYMBOL	EA		
RPLSYM	REMOVE PL. ARROW, LETTER, SYMBOL	EA		
RRPM	REMOVE RPM	EA		
RPLXW	REMOVE PLASTIC STRIPE	SF		60
	PAINT STRIPE, 12" TRANSVERSE	LF		
	PAINTED TRAFFIC LETTER, 8'	EA		

CITY OF KIRKLAND
DEPARTMENT OF PUBLIC WORKS
123 FIFTH AVENUE KIRKLAND, WA 98033
(425) 587-3800 www.kirklandwa.gov

P. HERBIG 4/2014
DESIGNED BY: DATE

J.JENNINGS 4/2014
DRAWN BY: DATE

CHECKED BY: DATE

2020 PAVEMENT MARKING PROGRAM

STREET: 84TH AVE NE

CROSS STREET: NE 129TH PL

SEGMENT:

SCALE: N.T.S.

FILENAME: Page 1-29

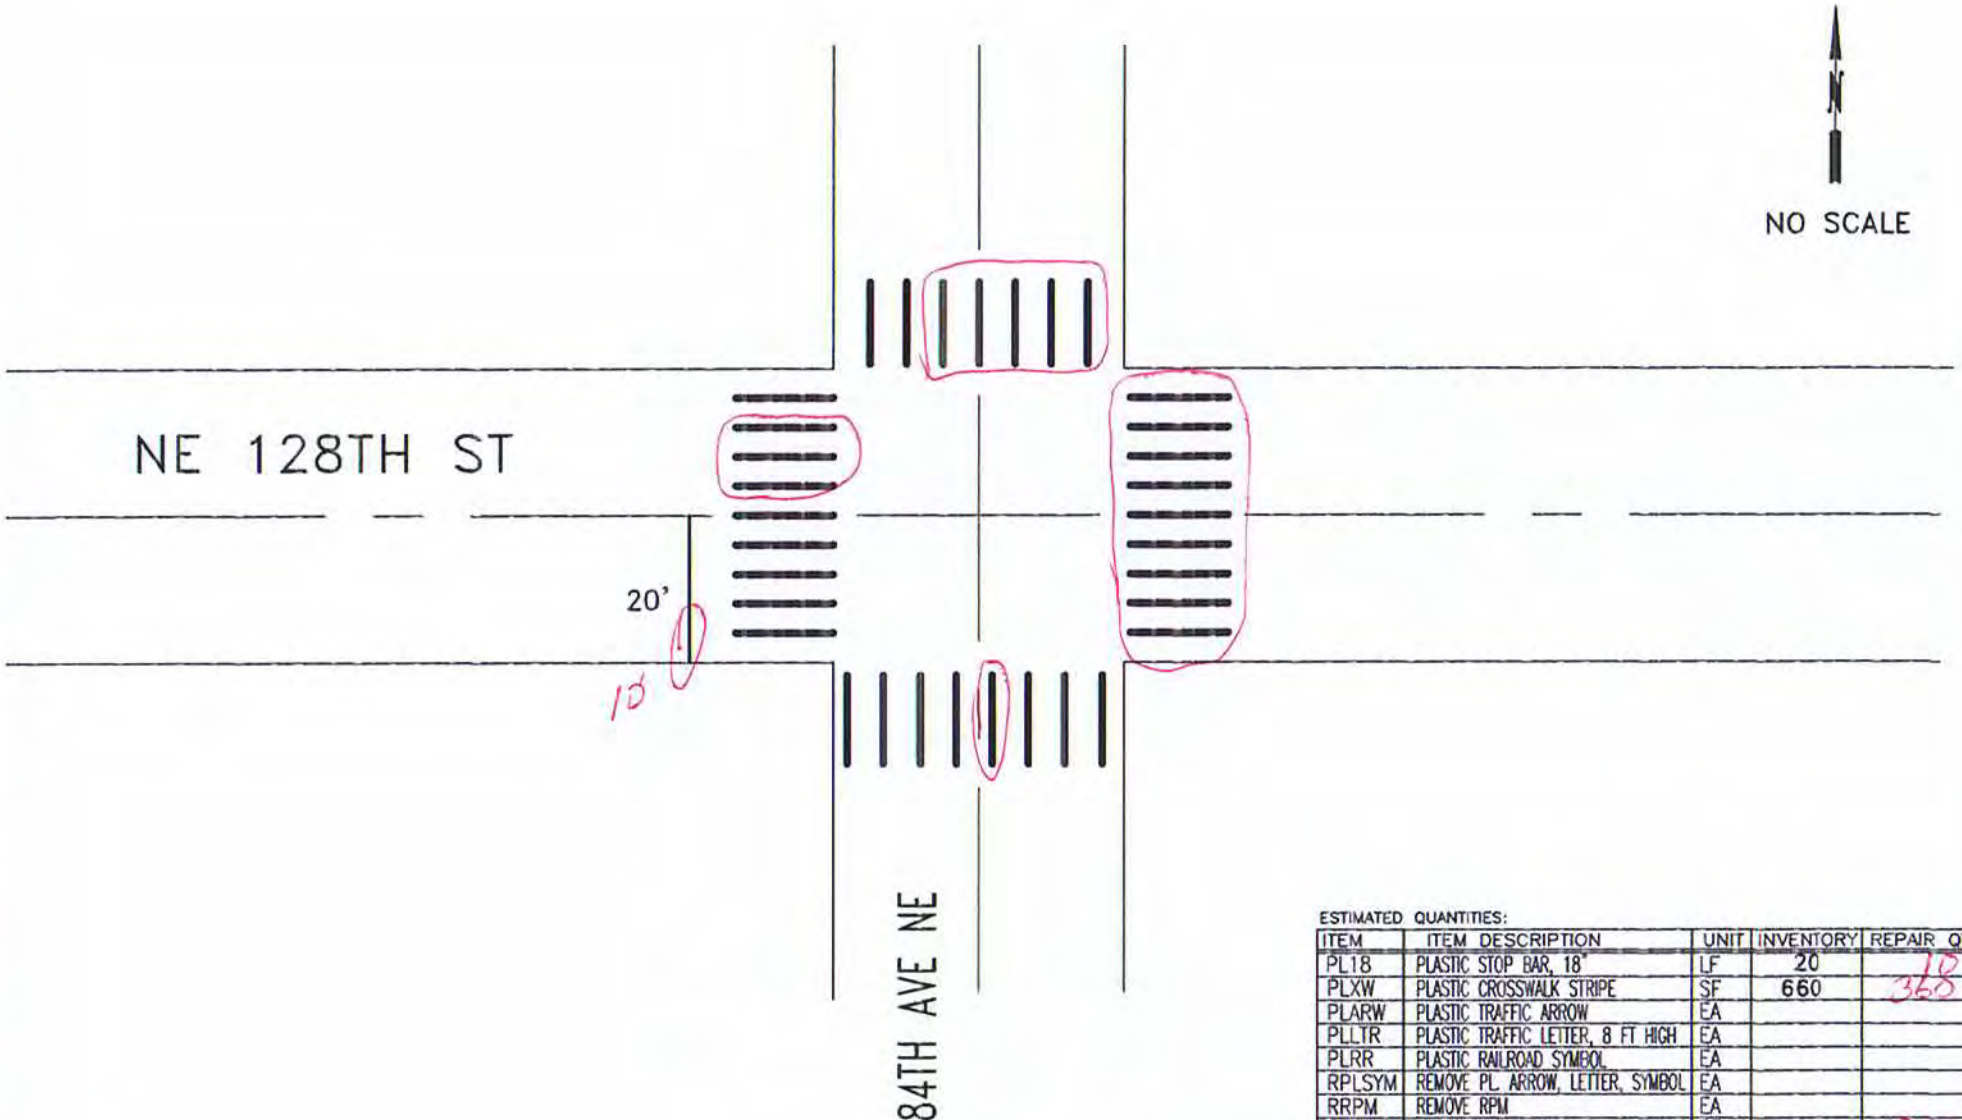

ESTIMATED QUANTITIES:

ITEM	ITEM DESCRIPTION	UNIT	INVENTORY	REPAIR QTY
PL18	PLASTIC STOP BAR, 18"	LF	20	18
PLXW	PLASTIC CROSSWALK STRIPE	SF	660	368
PLARW	PLASTIC TRAFFIC ARROW	EA		
PLLTR	PLASTIC TRAFFIC LETTER, 8 FT HIGH	EA		
PLRR	PLASTIC RAILROAD SYMBOL	EA		
RPLSYM	REMOVE PL ARROW, LETTER, SYMBOL	EA		
RRPM	REMOVE RPM	EA		
RPLXW	REMOVE PLASTIC STRIPE	SF		80

CITY OF KIRKLAND
DEPARTMENT OF PUBLIC WORKS
123 FIFTH AVENUE KIRKLAND, WA 98033
(425) 587-3800 www.kirklandwa.gov

P. HERBIG 4/2014
DESIGNED BY: DATE

J.JENNINGS 4/2014
DRAWN BY: DATE

CHECKED BY: DATE

2020 PAVEMENT MARKING PROGRAM

STREET: 84TH AVE NE

CROSS STREET: NE 128TH STREET

SEGMENT:

SCALE: N.T.S.

FILENAME: Page 1-30

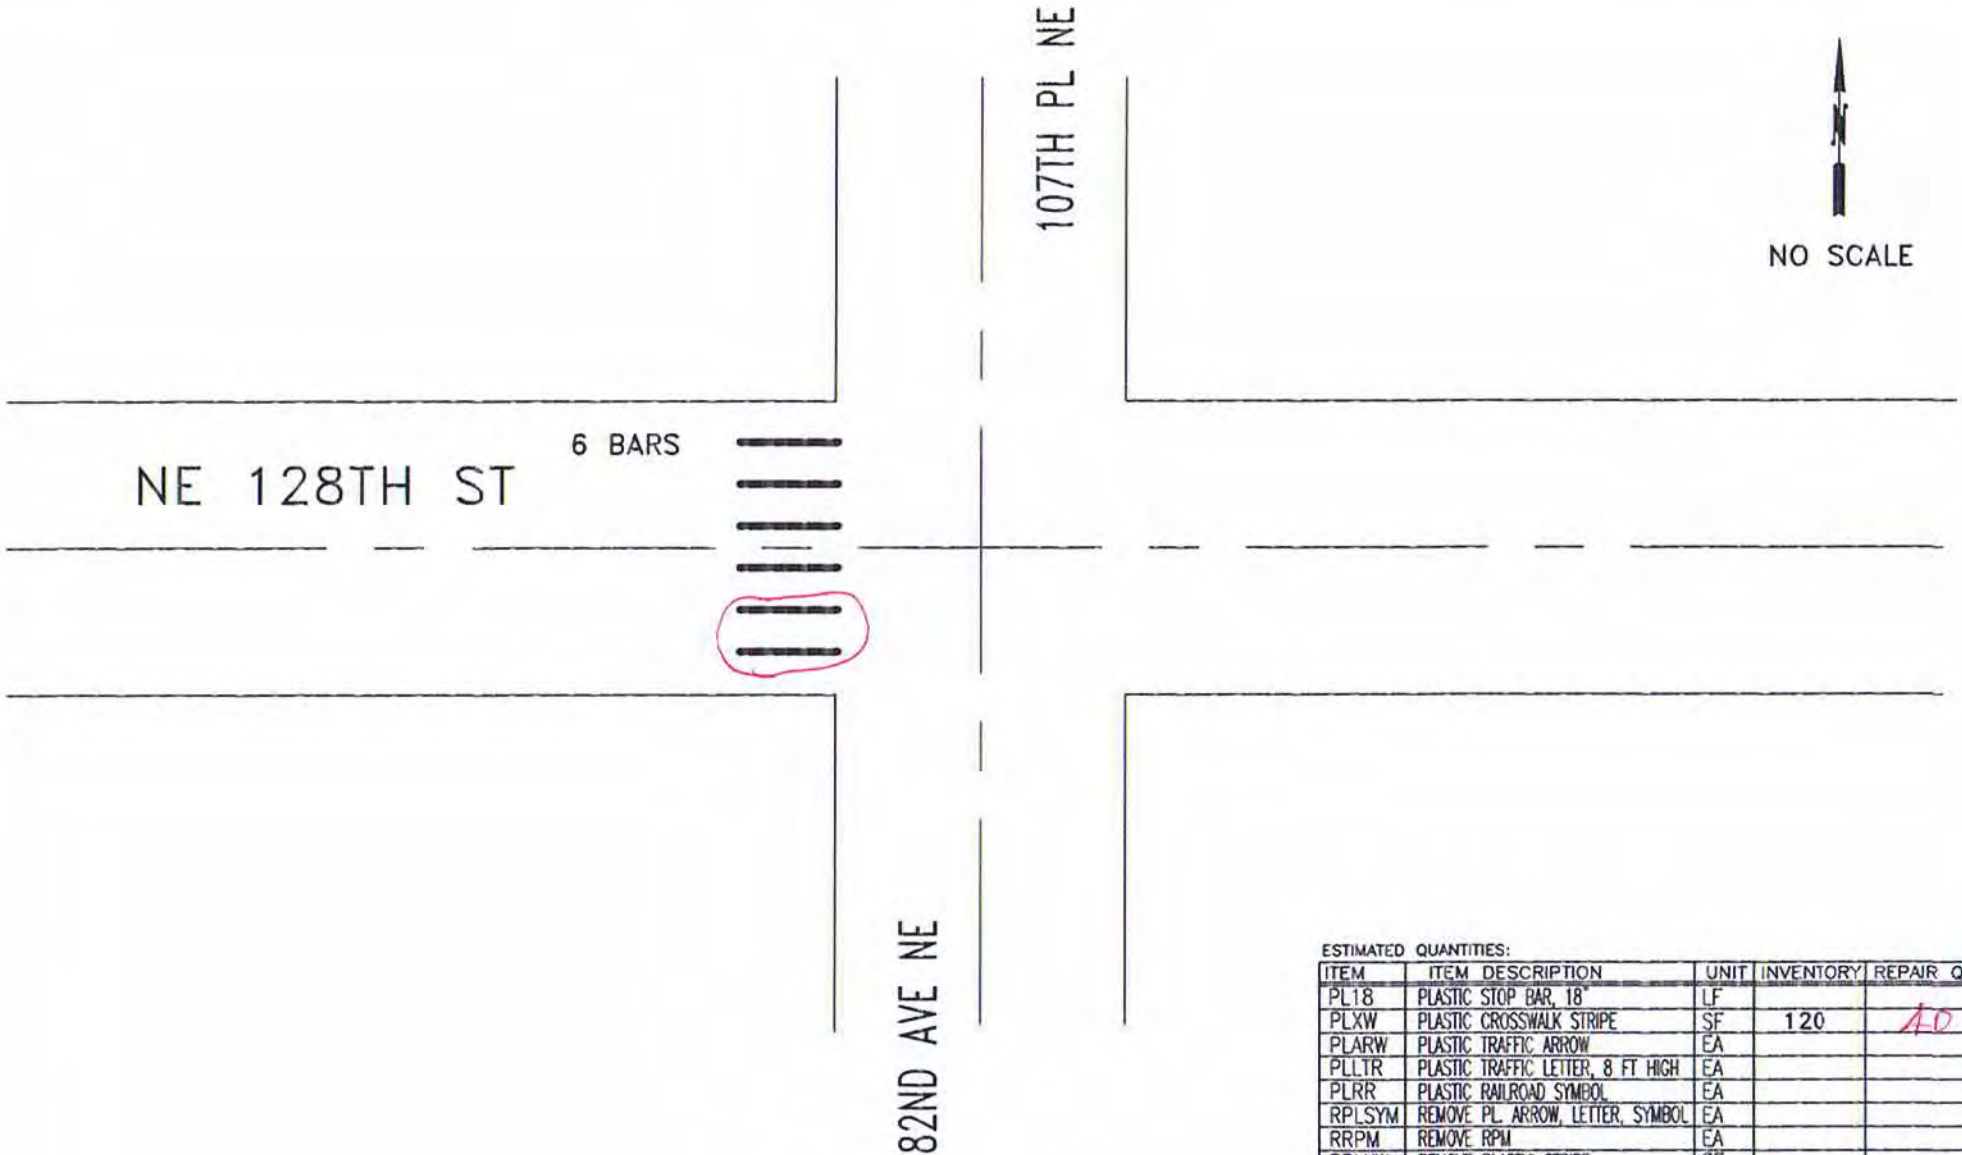

ESTIMATED QUANTITIES:

ITEM	ITEM DESCRIPTION	UNIT	INVENTORY	REPAIR QTY
PL18	PLASTIC STOP BAR, 18"	LF		
PLXW	PLASTIC CROSSWALK STRIPE	SF	120	40
PLARW	PLASTIC TRAFFIC ARROW	EA		
PLLTR	PLASTIC TRAFFIC LETTER, 8 FT HIGH	EA		
PLRR	PLASTIC RAILROAD SYMBOL	EA		
RPLSYM	REMOVE PL. ARROW, LETTER, SYMBOL	EA		
RRPM	REMOVE RPM	EA		
RPLXW	REMOVE PLASTIC STRIPE	SF		

CITY OF KIRKLAND
DEPARTMENT OF PUBLIC WORKS
123 FIFTH AVENUE KIRKLAND, WA 98033
(425) 587-3800 www.kirklandwa.gov

P. HERBIG 4/2014
DESIGNED BY: DATE

J.JENNINGS 4/2014
DRAWN BY: DATE

CHECKED BY: DATE

2020 PAVEMENT MARKING PROGRAM

STREET: 82ND AVE NE

CROSS STREET: NE 128TH STREET

SEGMENT:

SCALE: N.T.S.

FILENAME:

HENRY DAVID THOREAU ELEMENTARY
SCHOOL PARKING LOT & BUS ACCESS

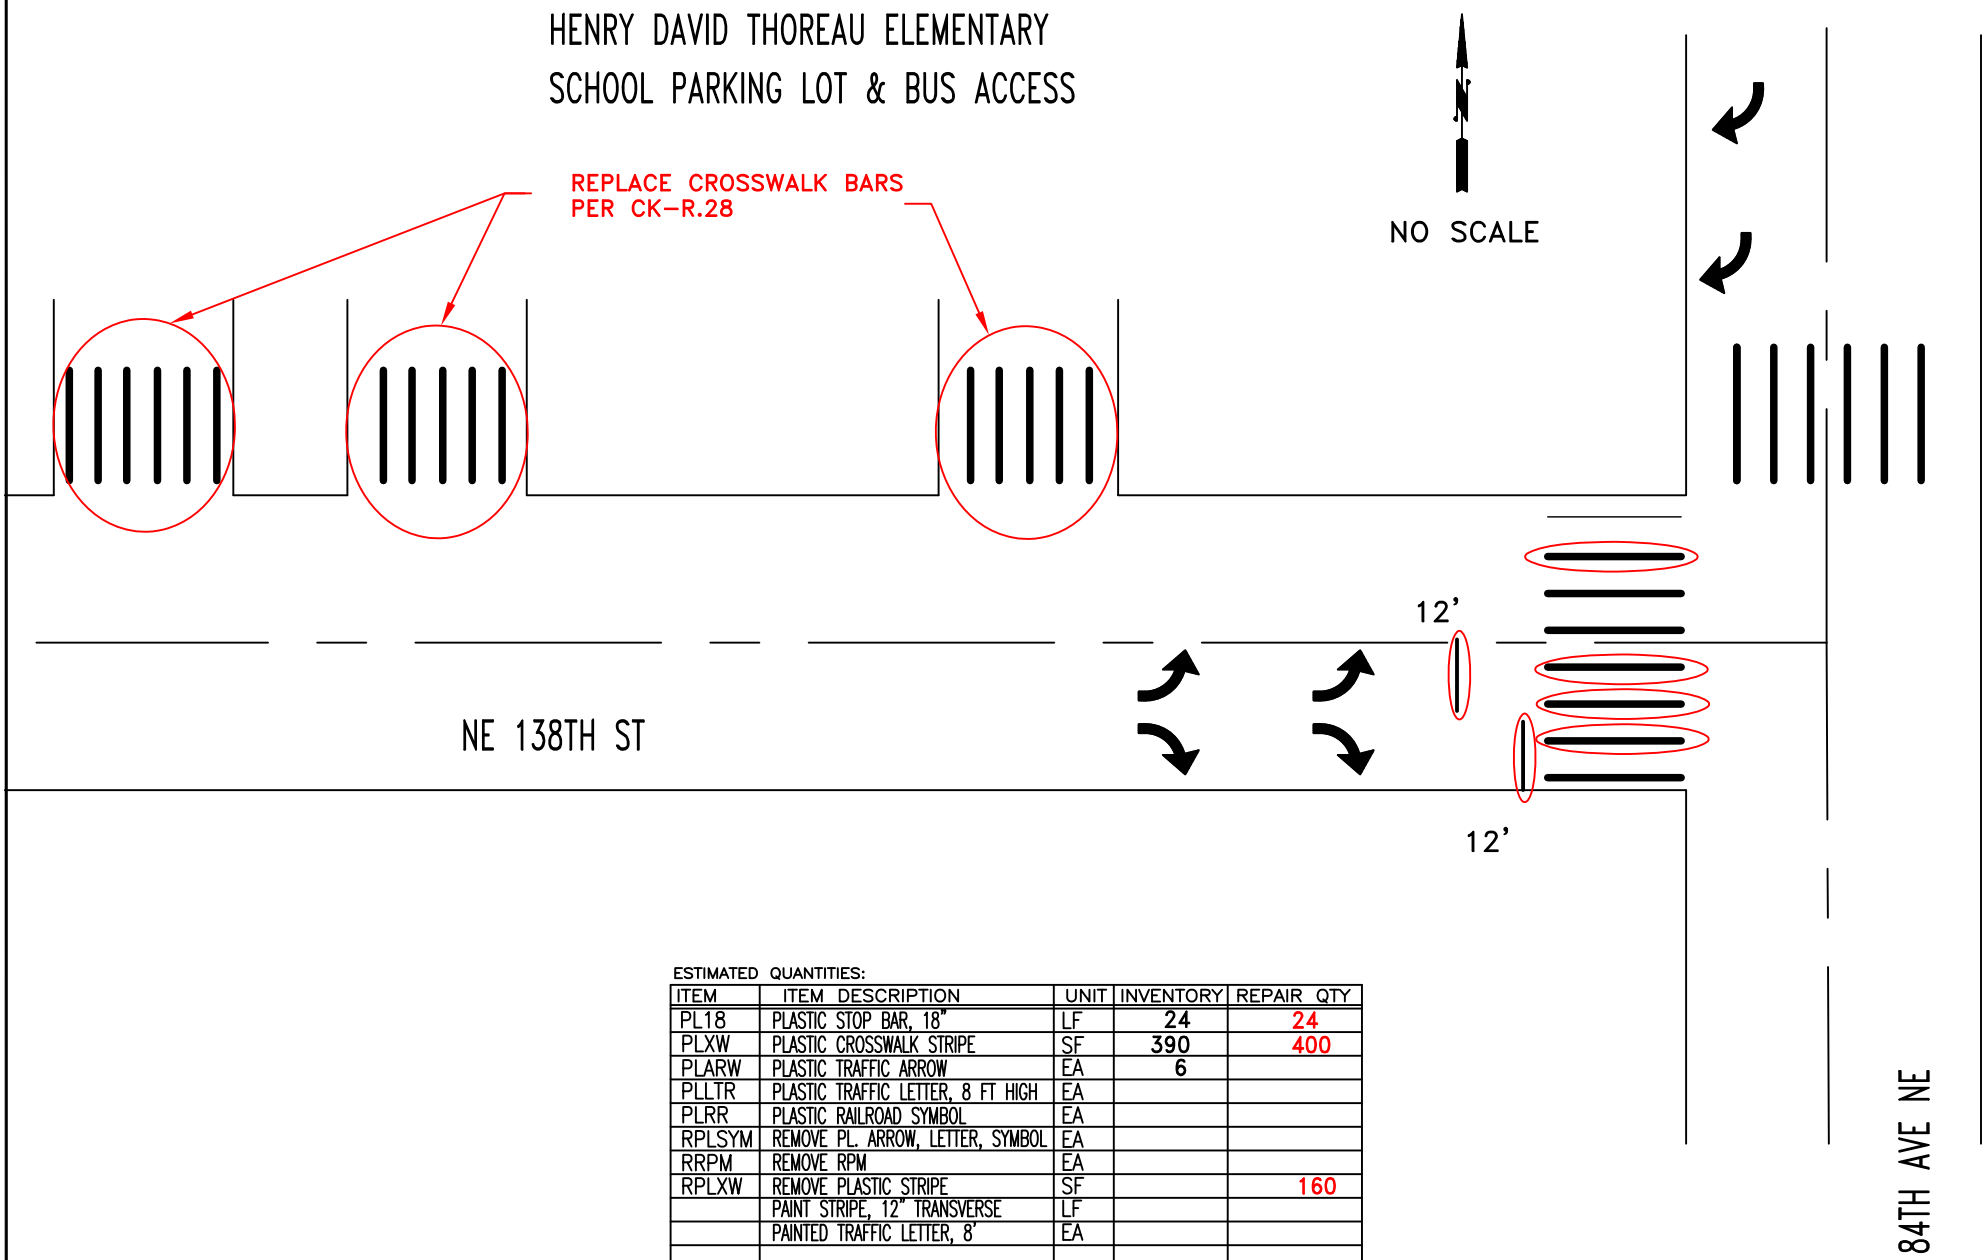

ESTIMATED QUANTITIES:

ITEM	ITEM DESCRIPTION	UNIT	INVENTORY	REPAIR QTY
PL18	PLASTIC STOP BAR, 18"	LF	24	24
PLXW	PLASTIC CROSSWALK STRIPE	SF	390	400
PLARW	PLASTIC TRAFFIC ARROW	EA	6	
PLLTR	PLASTIC TRAFFIC LETTER, 8 FT HIGH	EA		
PLRR	PLASTIC RAILROAD SYMBOL	EA		
RPLSYM	REMOVE PL. ARROW, LETTER, SYMBOL	EA		
RRPM	REMOVE RPM	EA		
RPLXW	REMOVE PLASTIC STRIPE	SF		160
	PAINT STRIPE, 12" TRANSVERSE	LF		
	PAINTED TRAFFIC LETTER, 8'	EA		

CITY OF KIRKLAND
DEPARTMENT OF PUBLIC WORKS
123 FIFTH AVENUE KIRKLAND, WA 98033
(425) 587-3800 www.kirklandwa.gov

S GONSAR 3/2020
DESIGNED BY: DATE

J JENNINGS 3/2020
DRAWN BY: DATE

CHECKED BY: DATE

2020 PAVEMENT MARKING PROGRAM

STREET: 84TH AVE NE

CROSS STREET: NE 138TH ST

SEGMENT:

SCALE: N.T.S.

FILENAME:

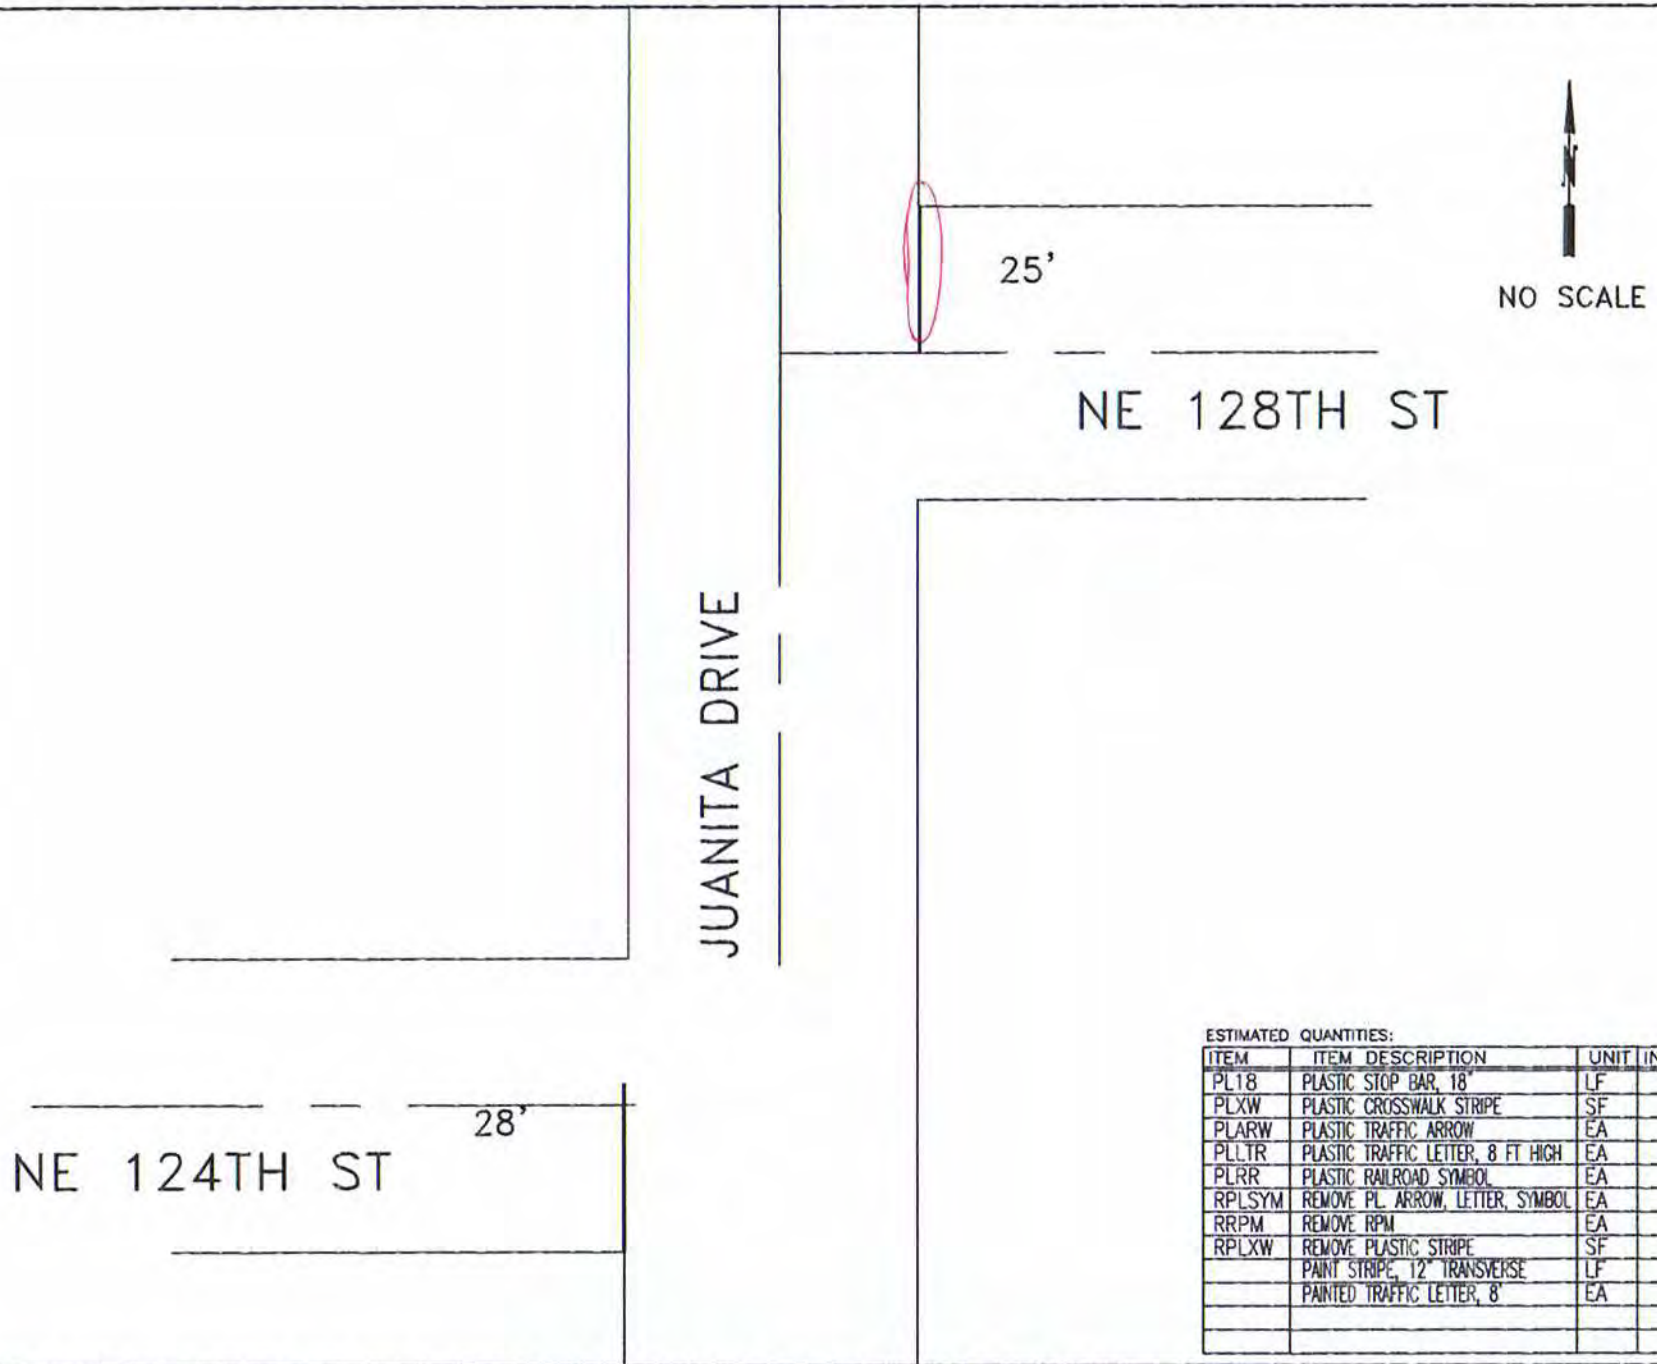

ESTIMATED QUANTITIES:

ITEM	ITEM DESCRIPTION	UNIT	INVENTORY	REPAIR QTY
PL18	PLASTIC STOP BAR, 18"	LF	53	35
PLXW	PLASTIC CROSSWALK STRIPE	SF		
PLARW	PLASTIC TRAFFIC ARROW	EA		
PLLTR	PLASTIC TRAFFIC LETTER, 8 FT HIGH	EA		
PLRR	PLASTIC RAILROAD SYMBOL	EA		
RPLSYM	REMOVE PL. ARROW, LETTER, SYMBOL	EA		
RRPM	REMOVE RPM	EA		
RPLXW	REMOVE PLASTIC STRIPE	SF		38
	PAINT STRIPE, 12" TRANSVERSE	LF		
	PAINTED TRAFFIC LETTER, 8'	EA		

CITY OF KIRKLAND WASHINGTON

CITY OF KIRKLAND
DEPARTMENT OF PUBLIC WORKS
123 FIFTH AVENUE KIRKLAND, WA 98033
(425) 587-3800 www.kirklandwa.gov

L. KAWOAKA 3/2016
DESIGNED BY: DATE

J.JENNINGS 3/2016
DRAWN BY: DATE

CHECKED BY: DATE


STREET: JUANITA DRIVE

CROSS STREET: NE 128TH STREET

SEGMENT:

SCALE: N.T.S.

FILENAME:

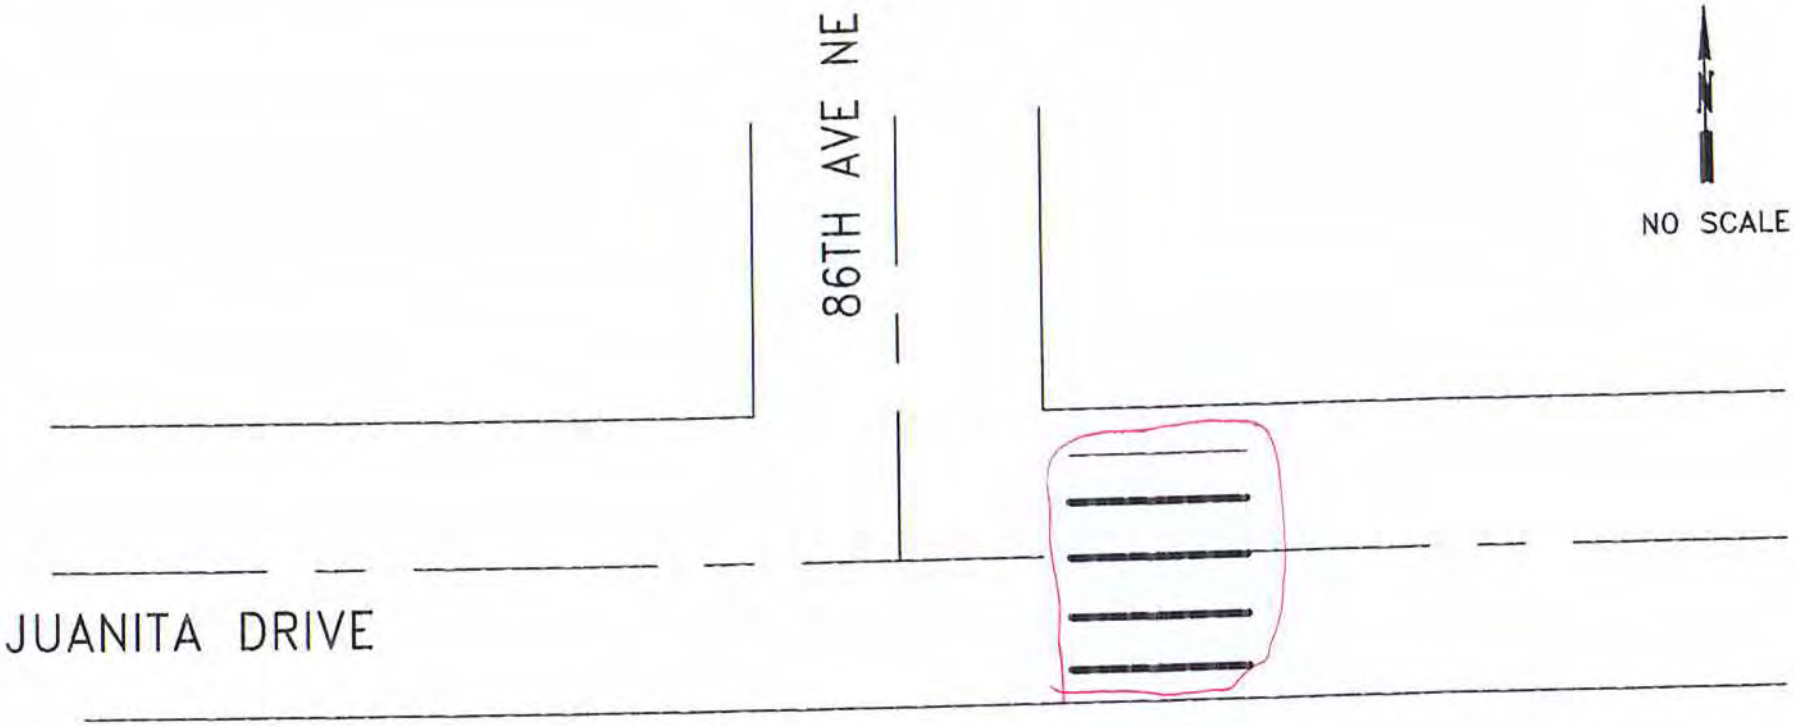

ESTIMATED QUANTITIES:

ITEM	ITEM DESCRIPTION	UNIT	INVENTORY	REPAIR QTY
PL18	PLASTIC STOP BAR, 18"	LF		
PLXW	PLASTIC CROSSWALK STRIPE	SF	90	90
PLARW	PLASTIC TRAFFIC ARROW	EA		
PLLTR	PLASTIC TRAFFIC LETTER, 8 FT HIGH	EA		
PLRR	PLASTIC RAILROAD SYMBOL	EA		
RPLSYM	REMOVE PL. ARROW, LETTER, SYMBOL	EA		
RRPM	REMOVE RPM	EA		
RPLXW	REMOVE PLASTIC STRIPE	SF		40

CITY OF KIRKLAND
DEPARTMENT OF PUBLIC WORKS
123 FIFTH AVENUE KIRKLAND, WA 98033
(425) 587-3800 www.kirklandwa.gov

F. LEE 4/2015
DESIGNED BY: DATE

J.JENNINGS 4/2015
DRAWN BY: DATE

CHECKED BY: DATE

2020 PAVEMENT MARKING PROGRAM

STREET: JUANITA DRIVE

CROSS STREET: 86TH AVE NE

SEGMENT:

SCALE: N.T.S.

FILENAME:

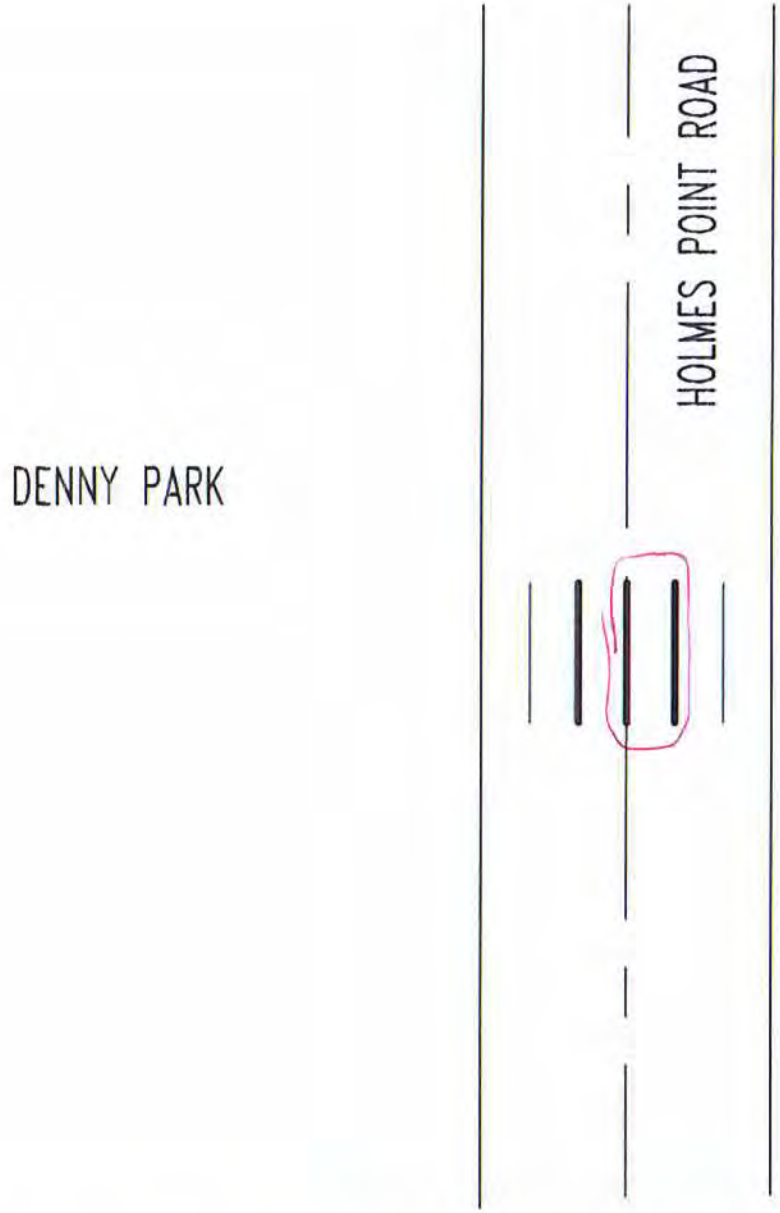

NO SCALE

ESTIMATED QUANTITIES:

ITEM	ITEM DESCRIPTION	UNIT	INVENTORY	REPAIR QTY
PL18	PLASTIC STOP BAR, 18"	LF		
PLXW	PLASTIC CROSSWALK STRIPE	SF	80	40
PLARW	PLASTIC TRAFFIC ARROW	EA		
PLLTR	PLASTIC TRAFFIC LETTER, 8 FT HIGH	EA		
PLRR	PLASTIC RAILROAD SYMBOL	EA		
RPLSYM	REMOVE PL. ARROW, LETTER, SYMBOL	EA		
RRPM	REMOVE RPM	EA		
RPLXW	REMOVE PLASTIC STRIPE	SF		40

CITY OF KIRKLAND
DEPARTMENT OF PUBLIC WORKS
123 FIFTH AVENUE KIRKLAND, WA 98033
(425) 587-3800 www.kirklandwa.gov

L. KAWAOKA 3/2016
DESIGNED BY: DATE

J.JENNINGS 3/2016
DRAWN BY: DATE

CHECKED BY: DATE

2022 PAVEMENT MARKING PROGRAM

STREET: HOLMES POINT ROAD

CROSS STREET: 68TH AVE NE

SEGMENT:

SCALE: N.T.S.

FILENAME:

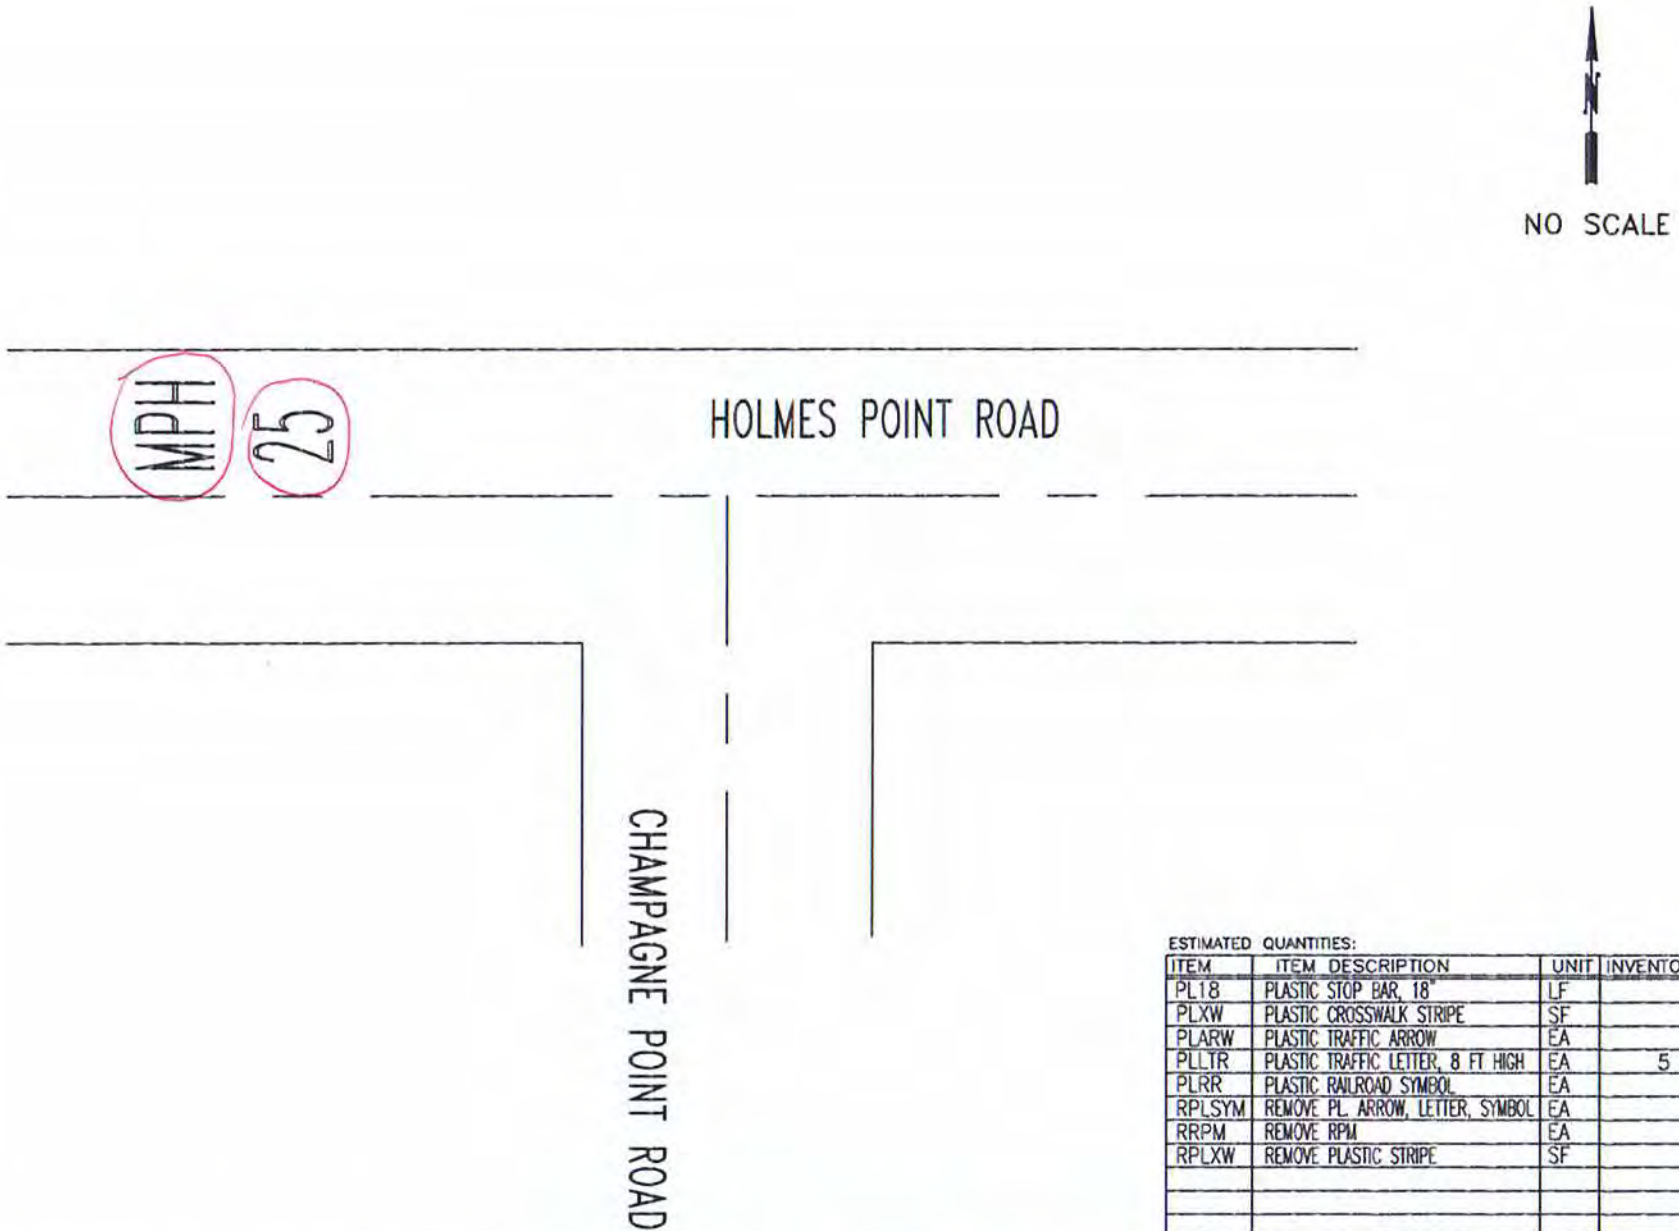

ESTIMATED QUANTITIES:

ITEM	ITEM DESCRIPTION	UNIT	INVENTORY	REPAIR QTY
PL18	PLASTIC STOP BAR, 18"	LF		
PLXW	PLASTIC CROSSWALK STRIPE	SF		
PLARW	PLASTIC TRAFFIC ARROW	EA		
PLLTR	PLASTIC TRAFFIC LETTER, 8 FT HIGH	EA	5	5
PLRR	PLASTIC RAILROAD SYMBOL	EA		
RPLSYM	REMOVE PL. ARROW, LETTER, SYMBOL	EA		5
RRPM	REMOVE RPM	EA		
RPLXW	REMOVE PLASTIC STRIPE	SF		

CITY OF KIRKLAND
DEPARTMENT OF PUBLIC WORKS
123 FIFTH AVENUE KIRKLAND, WA 98033
(425) 587-3800 www.kirklandwa.gov

L. KAWAOKA 3/2016
DESIGNED BY: DATE

J.JENNINGS 3/2016
DRAWN BY: DATE

CHECKED BY: DATE

2020 PAVEMENT MARKING PROGRAM

STREET: HOLMES POINT ROAD

CROSS STREET: CHAMPAGNE POINT ROAD

SEGMENT:

SCALE: N.T.S.

FILENAME:

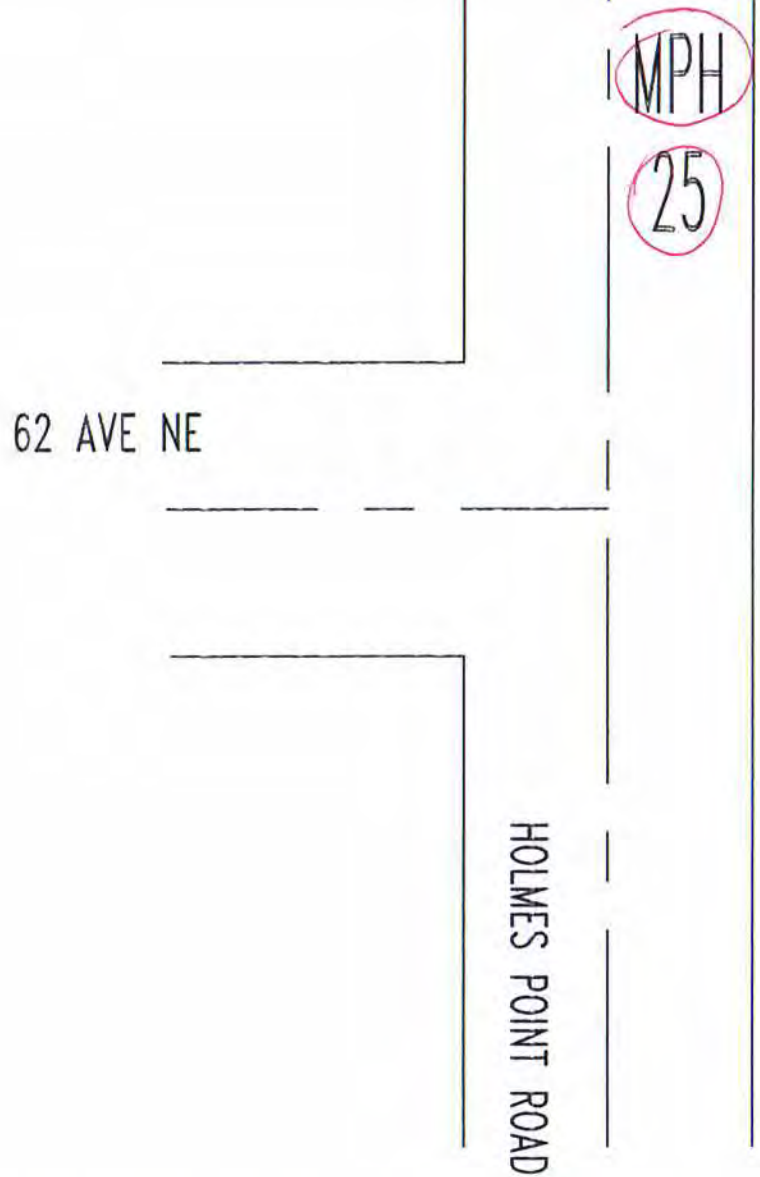

NO SCALE

ESTIMATED QUANTITIES:

ITEM	ITEM DESCRIPTION	UNIT	INVENTORY	REPAIR QTY
PL18	PLASTIC STOP BAR, 18"	LF		
PLXW	PLASTIC CROSSWALK STRIPE	SF		
PLARW	PLASTIC TRAFFIC ARROW	EA		
PLLTR	PLASTIC TRAFFIC LETTER, 8 FT HIGH	EA	5	3
PLRR	PLASTIC RAILROAD SYMBOL	EA		
RPLSYM	REMOVE PL. ARROW, LETTER, SYMBOL	EA		5
RRPM	REMOVE RPM	EA		
RPLXW	REMOVE PLASTIC STRIPE	SF		

CITY OF KIRKLAND
DEPARTMENT OF PUBLIC WORKS
123 FIFTH AVENUE KIRKLAND, WA 98033
(425) 587-3800 www.kirklandwa.gov

L. KAWAOKA 3/2016
DESIGNED BY: DATE

J.JENNINGS 3/2016
DRAWN BY: DATE

CHECKED BY: DATE

2022 PAVEMENT MARKING PROGRAM

STREET: HOLMES POINT ROAD

CROSS STREET: 62ND AVE NE

SEGMENT:

SCALE: N.T.S.

FILENAME:

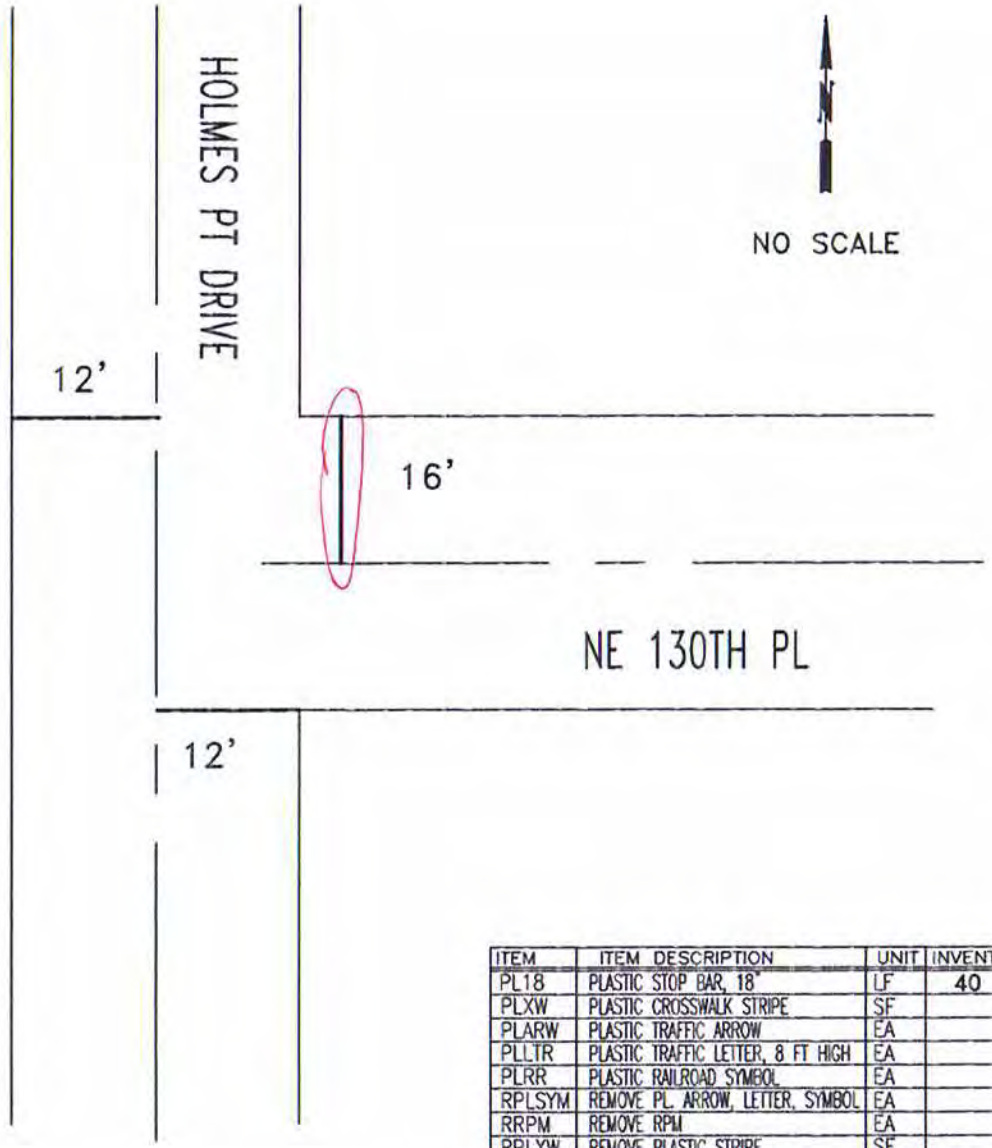

ITEM	ITEM DESCRIPTION	UNIT	INVENTORY	REPAIR QTY
PL18	PLASTIC STOP BAR, 18"	LF	40	16
PLXW	PLASTIC CROSSWALK STRIPE	SF		
PLARW	PLASTIC TRAFFIC ARROW	EA		
PLLTR	PLASTIC TRAFFIC LETTER, 8 FT HIGH	EA		
PLRR	PLASTIC RAILROAD SYMBOL	EA		
RPLSYM	REMOVE PL. ARROW, LETTER, SYMBOL	EA		
RRPM	REMOVE RPM	EA		
RPLXW	REMOVE PLASTIC STRIPE	SF		

CITY OF KIRKLAND WASHINGTON

CITY OF KIRKLAND
DEPARTMENT OF PUBLIC WORKS
123 FIFTH AVENUE KIRKLAND, WA 98033
(425) 587-3800 www.kirklandwa.gov

G. HORTILLOSA 10/2013
DESIGNED BY: DATE

J.JENNINGS 10/2013
DRAWN BY: DATE

REVISED BY: DATE

20 22 PAVEMENT MARKING PROGRAM

STREET: HOLMES POINT DRIVE

CROSS STREET: NE 130TH PL

SEGMENT:

SCALE: N.T.S.

FILENAME: Page 1-42

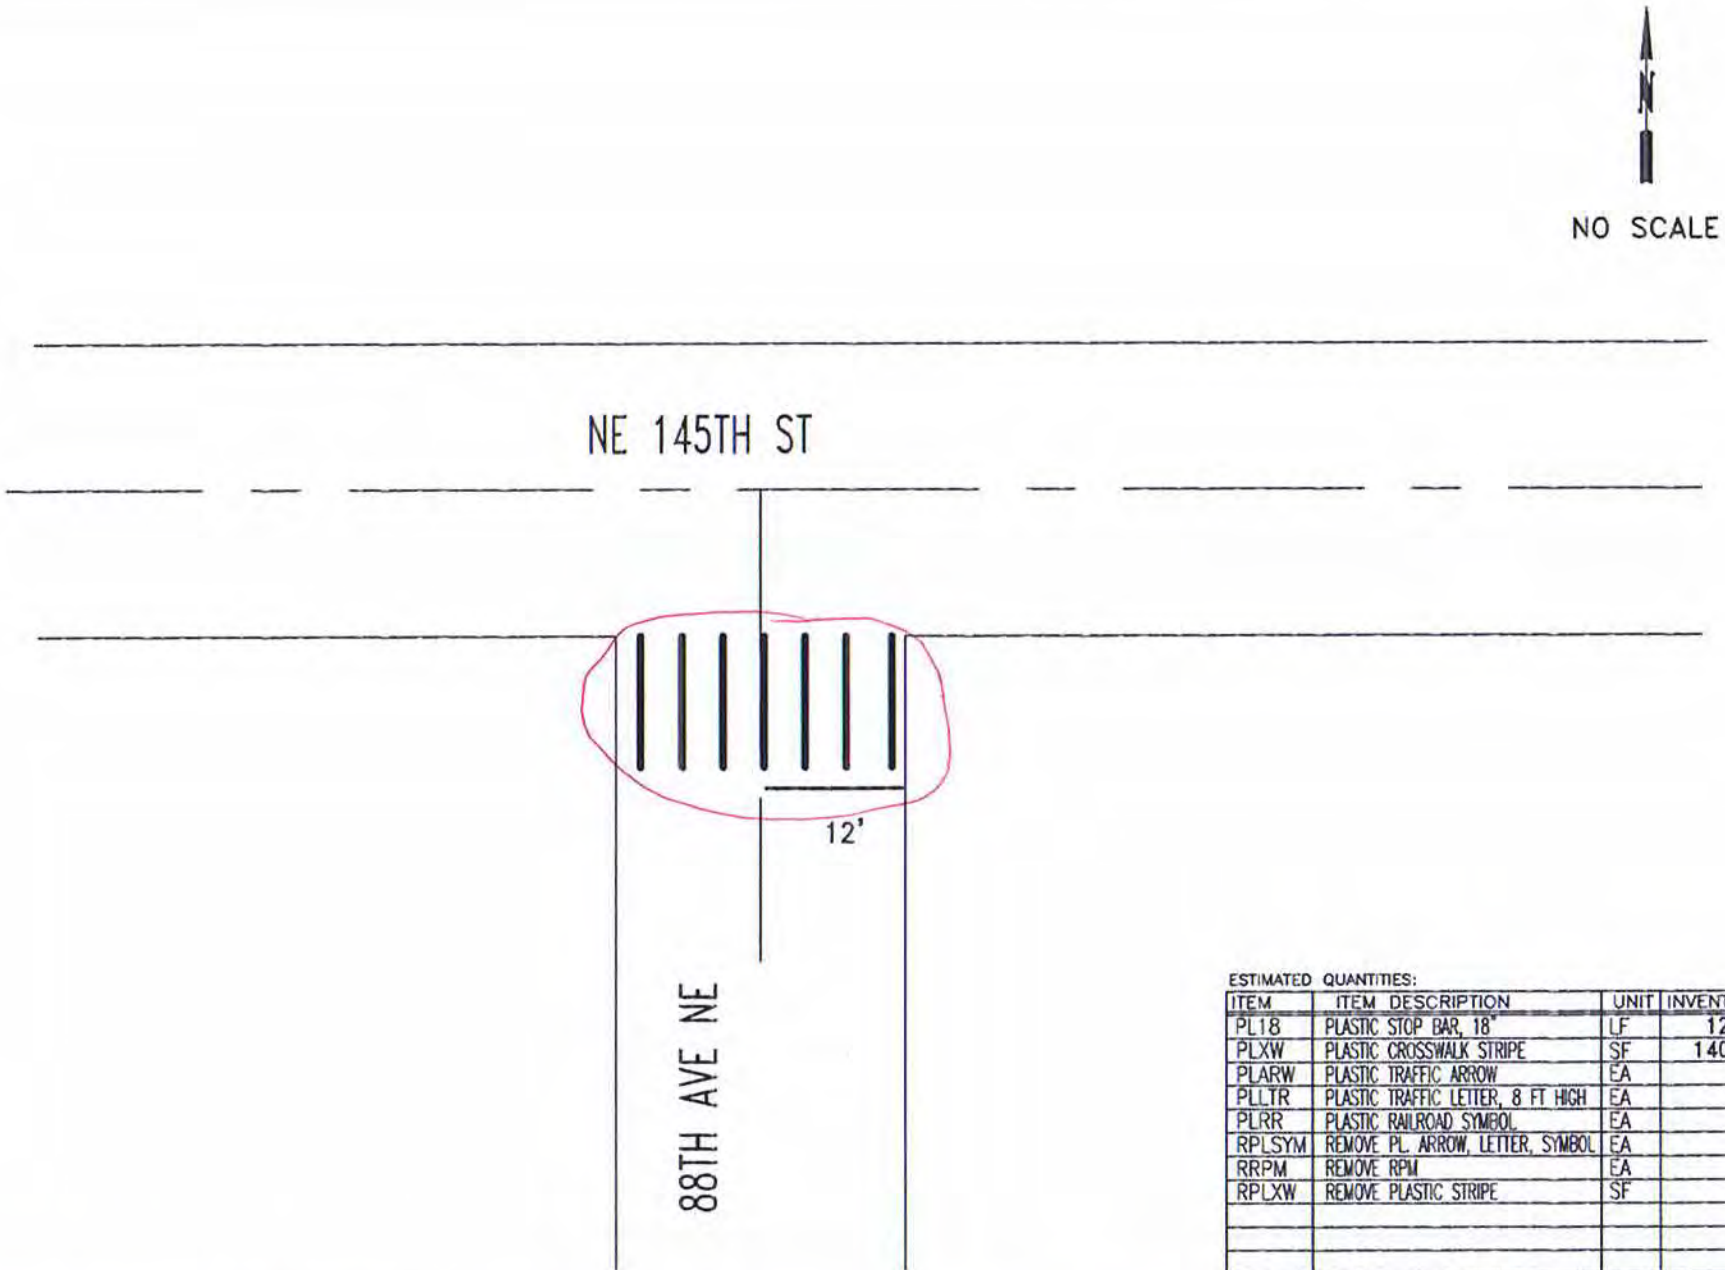

ESTIMATED QUANTITIES:

ITEM	ITEM DESCRIPTION	UNIT	INVENTORY	REPAIR QTY
PL18	PLASTIC STOP BAR, 18"	LF	12	12
PLXW	PLASTIC CROSSWALK STRIPE	SF	140	145
PLARW	PLASTIC TRAFFIC ARROW	EA		
PLLTR	PLASTIC TRAFFIC LETTER, 8 FT HIGH	EA		
PLRR	PLASTIC RAILROAD SYMBOL	EA		
RPLSYM	REMOVE PL. ARROW, LETTER, SYMBOL	EA		
RRPM	REMOVE RPM	EA		
RPLXW	REMOVE PLASTIC STRIPE	SF		

CITY OF KIRKLAND WASHINGTON

CITY OF KIRKLAND
DEPARTMENT OF PUBLIC WORKS
123 FIFTH AVENUE KIRKLAND, WA 98033
(425) 587-3800 www.kirklandwa.gov

L. KAWAOKA 8/2016
DESIGNED BY: DATE

J.JENNINGS 8/2016
DRAWN BY: DATE

CHECKED BY: DATE

2020 PAVEMENT MARKING PROGRAM

STREET: NE 145TH ST

CROSS STREET: 88TH AVE NE

SEGMENT:

SCALE: N.T.S.

FILENAME:

APPENDIX D

ALTERNATE D – PLAN SHEETS

Additional Item #1 – 4 ADA Stalls

Location A

Location B

Location C

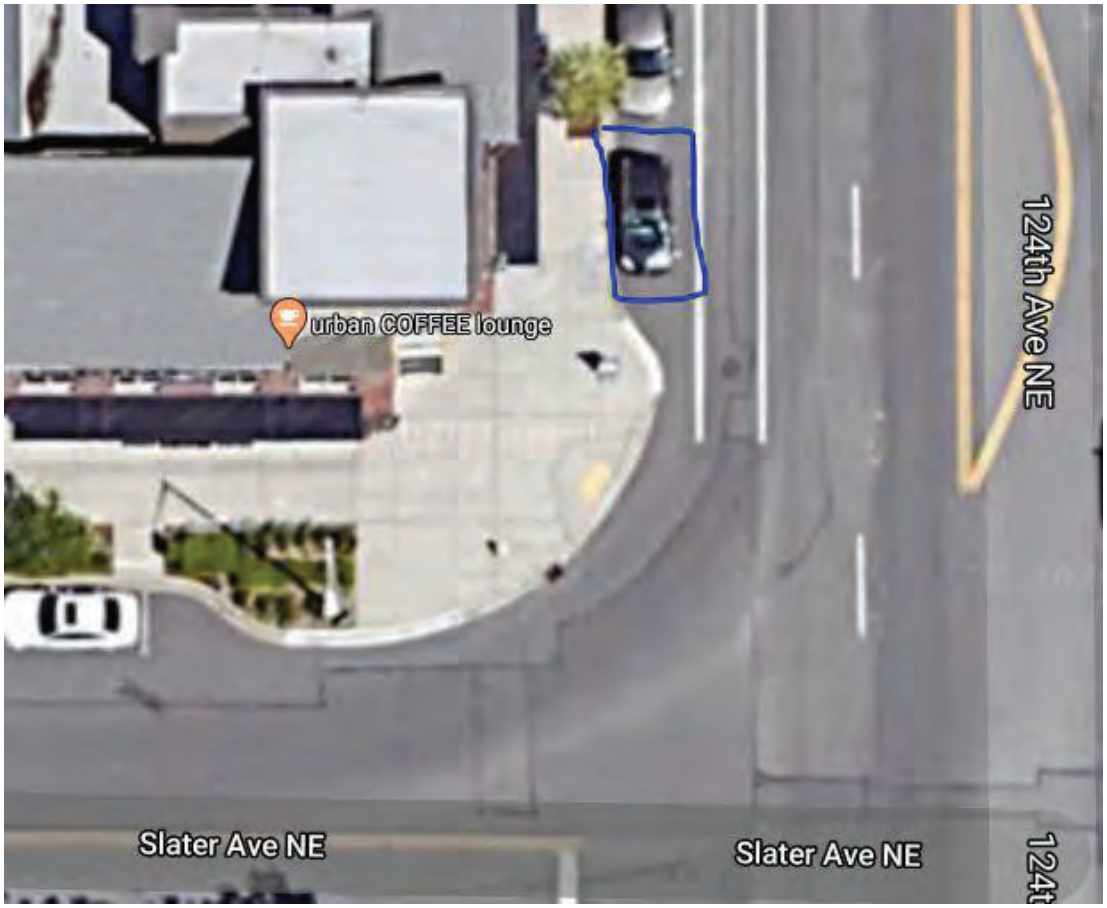

Location D

Additional Item #2 – Parking Stall Refresh

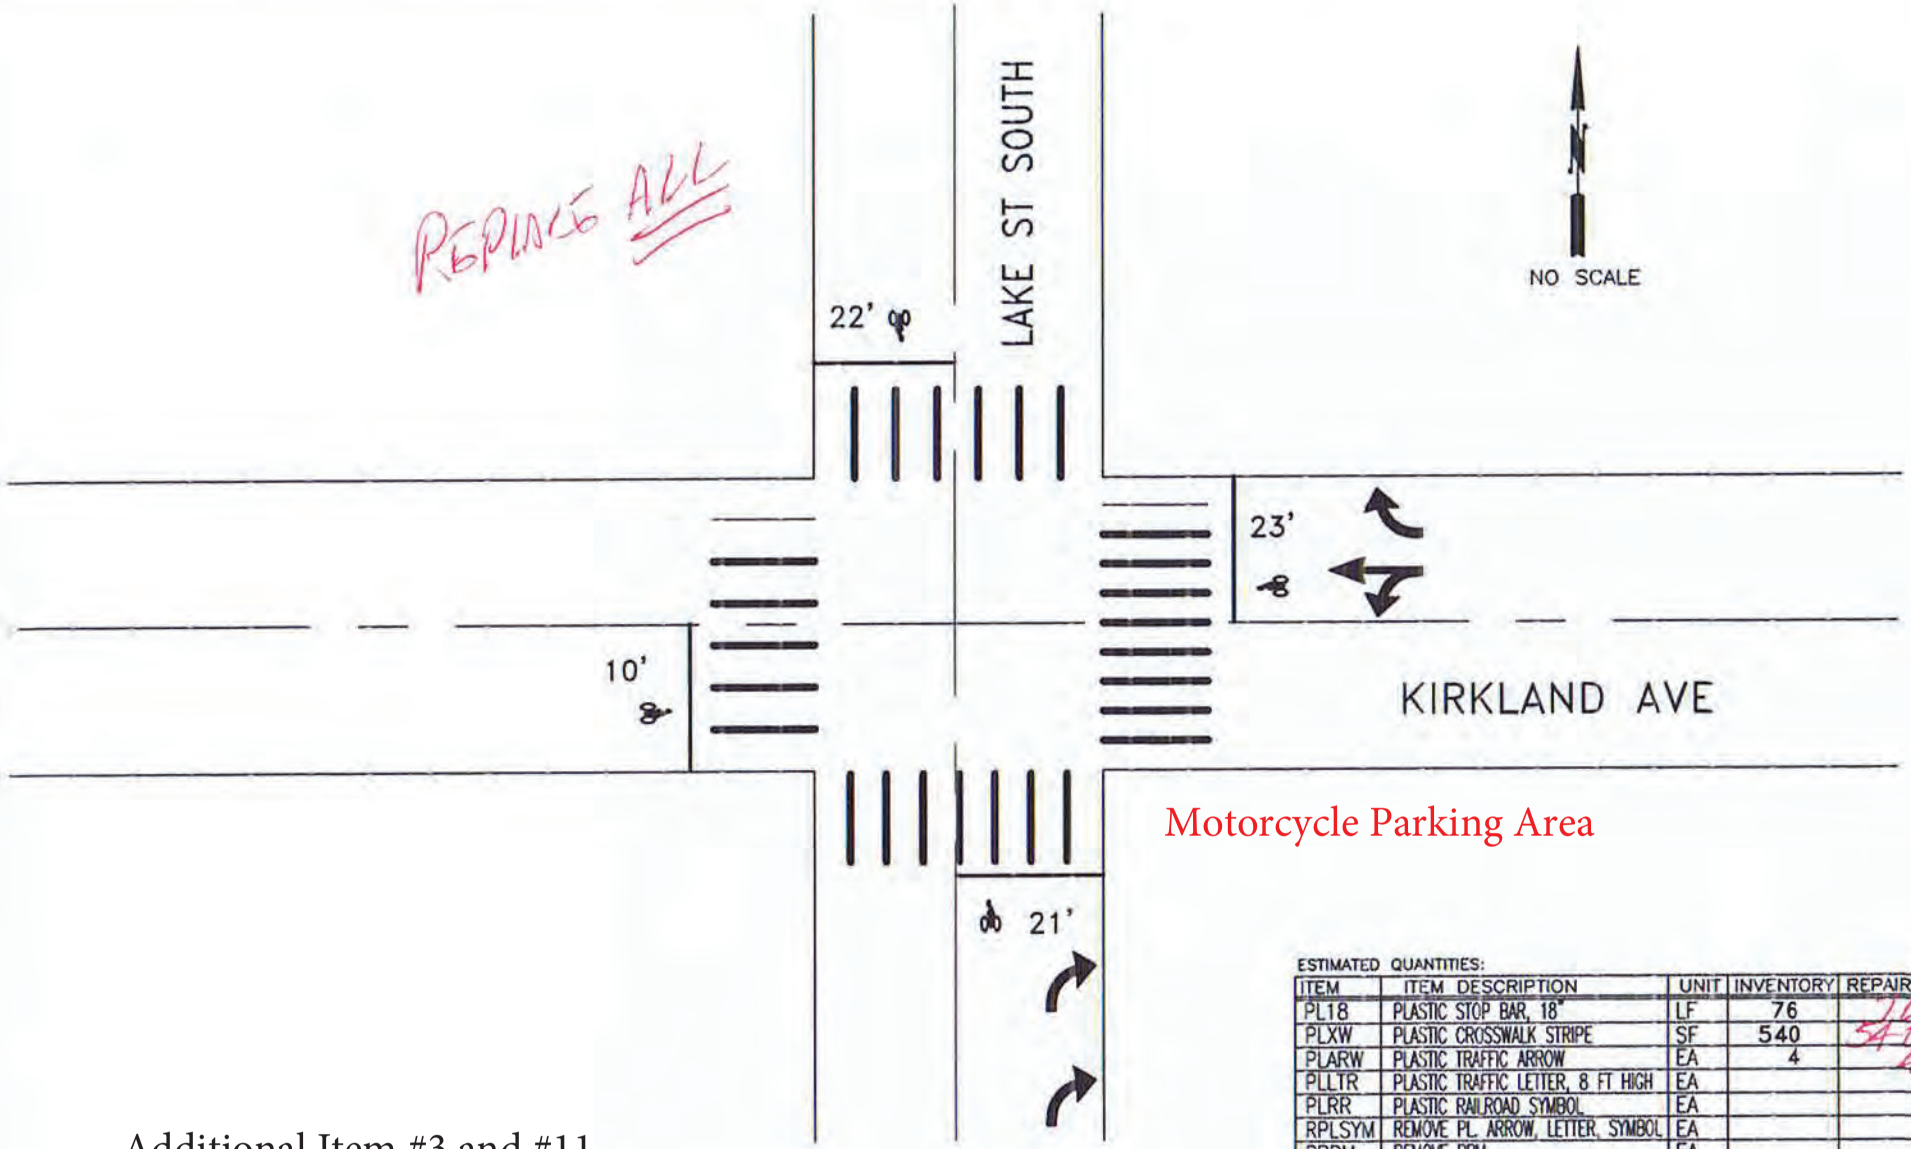

ESTIMATED QUANTITIES:

ITEM	ITEM DESCRIPTION	UNIT	INVENTORY	REPAIR QTY
PL18	PLASTIC STOP BAR, 18"	LF	76	76
PLXW	PLASTIC CROSSWALK STRIPE	SF	540	540
PLARW	PLASTIC TRAFFIC ARROW	EA	4	4
PLLTR	PLASTIC TRAFFIC LETTER, 8 FT HIGH	EA		
PLRR	PLASTIC RAILROAD SYMBOL	EA		
RPLSYM	REMOVE PL. ARROW, LETTER, SYMBOL	EA		
RRPM	REMOVE RPM	EA		
RPLXW	REMOVE PLASTIC STRIPE	SF		
	PLASTIC BIKE DETECTION SYMBOL	EA	4	

Additional Item #3 and #11

CITY OF KIRKLAND
DEPARTMENT OF PUBLIC WORKS
123 FIFTH AVENUE KIRKLAND, WA 98033
(425) 587-3800 www.kirklandwa.gov

G. HORTILLOSA 10/2006 DESIGNED BY: DATE
J.JENNINGS 10/2011 DRAWN BY: DATE
CHECKED BY: DATE

2022 PAVEMENT MARKING PROGRAM
STREET: KIRKLAND AVENUE
CROSS STREET: LAKE ST SOUTH
SEGMENT:
SCALE: N.T.S.
FILENAME: Page 10-9

Additional Item #4 – Wavery Way 25 MPH Symbol

Additional Item #5 – Big Finn Hill Park Crosswalk

Exact Location to be Determined in Field

NO SCALE

ESTIMATED QUANTITIES:

ITEM	ITEM DESCRIPTION	UNIT	INVENTORY	REPAIR QTY
PL18	PLASTIC STOP BAR, 18"	LF	30	30
PLXW	PLASTIC CROSSWALK STRIPE	SF		
PLARW	PLASTIC TRAFFIC ARROW	EA	2	
PLLTR	PLASTIC TRAFFIC LETTER, 8 FT HIGH	EA		
PLRR	PLASTIC RAILROAD SYMBOL	EA		
RPLSYM	REMOVE PL. ARROW, LETTER, SYMBOL	EA		
RRPM	REMOVE RPM	EA		
RPLXW	REMOVE PLASTIC STRIPE	SF		

Additional Item #6

CITY OF KIRKLAND
DEPARTMENT OF PUBLIC WORKS
123 FIFTH AVENUE KIRKLAND, WA 98033
(425) 587-3800 www.kirklandwa.gov

S. GONSAR 4/2019
DESIGNED BY: DATE

J.JENNINGS 4/2019
DRAWN BY: DATE

CHECKED BY: DATE

2020 PAVEMENT MARKING PROGRAM

STREET: JUANITA DR NE

CROSS STREET: NE 138TH PL

SEGMENT:

SCALE: N.T.S.

FILENAME: Page 1-3

Additional Item #7 – New Stop Bar Location

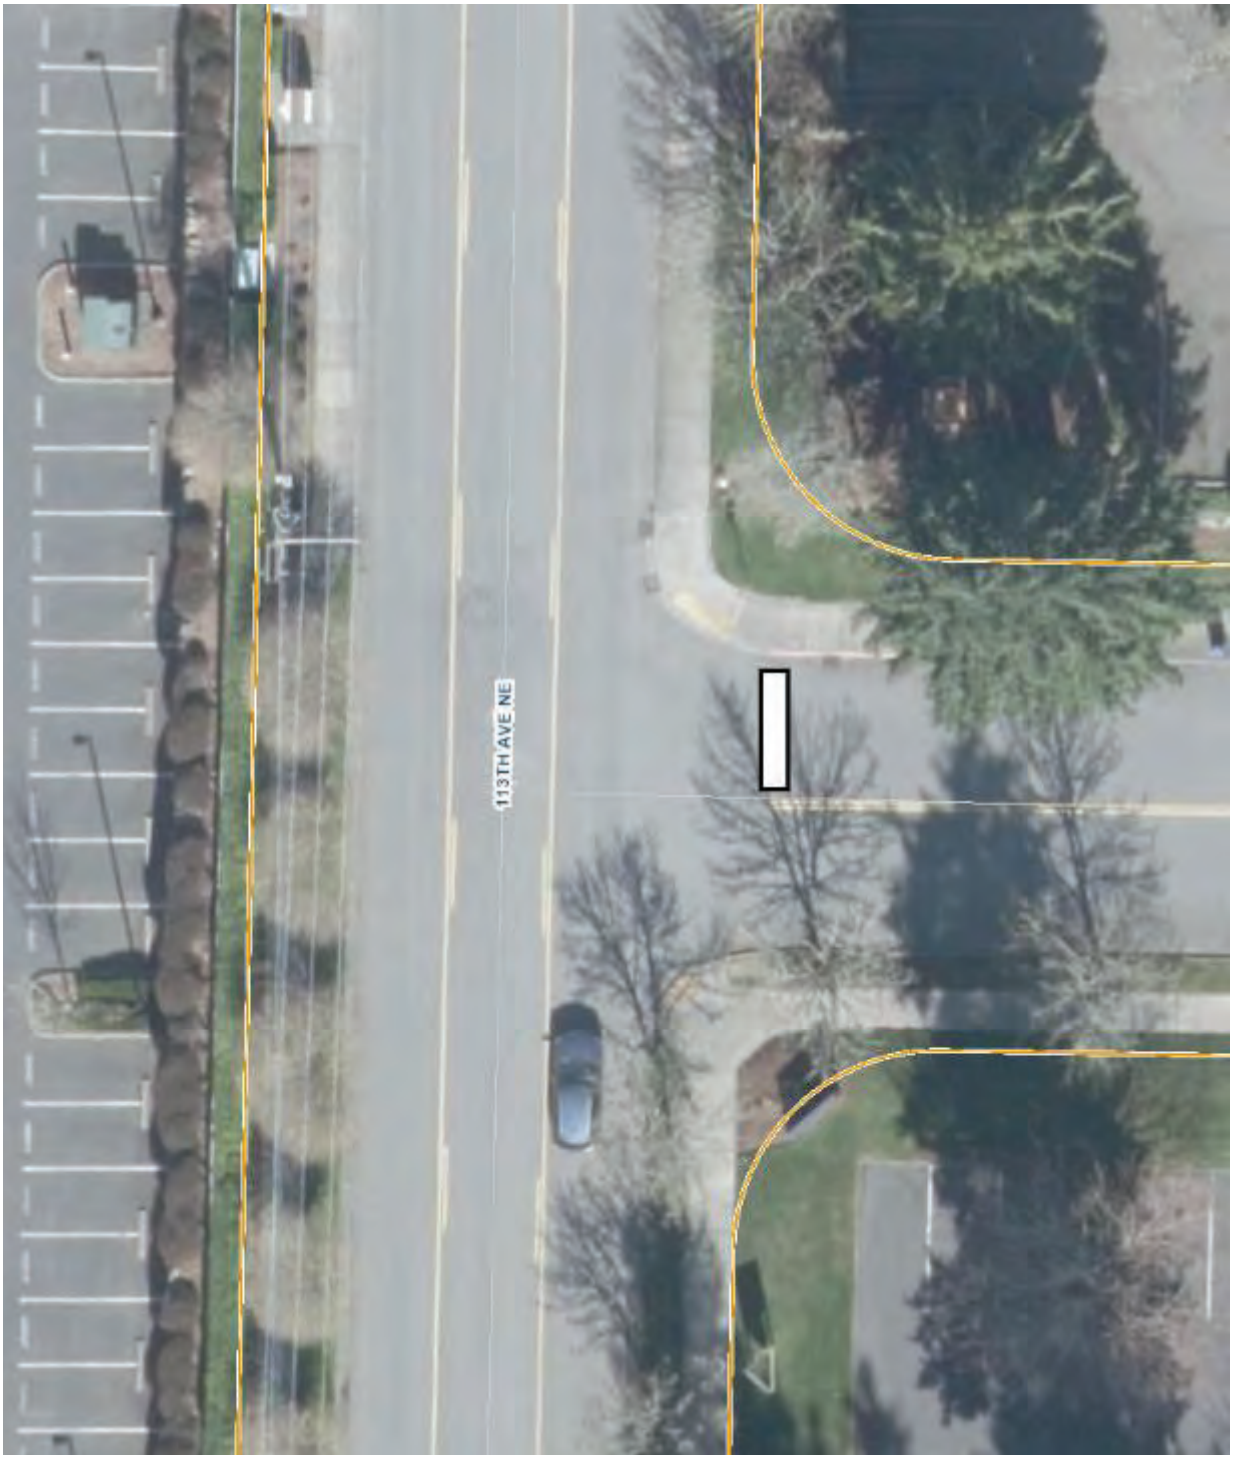

Exact Location to be Determined in Field

Additional Item #8 – Refresh No-Parking

Additional Item #9 – New Stop Bar Location

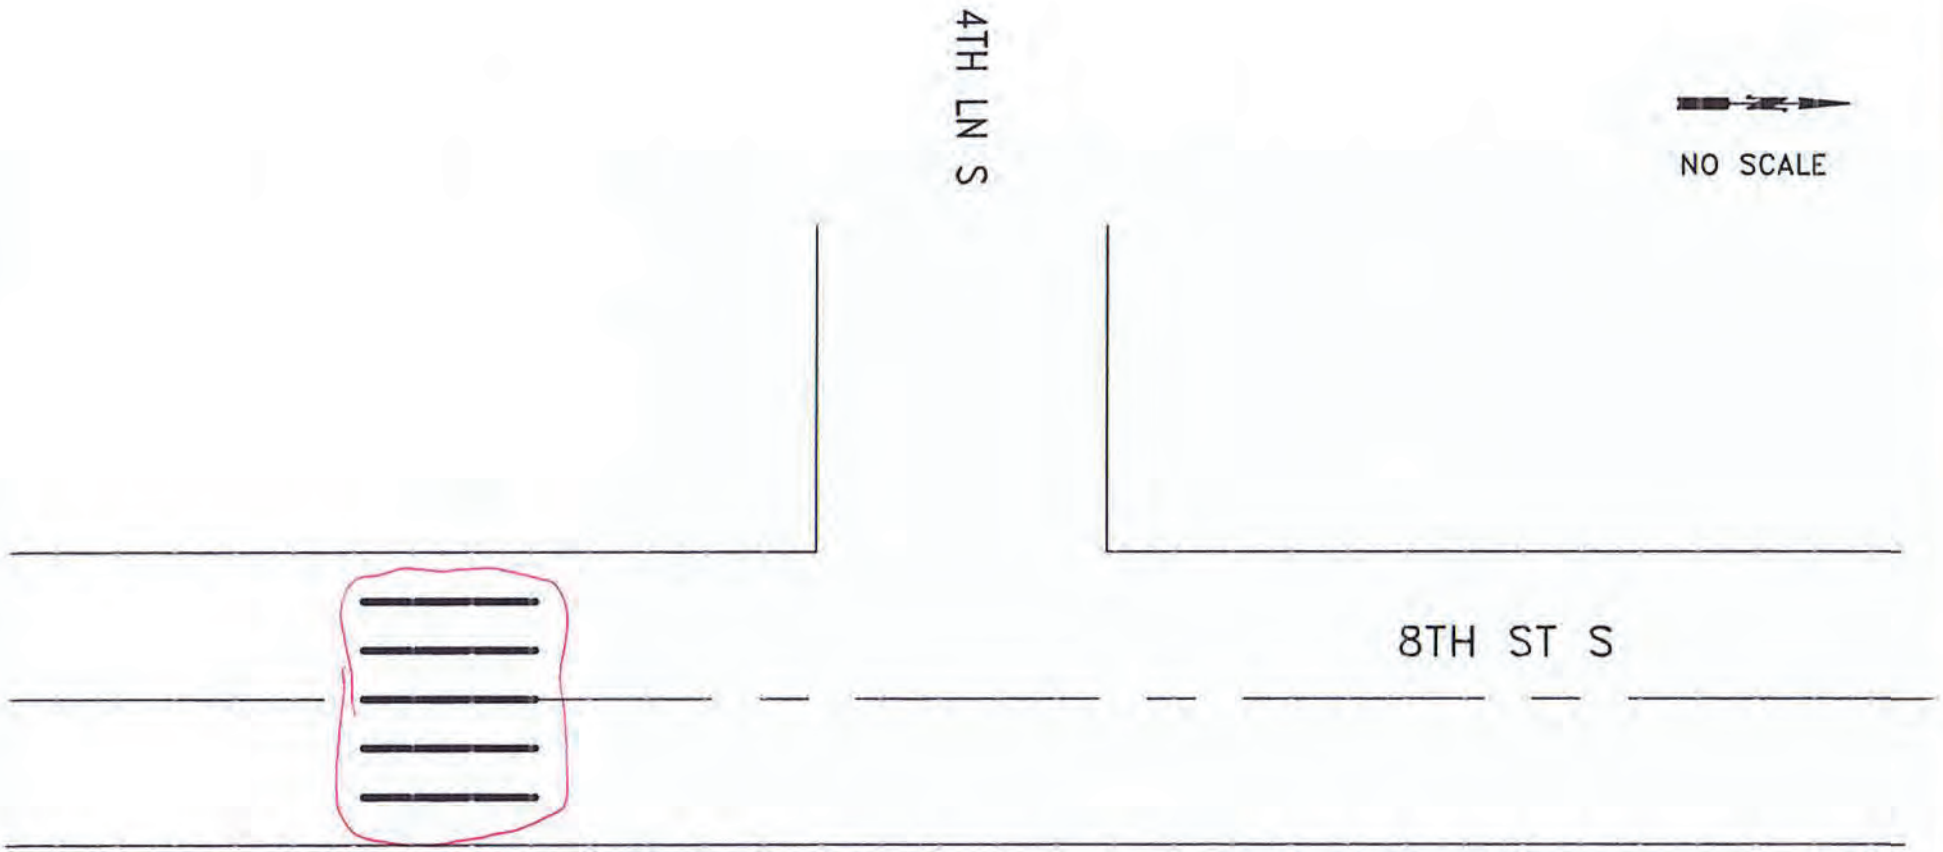

ESTIMATED QUANTITIES:

ITEM	ITEM DESCRIPTION	UNIT	INVENTORY	REPAIR QTY
PL18	PLASTIC STOP BAR, 18"	LF		
PLXW	PLASTIC CROSSWALK STRIPE	SF	100	100
PLARW	PLASTIC TRAFFIC ARROW	EA		
PLLTR	PLASTIC TRAFFIC LETTER, 8 FT HIGH	EA		
PLRR	PLASTIC RAILROAD SYMBOL	EA		
RPLSYM	REMOVE PL. ARROW, LETTER, SYMBOL	EA		
RRPM	REMOVE RPM	EA		
RPLXW	REMOVE PLASTIC STRIPE	SF		

Additional Item #10

CITY OF KIRKLAND
DEPARTMENT OF PUBLIC WORKS
123 FIFTH AVENUE KIRKLAND, WA 98033
(425) 587-3800 www.kirklandwa.gov

S.GONSAR 2/2018
DESIGNED BY: DATE

J.JENNINGS 2/2018
DRAWN BY: DATE

CHECKED BY: DATE

2020 PAVEMENT MARKING PROGRAM

STREET: 8TH ST S

CROSS STREET: 4TH LN S

SEGMENT:

SCALE: N.T.S.

FILENAME: Page 11-13

Additional Item #12 – Bicycle Symbol Refresh

Additional Item #13 – Bicycle Symbol Refresh

APPENDIX E

ALTERNATE E – PLAN SHEETS

KINGSGATE
INTERSECTION PLANS

CITY OF KIRKLAND
DEPARTMENT OF PUBLIC WORKS
123 FIFTH AVENUE KIRKLAND, WA 98033
(425) 587-3800 www.kirklandwa.gov

S GONSAR	1/2019	DESIGNED BY: DATE
J.JENNINGS	1/2019	DRAWN BY: DATE
		CHECKED BY: DATE

2020 PAVEMENT MARKING PROGRAM

STREET:

CROSS STREET:

SEGMENT:

SCALE: N.T.S.

FILENAME: 3-0

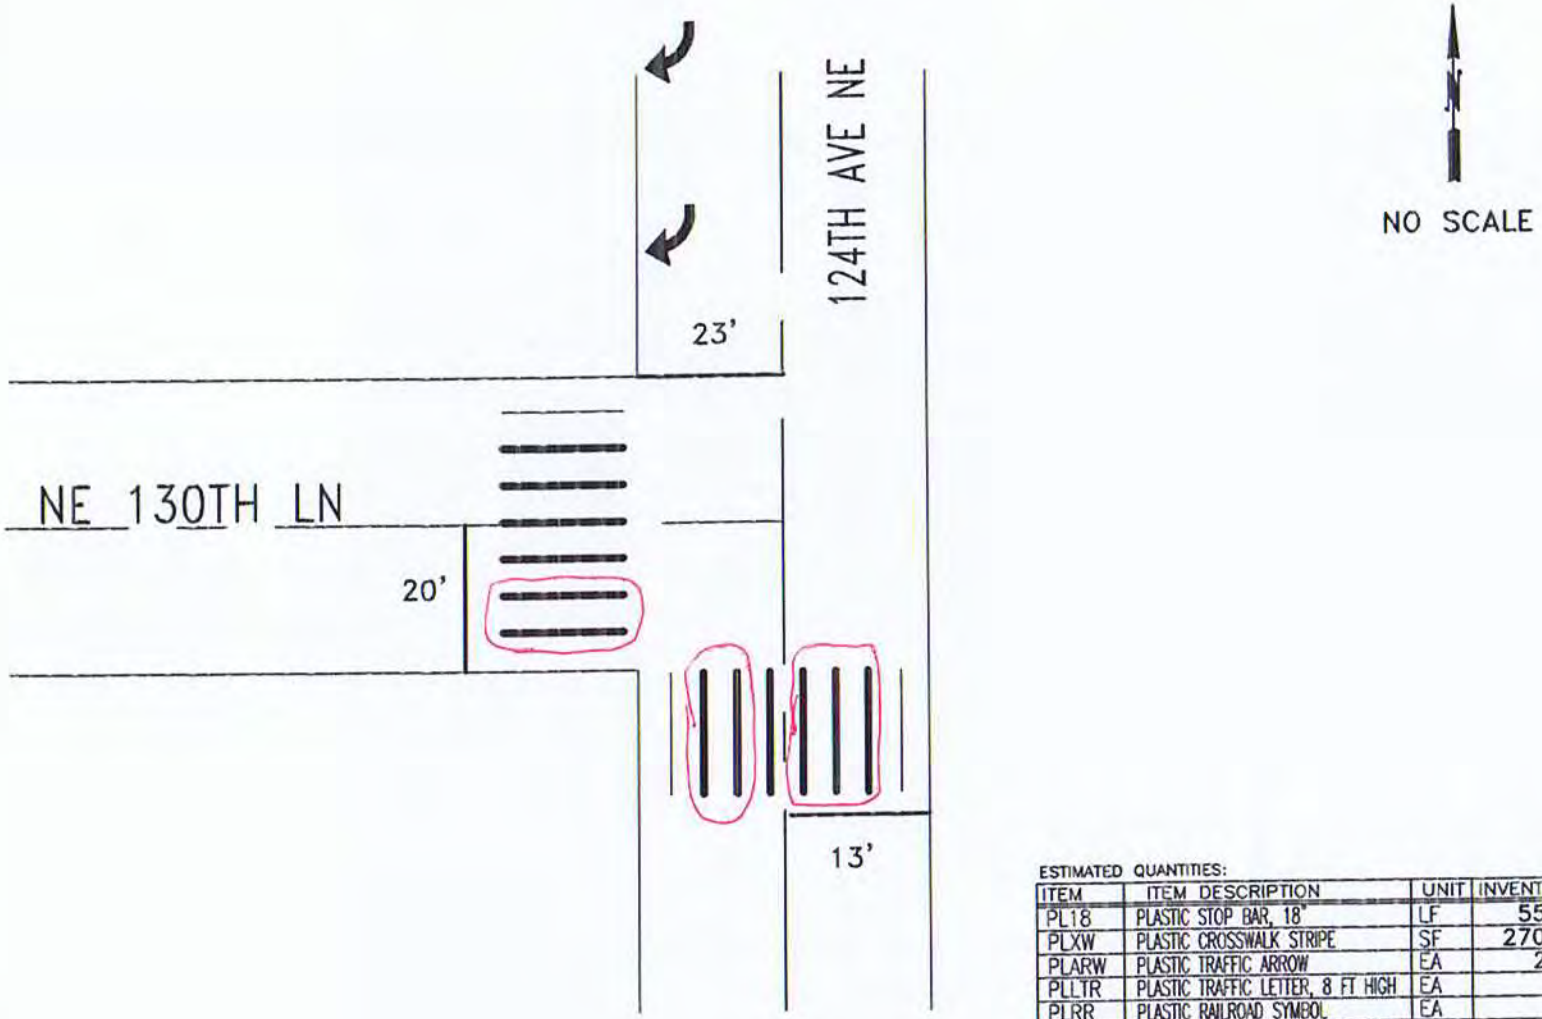

ESTIMATED QUANTITIES:

ITEM	ITEM DESCRIPTION	UNIT	INVENTORY	REPAIR QTY
PL18	PLASTIC STOP BAR, 18"	LF	55	
PLXW	PLASTIC CROSSWALK STRIPE	SF	270	140
PLARW	PLASTIC TRAFFIC ARROW	EA	2	
PLLTR	PLASTIC TRAFFIC LETTER, 8 FT HIGH	EA		
PLRR	PLASTIC RAILROAD SYMBOL	EA		
RPLSYM	REMOVE PL. ARROW, LETTER, SYMBOL	EA		
RRPM	REMOVE RPM	EA		
RPLXW	REMOVE PLASTIC STRIPE	SF		40

CITY OF KIRKLAND
DEPARTMENT OF PUBLIC WORKS
123 FIFTH AVENUE KIRKLAND, WA 98033
(425) 587-3800 www.kirklandwa.gov

G. HORTILLOSA 11/2008
DESIGNED BY: DATE

J.JENNINGS 10/2009
DRAWN BY: DATE

CHECKED BY: DATE

2020 PAVEMENT MARKING PROGRAM

STREET: NE 130TH LN

CROSS STREET: 124TH AVE NE

SEGMENT: 3020-#260

SCALE: N.T.S.

FILENAME: Page 3-1

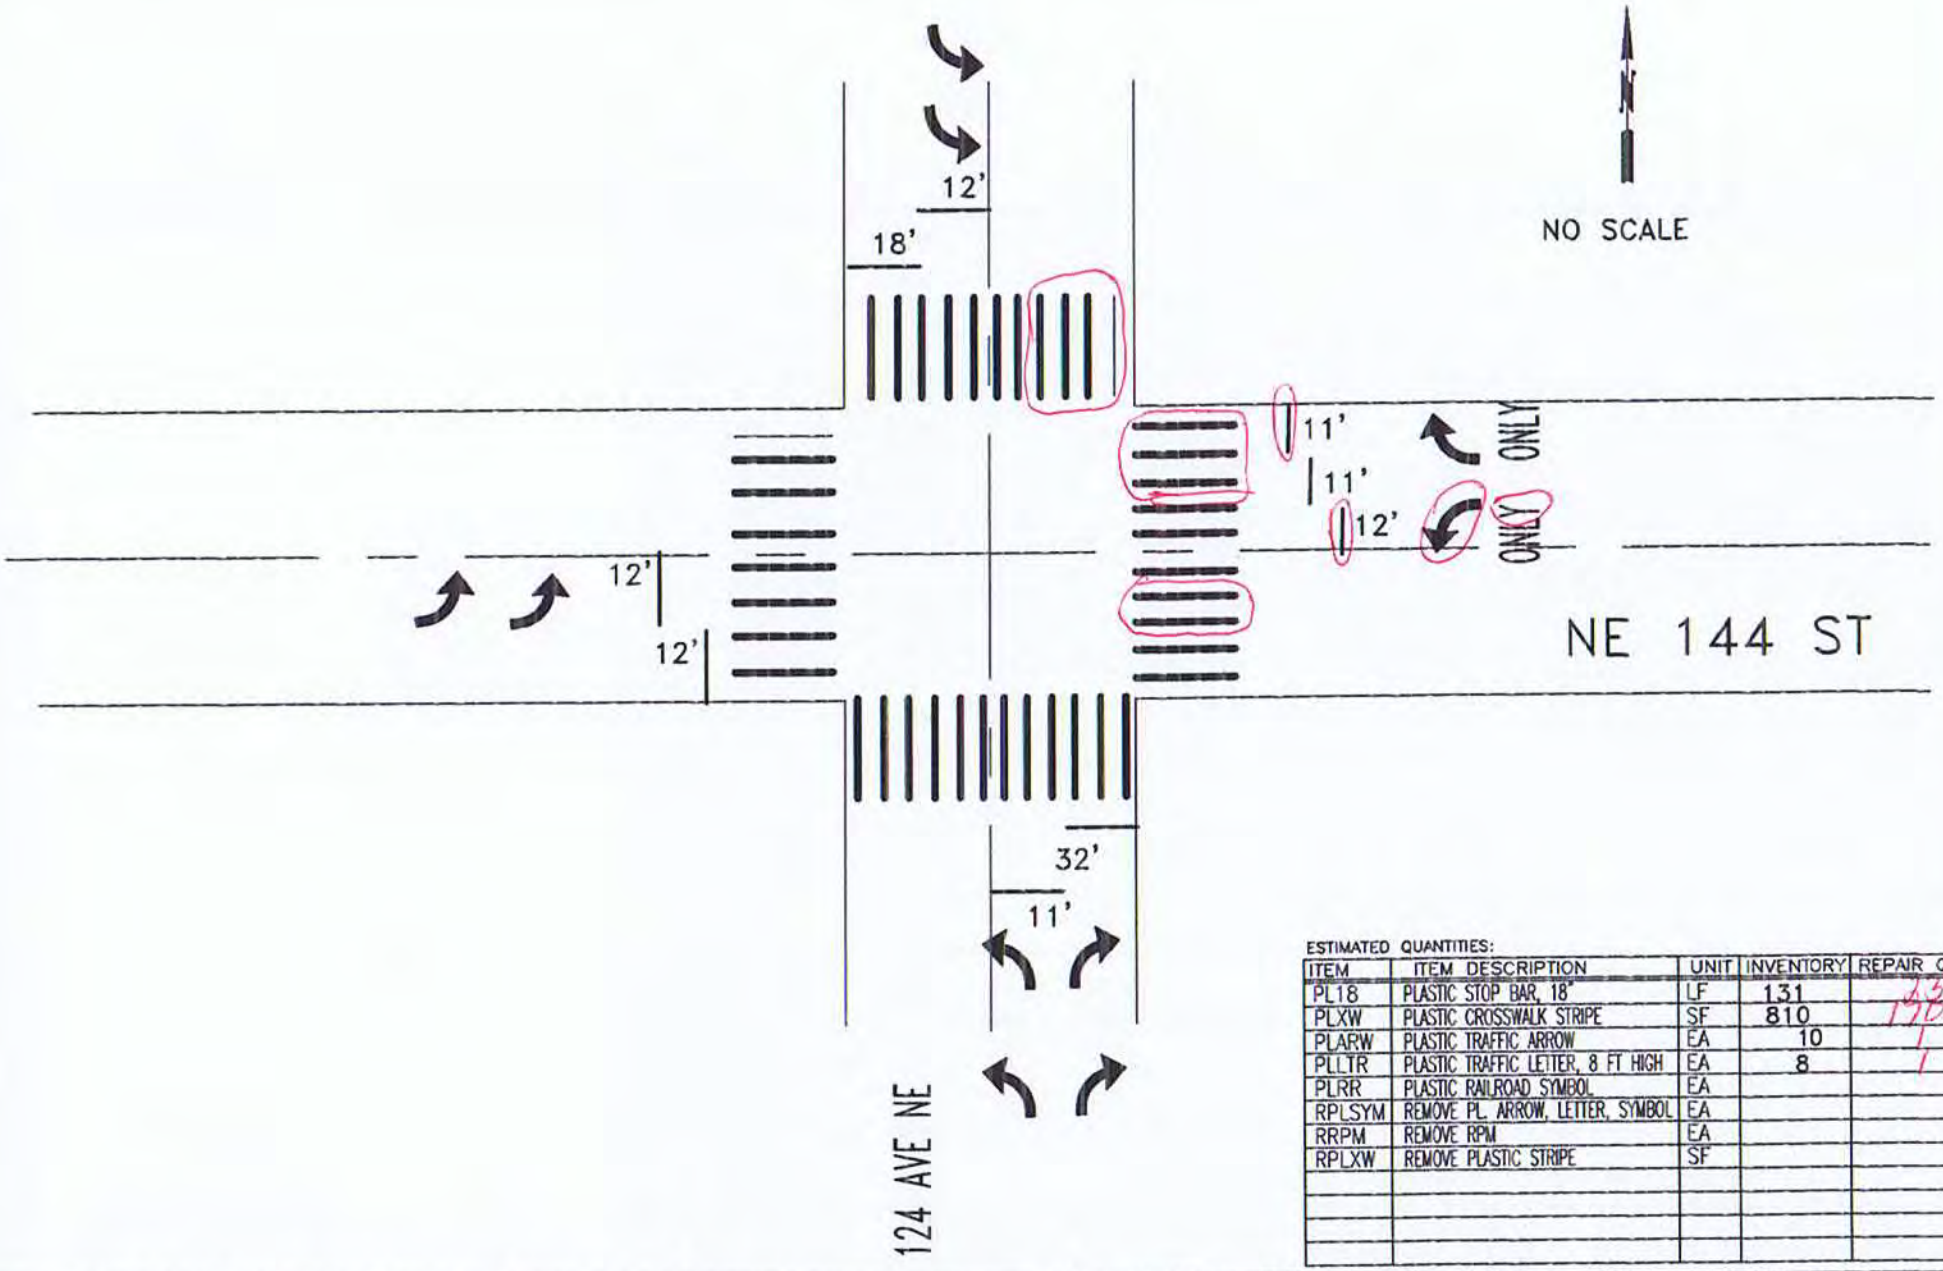

ESTIMATED QUANTITIES:

ITEM	ITEM DESCRIPTION	UNIT	INVENTORY	REPAIR QTY
PL18	PLASTIC STOP BAR, 18"	LF	131	133
PLXW	PLASTIC CROSSWALK STRIPE	SF	810	
PLARW	PLASTIC TRAFFIC ARROW	EA	10	1
PLLTR	PLASTIC TRAFFIC LETTER, 8 FT HIGH	EA	8	1
PLRR	PLASTIC RAILROAD SYMBOL	EA		
RPLSYM	REMOVE PL. ARROW, LETTER, SYMBOL	EA		
RRPM	REMOVE RPM	EA		
RPLXW	REMOVE PLASTIC STRIPE	SF		

CITY OF KIRKLAND WASHINGTON

CITY OF KIRKLAND
DEPARTMENT OF PUBLIC WORKS
123 FIFTH AVENUE KIRKLAND, WA 98033
(425) 587-3800 www.kirklandwa.gov

L KAWAOKA 3/2016
DESIGNED BY: DATE

J.JENNINGS 3/2016
DRAWN BY: DATE

CHECKED BY: DATE


STREET: 124 AVE NE

CROSS STREET: NE 144 ST

SEGMENT:

SCALE: N.T.S.

FILENAME: Page 3-3

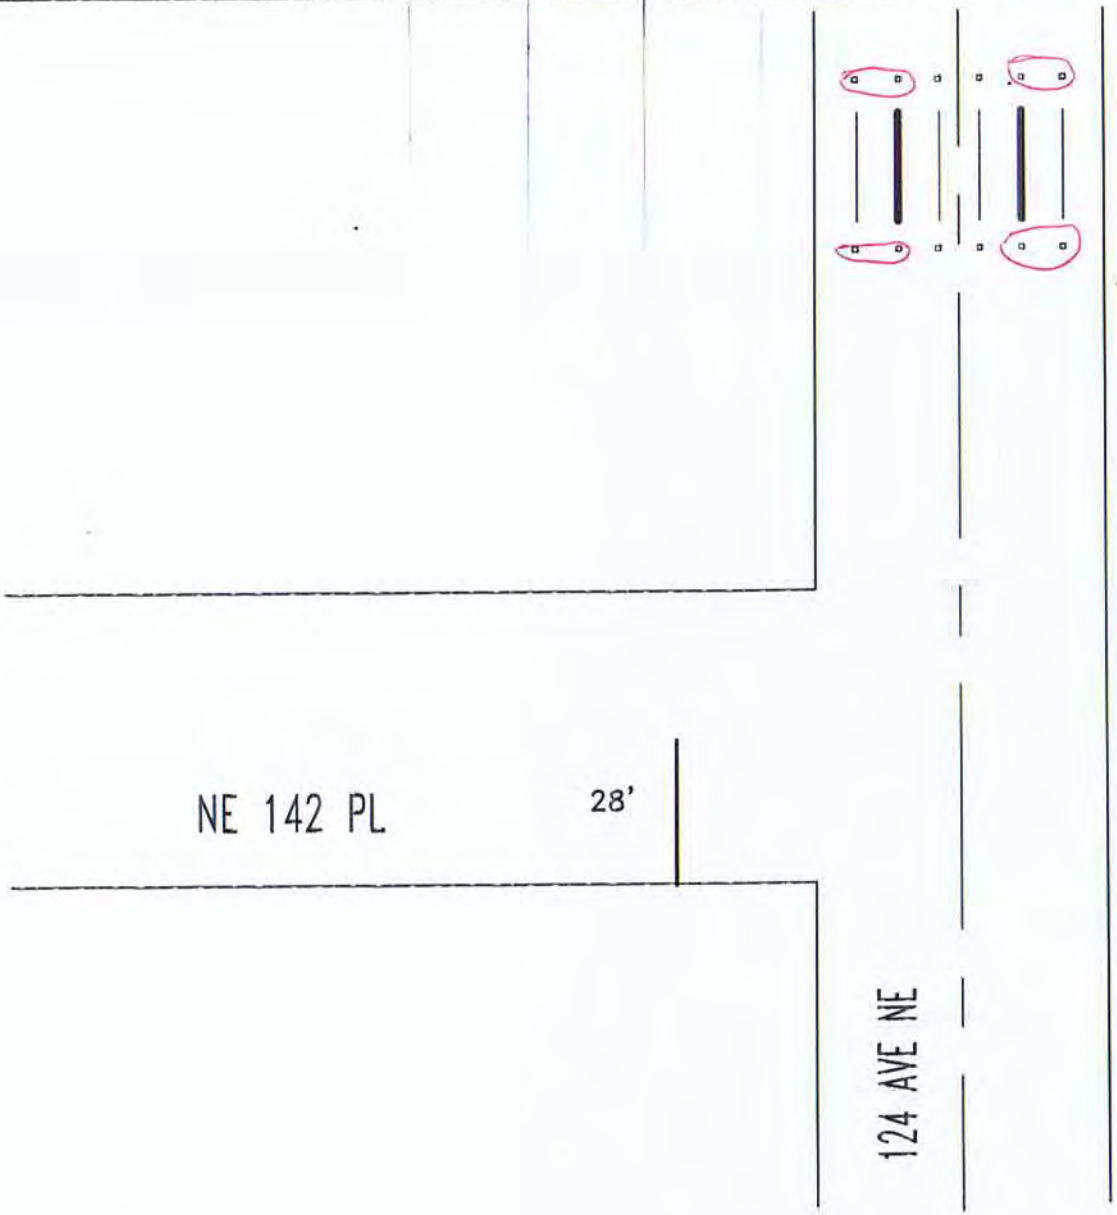

NO SCALE

ESTIMATED QUANTITIES:

ITEM	ITEM DESCRIPTION	UNIT	INVENTORY	REPAIR QTY
PL18	PLASTIC STOP BAR, 18"	LF	28	
PLXW	PLASTIC CROSSWALK STRIPE	SF	80	
PLARW	PLASTIC TRAFFIC ARROW	EA		
PLLTR	PLASTIC TRAFFIC LETTER, 8 FT HIGH	EA		
PLRR	PLASTIC RAILROAD SYMBOL	EA		
RPLSYM	REMOVE PL. ARROW, LETTER, SYMBOL	EA		
RRPM	REMOVE RPM	EA		
RPLXW	REMOVE PLASTIC STRIPE	SF		
	RAISED PAVEMENT MARKER TYPE 2	EA	12	3

CITY OF KIRKLAND WASHINGTON

CITY OF KIRKLAND
DEPARTMENT OF PUBLIC WORKS
123 FIFTH AVENUE KIRKLAND, WA 98033
(425) 587-3800 www.kirklandwa.gov

G. HORTILLOSA 2/2012
DESIGNED BY: DATE

J.JENNINGS 2/2012
DRAWN BY: DATE

CHECKED BY: DATE

2020 PAVEMENT MARKING PROGRAM

STREET: 124 AVE NE

CROSS STREET: NE 142 PL

SEGMENT:

SCALE: N.T.S.

FILENAME: Page 3-5

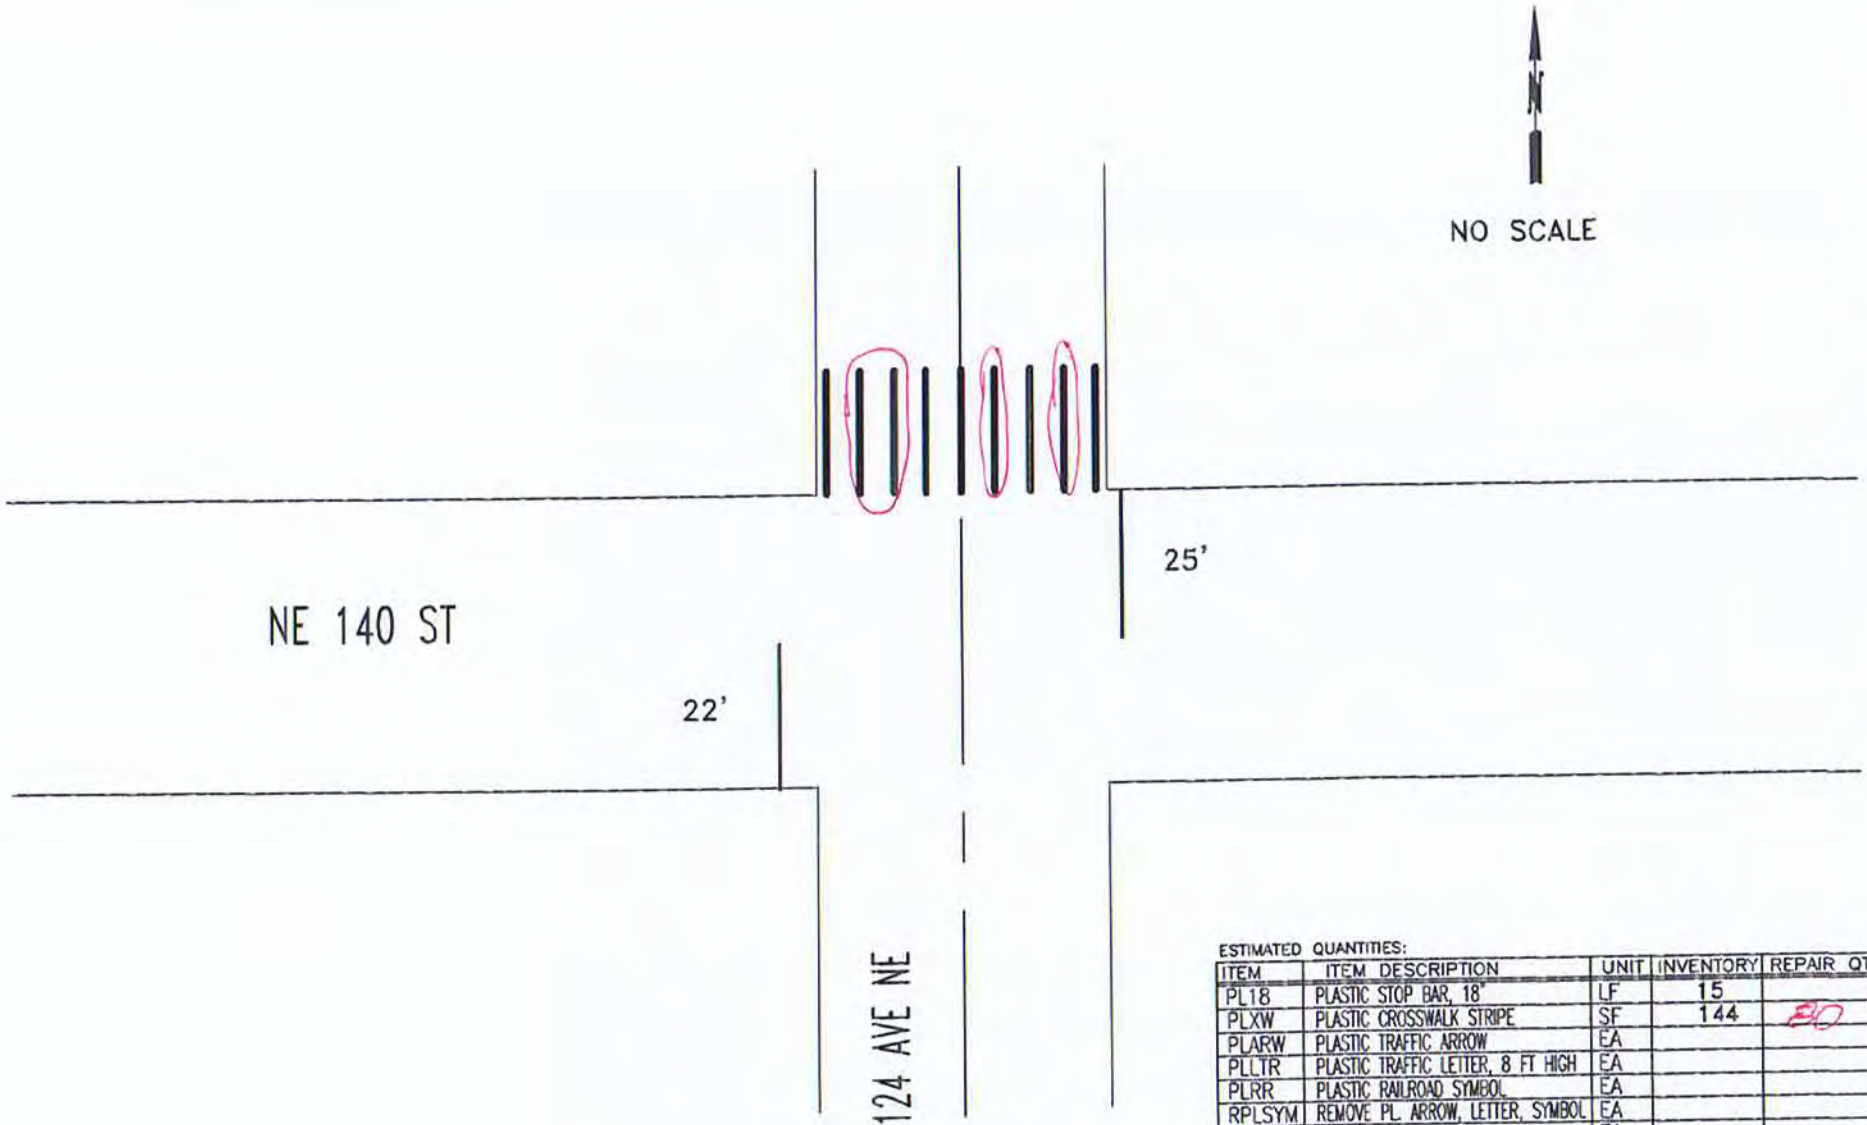

ESTIMATED QUANTITIES:

ITEM	ITEM DESCRIPTION	UNIT	INVENTORY	REPAIR QTY
PL18	PLASTIC STOP BAR, 18"	LF	15	
PLXW	PLASTIC CROSSWALK STRIPE	SF	144	20
PLARW	PLASTIC TRAFFIC ARROW	EA		
PLLTR	PLASTIC TRAFFIC LETTER, 8 FT HIGH	EA		
PLRR	PLASTIC RAILROAD SYMBOL	EA		
RPLSYM	REMOVE PL. ARROW, LETTER, SYMBOL	EA		
RRPM	REMOVE RPM	EA		
RPLXW	REMOVE PLASTIC STRIPE	SF		

CITY OF KIRKLAND WASHINGTON

CITY OF KIRKLAND
DEPARTMENT OF PUBLIC WORKS
123 FIFTH AVENUE KIRKLAND, WA 98033
(425) 587-3800 www.kirklandwa.gov

G. HORTILLOSA 2/2012
DESIGNED BY: DATE

J.JENNINGS 2/2012
DRAWN BY: DATE

CHECKED BY: DATE

2020 PAVEMENT MARKING PROGRAM

STREET: 124 AVE NE

CROSS STREET: NE 140 ST

SEGMENT:

SCALE: N.T.S.

FILENAME:

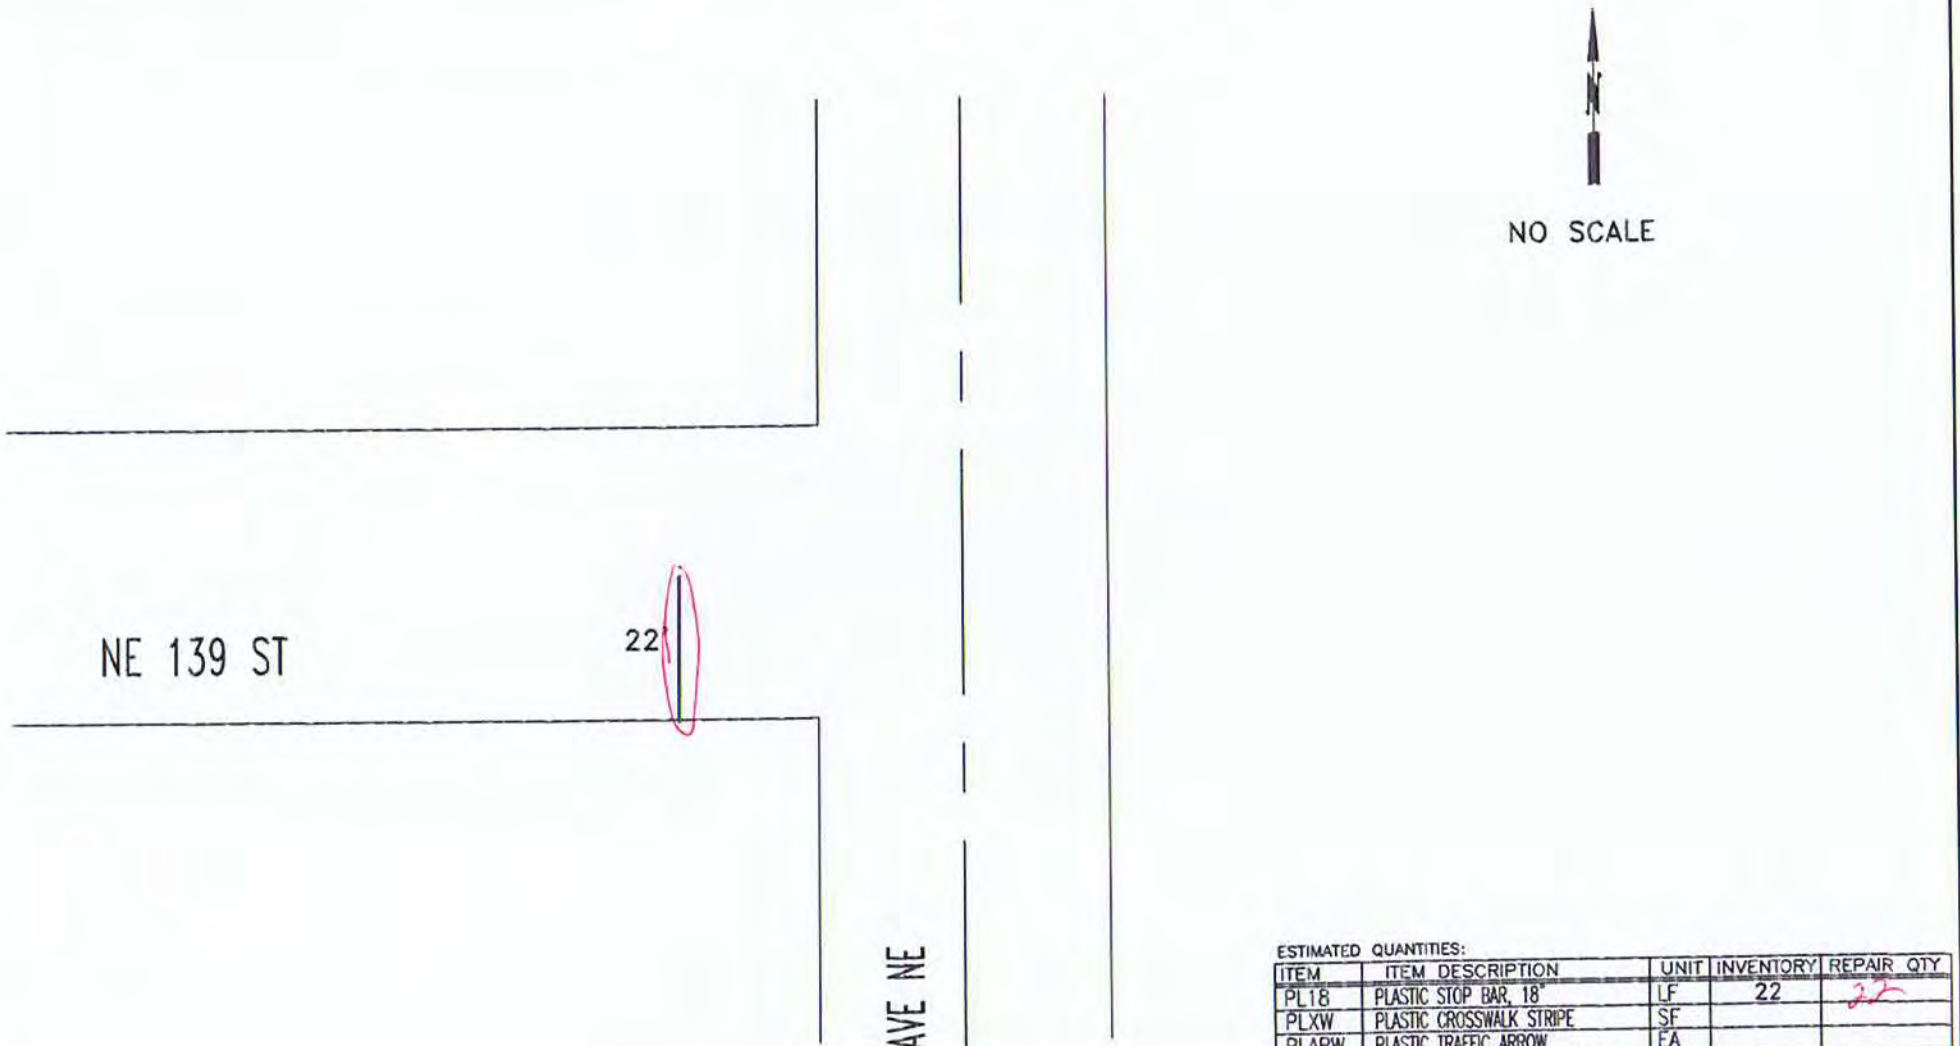

ESTIMATED QUANTITIES:

ITEM	ITEM DESCRIPTION	UNIT	INVENTORY	REPAIR QTY
PL18	PLASTIC STOP BAR, 18"	LF	22	22
PLXW	PLASTIC CROSSWALK STRIPE	SF		
PLARW	PLASTIC TRAFFIC ARROW	EA		
PLLTR	PLASTIC TRAFFIC LETTER, 8 FT HIGH	EA		
PLRR	PLASTIC RAILROAD SYMBOL	EA		
RPLSYM	REMOVE PL. ARROW, LETTER, SYMBOL	EA		
RRPM	REMOVE RPM	EA		
RPLXW	REMOVE PLASTIC STRIPE	SF		

CITY OF KIRKLAND
DEPARTMENT OF PUBLIC WORKS
123 FIFTH AVENUE KIRKLAND, WA 98033
(425) 587-3800 www.kirklandwa.gov

G. HORTILLOSA 2/2012
DESIGNED BY: DATE

J.JENNINGS 2/2012
DRAWN BY: DATE

CHECKED BY: DATE


STREET: 124 AVE NE

CROSS STREET: NE 139 ST

SEGMENT:

SCALE: N.T.S.

FILENAME: Page 3-10

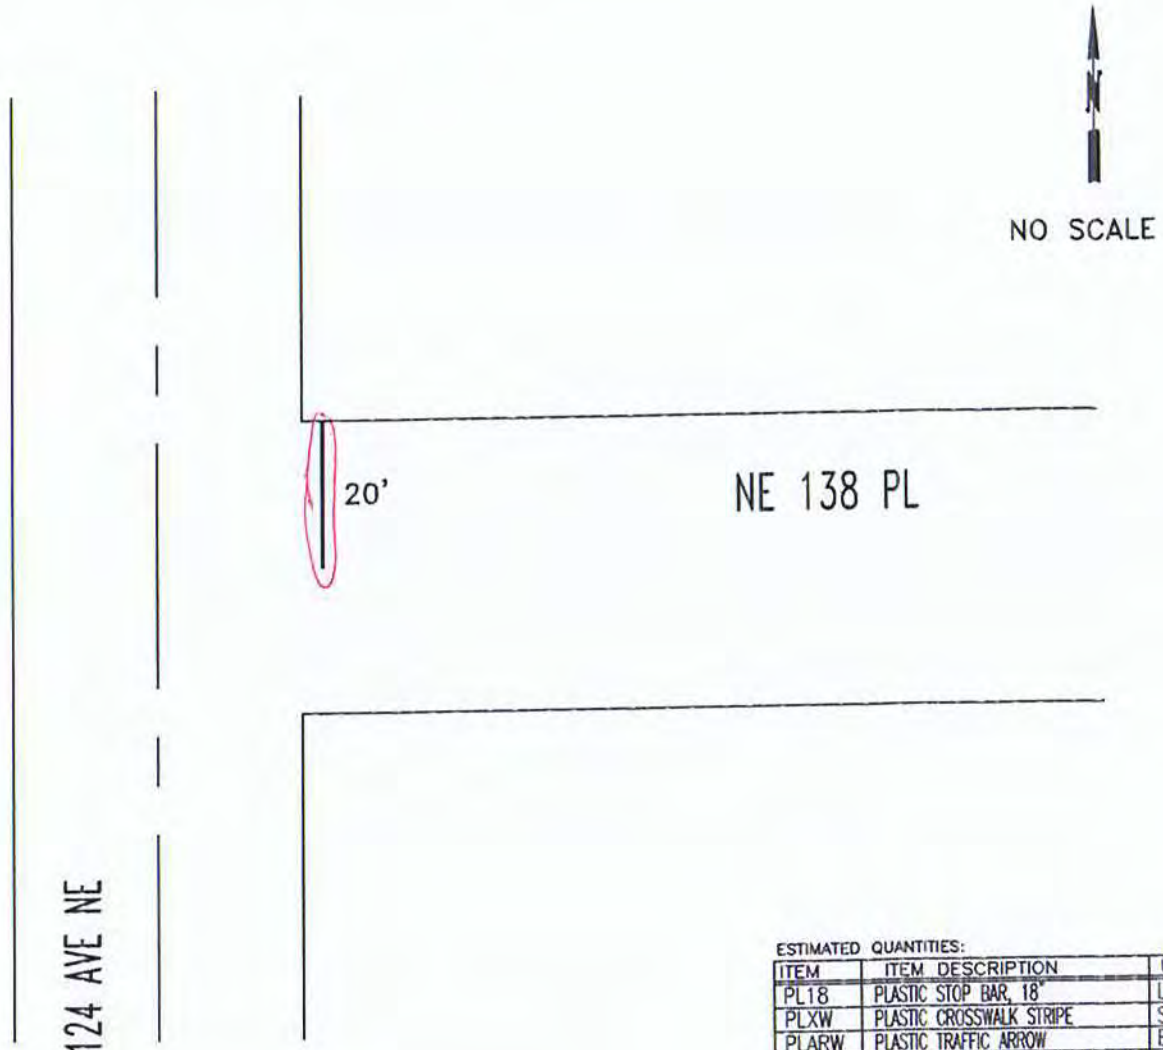

ESTIMATED QUANTITIES:

ITEM	ITEM DESCRIPTION	UNIT	INVENTORY	REPAIR QTY
PL18	PLASTIC STOP BAR, 18"	LF	20'	20
PLXW	PLASTIC CROSSWALK STRIPE	SF		
PLARW	PLASTIC TRAFFIC ARROW	EA		
PLLTR	PLASTIC TRAFFIC LETTER, 8 FT HIGH	EA		
PLRR	PLASTIC RAILROAD SYMBOL	EA		
RPLSYM	REMOVE PL ARROW, LETTER, SYMBOL	EA		
RRPM	REMOVE RPM	EA		
RPLXW	REMOVE PLASTIC STRIPE	SF		

CITY OF KIRKLAND
DEPARTMENT OF PUBLIC WORKS
123 FIFTH AVENUE KIRKLAND, WA 98033
(425) 587-3800 www.kirklandwa.gov

G. HORTILLOSA 2/2012
DESIGNED BY: DATE

J.JENNINGS 2/2012
DRAWN BY: DATE

CHECKED BY: DATE

2020 PAVEMENT MARKING PROGRAM

STREET: 124 AVE NE

CROSS STREET: NE 138 PL

SEGMENT:

SCALE: N.T.S.

FILENAME: Page 3-11

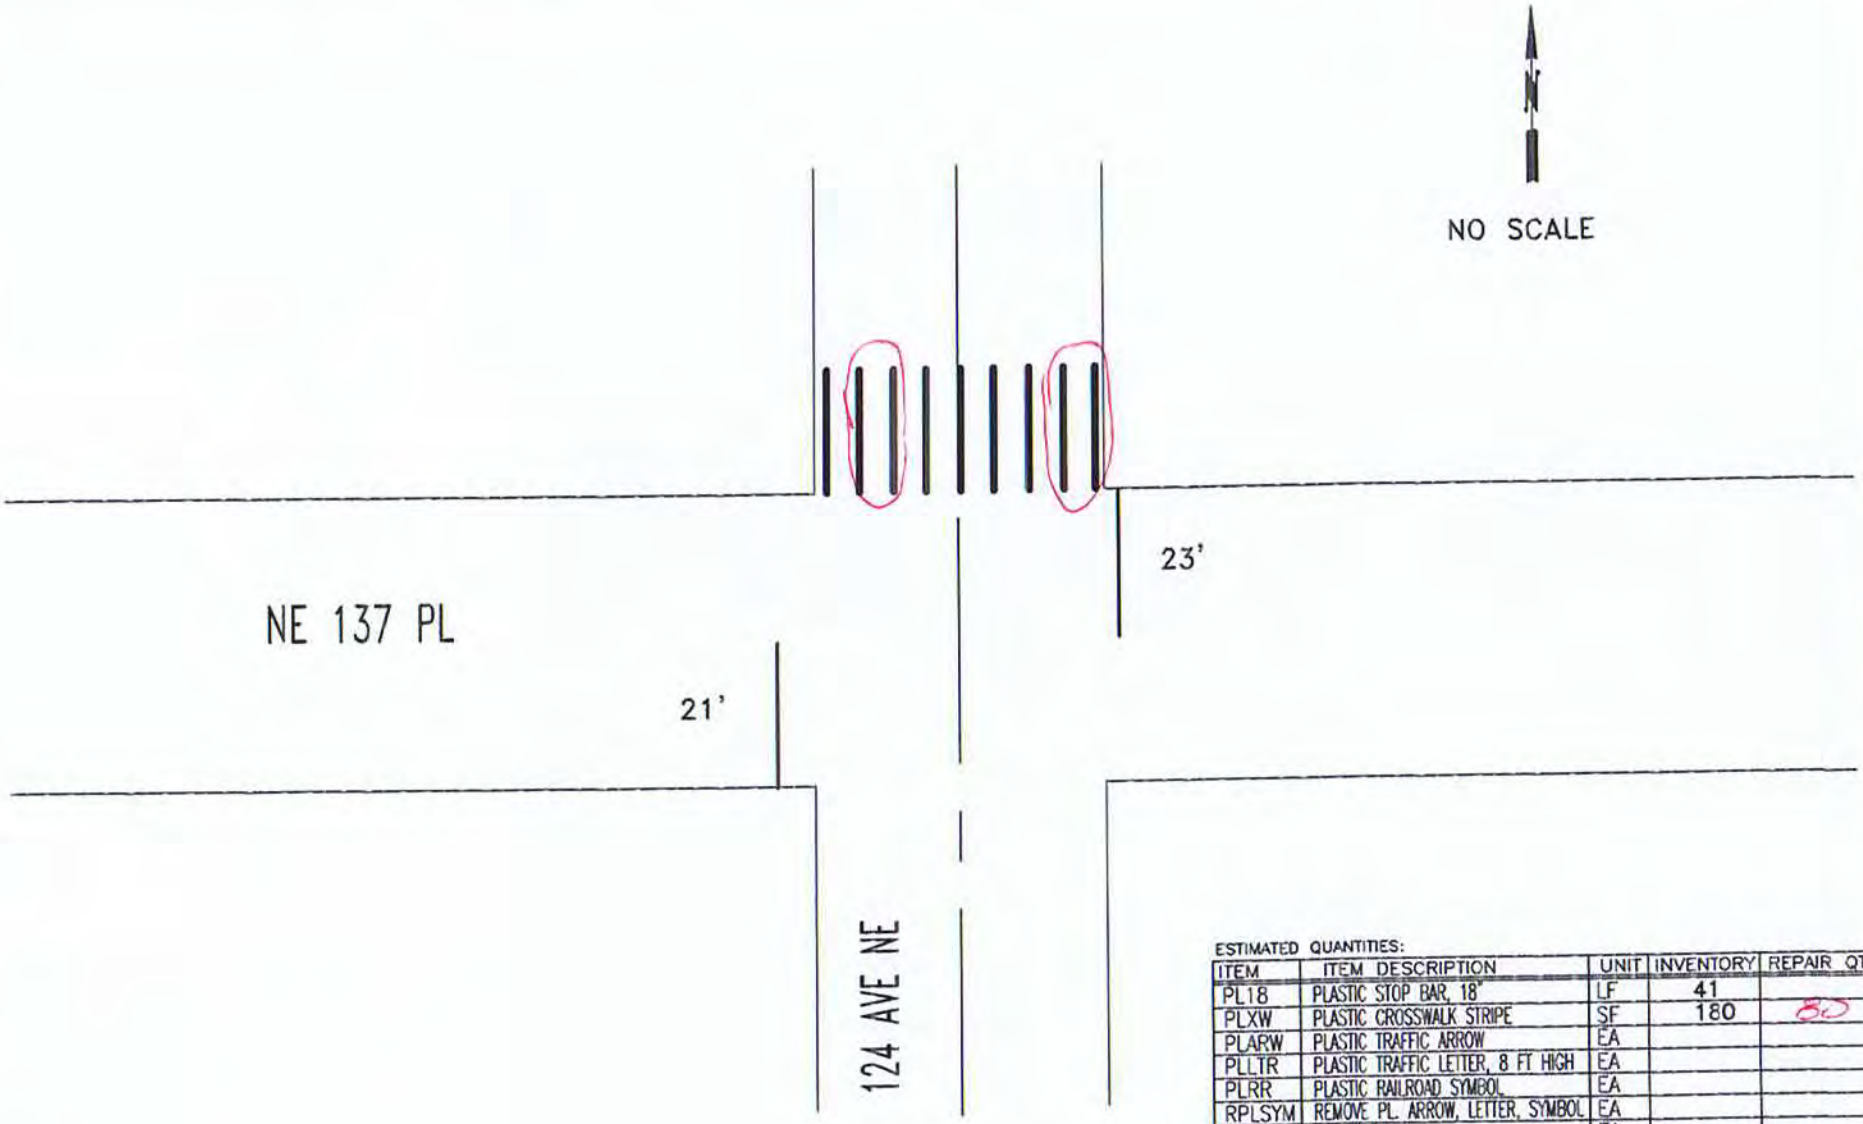

ESTIMATED QUANTITIES:

ITEM	ITEM DESCRIPTION	UNIT	INVENTORY	REPAIR QTY
PL18	PLASTIC STOP BAR, 18"	LF	41	
PLXW	PLASTIC CROSSWALK STRIPE	SF	180	80
PLARW	PLASTIC TRAFFIC ARROW	EA		
PLLTR	PLASTIC TRAFFIC LETTER, 8 FT HIGH	EA		
PLRR	PLASTIC RAILROAD SYMBOL	EA		
RPLSYM	REMOVE PL. ARROW, LETTER, SYMBOL	EA		
RRPM	REMOVE RPM	EA		
RPLXW	REMOVE PLASTIC STRIPE	SF		

CITY OF KIRKLAND WASHINGTON

CITY OF KIRKLAND
DEPARTMENT OF PUBLIC WORKS
123 FIFTH AVENUE KIRKLAND, WA 98033
(425) 587-3800 www.kirklandwa.gov

G. HORTILLOSA 2/2012
DESIGNED BY: DATE

J.JENNINGS 2/2012
DRAWN BY: DATE

CHECKED BY: DATE

2020 PAVEMENT MARKING PROGRAM

STREET: 124 AVE NE

CROSS STREET: NE 137 PL

SEGMENT:

SCALE: N.T.S.

FILENAME:

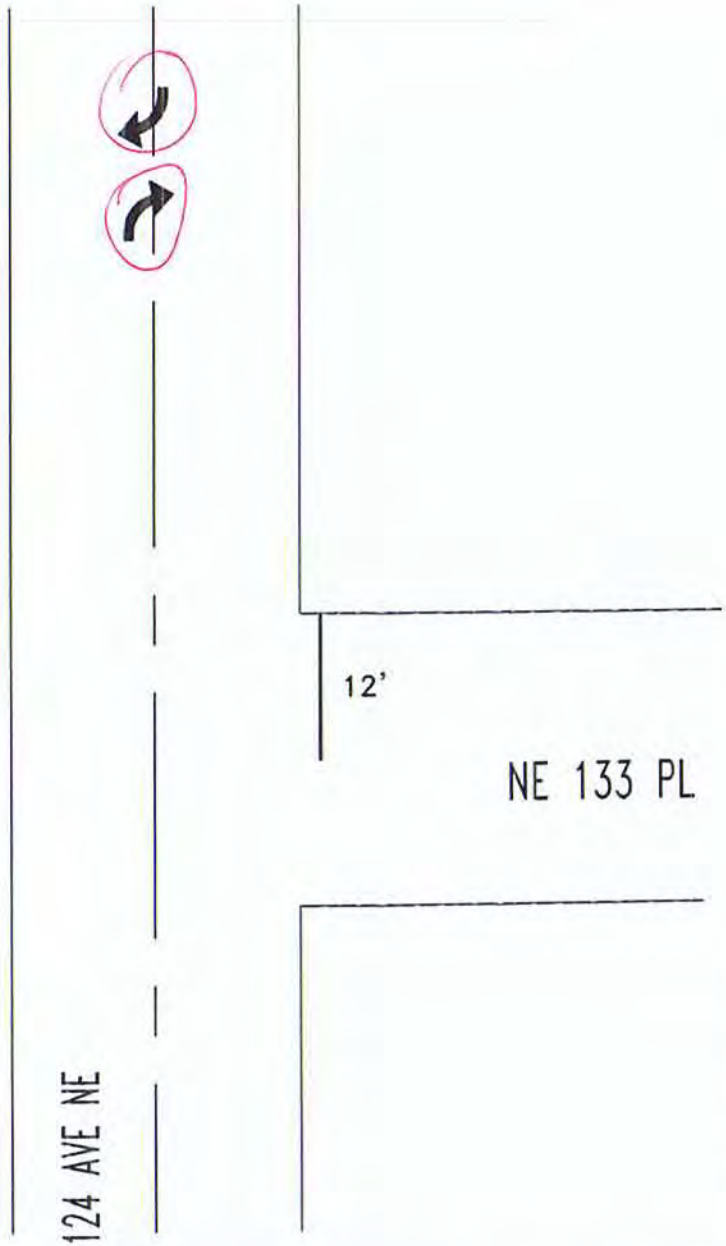

NO SCALE

ESTIMATED QUANTITIES:

ITEM	ITEM DESCRIPTION	UNIT	INVENTORY	REPAIR QTY
PL18	PLASTIC STOP BAR, 18"	LF	12	
PLXW	PLASTIC CROSSWALK STRIPE	SF		
PLARW	PLASTIC TRAFFIC ARROW	EA		2
PLLTR	PLASTIC TRAFFIC LETTER, 8 FT HIGH	EA		
PLRR	PLASTIC RAILROAD SYMBOL	EA		
RPLSYM	REMOVE PL. ARROW, LETTER, SYMBOL	EA		
RRPM	REMOVE RPM	EA		
RPLXW	REMOVE PLASTIC STRIPE	SF		

CITY OF KIRKLAND WASHINGTON

CITY OF KIRKLAND
DEPARTMENT OF PUBLIC WORKS
123 FIFTH AVENUE KIRKLAND, WA 98033
(425) 587-3800 www.kirklandwa.gov

G. HORTILLOSA 2/2012
DESIGNED BY: DATE

J.JENNINGS 2/2012
DRAWN BY: DATE

CHECKED BY: DATE

2020 PAVEMENT MARKING PROGRAM

STREET: 124 AVE NE

CROSS STREET: NE 133 PL

SEGMENT:

SCALE: N.T.S.

FILENAME: Page 3-15

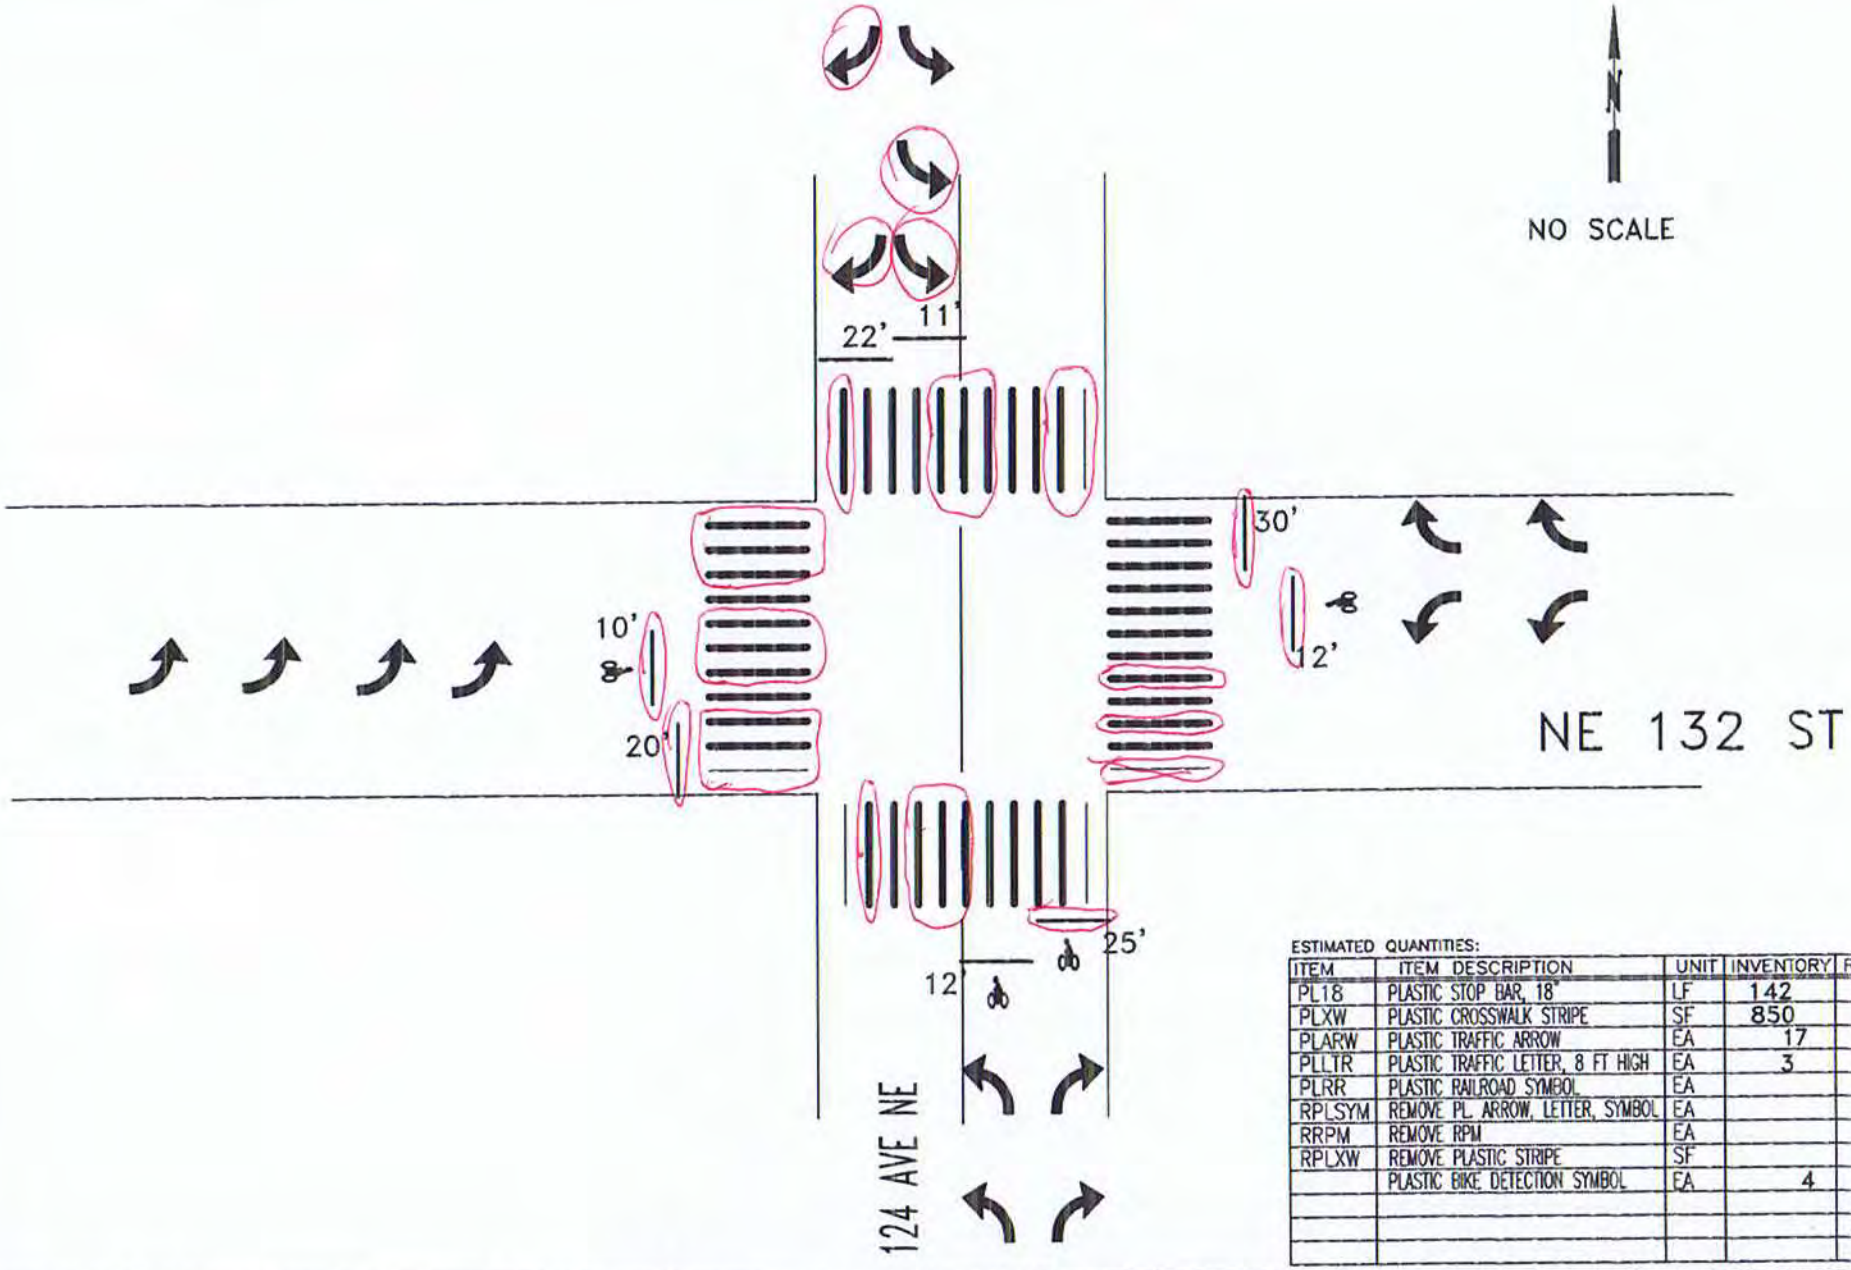

ESTIMATED QUANTITIES:

ITEM	ITEM DESCRIPTION	UNIT	INVENTORY	REPAIR QTY
PL18	PLASTIC STOP BAR, 18"	LF	142	78
PLXW	PLASTIC CROSSWALK STRIPE	SF	850	478
PLARW	PLASTIC TRAFFIC ARROW	EA	17	
PLLTR	PLASTIC TRAFFIC LETTER, 8 FT HIGH	EA	3	4
PLRR	PLASTIC RAILROAD SYMBOL	EA		
RPLSYM	REMOVE PL. ARROW, LETTER, SYMBOL	EA		
RRPM	REMOVE RPM	EA		
RPLXW	REMOVE PLASTIC STRIPE	SF		100
	PLASTIC BIKE DETECTION SYMBOL	EA	4	

CITY OF KIRKLAND WASHINGTON

CITY OF KIRKLAND
DEPARTMENT OF PUBLIC WORKS
123 FIFTH AVENUE KIRKLAND, WA 98033
(425) 587-3800 www.kirklandwa.gov

G. HORTILLOSA 2/2012
DESIGNED BY: DATE

J.JENNINGS 2/2012
DRAWN BY: DATE

CHECKED BY: DATE

2022 PAVEMENT MARKING PROGRAM

STREET: 124 AVE NE

CROSS STREET: NE 132 ST

SEGMENT:

SCALE: N.T.S.

FILENAME: Page 3-16

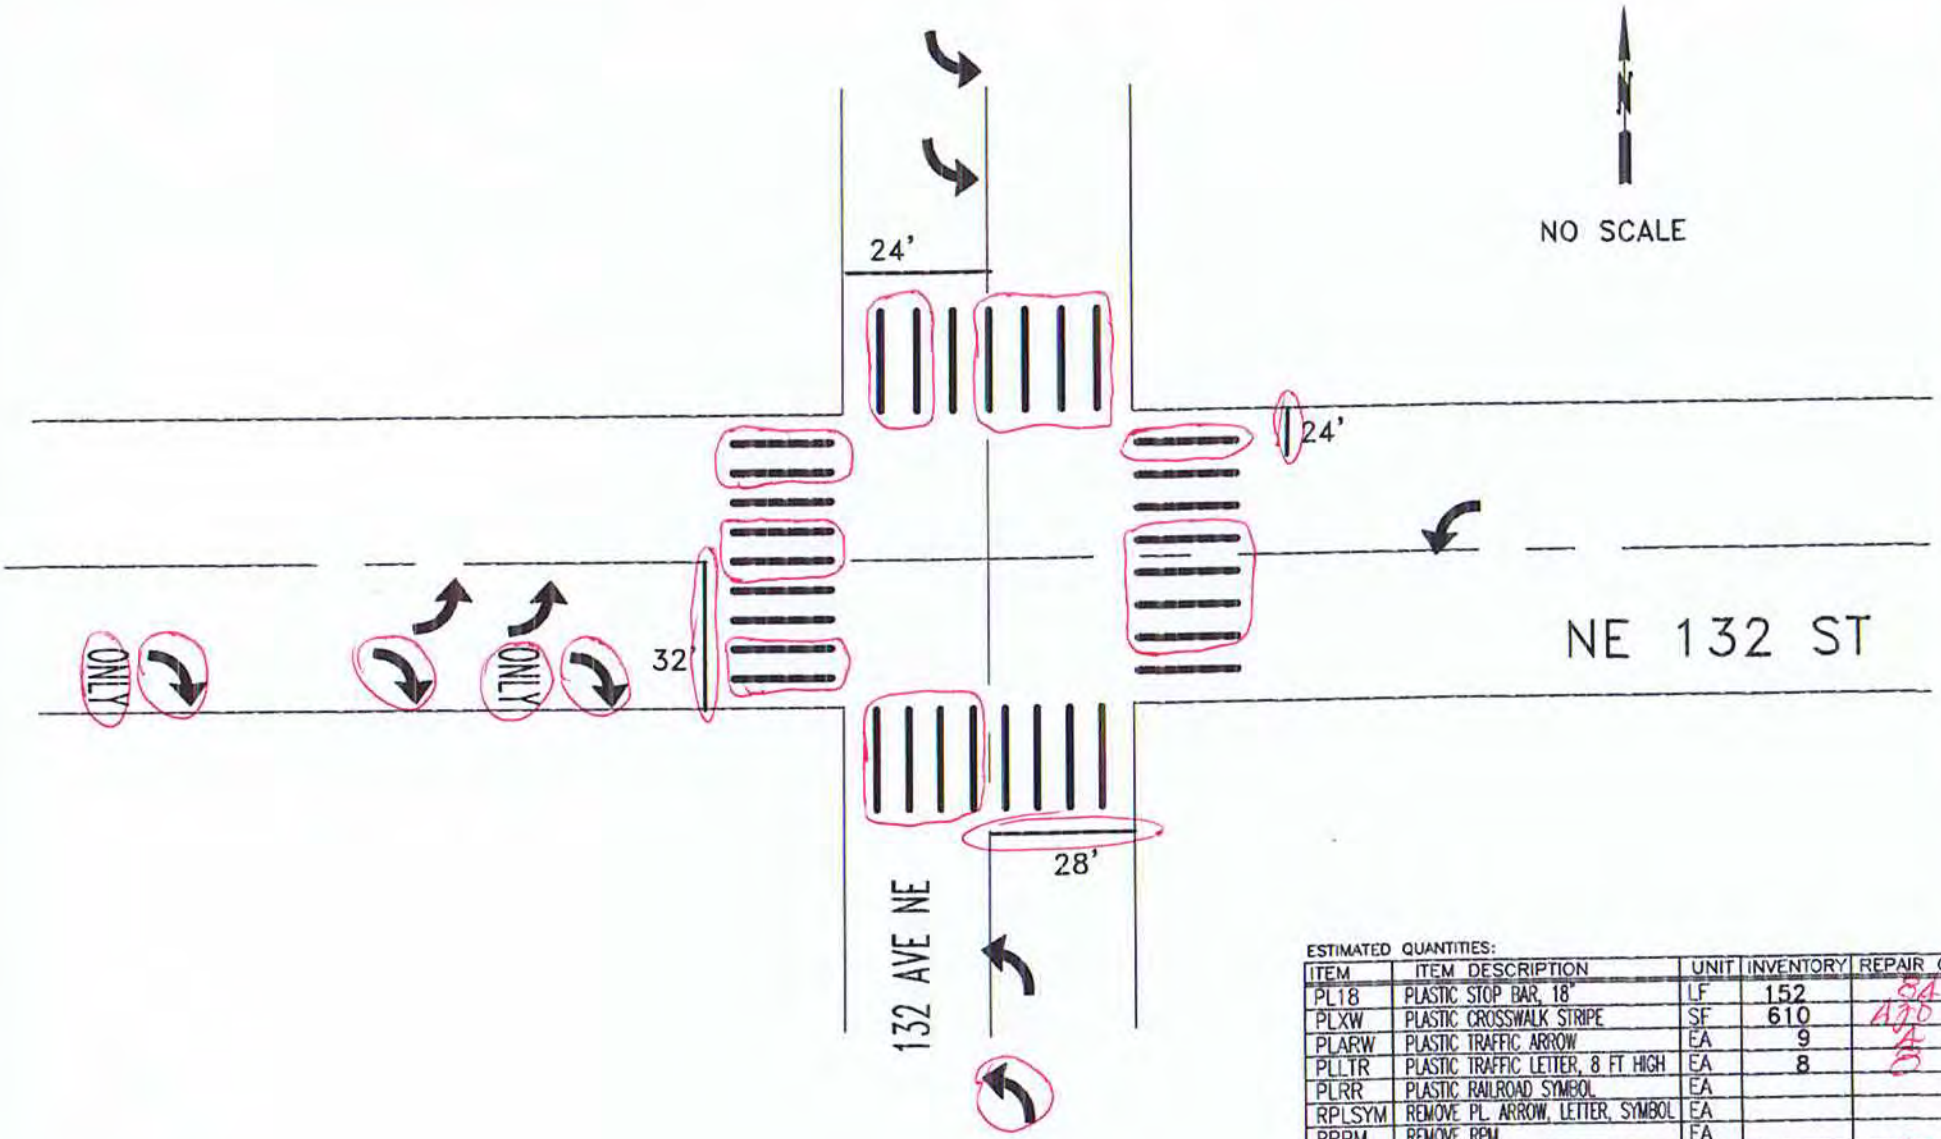

ESTIMATED QUANTITIES:

ITEM	ITEM DESCRIPTION	UNIT	INVENTORY	REPAIR QTY
PL18	PLASTIC STOP BAR, 18"	LF	152	84
PLXW	PLASTIC CROSSWALK STRIPE	SF	610	470
PLARW	PLASTIC TRAFFIC ARROW	EA	9	4
PLLTR	PLASTIC TRAFFIC LETTER, 8 FT HIGH	EA	8	3
PLRR	PLASTIC RAILROAD SYMBOL	EA		
RPLSYM	REMOVE PL. ARROW, LETTER, SYMBOL	EA		
RRPM	REMOVE RPM	EA		
RPLXW	REMOVE PLASTIC STRIPE	SF		140

CITY OF KIRKLAND WASHINGTON

CITY OF KIRKLAND
DEPARTMENT OF PUBLIC WORKS
123 FIFTH AVENUE KIRKLAND, WA 98033
(425) 587-3800 www.kirklandwa.gov

L KAWAOKA 3/2016
DESIGNED BY: DATE

J.JENNINGS 3/2016
DRAWN BY: DATE

CHECKED BY: DATE

2012 PAVEMENT MARKING PROGRAM

STREET: NE 132ND ST

CROSS STREET: 132ND AVE NE

SEGMENT:

SCALE: N.T.S.

FILENAME: Page 3-17

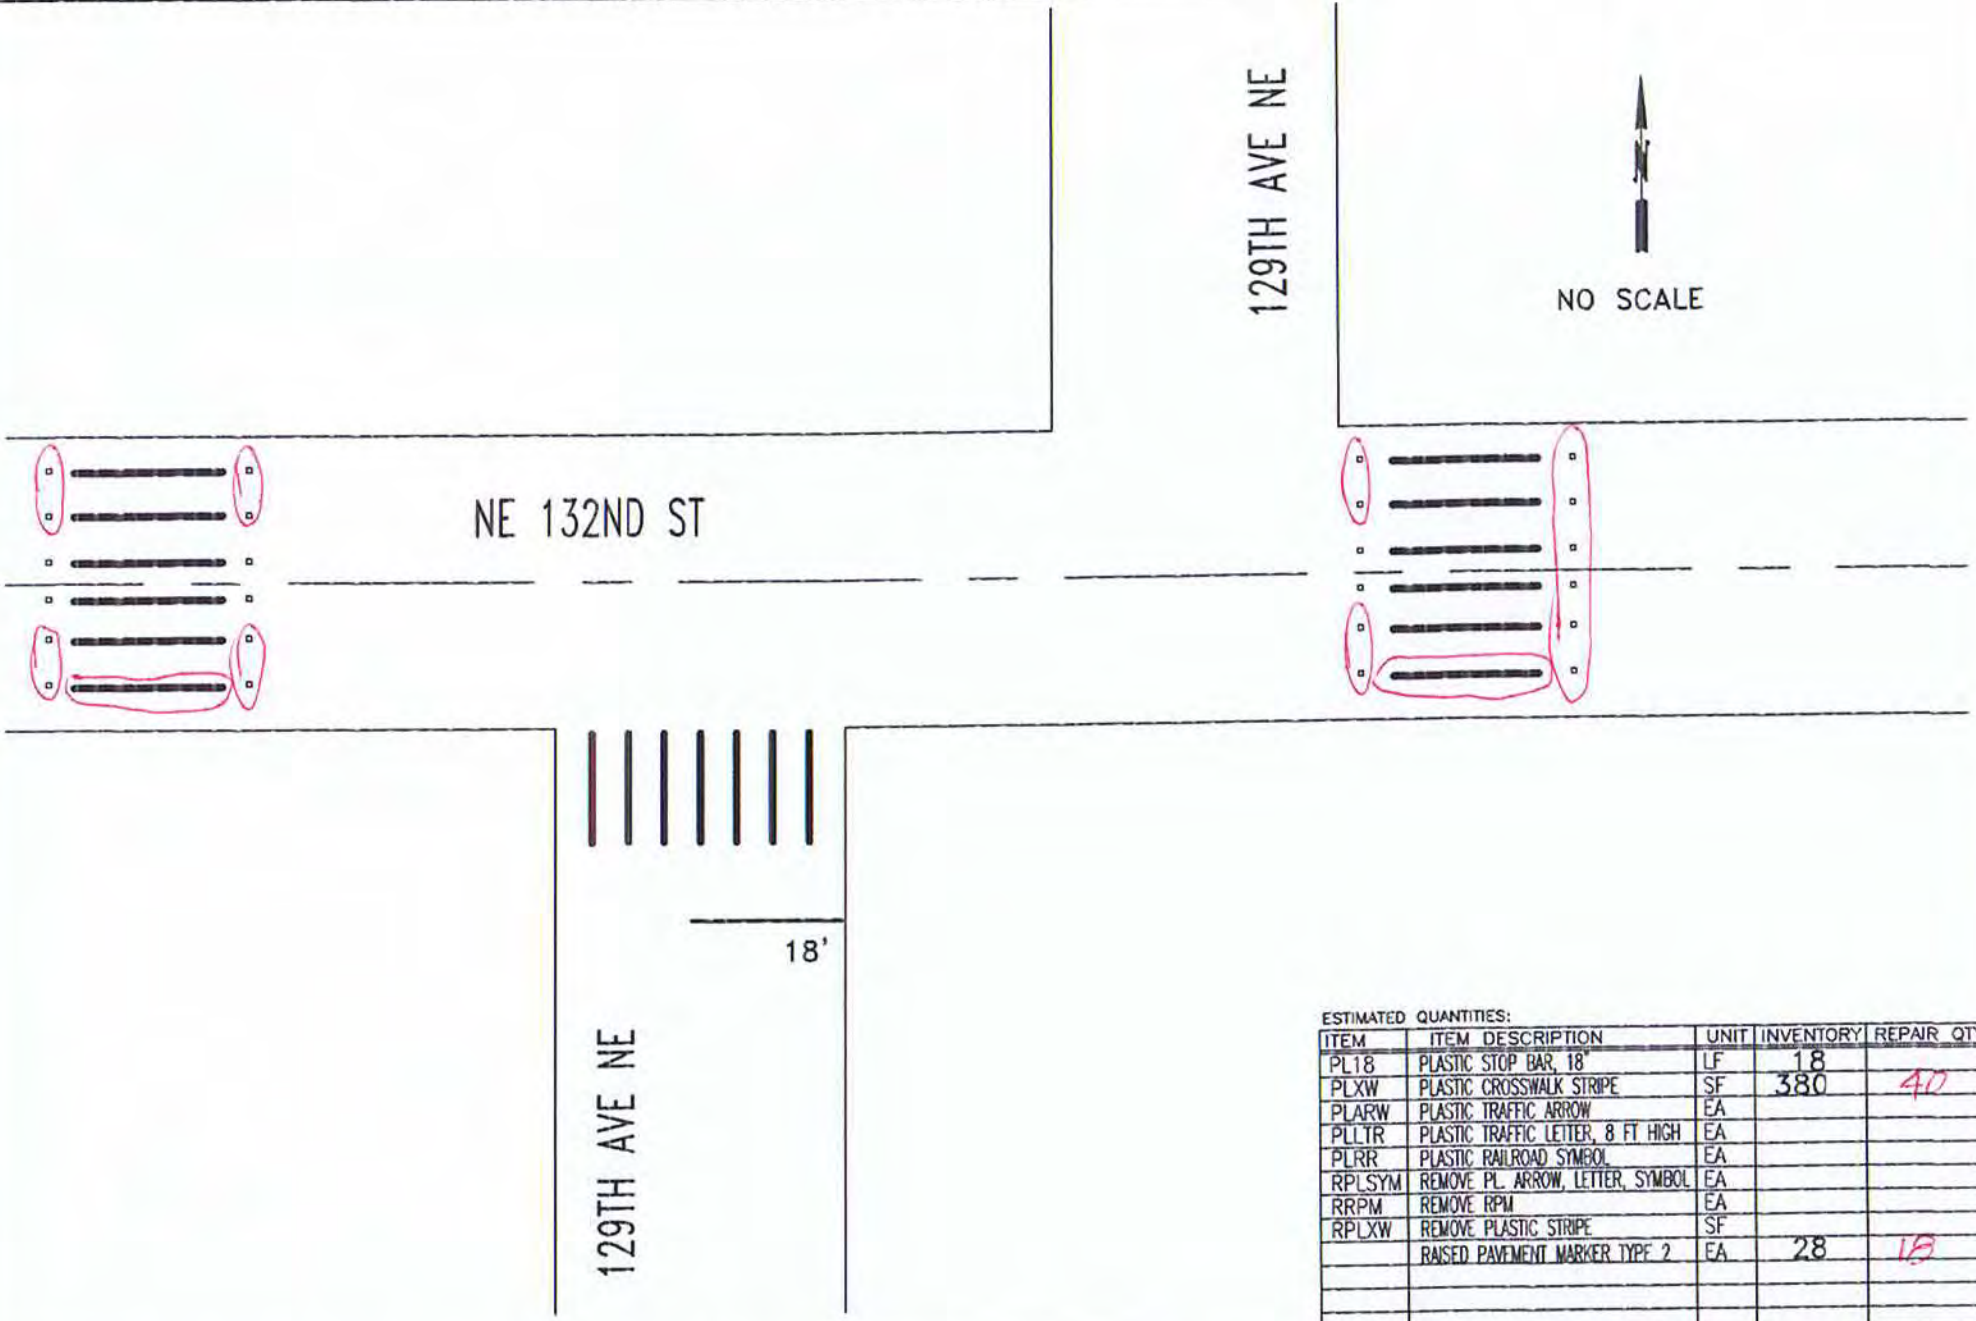

ESTIMATED QUANTITIES:

ITEM	ITEM DESCRIPTION	UNIT	INVENTORY	REPAIR QTY
PL18	PLASTIC STOP BAR, 18"	LF	18	
PLXW	PLASTIC CROSSWALK STRIPE	SF	380	40
PLARW	PLASTIC TRAFFIC ARROW	EA		
PLLTR	PLASTIC TRAFFIC LETTER, 8 FT HIGH	EA		
PLRR	PLASTIC RAILROAD SYMBOL	EA		
RPLSYM	REMOVE PL. ARROW, LETTER, SYMBOL	EA		
RRPM	REMOVE RPM	EA		
RPLXW	REMOVE PLASTIC STRIPE	SF		
	RAISED PAVEMENT MARKER TYPE 2	EA	28	18

CITY OF KIRKLAND
DEPARTMENT OF PUBLIC WORKS
123 FIFTH AVENUE KIRKLAND, WA 98033
(425) 587-3800 www.kirklandwa.gov

G. HORTILLOSA 8/2013
DESIGNED BY: DATE

J.JENNINGS 8/2013
DRAWN BY: DATE

CHECKED BY: DATE

2020 PAVEMENT MARKING PROGRAM

STREET: NE 132ND ST

CROSS STREET: 129TH AVE NE

SEGMENT:

SCALE: N.T.S.

FILENAME: Page 3-18

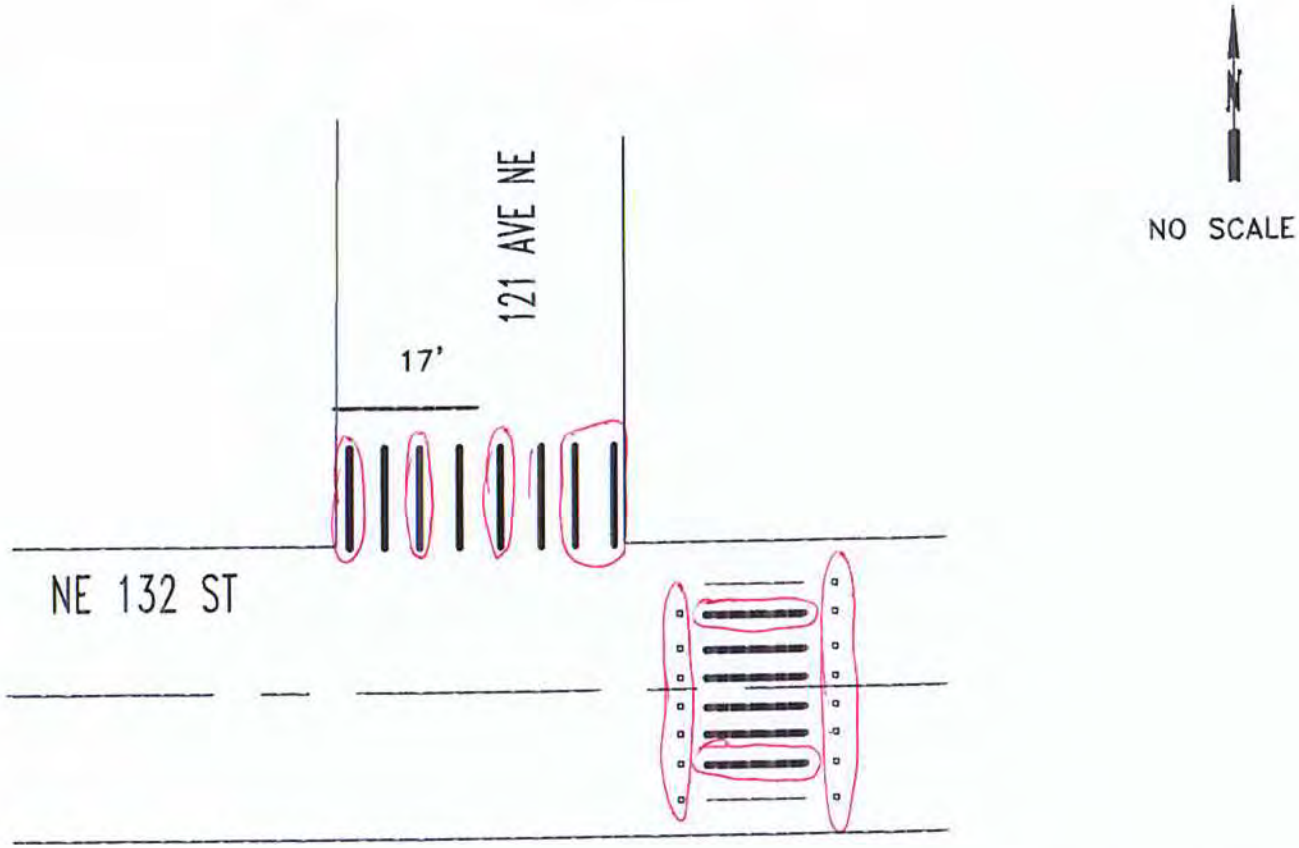

ESTIMATED QUANTITIES:

ITEM	ITEM DESCRIPTION	UNIT	INVENTORY	REPAIR QTY
PL18	PLASTIC STOP BAR, 18"	LF	17	
PLXW	PLASTIC CROSSWALK STRIPE	SF	300	140
PLARW	PLASTIC TRAFFIC ARROW	EA		
PLLTR	PLASTIC TRAFFIC LETTER, 8 FT HIGH	EA		
PLRR	PLASTIC RAILROAD SYMBOL	EA		
RPLSYM	REMOVE PL. ARROW, LETTER, SYMBOL	EA		
RRPM	REMOVE RPM	EA		
RPLXW	REMOVE PLASTIC STRIPE	SF		
	RAISED PAVEMENT MARKER TYPE 2	EA	15	15

CITY OF KIRKLAND
DEPARTMENT OF PUBLIC WORKS
123 FIFTH AVENUE KIRKLAND, WA 98033
(425) 587-3800 www.kirklandwa.gov

G. HORTILLOSA 2/2012
DESIGNED BY: DATE

J.JENNINGS 2/2012
DRAWN BY: DATE

CHECKED BY: DATE

2020 PAVEMENT MARKING PROGRAM

STREET: NE 132 ST

CROSS STREET: 121 AVE NE

SEGMENT:

SCALE: N.T.S.

FILENAME:

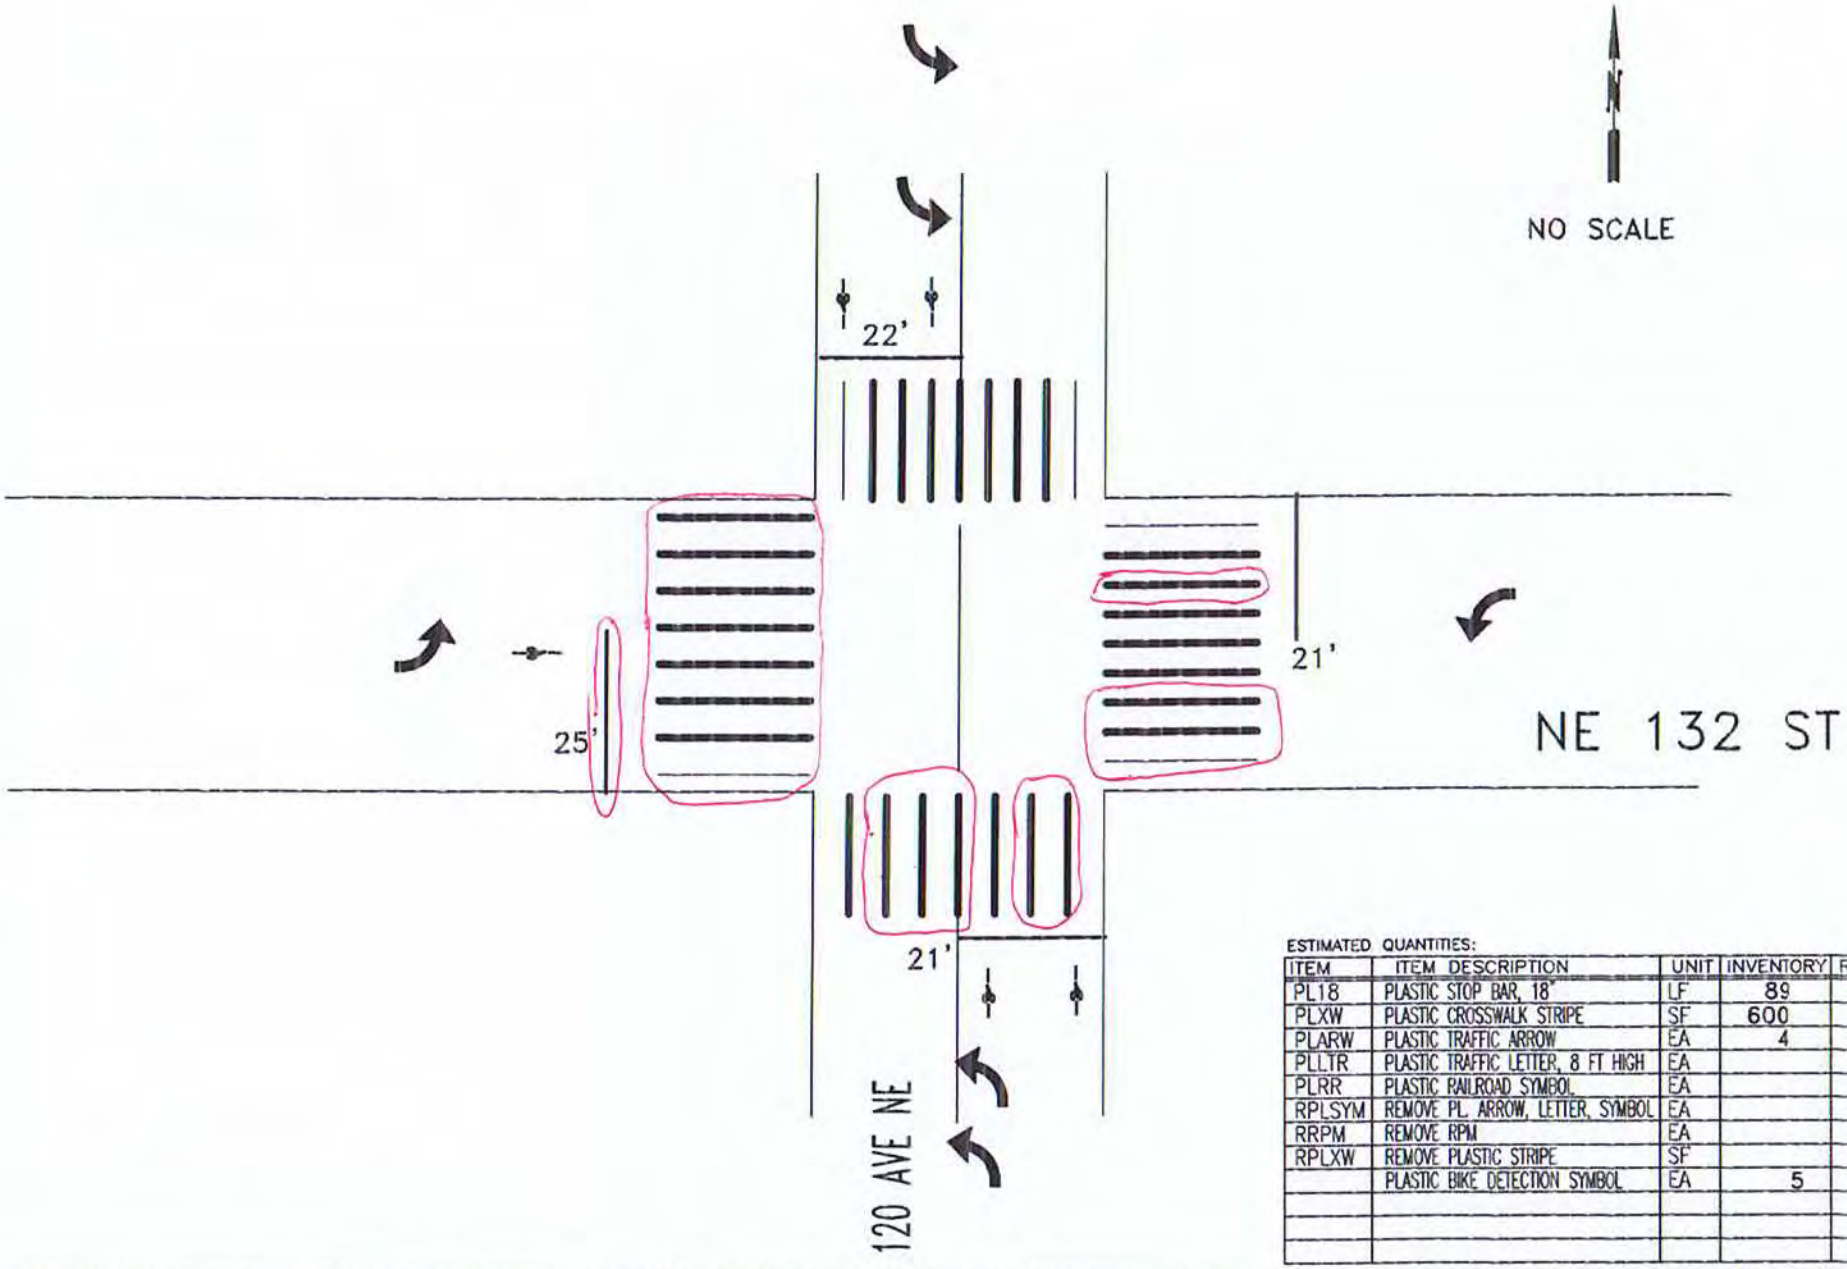

ESTIMATED QUANTITIES:

ITEM	ITEM DESCRIPTION	UNIT	INVENTORY	REPAIR QTY
PL18	PLASTIC STOP BAR, 18"	LF	89	25
PLXW	PLASTIC CROSSWALK STRIPE	SF	600	320
PLARW	PLASTIC TRAFFIC ARROW	EA	4	
PLLTR	PLASTIC TRAFFIC LETTER, 8 FT HIGH	EA		
PLRR	PLASTIC RAILROAD SYMBOL	EA		
RPLSYM	REMOVE PL. ARROW, LETTER, SYMBOL	EA		
RRPM	REMOVE RPM	EA		
RPLXW	REMOVE PLASTIC STRIPE	SF		
	PLASTIC BIKE DETECTION SYMBOL	EA	5	

CITY OF KIRKLAND
DEPARTMENT OF PUBLIC WORKS
123 FIFTH AVENUE KIRKLAND, WA 98033
(425) 587-3800 www.kirklandwa.gov

G. HORTILLOSA 10/2012
DESIGNED BY: DATE

J.JENNINGS 10/2012
DRAWN BY: DATE

CHECKED BY: DATE

2022 PAVEMENT MARKING PROGRAM

STREET: NE 132ND ST

CROSS STREET: 120 AVE NE

SEGMENT:

SCALE: N.T.S.

FILENAME: Page 3-20

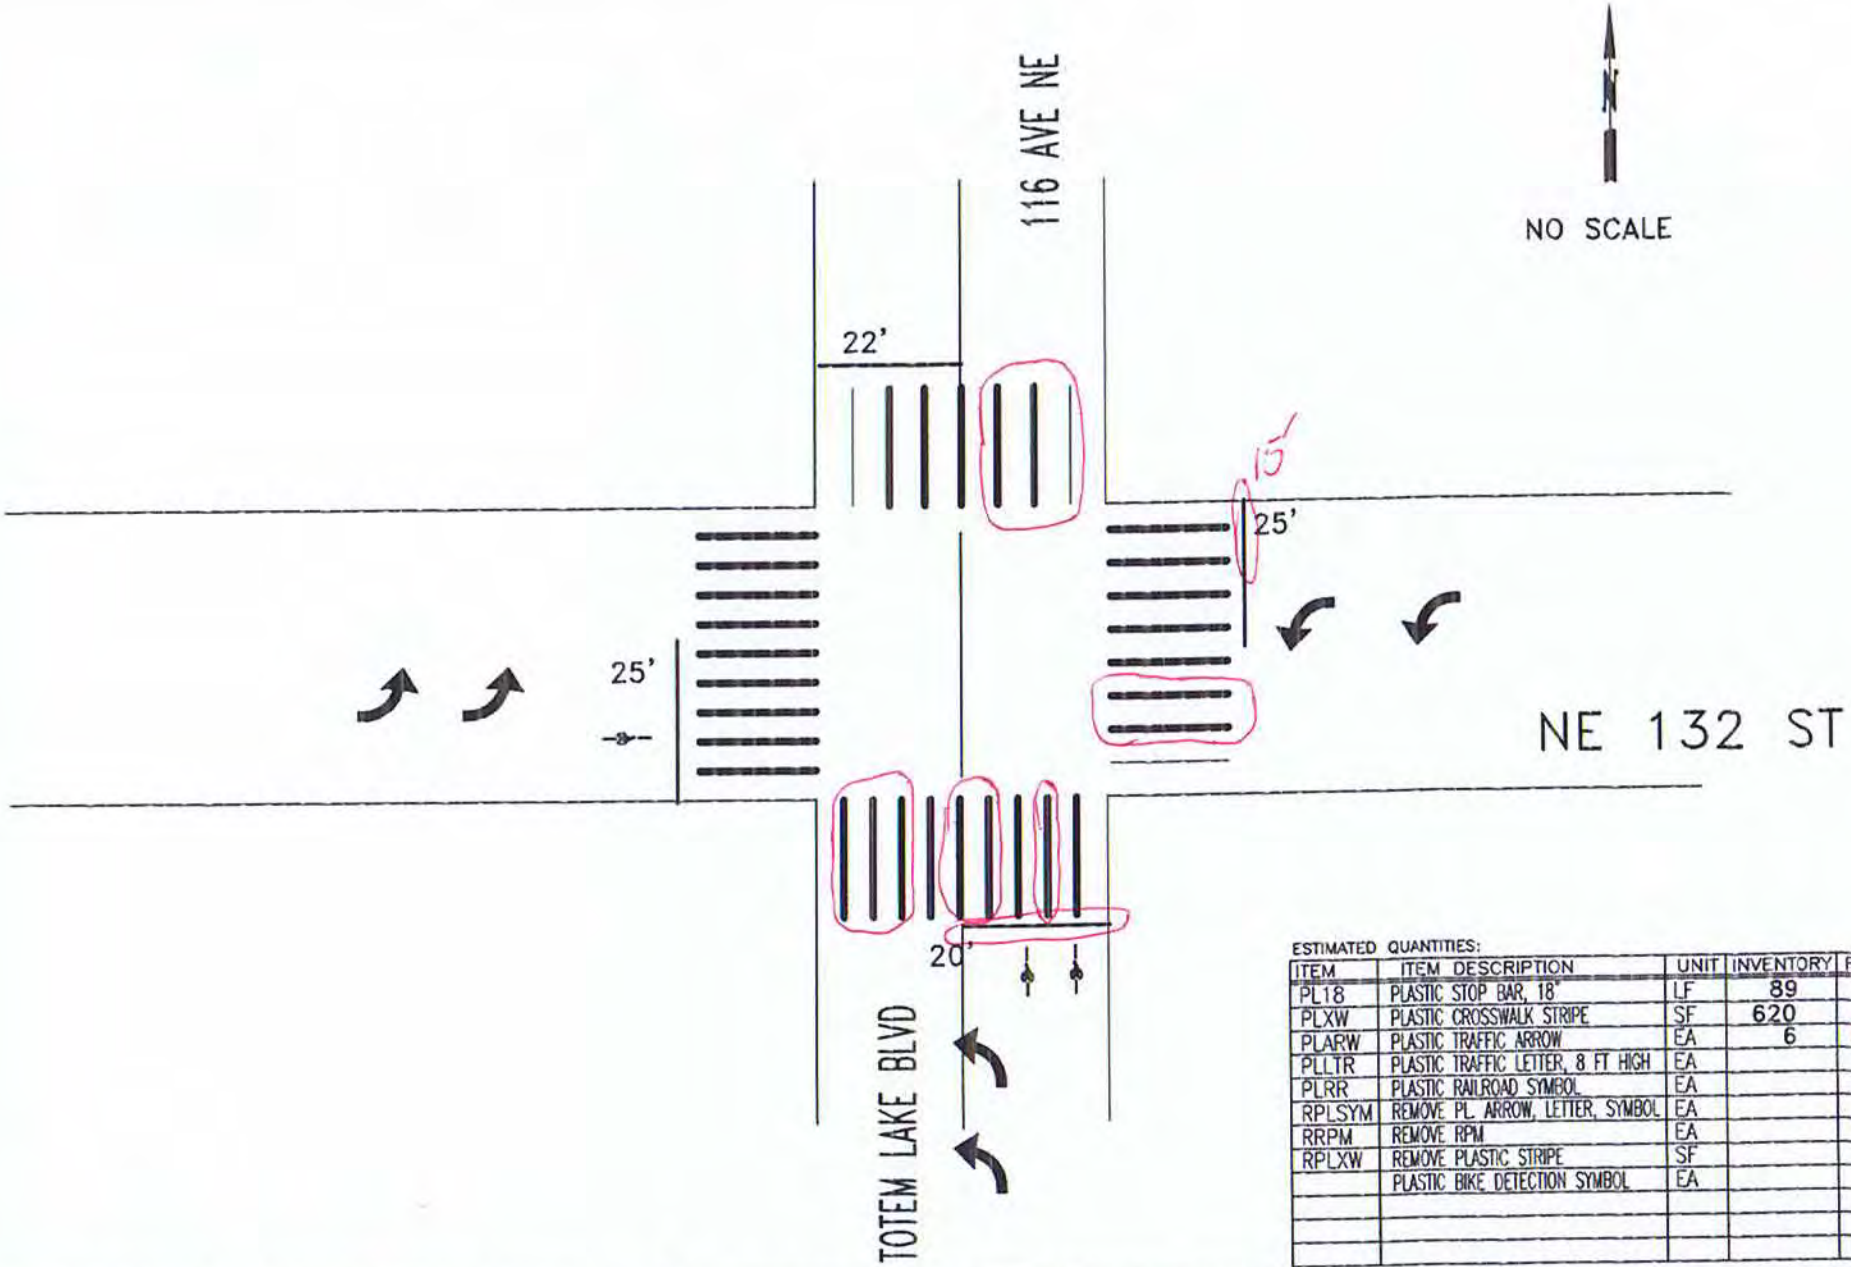

ESTIMATED QUANTITIES:

ITEM	ITEM DESCRIPTION	UNIT	INVENTORY	REPAIR QTY
PL18	PLASTIC STOP BAR, 18"	LF	89	35
PLXW	PLASTIC CROSSWALK STRIPE	SF	620	210
PLARW	PLASTIC TRAFFIC ARROW	EA	6	
PLLTR	PLASTIC TRAFFIC LETTER, 8 FT HIGH	EA		
PLRR	PLASTIC RAILROAD SYMBOL	EA		
RPLSYM	REMOVE PL. ARROW, LETTER, SYMBOL	EA		
RRPM	REMOVE RPM	EA		
RPLXW	REMOVE PLASTIC STRIPE	SF		
	PLASTIC BIKE DETECTION SYMBOL	EA		

CITY OF KIRKLAND
DEPARTMENT OF PUBLIC WORKS
123 FIFTH AVENUE KIRKLAND, WA 98033
(425) 587-3800 www.kirklandwa.gov

G. HORTILLOSA 10/2012
DESIGNED BY: DATE

J.JENNINGS 10/2012
DRAWN BY: DATE

CHECKED BY: DATE

2020 PAVEMENT MARKING PROGRAM

STREET: NE 132ND ST

CROSS STREET: TOTEM LAKE BLVD

SEGMENT:

SCALE: N.T.S.

FILENAME: Page 3-21

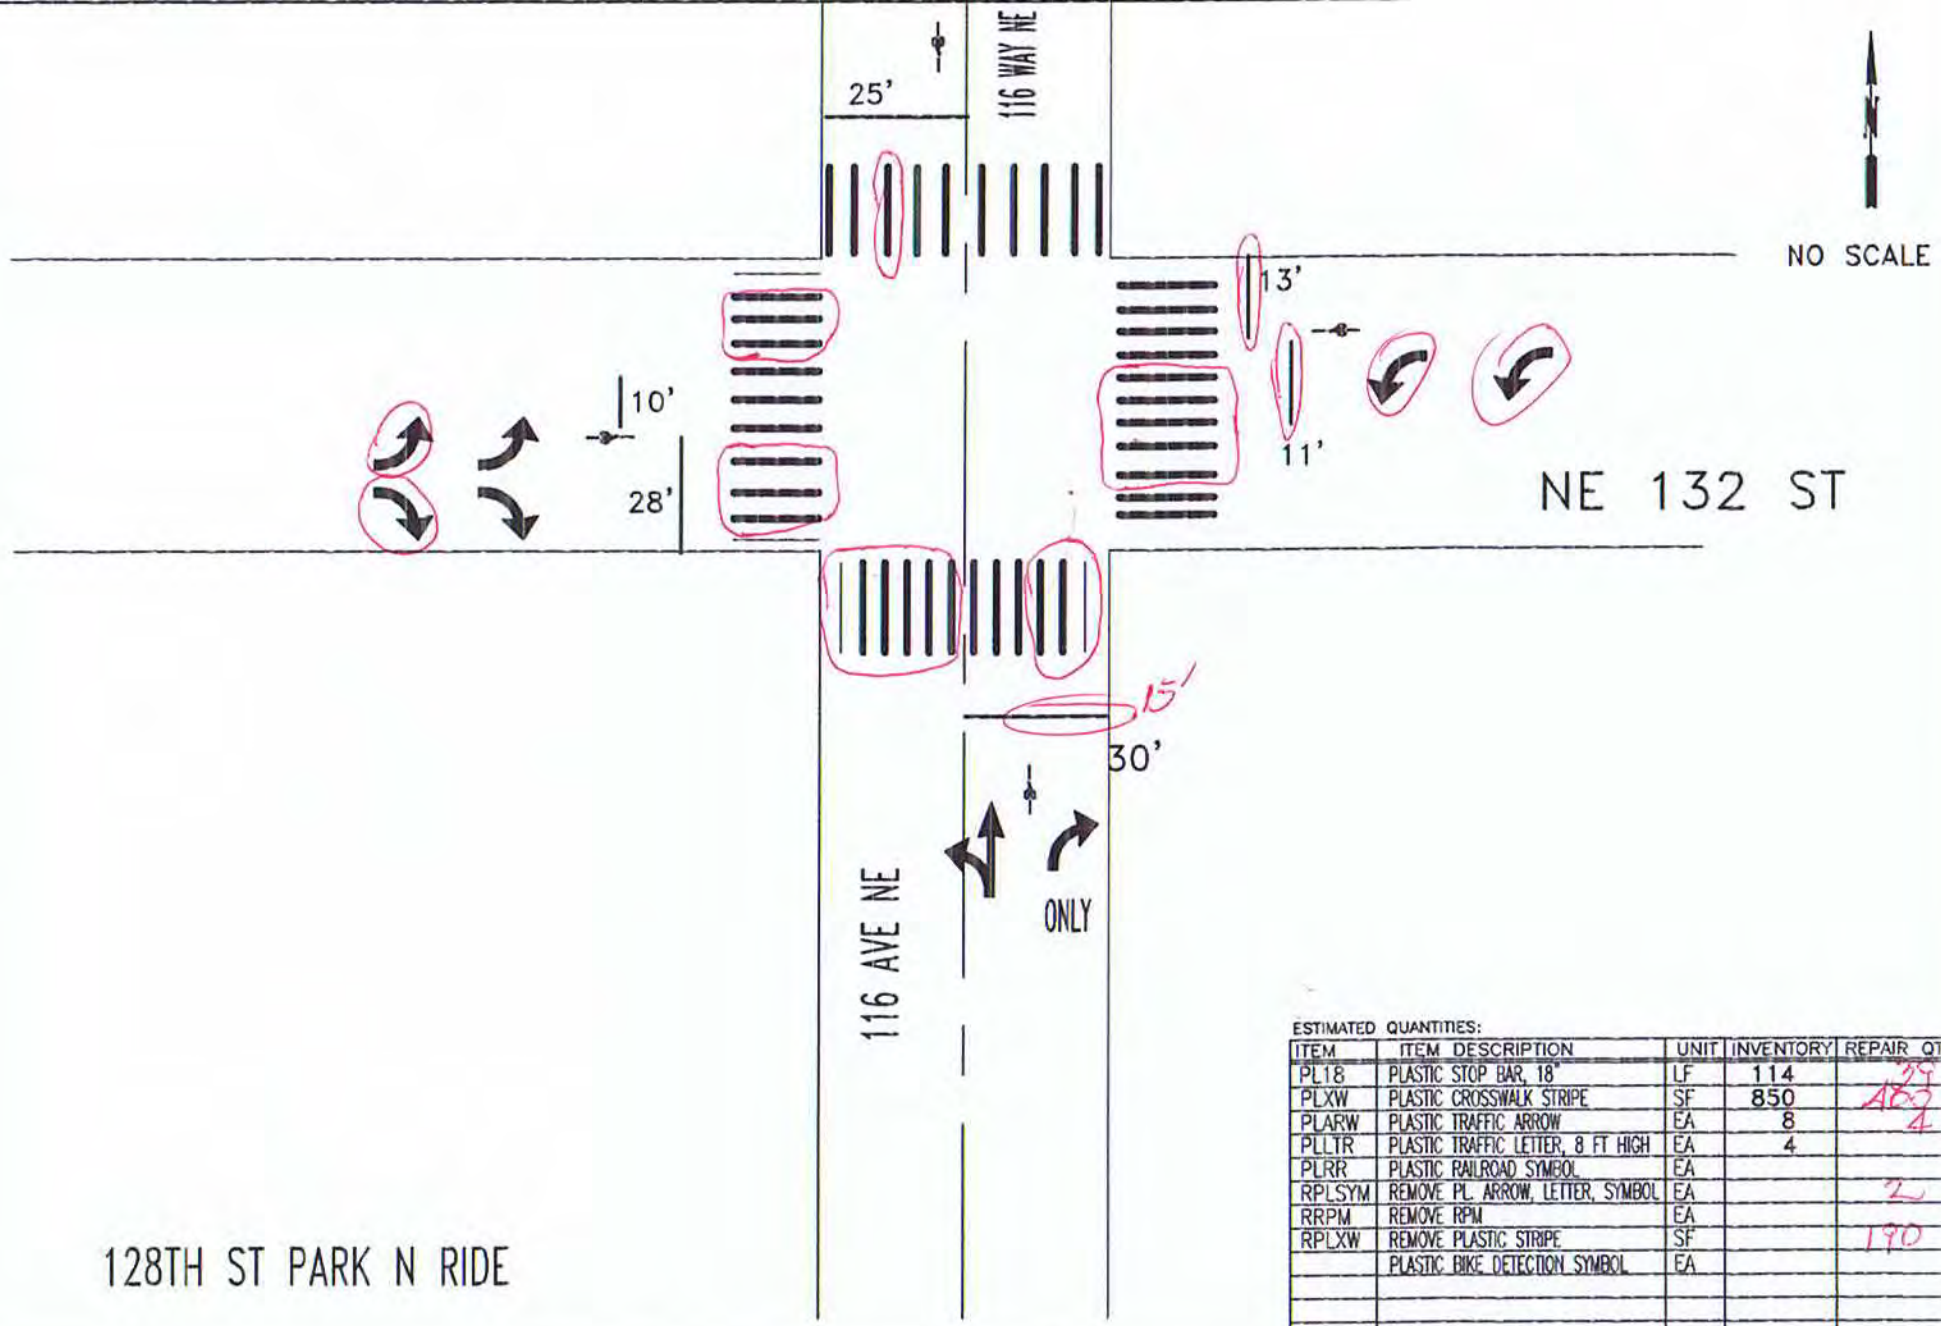

128TH ST PARK N RIDE

ESTIMATED QUANTITIES:

ITEM	ITEM DESCRIPTION	UNIT	INVENTORY	REPAIR QTY
PL18	PLASTIC STOP BAR, 18"	LF	114	29
PLXW	PLASTIC CROSSWALK STRIPE	SF	850	182
PLARW	PLASTIC TRAFFIC ARROW	EA	8	4
PLLTR	PLASTIC TRAFFIC LETTER, 8 FT HIGH	EA	4	
PLRR	PLASTIC RAILROAD SYMBOL	EA		
RPLSYM	REMOVE PL. ARROW, LETTER, SYMBOL	EA		2
RRPM	REMOVE RPM	EA		
RPLXW	REMOVE PLASTIC STRIPE	SF		190
	PLASTIC BIKE DETECTION SYMBOL	EA		

CITY OF KIRKLAND
DEPARTMENT OF PUBLIC WORKS
123 FIFTH AVENUE KIRKLAND, WA 98033
(425) 587-3800 www.kirklandwa.gov

L. KAWAOKA 8/2016
DESIGNED BY: DATE

J.JENNINGS 8/2016
DRAWN BY: DATE

CHECKED BY: DATE

2022 PAVEMENT MARKING PROGRAM

STREET: NE 132ND ST

CROSS STREET: 116 AVE NE

SEGMENT:

SCALE: N.T.S.

FILENAME: Page 3-22

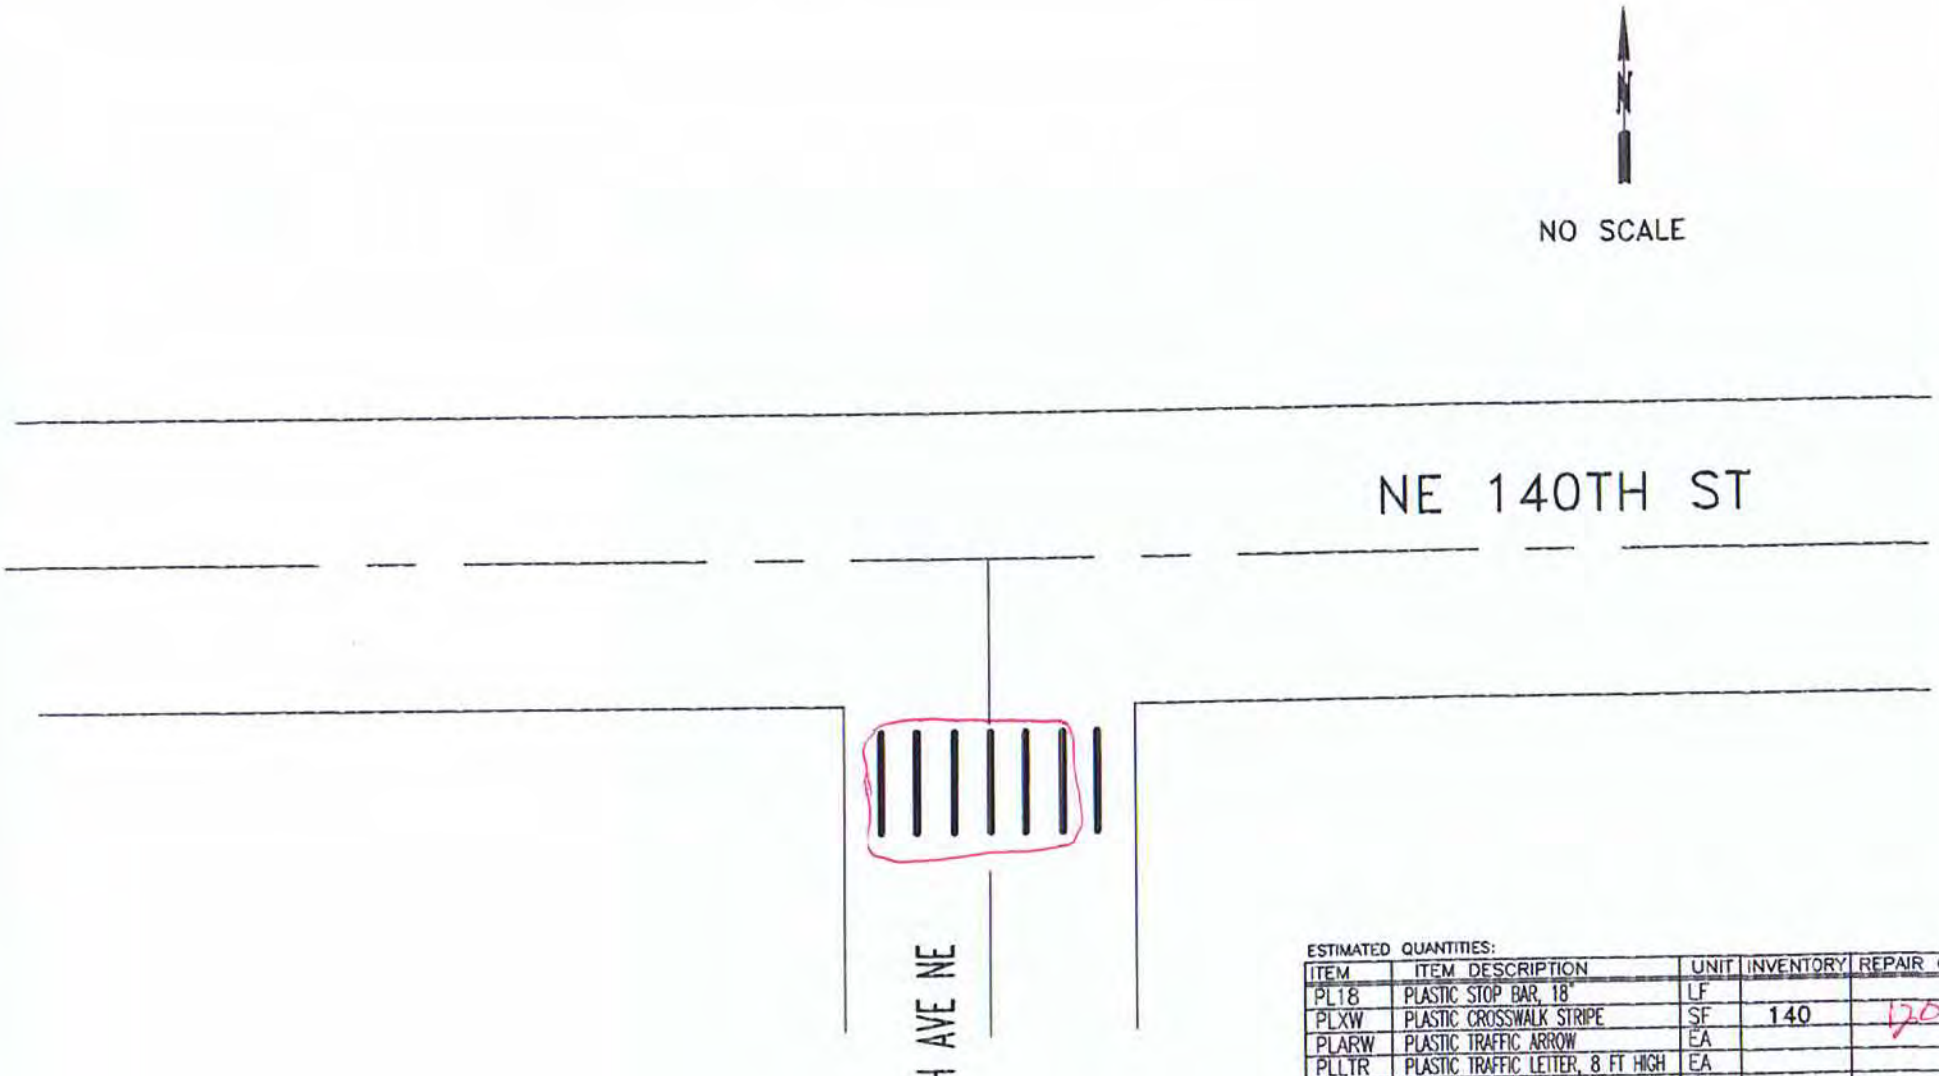

ESTIMATED QUANTITIES:

ITEM	ITEM DESCRIPTION	UNIT	INVENTORY	REPAIR QTY
PL18	PLASTIC STOP BAR, 18"	LF		
PLXW	PLASTIC CROSSWALK STRIPE	SF	140	120
PLARW	PLASTIC TRAFFIC ARROW	EA		
PLLTR	PLASTIC TRAFFIC LETTER, 8 FT HIGH	EA		
PLRR	PLASTIC RAILROAD SYMBOL	EA		
RPLSYM	REMOVE PL ARROW, LETTER, SYMBOL	EA		
RRPM	REMOVE RPM	EA		
RPLXW	REMOVE PLASTIC STRIPE	SF		80

CITY OF KIRKLAND WASHINGTON

CITY OF KIRKLAND
DEPARTMENT OF PUBLIC WORKS
123 FIFTH AVENUE KIRKLAND, WA 98033
(425) 587-3800 www.kirklandwa.gov

G. HORTILLOSA 7/2013
DESIGNED BY: DATE

J.JENNINGS 7/2013
DRAWN BY: DATE

CHECKED BY: DATE

2020 PAVEMENT MARKING PROGRAM

STREET: NE 140TH ST

CROSS STREET: 116TH AVE NE

SEGMENT:

SCALE: N.T.S.

FILENAME: Page 3-23

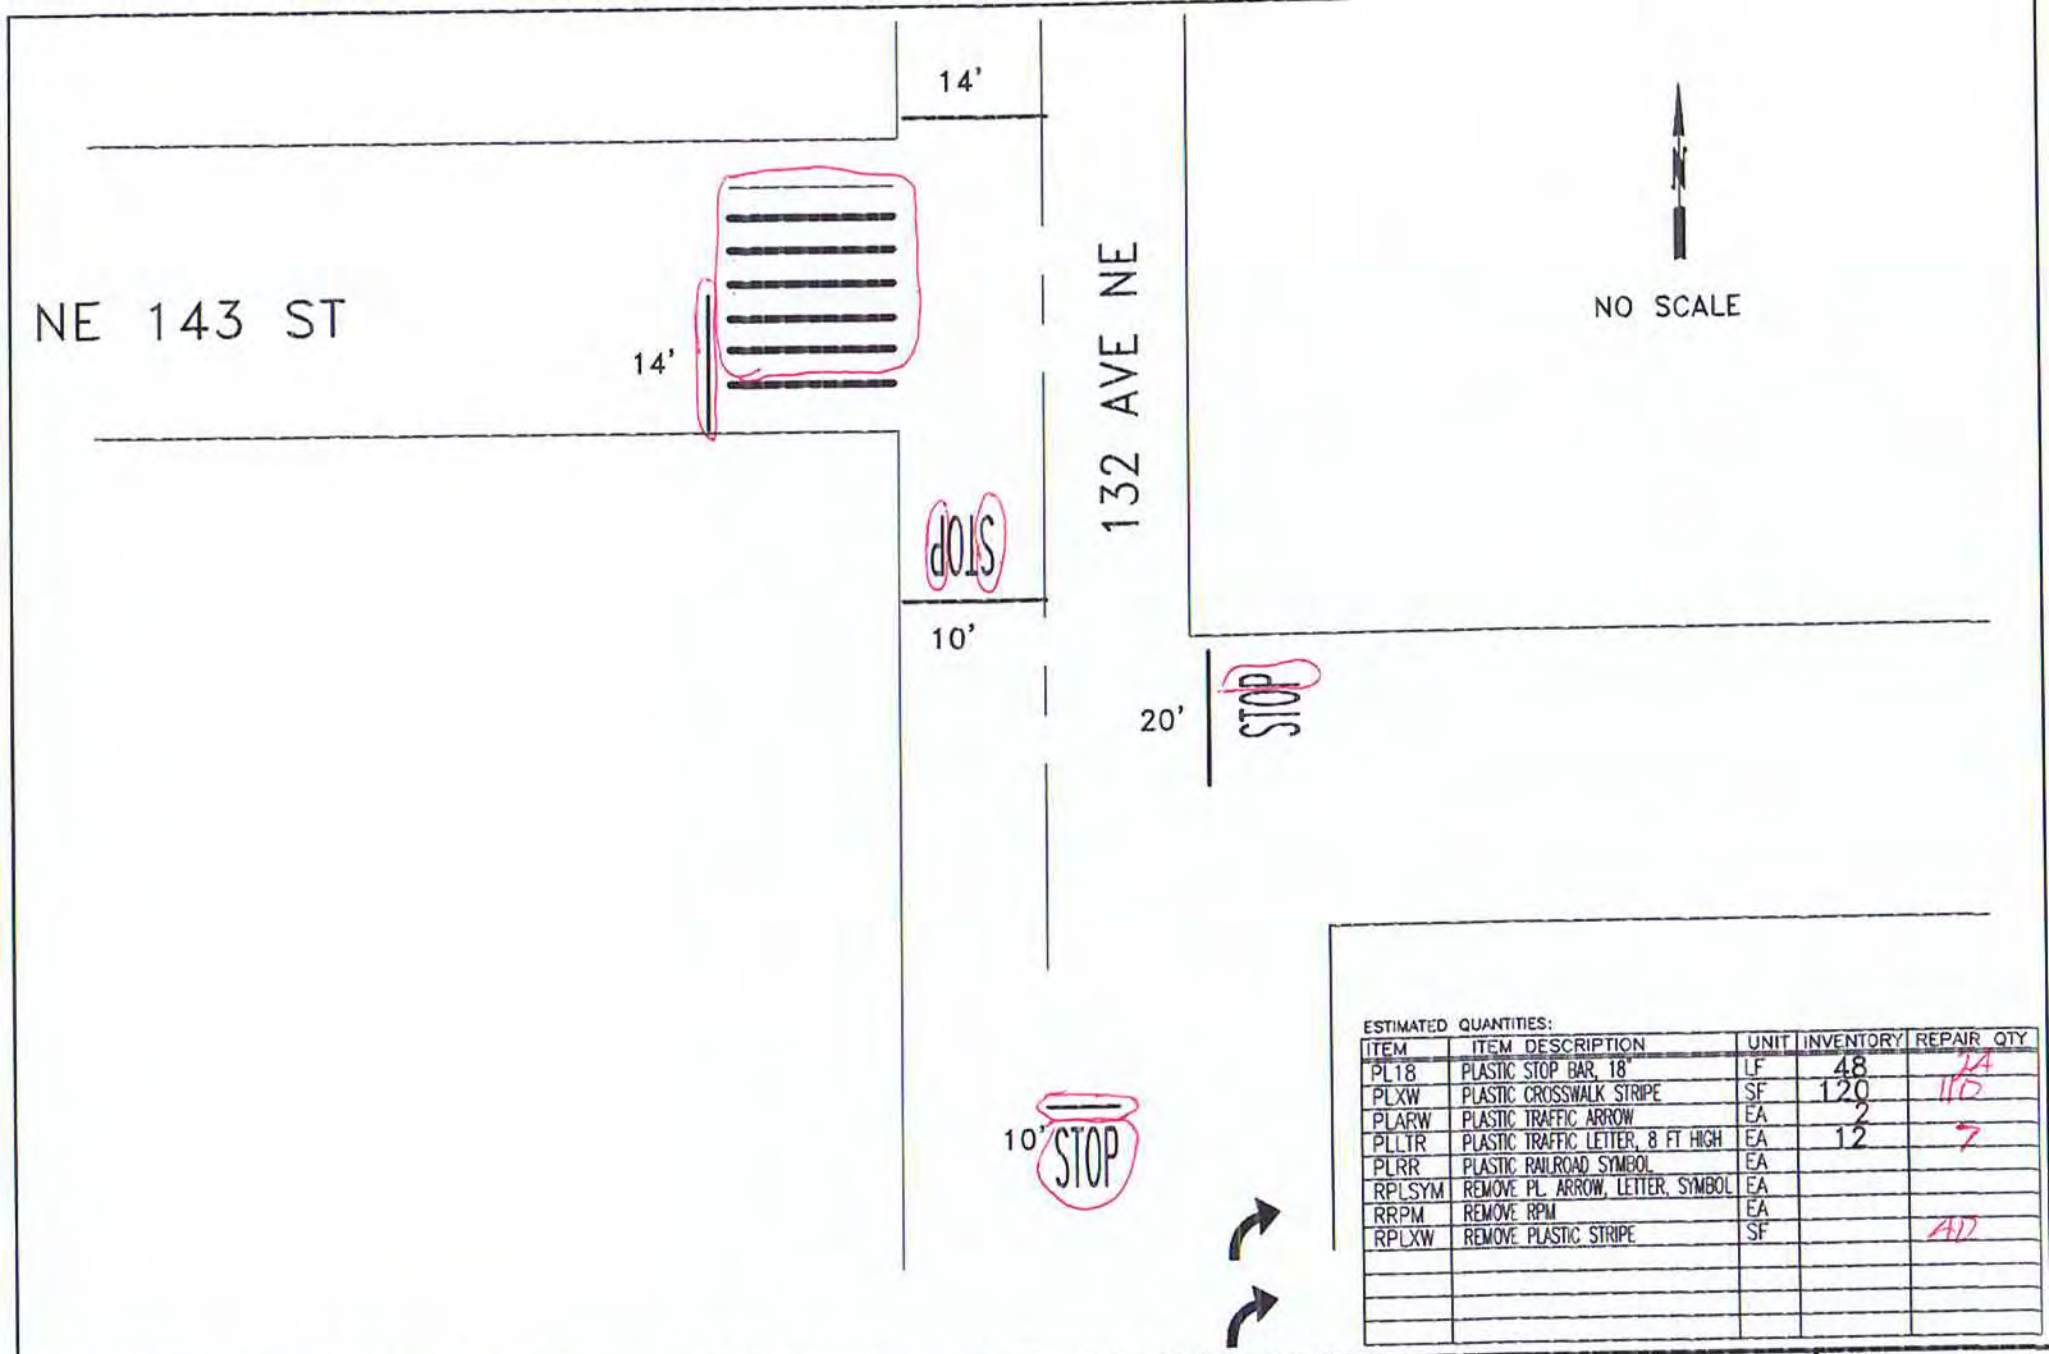

ESTIMATED QUANTITIES:

ITEM	ITEM DESCRIPTION	UNIT	INVENTORY	REPAIR QTY
PL18	PLASTIC STOP BAR, 18"	LF	48	24
PLXW	PLASTIC CROSSWALK STRIPE	SF	120	110
PLARW	PLASTIC TRAFFIC ARROW	EA	2	
PLLTR	PLASTIC TRAFFIC LETTER, 8 FT HIGH	EA	12	7
PLRR	PLASTIC RAILROAD SYMBOL	EA		
RPLSYM	REMOVE PL. ARROW, LETTER, SYMBOL	EA		
RRPM	REMOVE RPM	EA		
RPLXW	REMOVE PLASTIC STRIPE	SF		40

CITY OF KIRKLAND WASHINGTON

CITY OF KIRKLAND
DEPARTMENT OF PUBLIC WORKS
123 FIFTH AVENUE KIRKLAND, WA 98033
(425) 587-3800 www.kirklandwa.gov

G. HORTILLOSA 8/2013
DESIGNED BY: DATE

J.JENNINGS 8/2013
DRAWN BY: DATE

CHECKED BY: DATE

2022 PAVEMENT MARKING PROGRAM

STREET: NE 143RD ST

CROSS STREET: 132ND AVE NE

SEGMENT:

SCALE: N.T.S.

FILENAME: Page 3-24

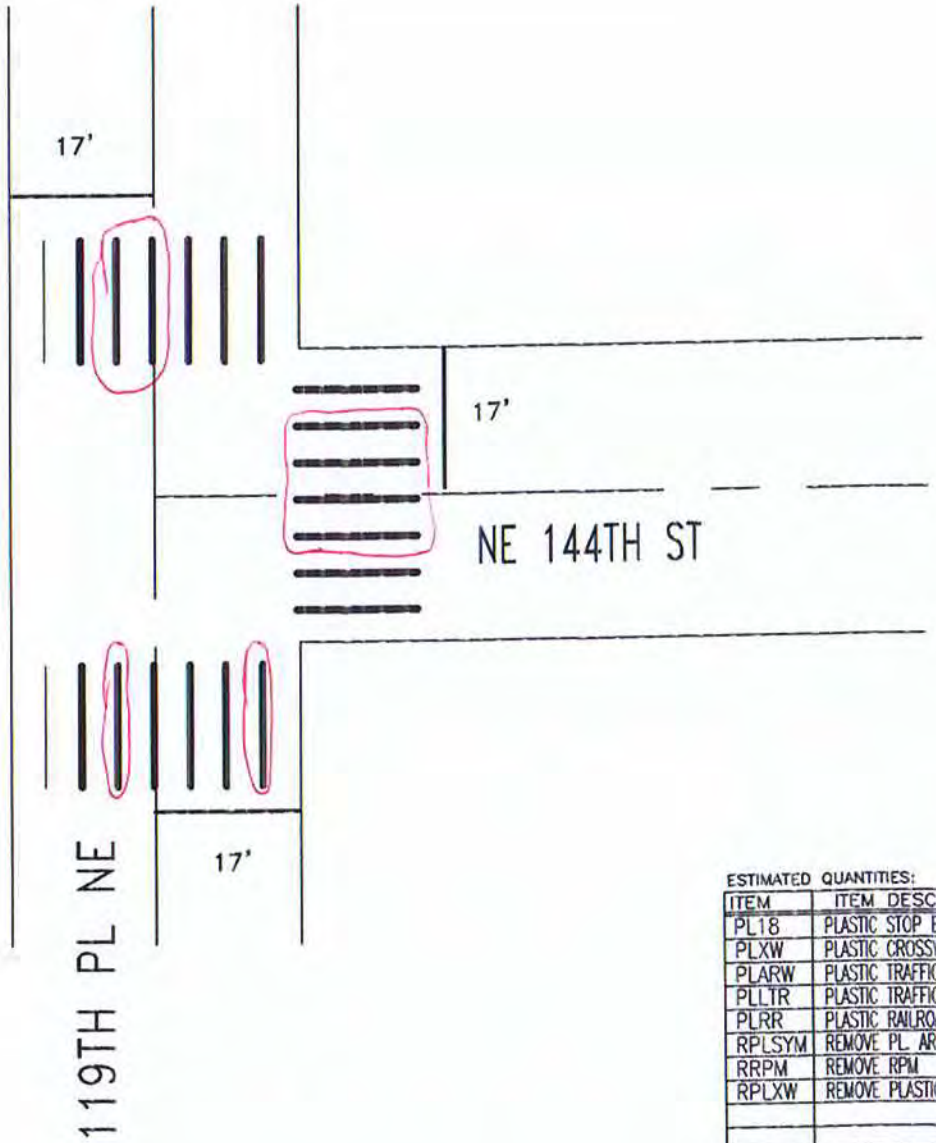

NO SCALE

ESTIMATED QUANTITIES:

ITEM	ITEM DESCRIPTION	UNIT	INVENTORY	REPAIR QTY
PL18	PLASTIC STOP BAR, 18"	LF	51	
PLXW	PLASTIC CROSSWALK STRIPE	SF	130	160
PLARW	PLASTIC TRAFFIC ARROW	EA		
PLLTR	PLASTIC TRAFFIC LETTER, 8 FT HIGH	EA		
PLRR	PLASTIC RAILROAD SYMBOL	EA		
RPLSYM	REMOVE PL. ARROW, LETTER, SYMBOL	EA		
RRPM	REMOVE RPM	EA		
RPLXW	REMOVE PLASTIC STRIPE	SF		160

CITY OF KIRKLAND
DEPARTMENT OF PUBLIC WORKS
123 FIFTH AVENUE KIRKLAND, WA 98033
(425) 587-3800 www.kirklandwa.gov

A. KHANAL 10/2015
DESIGNED BY: DATE

J.JENNINGS 10/2015
DRAWN BY: DATE

CHECKED BY: DATE

2020 PAVEMENT MARKING PROGRAM

STREET: 119TH PL NE

CROSS STREET: NE 144TH ST

SEGMENT:

SCALE: N.T.S.

FILENAME: Page 3-28

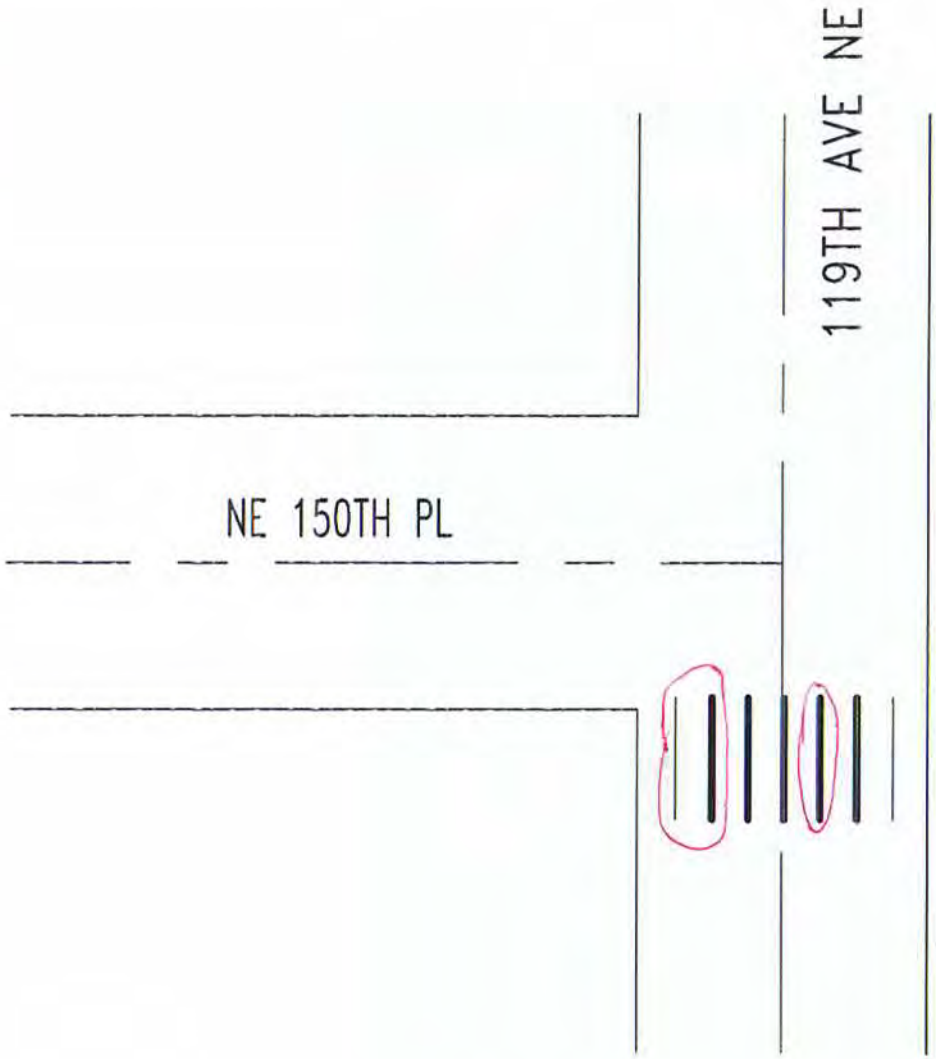

NO SCALE

ESTIMATED QUANTITIES:

ITEM	ITEM DESCRIPTION	UNIT	INVENTORY	REPAIR QTY
PL18	PLASTIC STOP BAR, 18"	LF		
PLXW	PLASTIC CROSSWALK STRIPE	SF	120	30
PLARW	PLASTIC TRAFFIC ARROW	EA		
PLLTR	PLASTIC TRAFFIC LETTER, 8 FT HIGH	EA		
PLRR	PLASTIC RAILROAD SYMBOL	EA		
RPLSYM	REMOVE PL. ARROW, LETTER, SYMBOL	EA		
RRPM	REMOVE RPM	EA		
RPLXW	REMOVE PLASTIC STRIPE	SF		30

CITY OF KIRKLAND
DEPARTMENT OF PUBLIC WORKS
123 FIFTH AVENUE KIRKLAND, WA 98033
(425) 587-3800 www.kirklandwa.gov

A. KHANAL 10/2015
DESIGNED BY: DATE

J.JENNINGS 10/2015
DRAWN BY: DATE

CHECKED BY: DATE

20~~20~~ PAVEMENT MARKING PROGRAM


CROSS STREET: NE 150TH PL

SEGMENT:

SCALE: N.T.S.

FILENAME: Page 3-29

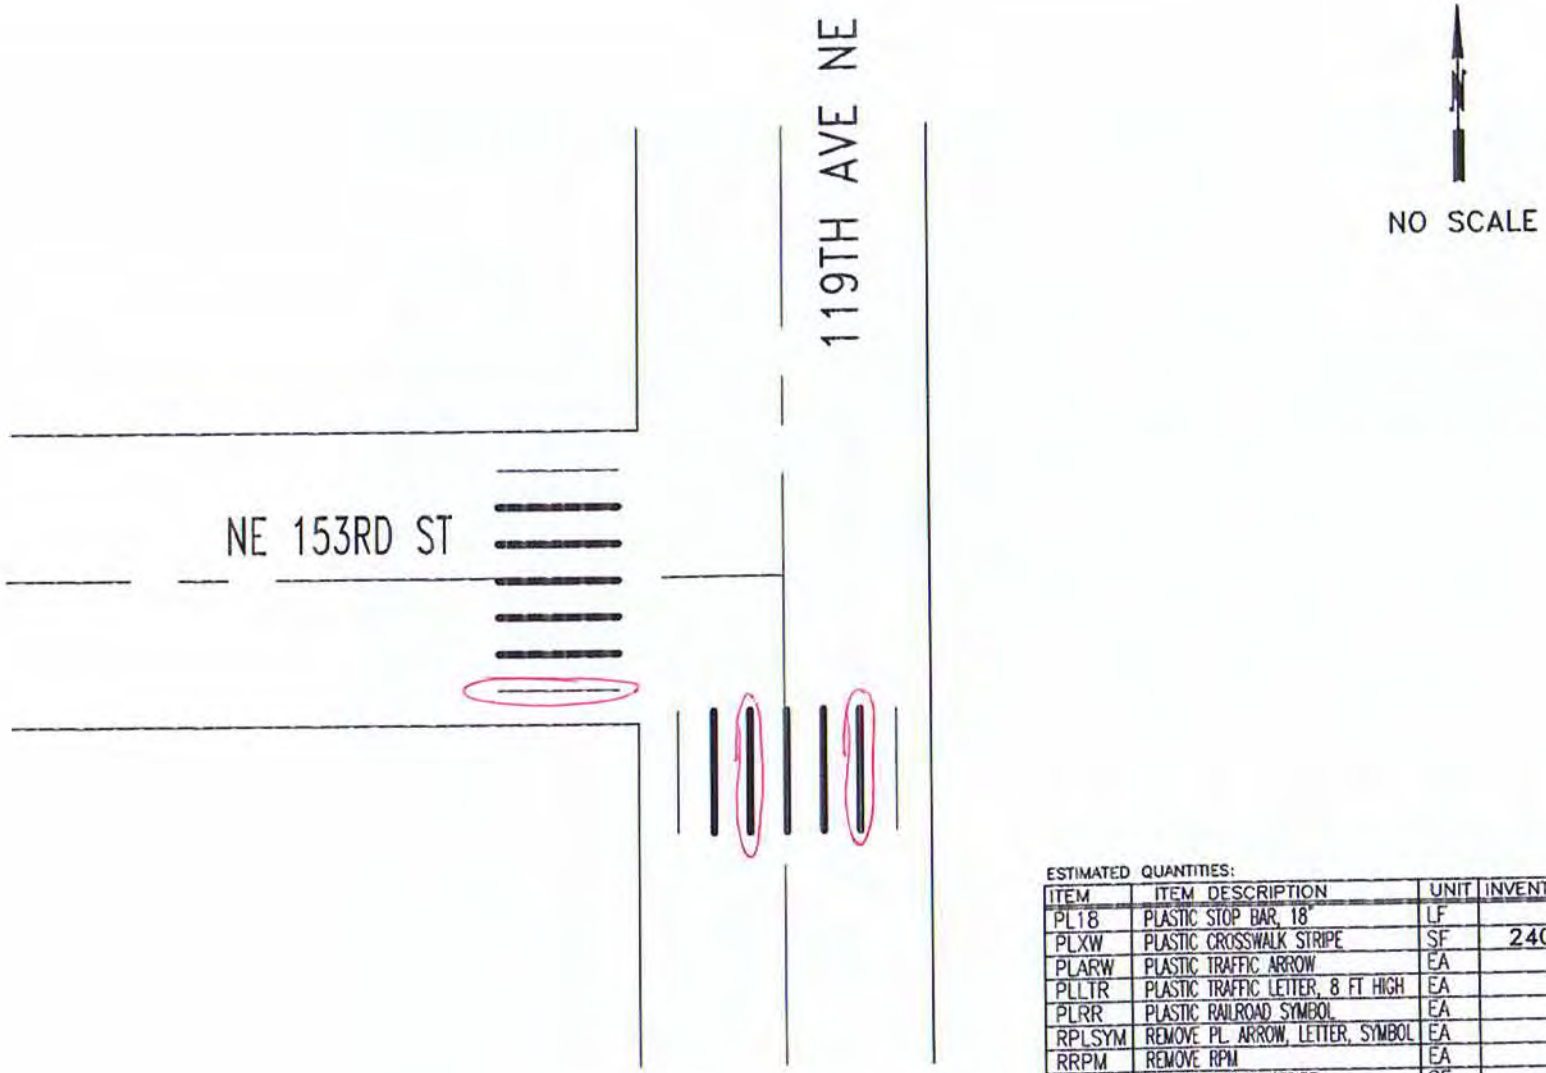

ESTIMATED QUANTITIES:

ITEM	ITEM DESCRIPTION	UNIT	INVENTORY	REPAIR QTY
PL18	PLASTIC STOP BAR, 18"	LF		
PLXW	PLASTIC CROSSWALK STRIPE	SF	240	50
PLARW	PLASTIC TRAFFIC ARROW	EA		
PLLTR	PLASTIC TRAFFIC LETTER, 8 FT HIGH	EA		
PLRR	PLASTIC RAILROAD SYMBOL	EA		
RPLSYM	REMOVE PL. ARROW, LETTER, SYMBOL	EA		
RRPM	REMOVE RPM	EA		
RPLXW	REMOVE PLASTIC STRIPE	SF		50

CITY OF KIRKLAND
DEPARTMENT OF PUBLIC WORKS
123 FIFTH AVENUE KIRKLAND, WA 98033
(425) 587-3800 www.kirklandwa.gov

A. KHANAL 10/2015
DESIGNED BY: DATE

J.JENNINGS 10/2015
DRAWN BY: DATE

CHECKED BY: DATE

2022 PAVEMENT MARKING PROGRAM

STREET: 119TH PL NE

CROSS STREET: NE 153RD ST

SEGMENT:

SCALE: N.T.S.

FILENAME: Page 3-30

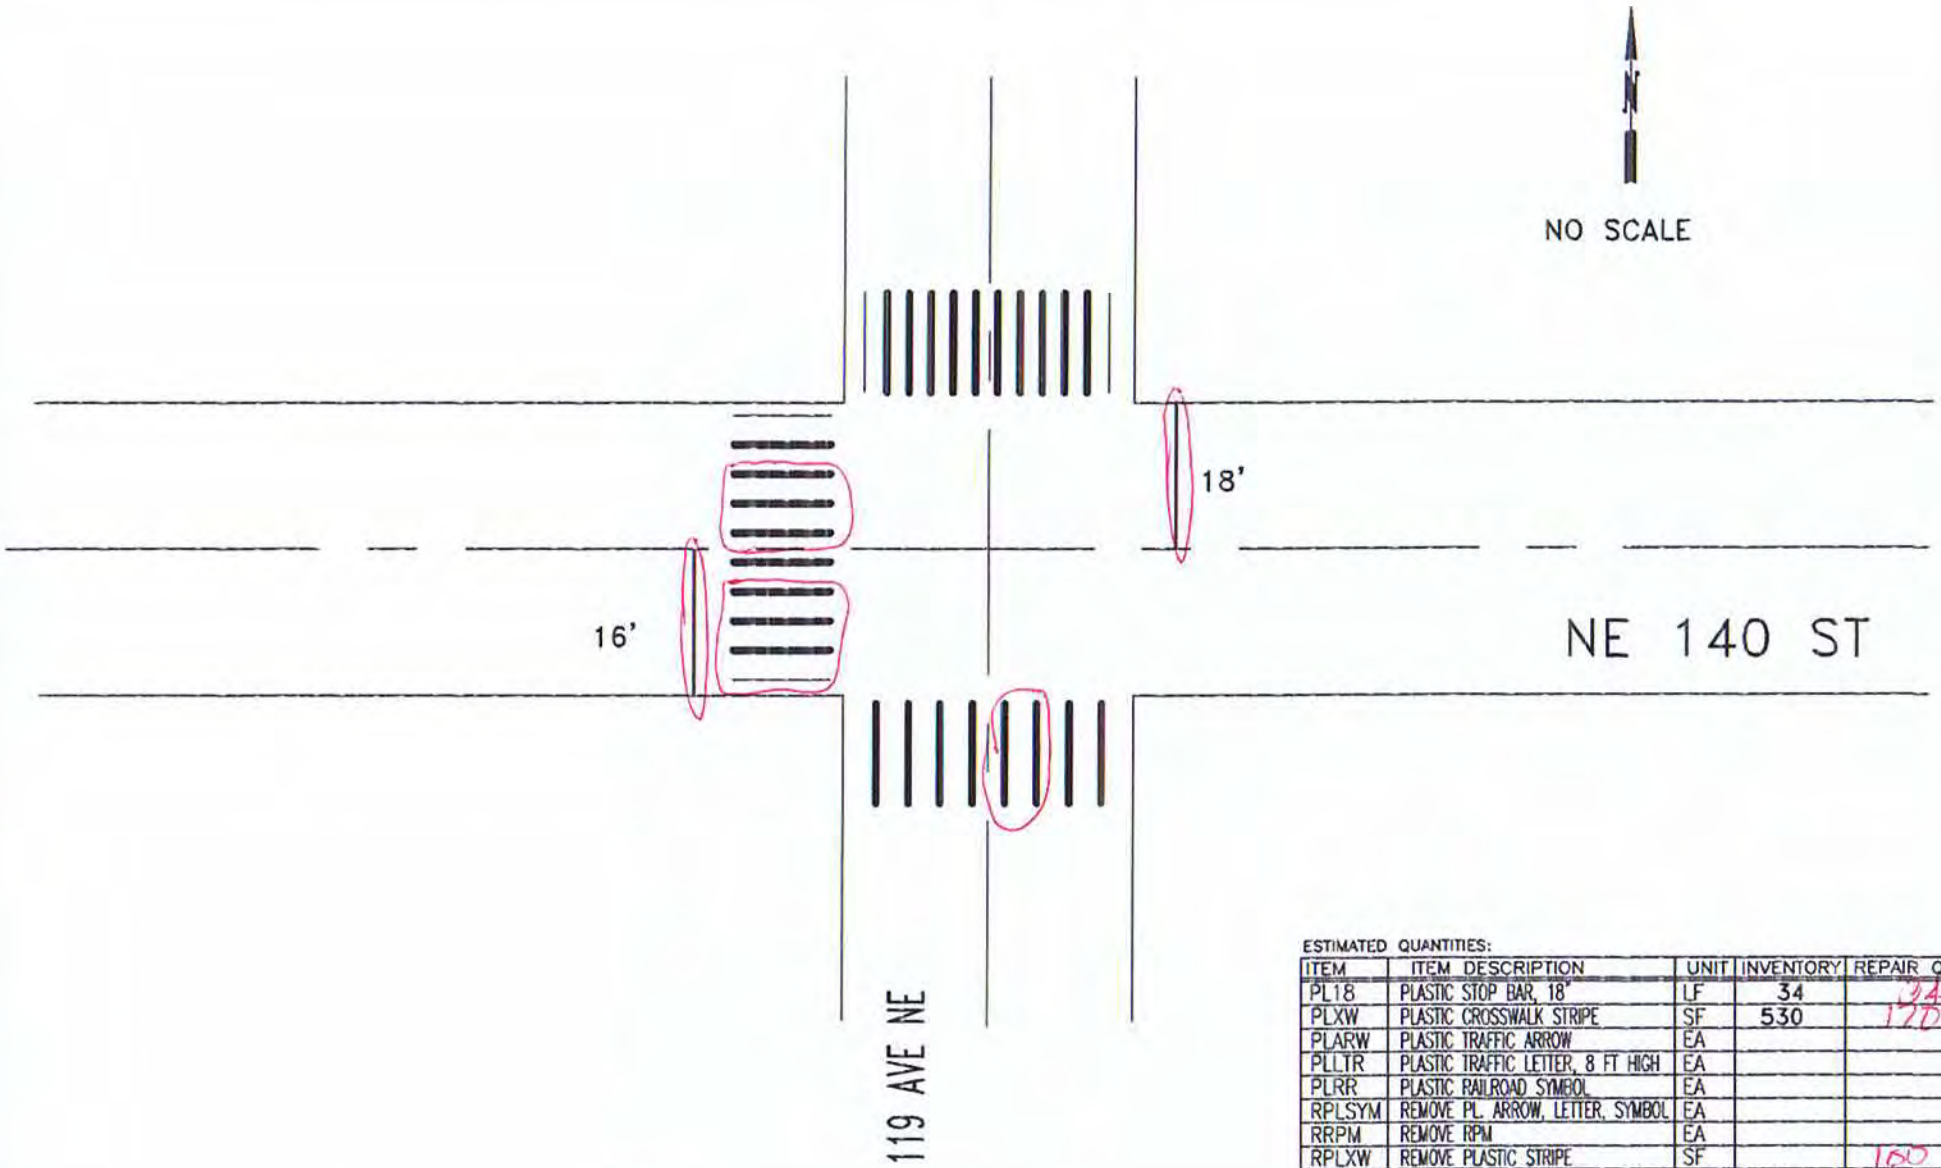

ESTIMATED QUANTITIES:

ITEM	ITEM DESCRIPTION	UNIT	INVENTORY	REPAIR QTY
PL18	PLASTIC STOP BAR, 18"	LF	34	34
PLXW	PLASTIC CROSSWALK STRIPE	SF	530	120
PLARW	PLASTIC TRAFFIC ARROW	EA		
PLLTR	PLASTIC TRAFFIC LETTER, 8 FT HIGH	EA		
PLRR	PLASTIC RAILROAD SYMBOL	EA		
RPLSYM	REMOVE PL. ARROW, LETTER, SYMBOL	EA		
RRPM	REMOVE RPM	EA		
RPLXW	REMOVE PLASTIC STRIPE	SF		100

CITY OF KIRKLAND
DEPARTMENT OF PUBLIC WORKS
123 FIFTH AVENUE KIRKLAND, WA 98033
(425) 587-3800 www.kirklandwa.gov

L KAWAOKA 3/2016
DESIGNED BY: DATE

J.JENNINGS 3/2016
DRAWN BY: DATE

CHECKED BY: DATE

2020 PAVEMENT MARKING PROGRAM

STREET: NE 140 ST

CROSS STREET: 119 AVE NE

SEGMENT:

SCALE: N.T.S.

FILENAME:

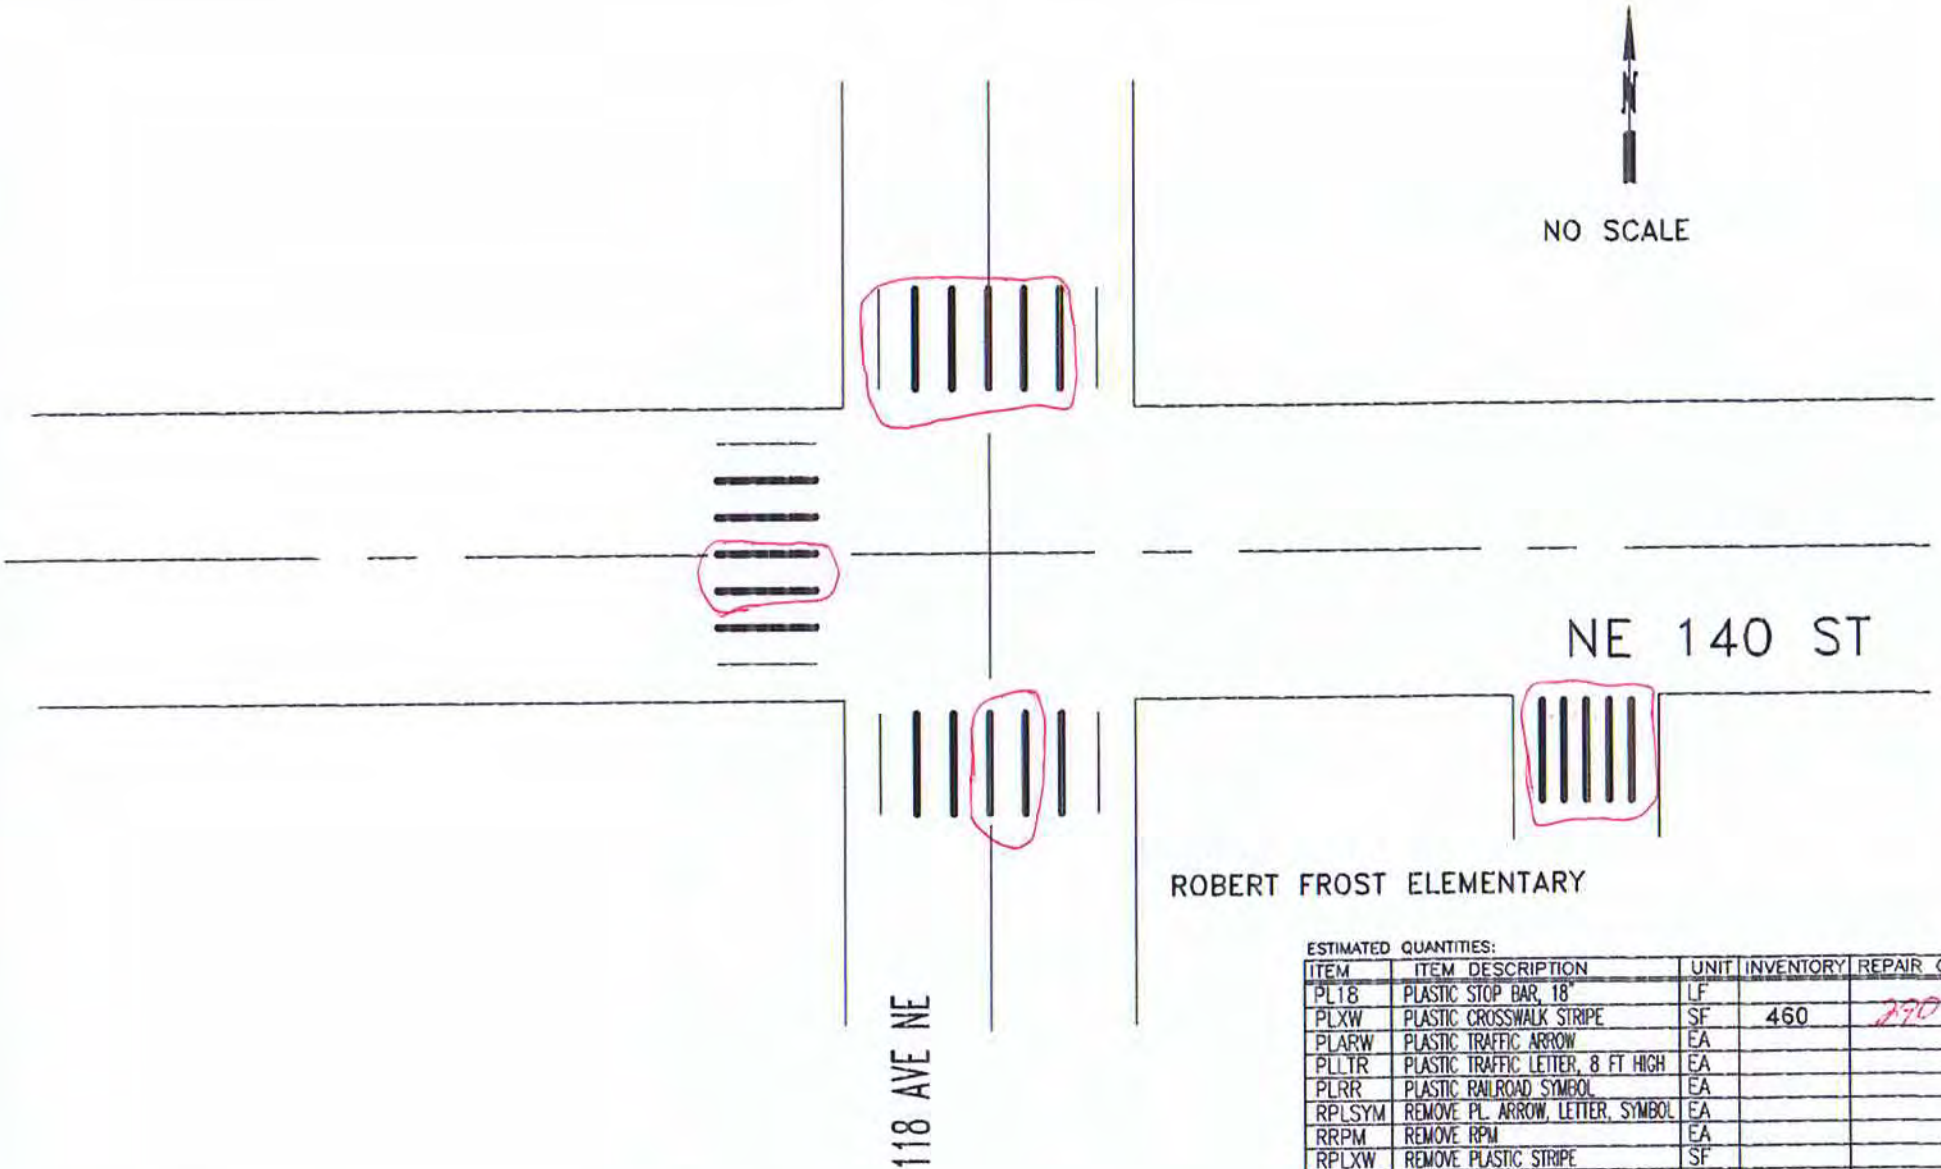

ESTIMATED QUANTITIES:

ITEM	ITEM DESCRIPTION	UNIT	INVENTORY	REPAIR QTY
PL18	PLASTIC STOP BAR, 18"	LF		
PLXW	PLASTIC CROSSWALK STRIPE	SF	460	270
PLARW	PLASTIC TRAFFIC ARROW	EA		
PLLTR	PLASTIC TRAFFIC LETTER, 8 FT HIGH	EA		
PLRR	PLASTIC RAILROAD SYMBOL	EA		
RPLSYM	REMOVE PL. ARROW, LETTER, SYMBOL	EA		
RRPM	REMOVE RPM	EA		
RPLXW	REMOVE PLASTIC STRIPE	SF		

CITY OF KIRKLAND WASHINGTON

CITY OF KIRKLAND
DEPARTMENT OF PUBLIC WORKS
123 FIFTH AVENUE KIRKLAND, WA 98033
(425) 587-3800 www.kirklandwa.gov

L KAWAOKA 3/2016
DESIGNED BY: DATE

J.JENNINGS 3/2016
DRAWN BY: DATE

CHECKED BY: DATE

2020 PAVEMENT MARKING PROGRAM

STREET: NE 140 ST

CROSS STREET: 118 AVE NE

SEGMENT:

SCALE: N.T.S.

FILENAME: Page 3-33

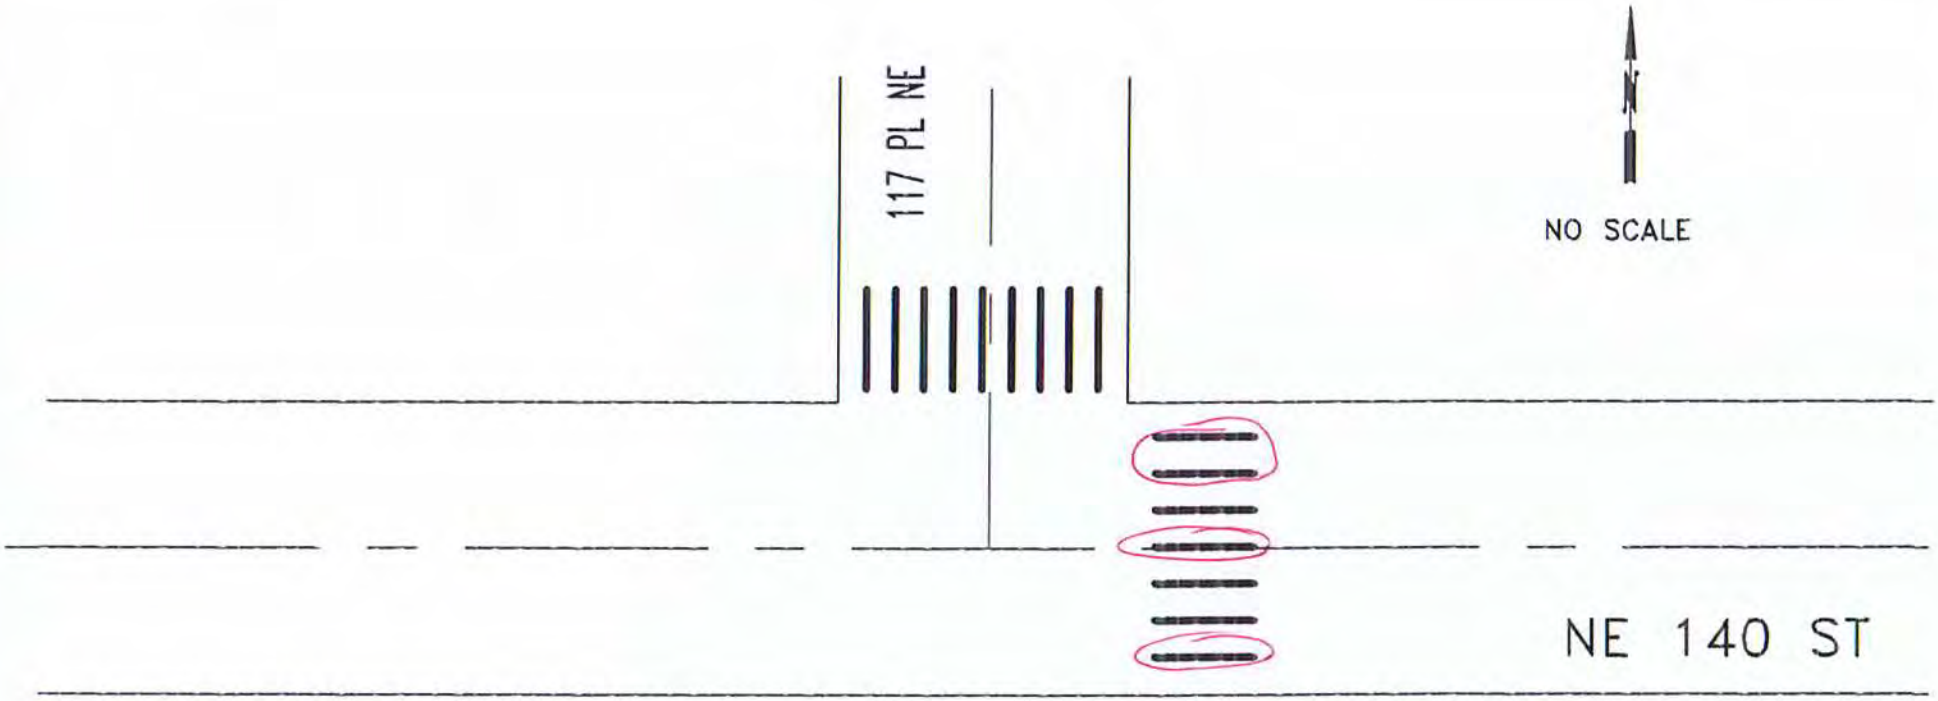

ESTIMATED QUANTITIES:

ITEM	ITEM DESCRIPTION	UNIT	INVENTORY	REPAIR QTY
PL18	PLASTIC STOP BAR, 18"	LF		
PLXW	PLASTIC CROSSWALK STRIPE	SF	320	50
PLARW	PLASTIC TRAFFIC ARROW	EA		
PLLTR	PLASTIC TRAFFIC LETTER, 8 FT HIGH	EA		
PLRR	PLASTIC RAILROAD SYMBOL	EA		
RPLSYM	REMOVE PL. ARROW, LETTER, SYMBOL	EA		
RRPM	REMOVE RPM	EA		
RPLXW	REMOVE PLASTIC STRIPE	SF		

CITY OF KIRKLAND
DEPARTMENT OF PUBLIC WORKS
123 FIFTH AVENUE KIRKLAND, WA 98033
(425) 587-3800 www.kirklandwa.gov

L KAWAOKA 3/2016
DESIGNED BY: DATE

J.JENNINGS 3/2016
DRAWN BY: DATE

CHECKED BY: DATE

20~~20~~ PAVEMENT MARKING PROGRAM

STREET: NE 140 ST

CROSS STREET: 117 PL NE

SEGMENT:

SCALE: N.T.S.

FILENAME: Page 3-34

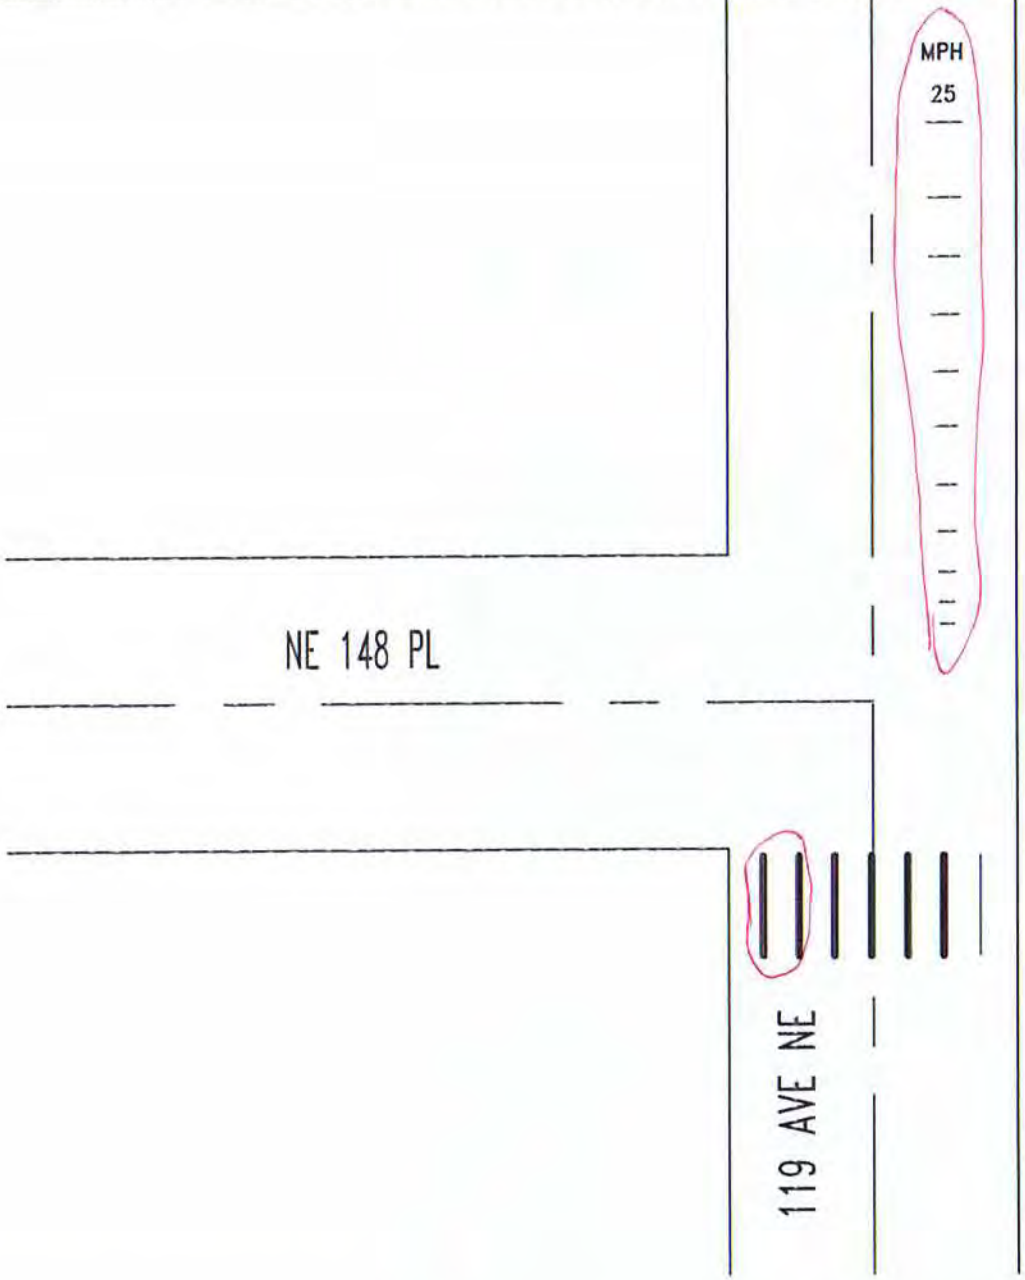

NO SCALE

ESTIMATED QUANTITIES:

ITEM	ITEM DESCRIPTION	UNIT	INVENTORY	REPAIR QTY
PL18	PLASTIC STOP BAR, 18"	LF		
PLXW	PLASTIC CROSSWALK STRIPE	SF	130	33
PLARW	PLASTIC TRAFFIC ARROW	EA	5	3
PLLTR	PLASTIC TRAFFIC LETTER, 8 FT HIGH	EA		
PLRR	PLASTIC RAILROAD SYMBOL	EA		
RPLSYM	REMOVE PL. ARROW, LETTER, SYMBOL	EA		
RRPM	REMOVE RPM	EA		
RPLXW	REMOVE PLASTIC STRIPE	SF		
PLLGD	PLASTIC SPEED LEGEND BARS	EA	62	62

CITY OF KIRKLAND WASHINGTON

CITY OF KIRKLAND
DEPARTMENT OF PUBLIC WORKS
123 FIFTH AVENUE KIRKLAND, WA 98033
(425) 587-3800 www.kirklandwa.gov

L KAWAOKA 3/2016
DESIGNED BY: DATE

J.JENNINGS 3/2016
DRAWN BY: DATE

CHECKED BY: DATE

2022 PAVEMENT MARKING PROGRAM

STREET: NE 148TH PL


SEGMENT:

SCALE: N.T.S.

FILENAME:

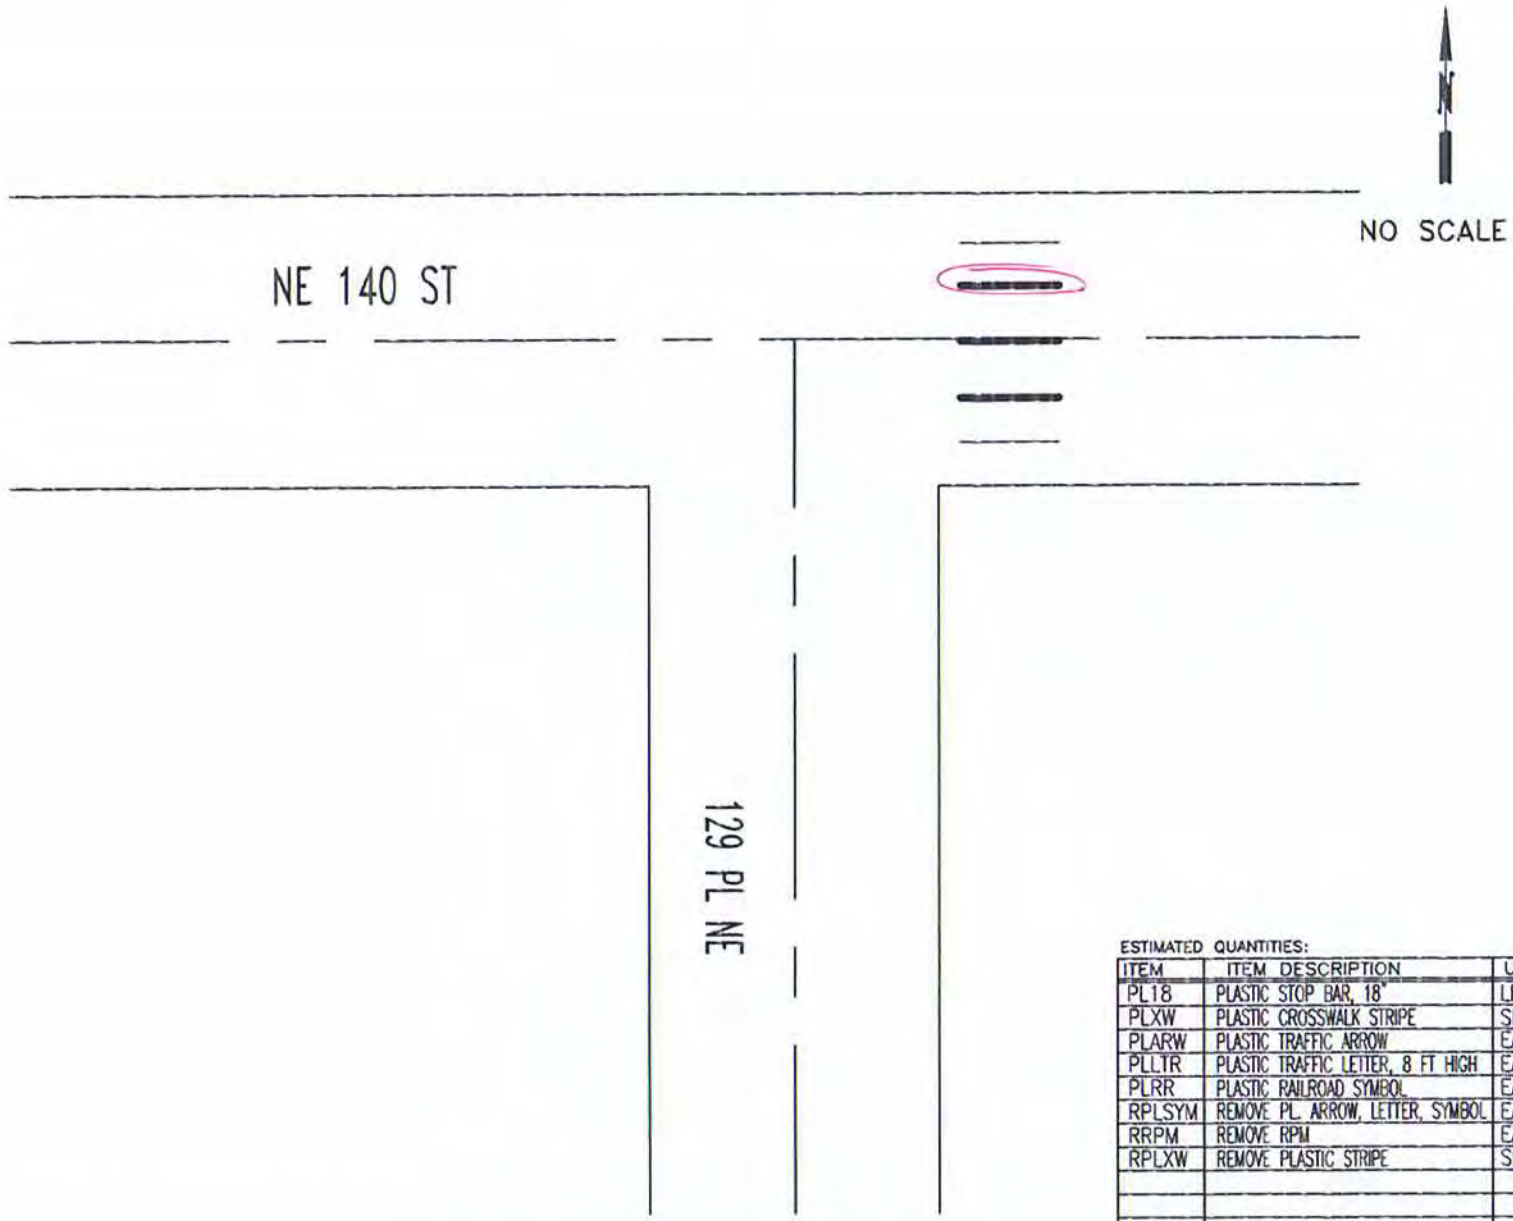

ESTIMATED QUANTITIES:

ITEM	ITEM DESCRIPTION	UNIT	INVENTORY	REPAIR QTY
PL18	PLASTIC STOP BAR, 18"	LF		
PLXW	PLASTIC CROSSWALK STRIPE	SF	80	20
PLARW	PLASTIC TRAFFIC ARROW	EA		
PLLTR	PLASTIC TRAFFIC LETTER, 8 FT HIGH	EA		
PLRR	PLASTIC RAILROAD SYMBOL	EA		
RPLSYM	REMOVE PL. ARROW, LETTER, SYMBOL	EA		
RRPM	REMOVE RPM	EA		
RPLXW	REMOVE PLASTIC STRIPE	SF		

CITY OF KIRKLAND WASHINGTON

CITY OF KIRKLAND
DEPARTMENT OF PUBLIC WORKS
123 FIFTH AVENUE KIRKLAND, WA 98033
(425) 587-3800 www.kirklandwa.gov

L. KAWAOKA 3/2016
DESIGNED BY: DATE

J.JENNINGS 3/2016
DRAWN BY: DATE

CHECKED BY: DATE

2020 PAVEMENT MARKING PROGRAM

STREET: NE 140 ST

CROSS STREET: 129 PL NE

SEGMENT:

SCALE: N.T.S.

FILENAME:

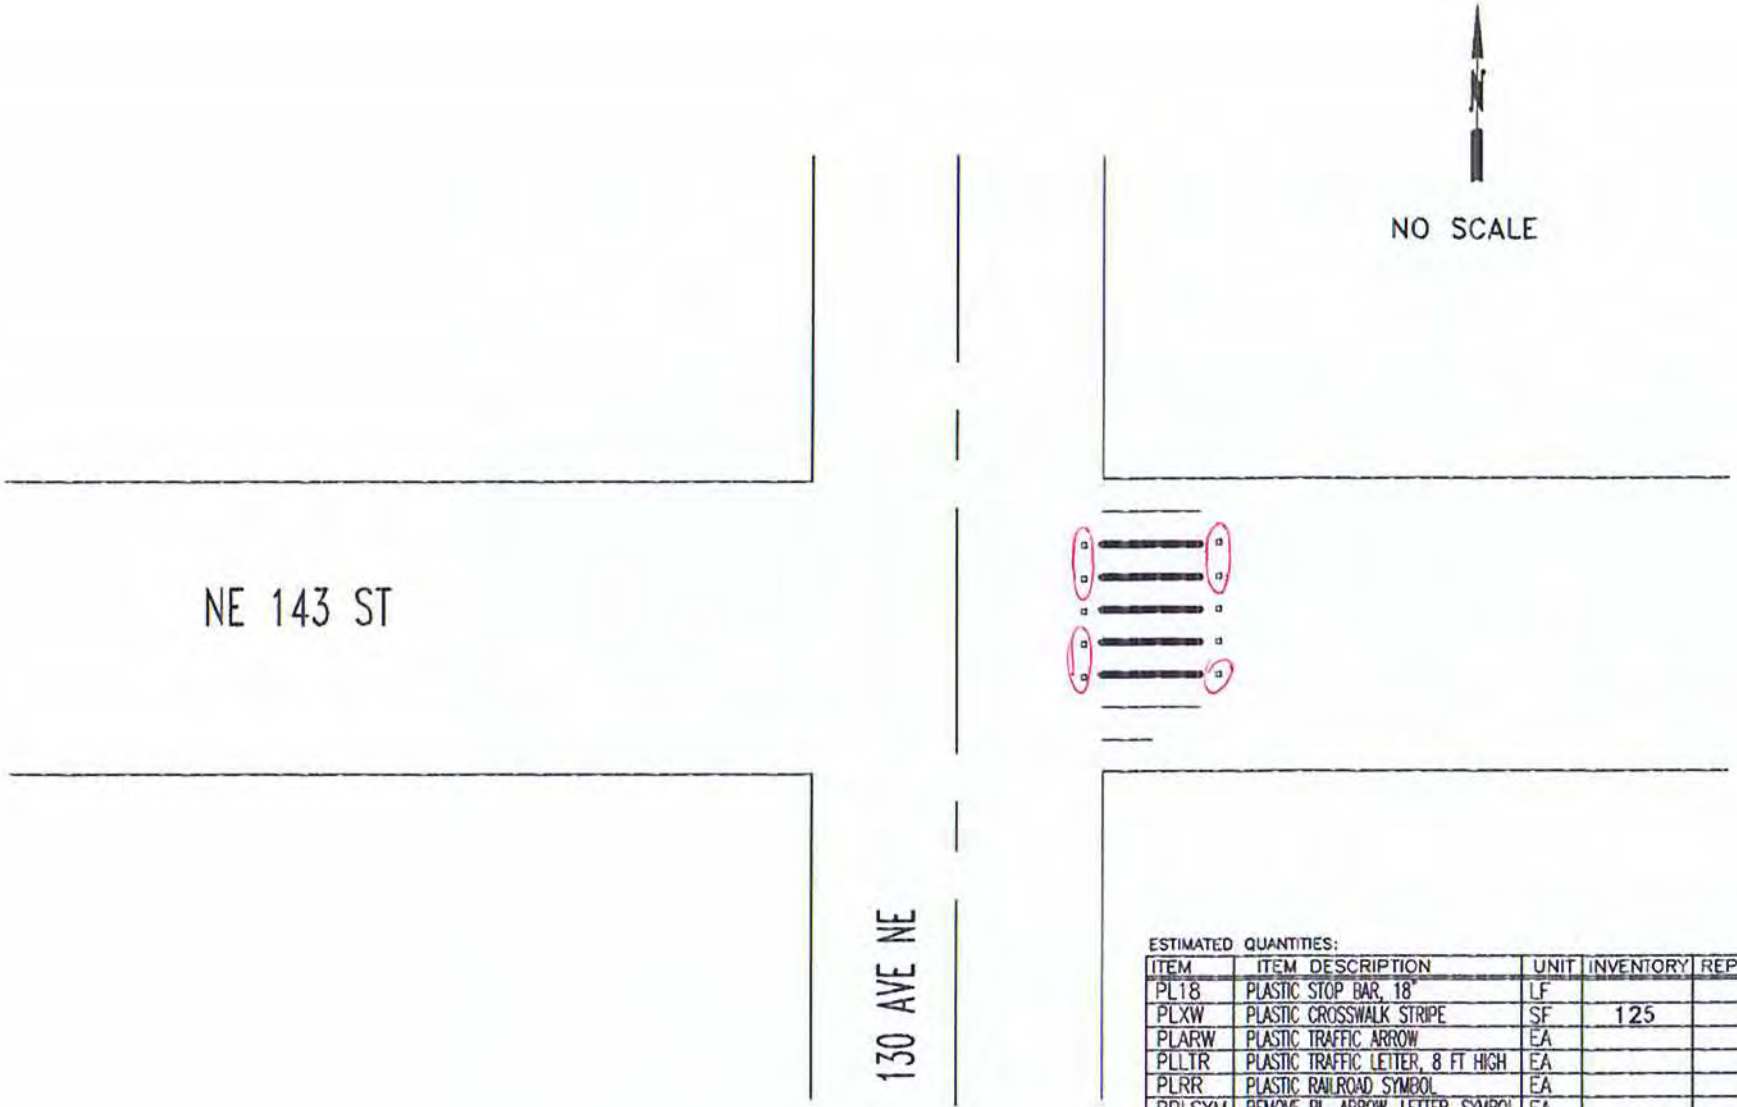

ESTIMATED QUANTITIES:

ITEM	ITEM DESCRIPTION	UNIT	INVENTORY	REPAIR QTY
PL18	PLASTIC STOP BAR, 18"	LF		
PLXW	PLASTIC CROSSWALK STRIPE	SF	125	
PLARW	PLASTIC TRAFFIC ARROW	EA		
PLLTR	PLASTIC TRAFFIC LETTER, 8 FT HIGH	EA		
PLRR	PLASTIC RAILROAD SYMBOL	EA		
RPLSYM	REMOVE PL. ARROW, LETTER, SYMBOL	EA		
RRPM	REMOVE RPM	EA		
RPLXW	REMOVE PLASTIC STRIPE	SF		
	RAISED PAVEMENT MARKER TYPE 2	EA	10	7

CITY OF KIRKLAND
DEPARTMENT OF PUBLIC WORKS
123 FIFTH AVENUE KIRKLAND, WA 98033
(425) 587-3800 www.kirklandwa.gov

LANE KAWAOKA 3/2016
DESIGNED BY: DATE

J.JENNINGS 3/2016
DRAWN BY: DATE

CHECKED BY: DATE

2022 PAVEMENT MARKING PROGRAM

STREET: NE 143 ST

CROSS STREET: 130 AVE NE

SEGMENT:

SCALE: N.T.S.

FILENAME:

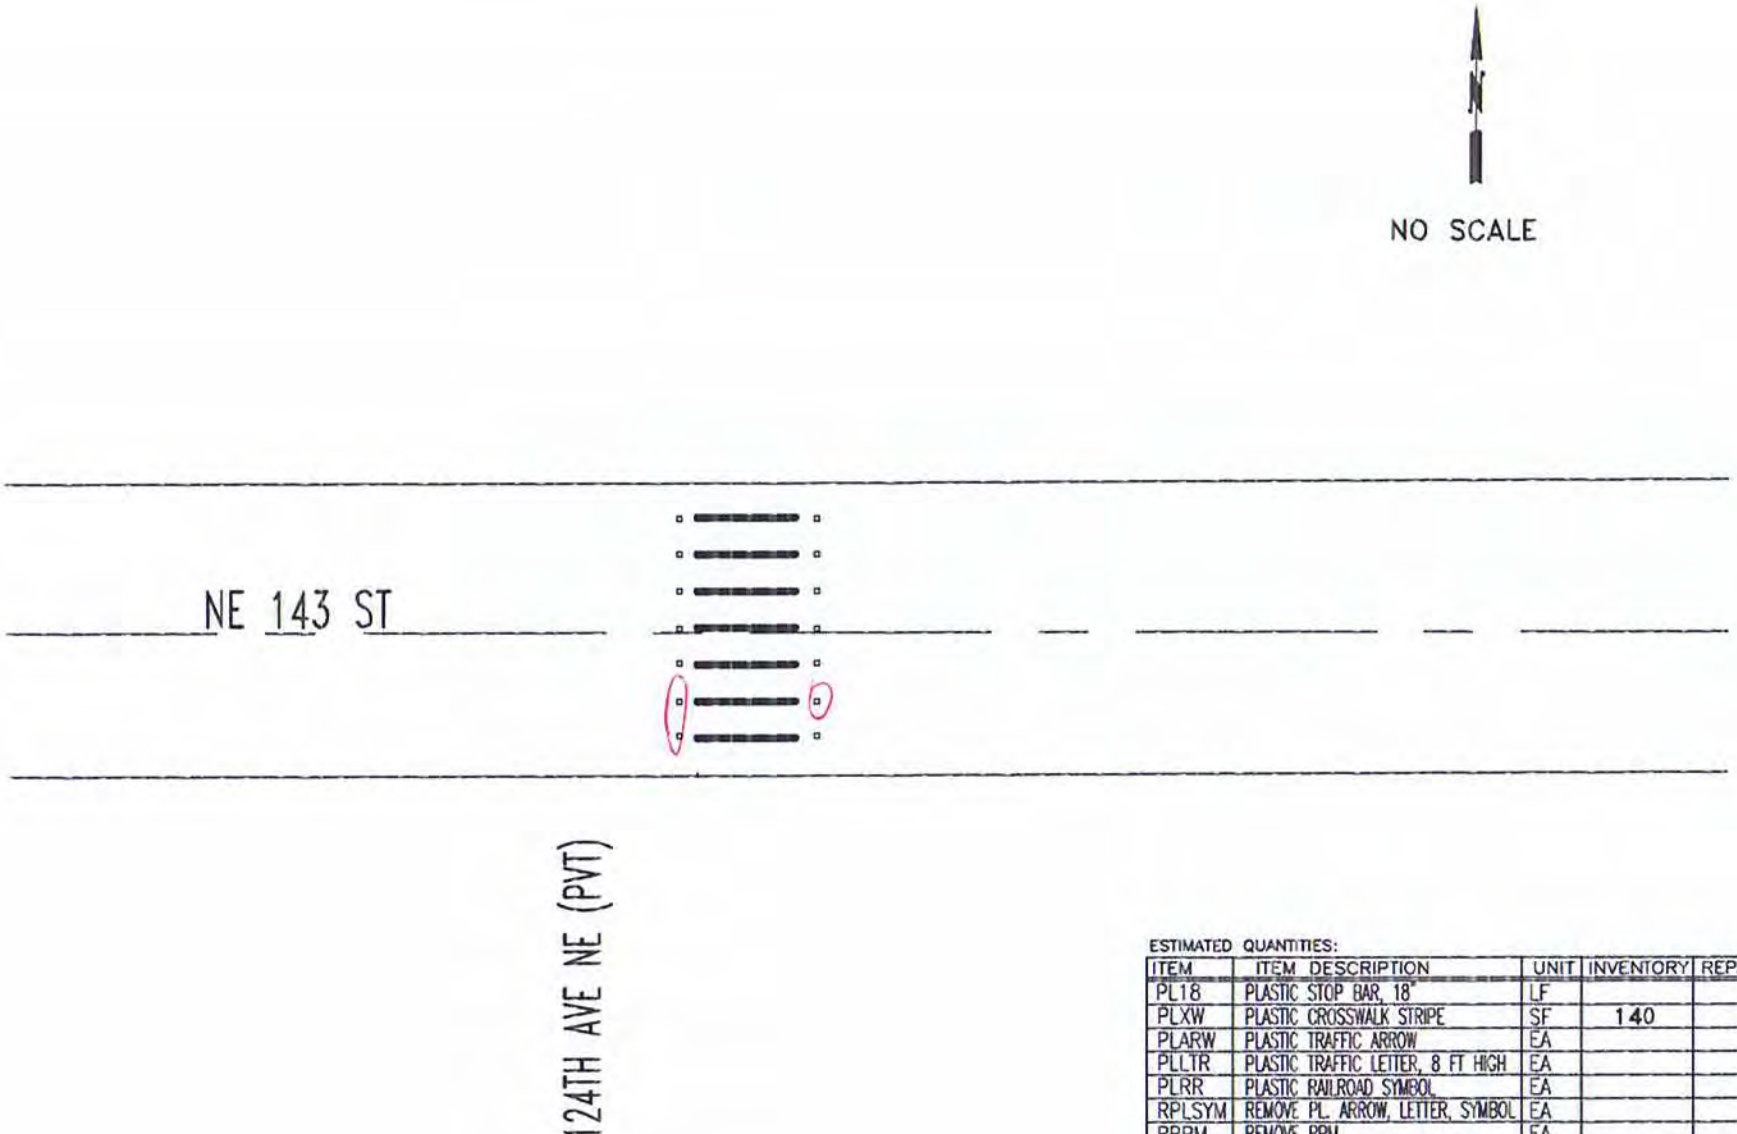

ESTIMATED QUANTITIES:

ITEM	ITEM DESCRIPTION	UNIT	INVENTORY	REPAIR QTY
PL18	PLASTIC STOP BAR, 18"	LF		
PLXW	PLASTIC CROSSWALK STRIPE	SF	140	
PLARW	PLASTIC TRAFFIC ARROW	EA		
PLLTR	PLASTIC TRAFFIC LETTER, 8 FT HIGH	EA		
PLRR	PLASTIC RAILROAD SYMBOL	EA		
RPLSYM	REMOVE PL. ARROW, LETTER, SYMBOL	EA		
RRPM	REMOVE RPM	EA		
RPLXW	REMOVE PLASTIC STRIPE	SF		
	RAISED PAVEMENT MARKER TYPE 2	EA	14	3

CITY OF KIRKLAND
DEPARTMENT OF PUBLIC WORKS
123 FIFTH AVENUE KIRKLAND, WA 98033
(425) 587-3800 www.kirklandwa.gov

LANE KAWAOKA 3/2016
DESIGNED BY: DATE
J.JENNINGS 3/2016
DRAWN BY: DATE
CHECKED BY: DATE

2022 PAVEMENT MARKING PROGRAM

STREET: NE 143 ST


SEGMENT:

SCALE: N.T.S.

FILENAME:

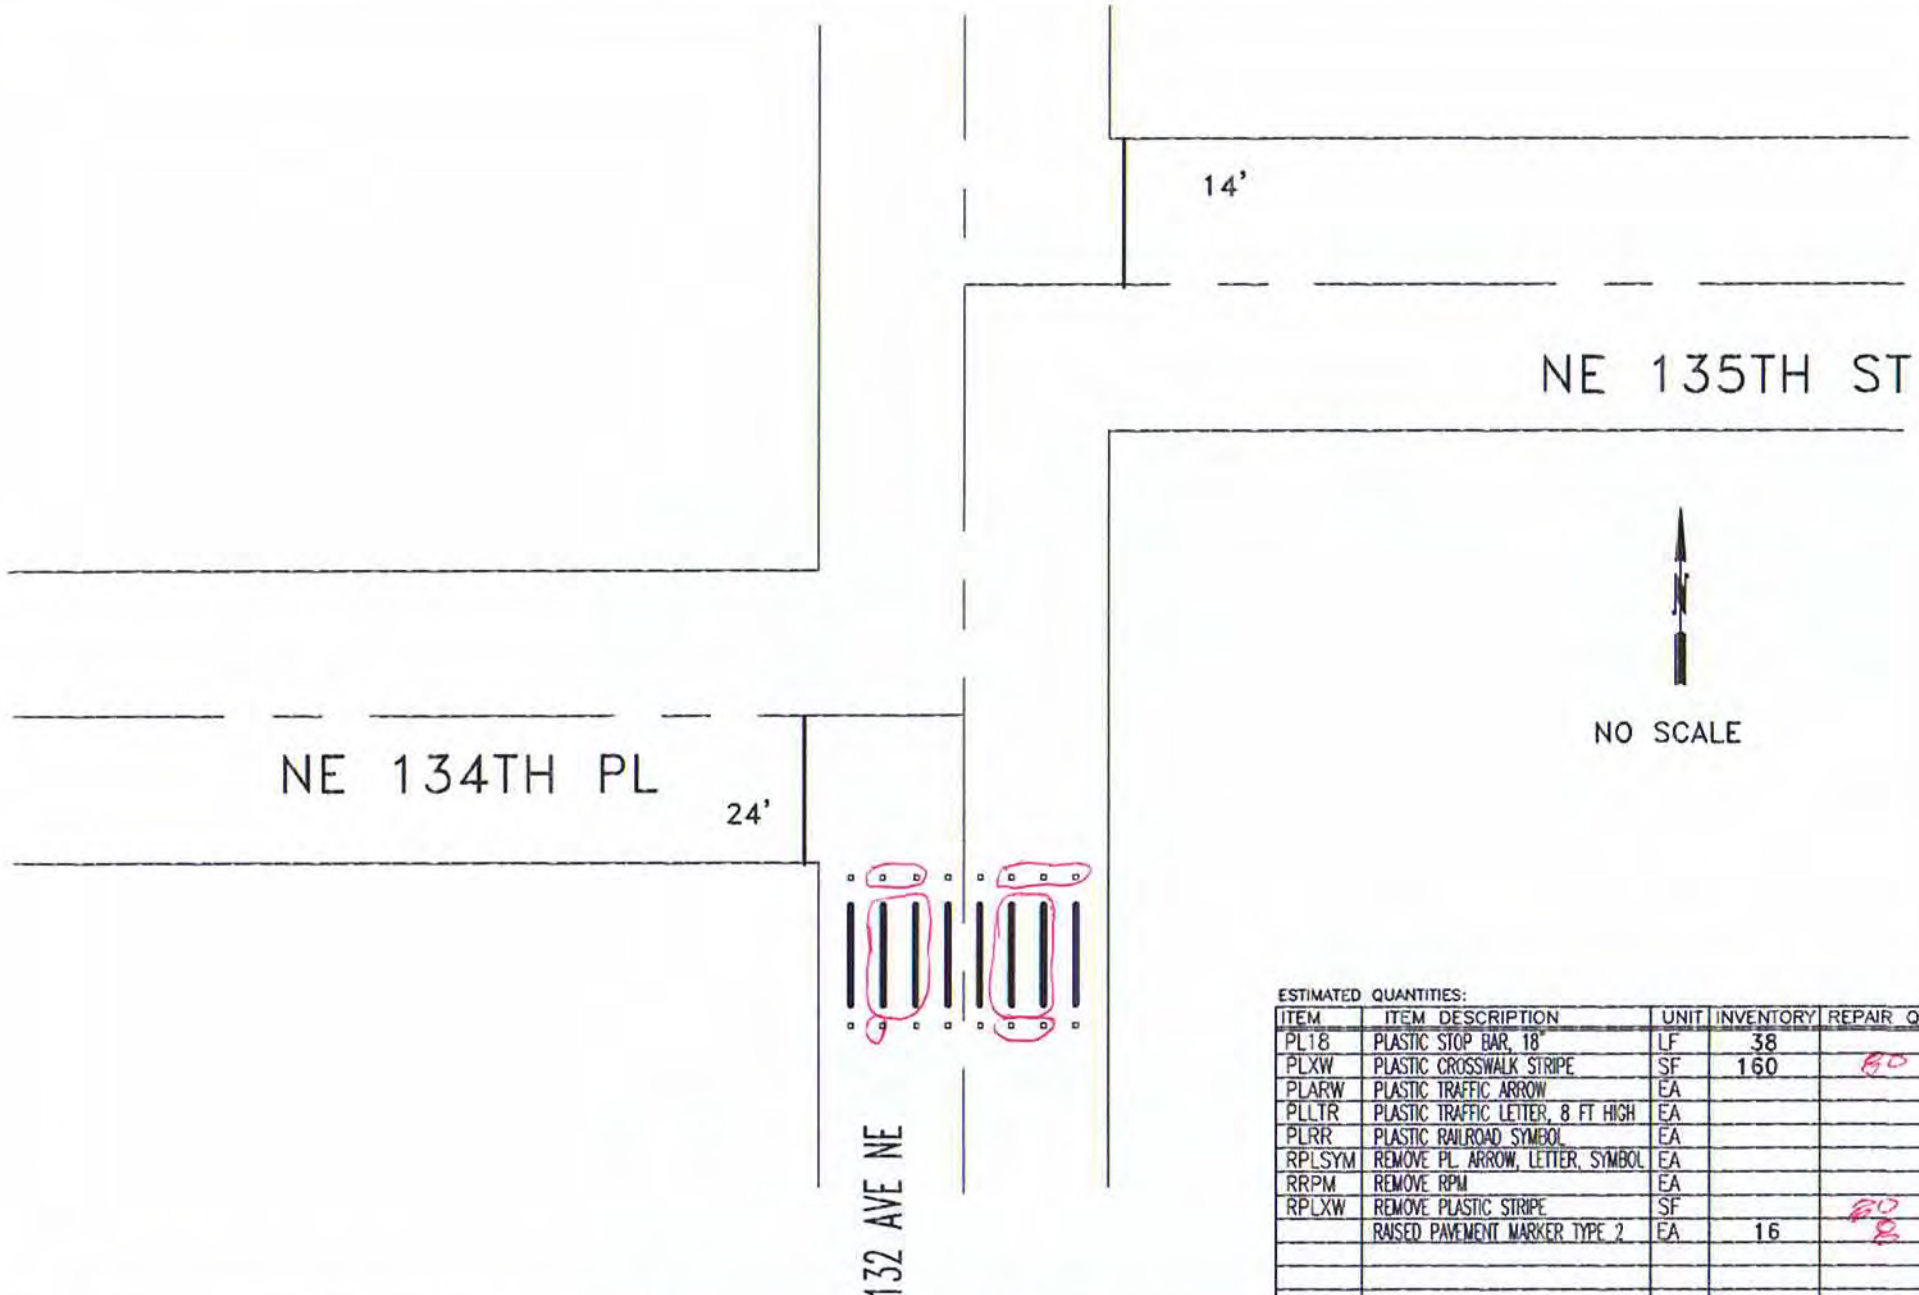

ESTIMATED QUANTITIES:

ITEM	ITEM DESCRIPTION	UNIT	INVENTORY	REPAIR QTY
PL18	PLASTIC STOP BAR, 18"	LF	38	
PLXW	PLASTIC CROSSWALK STRIPE	SF	160	80
PLARW	PLASTIC TRAFFIC ARROW	EA		
PLLTR	PLASTIC TRAFFIC LETTER, 8 FT HIGH	EA		
PLRR	PLASTIC RAILROAD SYMBOL	EA		
RPLSYM	REMOVE PL. ARROW, LETTER, SYMBOL	EA		
RRPM	REMOVE RPM	EA		
RPLXW	REMOVE PLASTIC STRIPE	SF		80
	RAISED PAVEMENT MARKER TYPE 2	EA	16	8

CITY OF KIRKLAND WASHINGTON

CITY OF KIRKLAND
DEPARTMENT OF PUBLIC WORKS
123 FIFTH AVENUE KIRKLAND, WA 98033
(425) 587-3800 www.kirklandwa.gov

L KAWAOKA 3/2016
DESIGNED BY: DATE

J.JENNINGS 3/2016
DRAWN BY: DATE

CHECKED BY: DATE

2020 PAVEMENT MARKING PROGRAM

STREET: 132ND AVE NE

CROSS STREET: NE 134TH PL & NE 135TH ST

SEGMENT:

SCALE: N.T.S.

FILENAME:

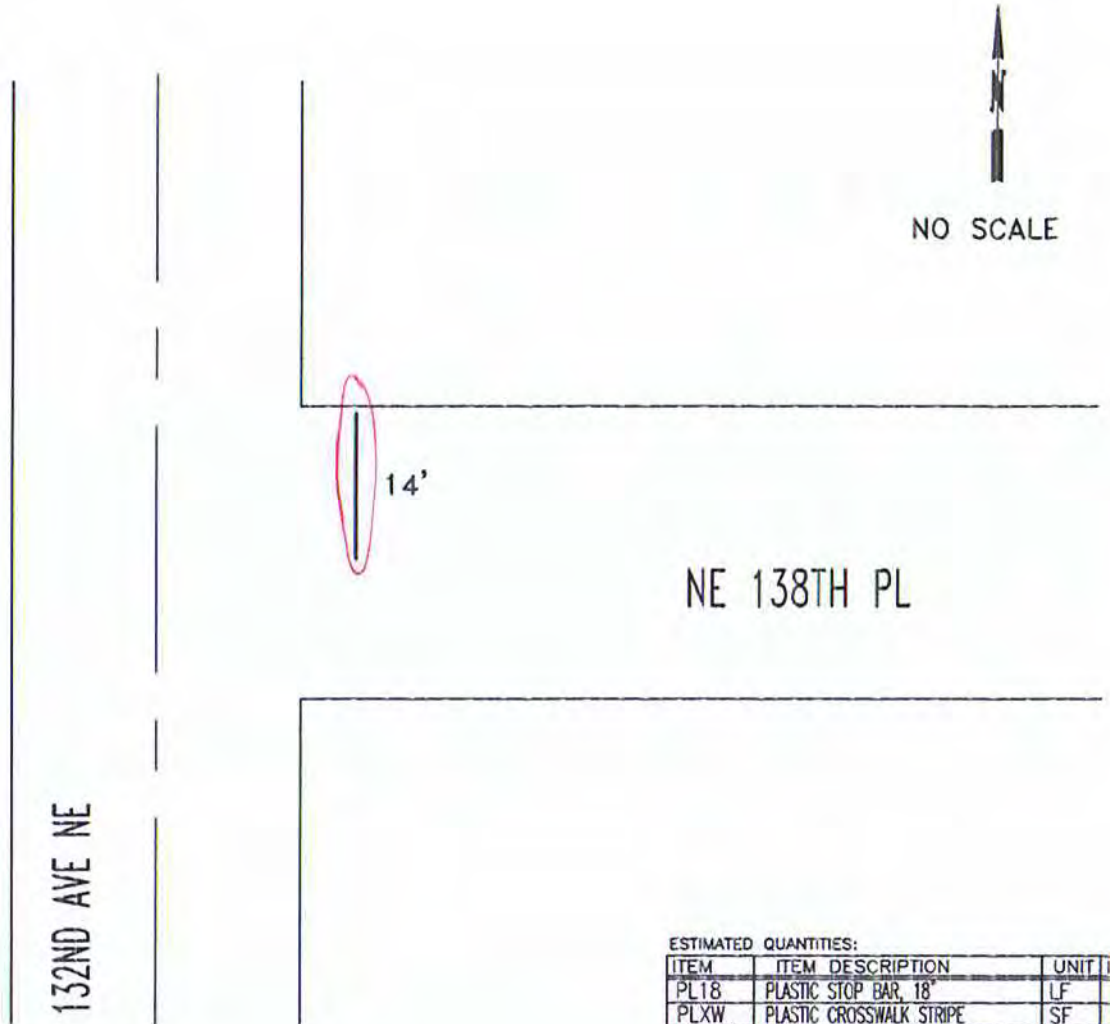

ESTIMATED QUANTITIES:

ITEM	ITEM DESCRIPTION	UNIT	INVENTORY	REPAIR QTY
PL18	PLASTIC STOP BAR, 18"	LF	14	14
PLXW	PLASTIC CROSSWALK STRIPE	SF		
PLARW	PLASTIC TRAFFIC ARROW	EA		
PLLTR	PLASTIC TRAFFIC LETTER, 8 FT HIGH	EA		
PLRR	PLASTIC RAILROAD SYMBOL	EA		
RPLSYM	REMOVE PL. ARROW, LETTER, SYMBOL	EA		
RRPM	REMOVE RPM	EA		
RPLXW	REMOVE PLASTIC STRIPE	SF		

CITY OF KIRKLAND
DEPARTMENT OF PUBLIC WORKS
123 FIFTH AVENUE KIRKLAND, WA 98033
(425) 587-3800 www.kirklandwa.gov

L KAWAOKA 3/2016
DESIGNED BY: DATE

J.JENNINGS 3/2016
DRAWN BY: DATE

CHECKED BY: DATE

20~~21~~22 PAVEMENT MARKING PROGRAM

STREET: 132ND AVE NE

CROSS STREET: NE 138TH PL

SEGMENT:

SCALE: N.T.S.

FILENAME: Page 3-43

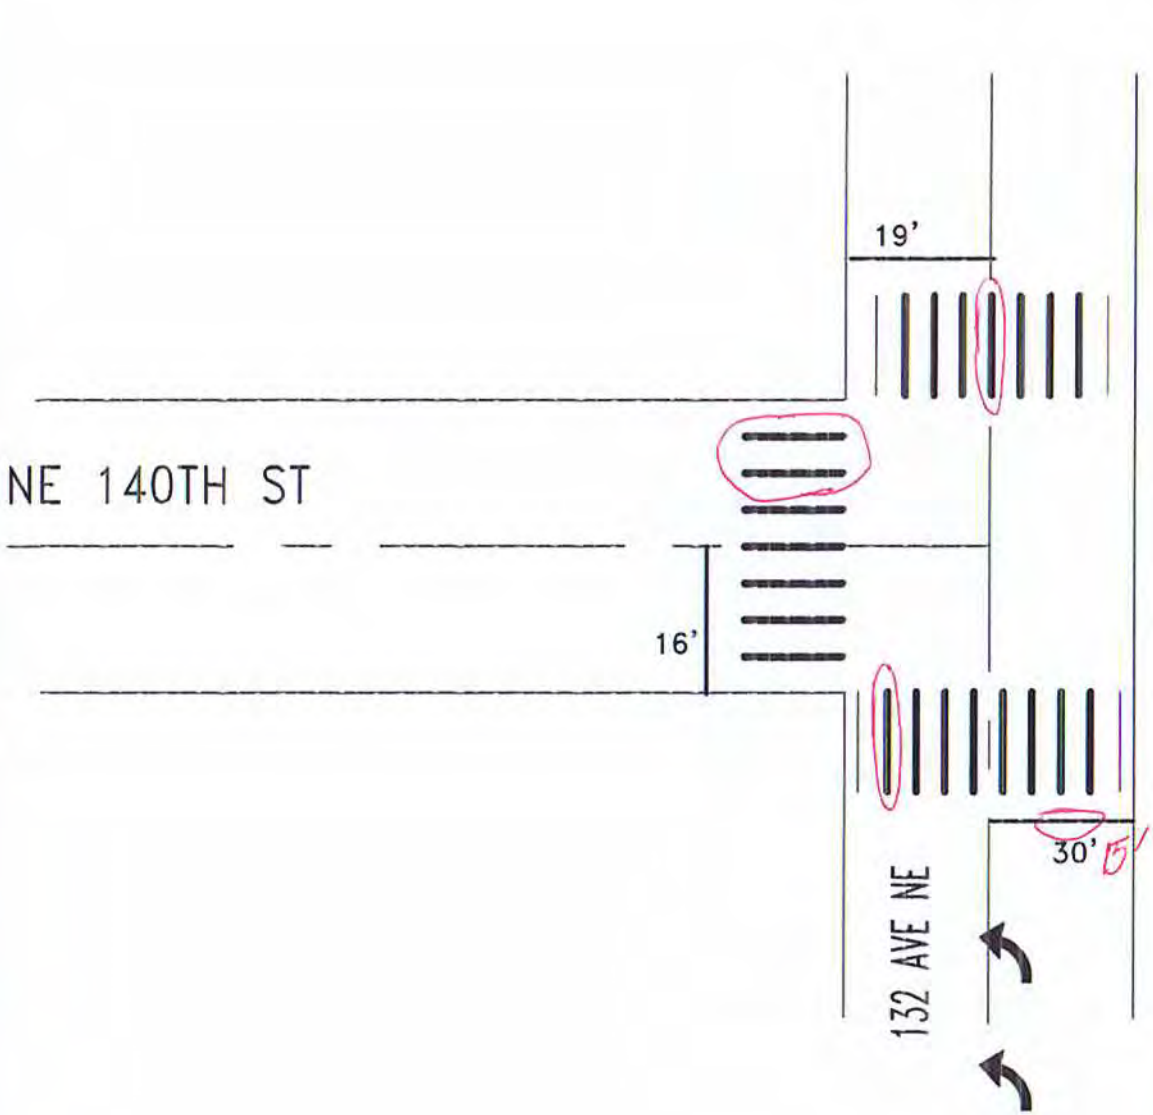

NO SCALE

ESTIMATED QUANTITIES:

ITEM	ITEM DESCRIPTION	UNIT	INVENTORY	REPAIR QTY
PL18	PLASTIC STOP BAR, 18"	LF	49	13
PLXW	PLASTIC CROSSWALK STRIPE	SF	440	50
PLARW	PLASTIC TRAFFIC ARROW	EA	2	
PLLTR	PLASTIC TRAFFIC LETTER, 8 FT HIGH	EA		
PLRR	PLASTIC RAILROAD SYMBOL	EA		
RPLSYM	REMOVE PL. ARROW, LETTER, SYMBOL	EA		
RRPM	REMOVE RPM	EA		
RPLXW	REMOVE PLASTIC STRIPE	SF		60

CITY OF KIRKLAND
DEPARTMENT OF PUBLIC WORKS
123 FIFTH AVENUE KIRKLAND, WA 98033
(425) 587-3800 www.kirklandwa.gov

L KAWAOKA 3/2016
DESIGNED BY: DATE

J.JENNINGS 3/2016
DRAWN BY: DATE

CHECKED BY: DATE

2020 PAVEMENT MARKING PROGRAM

STREET: 132ND AVE NE

CROSS STREET: NE 140TH ST

SEGMENT:

SCALE: N.T.S.

FILENAME:

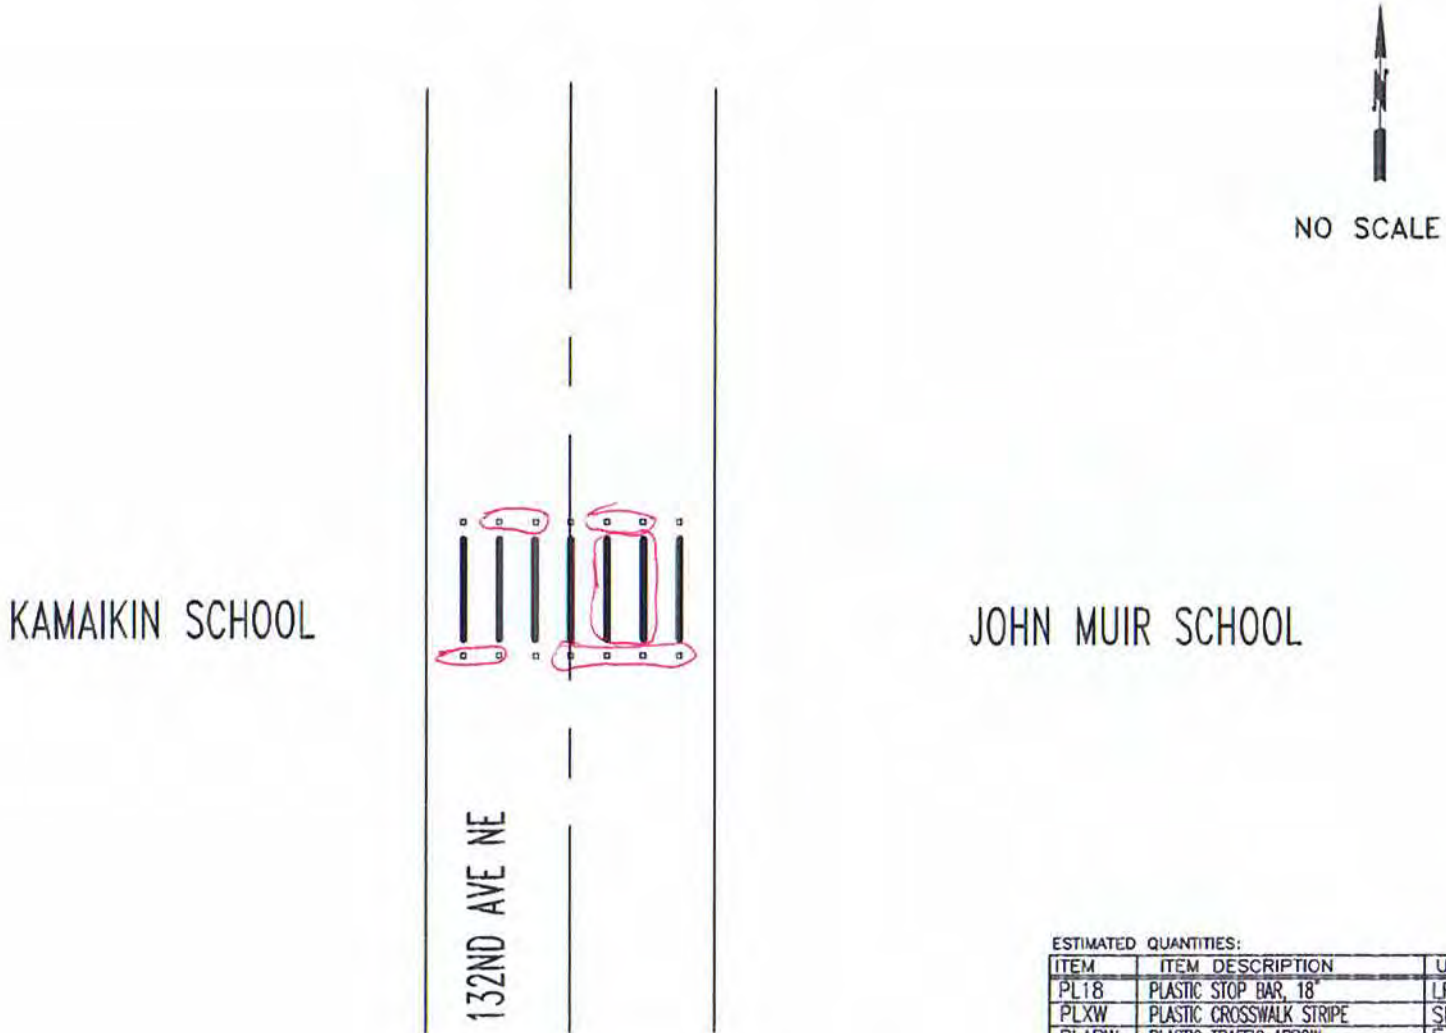

ESTIMATED QUANTITIES:

ITEM	ITEM DESCRIPTION	UNIT	INVENTORY	REPAIR QTY
PL18	PLASTIC STOP BAR, 18"	LF		
PLXW	PLASTIC CROSSWALK STRIPE	SF	140	40
PLARW	PLASTIC TRAFFIC ARROW	EA		
PLLTR	PLASTIC TRAFFIC LETTER, 8 FT HIGH	EA		
PLRR	PLASTIC RAILROAD SYMBOL	EA		
RPLSYM	REMOVE PL. ARROW, LETTER, SYMBOL	EA		
RRPM	REMOVE RPM	EA		
RPLXW	REMOVE PLASTIC STRIPE	SF		
	RAISED PAVEMENT MARKER TYPE 2	EA	14	10

CITY OF KIRKLAND
DEPARTMENT OF PUBLIC WORKS
123 FIFTH AVENUE KIRKLAND, WA 98033
(425) 587-3800 www.kirklandwa.gov

L. KAWAOKA 3/2016
DESIGNED BY: DATE

J.JENNINGS 3/2016
DRAWN BY: DATE

CHECKED BY: DATE

20~~21~~22 PAVEMENT MARKING PROGRAM

STREET: 132ND AVE NE

CROSS STREET: KAMAIKIN SCHOOL

SEGMENT:

SCALE: N.T.S.

FILENAME:

EVEREST
INTERSECTION PLANS

CITY OF KIRKLAND
DEPARTMENT OF PUBLIC WORKS
123 FIFTH AVENUE KIRKLAND, WA 98033
(425) 587-3800 www.kirklandwa.gov

S GONSAR	1/2019	DESIGNED BY: DATE
J.JENNINGS	1/2019	DRAWN BY: DATE
		CHECKED BY: DATE

2020 PAVEMENT MARKING PROGRAM

STREET:

CROSS STREET:

SEGMENT:

SCALE: N.T.S.

FILENAME: 11-0

NO SCALE

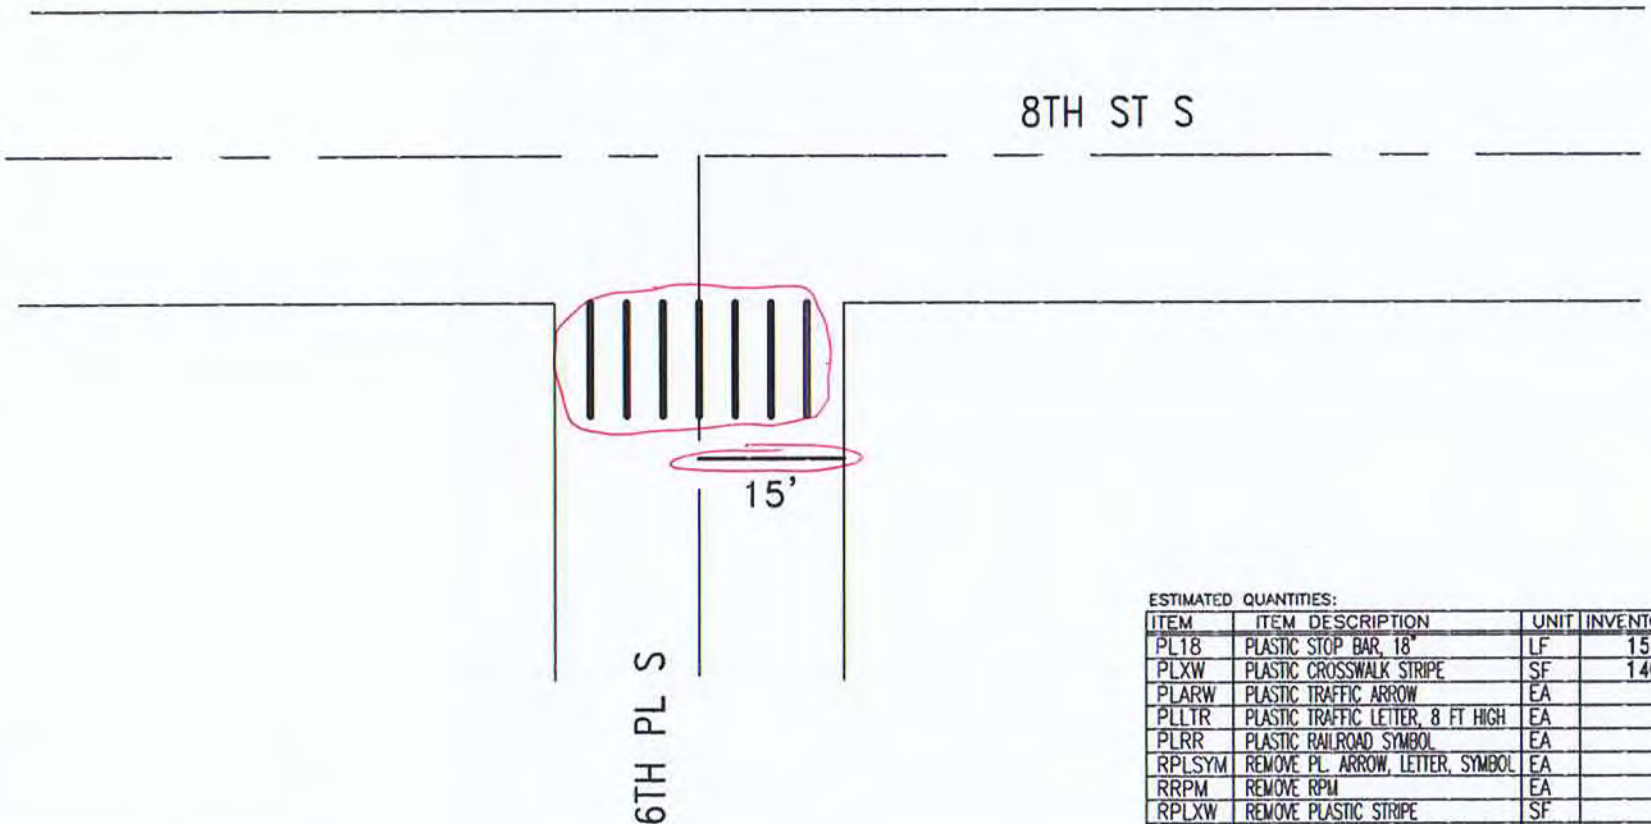

ESTIMATED QUANTITIES:

ITEM	ITEM DESCRIPTION	UNIT	INVENTORY	REPAIR QTY
PL18	PLASTIC STOP BAR, 18"	LF	15	15
PLXW	PLASTIC CROSSWALK STRIPE	SF	140	140
PLARW	PLASTIC TRAFFIC ARROW	EA		
PLLTR	PLASTIC TRAFFIC LETTER, 8 FT HIGH	EA		
PLRR	PLASTIC RAILROAD SYMBOL	EA		
RPLSYM	REMOVE PL. ARROW, LETTER, SYMBOL	EA		
RRPM	REMOVE RPM	EA		
RPLXW	REMOVE PLASTIC STRIPE	SF		160

CITY OF KIRKLAND
DEPARTMENT OF PUBLIC WORKS
123 FIFTH AVENUE KIRKLAND, WA 98033
(425) 587-3800 www.kirklandwa.gov

R. STEITZER 8/2005
DESIGNED BY: DATE

J.JENNINGS 8/2005
DRAWN BY: DATE

CHECKED BY: DATE

2022 PAVEMENT MARKING PROGRAM

STREET: 8TH ST S

CROSS STREET: 6TH PL S

SEGMENT:

SCALE: N.T.S.

FILENAME:

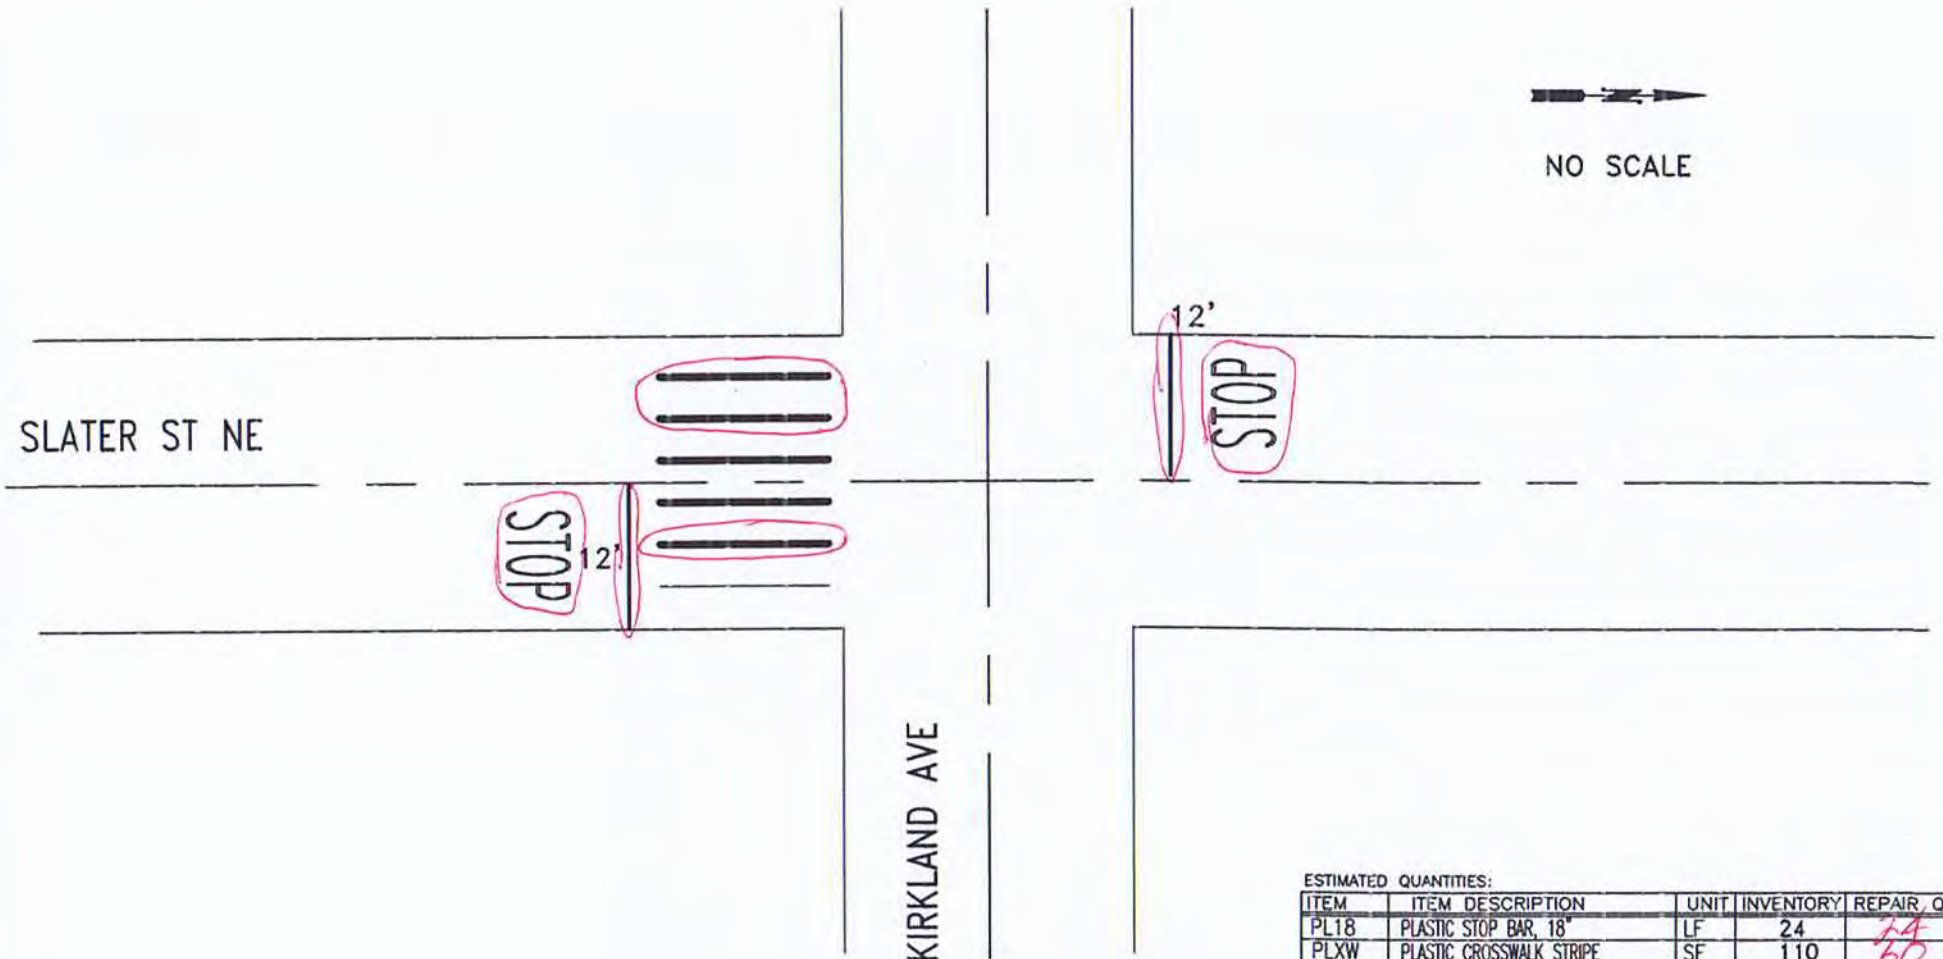

ESTIMATED QUANTITIES:

ITEM	ITEM DESCRIPTION	UNIT	INVENTORY	REPAIR QTY
PL18	PLASTIC STOP BAR, 18"	LF	24	24
PLXW	PLASTIC CROSSWALK STRIPE	SF	110	60
PLARW	PLASTIC TRAFFIC ARROW	EA		
PLLTR	PLASTIC TRAFFIC LETTER, 8 FT HIGH	EA	8	8
PLRR	PLASTIC RAILROAD SYMBOL	EA		
RPLSYM	REMOVE PL. ARROW, LETTER, SYMBOL	EA		
RRPM	REMOVE RPM	EA		
RPLXW	REMOVE PLASTIC STRIPE	SF		40

CITY OF KIRKLAND
DEPARTMENT OF PUBLIC WORKS
123 FIFTH AVENUE KIRKLAND, WA 98033
(425) 587-3800 www.kirklandwa.gov

G. HORTILLOSA 10/2011
DESIGNED BY: DATE

J.JENNINGS 10/2011
DRAWN BY: DATE

CHECKED BY: DATE

2022 PAVEMENT MARKING PROGRAM

STREET: SLATER AVE NE

CROSS STREET: KIRKLAND AVE

SEGMENT:

SCALE: N.T.S.

FILENAME:

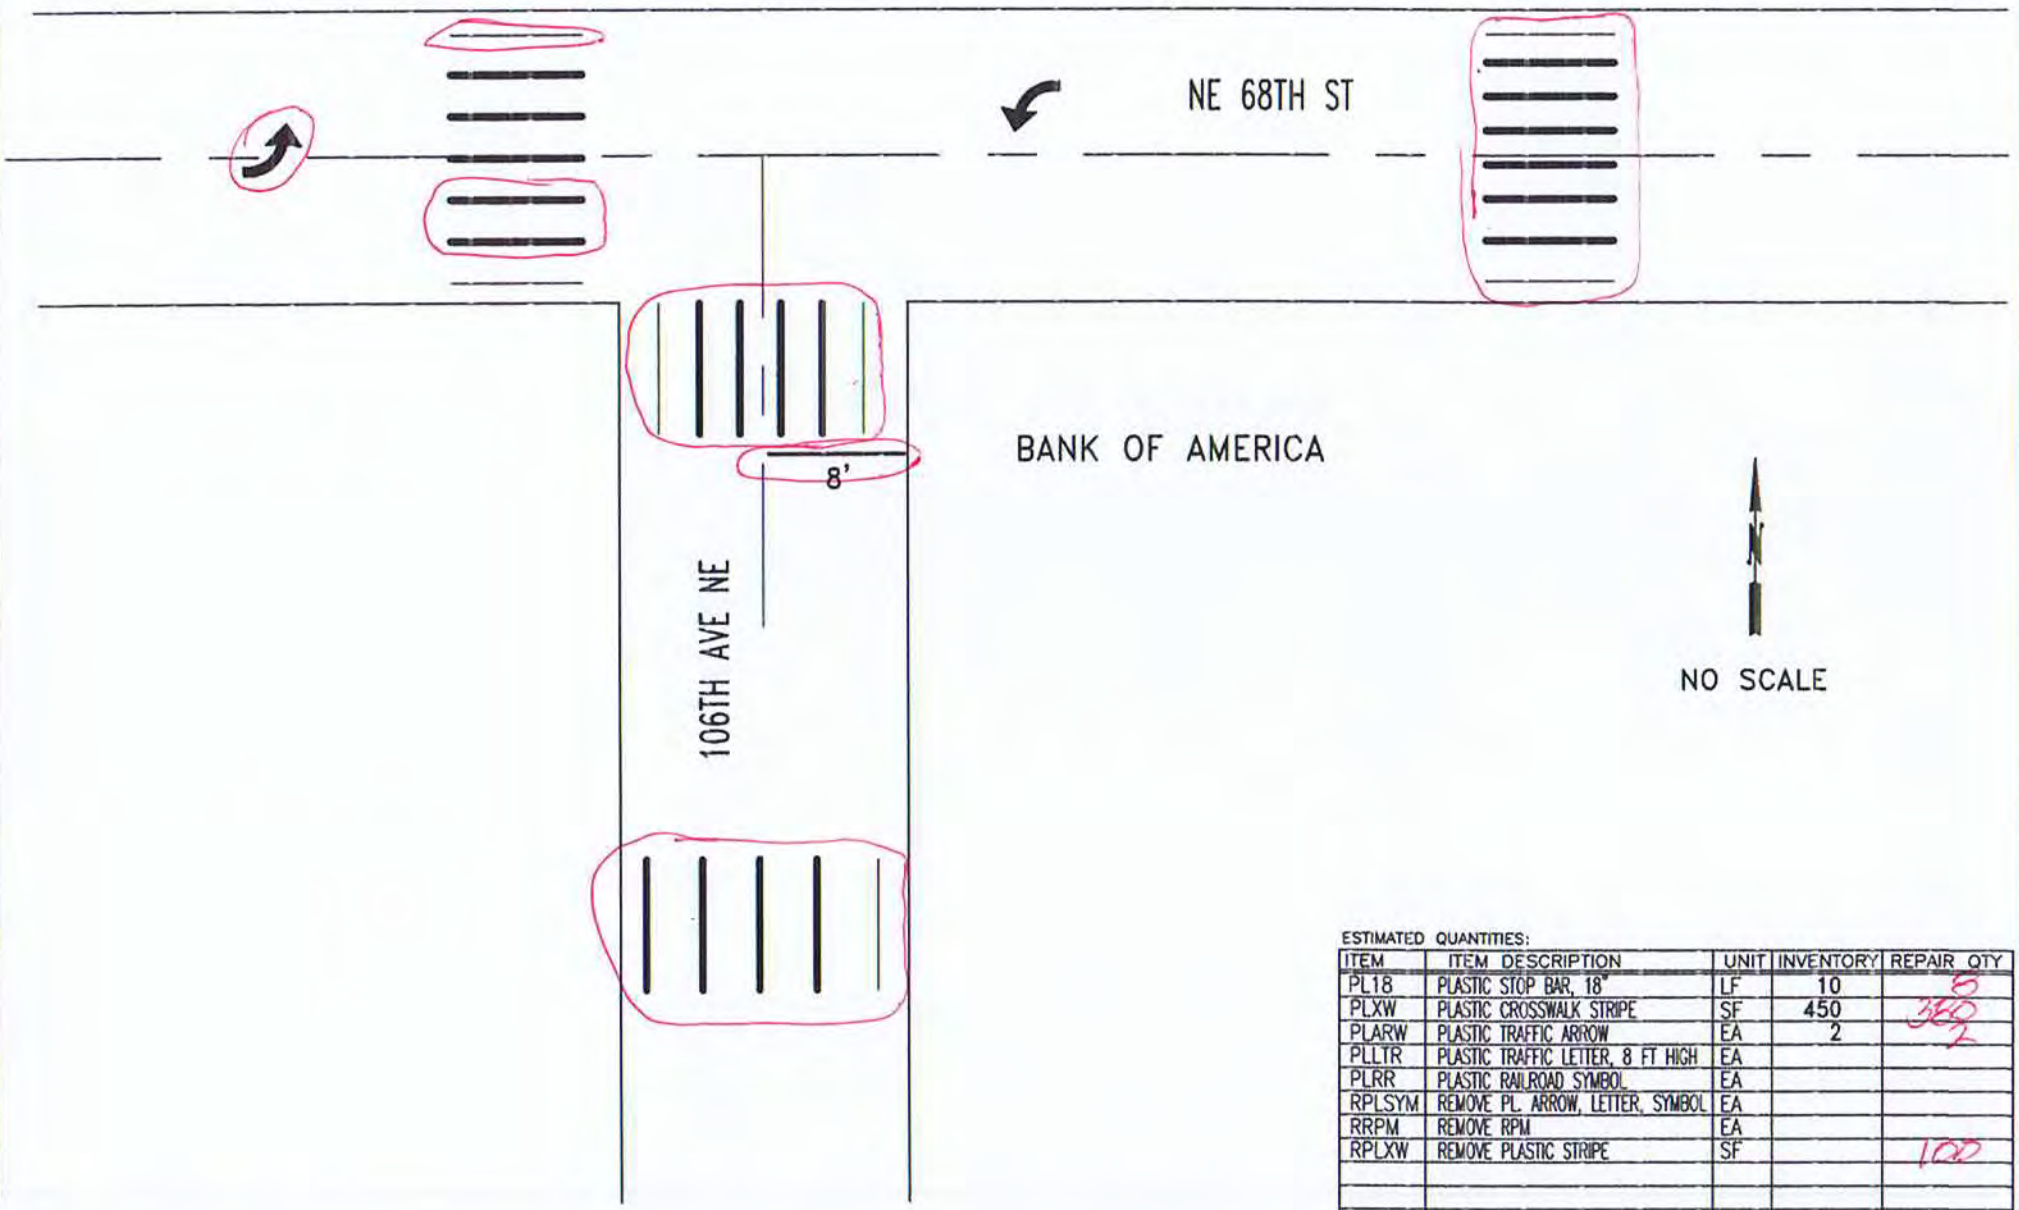

ESTIMATED QUANTITIES:

ITEM	ITEM DESCRIPTION	UNIT	INVENTORY	REPAIR QTY
PL18	PLASTIC STOP BAR, 18"	LF	10	5
PLXW	PLASTIC CROSSWALK STRIPE	SF	450	350
PLARW	PLASTIC TRAFFIC ARROW	EA	2	2
PLLTR	PLASTIC TRAFFIC LETTER, 8 FT HIGH	EA		
PLRR	PLASTIC RAILROAD SYMBOL	EA		
RPLSYM	REMOVE PL. ARROW, LETTER, SYMBOL	EA		
RRPM	REMOVE RPM	EA		
RPLXW	REMOVE PLASTIC STRIPE	SF		100

CITY OF KIRKLAND
DEPARTMENT OF PUBLIC WORKS
123 FIFTH AVENUE KIRKLAND, WA 98033
(425) 587-3800 www.kirklandwa.gov

L. KAWAOKA 8/2016
DESIGNED BY: DATE

J.JENNINGS 8/2016
DRAWN BY: DATE

CHECKED BY: DATE

2020 PAVEMENT MARKING PROGRAM

STREET: NE 68TH ST

CROSS STREET: 106TH AVE NE

SEGMENT:

SCALE: N.T.S.

FILENAME: Page 11-5

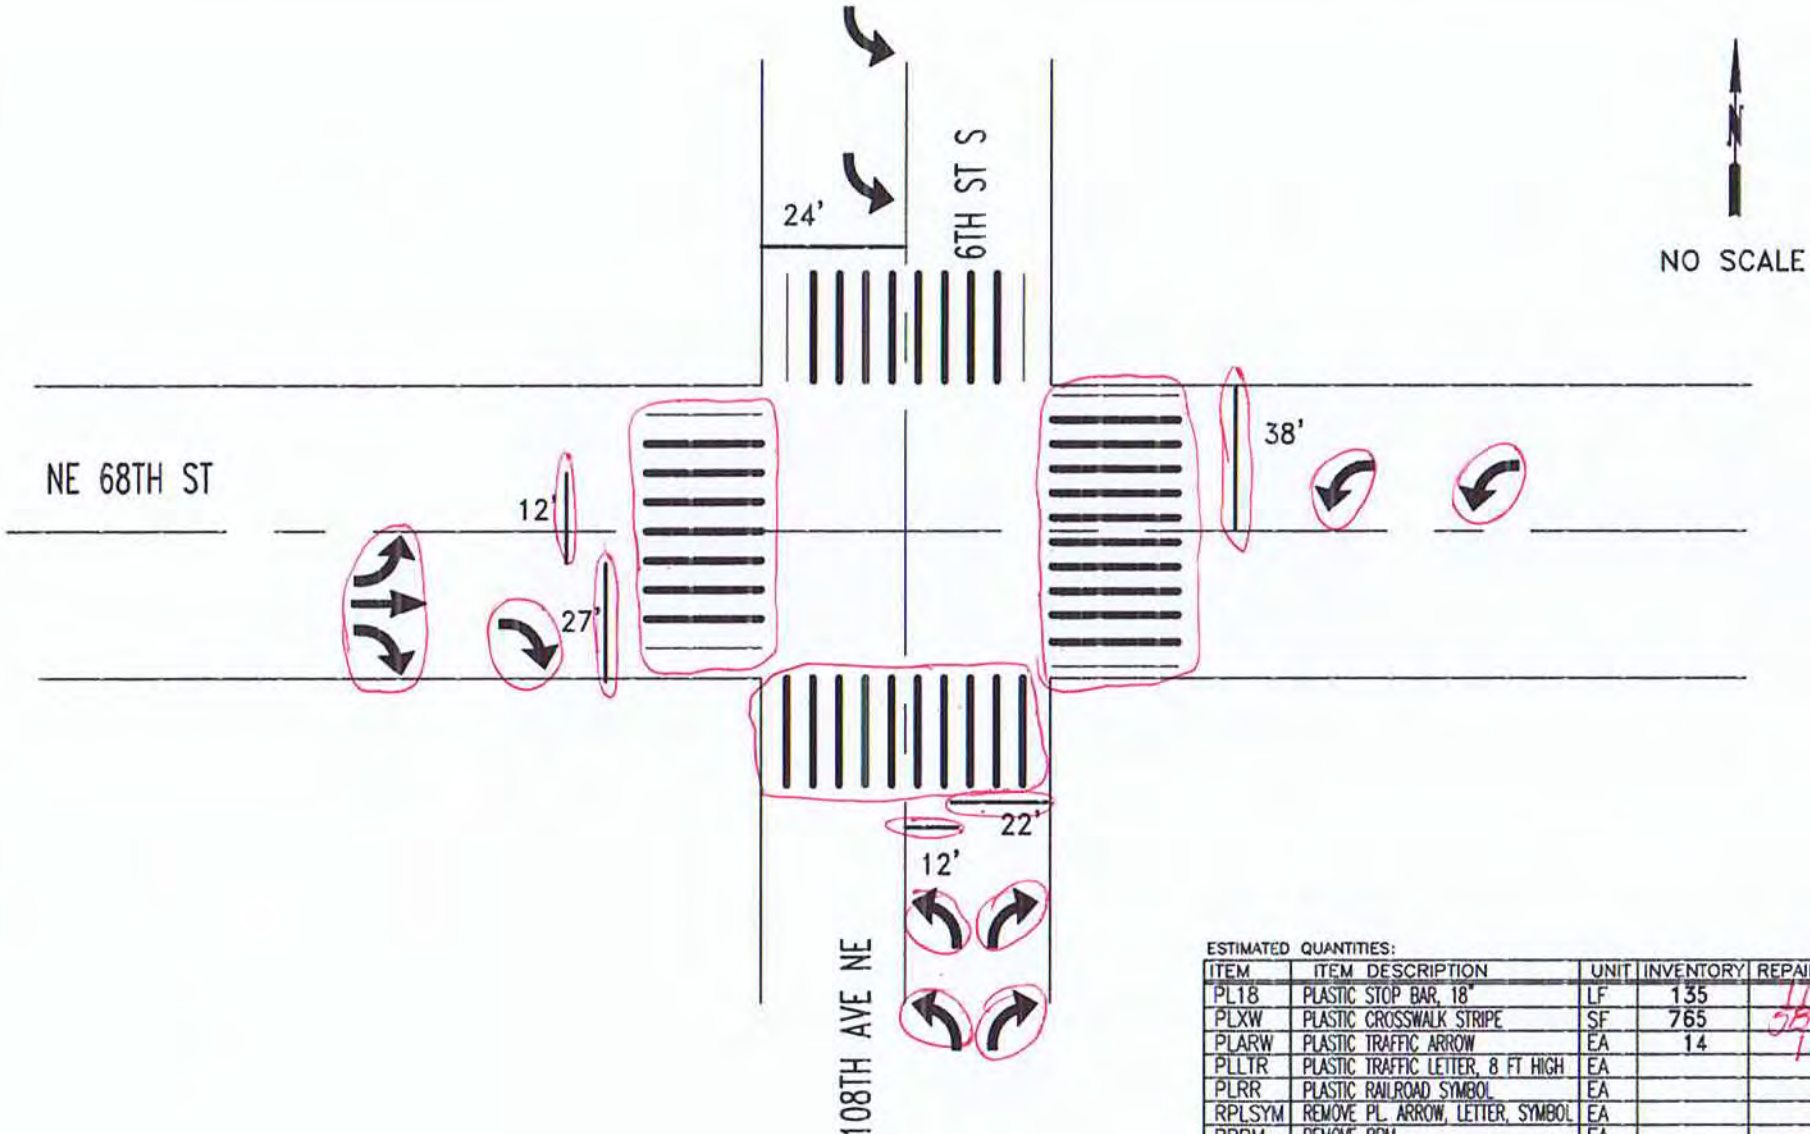

ESTIMATED QUANTITIES:

ITEM	ITEM DESCRIPTION	UNIT	INVENTORY	REPAIR QTY
PL18	PLASTIC STOP BAR, 18"	LF	135	111
PLXW	PLASTIC CROSSWALK STRIPE	SF	765	550
PLARW	PLASTIC TRAFFIC ARROW	EA	14	10
PLLTR	PLASTIC TRAFFIC LETTER, 8 FT HIGH	EA		
PLRR	PLASTIC RAILROAD SYMBOL	EA		
RPLSYM	REMOVE PL. ARROW, LETTER, SYMBOL	EA		
RRPM	REMOVE RPM	EA		
RPLXW	REMOVE PLASTIC STRIPE	SF		750

CITY OF KIRKLAND
DEPARTMENT OF PUBLIC WORKS
123 FIFTH AVENUE KIRKLAND, WA 98033
(425) 587-3800 www.kirklandwa.gov

R. STEITZER 1/2005
DESIGNED BY: DATE

J.JENNINGS 1/2005
DRAWN BY: DATE

CHECKED BY: DATE

2022 PAVEMENT MARKING PROGRAM

STREET: NE 68TH ST

CROSS STREET: 108TH AVE NE

SEGMENT:

SCALE: N.T.S.

FILENAME: Page 11-6

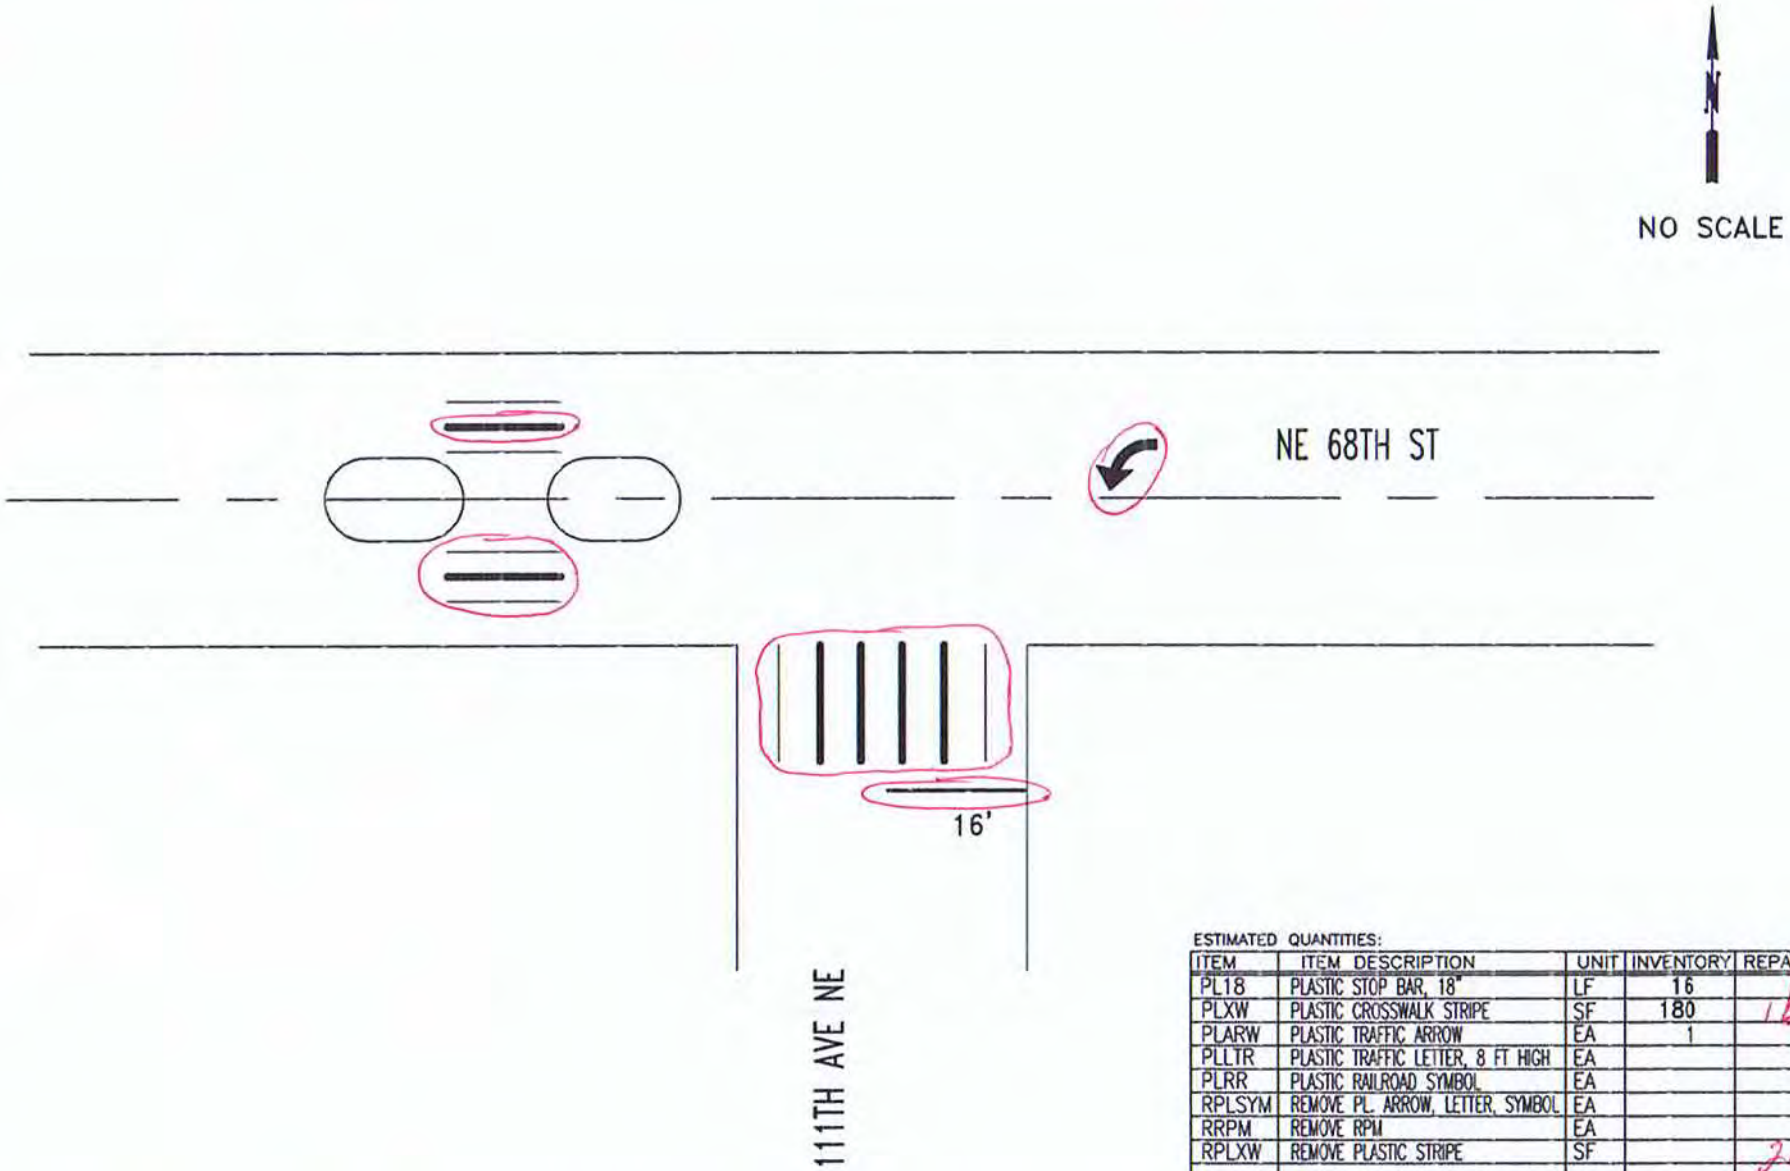

ESTIMATED QUANTITIES:

ITEM	ITEM DESCRIPTION	UNIT	INVENTORY	REPAIR QTY
PL18	PLASTIC STOP BAR, 18"	LF	16	
PLXW	PLASTIC CROSSWALK STRIPE	SF	180	160
PLARW	PLASTIC TRAFFIC ARROW	EA	1	1
PLLTR	PLASTIC TRAFFIC LETTER, 8 FT HIGH	EA		
PLRR	PLASTIC RAILROAD SYMBOL	EA		
RPLSYM	REMOVE PL. ARROW, LETTER, SYMBOL	EA		
RRPM	REMOVE RPM	EA		
RPLXW	REMOVE PLASTIC STRIPE	SF		20

CITY OF KIRKLAND
DEPARTMENT OF PUBLIC WORKS
123 FIFTH AVENUE KIRKLAND, WA 98033
(425) 587-3800 www.kirklandwa.gov

P. HERBIG 4/2014
DESIGNED BY: DATE

J.JENNINGS 4/2014
DRAWN BY: DATE

CHECKED BY: DATE

2020 PAVEMENT MARKING PROGRAM

STREET: NE 68TH ST

CROSS STREET: 111TH AVE NE

SEGMENT:

SCALE: N.T.S.

FILENAME: Page 11-7

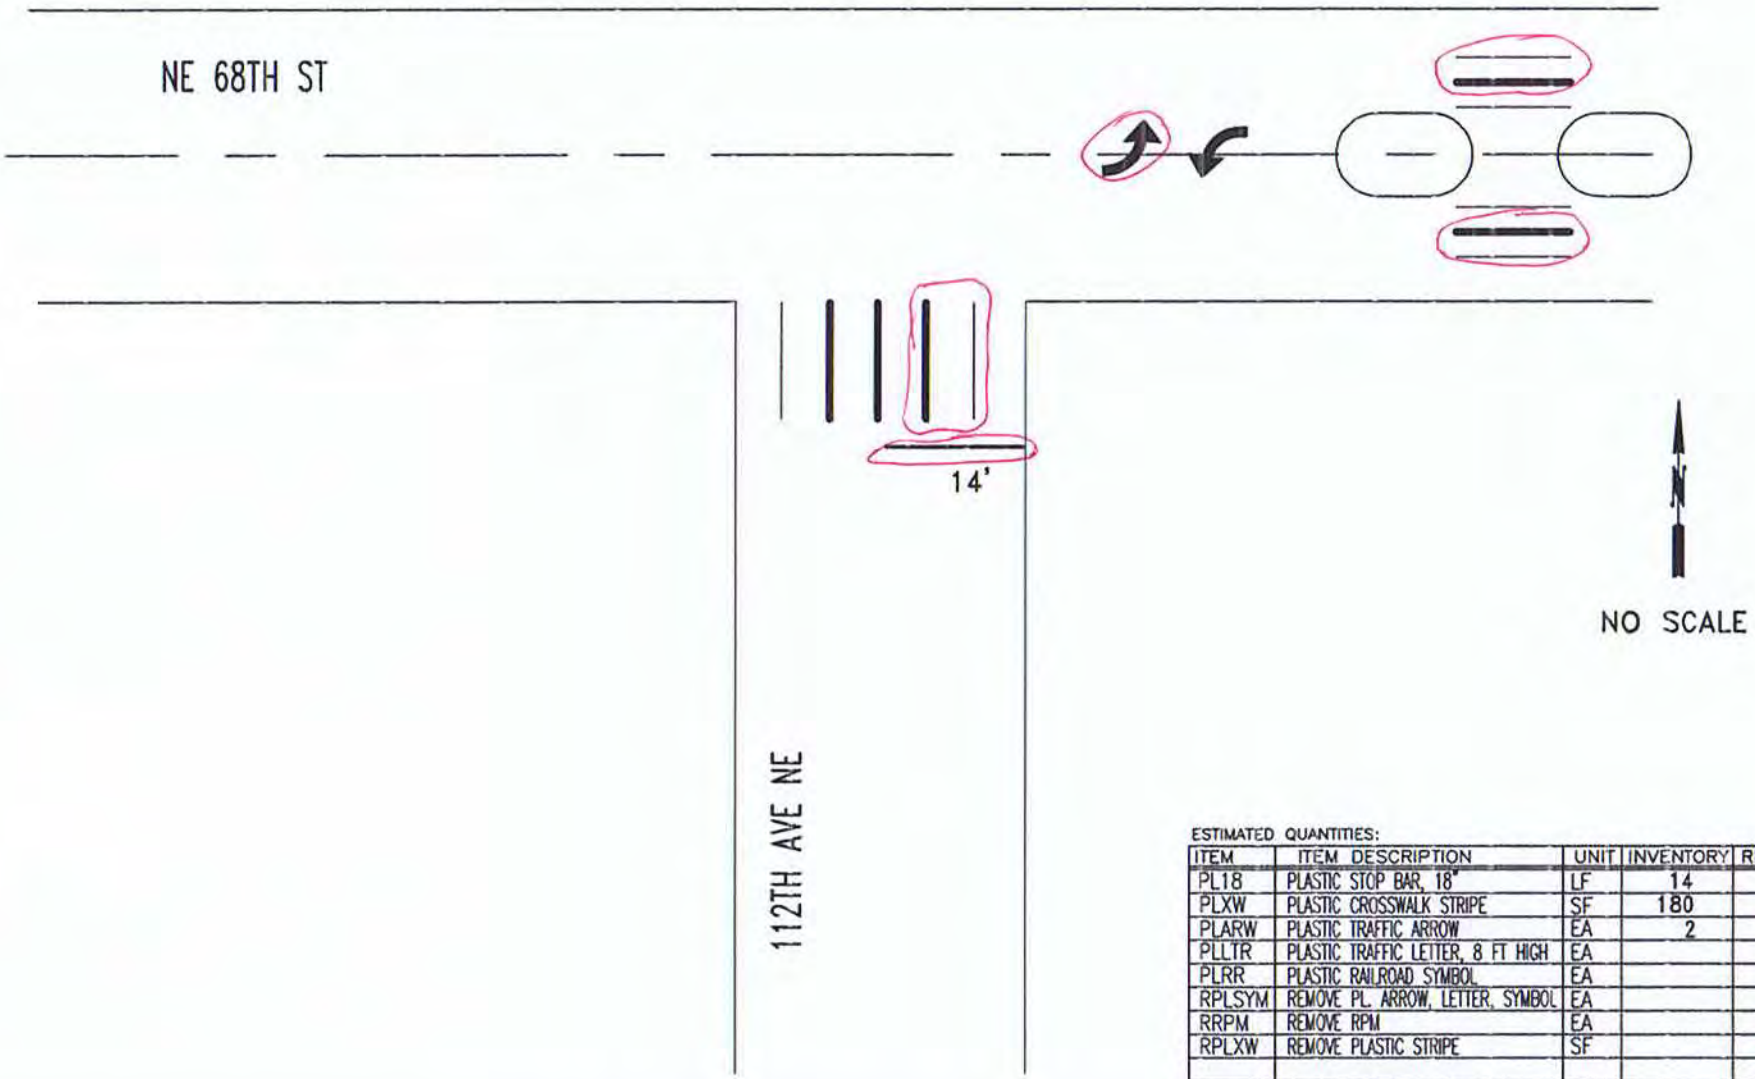

ESTIMATED QUANTITIES:

ITEM	ITEM DESCRIPTION	UNIT	INVENTORY	REPAIR QTY
PL18	PLASTIC STOP BAR, 18"	LF	14	14
PLXW	PLASTIC CROSSWALK STRIPE	SF	180	90
PLARW	PLASTIC TRAFFIC ARROW	EA	2	1
PLLTR	PLASTIC TRAFFIC LETTER, 8 FT HIGH	EA		
PLRR	PLASTIC RAILROAD SYMBOL	EA		
RPLSYM	REMOVE PL. ARROW, LETTER, SYMBOL	EA		
RRPM	REMOVE RPM	EA		
RPLXW	REMOVE PLASTIC STRIPE	SF		90

CITY OF KIRKLAND
DEPARTMENT OF PUBLIC WORKS
123 FIFTH AVENUE KIRKLAND, WA 98033
(425) 587-3800 www.kirklandwa.gov

G. HORTILLOSA 3/2006
DESIGNED BY: DATE

J.JENNINGS 3/2006
DRAWN BY: DATE

CHECKED BY: DATE

2020 PAVEMENT MARKING PROGRAM

STREET: NE 68TH ST

CROSS STREET: 112TH AVE NE

SEGMENT:

SCALE: N.T.S.

FILENAME: Page 11-8

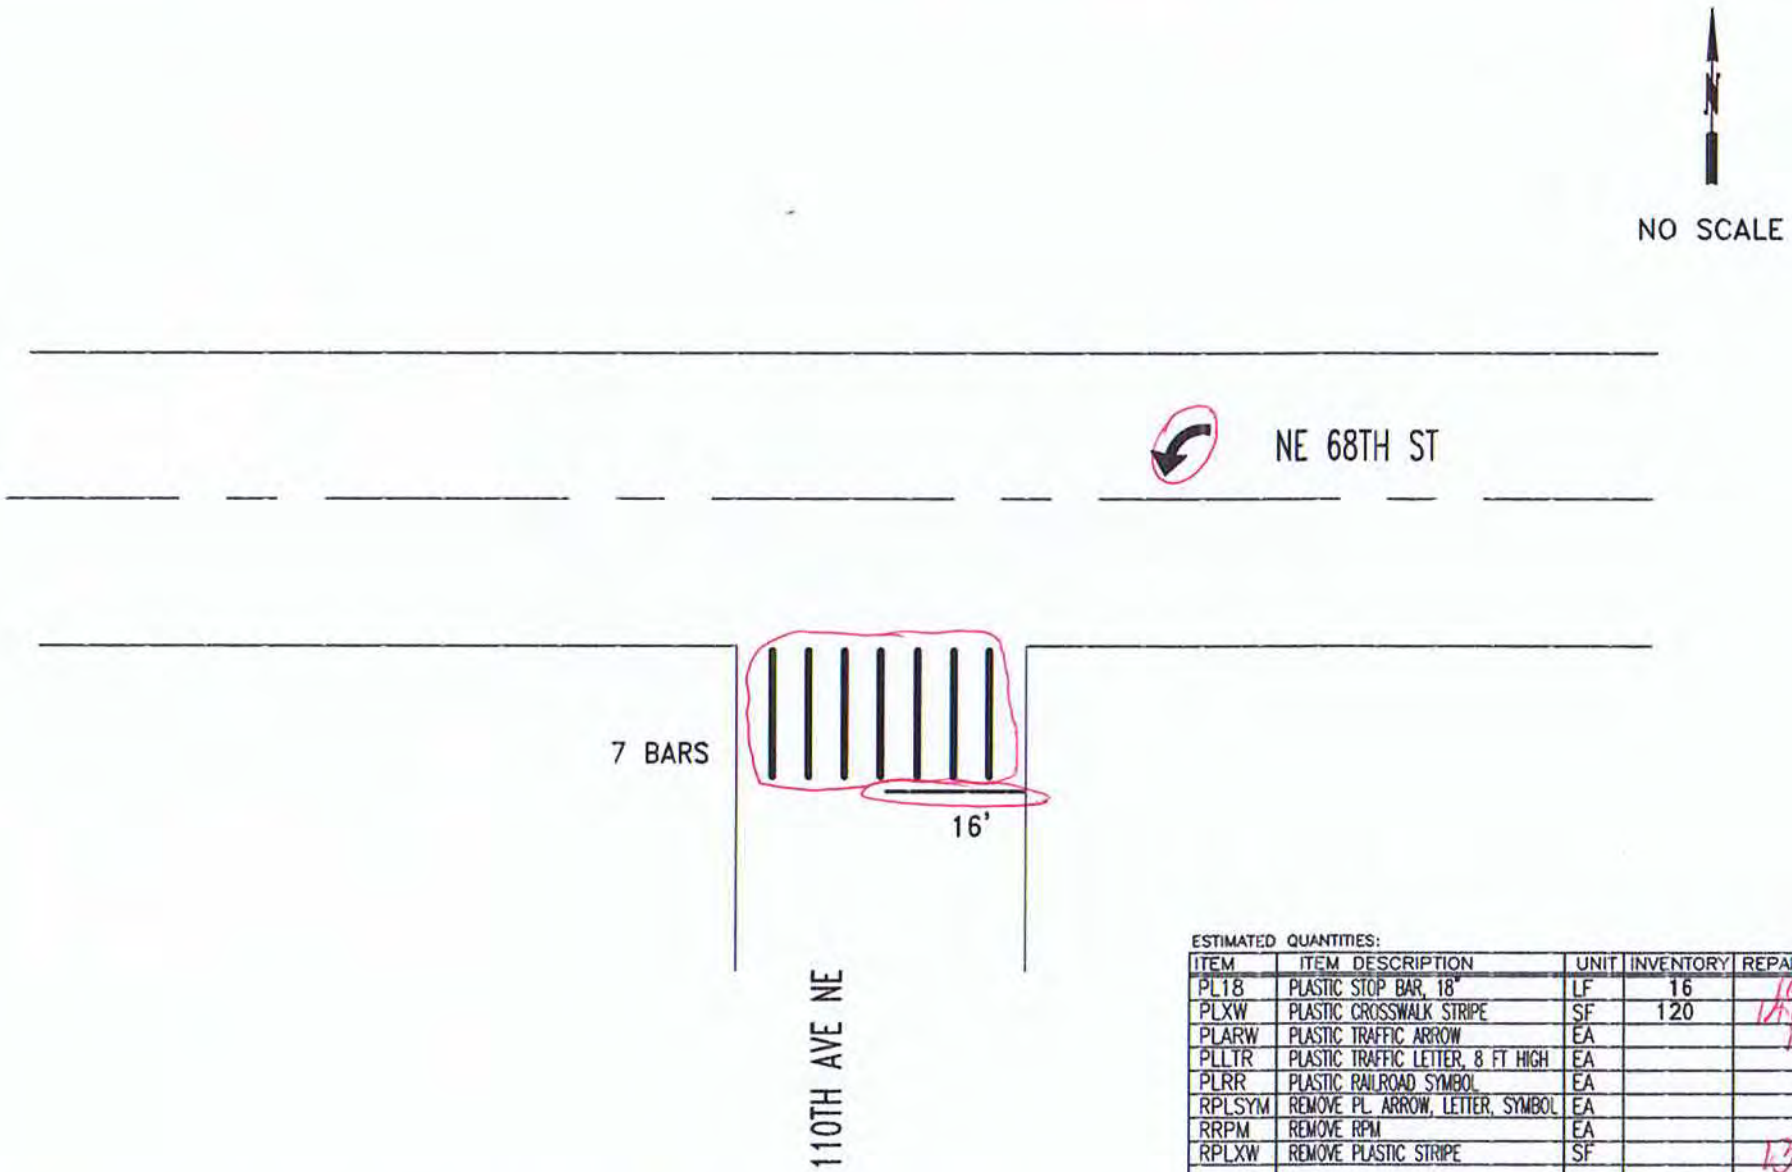

ESTIMATED QUANTITIES:

ITEM	ITEM DESCRIPTION	UNIT	INVENTORY	REPAIR QTY
PL18	PLASTIC STOP BAR, 18"	LF	16	16
PLXW	PLASTIC CROSSWALK STRIPE	SF	120	144
PLARW	PLASTIC TRAFFIC ARROW	EA		1
PLLTR	PLASTIC TRAFFIC LETTER, 8 FT HIGH	EA		
PLRR	PLASTIC RAILROAD SYMBOL	EA		
RPLSYM	REMOVE PL. ARROW, LETTER, SYMBOL	EA		
RRPM	REMOVE RPM	EA		
RPLXW	REMOVE PLASTIC STRIPE	SF		120

CITY OF KIRKLAND
DEPARTMENT OF PUBLIC WORKS
123 FIFTH AVENUE KIRKLAND, WA 98033
(425) 587-3800 www.kirklandwa.gov

G. HORTILLOSA 2/2011
DESIGNED BY: DATE

J.JENNINGS 10/2011
DRAWN BY: DATE

CHECKED BY: DATE

2022 PAVEMENT MARKING PROGRAM

STREET: NE 68TH ST

CROSS STREET: 110TH AVE NE

SEGMENT:

SCALE: N.T.S.

FILENAME: Page 11-9

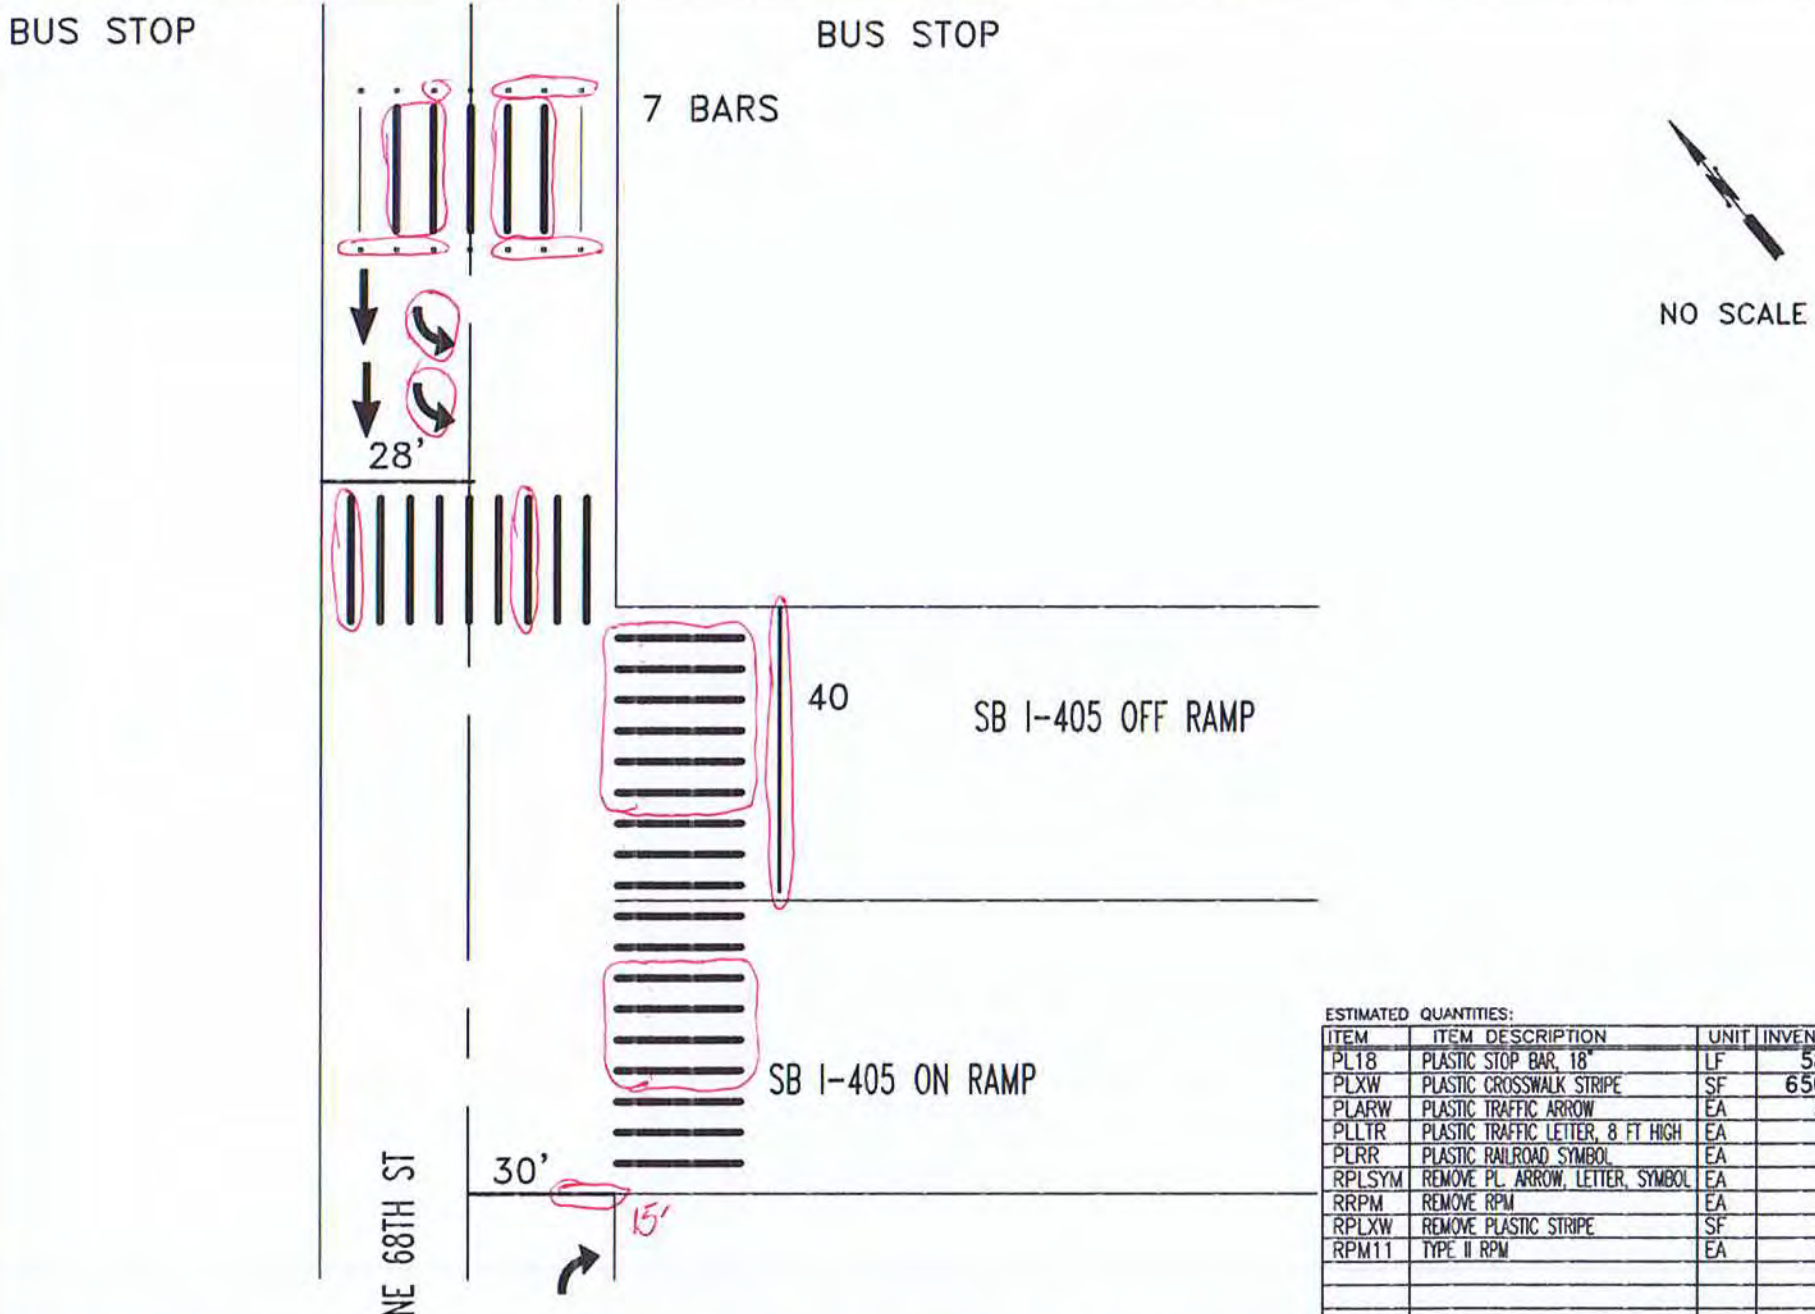

ESTIMATED QUANTITIES:

ITEM	ITEM DESCRIPTION	UNIT	INVENTORY	REPAIR QTY
PL18	PLASTIC STOP BAR, 18"	LF	58	40
PLXW	PLASTIC CROSSWALK STRIPE	SF	650	250
PLARW	PLASTIC TRAFFIC ARROW	EA	5	2
PLLTR	PLASTIC TRAFFIC LETTER, 8 FT HIGH	EA		
PLRR	PLASTIC RAILROAD SYMBOL	EA		
RPLSYM	REMOVE PL. ARROW, LETTER, SYMBOL	EA		
RRPM	REMOVE RPM	EA		4
RPLXW	REMOVE PLASTIC STRIPE	SF		100
RPM11	TYPE II RPM	EA	14	10

CITY OF KIRKLAND
DEPARTMENT OF PUBLIC WORKS
123 FIFTH AVENUE KIRKLAND, WA 98033
(425) 587-3800 www.kirklandwa.gov

G. HORTILLOSA 10/2006
DESIGNED BY: DATE

J.JENNINGS 10/2006
DRAWN BY: DATE

CHECKED BY: DATE

2020 PAVEMENT MARKING PROGRAM

STREET: NE 68TH ST

CROSS STREET: I-405 ON/OFF RAMPS

SEGMENT:

SCALE: N.T.S.

FILENAME: Page 11-11

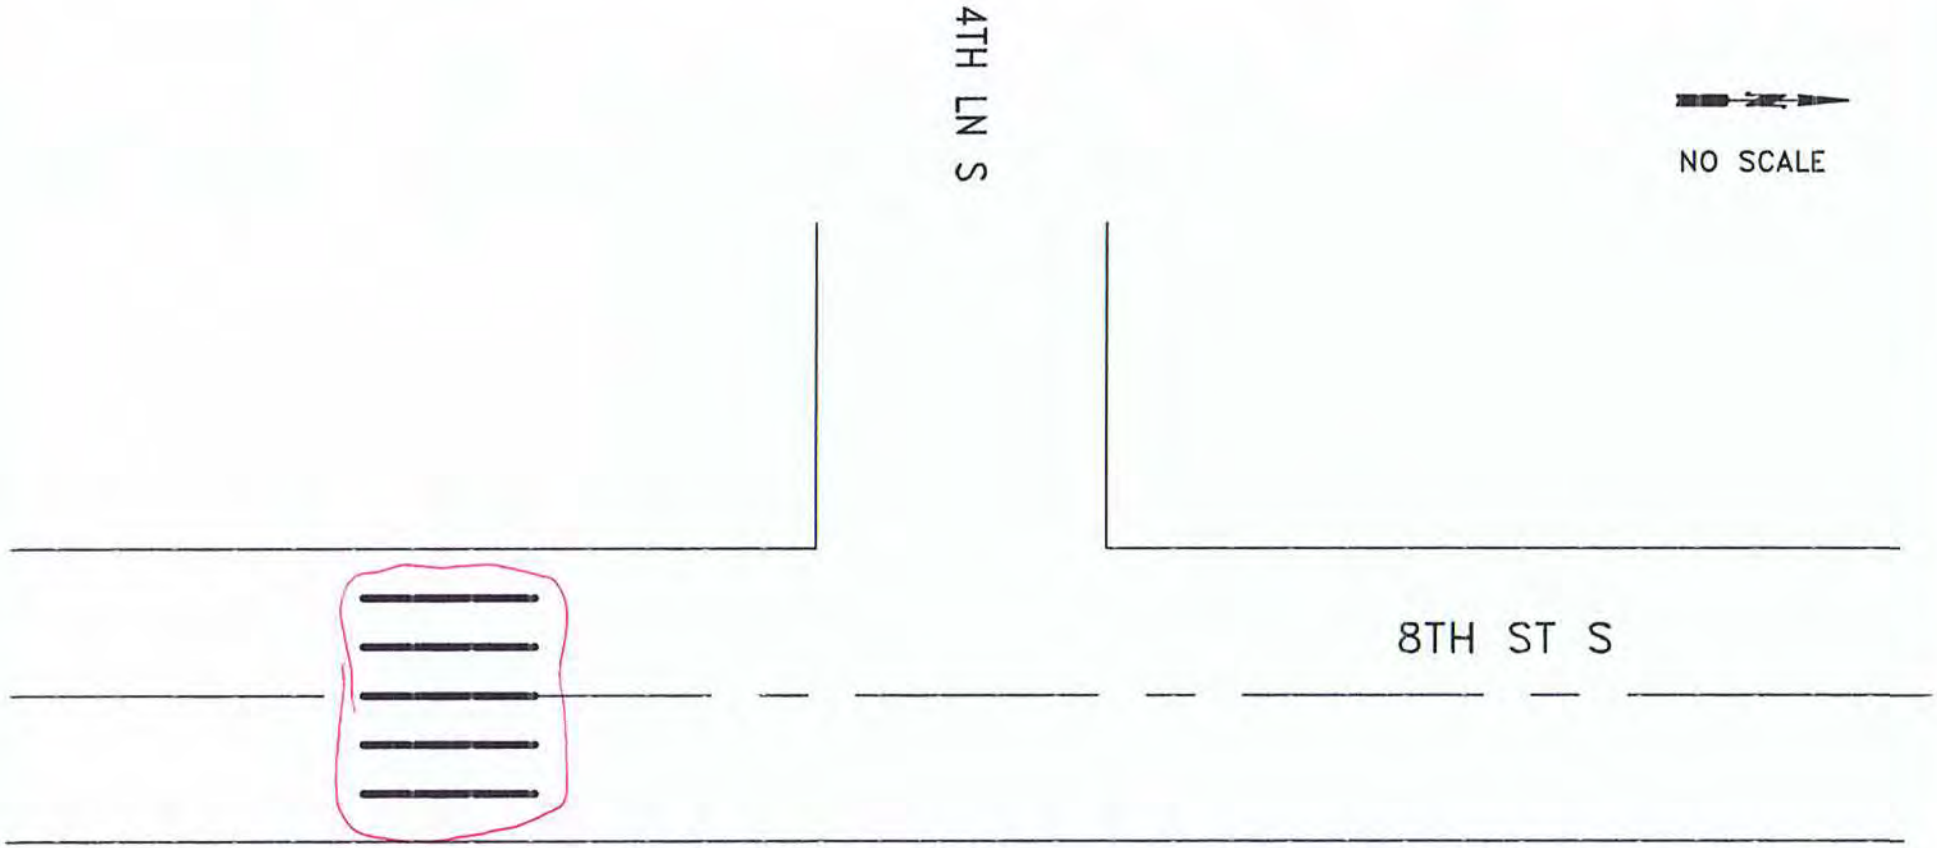

ESTIMATED QUANTITIES:

ITEM	ITEM DESCRIPTION	UNIT	INVENTORY	REPAIR QTY
PL18	PLASTIC STOP BAR, 18"	LF		
PLXW	PLASTIC CROSSWALK STRIPE	SF	100	100
PLARW	PLASTIC TRAFFIC ARROW	EA		
PLLTR	PLASTIC TRAFFIC LETTER, 8 FT HIGH	EA		
PLRR	PLASTIC RAILROAD SYMBOL	EA		
RPLSYM	REMOVE PL. ARROW, LETTER, SYMBOL	EA		
RRPM	REMOVE RPM	EA		
RPLXW	REMOVE PLASTIC STRIPE	SF		

CITY OF KIRKLAND
DEPARTMENT OF PUBLIC WORKS
123 FIFTH AVENUE KIRKLAND, WA 98033
(425) 587-3800 www.kirklandwa.gov

S.GONSAR 2/2018
DESIGNED BY: DATE

J.JENNINGS 2/2018
DRAWN BY: DATE

CHECKED BY: DATE

2020 PAVEMENT MARKING PROGRAM

STREET: 8TH ST S

CROSS STREET: 4TH LN S

SEGMENT:

SCALE: N.T.S.

FILENAME: Page 11-13

NO SCALE

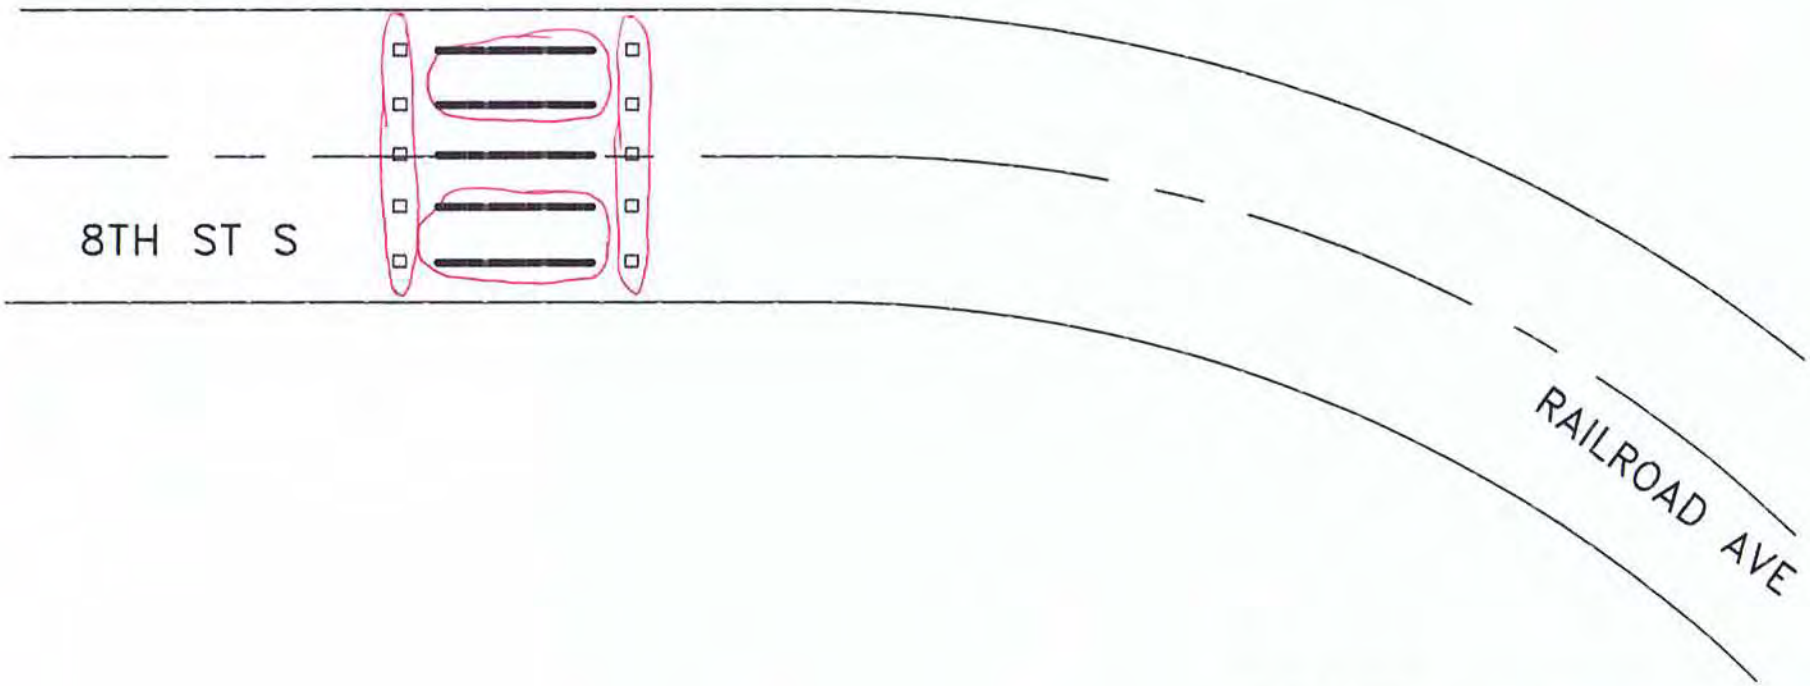

ESTIMATED QUANTITIES:

ITEM	ITEM DESCRIPTION	UNIT	INVENTORY	REPAIR QTY
PL18	PLASTIC STOP BAR, 18"	LF	15	
PLXW	PLASTIC CROSSWALK STRIPE	SF	120	80
PLARW	PLASTIC TRAFFIC ARROW	EA		
PLLTR	PLASTIC TRAFFIC LETTER, 8 FT HIGH	EA		
PLRR	PLASTIC RAILROAD SYMBOL	EA		
RPLSYM	REMOVE PL. ARROW, LETTER, SYMBOL	EA		
RRPM	REMOVE RPM	EA		2
RPLXW	REMOVE PLASTIC STRIPE	SF		
	RAISED PAVEMENT MARKER TYPE 2	EA	10	10

CITY OF KIRKLAND
DEPARTMENT OF PUBLIC WORKS
123 FIFTH AVENUE KIRKLAND, WA 98033
(425) 587-3800 www.kirklandwa.gov

S. GONSAR 2/2018
DESIGNED BY: DATE

J.JENNINGS 2/2018
DRAWN BY: DATE

CHECKED BY: DATE

2022 PAVEMENT MARKING PROGRAM

STREET: 8TH ST S

CROSS STREET: RAILROAD AVE

SEGMENT:

SCALE: N.T.S.

FILENAME:

TOTEM LAKE
INTERSECTION PLANS

CITY OF KIRKLAND
DEPARTMENT OF PUBLIC WORKS
123 FIFTH AVENUE KIRKLAND, WA 98033
(425) 587-3800 www.kirklandwa.gov

S GONSAR	1/2019	DESIGNED BY: DATE
J.JENNINGS	1/2019	DRAWN BY: DATE
		CHECKED BY: DATE

2020 PAVEMENT MARKING PROGRAM

STREET:

CROSS STREET:

SEGMENT:

SCALE: N.T.S.

FILENAME: 5-0

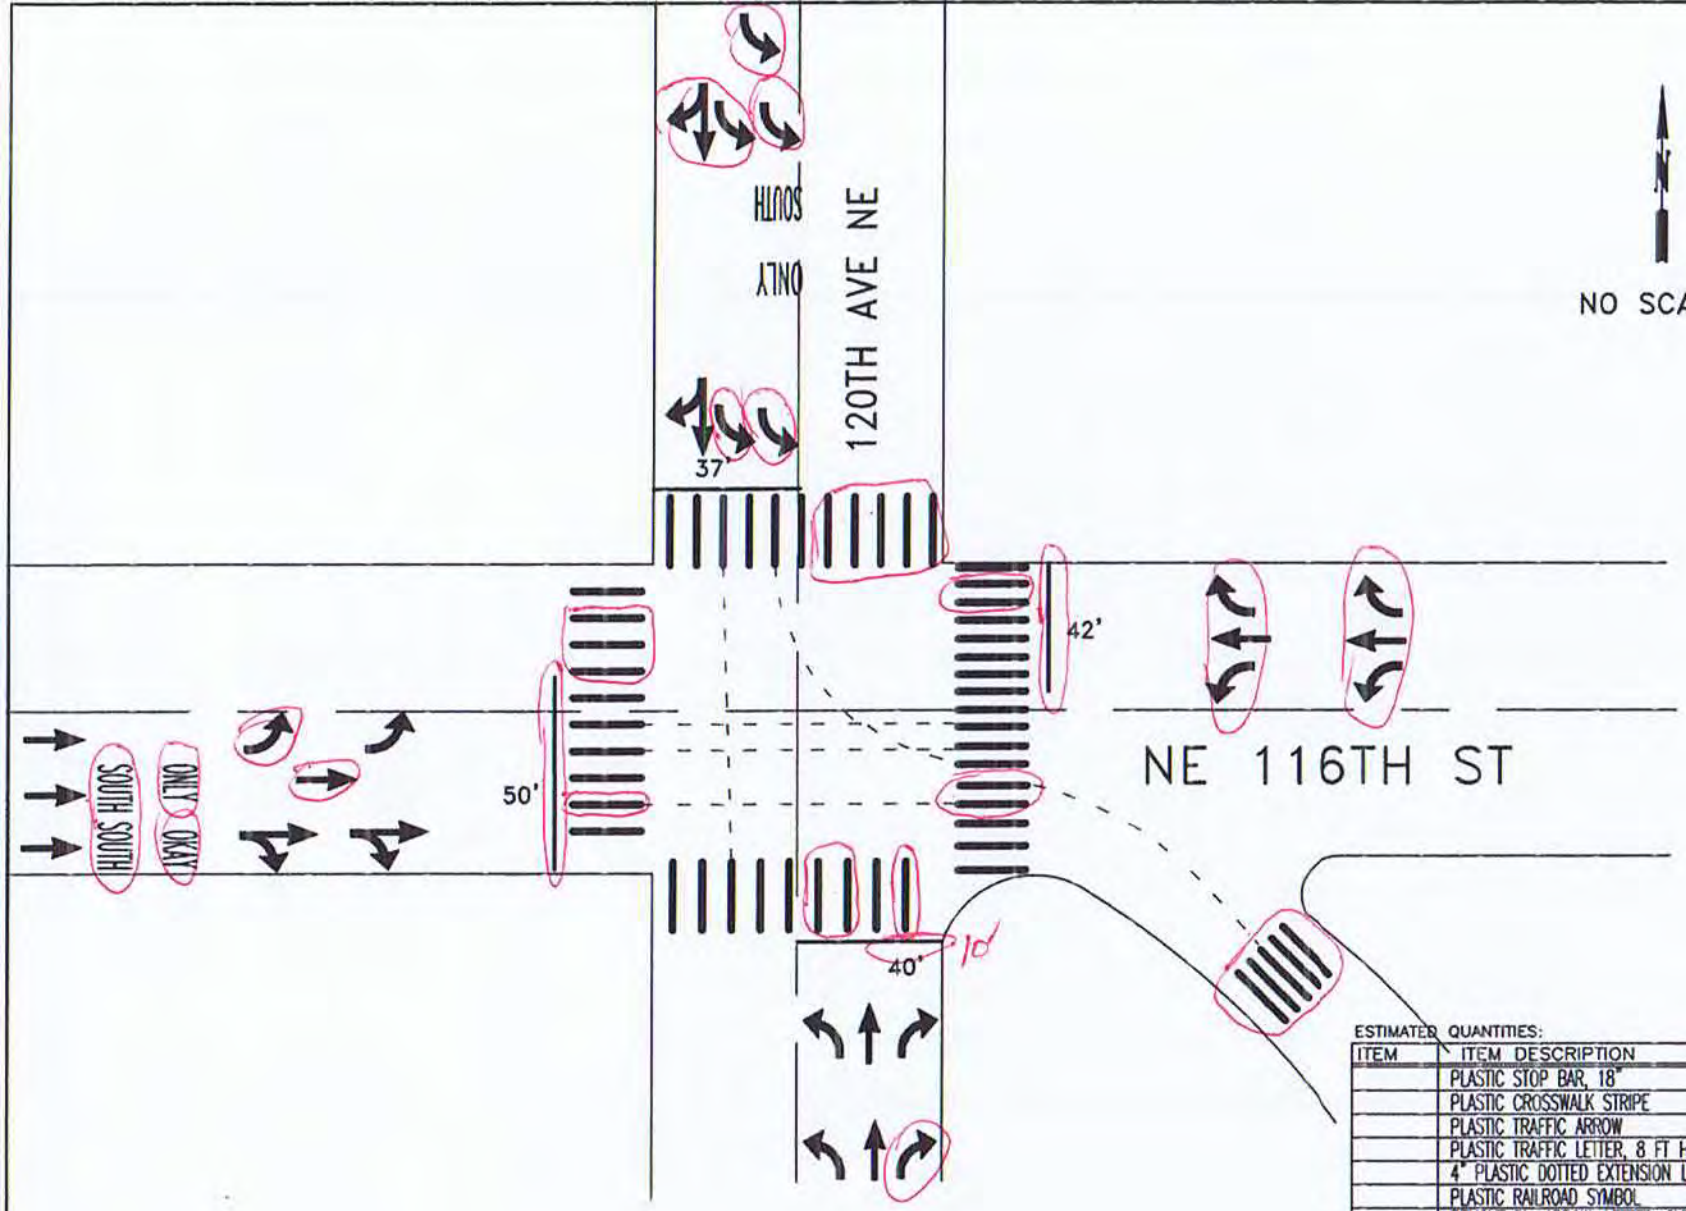

ESTIMATED QUANTITIES:

ITEM	ITEM DESCRIPTION	UNIT	INVENTORY	REPAIR QTY
	PLASTIC STOP BAR, 18"	LF	169	105
	PLASTIC CROSSWALK STRIPE	SF	1040	120
	PLASTIC TRAFFIC ARROW	EA	18	12
	PLASTIC TRAFFIC LETTER, 8 FT HIGH	EA	12	18
	4" PLASTIC DOTTED EXTENSION LINE	LF	425	
	PLASTIC RAILROAD SYMBOL	EA		
	REMOVE PL. ARROW, LETTER, SYMBOL	EA		
	REMOVE RPM	EA		
	REMOVE PLASTIC STRIPE	SF		

CITY OF KIRKLAND
DEPARTMENT OF PUBLIC WORKS
123 FIFTH AVENUE KIRKLAND, WA 98033
(425) 587-3800 www.kirklandwa.gov

S. GONSAR 1/2019
DESIGNED BY: DATE

J.JENNINGS 1/2019
DRAWN BY: DATE

CHECKED BY: DATE

2022 PAVEMENT MARKING PROGRAM

STREET: NE 116TH ST

CROSS STREET: 120TH AVE NE

SEGMENT:

SCALE: N.T.S.

FILENAME: Page 5-1

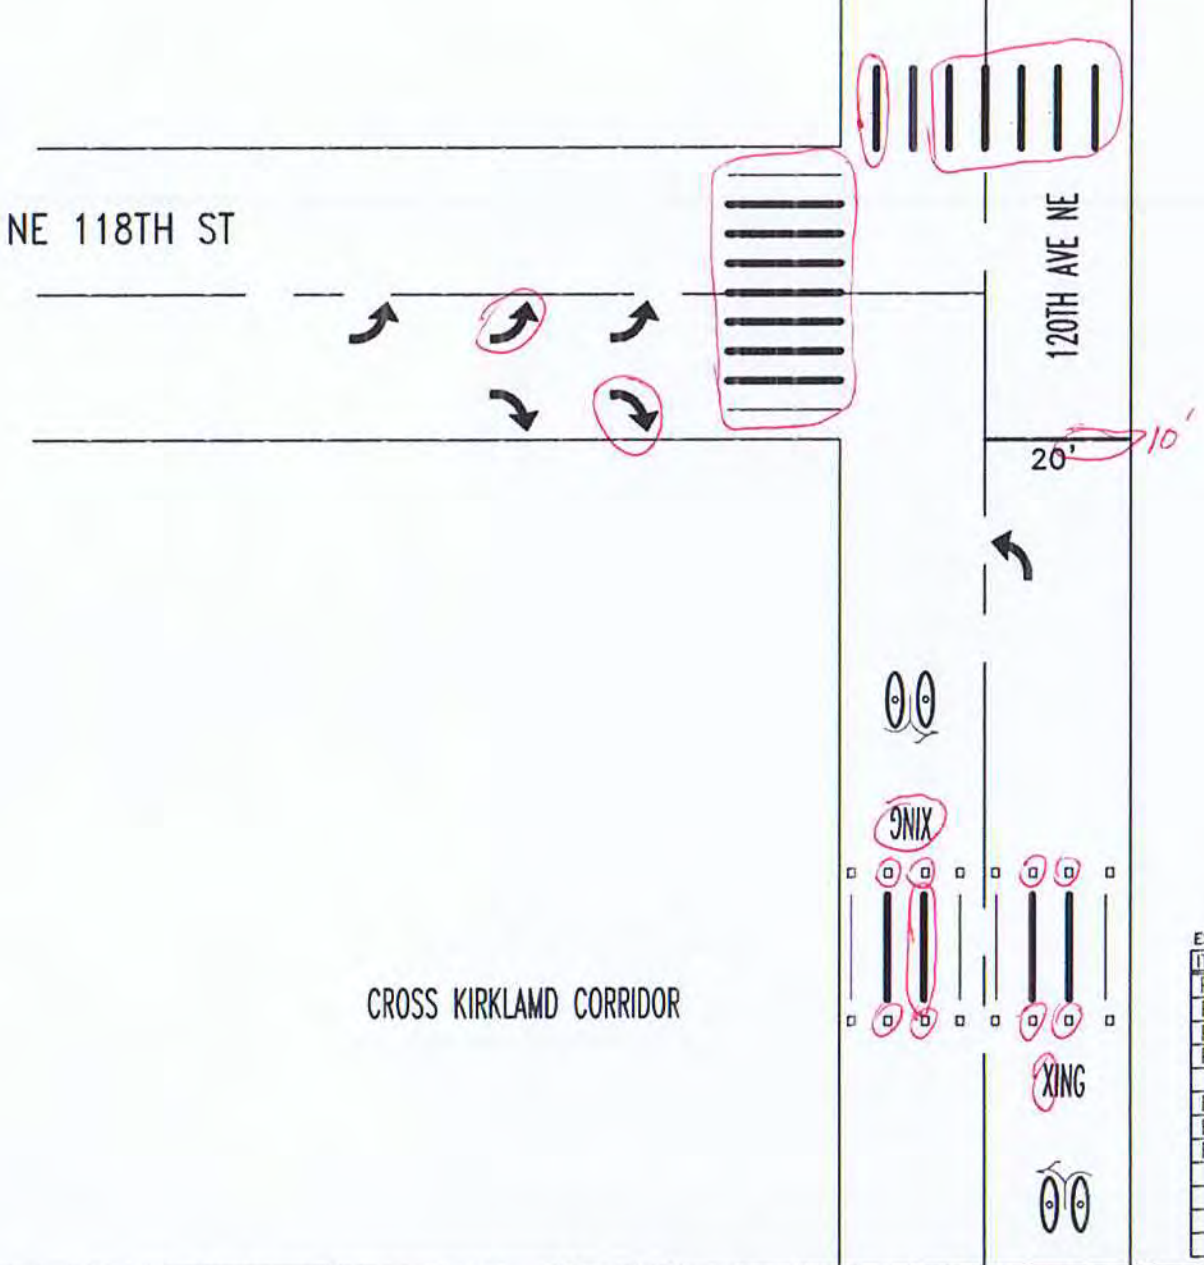

NO SCALE

ESTIMATED QUANTITIES:

ITEM	ITEM DESCRIPTION	UNIT	INVENTORY	REPAIR QTY
PL18	PLASTIC STOP BAR, 18"	LF	20	10
PLXW	PLASTIC CROSSWALK STRIPE	SF	420	300
PLARW	PLASTIC TRAFFIC ARROW	EA	6	5
PLLTR	PLASTIC TRAFFIC LETTER, 8 FT HIGH	EA	8	
	PLASTIC BICYCLE SYMBOL	EA	2	
RPLSYM	REMOVE PL. ARROW, LETTER, SYMBOL	EA		
RRPM	REMOVE RPM	EA		
RPLXW	REMOVE PLASTIC STRIPE	SF		50
	RAISED PAVEMENT MARKER TYPE 2	EA	16	8

CITY OF KIRKLAND
DEPARTMENT OF PUBLIC WORKS
123 FIFTH AVENUE KIRKLAND, WA 98033
(425) 587-3800 www.kirklandwa.gov

G. HORTILLOSA 10/2007
DESIGNED BY: DATE

J.JENNINGS 10/2007
DRAWN BY: DATE

CHECKED BY: DATE

2022 PAVEMENT MARKING PROGRAM

STREET: 120TH AVE NE

CROSS STREET: NE 118TH ST

SEGMENT:

SCALE: N.T.S.

FILENAME: Page 5-2

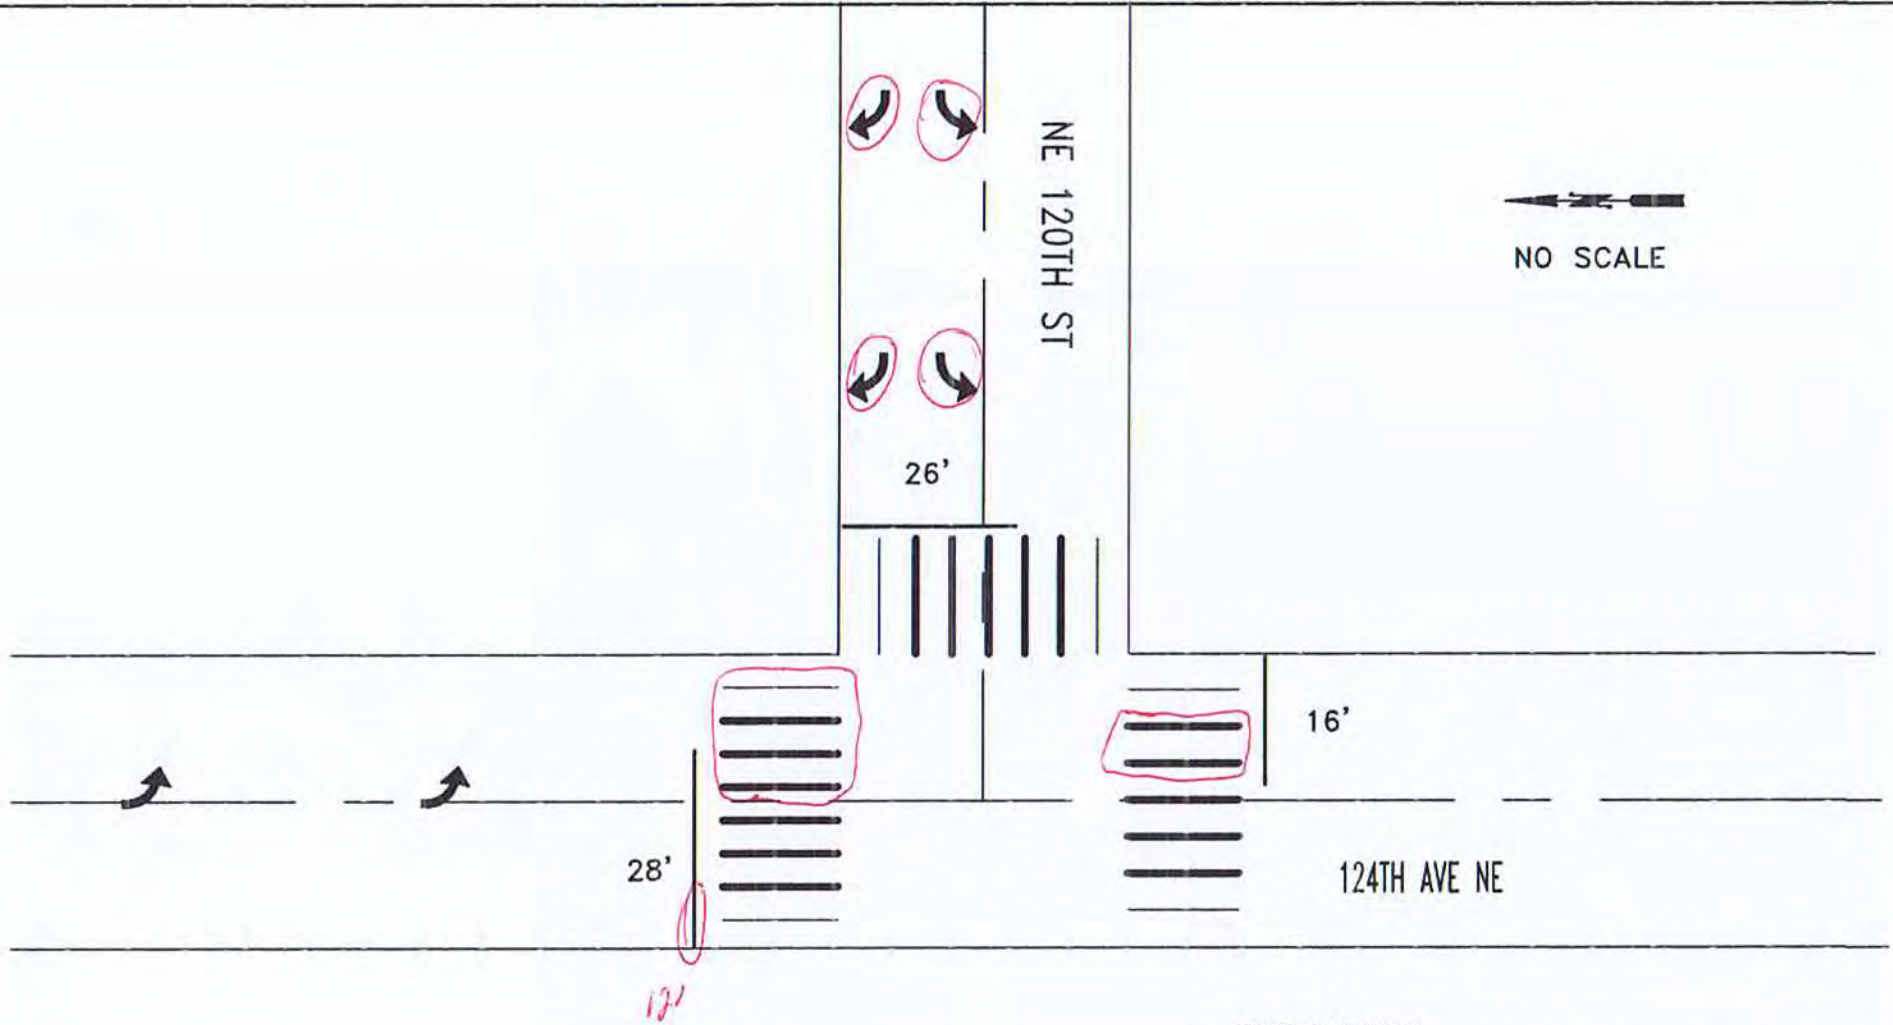

ESTIMATED QUANTITIES:

ITEM	ITEM DESCRIPTION	UNIT	INVENTORY	REPAIR QTY
PL18	PLASTIC STOP BAR, 18"	LF	70	12
PLXW	PLASTIC CROSSWALK STRIPE	SF	380	112
PLARW	PLASTIC TRAFFIC ARROW	EA	6	4
PLLTR	PLASTIC TRAFFIC LETTER, 8 FT HIGH	EA		
	PLASTIC BICYCLE SYMBOL	EA		
RPLSYM	REMOVE PL. ARROW, LETTER, SYMBOL	EA		
RRPM	REMOVE RPM	EA		
RPLXW	REMOVE PLASTIC STRIPE	SF		
	RAISED PAVEMENT MARKER TYPE 2	EA		

CITY OF KIRKLAND
DEPARTMENT OF PUBLIC WORKS
123 FIFTH AVENUE KIRKLAND, WA 98033
(425) 587-3800 www.kirklandwa.gov

S GONSAR 8/2019
DESIGNED BY: DATE

J.JENNINGS 8/2019
DRAWN BY: DATE

CHECKED BY: DATE

2020 PAVEMENT MARKING PROGRAM

STREET: 124TH AVE NE

CROSS STREET: NE 120TH ST

SEGMENT:

SCALE: N.T.S.

FILENAME: Page 5-2A

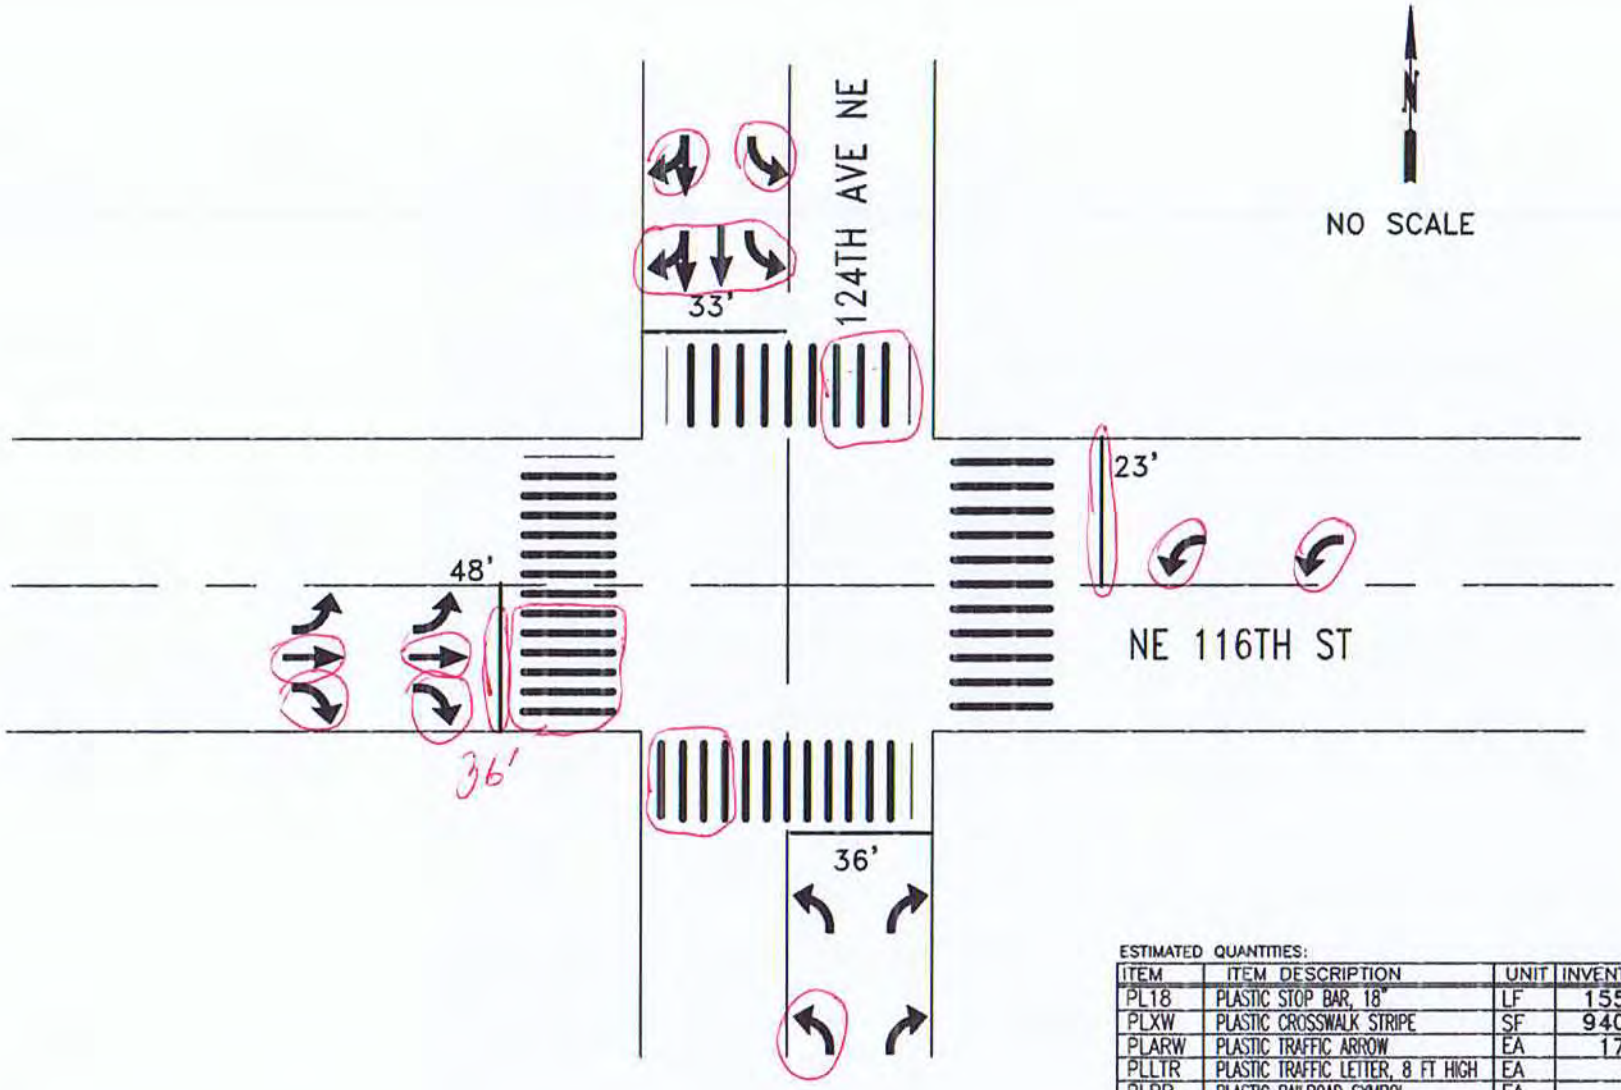

ESTIMATED QUANTITIES:

ITEM	ITEM DESCRIPTION	UNIT	INVENTORY	REPAIR QTY
PL18	PLASTIC STOP BAR, 18"	LF	155	53
PLXW	PLASTIC CROSSWALK STRIPE	SF	940	278
PLARW	PLASTIC TRAFFIC ARROW	EA	17	12
PLLTR	PLASTIC TRAFFIC LETTER, 8 FT HIGH	EA		
PLRR	PLASTIC RAILROAD SYMBOL	EA		
RPLSYM	REMOVE PL. ARROW, LETTER, SYMBOL	EA		
RRPM	REMOVE RPM	EA		
RPLXW	REMOVE PLASTIC STRIPE	SF		

CITY OF KIRKLAND
DEPARTMENT OF PUBLIC WORKS
123 FIFTH AVENUE KIRKLAND, WA 98033
(425) 587-3800 www.kirklandwa.gov

G. HORTILLOSA 2/2011
DESIGNED BY: DATE

J.JENNINGS 10/2011
DRAWN BY: DATE

CHECKED BY: DATE

2022 PAVEMENT MARKING PROGRAM

STREET: 124TH AVE NE

CROSS STREET: NE 116TH ST

SEGMENT:

SCALE: N.T.S.

FILENAME: Page 5-3

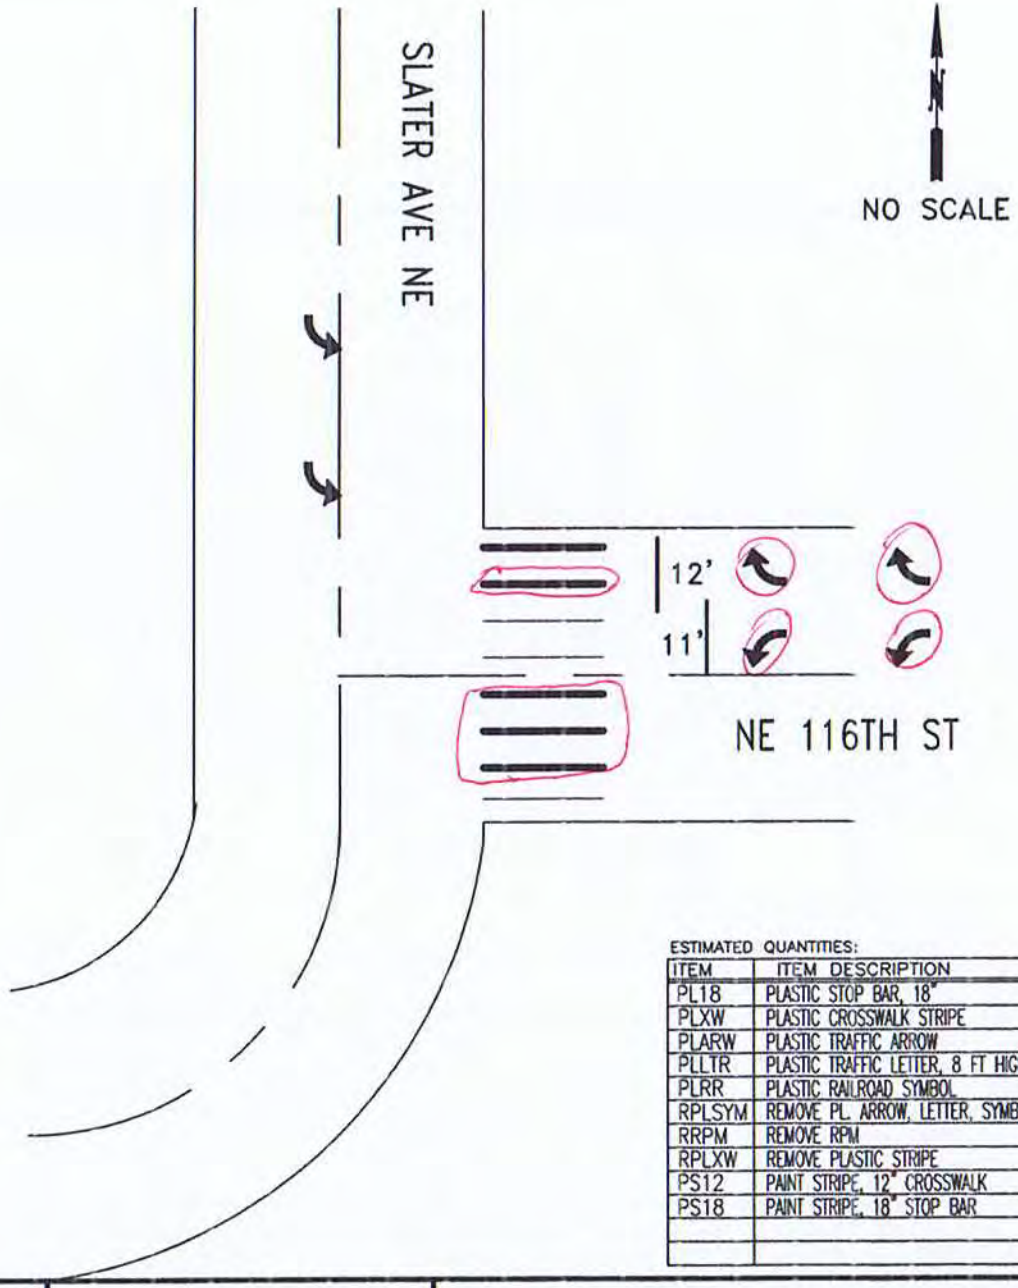

ESTIMATED QUANTITIES:

ITEM	ITEM DESCRIPTION	UNIT	INVENTORY	REPAIR QTY
PL18	PLASTIC STOP BAR, 18"	LF	23	
PLXW	PLASTIC CROSSWALK STRIPE	SF	130	89
PLARW	PLASTIC TRAFFIC ARROW	EA	6	4
PLLTR	PLASTIC TRAFFIC LETTER, 8 FT HIGH	EA		
PLRR	PLASTIC RAILROAD SYMBOL	EA		
RPLSYM	REMOVE PL. ARROW, LETTER, SYMBOL	EA		
RRPM	REMOVE RPM	EA		
RPLXW	REMOVE PLASTIC STRIPE	SF		20
PS12	PAINT STRIPE, 12" CROSSWALK			
PS18	PAINT STRIPE, 18" STOP BAR			

CITY OF KIRKLAND
DEPARTMENT OF PUBLIC WORKS
123 FIFTH AVENUE KIRKLAND, WA 98033
(425) 587-3800 www.kirklandwa.gov

G. HORTILLOSA 10/2011
DESIGNED BY: DATE

J.JENNINGS 10/2011
DRAWN BY: DATE

CHECKED BY: DATE

2020 PAVEMENT MARKING PROGRAM

STREET: NE 116TH ST

CROSS STREET: SLATER AVE NE

SEGMENT:

SCALE: N.T.S.

FILENAME: Page 5-4

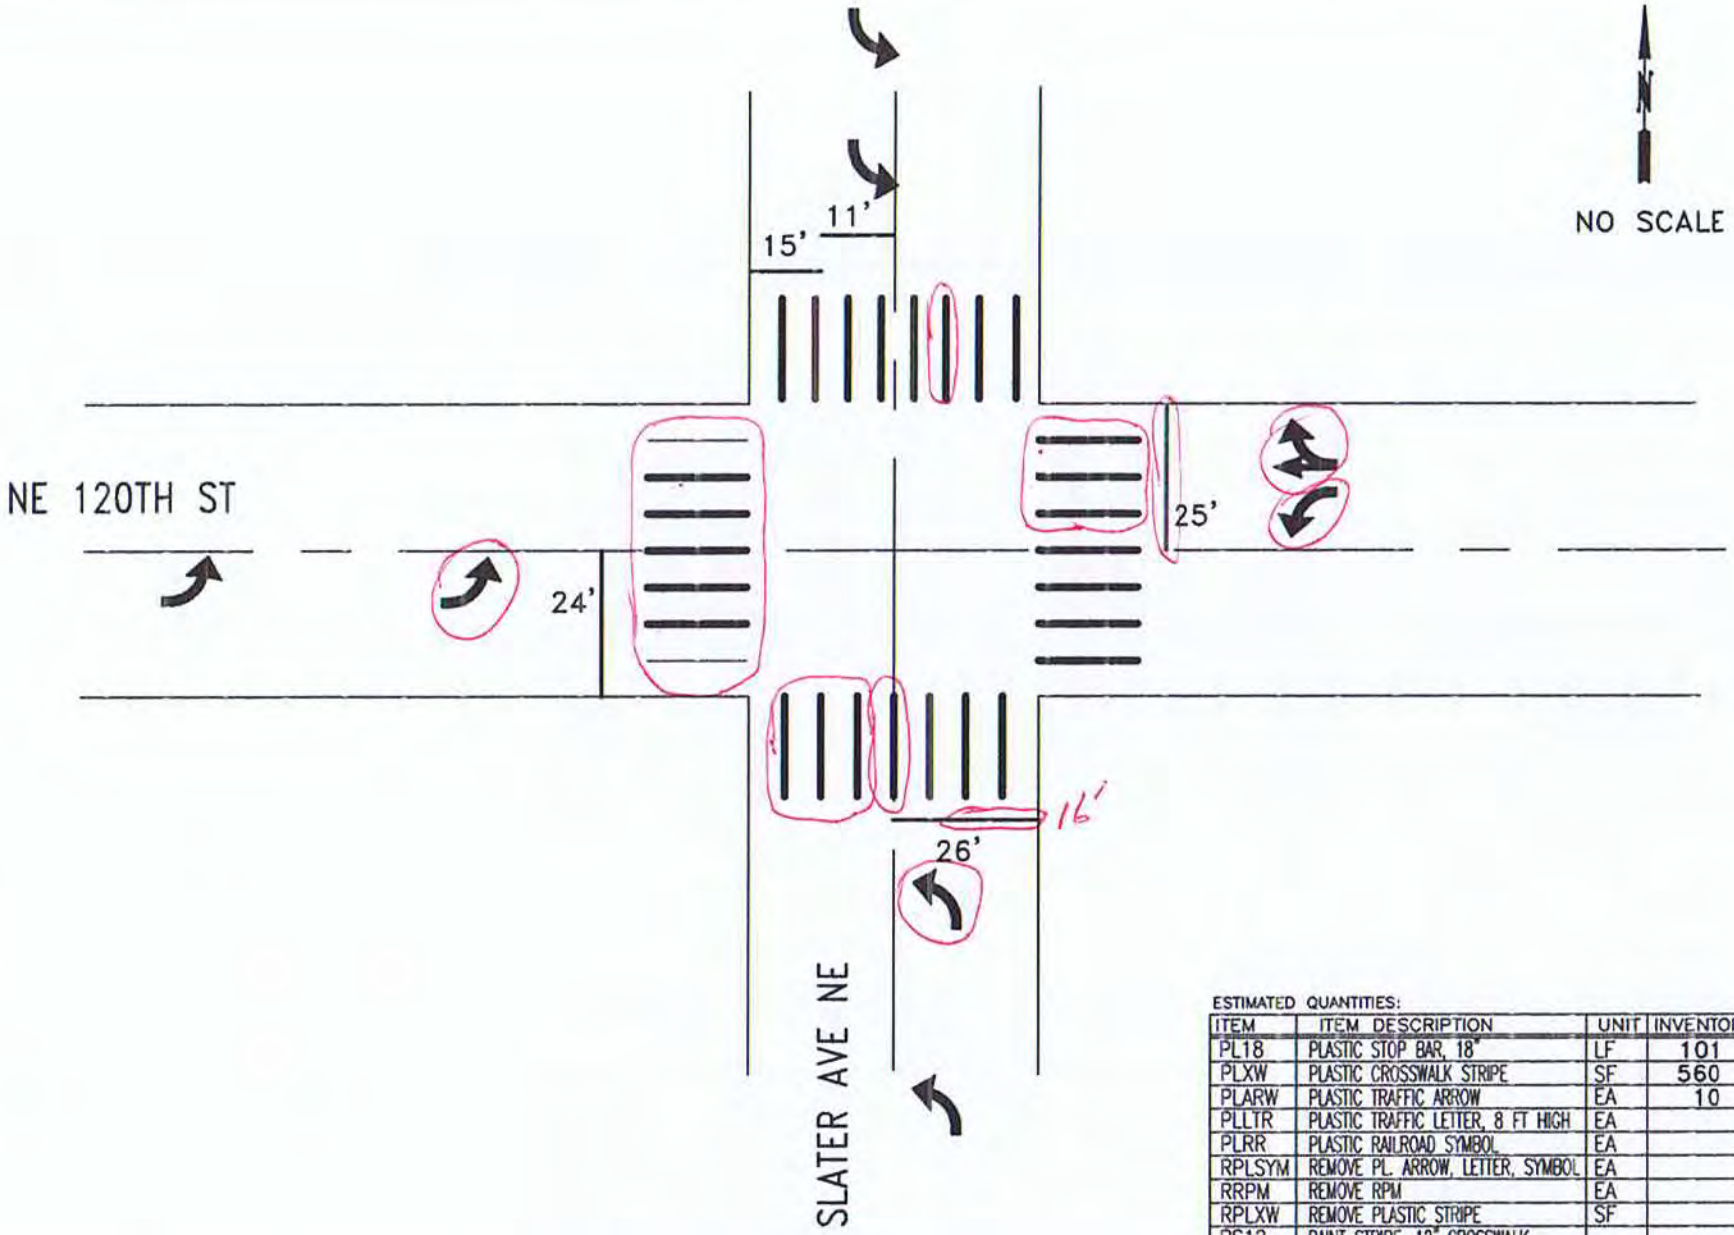

ESTIMATED QUANTITIES:

ITEM	ITEM DESCRIPTION	UNIT	INVENTORY	REPAIR QTY
PL18	PLASTIC STOP BAR, 18"	LF	101	41
PLXW	PLASTIC CROSSWALK STRIPE	SF	560	320
PLARW	PLASTIC TRAFFIC ARROW	EA	10	4
PLLTR	PLASTIC TRAFFIC LETTER, 8 FT HIGH	EA		
PLRR	PLASTIC RAILROAD SYMBOL	EA		
RPLSYM	REMOVE PL. ARROW, LETTER, SYMBOL	EA		
RRPM	REMOVE RPM	EA		
RPLXW	REMOVE PLASTIC STRIPE	SF		
PS12	PAINT STRIPE, 12" CROSSWALK			
PS18	PAINT STRIPE, 18" STOP BAR			

CITY OF KIRKLAND
DEPARTMENT OF PUBLIC WORKS
123 FIFTH AVENUE KIRKLAND, WA 98033
(425) 587-3800 www.kirklandwa.gov

G. HORTILLOSA 7/2007
DESIGNED BY: DATE

J.JENNINGS 10/2009
DRAWN BY: DATE

CHECKED BY: DATE

2020 PAVEMENT MARKING PROGRAM

STREET: SLATER AVE NE

CROSS STREET: NE 120TH ST

SEGMENT:

SCALE: N.T.S.

FILENAME: Page 5-5

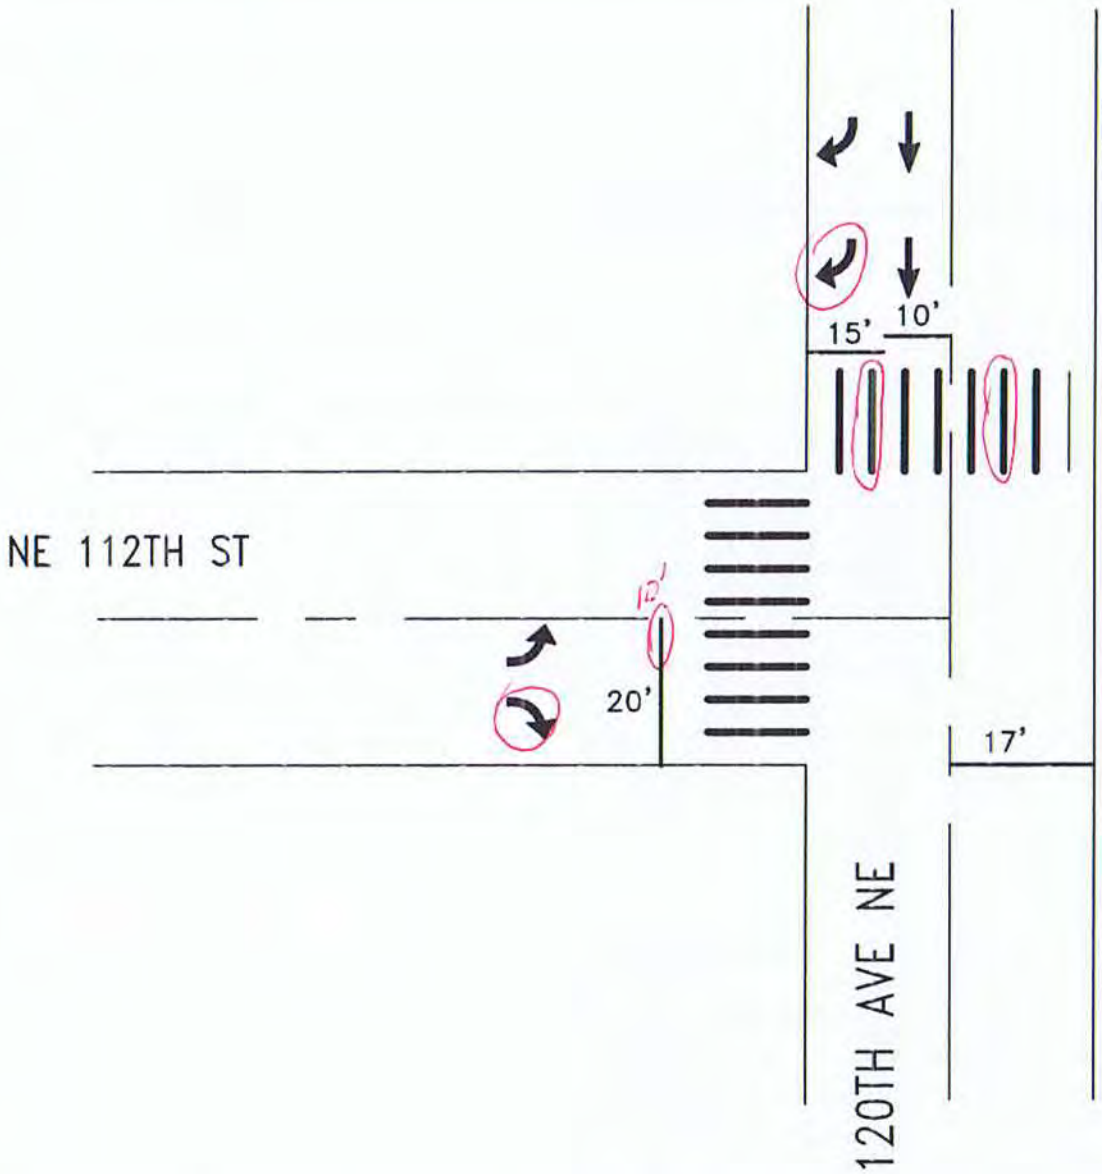

ESTIMATED QUANTITIES:

ITEM	ITEM DESCRIPTION	UNIT	INVENTORY	REPAIR QTY
PL18	PLASTIC STOP BAR, 18"	LF	62	
PLXW	PLASTIC CROSSWALK STRIPE	SF	320	40
PLARW	PLASTIC TRAFFIC ARROW	EA	6	2
PLLTR	PLASTIC TRAFFIC LETTER, 8 FT HIGH	EA		
PLRR	PLASTIC RAILROAD SYMBOL	EA		
RPLSYM	REMOVE PL. ARROW, LETTER, SYMBOL	EA		
RRPM	REMOVE RPM	EA		
RPLXW	REMOVE PLASTIC STRIPE	SF		

CITY OF KIRKLAND
DEPARTMENT OF PUBLIC WORKS
123 FIFTH AVENUE KIRKLAND, WA 98033
(425) 587-3800 www.kirklandwa.gov

R. STEITZER 8/2005
DESIGNED BY: DATE

J.JENNINGS 8/2005
DRAWN BY: DATE

CHECKED BY: DATE

2022 PAVEMENT MARKING PROGRAM

STREET: 120TH AVE NE

CROSS STREET: NE 112TH ST

SEGMENT:

SCALE: N.T.S.

FILENAME: Page 5-6

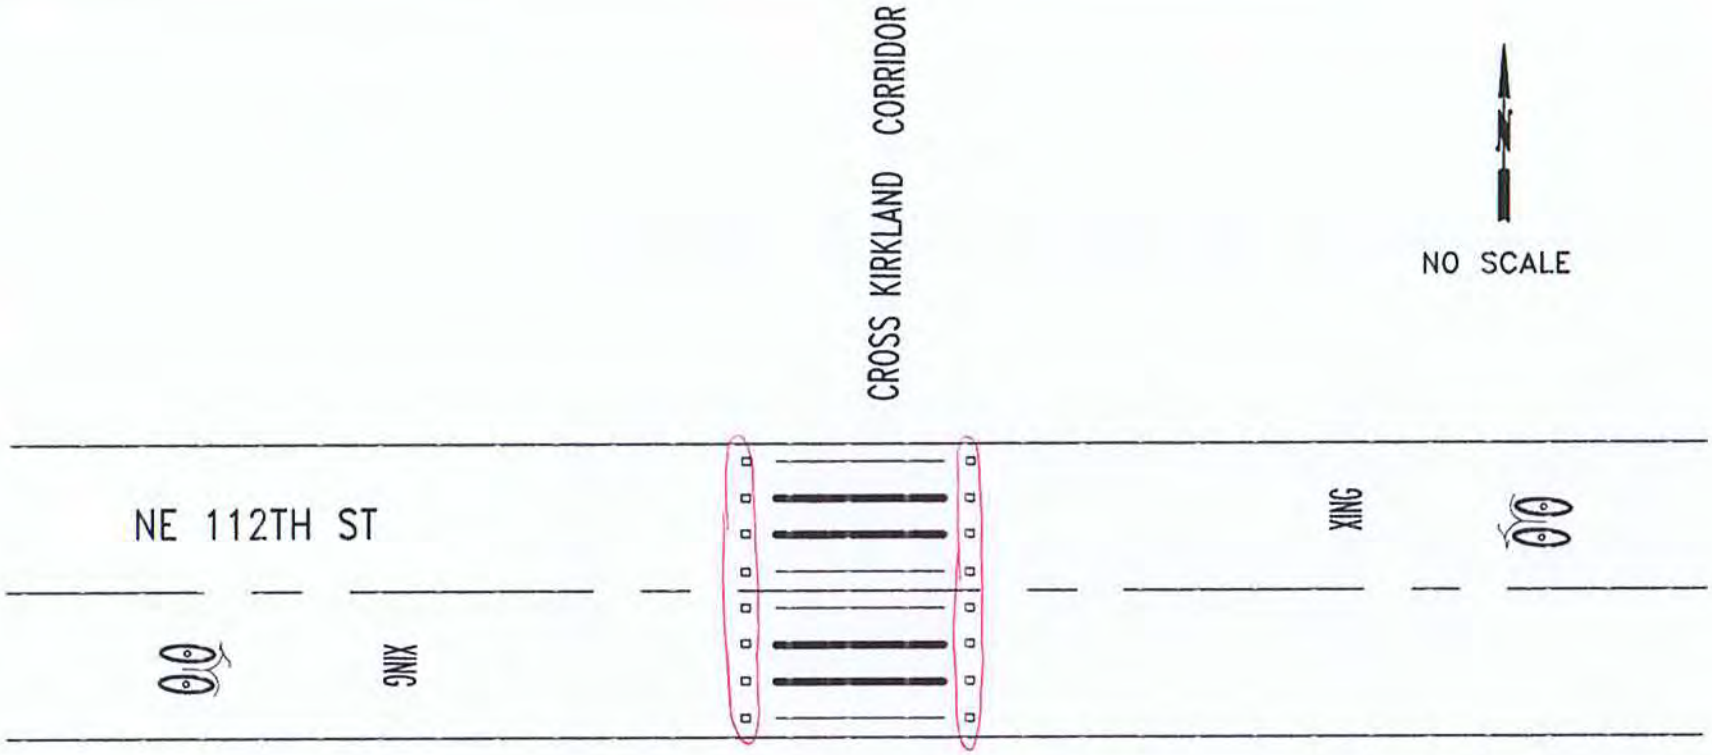

ESTIMATED QUANTITIES:

ITEM	ITEM DESCRIPTION	UNIT	INVENTORY	REPAIR QTY
PL18	PLASTIC STOP BAR, 18"	LF	120	
PLXW	PLASTIC CROSSWALK STRIPE	SF		
PLARW	PLASTIC TRAFFIC ARROW	EA		
PLLTR	PLASTIC TRAFFIC LETTER, 8 FT HIGH	EA	8	
	PLASTIC BICYCLE LANE SYMBOL	EA	2	
RPLSYM	REMOVE PL. ARROW, LETTER, SYMBOL	EA		
RRPM	REMOVE RPM	EA		10
RPLXW	REMOVE PLASTIC STRIPE	SF		
	RAISED PAVEMENT MARKER TYPE 2	EA	16	16

CITY OF KIRKLAND WASHINGTON

CITY OF KIRKLAND
DEPARTMENT OF PUBLIC WORKS
123 FIFTH AVENUE KIRKLAND, WA 98033
(425) 587-3800 www.kirklandwa.gov

L. KAWAOKA 12/2016
DESIGNED BY: DATE

J.JENNINGS 12/2016
DRAWN BY: DATE

CHECKED BY: DATE

2022 PAVEMENT MARKING PROGRAM

STREET: NE 112TH ST

CROSS STREET: CROSS KIRKLAND CORRIDOR

SEGMENT:

SCALE: N.T.S.

FILENAME: Page 5-7

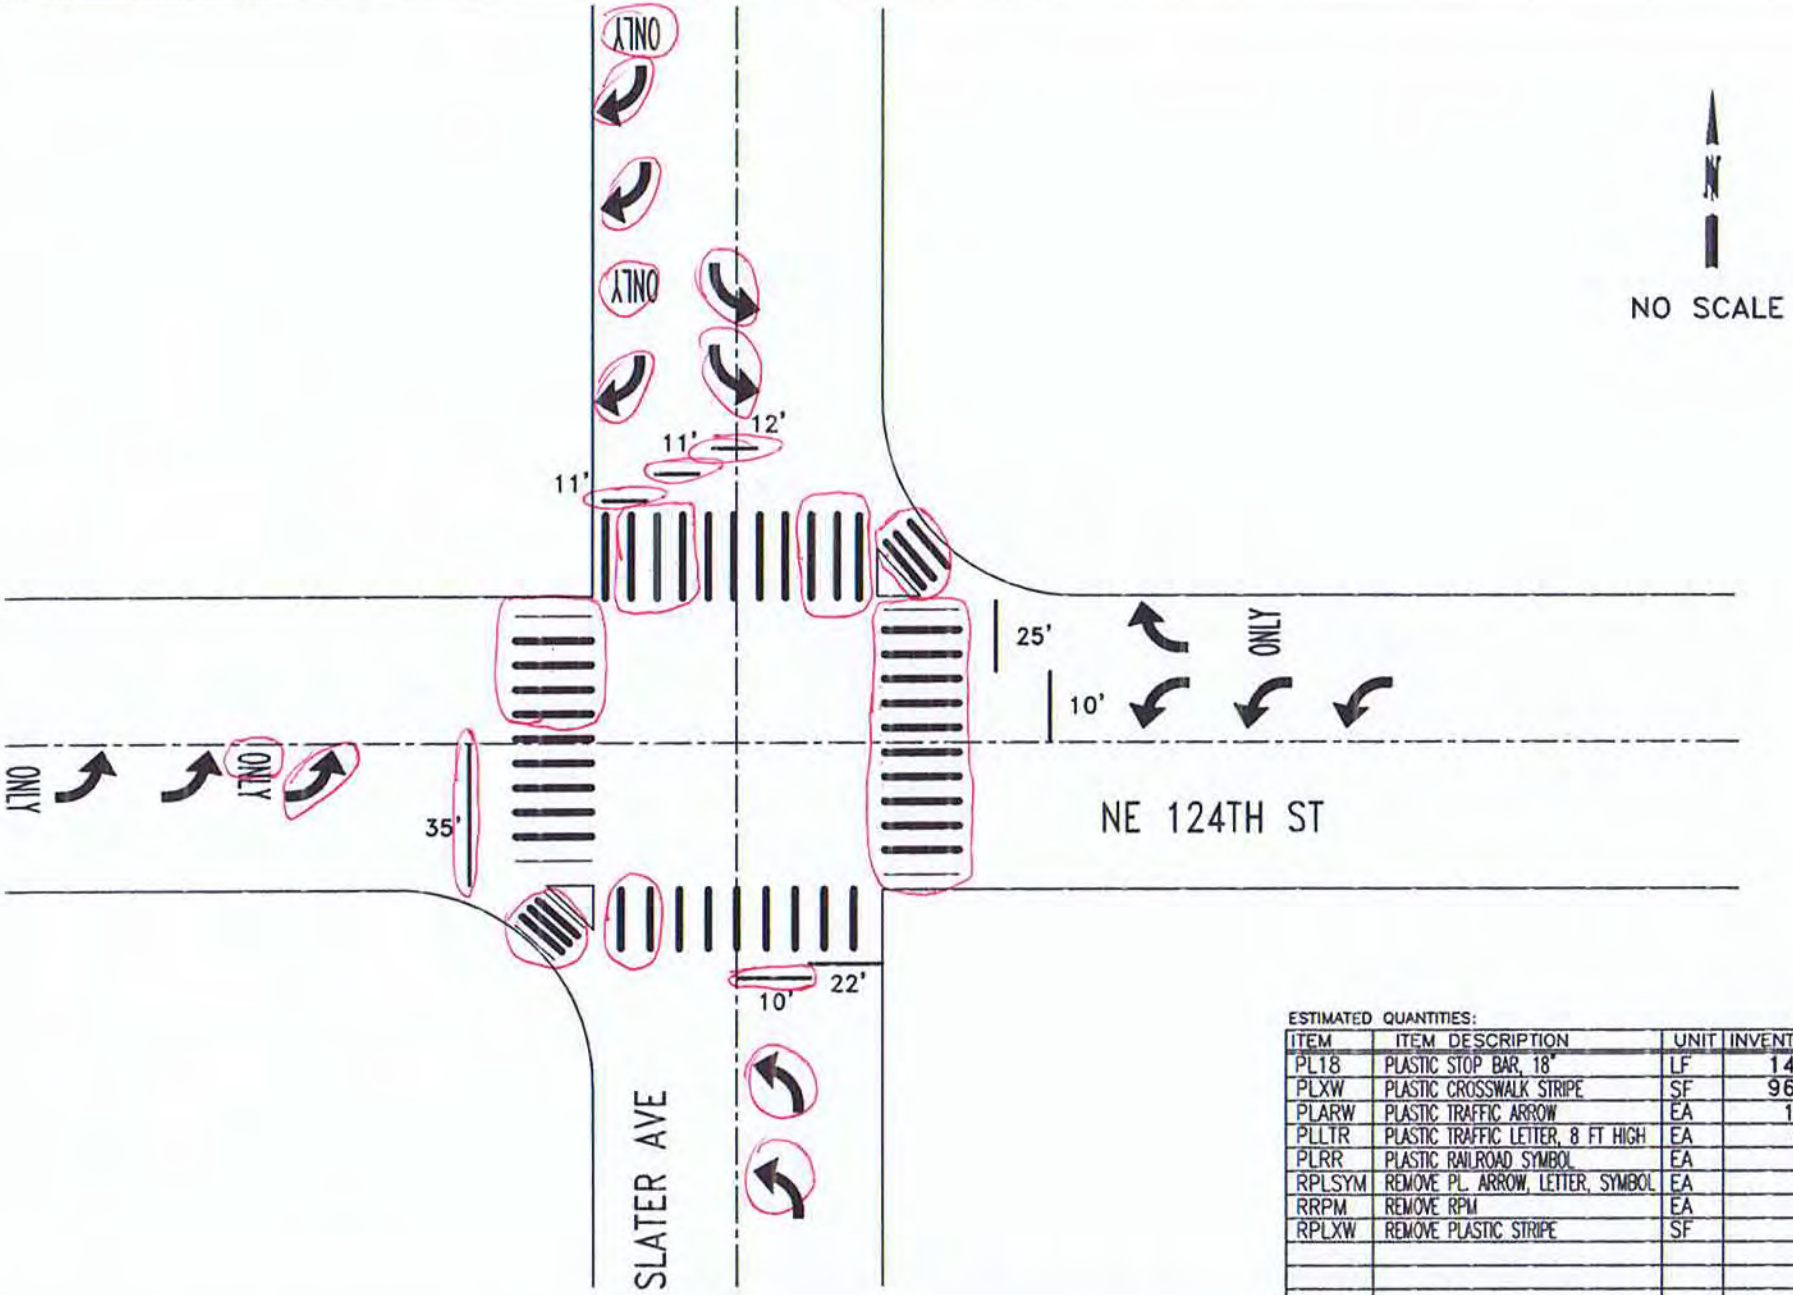

ESTIMATED QUANTITIES:

ITEM	ITEM DESCRIPTION	UNIT	INVENTORY	REPAIR QTY
PL18	PLASTIC STOP BAR, 18"	LF	144	79
PLXW	PLASTIC CROSSWALK STRIPE	SF	960	610
PLARW	PLASTIC TRAFFIC ARROW	EA	14	10
PLLTR	PLASTIC TRAFFIC LETTER, 8 FT HIGH	EA	8	10
PLRR	PLASTIC RAILROAD SYMBOL	EA		
RPLSYM	REMOVE PL. ARROW, LETTER, SYMBOL	EA		
RRPM	REMOVE RPM	EA		
RPLXW	REMOVE PLASTIC STRIPE	SF		

CITY OF KIRKLAND
DEPARTMENT OF PUBLIC WORKS
123 FIFTH AVENUE KIRKLAND, WA 98033
(425) 587-3800 www.kirklandwa.gov

G. HORTILLOSA 10/2012
DESIGNED BY: DATE

J.JENNINGS 10/2012
DRAWN BY: DATE

CHECKED BY: DATE

2022 PAVEMENT MARKING PROGRAM

STREET: NE 124TH ST

CROSS STREET: SLATER AVE

SEGMENT:

SCALE: N.T.S.

FILENAME: Page 5-8

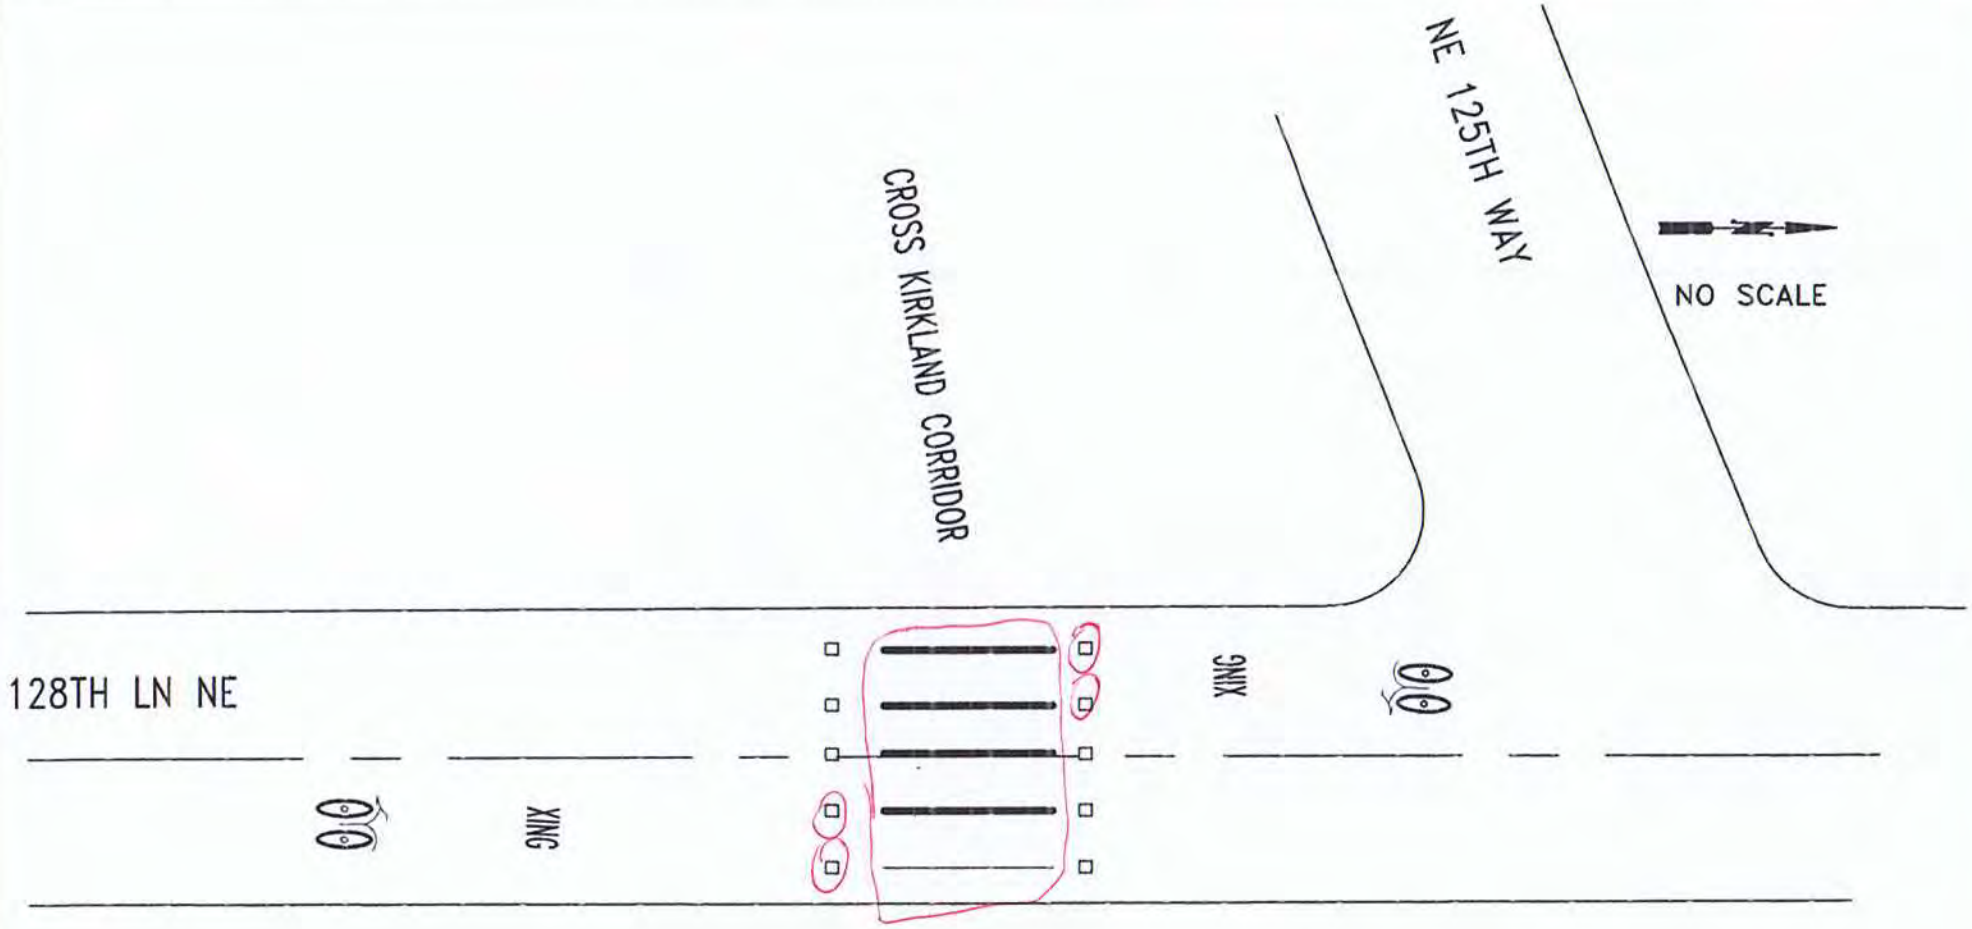

ESTIMATED QUANTITIES:

ITEM	ITEM DESCRIPTION	UNIT	INVENTORY	REPAIR QTY
PL18	PLASTIC STOP BAR, 18"	LF		
PLXW	PLASTIC CROSSWALK STRIPE	SF	90	90
PLARW	PLASTIC TRAFFIC ARROW	EA		
PLLTR	PLASTIC TRAFFIC LETTER, 8 FT HIGH	EA	8	
	RAISED PAVEMENT MARKER TYPE 2	EA	10	
PLRR24	PLASTIC BICYCLE SYMBOL	SF	2	
RPLSYM	REMOVE PL. ARROW, LETTER, SYMBOL	EA		
RRPM	REMOVE RPM	EA		
RPLXW	REMOVE PLASTIC STRIPE	SF		
	RAISED PAVEMENT MARKER TYPE 2	EA	10	4

CITY OF KIRKLAND
DEPARTMENT OF PUBLIC WORKS
123 FIFTH AVENUE KIRKLAND, WA 98033
(425) 587-3800 www.kirklandwa.gov

L. KAWAOKA 12/2016
DESIGNED BY: DATE

J.JENNINGS 12/2016
DRAWN BY: DATE

CHECKED BY: DATE

2022 PAVEMENT MARKING PROGRAM

STREET: 128TH LANE NE

CROSS STREET: CROSS KIRKLAND CORRIDOR

SEGMENT:

SCALE: N.T.S.

FILENAME: Page 5-9

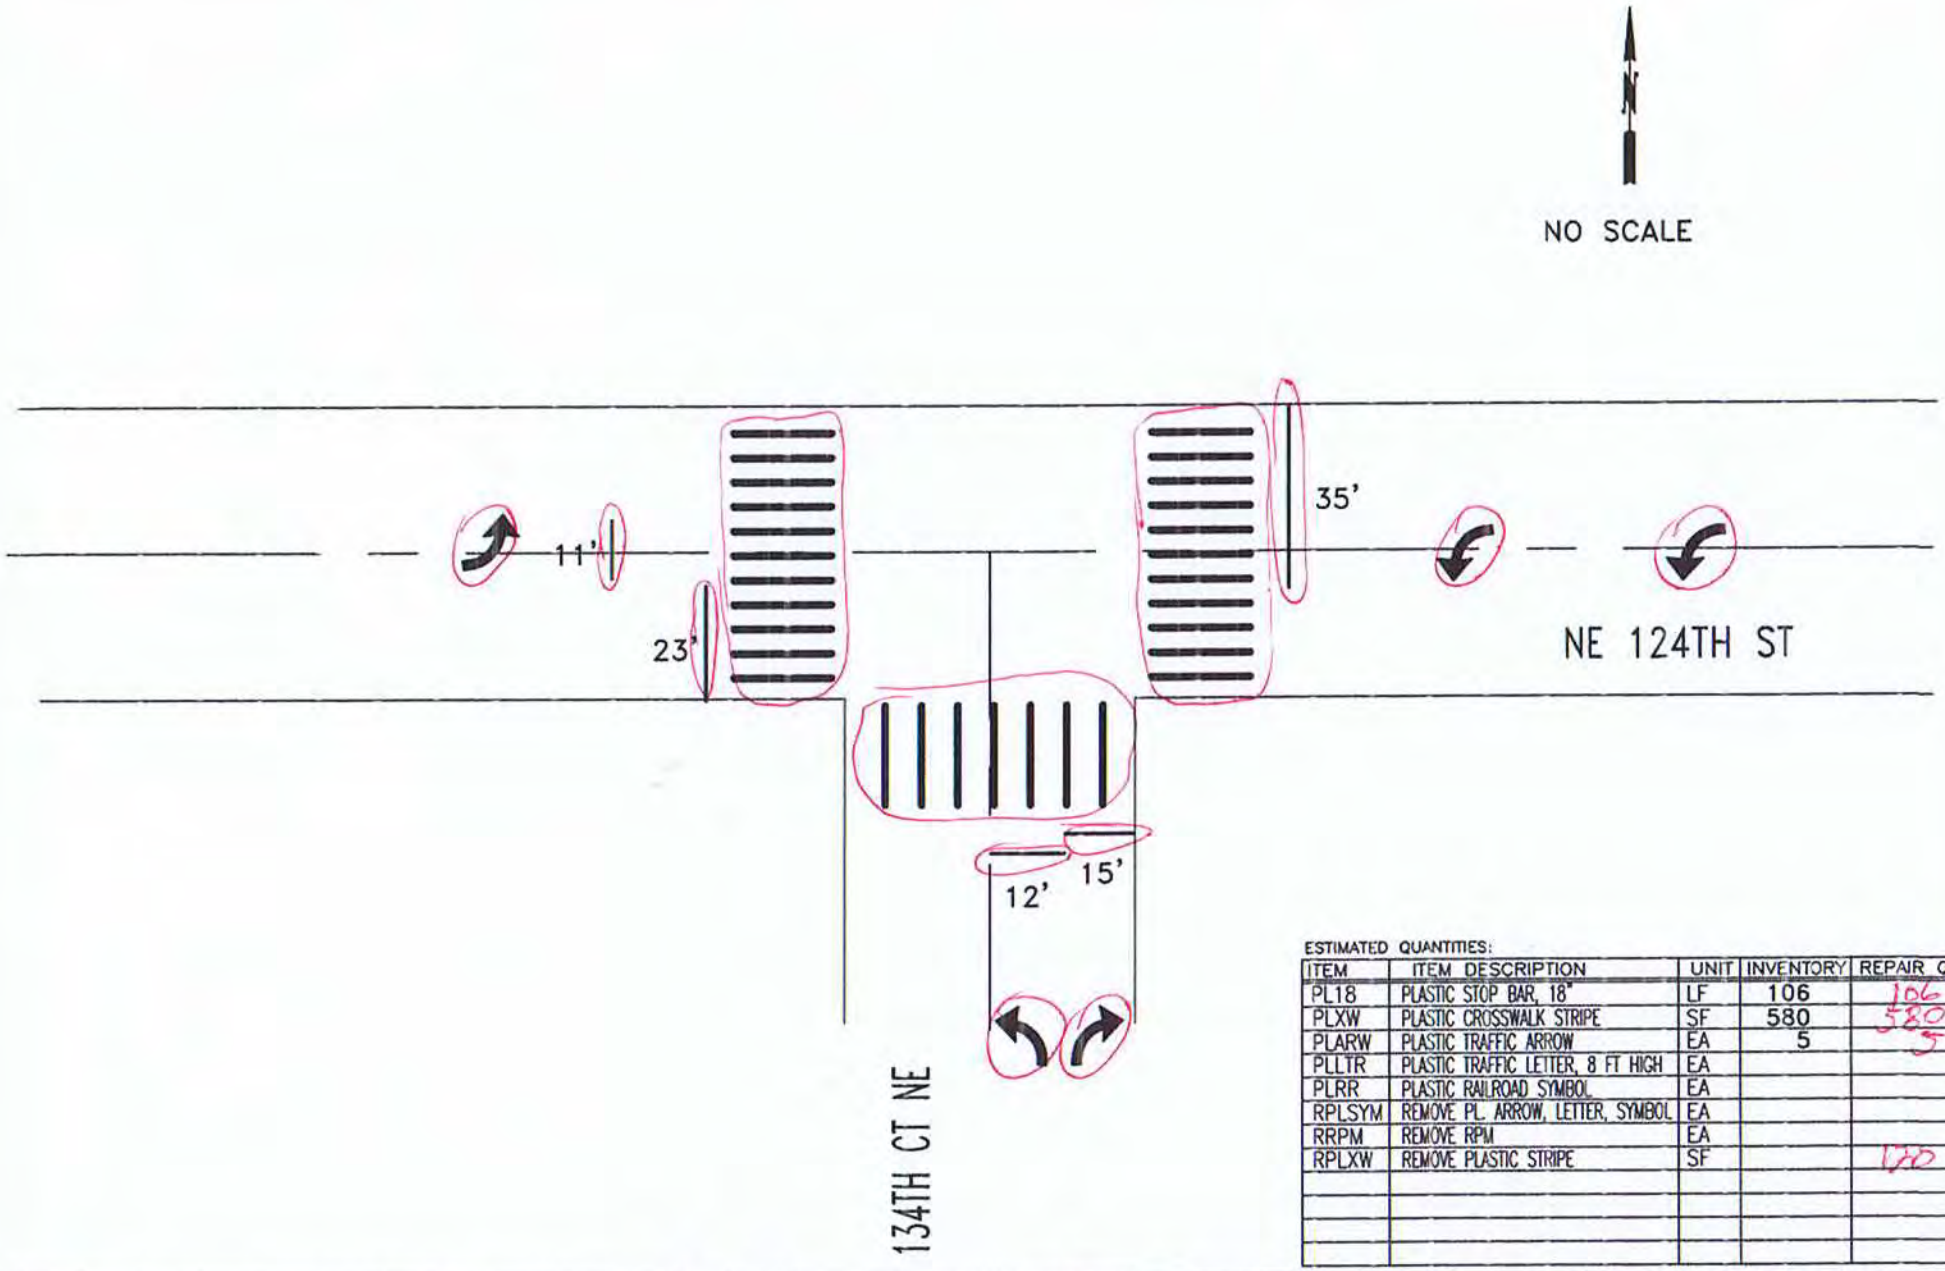

ESTIMATED QUANTITIES:

ITEM	ITEM DESCRIPTION	UNIT	INVENTORY	REPAIR QTY
PL18	PLASTIC STOP BAR, 18"	LF	106	106
PLXW	PLASTIC CROSSWALK STRIPE	SF	580	580
PLARW	PLASTIC TRAFFIC ARROW	EA	5	5
PLLTR	PLASTIC TRAFFIC LETTER, 8 FT HIGH	EA		
PLRR	PLASTIC RAILROAD SYMBOL	EA		
RPLSYM	REMOVE PL. ARROW, LETTER, SYMBOL	EA		
RRPM	REMOVE RPM	EA		
RPLXW	REMOVE PLASTIC STRIPE	SF		170

CITY OF KIRKLAND
DEPARTMENT OF PUBLIC WORKS
123 FIFTH AVENUE KIRKLAND, WA 98033
(425) 587-3800 www.kirklandwa.gov

G. HORTILLOSA 7/2013
DESIGNED BY: DATE

J.JENNINGS 7/2013
DRAWN BY: DATE

CHECKED BY: DATE

2020 PAVEMENT MARKING PROGRAM

STREET: NE 124TH ST

CROSS STREET: 134TH CT NE

SEGMENT:

SCALE: N.T.S.

FILENAME: Page 5-10

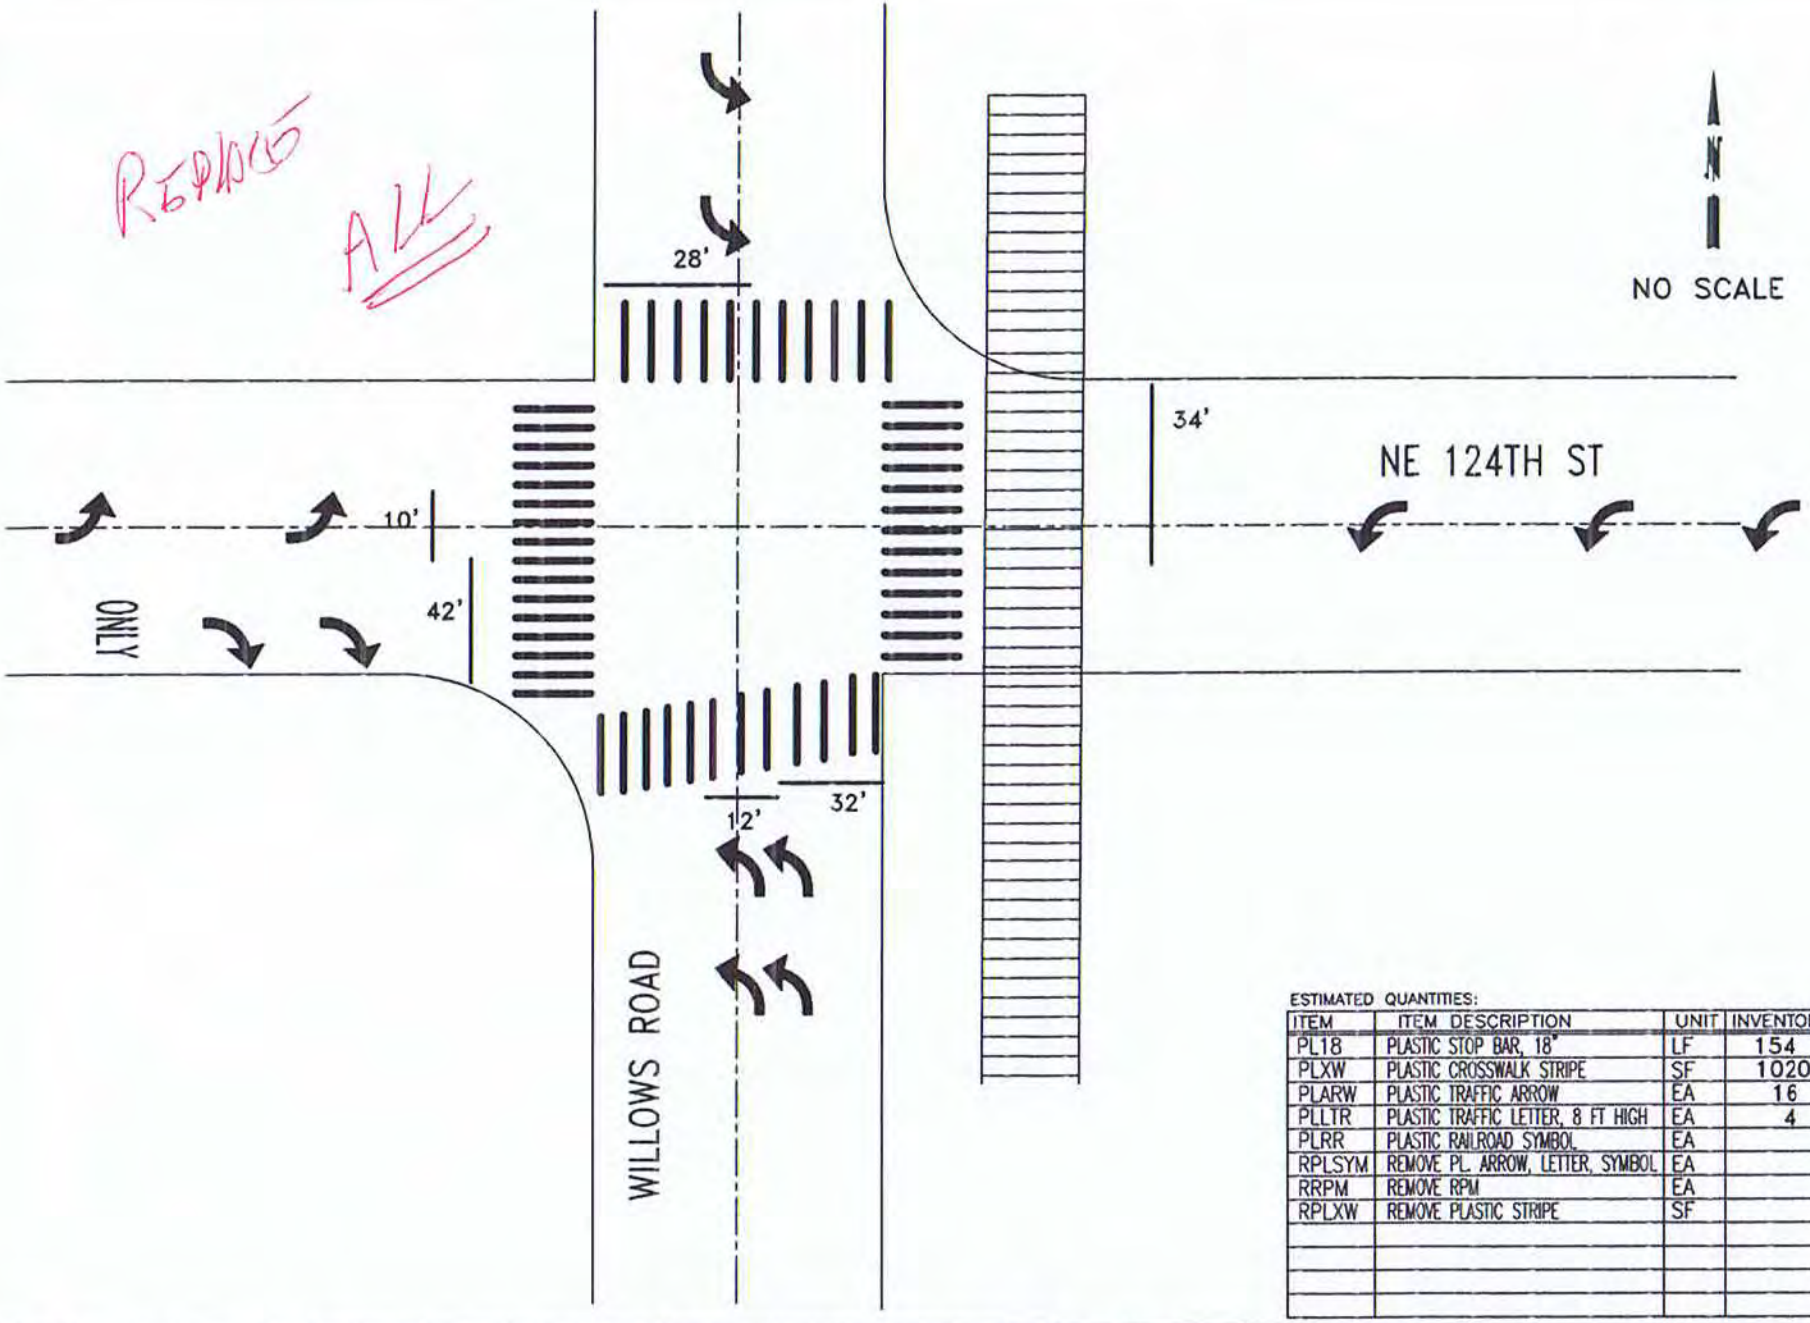

ESTIMATED QUANTITIES:

ITEM	ITEM DESCRIPTION	UNIT	INVENTORY	REPAIR QTY
PL18	PLASTIC STOP BAR, 18"	LF	154	154
PLXW	PLASTIC CROSSWALK STRIPE	SF	1020	1020
PLARW	PLASTIC TRAFFIC ARROW	EA	16	16
PLLTR	PLASTIC TRAFFIC LETTER, 8 FT HIGH	EA	4	4
PLRR	PLASTIC RAILROAD SYMBOL	EA		
RPLSYM	REMOVE PL. ARROW, LETTER, SYMBOL	EA		
RRPM	REMOVE RPM	EA		
RPLXW	REMOVE PLASTIC STRIPE	SF		

CITY OF KIRKLAND
DEPARTMENT OF PUBLIC WORKS
123 FIFTH AVENUE KIRKLAND, WA 98033
(425) 587-3800 www.kirklandwa.gov

G. HORTILLOSA 7/2013
DESIGNED BY: DATE

J.JENNINGS 7/2013
DRAWN BY: DATE

CHECKED BY: DATE

2022 PAVEMENT MARKING PROGRAM

STREET: NE 124TH ST

CROSS STREET: WILLOWS ROAD

SEGMENT:

SCALE: N.T.S.

FILENAME:

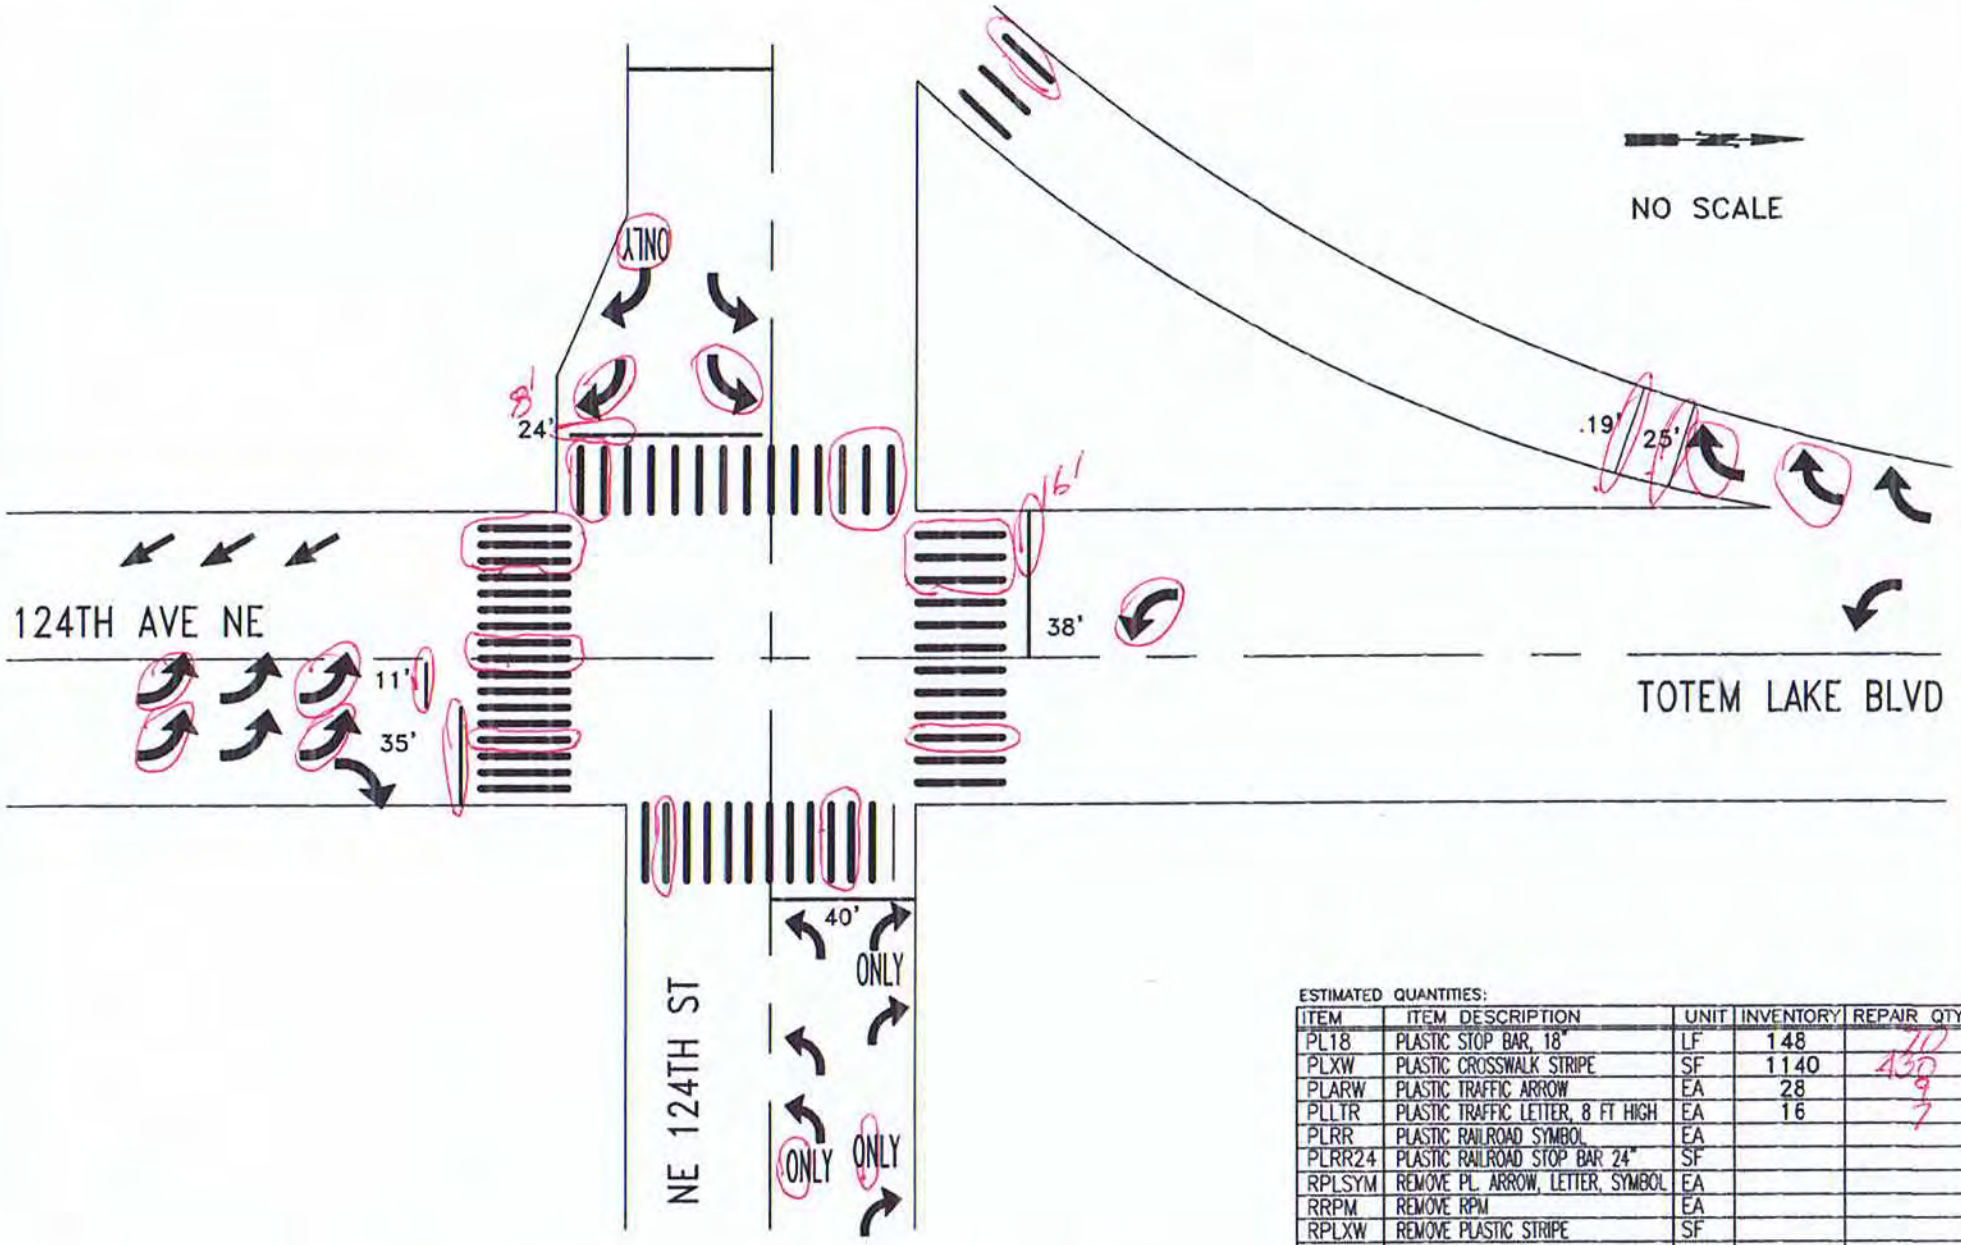

ESTIMATED QUANTITIES:

ITEM	ITEM DESCRIPTION	UNIT	INVENTORY	REPAIR QTY
PL18	PLASTIC STOP BAR, 18"	LF	148	30
PLXW	PLASTIC CROSSWALK STRIPE	SF	1140	430
PLARW	PLASTIC TRAFFIC ARROW	EA	28	9
PLLTR	PLASTIC TRAFFIC LETTER, 8 FT HIGH	EA	16	7
PLRR	PLASTIC RAILROAD SYMBOL	EA		
PLRR24	PLASTIC RAILROAD STOP BAR 24"	SF		
RPLSYM	REMOVE PL. ARROW, LETTER, SYMBOL	EA		
RRPM	REMOVE RPM	EA		
RPLXW	REMOVE PLASTIC STRIPE	SF		

CITY OF KIRKLAND
DEPARTMENT OF PUBLIC WORKS
123 FIFTH AVENUE KIRKLAND, WA 98033
(425) 587-3800 www.kirklandwa.gov

G. HORTILLOSA 10/2012
DESIGNED BY: DATE

J.JENNINGS 10/2012
DRAWN BY: DATE

CHECKED BY: DATE

2020 PAVEMENT MARKING PROGRAM

STREET: TOTEM LAKE BLVD

CROSS STREET: NE 124TH ST

SEGMENT:

SCALE: N.T.S.

FILENAME: Page 5-12

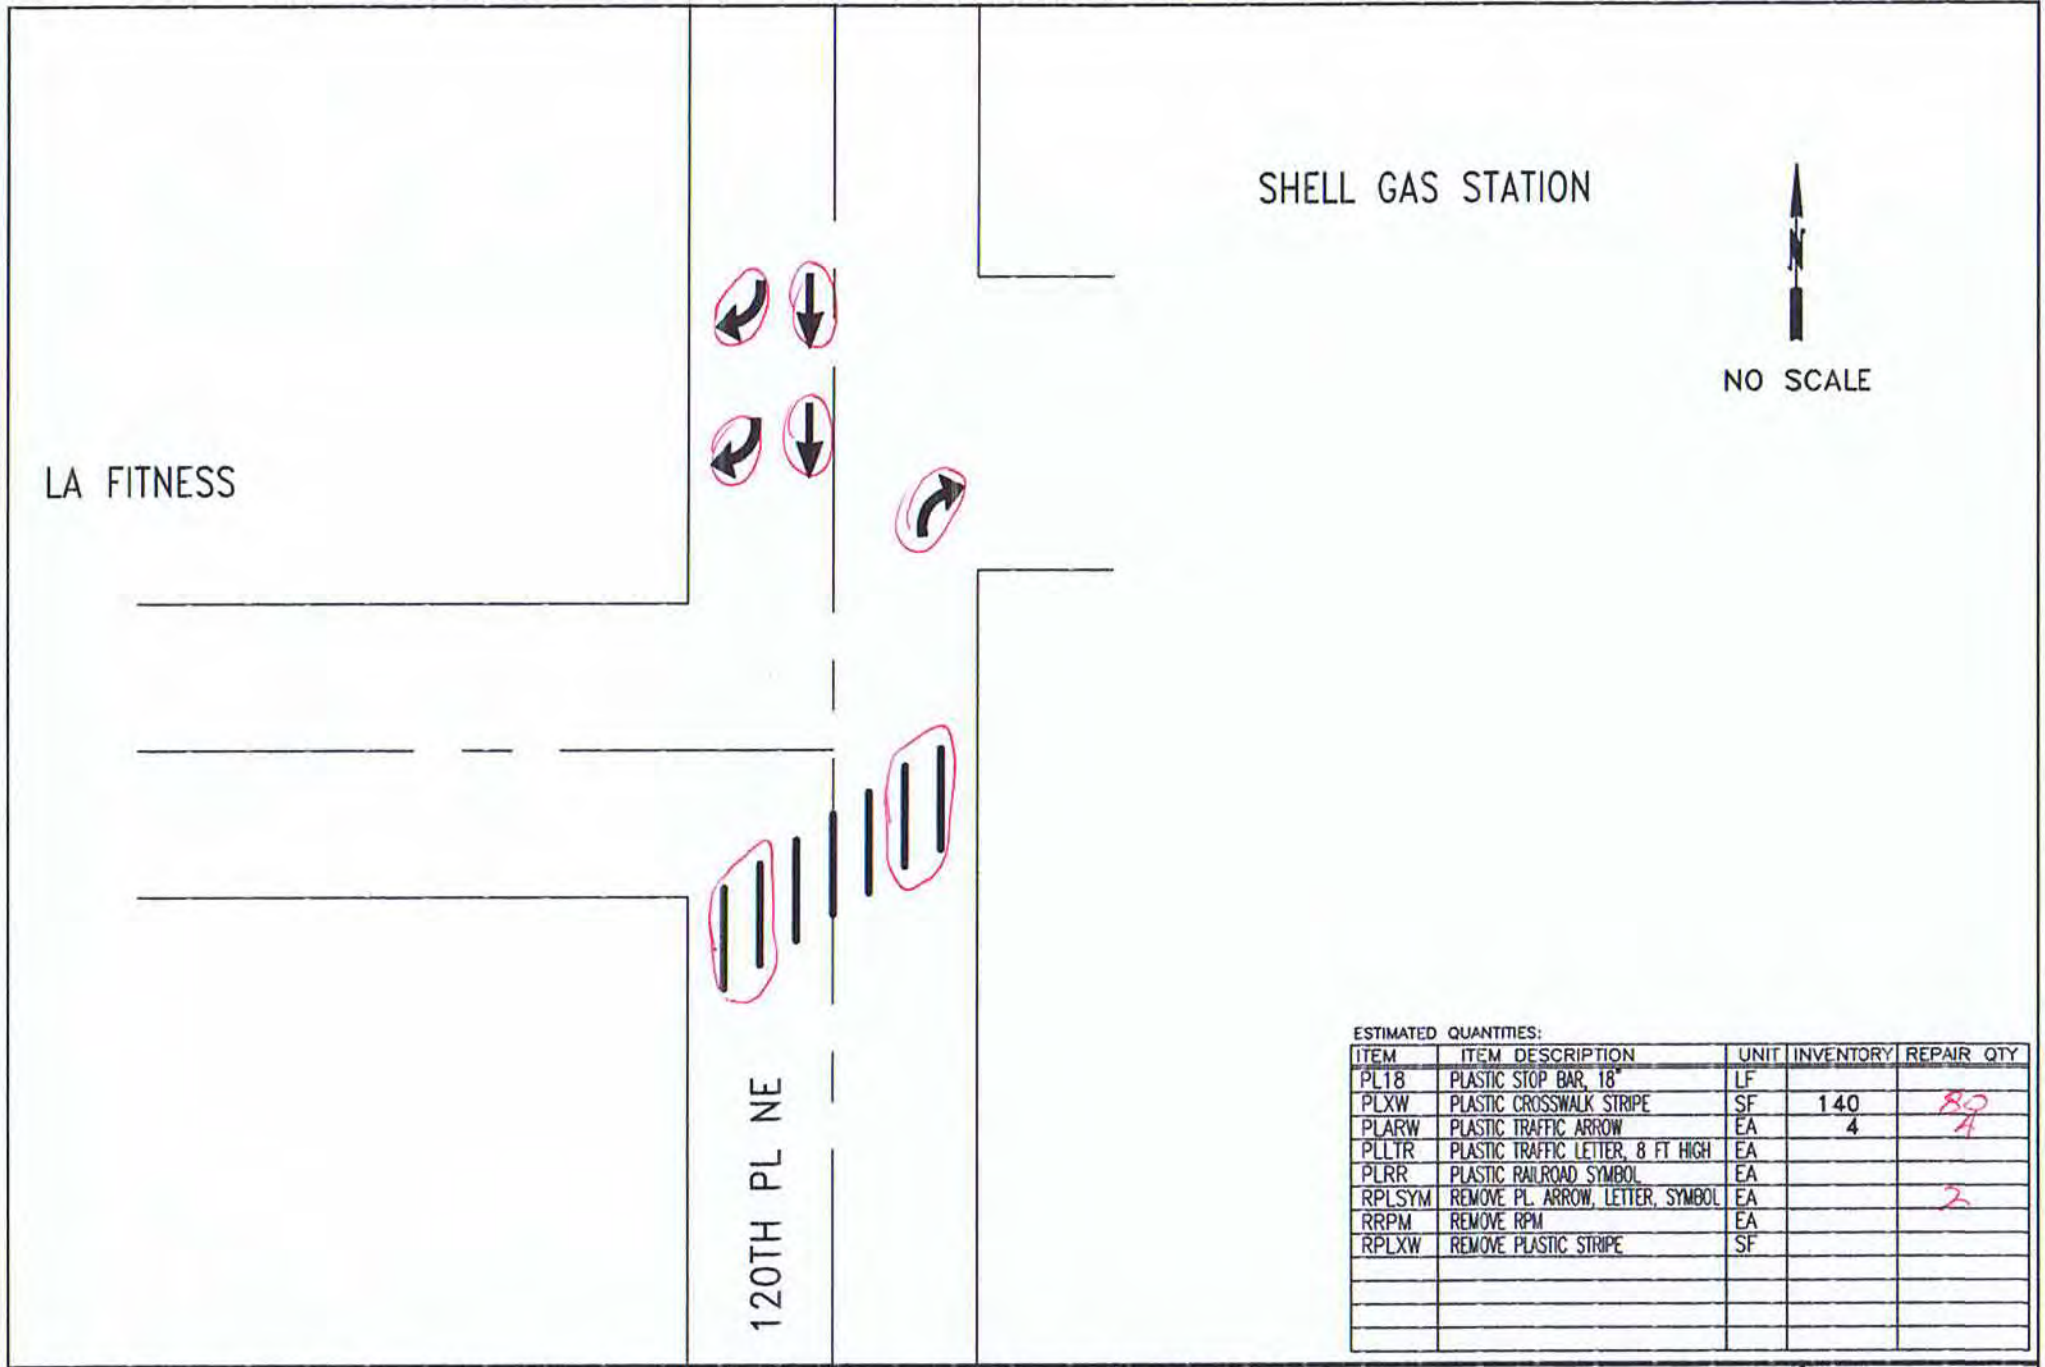

ESTIMATED QUANTITIES:

ITEM	ITEM DESCRIPTION	UNIT	INVENTORY	REPAIR QTY
PL18	PLASTIC STOP BAR, 18"	LF		
PLXW	PLASTIC CROSSWALK STRIPE	SF	140	89
PLARW	PLASTIC TRAFFIC ARROW	EA	4	4
PLLTR	PLASTIC TRAFFIC LETTER, 8 FT HIGH	EA		
PLRR	PLASTIC RAILROAD SYMBOL	EA		
RPLSYM	REMOVE PL. ARROW, LETTER, SYMBOL	EA		2
RRPM	REMOVE RPM	EA		
RPLXW	REMOVE PLASTIC STRIPE	SF		

CITY OF KIRKLAND
DEPARTMENT OF PUBLIC WORKS
123 FIFTH AVENUE KIRKLAND, WA 98033
(425) 587-3800 www.kirklandwa.gov

G. HORTILLOSA 4/2007
DESIGNED BY: DATE

J.JENNINGS 4/2007
DRAWN BY: DATE

CHECKED BY: DATE

20~~07~~ PAVEMENT MARKING PROGRAM

STREET: 120TH PL NE

CROSS STREET: LARRY'S MARKET

SEGMENT:

SCALE: N.T.S.

FILENAME: Page 5-14

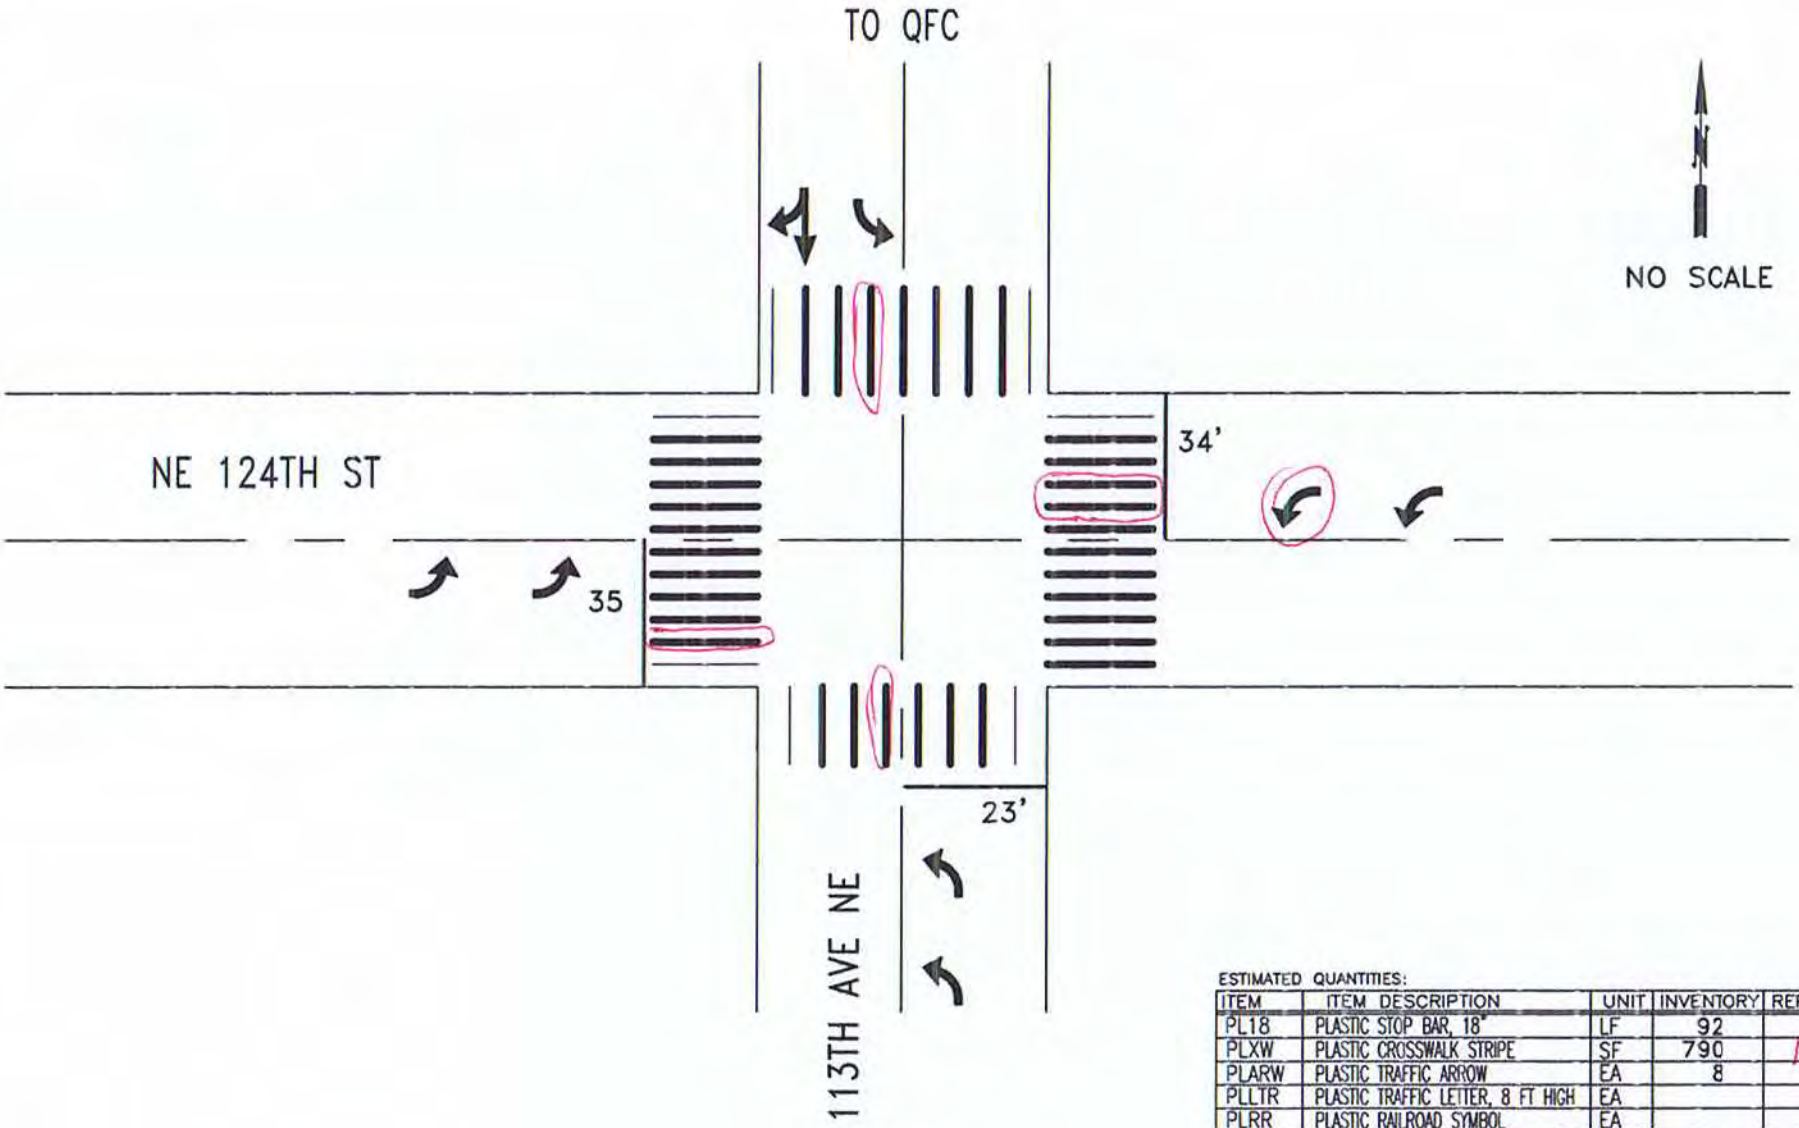

ESTIMATED QUANTITIES:

ITEM	ITEM DESCRIPTION	UNIT	INVENTORY	REPAIR QTY
PL18	PLASTIC STOP BAR, 18"	LF	92	
PLXW	PLASTIC CROSSWALK STRIPE	SF	790	100
PLARW	PLASTIC TRAFFIC ARROW	EA	8	
PLLTR	PLASTIC TRAFFIC LETTER, 8 FT HIGH	EA		1
PLRR	PLASTIC RAILROAD SYMBOL	EA		
RPLSYM	REMOVE PL. ARROW, LETTER, SYMBOL	EA		
RRPM	REMOVE RPM	EA		
RPLXW	REMOVE PLASTIC STRIPE	SF		40

CITY OF KIRKLAND
DEPARTMENT OF PUBLIC WORKS
123 FIFTH AVENUE KIRKLAND, WA 98033
(425) 587-3800 www.kirklandwa.gov

G. HORTILLOSA 2/2011
DESIGNED BY: DATE

J.JENNINGS 8/2005
DRAWN BY: DATE

CHECKED BY: DATE

2020 PAVEMENT MARKING PROGRAM

STREET: NE 124TH ST

CROSS STREET: 113TH AVE NE

SEGMENT:

SCALE: N.T.S.

FILENAME: Page 5-15

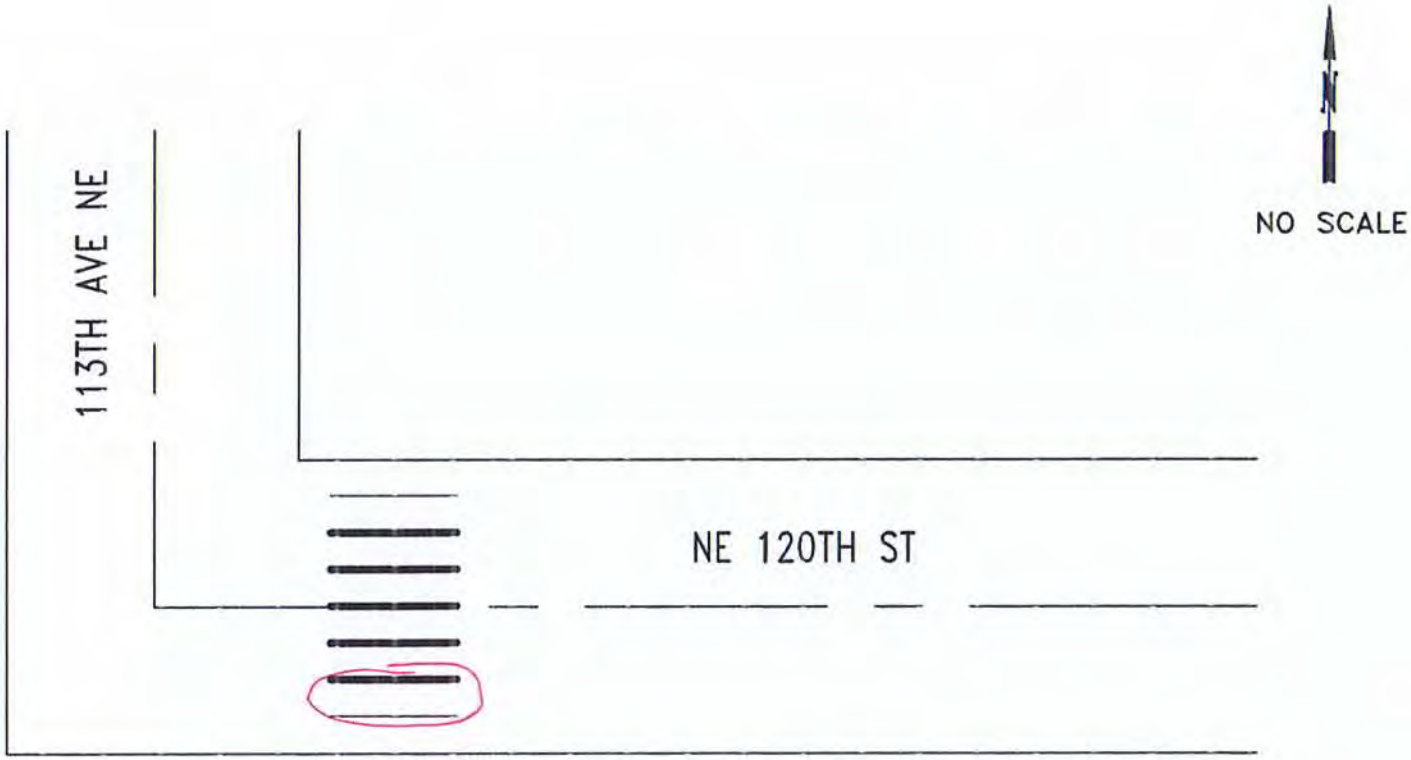

ESTIMATED QUANTITIES:

ITEM	ITEM DESCRIPTION	UNIT	INVENTORY	REPAIR QTY
PL18	PLASTIC STOP BAR, 18"	LF		
PLXW	PLASTIC CROSSWALK STRIPE	SF	120	30
PLARW	PLASTIC TRAFFIC ARROW	EA		
PLLTR	PLASTIC TRAFFIC LETTER, 8 FT HIGH	EA		
PLRR	PLASTIC RAILROAD SYMBOL	EA		
RPLSYM	REMOVE PL. ARROW, LETTER, SYMBOL	EA		
RRPM	REMOVE RPM	EA		
RPLXW	REMOVE PLASTIC STRIPE	SF		30

CITY OF KIRKLAND
DEPARTMENT OF PUBLIC WORKS
123 FIFTH AVENUE KIRKLAND, WA 98033
(425) 587-3800 www.kirklandwa.gov

G. HORTILLOSA 3/2009
DESIGNED BY: DATE

J.JENNINGS 3/2009
DRAWN BY: DATE

CHECKED BY: DATE

2020 PAVEMENT MARKING PROGRAM

STREET: 113TH AVE NE

CROSS STREET: NE 120TH ST

SEGMENT:

SCALE: N.T.S.

FILENAME: Page 5-16

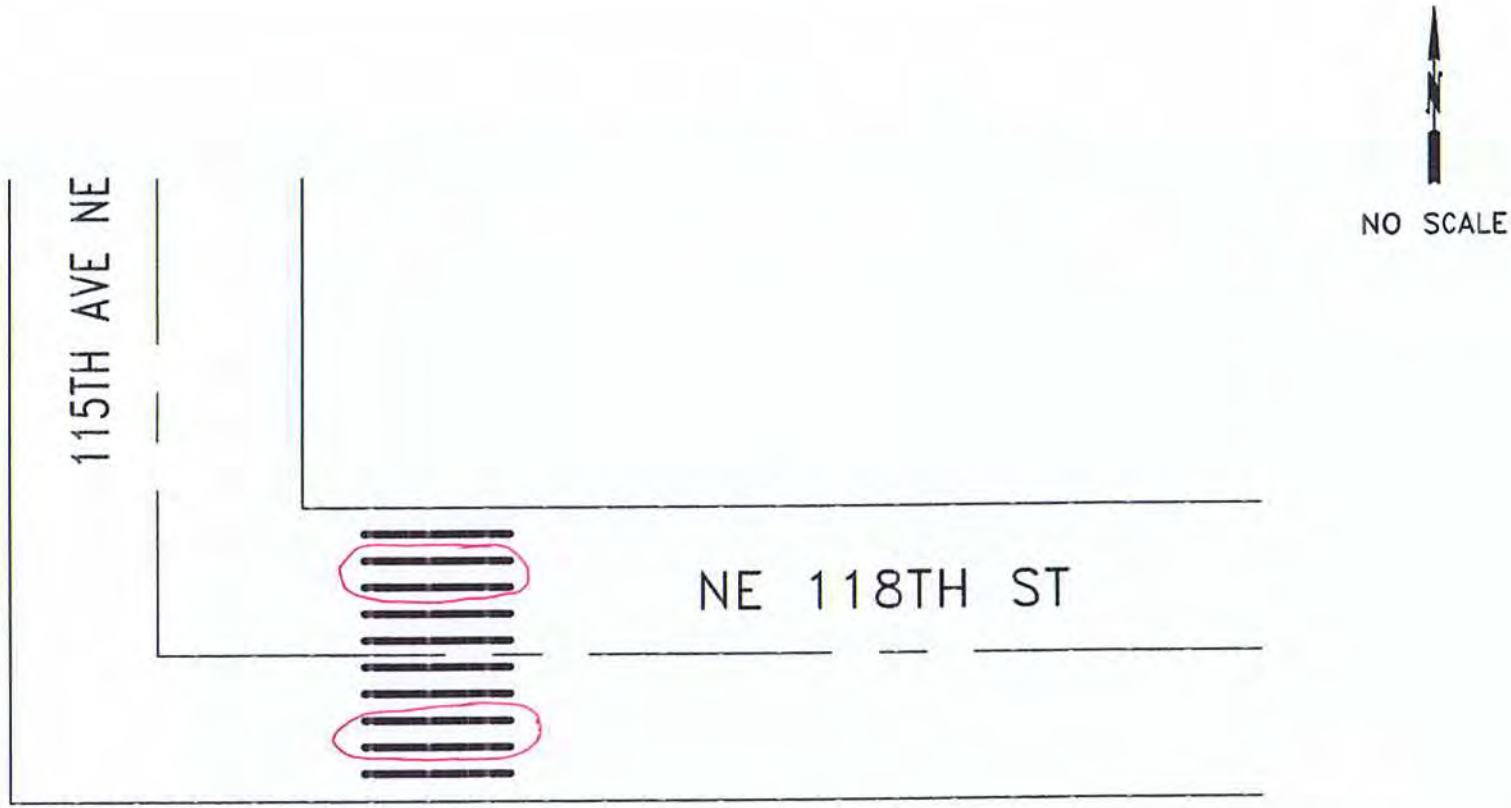

ESTIMATED QUANTITIES:

ITEM	ITEM DESCRIPTION	UNIT	INVENTORY	REPAIR QTY
PL18	PLASTIC STOP BAR, 18"	LF		
PLXW	PLASTIC CROSSWALK STRIPE	SF	200	80
PLARW	PLASTIC TRAFFIC ARROW	EA		
PLLTR	PLASTIC TRAFFIC LETTER, 8 FT HIGH	EA		
PLRR	PLASTIC RAILROAD SYMBOL	EA		
RPLSYM	REMOVE PL. ARROW, LETTER, SYMBOL	EA		
RRPM	REMOVE RPM	EA		
RPLXW	REMOVE PLASTIC STRIPE	SF		80

CITY OF KIRKLAND
DEPARTMENT OF PUBLIC WORKS
123 FIFTH AVENUE KIRKLAND, WA 98033
(425) 587-3800 www.kirklandwa.gov

D.GRILLEY 1/2000
DESIGNED BY: DATE

J.JENNINGS 1/2000
DRAWN BY: DATE

CHECKED BY: DATE

2020 PAVEMENT MARKING PROGRAM

STREET: 115TH AVE NE

CROSS STREET: NE 118TH ST

SEGMENT:

SCALE: N.T.S.

FILENAME: Page 5-17

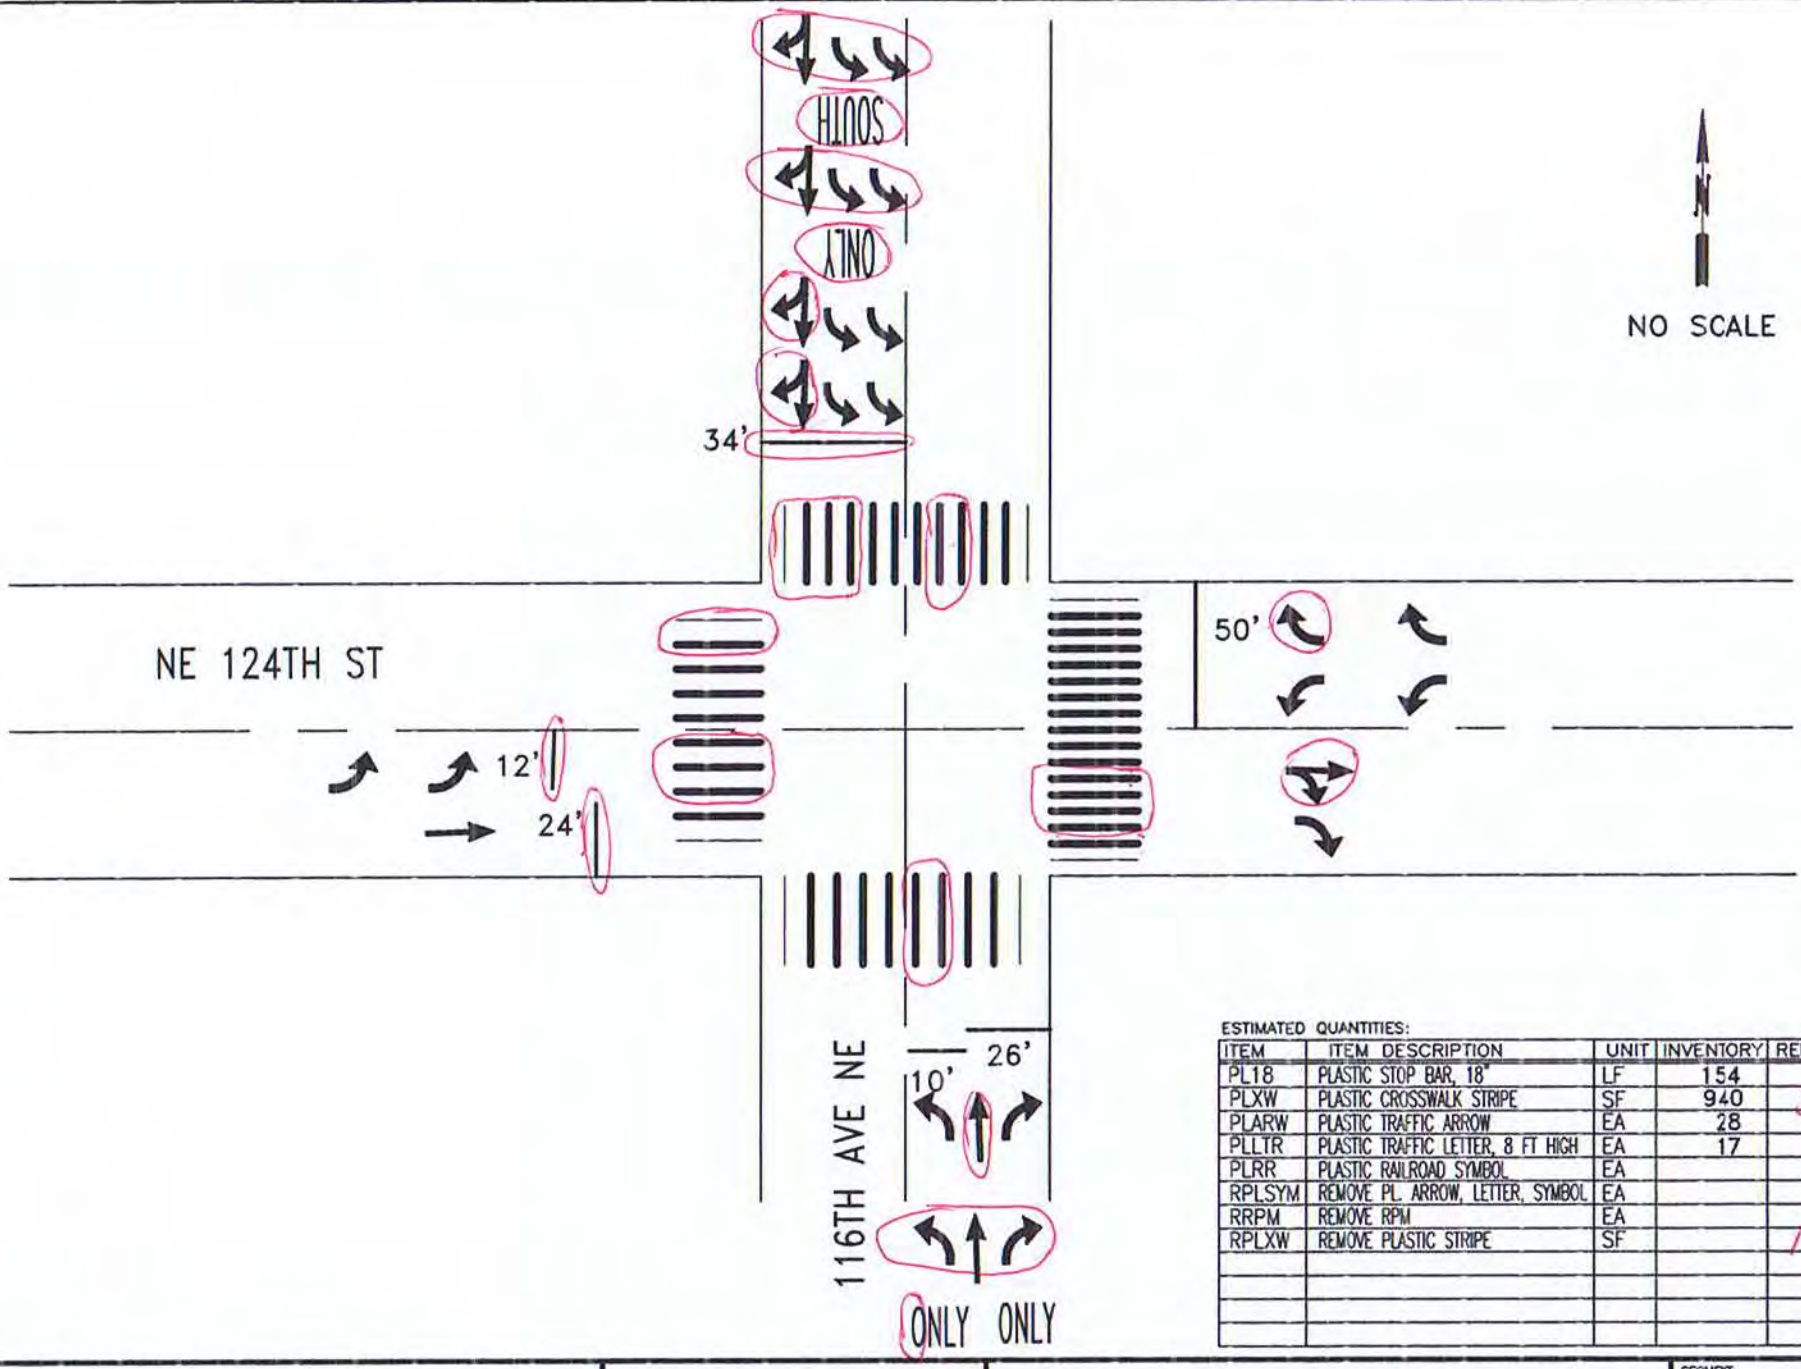

ESTIMATED QUANTITIES:

ITEM	ITEM DESCRIPTION	UNIT	INVENTORY	REPAIR QTY
PL18	PLASTIC STOP BAR, 18"	LF	154	70
PLXW	PLASTIC CROSSWALK STRIPE	SF	940	320
PLARW	PLASTIC TRAFFIC ARROW	EA	28	4
PLLTR	PLASTIC TRAFFIC LETTER, 8 FT HIGH	EA	17	10
PLRR	PLASTIC RAILROAD SYMBOL	EA		
RPLSYM	REMOVE PL. ARROW, LETTER, SYMBOL	EA		3
RRPM	REMOVE RPM	EA		
RPLXW	REMOVE PLASTIC STRIPE	SF		160

CITY OF KIRKLAND
DEPARTMENT OF PUBLIC WORKS
123 FIFTH AVENUE KIRKLAND, WA 98033
(425) 587-3800 www.kirklandwa.gov

G. HORTILLOSA 3/2009
DESIGNED BY: DATE

J.JENNINGS 3/2009
DRAWN BY: DATE

CHECKED BY: DATE

2022 PAVEMENT MARKING PROGRAM

STREET: NE 124TH ST

CROSS STREET: 116TH AVE NE

SEGMENT:

SCALE: N.T.S.

FILENAME: Page 5-18

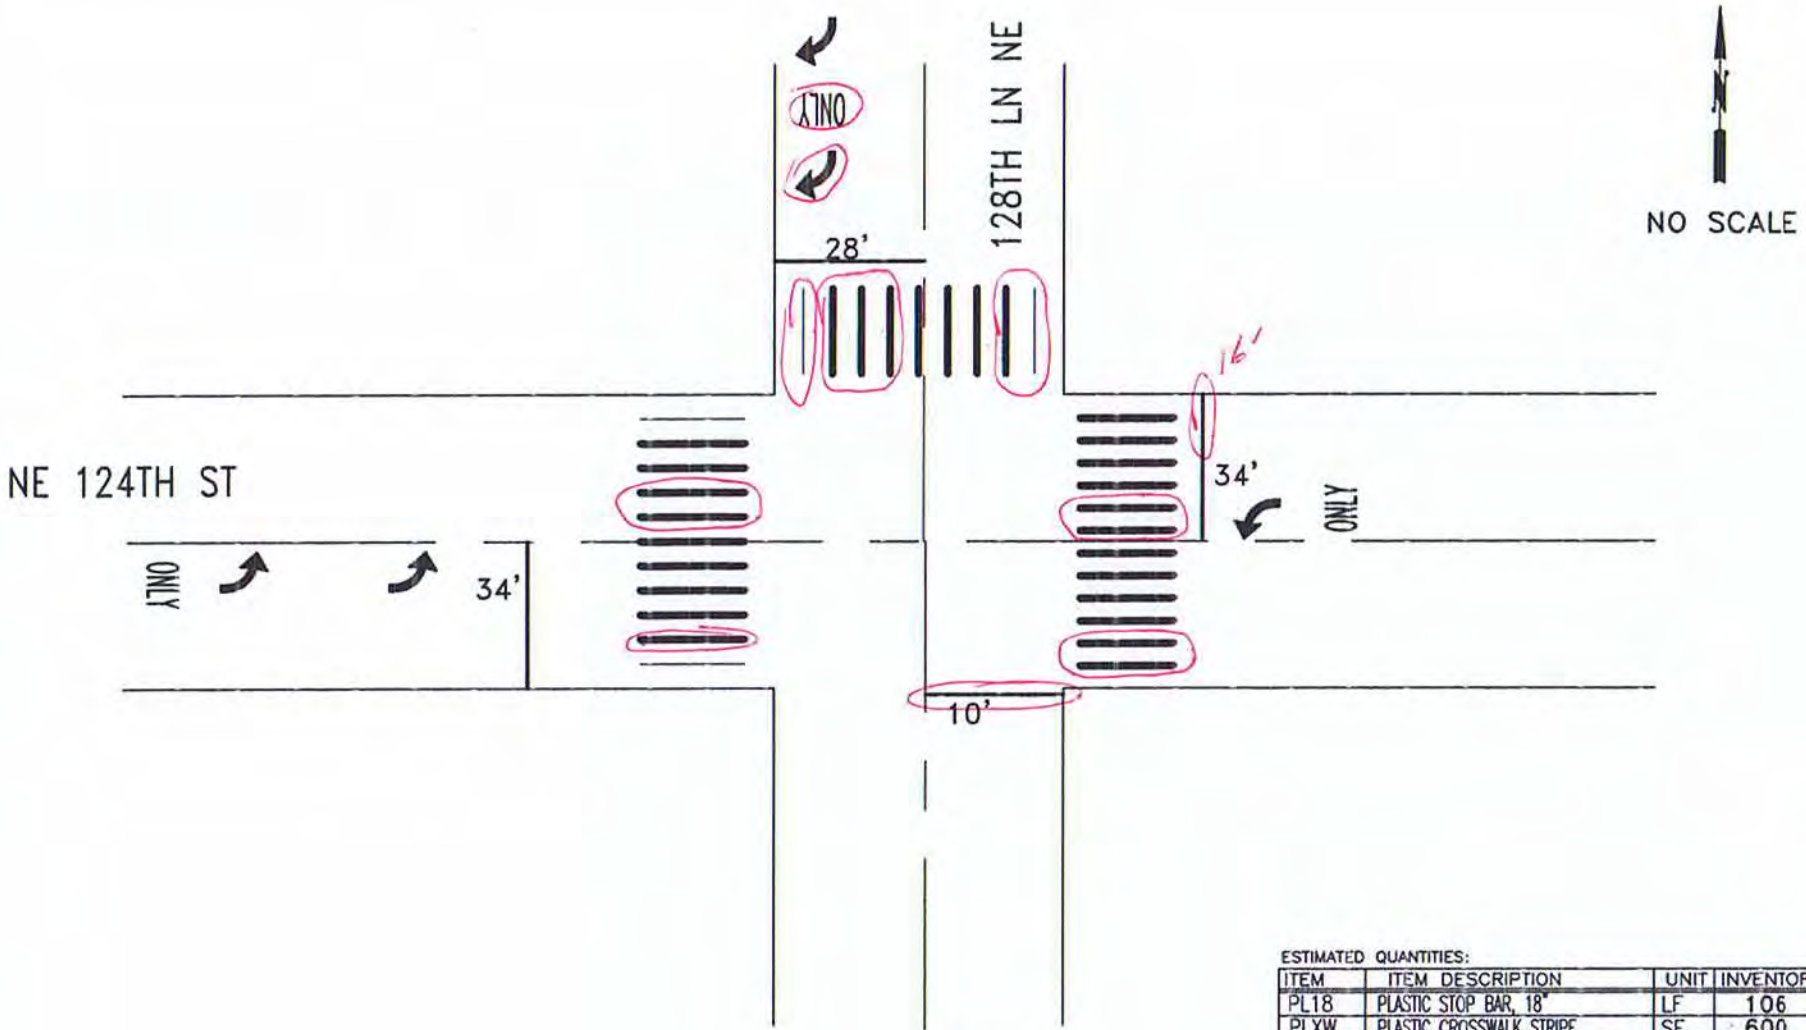

ESTIMATED QUANTITIES:

ITEM	ITEM DESCRIPTION	UNIT	INVENTORY	REPAIR QTY
PL18	PLASTIC STOP BAR, 18"	LF	106	26
PLXW	PLASTIC CROSSWALK STRIPE	SF	600	240
PLARW	PLASTIC TRAFFIC ARROW	EA	6	
PLLTR	PLASTIC TRAFFIC LETTER, 8 FT HIGH	EA	12	4
PLRR	PLASTIC RAILROAD SYMBOL	EA		
RPLSYM	REMOVE PL. ARROW, LETTER, SYMBOL	EA		
RRPM	REMOVE RPM	EA		
RPLXW	REMOVE PLASTIC STRIPE	SF		10

CITY OF KIRKLAND
DEPARTMENT OF PUBLIC WORKS
123 FIFTH AVENUE KIRKLAND, WA 98033
(425) 587-3800 www.kirklandwa.gov

G. HORTILLOSA 10/2012
DESIGNED BY: DATE

J.JENNINGS 10/2012
DRAWN BY: DATE

CHECKED BY: DATE

2020 PAVEMENT MARKING PROGRAM

STREET: NE 124TH ST

CROSS STREET: 128TH LN NE

SEGMENT:

SCALE: N.T.S.

FILENAME: Page 5-19

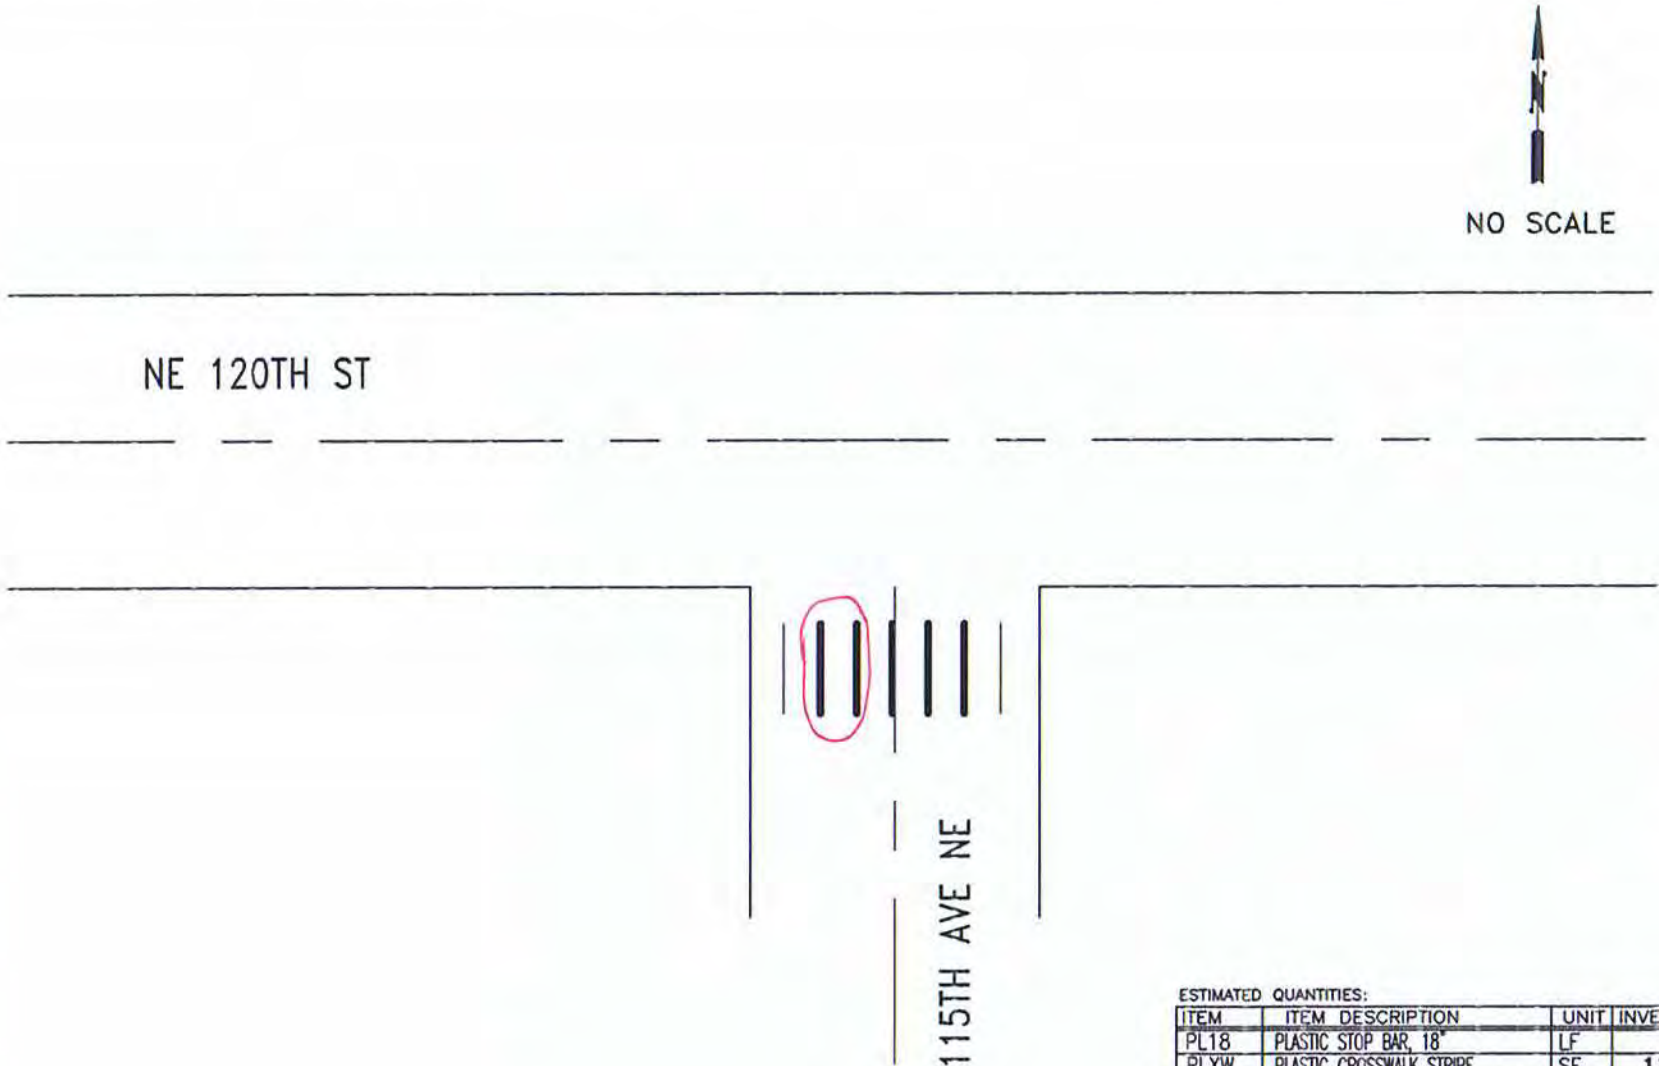

ESTIMATED QUANTITIES:

ITEM	ITEM DESCRIPTION	UNIT	INVENTORY	REPAIR QTY
PL18	PLASTIC STOP BAR, 18"	LF		
PLXW	PLASTIC CROSSWALK STRIPE	SF	120	40
PLARW	PLASTIC TRAFFIC ARROW	EA		
PLLTR	PLASTIC TRAFFIC LETTER, 8 FT HIGH	EA		
PLRR	PLASTIC RAILROAD SYMBOL	EA		
RPLSYM	REMOVE PL. ARROW, LETTER, SYMBOL	EA		
RRPM	REMOVE RPM	EA		
RPLXW	REMOVE PLASTIC STRIPE	SF		40

CITY OF KIRKLAND
DEPARTMENT OF PUBLIC WORKS
123 FIFTH AVENUE KIRKLAND, WA 98033
(425) 587-3800 www.kirklandwa.gov

G. HORTILLOSA 3/2009
DESIGNED BY: DATE

J.JENNINGS 3/2009
DRAWN BY: DATE

CHECKED BY: DATE

2022 PAVEMENT MARKING PROGRAM

STREET: NE 120TH ST

CROSS STREET: 115TH AVE NE

SEGMENT:

SCALE: N.T.S.

FILENAME: Page 5-20

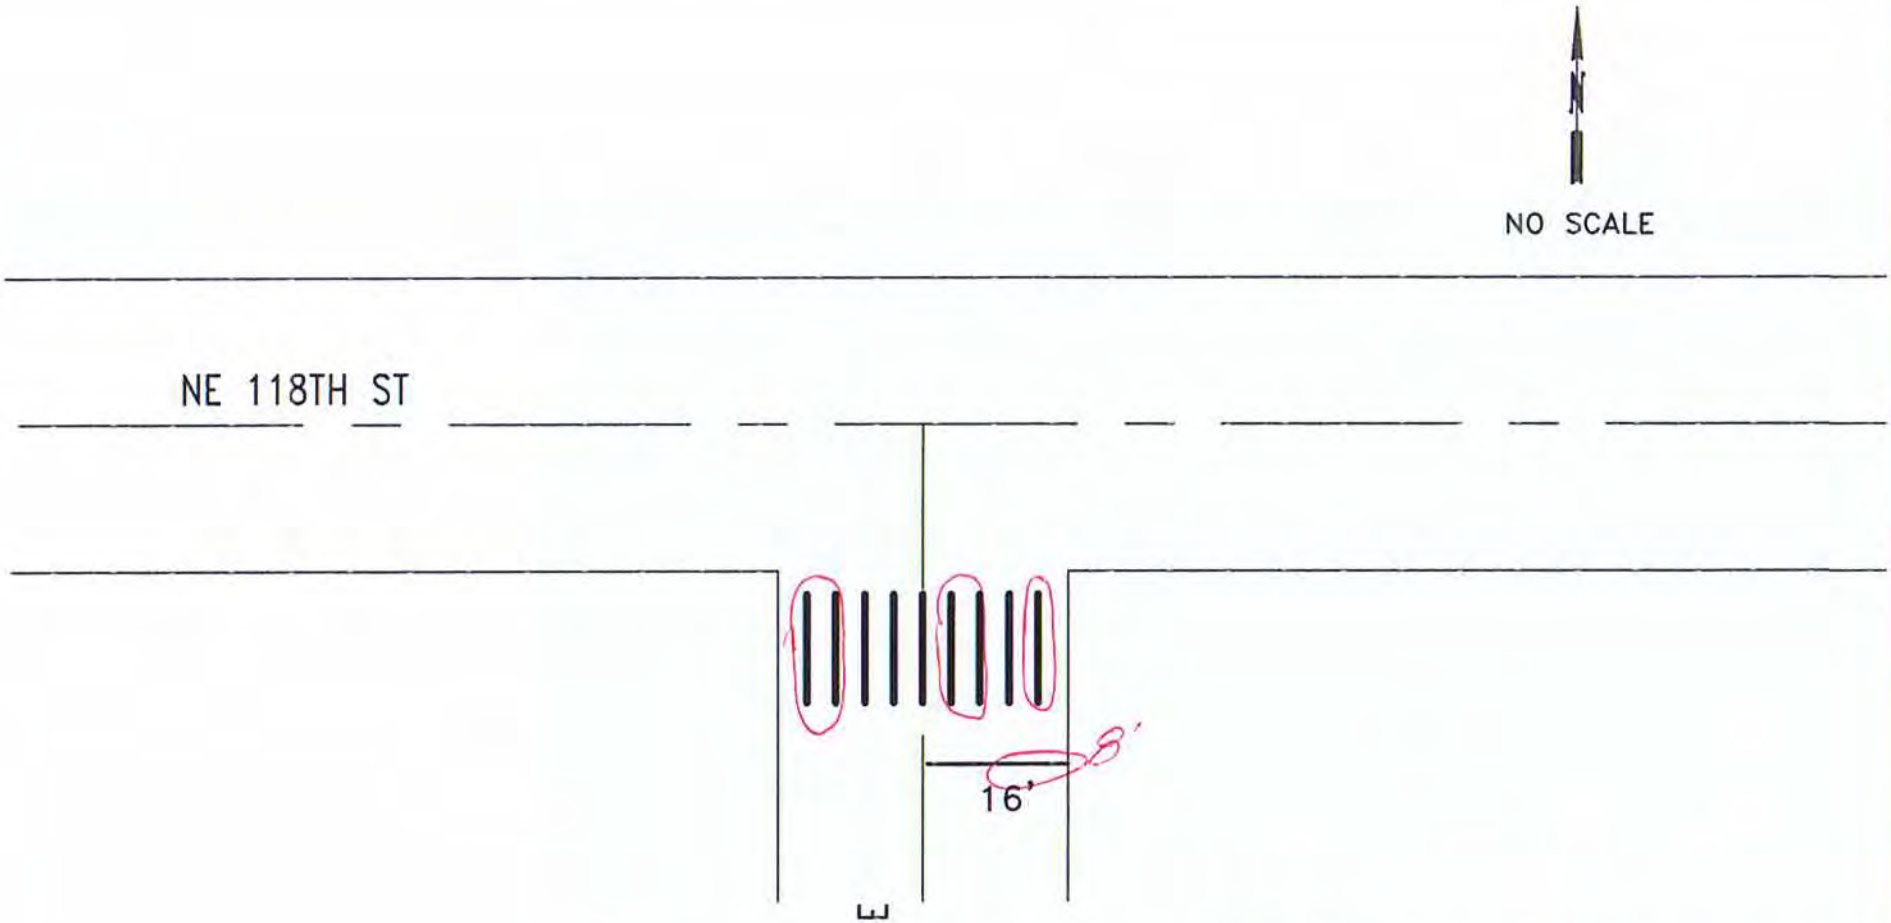

ESTIMATED QUANTITIES:

ITEM	ITEM DESCRIPTION	UNIT	INVENTORY	REPAIR QTY
PL18	PLASTIC STOP BAR, 18"	LF	16	8
PLXW	PLASTIC CROSSWALK STRIPE	SF	180	100
PLARW	PLASTIC TRAFFIC ARROW	EA		
PLLTR	PLASTIC TRAFFIC LETTER, 8 FT HIGH	EA		
PLRR	PLASTIC RAILROAD SYMBOL	EA		
RPLSYM	REMOVE PL. ARROW, LETTER, SYMBOL	EA		
RRPM	REMOVE RPM	EA		
RPLXW	REMOVE PLASTIC STRIPE	SF		60

CITY OF KIRKLAND
DEPARTMENT OF PUBLIC WORKS
123 FIFTH AVENUE KIRKLAND, WA 98033
(425) 587-3800 www.kirklandwa.gov

D.GRILLEY 1/2000
DESIGNED BY: DATE

J.JENNINGS 1/2000
DRAWN BY: DATE

CHECKED BY: DATE

2020 PAVEMENT MARKING PROGRAM

STREET: NE 118TH ST

CROSS STREET: 118TH AVE NE

SEGMENT:

SCALE: N.T.S.

FILENAME: Page 5-21

ESTIMATED QUANTITIES:

ITEM	ITEM DESCRIPTION	UNIT	INVENTORY	REPAIR QTY
PL18	PLASTIC STOP BAR, 18"	LF	48	12
PLXW	PLASTIC CROSSWALK STRIPE	SF	580	260
PLARW	PLASTIC TRAFFIC ARROW	EA	10	2
PLLTR	PLASTIC TRAFFIC LETTER, 8 FT HIGH	EA		
PLRR	PLASTIC RAILROAD SYMBOL	EA		
RPLSYM	REMOVE PL. ARROW, LETTER, SYMBOL	EA		
RRPM	REMOVE RPM	EA		
RPLXW	REMOVE PLASTIC STRIPE	SF		100

CITY OF KIRKLAND
DEPARTMENT OF PUBLIC WORKS
123 FIFTH AVENUE KIRKLAND, WA 98033
(425) 587-3800 www.kirklandwa.gov

G. HORTILLOSA 10/2011
DESIGNED BY: DATE

J.JENNINGS 10/2011
DRAWN BY: DATE

CHECKED BY: DATE

2020 PAVEMENT MARKING PROGRAM

STREET: NE 124TH ST

CROSS STREET: 107TH TO 113TH AVES NE

SEGMENT:

SCALE: N.T.S.

FILENAME: Page 5-22

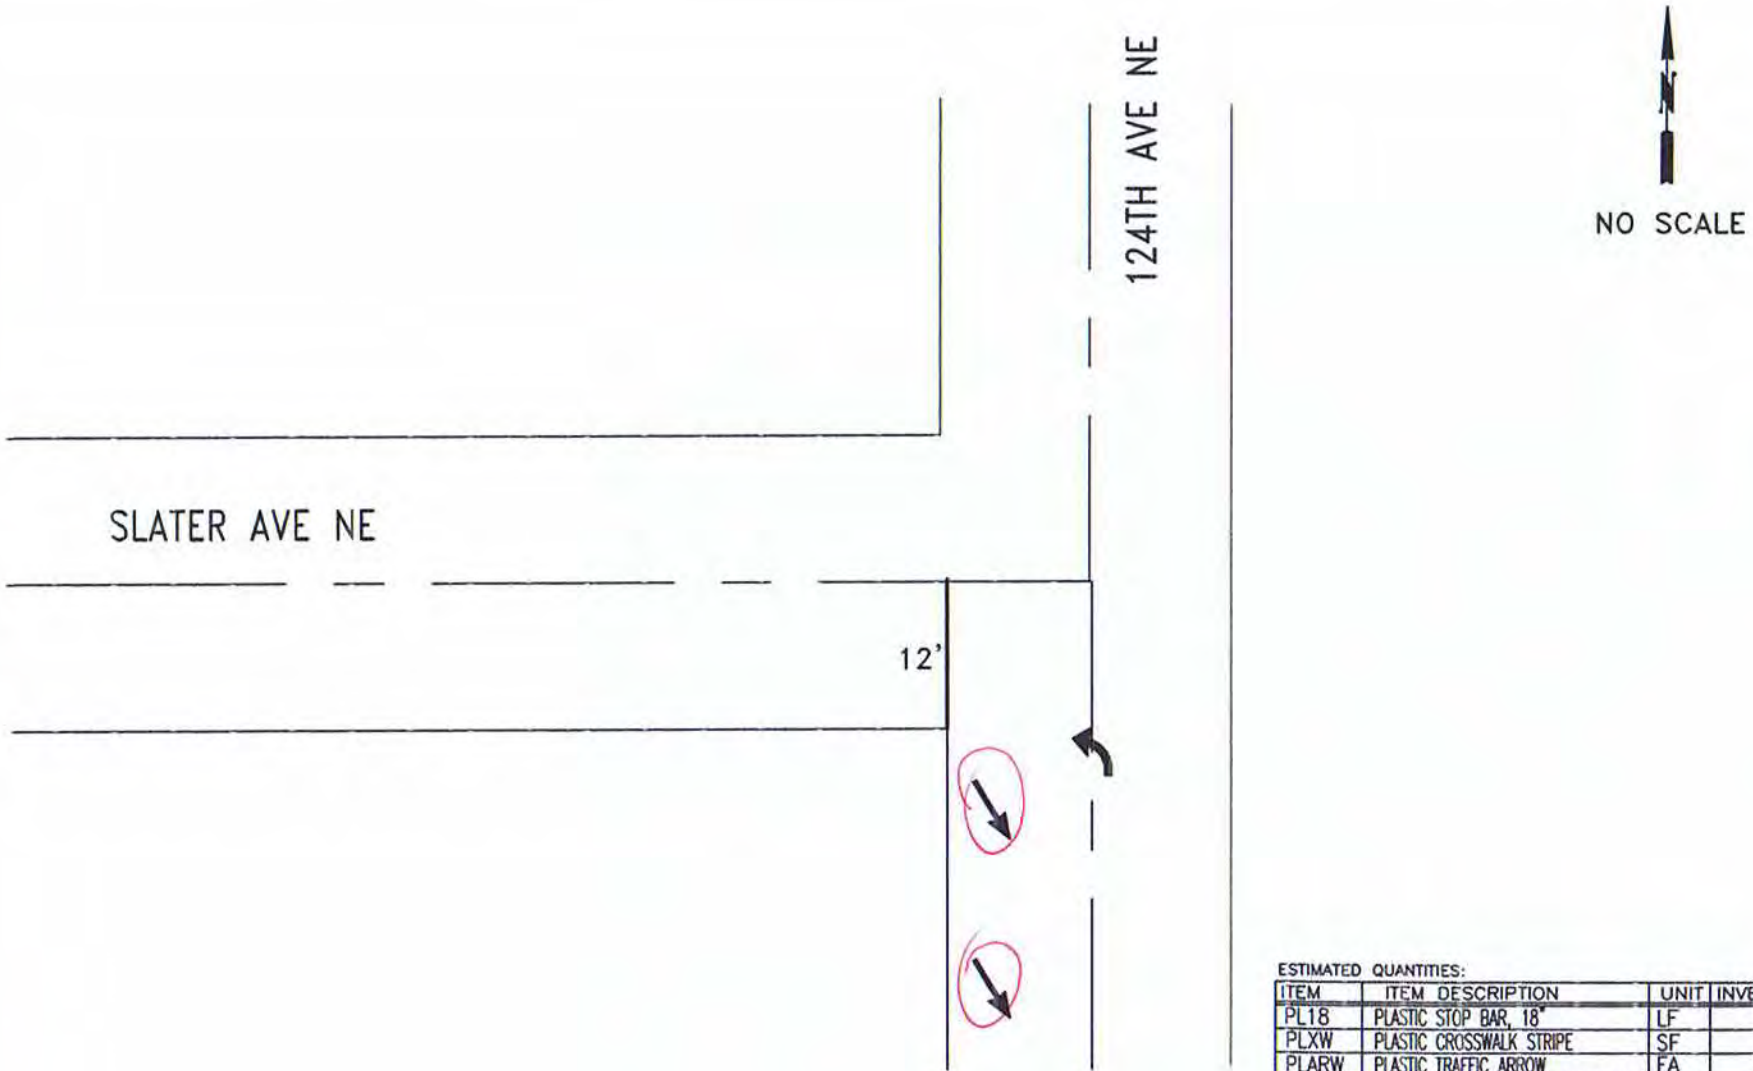

ESTIMATED QUANTITIES:

ITEM	ITEM DESCRIPTION	UNIT	INVENTORY	REPAIR QTY
PL18	PLASTIC STOP BAR, 18"	LF	12'	
PLXW	PLASTIC CROSSWALK STRIPE	SF		
PLARW	PLASTIC TRAFFIC ARROW	EA	3	2
PLLTR	PLASTIC TRAFFIC LETTER, 8 FT HIGH	EA		
PLRR	PLASTIC RAILROAD SYMBOL	EA		
RPLSYM	REMOVE PL. ARROW, LETTER, SYMBOL	EA		
RRPM	REMOVE RPM	EA		
RPLXW	REMOVE PLASTIC STRIPE	SF		

CITY OF KIRKLAND
DEPARTMENT OF PUBLIC WORKS
123 FIFTH AVENUE KIRKLAND, WA 98033
(425) 587-3800 www.kirklandwa.gov

G. HORTILLOSA 2/2011
DESIGNED BY: DATE

J.JENNINGS 1/2000
DRAWN BY: DATE

CHECKED BY: DATE

2022 PAVEMENT MARKING PROGRAM

STREET: SLATER AVE NE

CROSS STREET: 124TH AVE NE

SEGMENT:

SCALE: N.T.S.

FILENAME: Page 5-23

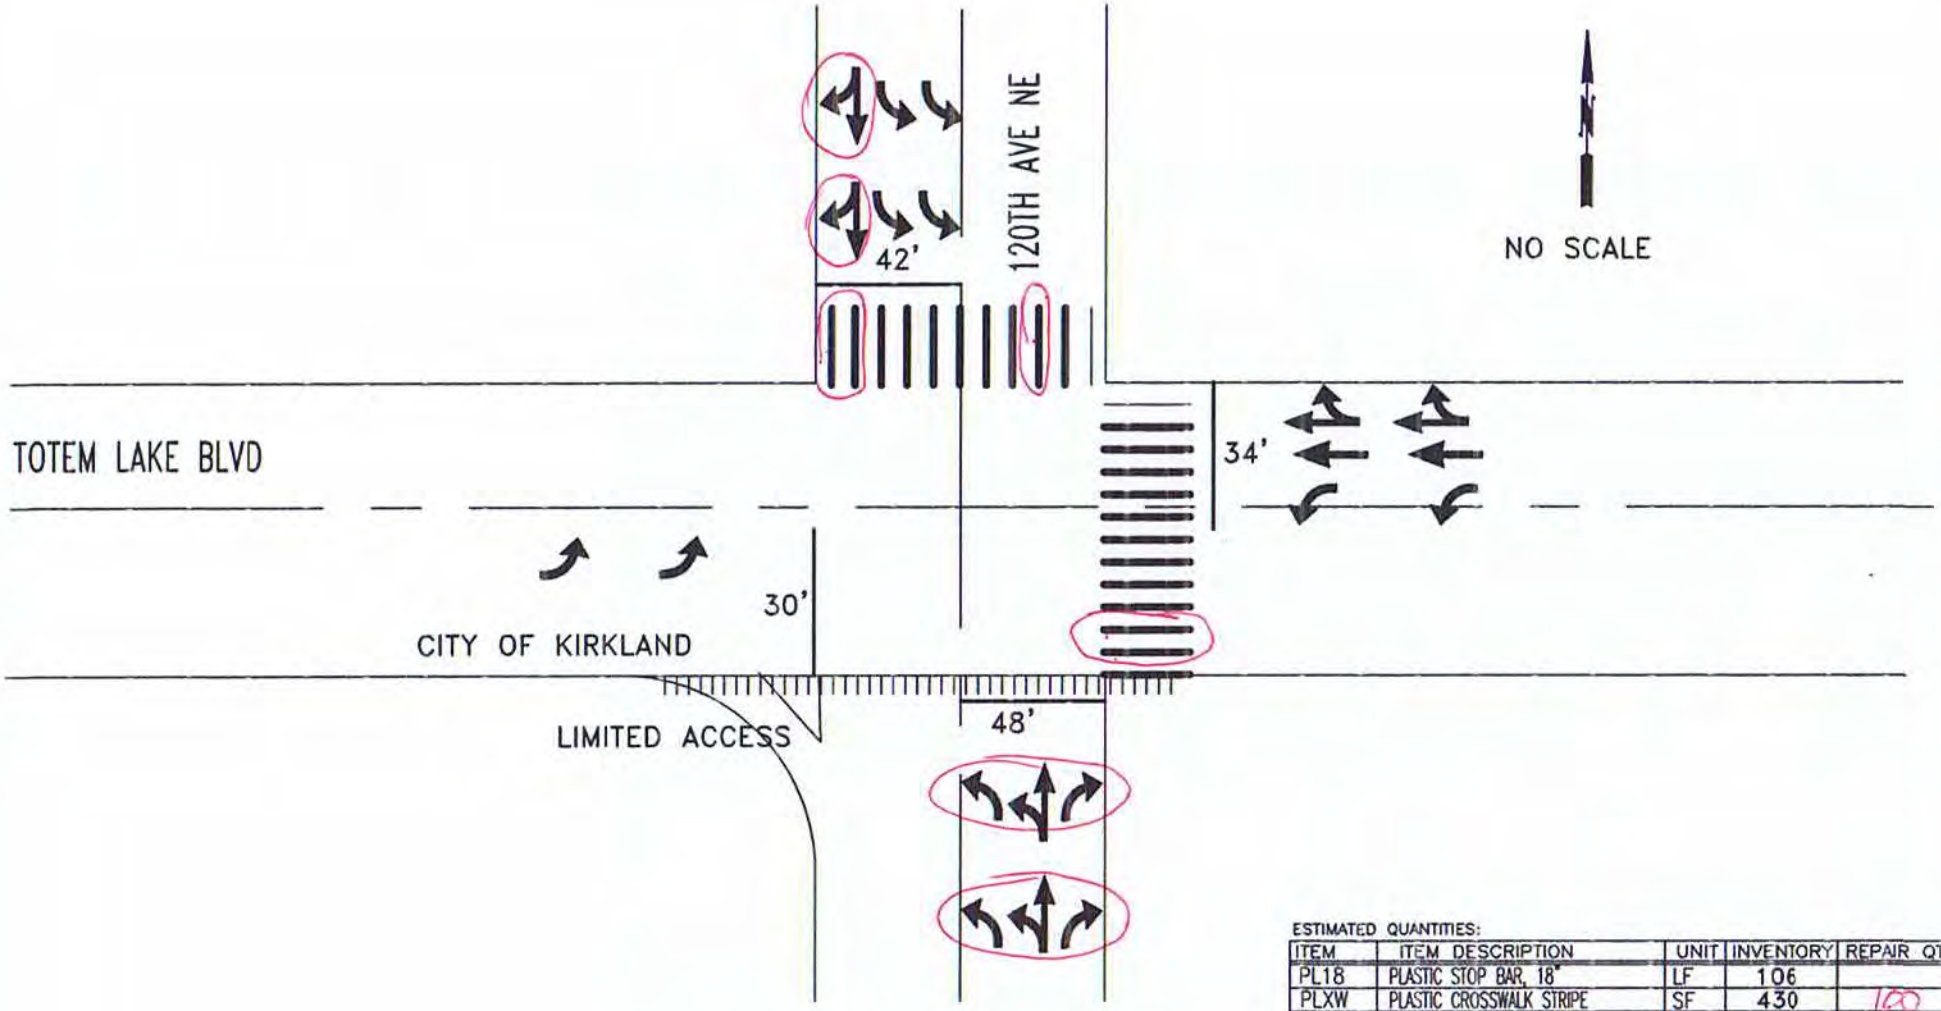

ESTIMATED QUANTITIES:

ITEM	ITEM DESCRIPTION	UNIT	INVENTORY	REPAIR QTY
PL18	PLASTIC STOP BAR, 18"	LF	106	
PLXW	PLASTIC CROSSWALK STRIPE	SF	430	100
PLARW	PLASTIC TRAFFIC ARROW	EA	14	8
PLLTR	PLASTIC TRAFFIC LETTER, 8 FT HIGH	EA		
PLRR	PLASTIC RAILROAD SYMBOL	EA		
RPLSYM	REMOVE PL. ARROW, LETTER, SYMBOL	EA		2
RRPM	REMOVE RPM	EA		
RPLXW	REMOVE PLASTIC STRIPE	SF		

CITY OF KIRKLAND
DEPARTMENT OF PUBLIC WORKS
123 FIFTH AVENUE KIRKLAND, WA 98033
(425) 587-3800 www.kirklandwa.gov

G. HORTILLOSA 11/2008
DESIGNED BY: DATE

J.JENNINGS 11/2009
DRAWN BY: DATE

CHECKED BY: DATE

2022 PAVEMENT MARKING PROGRAM

STREET: TOTEM LAKE BLVD

CROSS STREET: 120TH AVE NE

SEGMENT:

SCALE: N.T.S.

FILENAME: Page 5-24

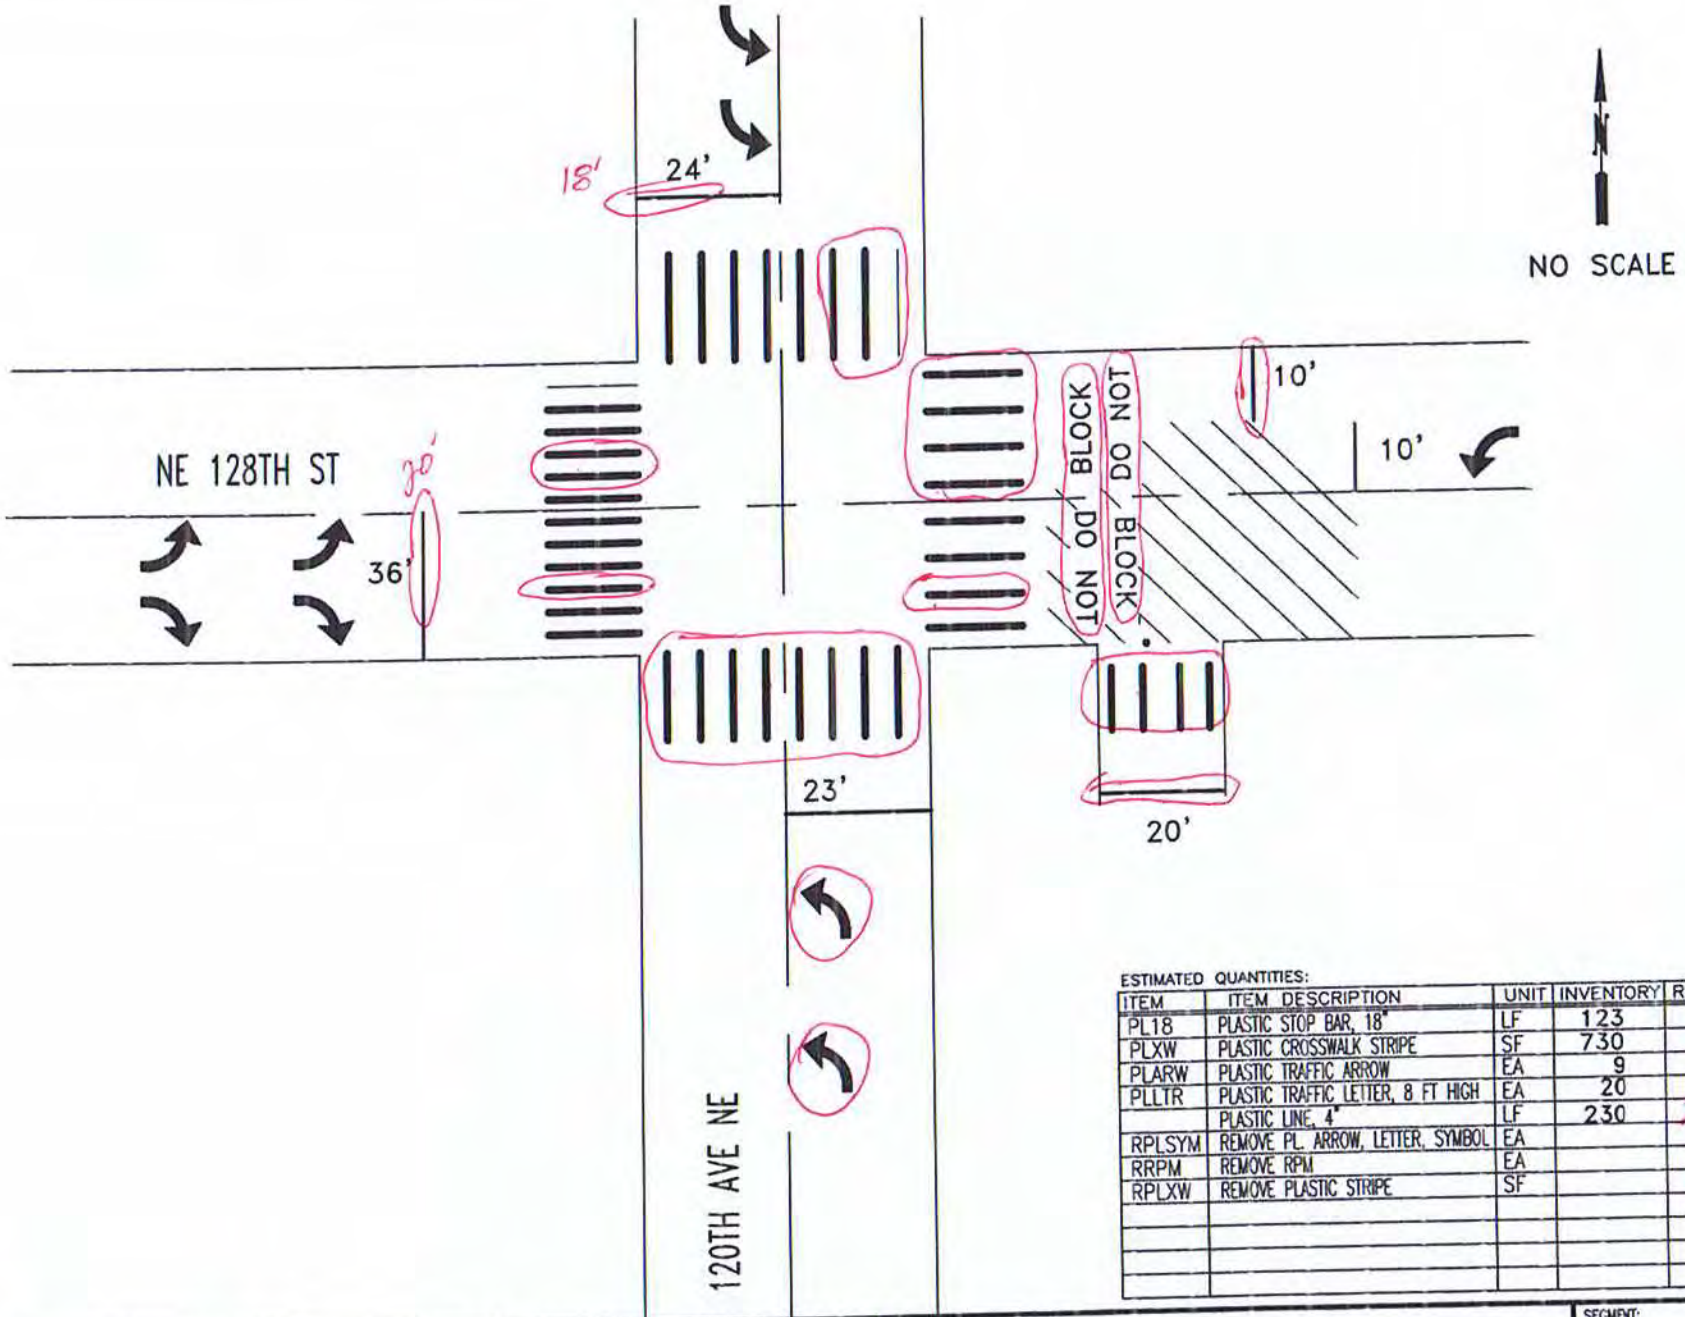

ESTIMATED QUANTITIES:

ITEM	ITEM DESCRIPTION	UNIT	INVENTORY	REPAIR QTY
PL18	PLASTIC STOP BAR, 18"	LF	123	91
PLXW	PLASTIC CROSSWALK STRIPE	SF	730	430
PLARW	PLASTIC TRAFFIC ARROW	EA	9	3
PLLTR	PLASTIC TRAFFIC LETTER, 8 FT HIGH	EA	20	30
	PLASTIC LINE, 4"	LF	230	230
RPLSYM	REMOVE PL. ARROW, LETTER, SYMBOL	EA		
RRPM	REMOVE RPM	EA		
RPLXW	REMOVE PLASTIC STRIPE	SF		180

CITY OF KIRKLAND
DEPARTMENT OF PUBLIC WORKS
123 FIFTH AVENUE KIRKLAND, WA 98033
(425) 587-3800 www.kirklandwa.gov

L KAWAOKA 3/2016
DESIGNED BY: DATE

J.JENNINGS 3/2016
DRAWN BY: DATE

CHECKED BY: DATE

2020 PAVEMENT MARKING PROGRAM

STREET: 120TH AVE NE

CROSS STREET: NE 128TH ST

SEGMENT:

SCALE: N.T.S.

FILENAME: Page 5-27

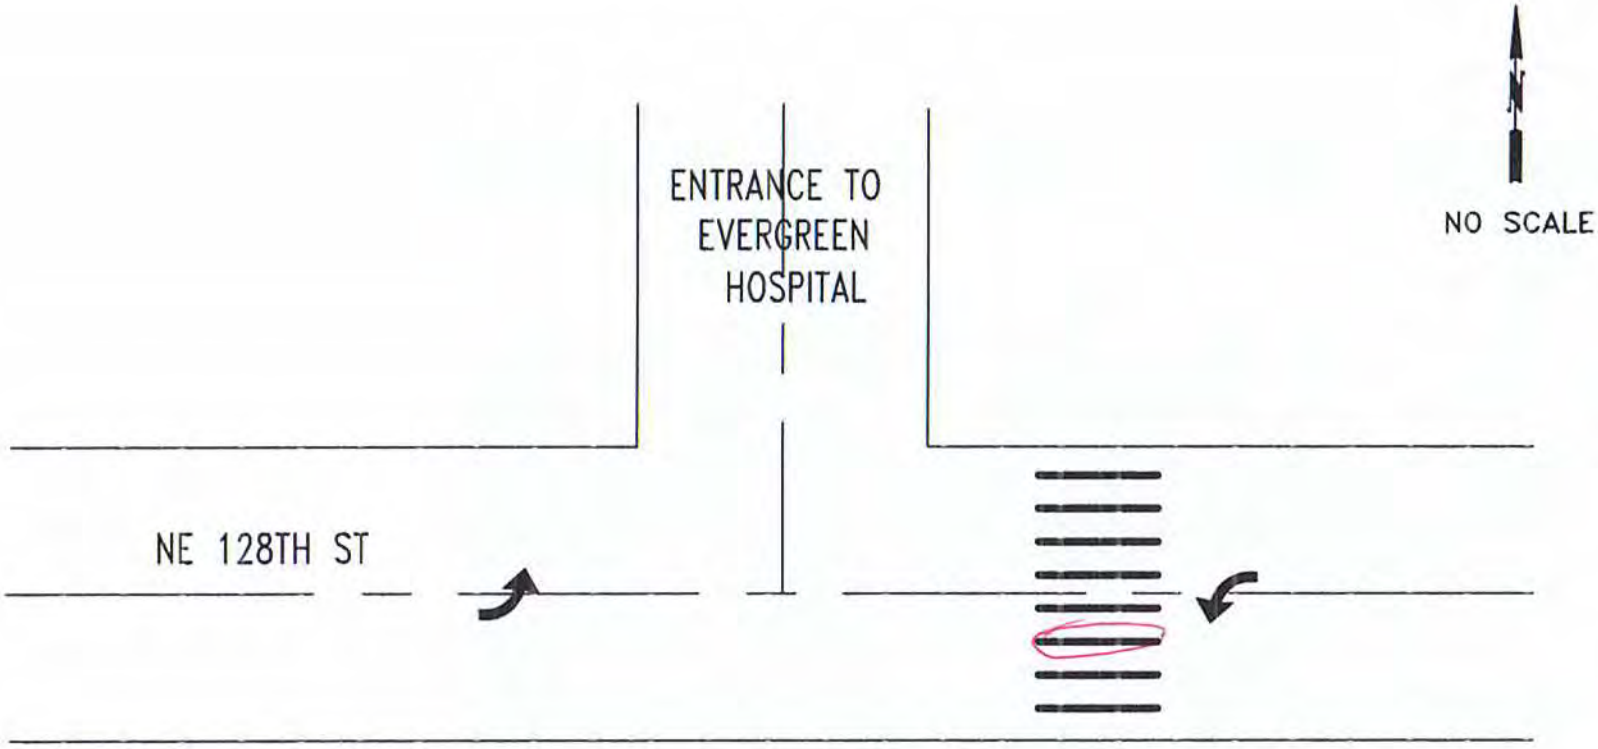

ESTIMATED QUANTITIES:

ITEM	ITEM DESCRIPTION	UNIT	INVENTORY	REPAIR QTY
PL18	PLASTIC STOP BAR, 18"	LF		
PLXW	PLASTIC CROSSWALK STRIPE	SF	160	30
PLARW	PLASTIC TRAFFIC ARROW	EA	2	
PLLTR	PLASTIC TRAFFIC LETTER, 8 FT HIGH	EA		
PLRR	PLASTIC RAILROAD SYMBOL	EA		
RPLSYM	REMOVE PL. ARROW, LETTER, SYMBOL	EA		
RRPM	REMOVE RPM	EA		
RPLXW	REMOVE PLASTIC STRIPE	SF		

CITY OF KIRKLAND
DEPARTMENT OF PUBLIC WORKS
123 FIFTH AVENUE KIRKLAND, WA 98033
(425) 587-3800 www.kirklandwa.gov

G. HORTILLOSA 3/2009
DESIGNED BY: DATE

J.JENNINGS 3/2009
DRAWN BY: DATE

CHECKED BY: DATE

2022 PAVEMENT MARKING PROGRAM

STREET: NE 128TH ST

CROSS STREET: EVERGREEN HOSPITAL ENTRANCE

SEGMENT:

SCALE: N.T.S.

FILENAME:

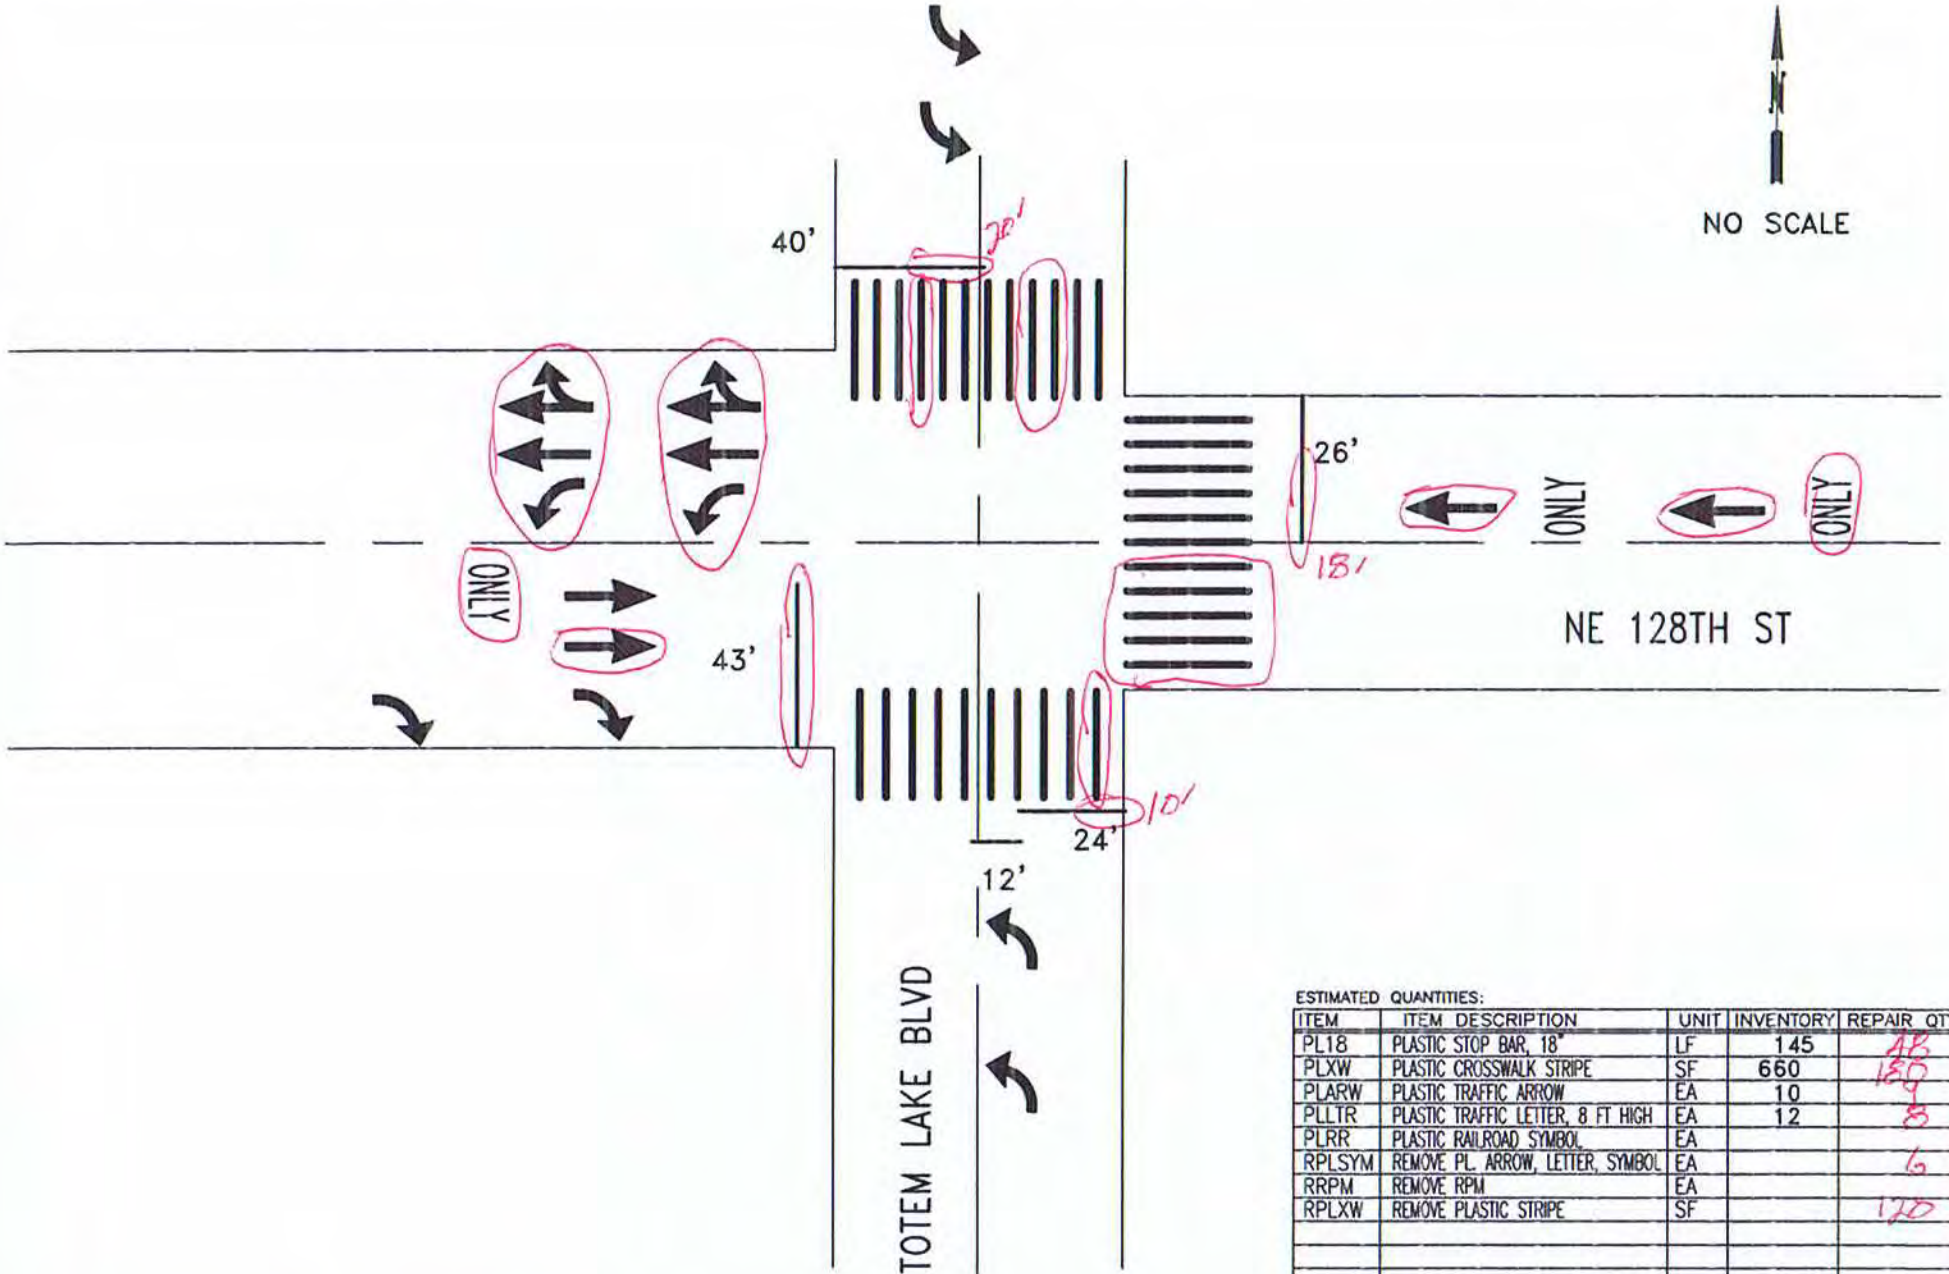

ESTIMATED QUANTITIES:

ITEM	ITEM DESCRIPTION	UNIT	INVENTORY	REPAIR QTY
PL18	PLASTIC STOP BAR, 18"	LF	145	48
PLXW	PLASTIC CROSSWALK STRIPE	SF	660	189
PLARW	PLASTIC TRAFFIC ARROW	EA	10	8
PLLTR	PLASTIC TRAFFIC LETTER, 8 FT HIGH	EA	12	8
PLRR	PLASTIC RAILROAD SYMBOL	EA		
RPLSYM	REMOVE PL. ARROW, LETTER, SYMBOL	EA		6
RRPM	REMOVE RPM	EA		
RPLXW	REMOVE PLASTIC STRIPE	SF		120

CITY OF KIRKLAND
DEPARTMENT OF PUBLIC WORKS
123 FIFTH AVENUE KIRKLAND, WA 98033
(425) 587-3800 www.kirklandwa.gov

G. HORTILLOSA 3/2009
DESIGNED BY: DATE

J.JENNINGS 3/2009
DRAWN BY: DATE

CHECKED BY: DATE

2022 PAVEMENT MARKING PROGRAM

STREET: TOTEM LAKE BLVD

CROSS STREET: NE 128TH ST

SEGMENT:

SCALE: N.T.S.

FILENAME:

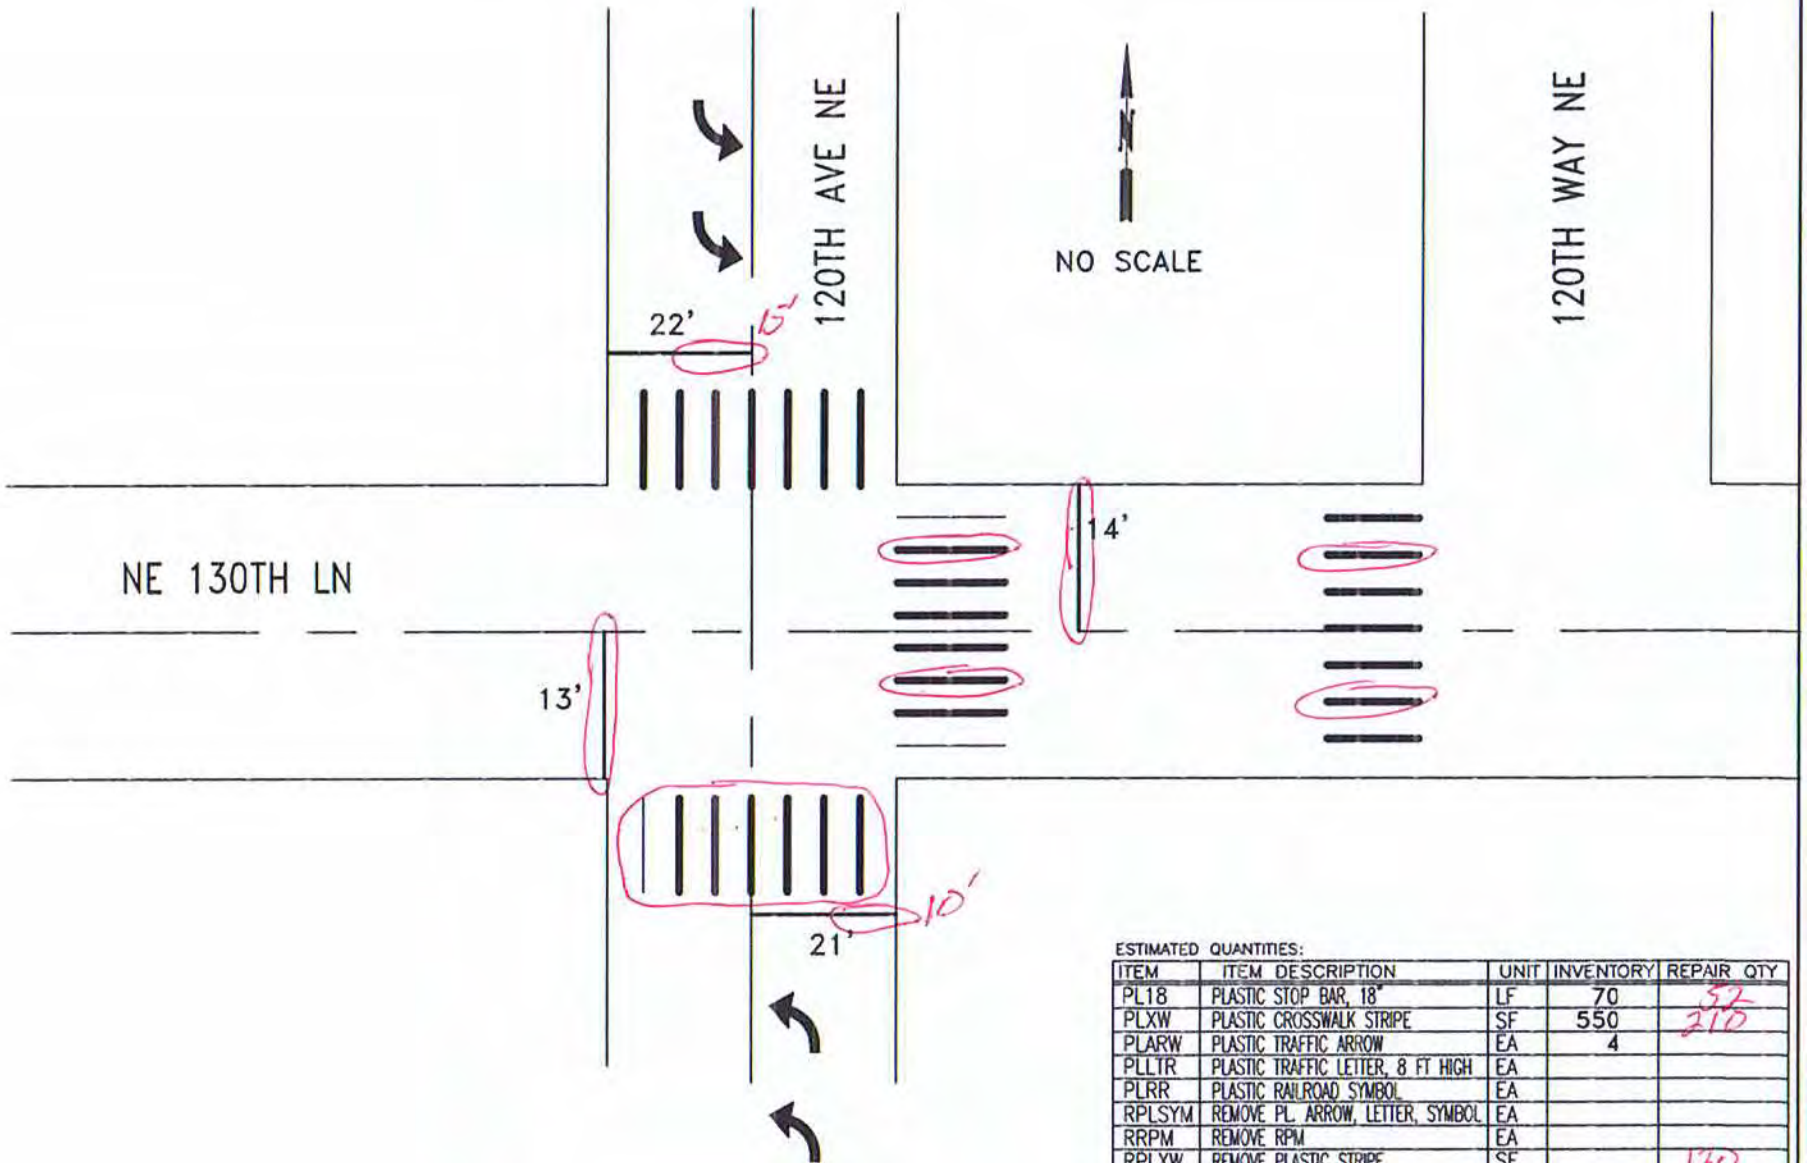

ESTIMATED QUANTITIES:

ITEM	ITEM DESCRIPTION	UNIT	INVENTORY	REPAIR QTY
PL18	PLASTIC STOP BAR, 18"	LF	70	52
PLXW	PLASTIC CROSSWALK STRIPE	SF	550	210
PLARW	PLASTIC TRAFFIC ARROW	EA	4	
PLLTR	PLASTIC TRAFFIC LETTER, 8 FT HIGH	EA		
PLRR	PLASTIC RAILROAD SYMBOL	EA		
RPLSYM	REMOVE PL. ARROW, LETTER, SYMBOL	EA		
RRPM	REMOVE RPM	EA		
RPLXW	REMOVE PLASTIC STRIPE	SF		130

CITY OF KIRKLAND
DEPARTMENT OF PUBLIC WORKS
123 FIFTH AVENUE KIRKLAND, WA 98033
(425) 587-3800 www.kirklandwa.gov

G. HORTILLOSA 2/2013
DESIGNED BY: DATE

J.JENNINGS 2/2011
DRAWN BY: DATE

CHECKED BY: DATE

20__ PAVEMENT MARKING PROGRAM

STREET: 120TH AVE NE

CROSS STREET: NE 130TH LN

SEGMENT:

SCALE: N.T.S.

FILENAME:

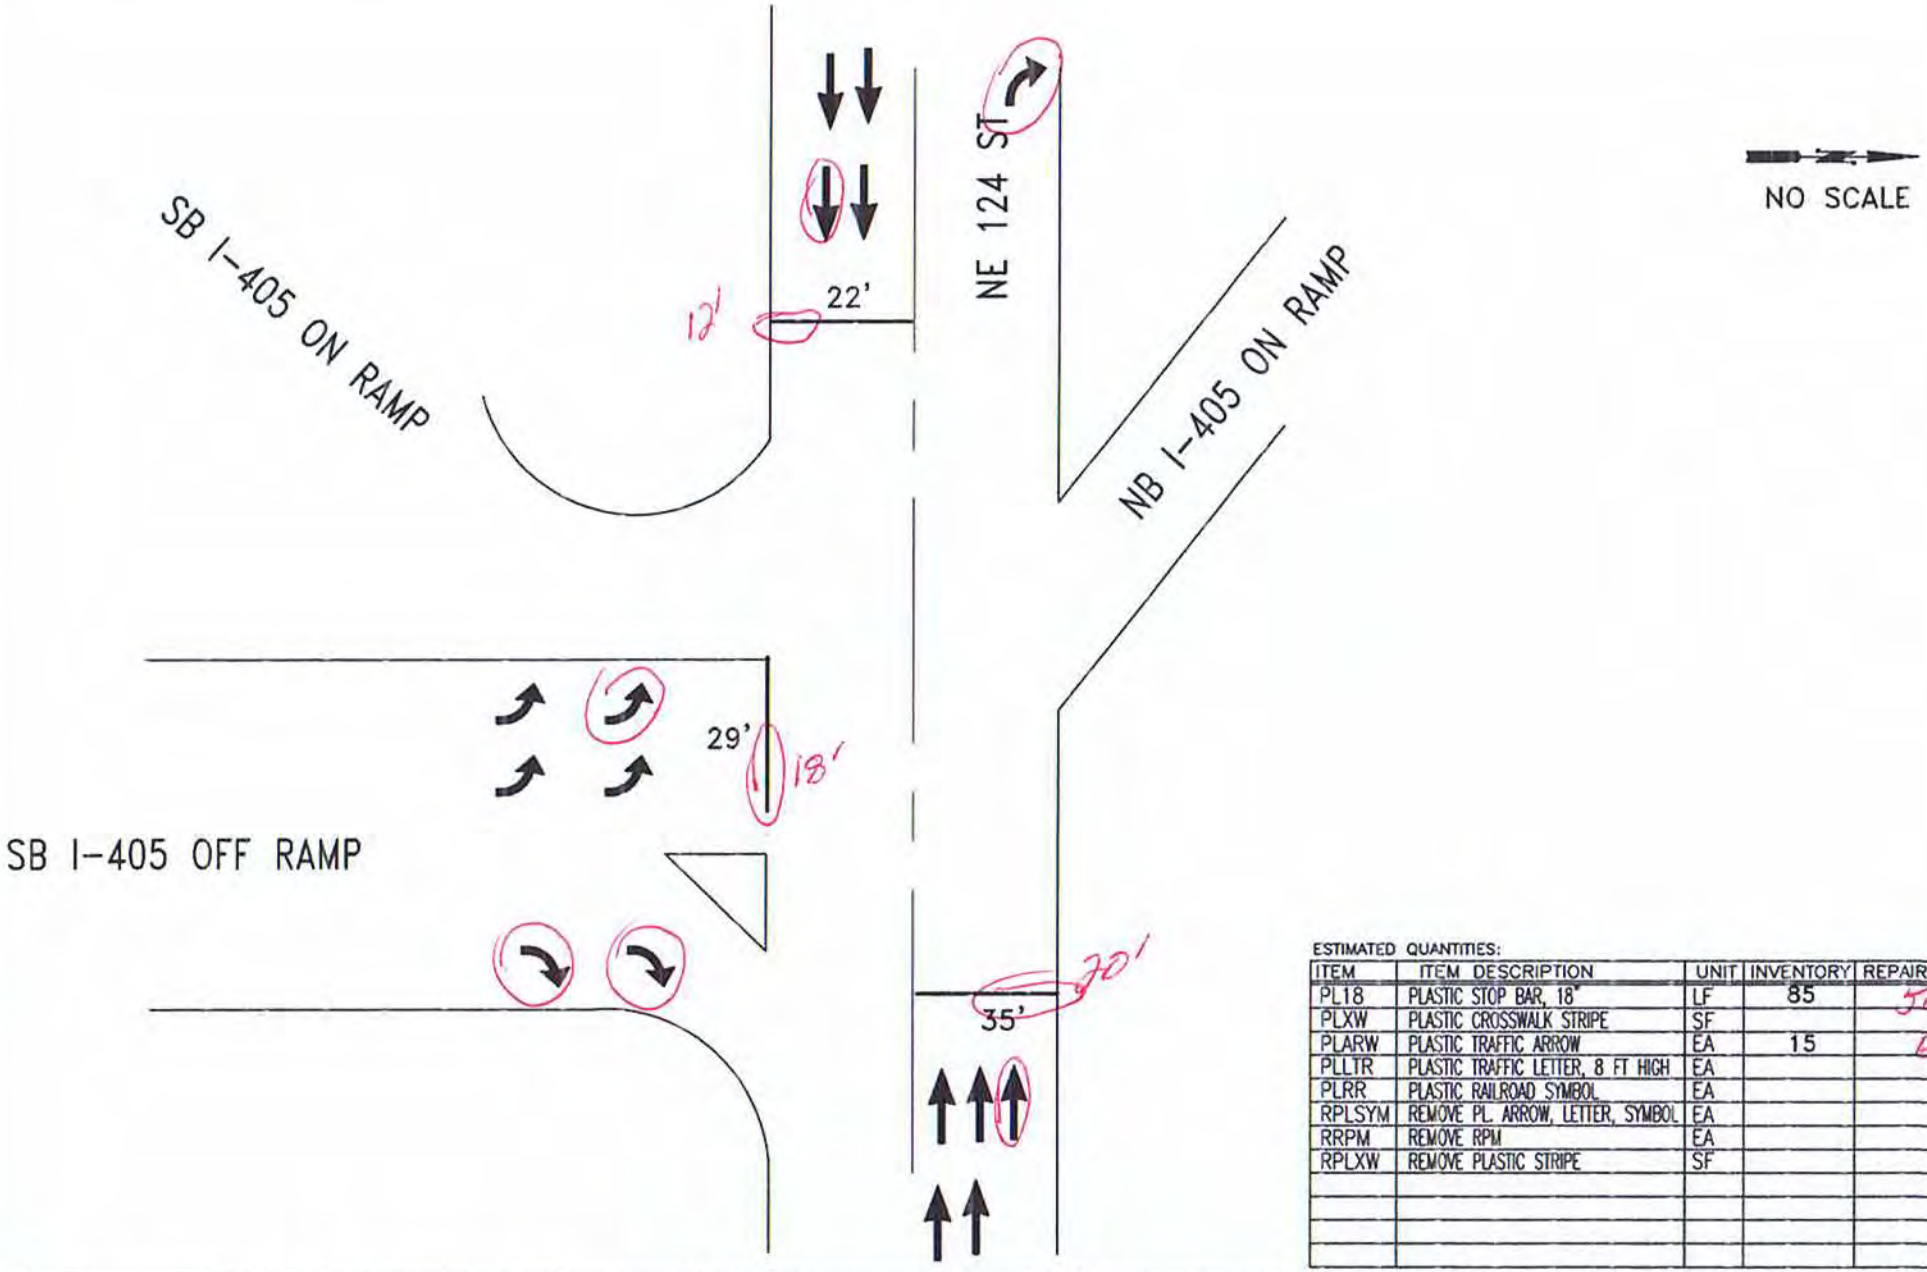

ESTIMATED QUANTITIES:

ITEM	ITEM DESCRIPTION	UNIT	INVENTORY	REPAIR QTY
PL18	PLASTIC STOP BAR, 18"	LF	85	50
PLXW	PLASTIC CROSSWALK STRIPE	SF		
PLARW	PLASTIC TRAFFIC ARROW	EA	15	6
PLLTR	PLASTIC TRAFFIC LETTER, 8 FT HIGH	EA		
PLRR	PLASTIC RAILROAD SYMBOL	EA		
RPLSYM	REMOVE PL. ARROW, LETTER, SYMBOL	EA		
RRPM	REMOVE RPM	EA		
RPLXW	REMOVE PLASTIC STRIPE	SF		

CITY OF KIRKLAND
DEPARTMENT OF PUBLIC WORKS
123 FIFTH AVENUE KIRKLAND, WA 98033
(425) 587-3800 www.kirklandwa.gov

G. HORTILLOSA 2/2011
DESIGNED BY: DATE

J.JENNINGS 2/2011
DRAWN BY: DATE

CHECKED BY: DATE

2020 PAVEMENT MARKING PROGRAM

STREET: NE 124 ST

CROSS STREET: I-405 EAST OF FREEWAY

SEGMENT:

SCALE: N.T.S.

FILENAME: Page 5-35

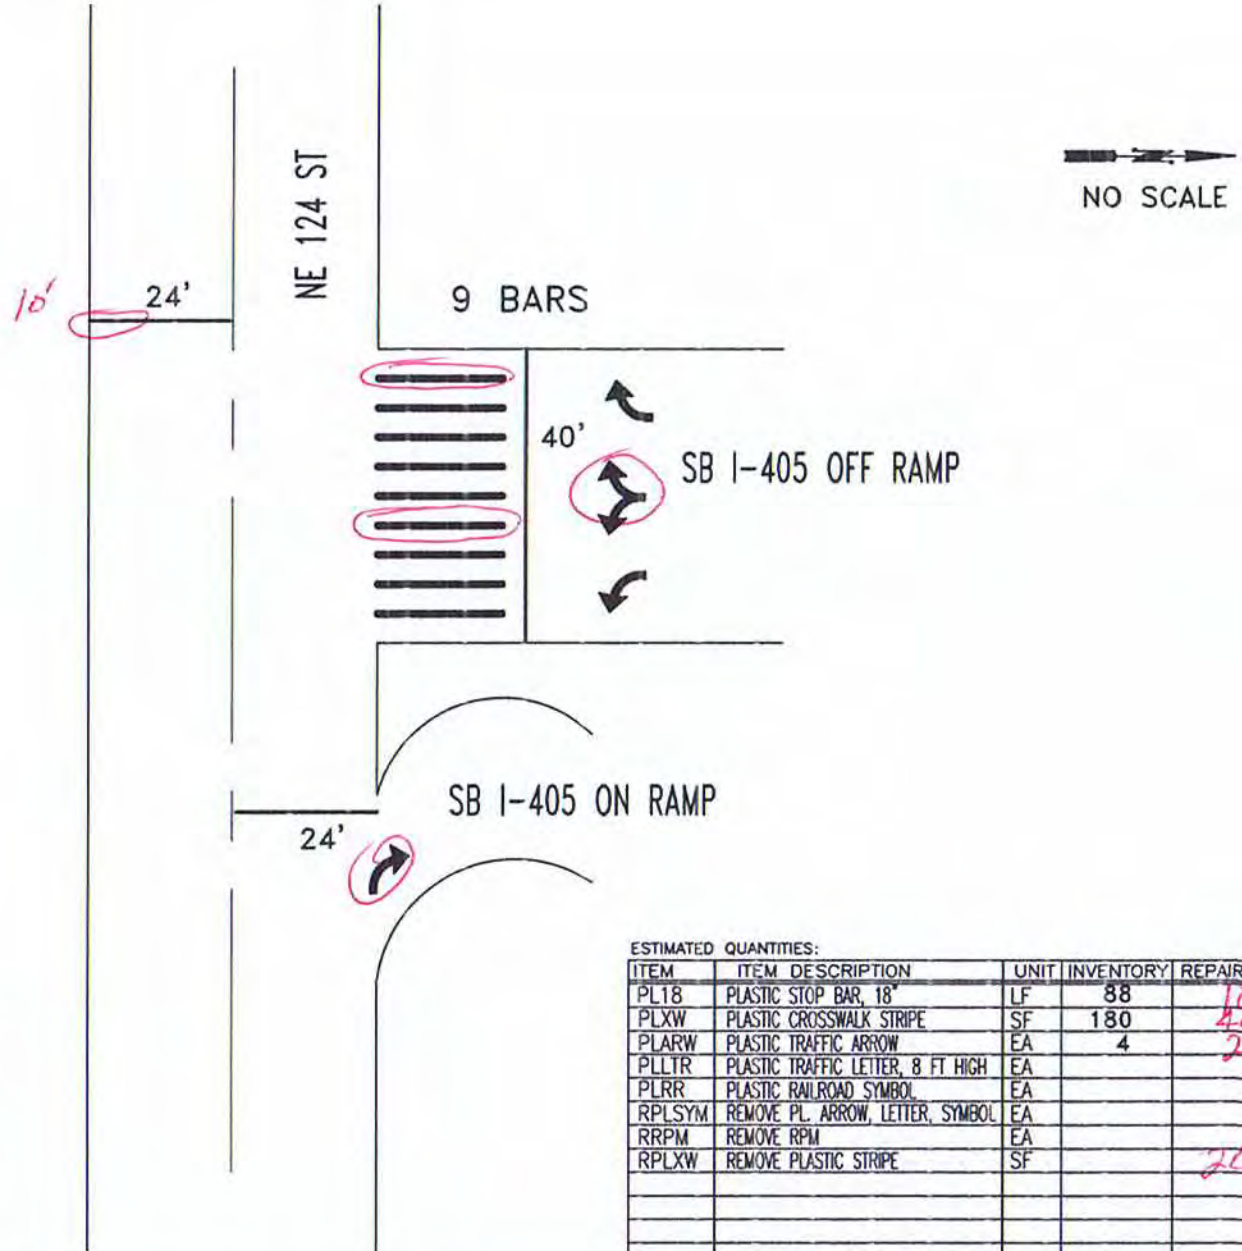

ESTIMATED QUANTITIES:

ITEM	ITEM DESCRIPTION	UNIT	INVENTORY	REPAIR QTY
PL18	PLASTIC STOP BAR, 18"	LF	88	10
PLXW	PLASTIC CROSSWALK STRIPE	SF	180	40
PLARW	PLASTIC TRAFFIC ARROW	EA	4	2
PLLTR	PLASTIC TRAFFIC LETTER, 8 FT HIGH	EA		
PLRR	PLASTIC RAILROAD SYMBOL	EA		
RPLSYM	REMOVE PL. ARROW, LETTER, SYMBOL	EA		
RRPM	REMOVE RPM	EA		
RPLXW	REMOVE PLASTIC STRIPE	SF		20

CITY OF KIRKLAND
DEPARTMENT OF PUBLIC WORKS
123 FIFTH AVENUE KIRKLAND, WA 98033
(425) 587-3800 www.kirklandwa.gov

R. STEITZER 2/2005
DESIGNED BY: DATE

J.JENNINGS 2/2005
DRAWN BY: DATE

CHECKED BY: DATE

20__ PAVEMENT MARKING PROGRAM

STREET: NE 124 ST

CROSS STREET: I-405 WEST OF FREEWAY

SEGMENT:

SCALE: N.T.S.

FILENAME:

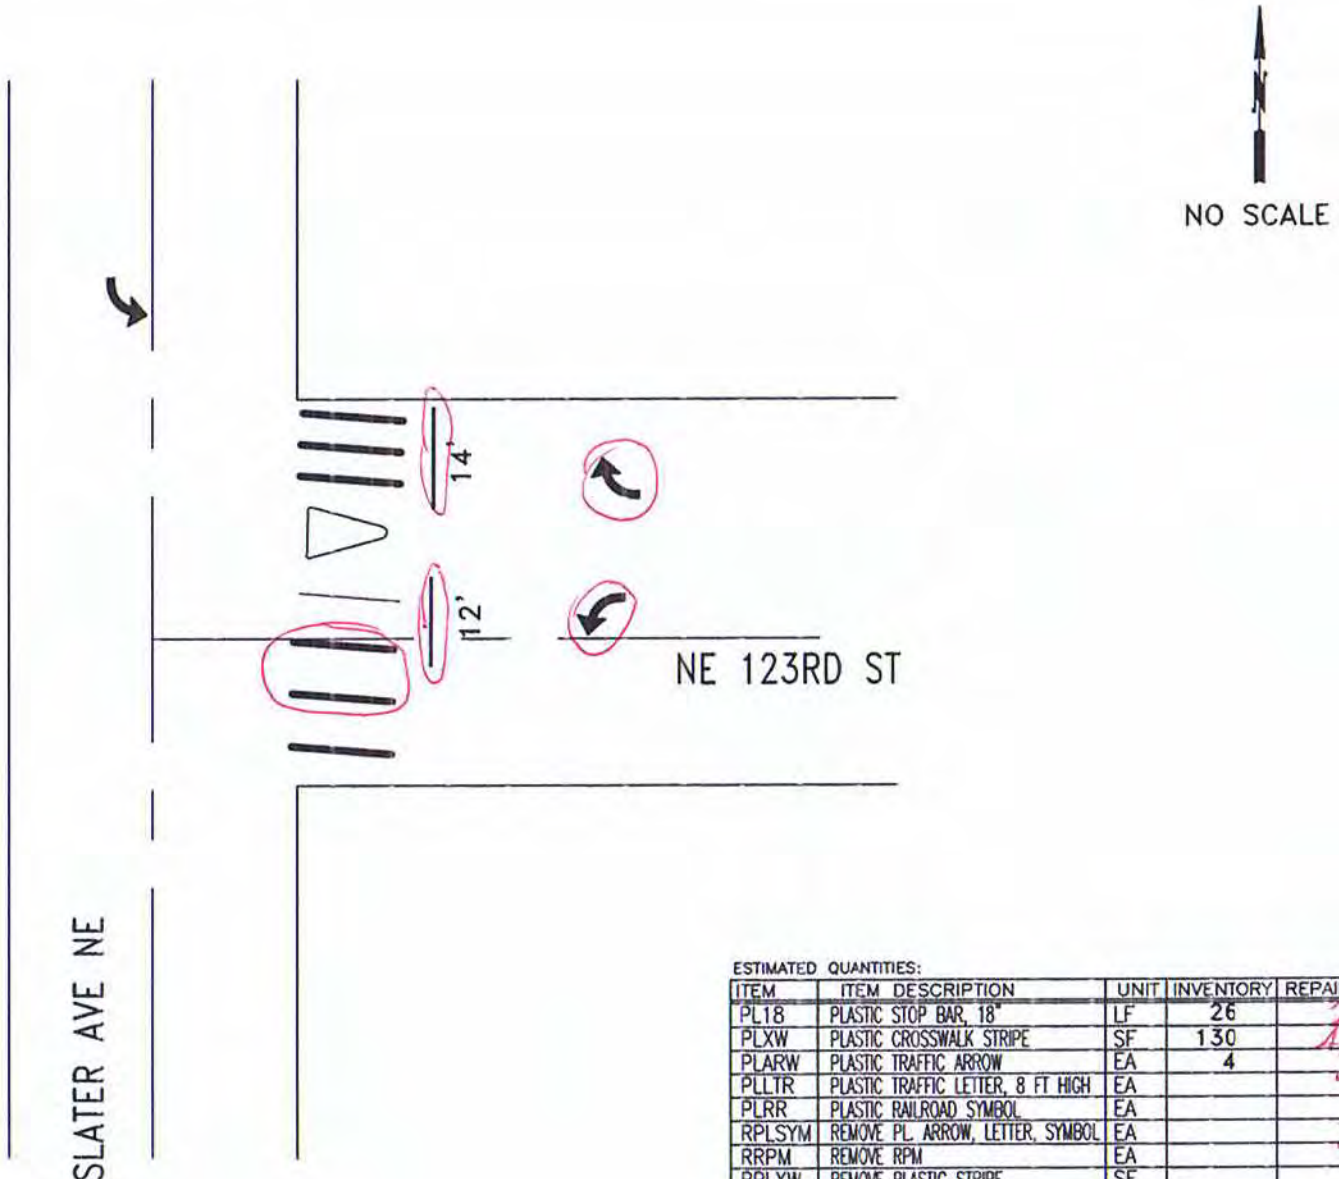

ESTIMATED QUANTITIES:

ITEM	ITEM DESCRIPTION	UNIT	INVENTORY	REPAIR QTY
PL18	PLASTIC STOP BAR, 18"	LF	26	25
PLXW	PLASTIC CROSSWALK STRIPE	SF	130	15
PLARW	PLASTIC TRAFFIC ARROW	EA	4	2
PLLTR	PLASTIC TRAFFIC LETTER, 8 FT HIGH	EA		
PLRR	PLASTIC RAILROAD SYMBOL	EA		
RPLSYM	REMOVE PL. ARROW, LETTER, SYMBOL	EA		2
RRPM	REMOVE RPM	EA		
RPLXW	REMOVE PLASTIC STRIPE	SF		

CITY OF KIRKLAND
DEPARTMENT OF PUBLIC WORKS
123 FIFTH AVENUE KIRKLAND, WA 98033
(425) 587-3800 www.kirklandwa.gov

F. LEE 4/2015
DESIGNED BY: DATE

J.JENNINGS 4/2015
DRAWN BY: DATE

CHECKED BY: DATE

2022 PAVEMENT MARKING PROGRAM

STREET: SLATER AVE NE

CROSS STREET: NE 123RD ST

SEGMENT:

SCALE: N.T.S.

FILENAME:

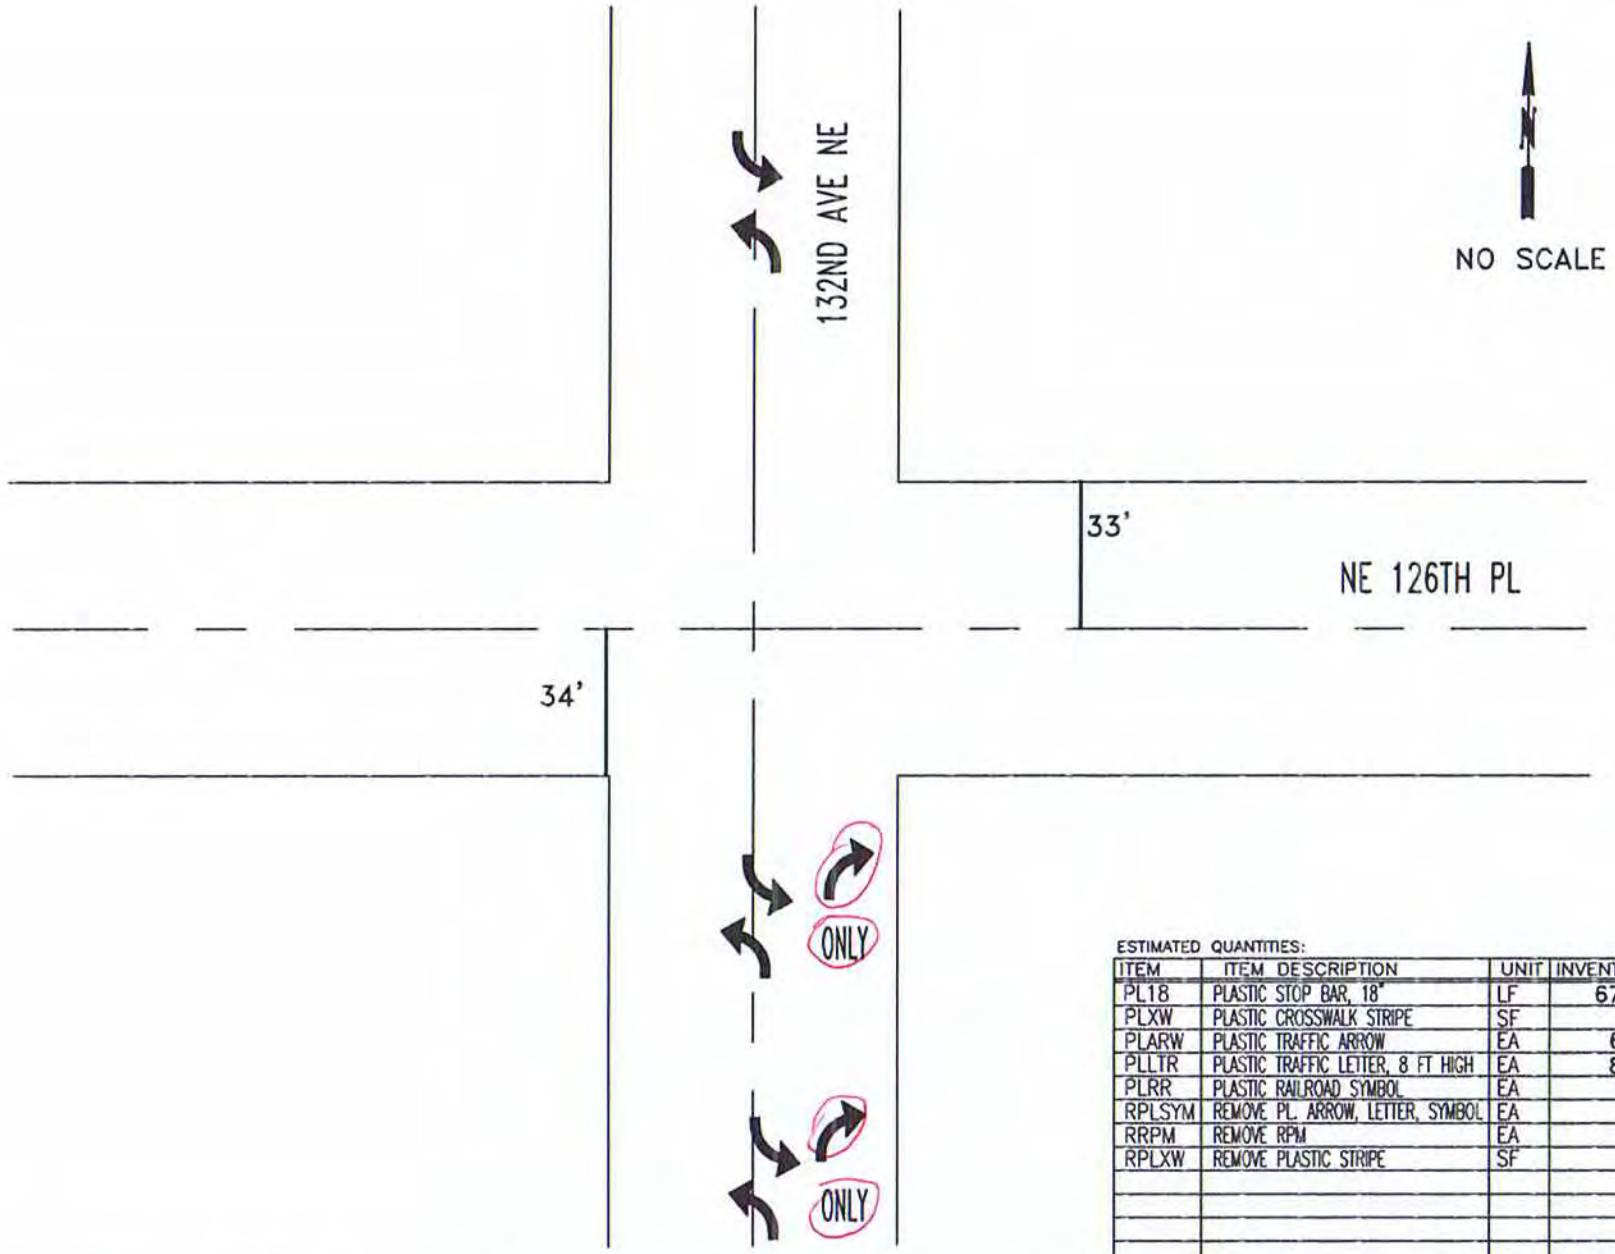

ESTIMATED QUANTITIES:

ITEM	ITEM DESCRIPTION	UNIT	INVENTORY	REPAIR QTY
PL18	PLASTIC STOP BAR, 18"	LF	67	
PLXW	PLASTIC CROSSWALK STRIPE	SF		
PLARW	PLASTIC TRAFFIC ARROW	EA	6	3
PLLTR	PLASTIC TRAFFIC LETTER, 8 FT HIGH	EA	8	3
PLRR	PLASTIC RAILROAD SYMBOL	EA		
RPLSYM	REMOVE PL. ARROW, LETTER, SYMBOL	EA		
RRPM	REMOVE RPM	EA		
RPLXW	REMOVE PLASTIC STRIPE	SF		

CITY OF KIRKLAND
DEPARTMENT OF PUBLIC WORKS
123 FIFTH AVENUE KIRKLAND, WA 98033
(425) 587-3800 www.kirklandwa.gov

F. LEE 4/2015
DESIGNED BY: DATE

J.JENNINGS 4/2015
DRAWN BY: DATE

CHECKED BY: DATE

2020 PAVEMENT MARKING PROGRAM

STREET: 132ND AVE NE

CROSS STREET: NE 126TH PL

SEGMENT:

SCALE: N.T.S.

FILENAME: Page 5-38

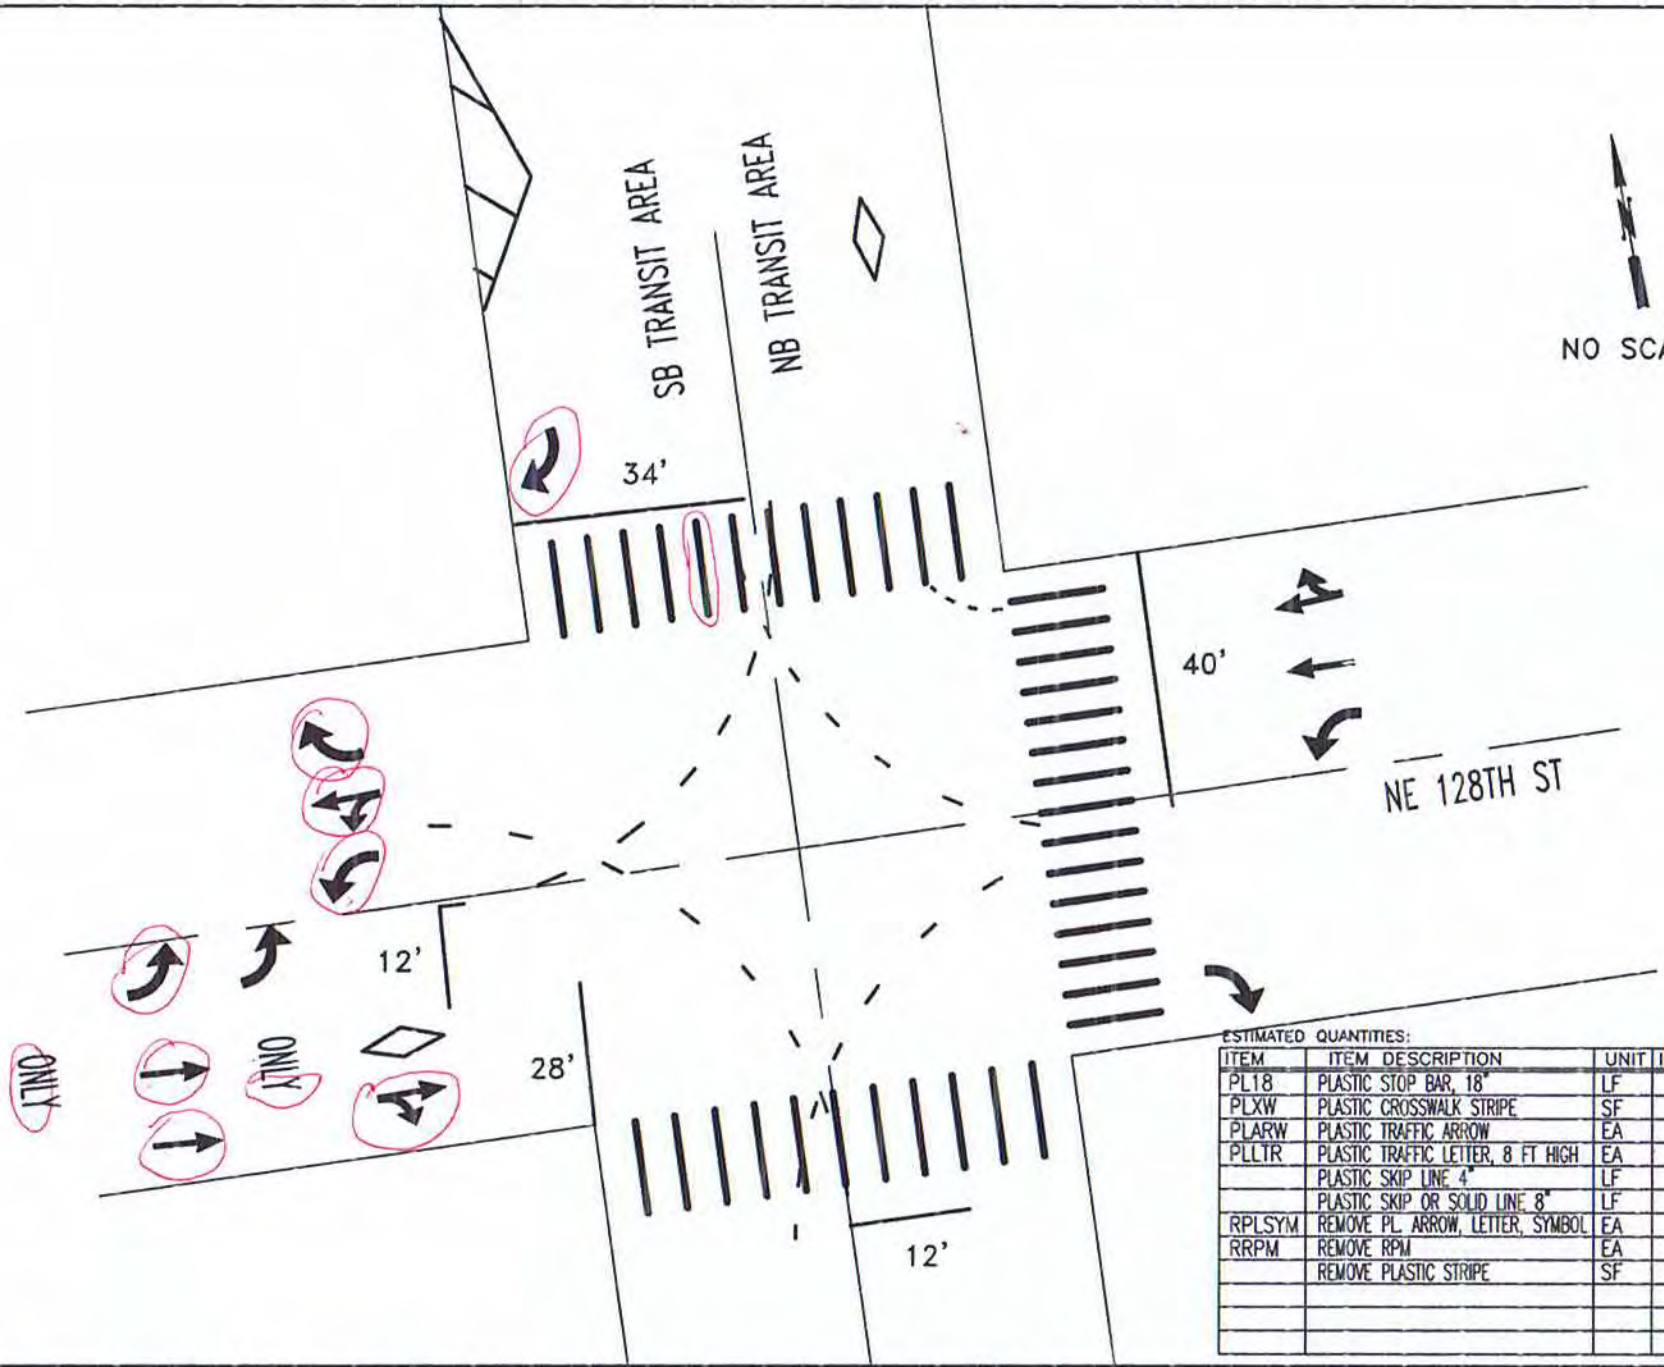

ESTIMATED QUANTITIES:

ITEM	ITEM DESCRIPTION	UNIT	INVENTORY	REPAIR QTY
PL18	PLASTIC STOP BAR, 18"	LF	126	
PLXW	PLASTIC CROSSWALK STRIPE	SF	760	
PLARW	PLASTIC TRAFFIC ARROW	EA	14	8
PLLTR	PLASTIC TRAFFIC LETTER, 8 FT HIGH	EA	8	8
	PLASTIC SKIP LINE 4"	LF	440	
	PLASTIC SKIP OR SOLID LINE 8"	LF	100	
RPLSYM	REMOVE PL. ARROW, LETTER, SYMBOL	EA		2
RRPM	REMOVE RPM	EA		
	REMOVE PLASTIC STRIPE	SF		

CITY OF KIRKLAND
DEPARTMENT OF PUBLIC WORKS
123 FIFTH AVENUE KIRKLAND, WA 98033
(425) 587-3800 www.kirklandwa.gov

L KAWOAKA 3/2016
DESIGNED BY: DATE

J.JENNINGS 3/2016
DRAWN BY: DATE

CHECKED BY: DATE

2022 PAVEMENT MARKING PROGRAM

STREET: NE 128TH ST

CROSS STREET: TRANSIT AREA MARKINGS

SEGMENT:

SCALE: N.T.S.

FILENAME:

APPENDIX F

ALTERNATE F– PLAN SHEETS

MARKET ST
INTERSECTION PLANS

CITY OF KIRKLAND
DEPARTMENT OF PUBLIC WORKS
123 FIFTH AVENUE KIRKLAND, WA 98033
(425) 587-3800 www.kirklandwa.gov

S GONSAR	1/2019	DESIGNED BY: DATE
J.JENNINGS	1/2019	DRAWN BY: DATE
		CHECKED BY: DATE

2020 PAVEMENT MARKING PROGRAM

STREET:

CROSS STREET:

SEGMENT:

SCALE: N.T.S.

FILENAME: 6-0

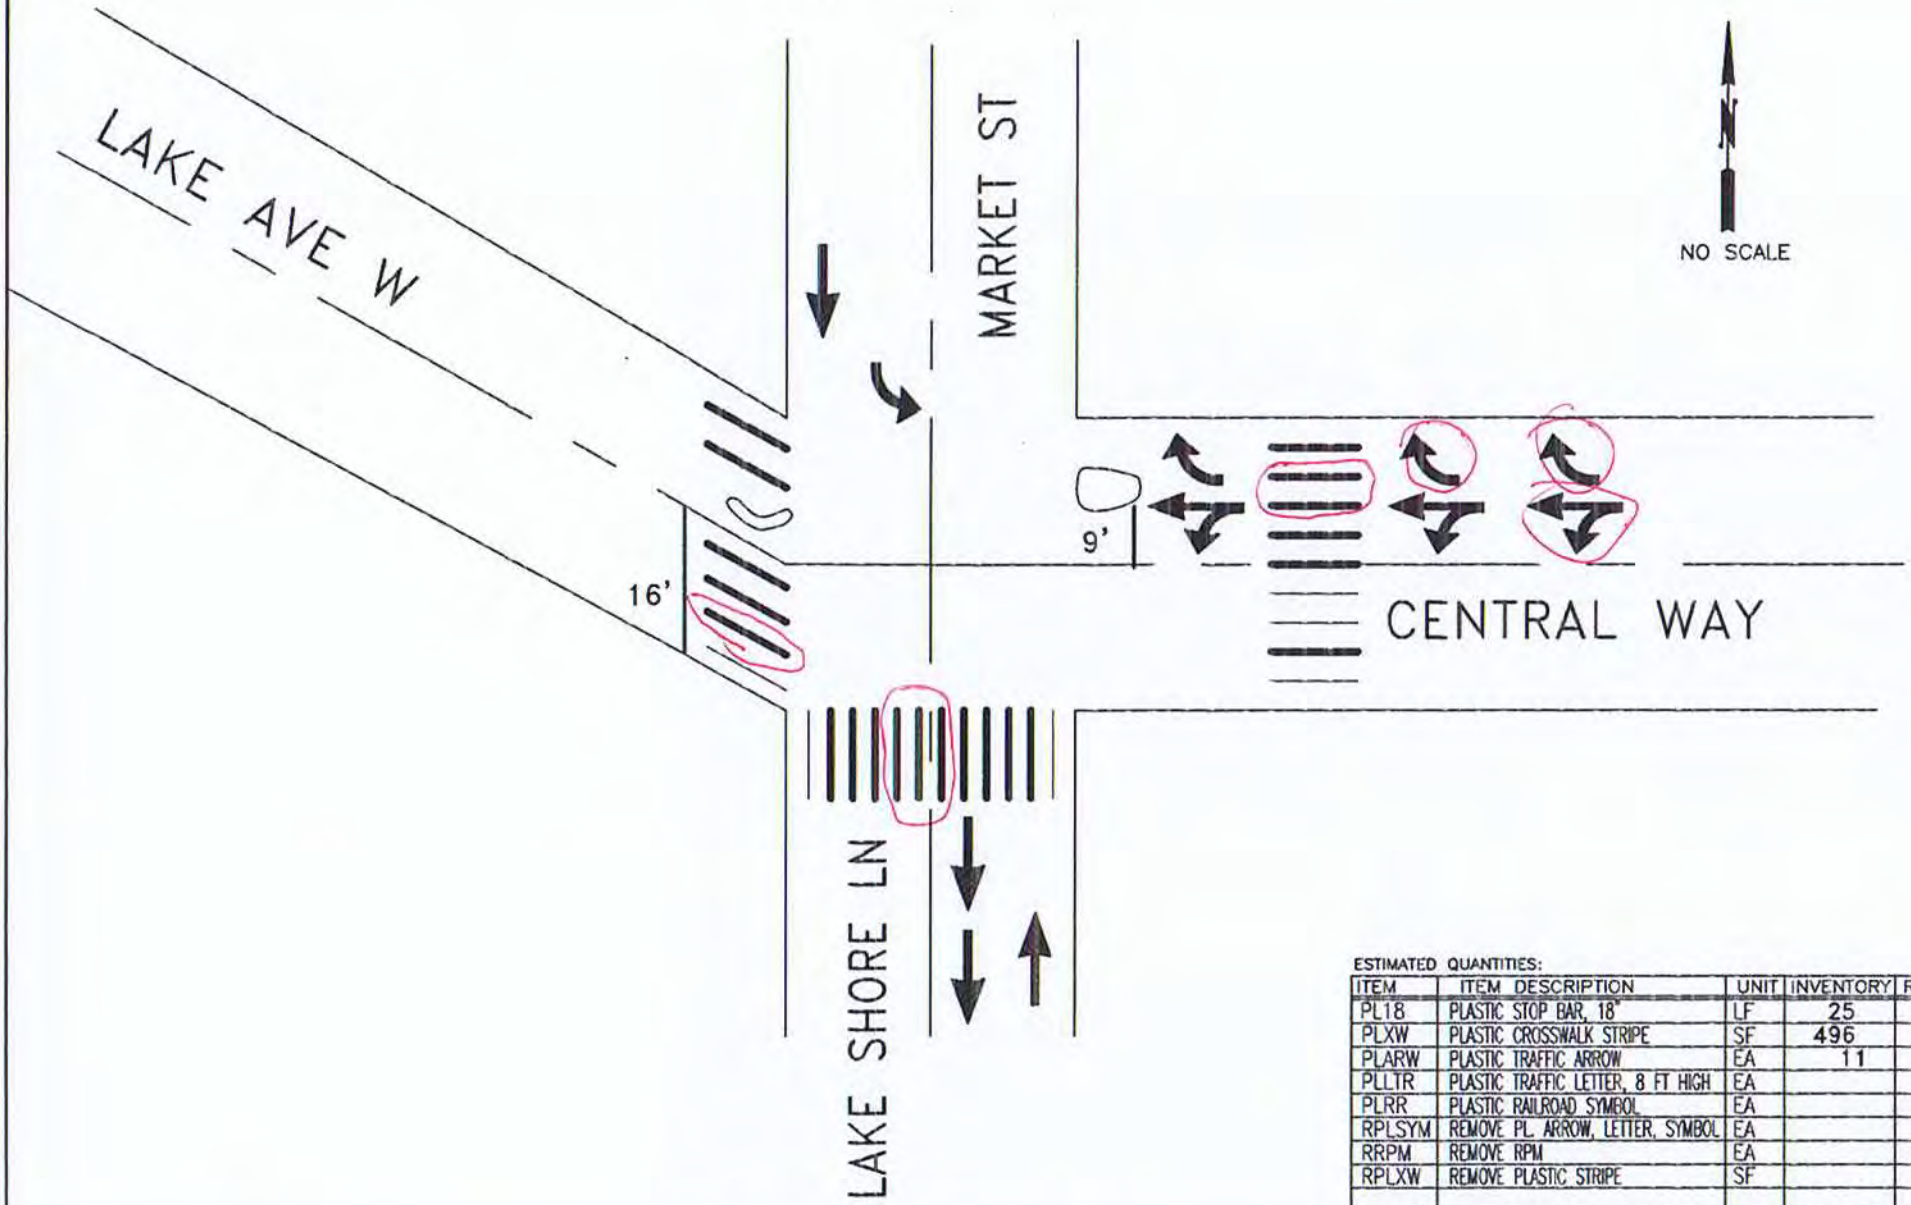

ESTIMATED QUANTITIES:

ITEM	ITEM DESCRIPTION	UNIT	INVENTORY	REPAIR QTY
PL18	PLASTIC STOP BAR, 18"	LF	25	
PLXW	PLASTIC CROSSWALK STRIPE	SF	496	120
PLARW	PLASTIC TRAFFIC ARROW	EA	11	6
PLLTR	PLASTIC TRAFFIC LETTER, 8 FT HIGH	EA		
PLRR	PLASTIC RAILROAD SYMBOL	EA		
RPLSYM	REMOVE PL. ARROW, LETTER, SYMBOL	EA		
RRPM	REMOVE RPM	EA		
RPLXW	REMOVE PLASTIC STRIPE	SF		

CITY OF KIRKLAND
DEPARTMENT OF PUBLIC WORKS
123 FIFTH AVENUE KIRKLAND, WA 98033
(425) 587-3800 www.kirklandwa.gov

G. HORTILLOSA 10/2011
DESIGNED BY: DATE

J.JENNINGS 10/2011
DRAWN BY: DATE

REVISED: DATE

2020 PAVEMENT MARKING PROGRAM

STREET: CENTRAL WAY

CROSS STREET: MARKET ST. & LAKE AVE W

SEGMENT:

SCALE: N.T.S.

FILENAME: Page 6-1

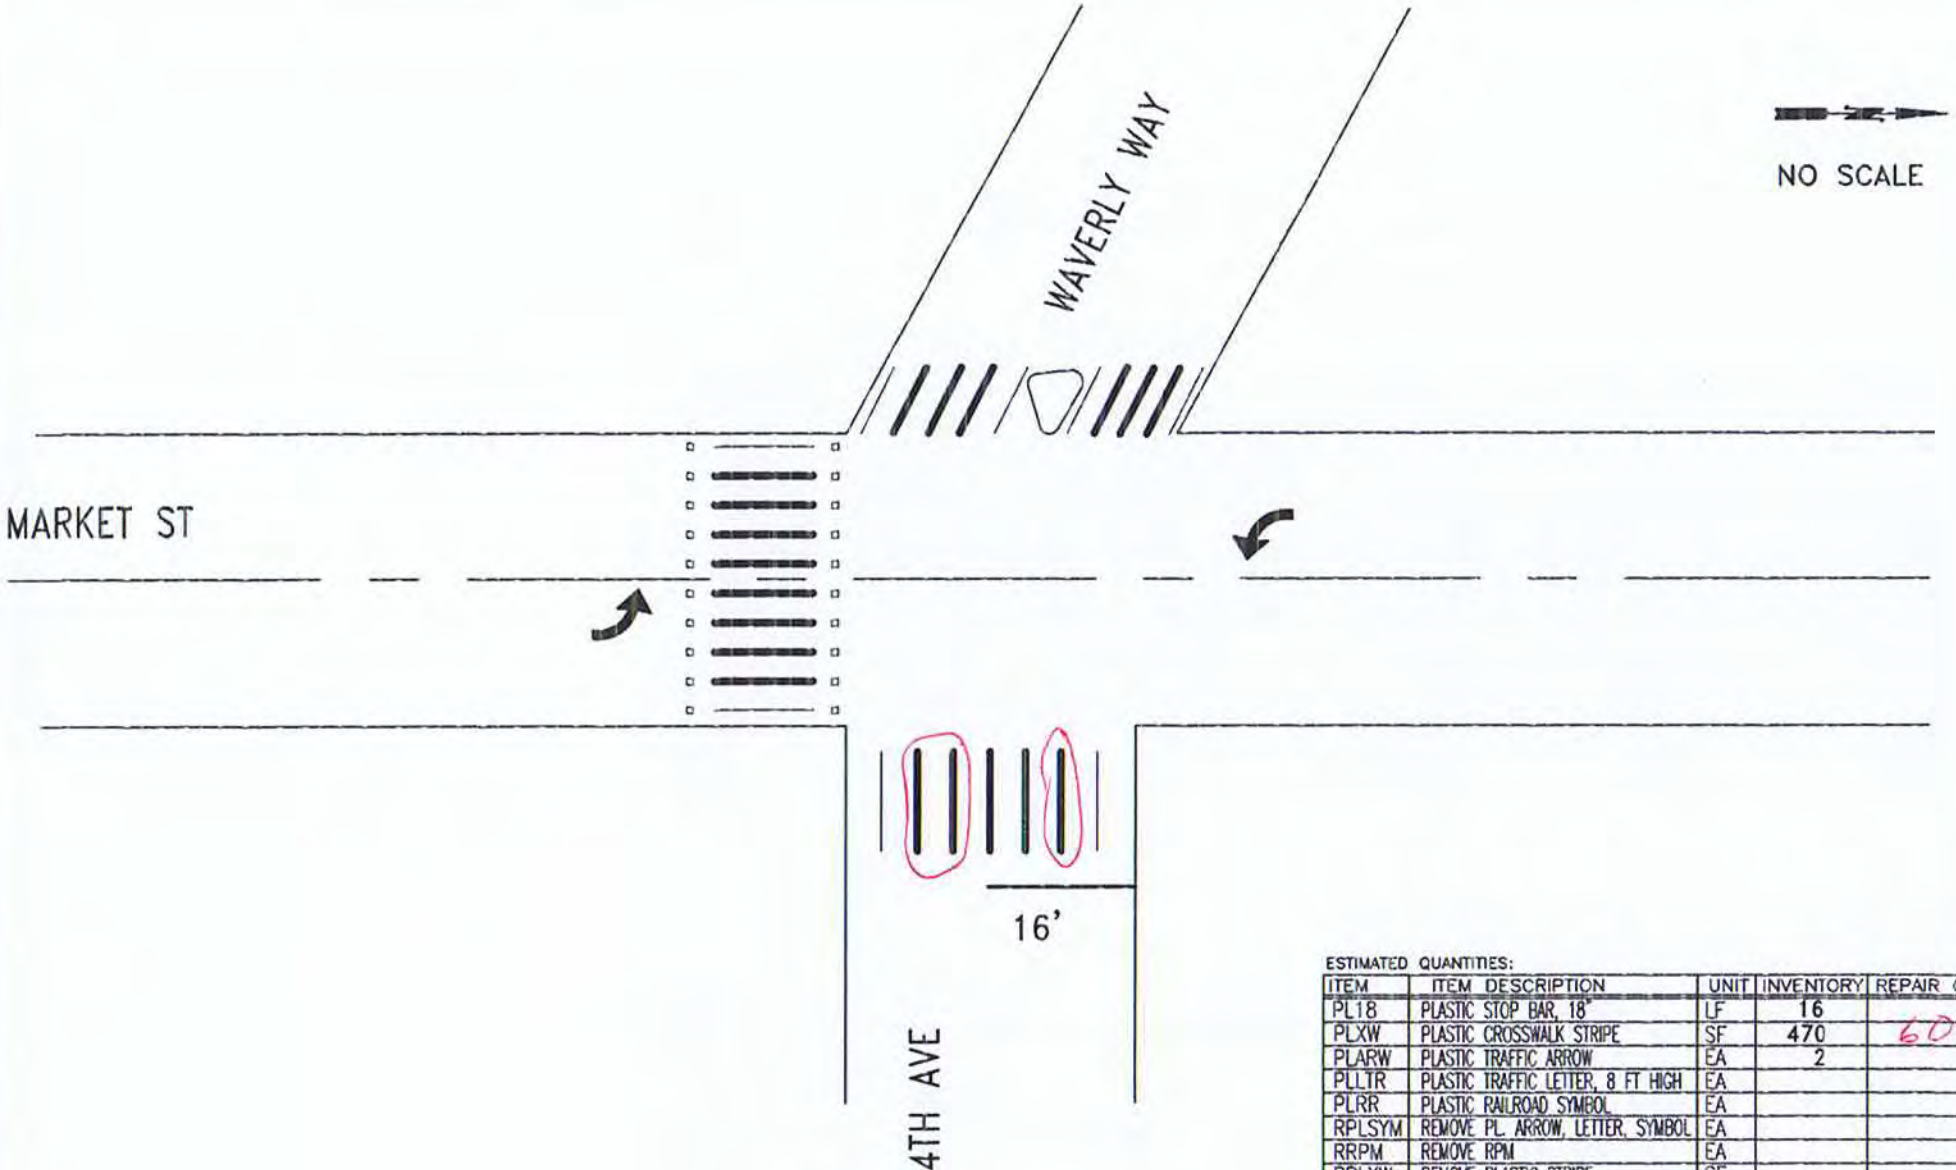

ESTIMATED QUANTITIES:

ITEM	ITEM DESCRIPTION	UNIT	INVENTORY	REPAIR QTY
PL18	PLASTIC STOP BAR, 18"	LF	16	
PLXW	PLASTIC CROSSWALK STRIPE	SF	470	60
PLARW	PLASTIC TRAFFIC ARROW	EA	2	
PLLTR	PLASTIC TRAFFIC LETTER, 8 FT HIGH	EA		
PLRR	PLASTIC RAILROAD SYMBOL	EA		
RPLSYM	REMOVE PL. ARROW, LETTER, SYMBOL	EA		
RRPM	REMOVE RPM	EA		
RPLXW	REMOVE PLASTIC STRIPE	SF		
RPMII	RPM TYPE II	EA	20	

CITY OF KIRKLAND WASHINGTON

CITY OF KIRKLAND
DEPARTMENT OF PUBLIC WORKS
123 FIFTH AVENUE KIRKLAND, WA 98033
(425) 587-3800 www.kirklandwa.gov

D.GRILLEY 1/2000
DESIGNED BY: DATE

J.JENNINGS 10/2009
DRAWN BY: DATE

CHECKED BY: DATE

20__ PAVEMENT MARKING PROGRAM

STREET: MARKET ST

CROSS STREET: 4TH AVE

SEGMENT:

SCALE: N.T.S.

FILENAME: Page 6-3

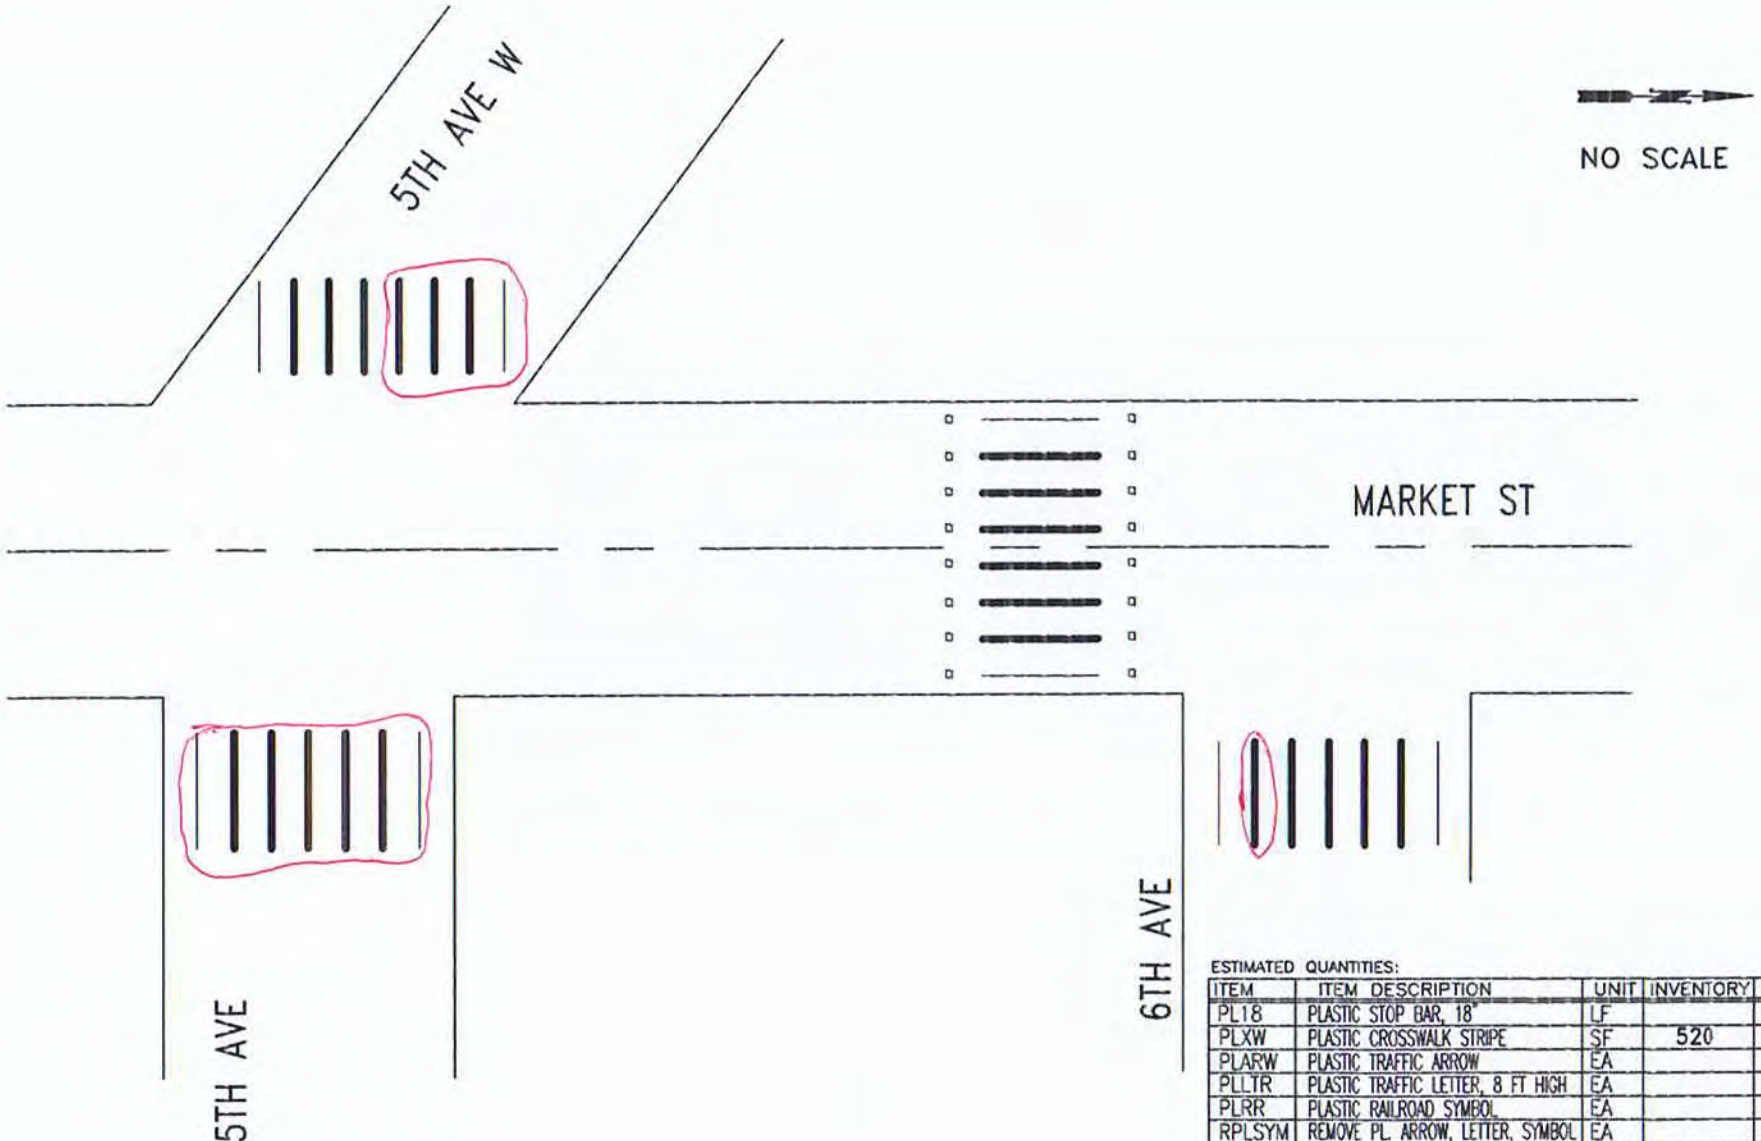

ESTIMATED QUANTITIES:

ITEM	ITEM DESCRIPTION	UNIT	INVENTORY	REPAIR QTY
PL18	PLASTIC STOP BAR, 18"	LF		
PLXW	PLASTIC CROSSWALK STRIPE	SF	520	210
PLARW	PLASTIC TRAFFIC ARROW	EA		
PLLTR	PLASTIC TRAFFIC LETTER, 8 FT HIGH	EA		
PLRR	PLASTIC RAILROAD SYMBOL	EA		
RPLSYM	REMOVE PL. ARROW, LETTER, SYMBOL	EA		
RRPM	REMOVE RPM	EA		
RPLXW	REMOVE PLASTIC STRIPE	SF		
RPMII	RPM TYPE II	EA	16	

CITY OF KIRKLAND
DEPARTMENT OF PUBLIC WORKS
123 FIFTH AVENUE KIRKLAND, WA 98033
(425) 587-3800 www.kirklandwa.gov

D.GRILLEY 1/2000
DESIGNED BY: DATE

J.JENNINGS 1/2000
DRAWN BY: DATE

CHECKED BY: DATE

2020 PAVEMENT MARKING PROGRAM

STREET: MARKET ST

CROSS STREET: 6TH AVE

SEGMENT:

SCALE: N.T.S.

FILENAME:

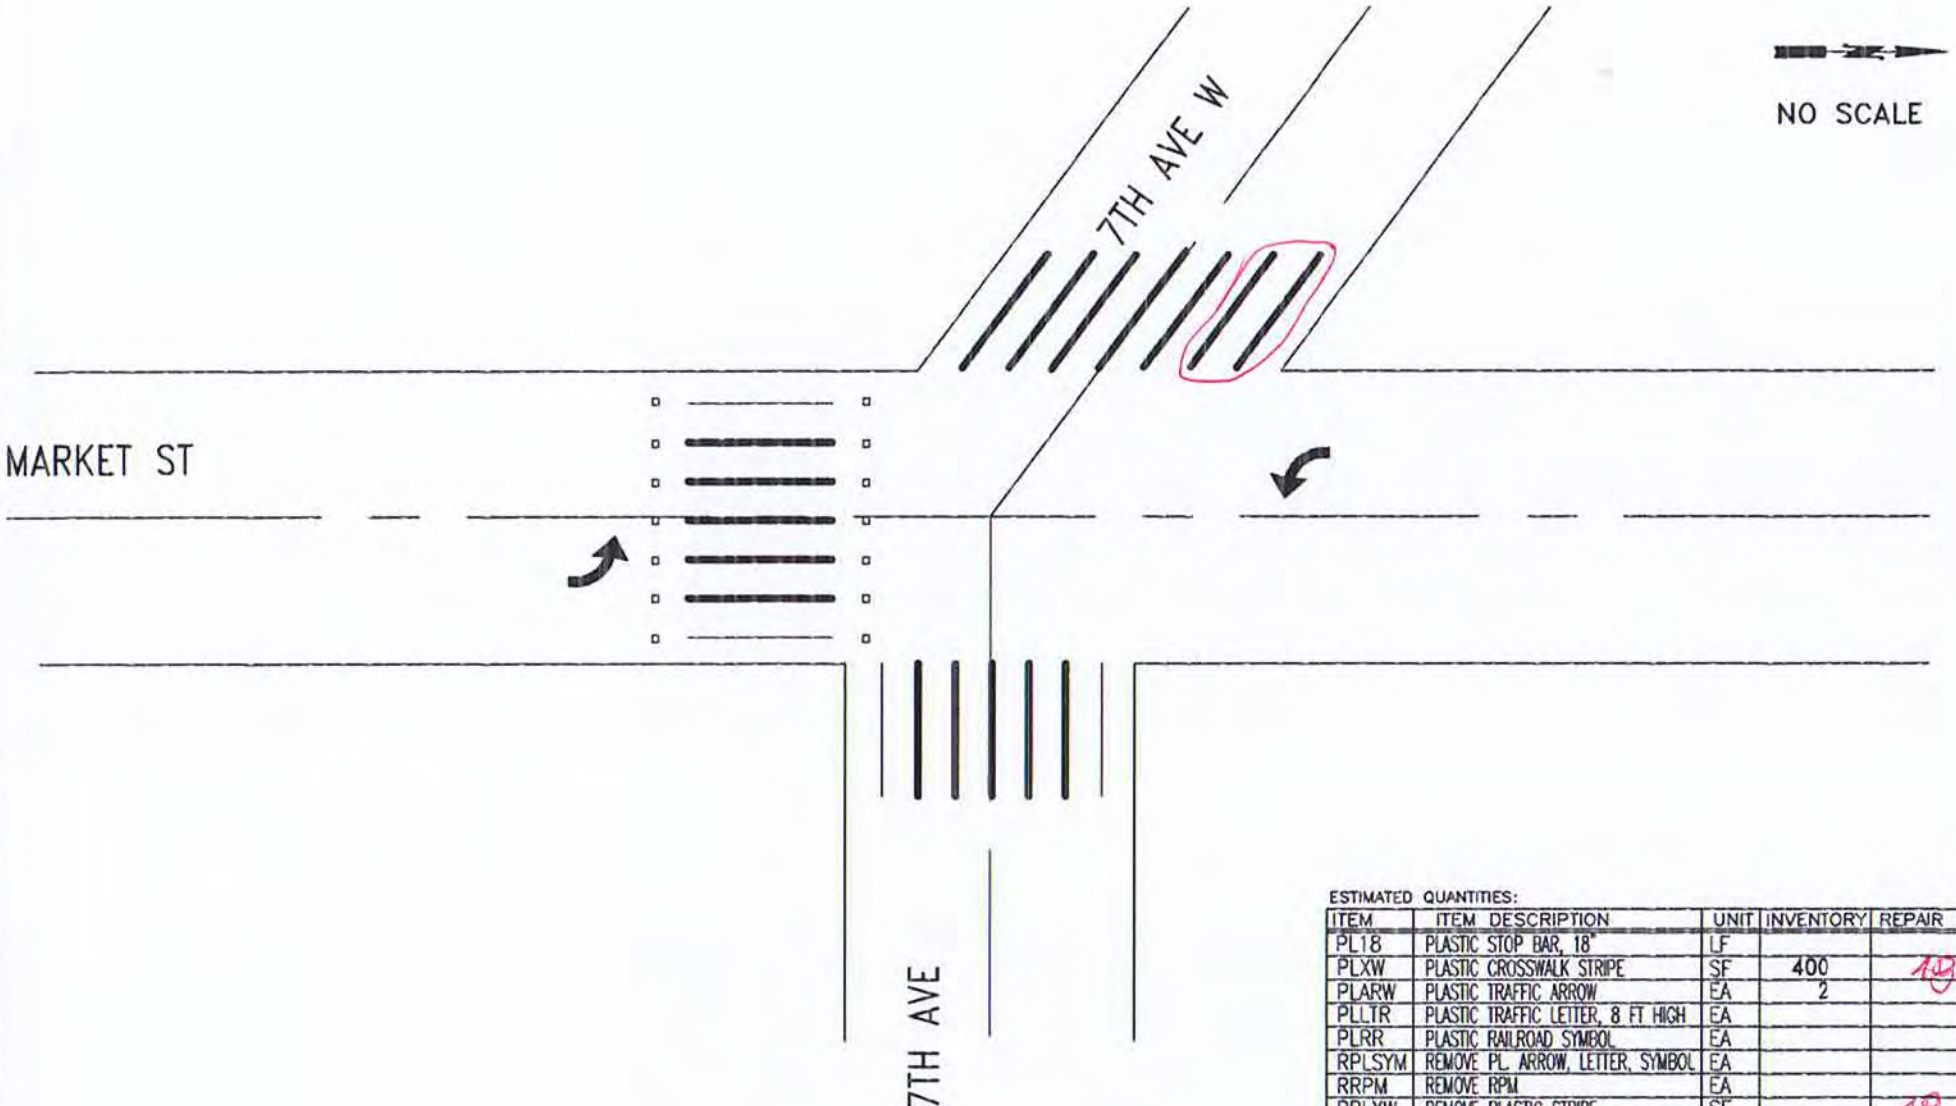

ESTIMATED QUANTITIES:

ITEM	ITEM DESCRIPTION	UNIT	INVENTORY	REPAIR QTY
PL18	PLASTIC STOP BAR, 18"	LF		
PLXW	PLASTIC CROSSWALK STRIPE	SF	400	10
PLARW	PLASTIC TRAFFIC ARROW	EA	2	
PLLTR	PLASTIC TRAFFIC LETTER, 8 FT HIGH	EA		
PLRR	PLASTIC RAILROAD SYMBOL	EA		
RPLSYM	REMOVE PL. ARROW, LETTER, SYMBOL	EA		
RRPM	REMOVE RPM	EA		
RPLXW	REMOVE PLASTIC STRIPE	SF		40
RPM11	TYPE II RPM	EA	14	

CITY OF KIRKLAND
DEPARTMENT OF PUBLIC WORKS
123 FIFTH AVENUE KIRKLAND, WA 98033
(425) 587-3800 www.kirklandwa.gov

D.GRILLEY 1/2000
DESIGNED BY: DATE

J.JENNINGS 1/2000
DRAWN BY: DATE

CHECKED BY: DATE

20~~00~~__ PAVEMENT MARKING PROGRAM

STREET: MARKET ST

CROSS STREET: 7TH AVE & 7TH AVE W

SEGMENT:

SCALE: N.T.S.

FILENAME:

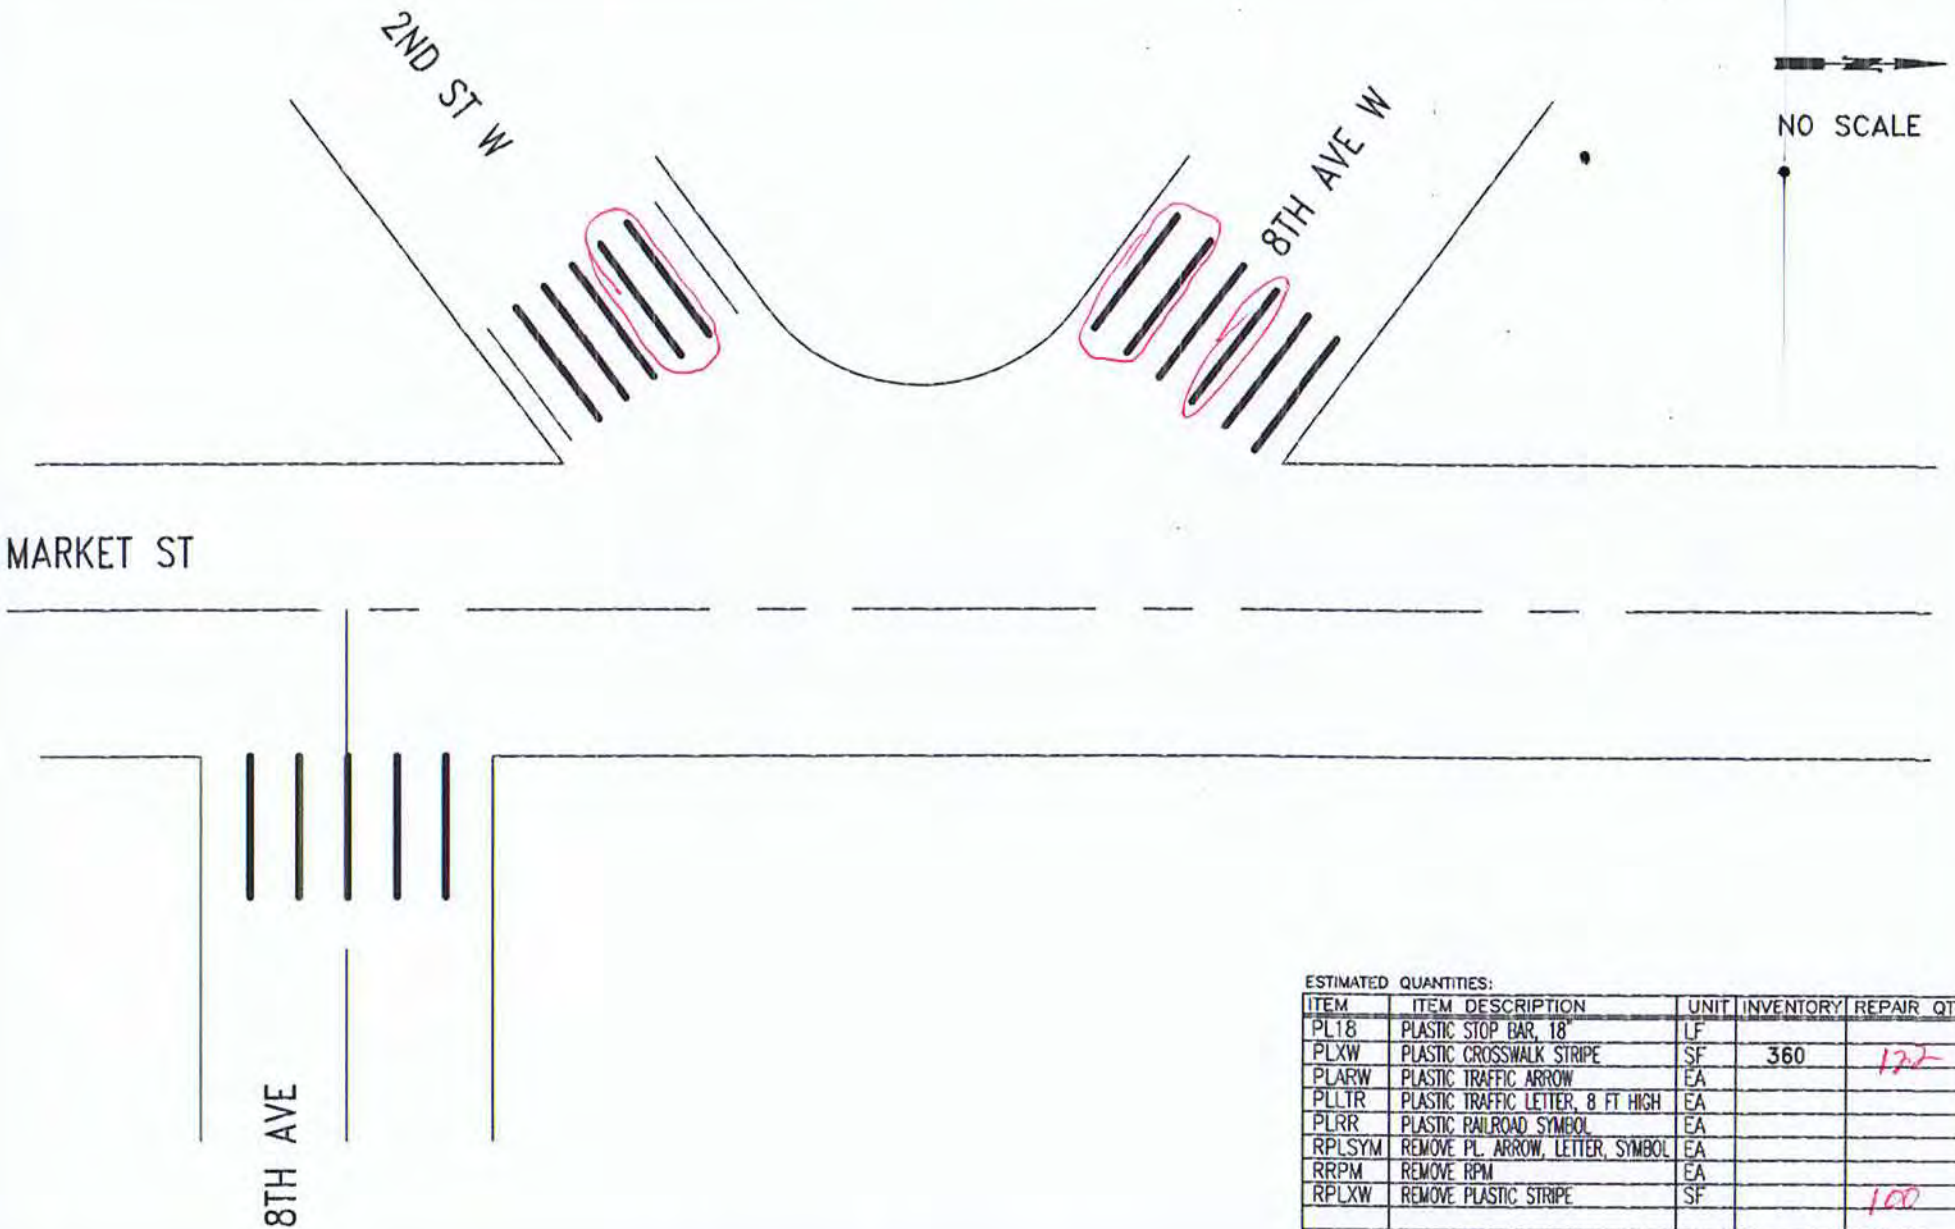

ESTIMATED QUANTITIES:

ITEM	ITEM DESCRIPTION	UNIT	INVENTORY	REPAIR QTY
PL18	PLASTIC STOP BAR, 18"	LF		
PLXW	PLASTIC CROSSWALK STRIPE	SF	360	122
PLARW	PLASTIC TRAFFIC ARROW	EA		
PLLTR	PLASTIC TRAFFIC LETTER, 8 FT HIGH	EA		
PLRR	PLASTIC RAILROAD SYMBOL	EA		
RPLSYM	REMOVE PL. ARROW, LETTER, SYMBOL	EA		
RRPM	REMOVE RPM	EA		
RPLXW	REMOVE PLASTIC STRIPE	SF		100

CITY OF KIRKLAND
DEPARTMENT OF PUBLIC WORKS
123 FIFTH AVENUE KIRKLAND, WA 98033
(425) 587-3800 www.kirklandwa.gov

D.GRILLEY 1/2000
DESIGNED BY: DATE

J.JENNINGS 1/2000
DRAWN BY: DATE

CHECKED BY: DATE

20__ PAVEMENT MARKING PROGRAM

STREET: MARKET ST

CROSS STREET: 2ND ST W & 8TH AVE

SEGMENT:

SCALE: N.T.S.

FILENAME: Page 6-6

NO SCALE

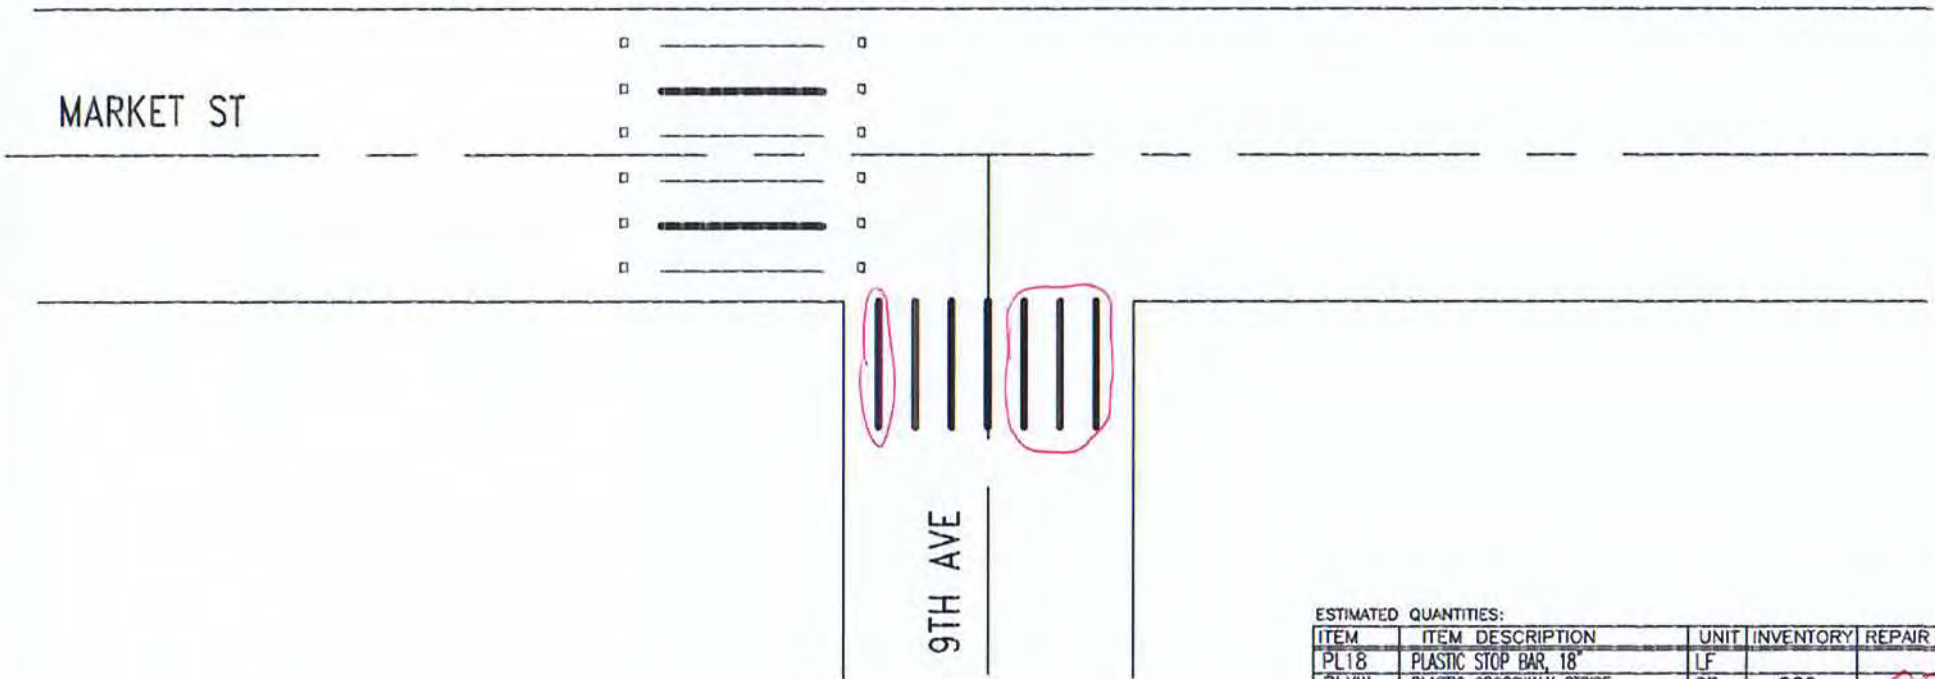

ESTIMATED QUANTITIES:

ITEM	ITEM DESCRIPTION	UNIT	INVENTORY	REPAIR QTY
PL18	PLASTIC STOP BAR, 18"	LF		
PLXW	PLASTIC CROSSWALK STRIPE	SF	220	80
PLARW	PLASTIC TRAFFIC ARROW	EA		
PLLTR	PLASTIC TRAFFIC LETTER, 8 FT HIGH	EA		
PLRR	PLASTIC RAILROAD SYMBOL	EA		
RPLSYM	REMOVE PL. ARROW, LETTER, SYMBOL	EA		
RRPM	REMOVE RPM	EA		
RPLXW	REMOVE PLASTIC STRIPE	SF		60
RPM11	RPM TYPE II	EA		
RPM11	TYPE II RPM	EA	12	

CITY OF KIRKLAND WASHINGTON

CITY OF KIRKLAND
DEPARTMENT OF PUBLIC WORKS
123 FIFTH AVENUE KIRKLAND, WA 98033
(425) 587-3800 www.kirklandwa.gov

G. HORTILLOSA 2/2011
DESIGNED BY: DATE

J.JENNINGS 1/2000
DRAWN BY: DATE

CHECKED BY: DATE

2012 PAVEMENT MARKING PROGRAM

STREET: MARKET ST

CROSS STREET: 9TH AVE

SEGMENT:

SCALE: N.T.S.

FILENAME: Page 6-7

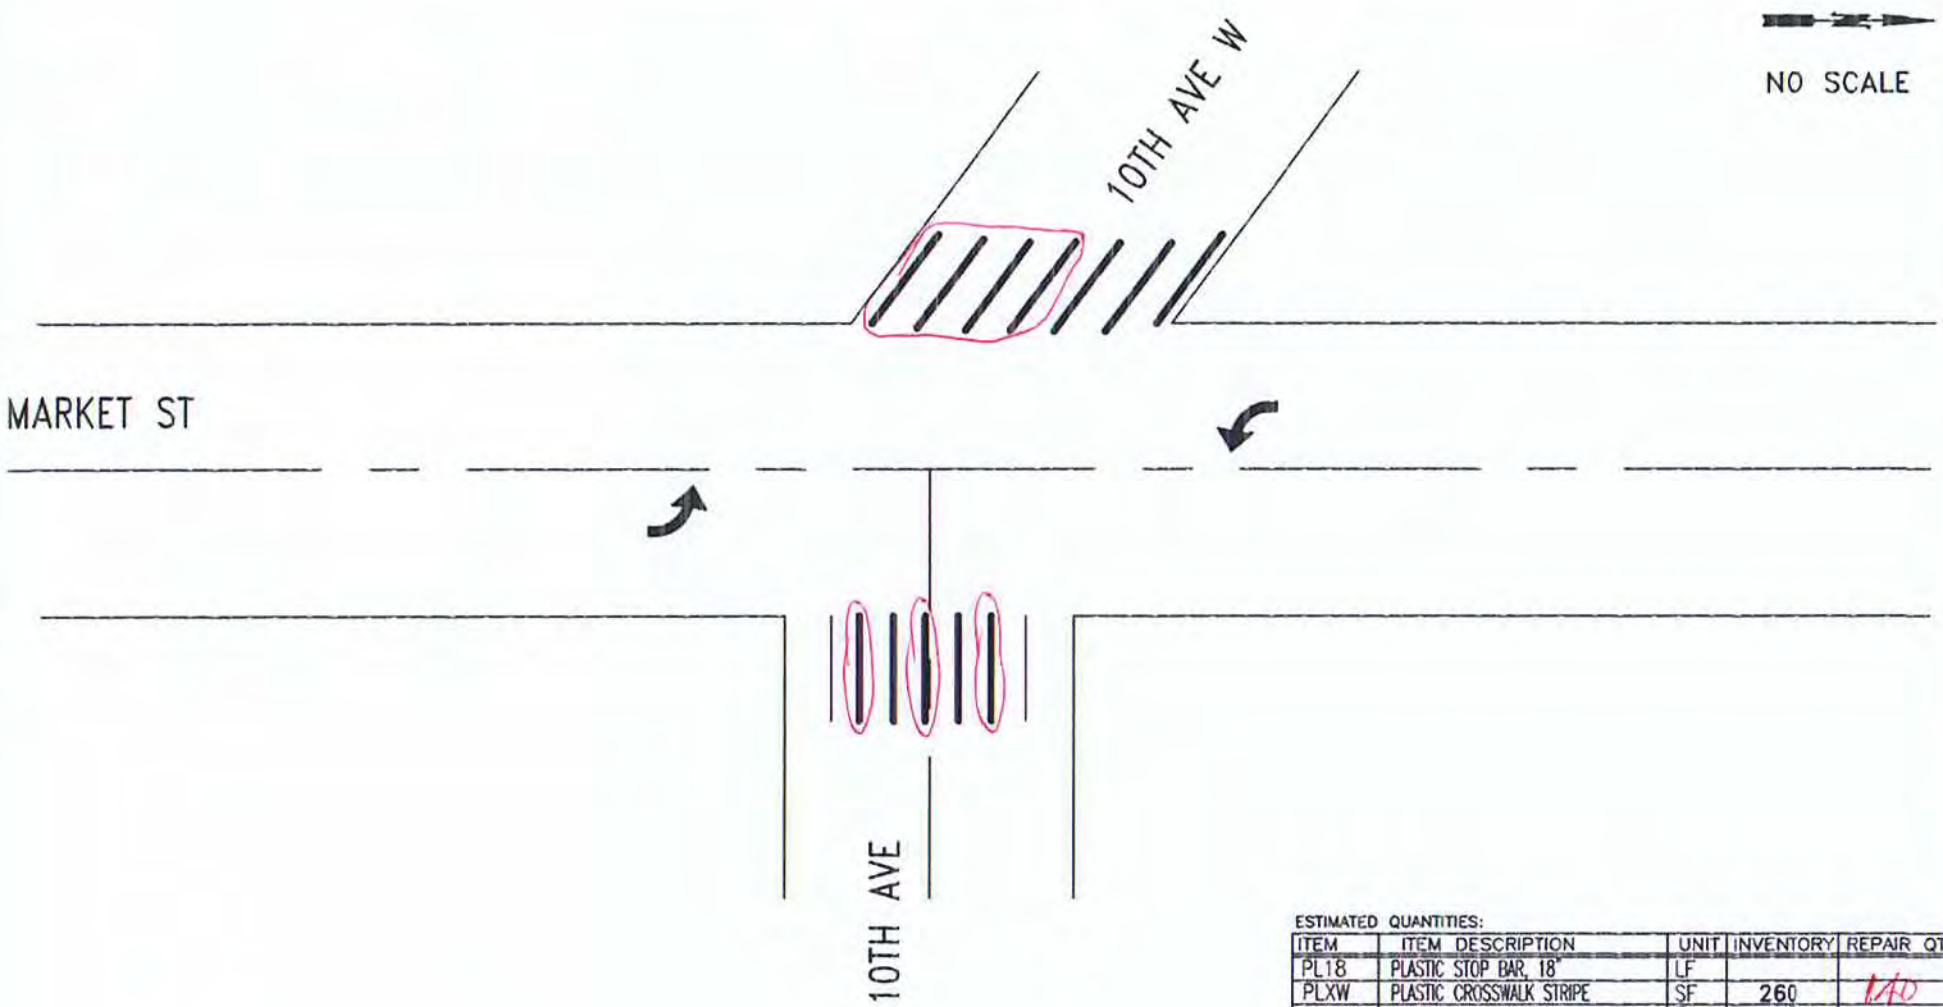

ESTIMATED QUANTITIES:

ITEM	ITEM DESCRIPTION	UNIT	INVENTORY	REPAIR QTY
PL18	PLASTIC STOP BAR, 18"	LF		
PLXW	PLASTIC CROSSWALK STRIPE	SF	260	140
PLARW	PLASTIC TRAFFIC ARROW	EA	2	
PLLTR	PLASTIC TRAFFIC LETTER, 8 FT HIGH	EA		
PLRR	PLASTIC RAILROAD SYMBOL	EA		
RPLSYM	REMOVE PL. ARROW, LETTER, SYMBOL	EA		
RRPM	REMOVE RPM	EA		
RPLXW	REMOVE PLASTIC STRIPE	SF		50

CITY OF KIRKLAND WASHINGTON

CITY OF KIRKLAND
DEPARTMENT OF PUBLIC WORKS
123 FIFTH AVENUE KIRKLAND, WA 98033
(425) 587-3800 www.kirklandwa.gov

G. HORTILLOSA 2/2011
DESIGNED BY: DATE

J.JENNINGS 10/2011
DRAWN BY: DATE

CHECKED BY: DATE

2020 PAVEMENT MARKING PROGRAM

STREET: MARKET ST

CROSS STREET: 10TH AVE

SEGMENT:

SCALE: N.T.S.

FILENAME:

NO SCALE

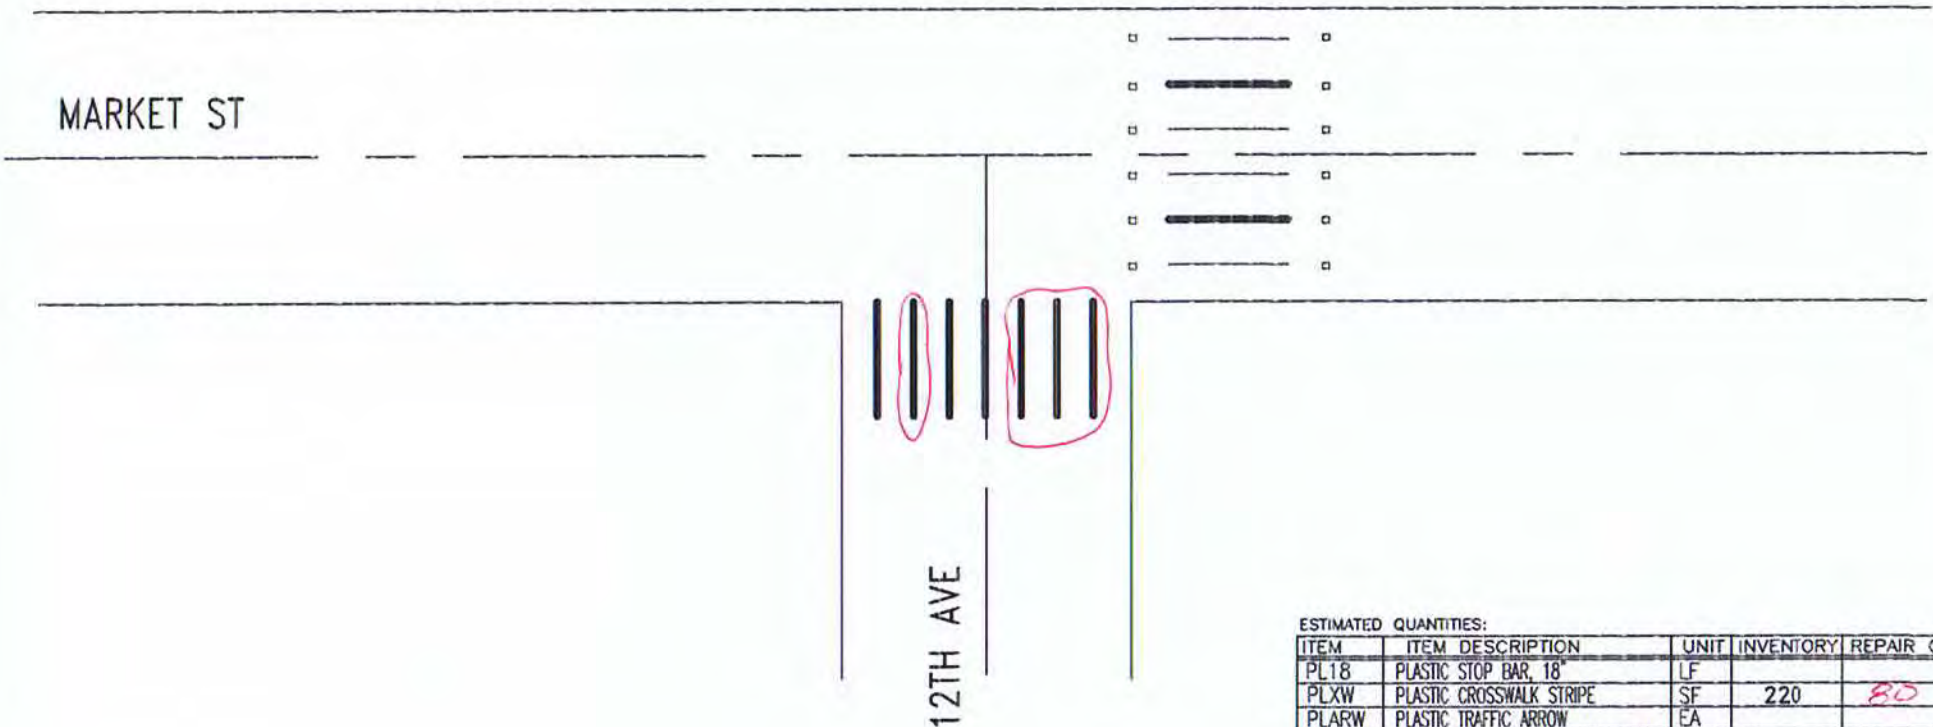

ESTIMATED QUANTITIES:

ITEM	ITEM DESCRIPTION	UNIT	INVENTORY	REPAIR QTY
PL18	PLASTIC STOP BAR, 18"	LF		
PLXW	PLASTIC CROSSWALK STRIPE	SF	220	80
PLARW	PLASTIC TRAFFIC ARROW	EA		
PLLTR	PLASTIC TRAFFIC LETTER, 8 FT HIGH	EA		
PLRR	PLASTIC RAILROAD SYMBOL	EA		
RPLSYM	REMOVE PL. ARROW, LETTER, SYMBOL	EA		
RRPM	REMOVE RPM	EA		
RPLXW	REMOVE PLASTIC STRIPE	SF		80
RPMII	TYPE II RPM	EA	12	

CITY OF KIRKLAND
DEPARTMENT OF PUBLIC WORKS
123 FIFTH AVENUE KIRKLAND, WA 98033
(425) 587-3800 www.kirklandwa.gov

D.GRILLEY 1/2000
DESIGNED BY: DATE

J.JENNINGS 1/2000
DRAWN BY: DATE

CHECKED BY: DATE

2020 PAVEMENT MARKING PROGRAM

STREET: MARKET ST

CROSS STREET: 12TH AVE

SEGMENT:

SCALE: N.T.S.

FILENAME: Page 6-10

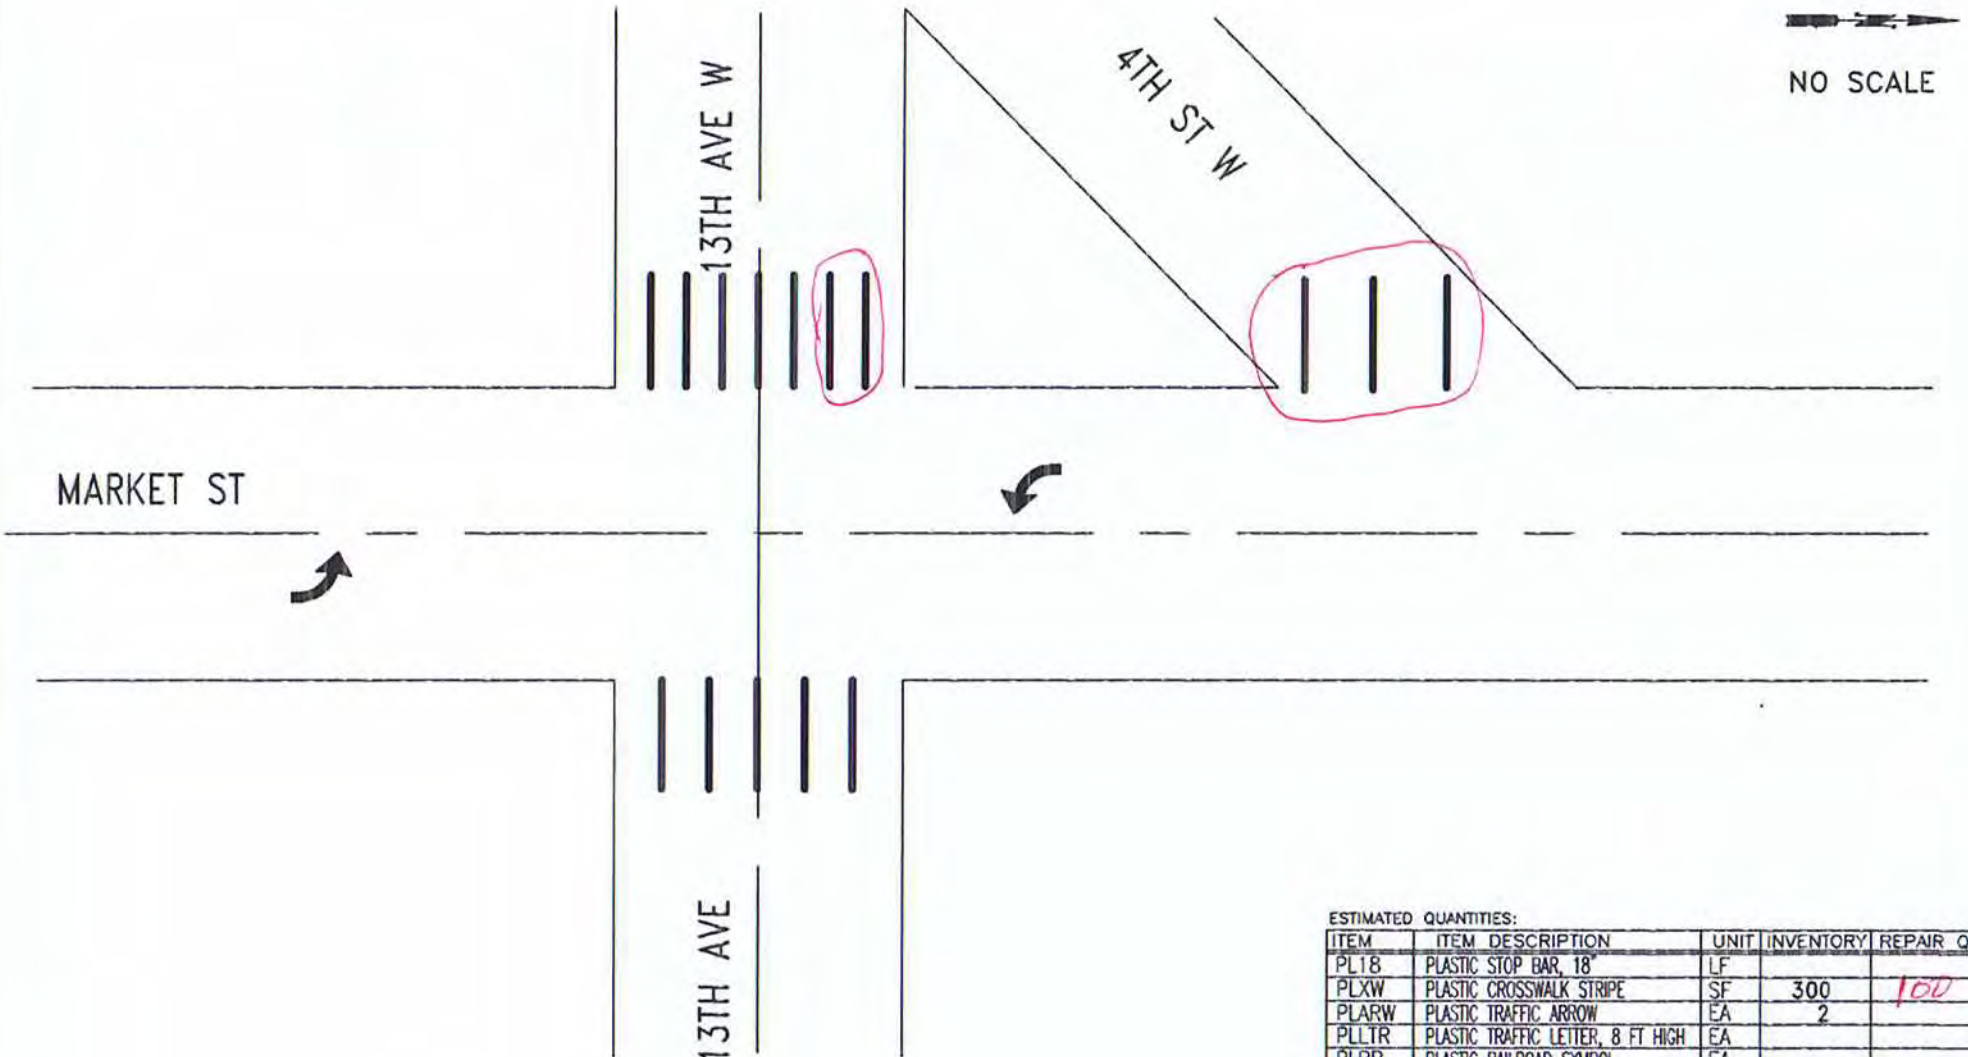

ESTIMATED QUANTITIES:

ITEM	ITEM DESCRIPTION	UNIT	INVENTORY	REPAIR QTY
PL18	PLASTIC STOP BAR, 18"	LF		
PLXW	PLASTIC CROSSWALK STRIPE	SF	300	100
PLARW	PLASTIC TRAFFIC ARROW	EA	2	
PLLTR	PLASTIC TRAFFIC LETTER, 8 FT HIGH	EA		
PLRR	PLASTIC RAILROAD SYMBOL	EA		
RPLSYM	REMOVE PL. ARROW, LETTER, SYMBOL	EA		
RRPM	REMOVE RPM	EA		
RPLXW	REMOVE PLASTIC STRIPE	SF		
RPMII	TYPE II RPM	EA		
RPM11	TYPE II RPM	EA		

CITY OF KIRKLAND
DEPARTMENT OF PUBLIC WORKS
123 FIFTH AVENUE KIRKLAND, WA 98033
(425) 587-3800 www.kirklandwa.gov

D.GRILLEY 1/2000
DESIGNED BY: DATE

J.JENNINGS 1/2000
DRAWN BY: DATE

CHECKED BY: DATE

2020 PAVEMENT MARKING PROGRAM

STREET: MARKET ST

CROSS STREET: 13TH AVE

SEGMENT:

SCALE: N.T.S.

FILENAME: Page 6-11

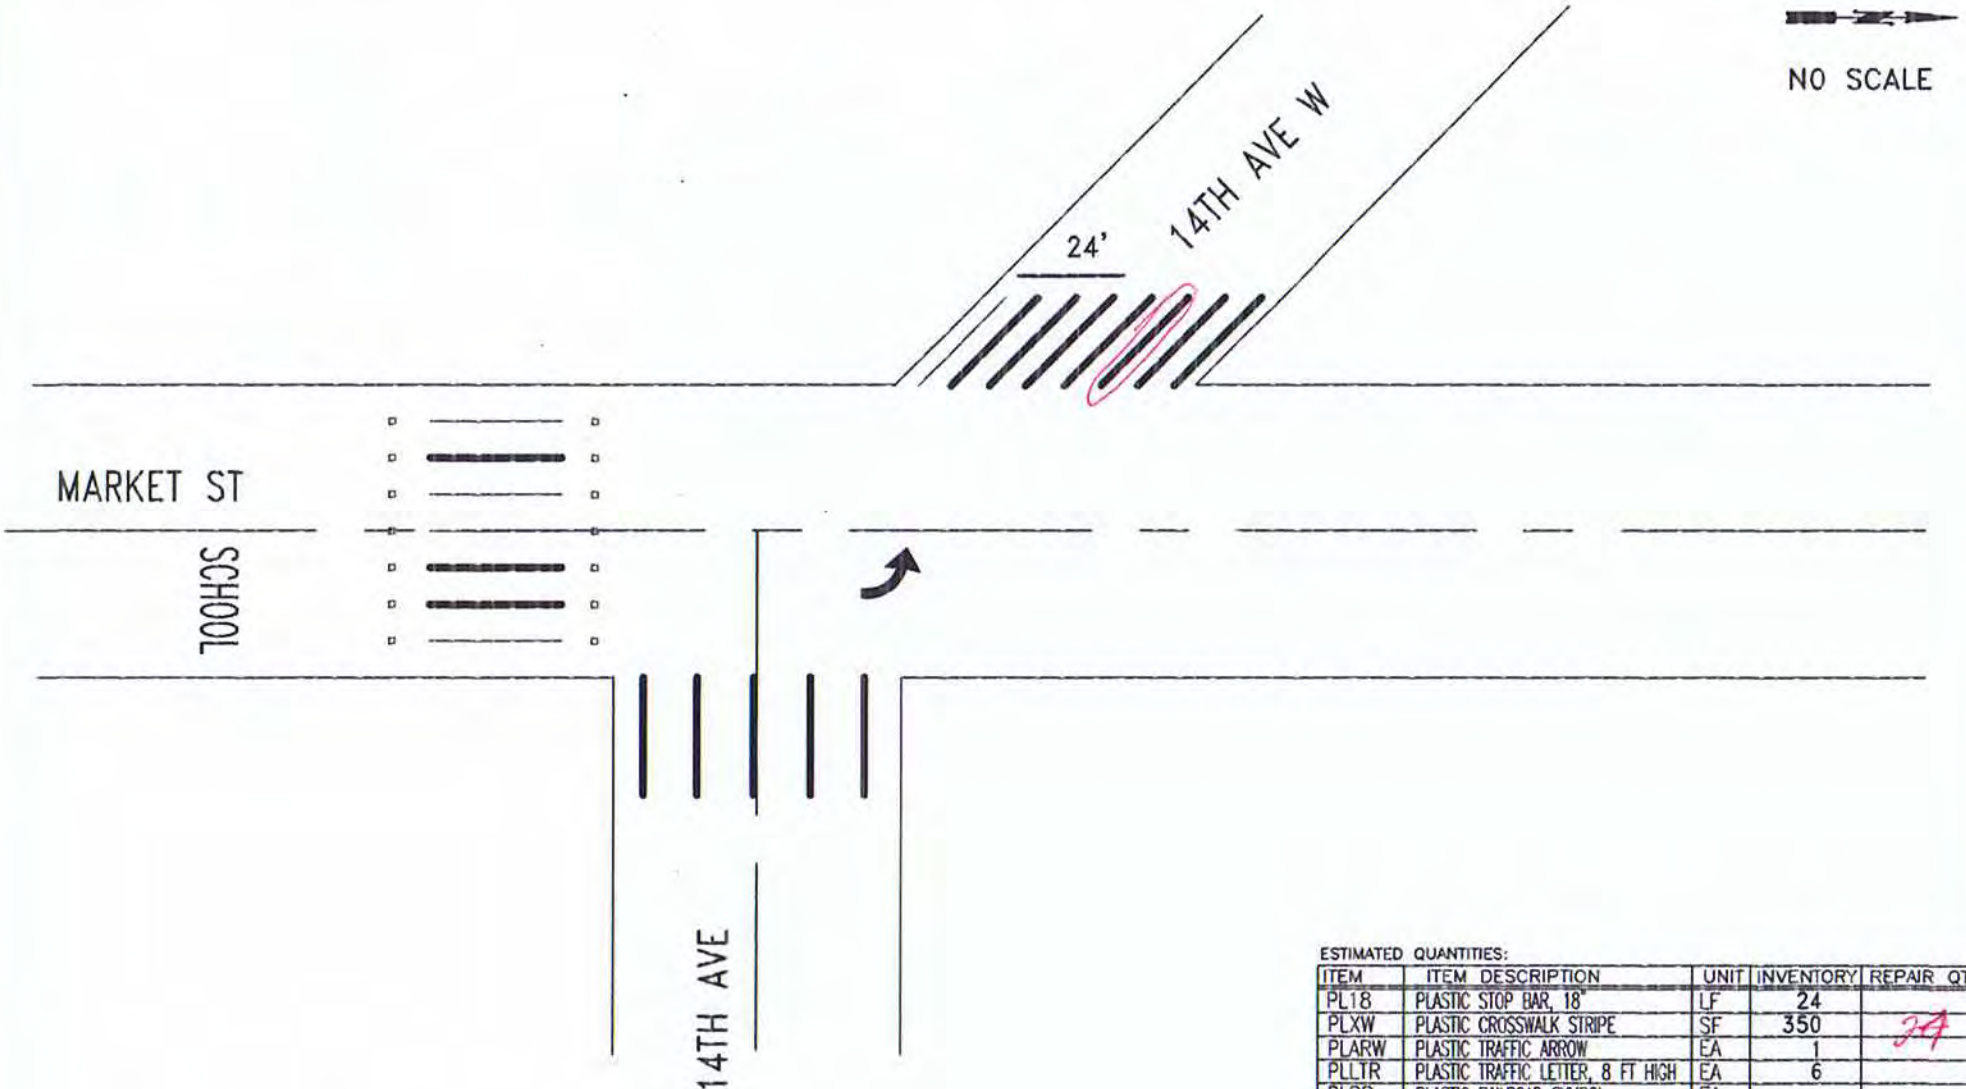

ESTIMATED QUANTITIES:

ITEM	ITEM DESCRIPTION	UNIT	INVENTORY	REPAIR QTY
PL18	PLASTIC STOP BAR, 18"	LF	24	
PLXW	PLASTIC CROSSWALK STRIPE	SF	350	24
PLARW	PLASTIC TRAFFIC ARROW	EA	1	
PLLTR	PLASTIC TRAFFIC LETTER, 8 FT HIGH	EA	6	
PLRR	PLASTIC RAILROAD SYMBOL	EA		
RPLSYM	REMOVE PL. ARROW, LETTER, SYMBOL	EA		
RRPM	REMOVE RPM	EA		
RPLXW	REMOVE PLASTIC STRIPE	SF		
RPMII	TYPE II RPM	EA	14	

CITY OF KIRKLAND
DEPARTMENT OF PUBLIC WORKS
123 FIFTH AVENUE KIRKLAND, WA 98033
(425) 587-3800 www.kirklandwa.gov

G. HORTILLOSA 2/2011
DESIGNED BY: DATE

J.JENNINGS 2/2004
DRAWN BY: DATE

CHECKED BY: DATE

2022 PAVEMENT MARKING PROGRAM

STREET: MARKET ST

CROSS STREET: 14TH AVE

SEGMENT:

SCALE: N.T.S.

FILENAME: Page 6-14

NO SCALE

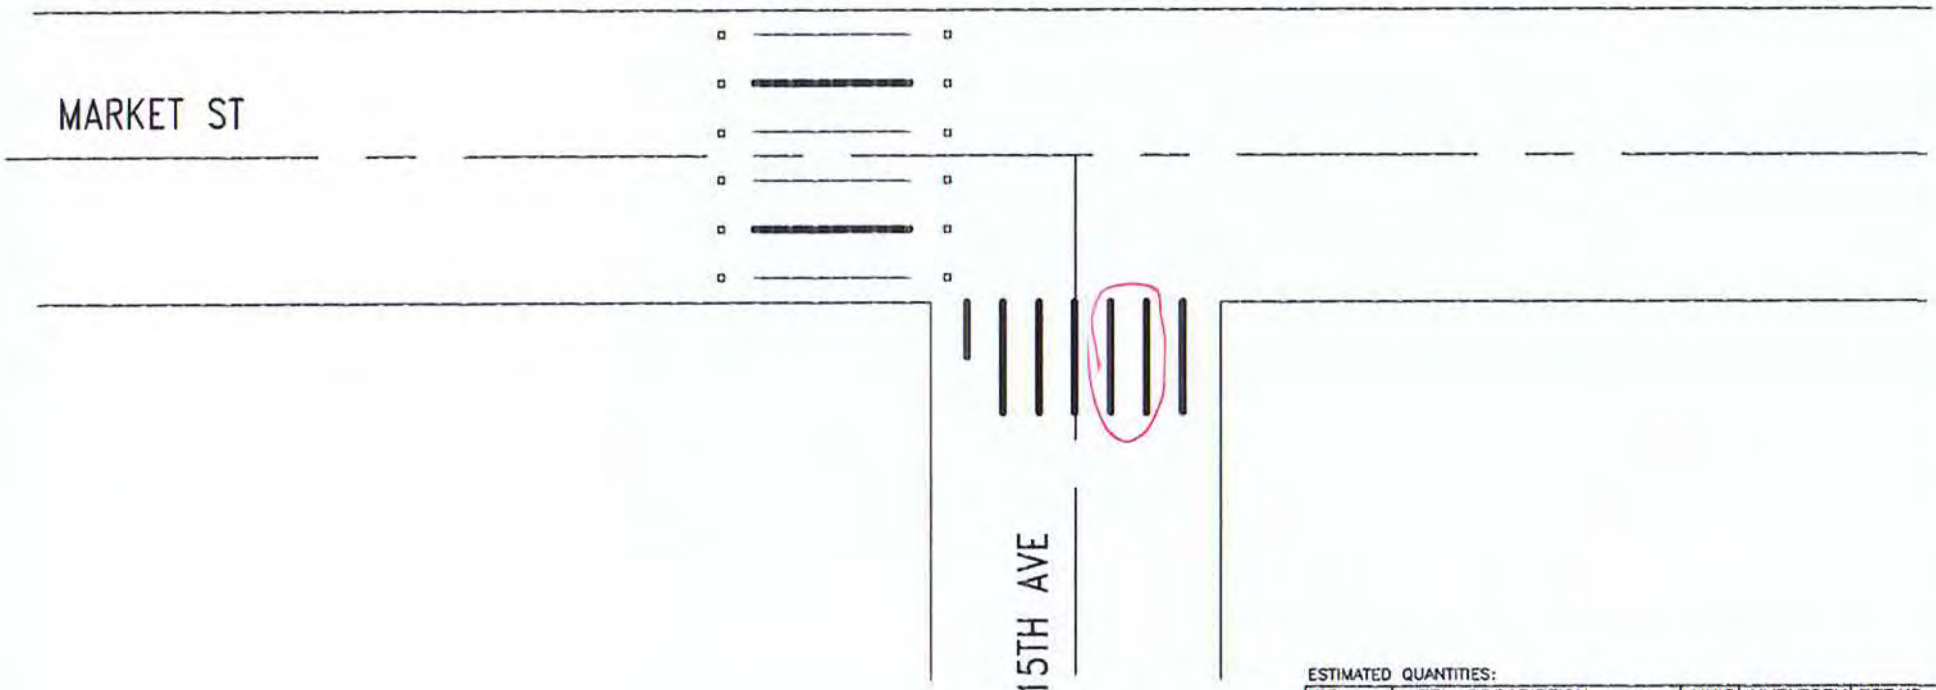

ESTIMATED QUANTITIES:

ITEM	ITEM DESCRIPTION	UNIT	INVENTORY	REPAIR QTY
PL18	PLASTIC STOP BAR, 18"	LF		
PLXW	PLASTIC CROSSWALK STRIPE	SF	195	40
PLARW	PLASTIC TRAFFIC ARROW	EA		
PLLTR	PLASTIC TRAFFIC LETTER, 8 FT HIGH	EA		
PLRR	PLASTIC RAILROAD SYMBOL	EA		
RPLSYM	REMOVE PL. ARROW, LETTER, SYMBOL	EA		
RRPM	REMOVE RPM	EA		
RPLXW	REMOVE PLASTIC STRIPE	SF		40
RPMII	TYPE II RPM	EA	12	

CITY OF KIRKLAND
DEPARTMENT OF PUBLIC WORKS
123 FIFTH AVENUE KIRKLAND, WA 98033
(425) 587-3800 www.kirklandwa.gov

D.GRILLEY 1/2000
DESIGNED BY: DATE

J.JENNINGS 1/2000
DRAWN BY: DATE

CHECKED BY: DATE

2022 PAVEMENT MARKING PROGRAM

STREET: MARKET ST

CROSS STREET: 15TH AVE

SEGMENT:

SCALE: N.T.S.

FILENAME:

NO SCALE

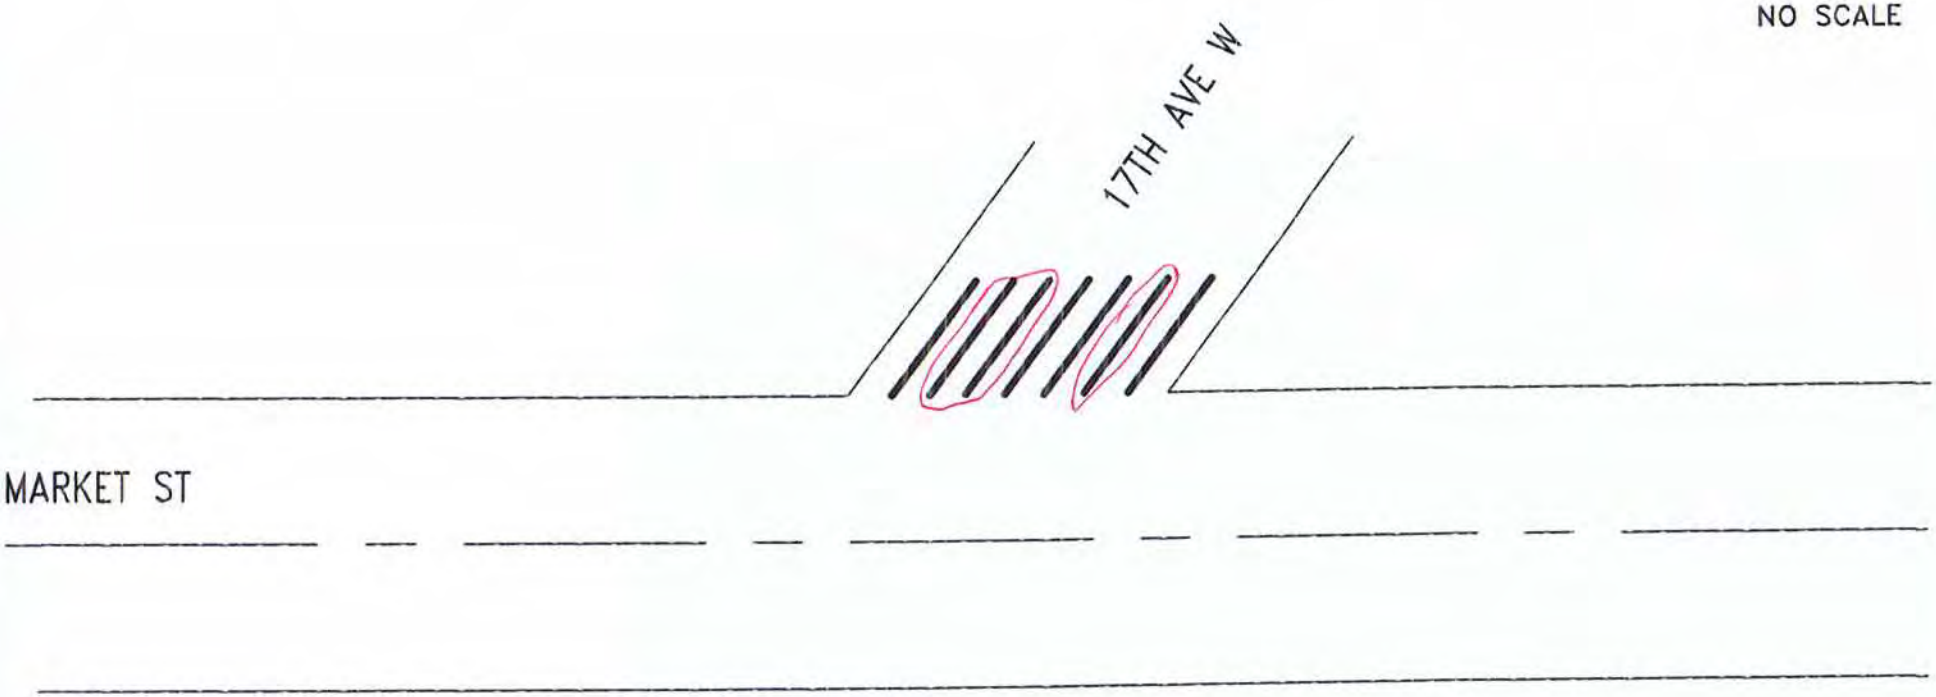

ESTIMATED QUANTITIES:

ITEM	ITEM DESCRIPTION	UNIT	INVENTORY	REPAIR QTY
PL18	PLASTIC STOP BAR, 18"	LF		
PLXW	PLASTIC CROSSWALK STRIPE	SF	182	75
PLARW	PLASTIC TRAFFIC ARROW	EA		
PLLTR	PLASTIC TRAFFIC LETTER, 8 FT HIGH	EA		
PLRR	PLASTIC RAILROAD SYMBOL	EA		
RPLSYM	REMOVE PL. ARROW, LETTER, SYMBOL	EA		
RRPM	REMOVE RPM	EA		
RPLXW	REMOVE PLASTIC STRIPE	SF		

CITY OF KIRKLAND WASHINGTON

CITY OF KIRKLAND
DEPARTMENT OF PUBLIC WORKS
123 FIFTH AVENUE KIRKLAND, WA 98033
(425) 587-3800 www.kirklandwa.gov

G. HORTILLOSA 10/2012
DESIGNED BY: DATE

J.JENNINGS 10/2012
DRAWN BY: DATE

CHECKED BY: DATE

20~~22~~ PAVEMENT MARKING PROGRAM

STREET: MARKET ST

CROSS STREET: 17TH AVE W

SEGMENT:

SCALE: N.T.S.

FILENAME: Page 6-17

NO SCALE

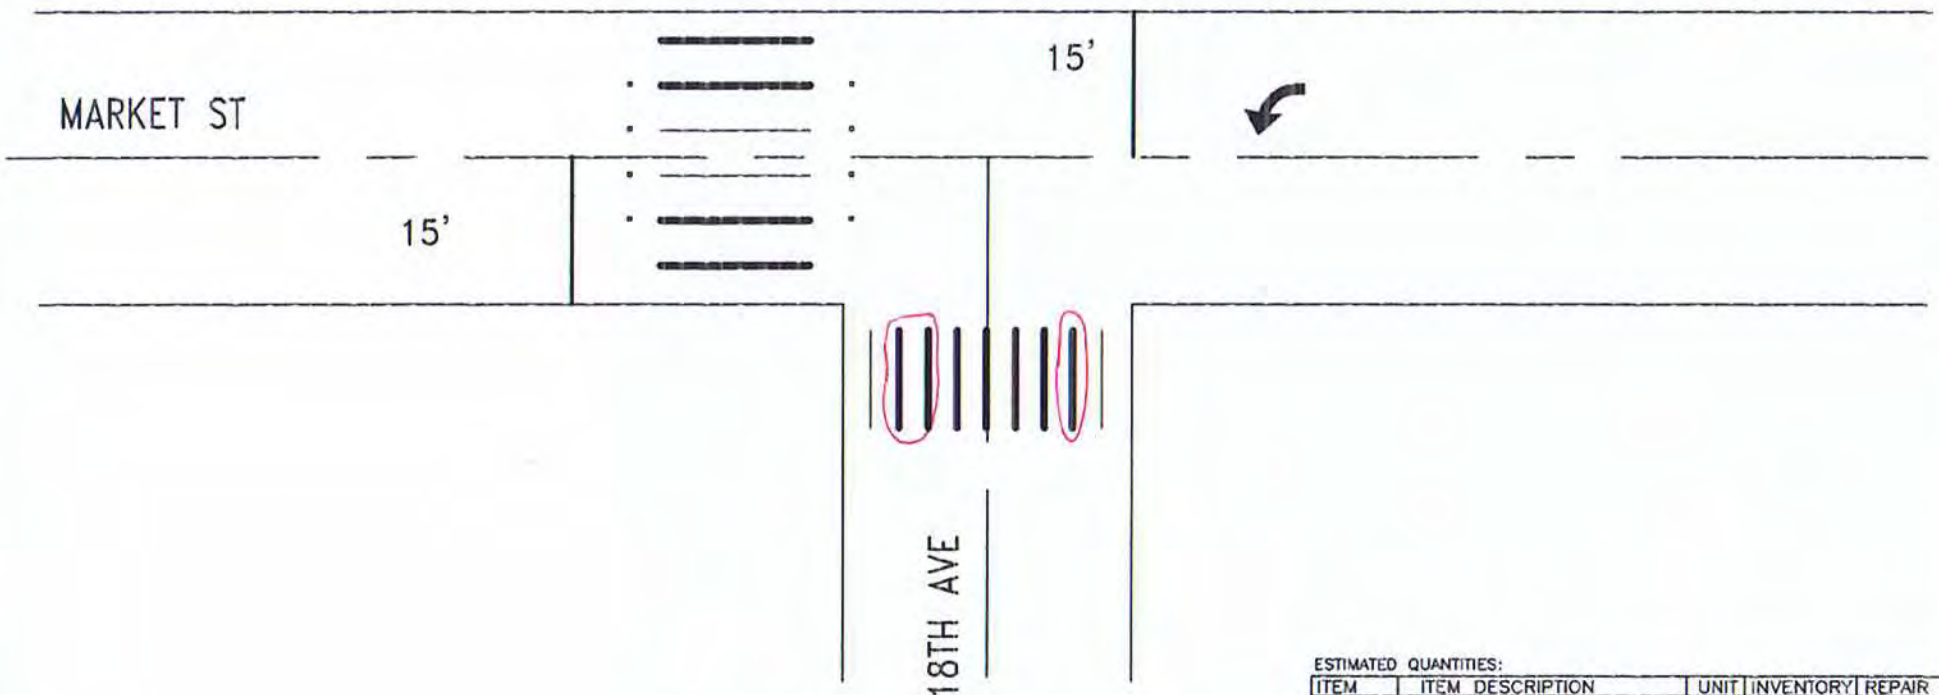

ESTIMATED QUANTITIES:

ITEM	ITEM DESCRIPTION	UNIT	INVENTORY	REPAIR QTY
PL18	PLASTIC STOP BAR, 18"	LF	30	
PLXW	PLASTIC CROSSWALK STRIPE	SF	260	60
PLARW	PLASTIC TRAFFIC ARROW	EA	1	
PLLTR	PLASTIC TRAFFIC LETTER, 8 FT HIGH	EA		
PLRR	PLASTIC RAILROAD SYMBOL	EA		
RPLSYM	REMOVE PL. ARROW, LETTER, SYMBOL	EA		
RRPM	REMOVE RPM	EA		
RPLXW	REMOVE PLASTIC STRIPE	SF		40
RPM11	TYPE II RPM	EA	8	

CITY OF KIRKLAND
DEPARTMENT OF PUBLIC WORKS
123 FIFTH AVENUE KIRKLAND, WA 98033
(425) 587-3800 www.kirklandwa.gov

G. HORTILLOSA 10/2012
DESIGNED BY: DATE

J.JENNINGS 10/2012
DRAWN BY: DATE

CHECKED BY: DATE

2022 PAVEMENT MARKING PROGRAM

STREET: MARKET ST

CROSS STREET: 18TH AVE

SEGMENT: 140-#10

SCALE: N.T.S.

FILENAME: Page 6-19

NO SCALE

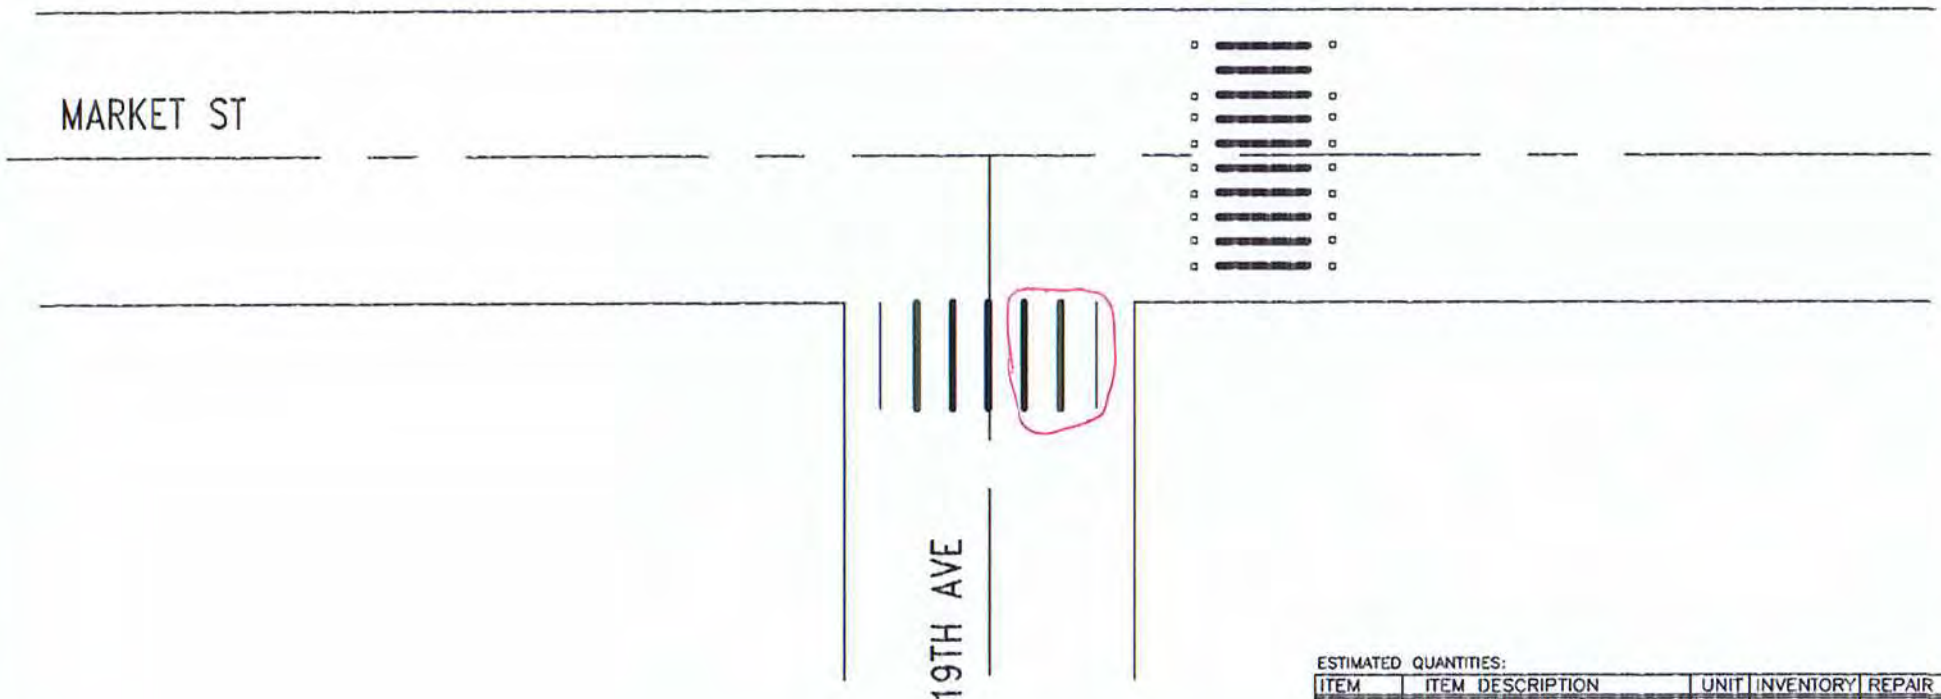

ESTIMATED QUANTITIES:

ITEM	ITEM DESCRIPTION	UNIT	INVENTORY	REPAIR QTY
PL18	PLASTIC STOP BAR, 18"	LF		
PLXW	PLASTIC CROSSWALK STRIPE	SF	320	30
PLARW	PLASTIC TRAFFIC ARROW	EA		
PLLTR	PLASTIC TRAFFIC LETTER, 8 FT HIGH	EA		
PLRR	PLASTIC RAILROAD SYMBOL	EA		
RPLSYM	REMOVE PL. ARROW, LETTER, SYMBOL	EA		
RRPM	REMOVE RPM	EA		
RPLXW	REMOVE PLASTIC STRIPE	SF		30
RPM11	TYPE II RPM	EA	18	

CITY OF KIRKLAND WASHINGTON

CITY OF KIRKLAND
DEPARTMENT OF PUBLIC WORKS
123 FIFTH AVENUE KIRKLAND, WA 98033
(425) 587-3800 www.kirklandwa.gov

G. HORTILLOSA 10/2012
DESIGNED BY: DATE

J.JENNINGS 10/2012
DRAWN BY: DATE

CHECKED BY: DATE

2020 PAVEMENT MARKING PROGRAM

STREET: MARKET ST

CROSS STREET: 19TH AVE

SEGMENT:

SCALE: N.T.S.

FILENAME: Page 6-20

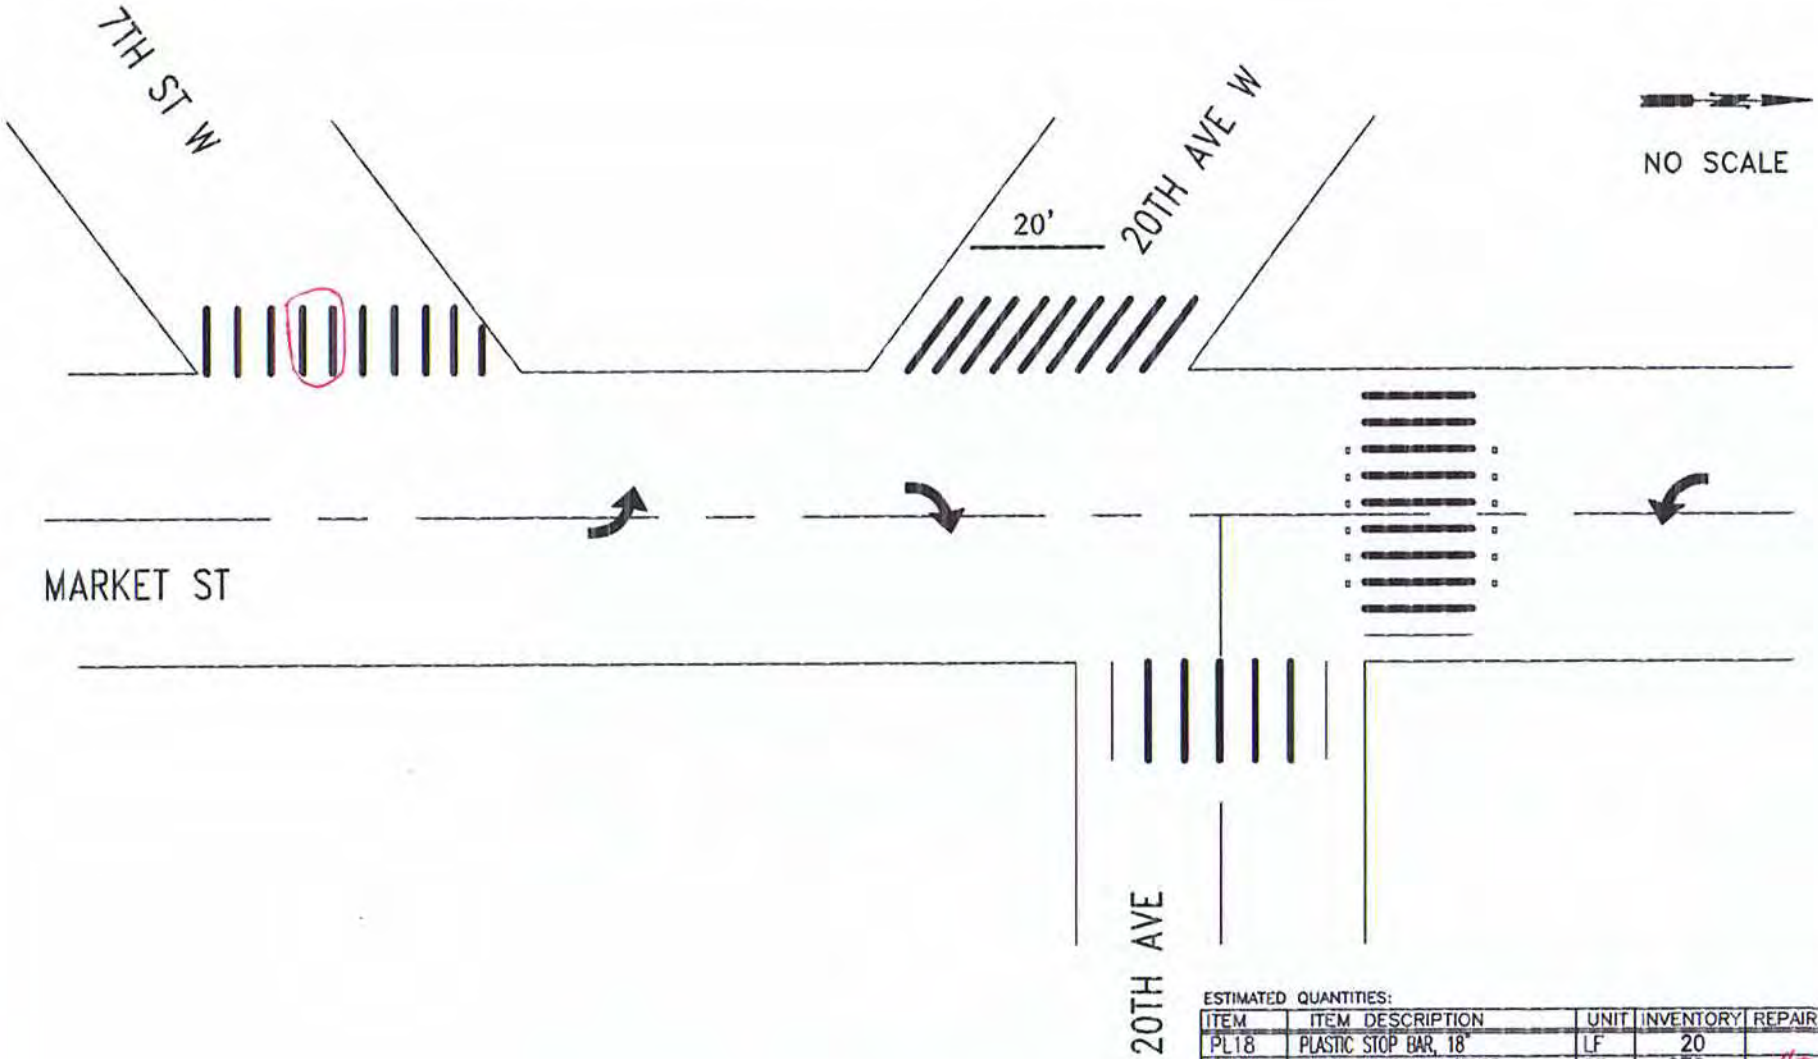

ESTIMATED QUANTITIES:

ITEM	ITEM DESCRIPTION	UNIT	INVENTORY	REPAIR QTY
PL18	PLASTIC STOP BAR, 18"	LF	20	
PLXW	PLASTIC CROSSWALK STRIPE	SF	670	40
PLARW	PLASTIC TRAFFIC ARROW	EA	3	
PLLTR	PLASTIC TRAFFIC LETTER, 8 FT HIGH	EA		
PLRR	PLASTIC RAILROAD SYMBOL	EA		
RPLSYM	REMOVE PL. ARROW, LETTER, SYMBOL	EA		
RRPM	REMOVE RPM	EA		
RPLXW	REMOVE PLASTIC STRIPE	SF		
RPM11	TYPE II RPM	EA	12	

CITY OF KIRKLAND
DEPARTMENT OF PUBLIC WORKS
123 FIFTH AVENUE KIRKLAND, WA 98033
(425) 587-3800 www.kirklandwa.gov

G. HORTILLOSA 10/2012
DESIGNED BY: DATE

J.JENNINGS 10/2012
DRAWN BY: DATE

CHECKED BY: DATE

2020 PAVEMENT MARKING PROGRAM

STREET: MARKET ST

CROSS STREET: 20TH AVE

SEGMENT:

SCALE: N.T.S.

FILENAME:

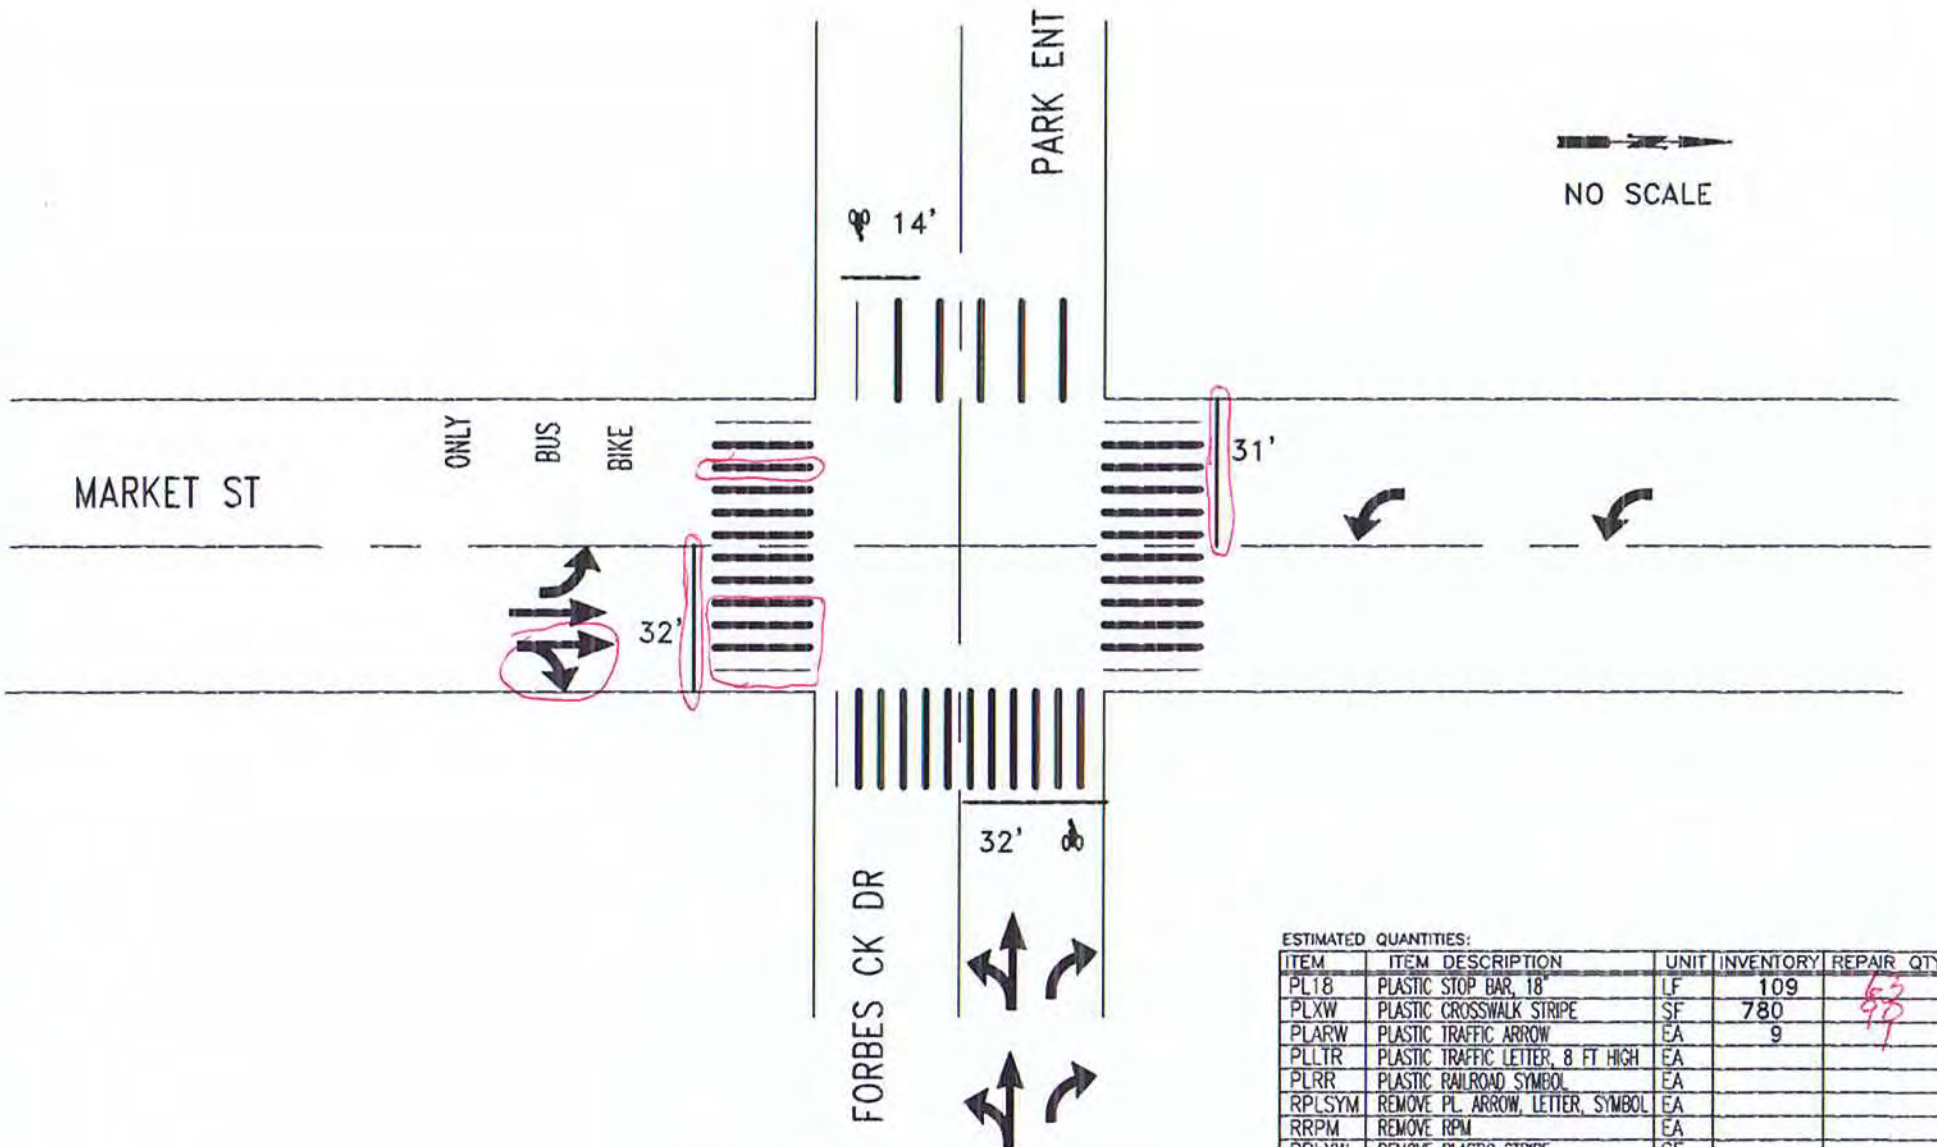

ESTIMATED QUANTITIES:

ITEM	ITEM DESCRIPTION	UNIT	INVENTORY	REPAIR QTY
PL18	PLASTIC STOP BAR, 18"	LF	109	63
PLXW	PLASTIC CROSSWALK STRIPE	SF	780	99
PLARW	PLASTIC TRAFFIC ARROW	EA	9	
PLLTR	PLASTIC TRAFFIC LETTER, 8 FT HIGH	EA		
PLRR	PLASTIC RAILROAD SYMBOL	EA		
RPLSYM	REMOVE PL. ARROW, LETTER, SYMBOL	EA		
RRPM	REMOVE RPM	EA		
RPLXW	REMOVE PLASTIC STRIPE	SF		
	PLASTIC BIKE DETECTION SYMBOL	EA	2	

CITY OF KIRKLAND
DEPARTMENT OF PUBLIC WORKS
123 FIFTH AVENUE KIRKLAND, WA 98033
(425) 587-3800 www.kirklandwa.gov

G. HORTILLOSA 10/2012
DESIGNED BY: DATE

J.JENNINGS 10/2012
DRAWN BY: DATE

CHECKED BY: DATE

2012 PAVEMENT MARKING PROGRAM

STREET: MARKET ST

CROSS STREET: FORBES CREEK DR

SEGMENT:

SCALE: N.T.S.

FILENAME: Page 6-22

NORKIRK
INTERSECTION PLANS

CITY OF KIRKLAND
DEPARTMENT OF PUBLIC WORKS
123 FIFTH AVENUE KIRKLAND, WA 98033
(425) 587-3800 www.kirklandwa.gov

S GONSAR	1/2019	DESIGNED BY: DATE
J.JENNINGS	1/2019	DRAWN BY: DATE
		CHECKED BY: DATE

2020 PAVEMENT MARKING PROGRAM

STREET:

CROSS STREET:

SEGMENT:

SCALE: N.T.S.

FILENAME: 7-0

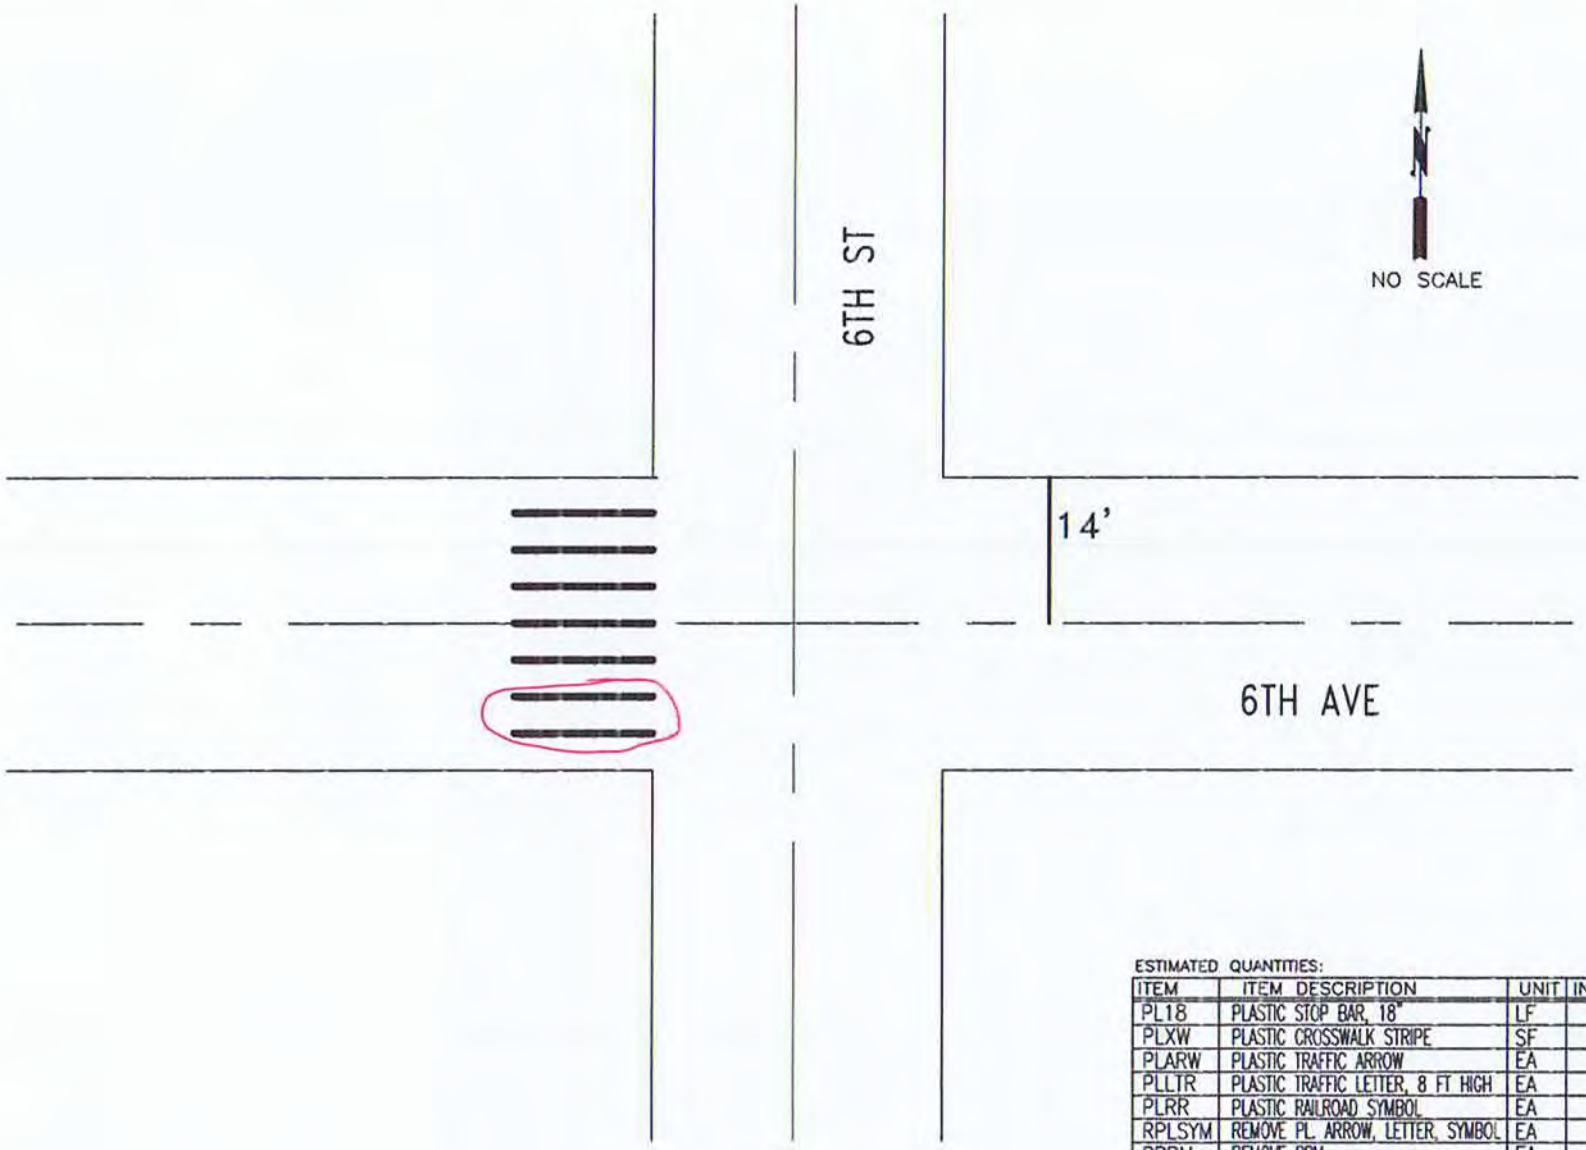

ESTIMATED QUANTITIES:

ITEM	ITEM DESCRIPTION	UNIT	INVENTORY	REPAIR QTY
PL18	PLASTIC STOP BAR, 18"	LF	14	
PLXW	PLASTIC CROSSWALK STRIPE	SF	140	40
PLARW	PLASTIC TRAFFIC ARROW	EA		
PLLTR	PLASTIC TRAFFIC LETTER, 8 FT HIGH	EA		
PLRR	PLASTIC RAILROAD SYMBOL	EA		
RPLSYM	REMOVE PL. ARROW, LETTER, SYMBOL	EA		
RRPM	REMOVE RPM	EA		
RPLXW	REMOVE PLASTIC STRIPE	SF		

CITY OF KIRKLAND WASHINGTON

CITY OF KIRKLAND
DEPARTMENT OF PUBLIC WORKS
123 FIFTH AVENUE KIRKLAND, WA 98033
(425) 587-3800 www.kirklandwa.gov

R. STEITZER 8/2005
DESIGNED BY: DATE

J.JENNINGS 8/2005
DRAWN BY: DATE

CHECKED BY: DATE

2020 PAVEMENT MARKING PROGRAM

STREET: 6TH AVE

CROSS STREET: 6TH ST

SEGMENT:

SCALE: N.T.S.

FILENAME: Page 7-1

REPAINT ALL

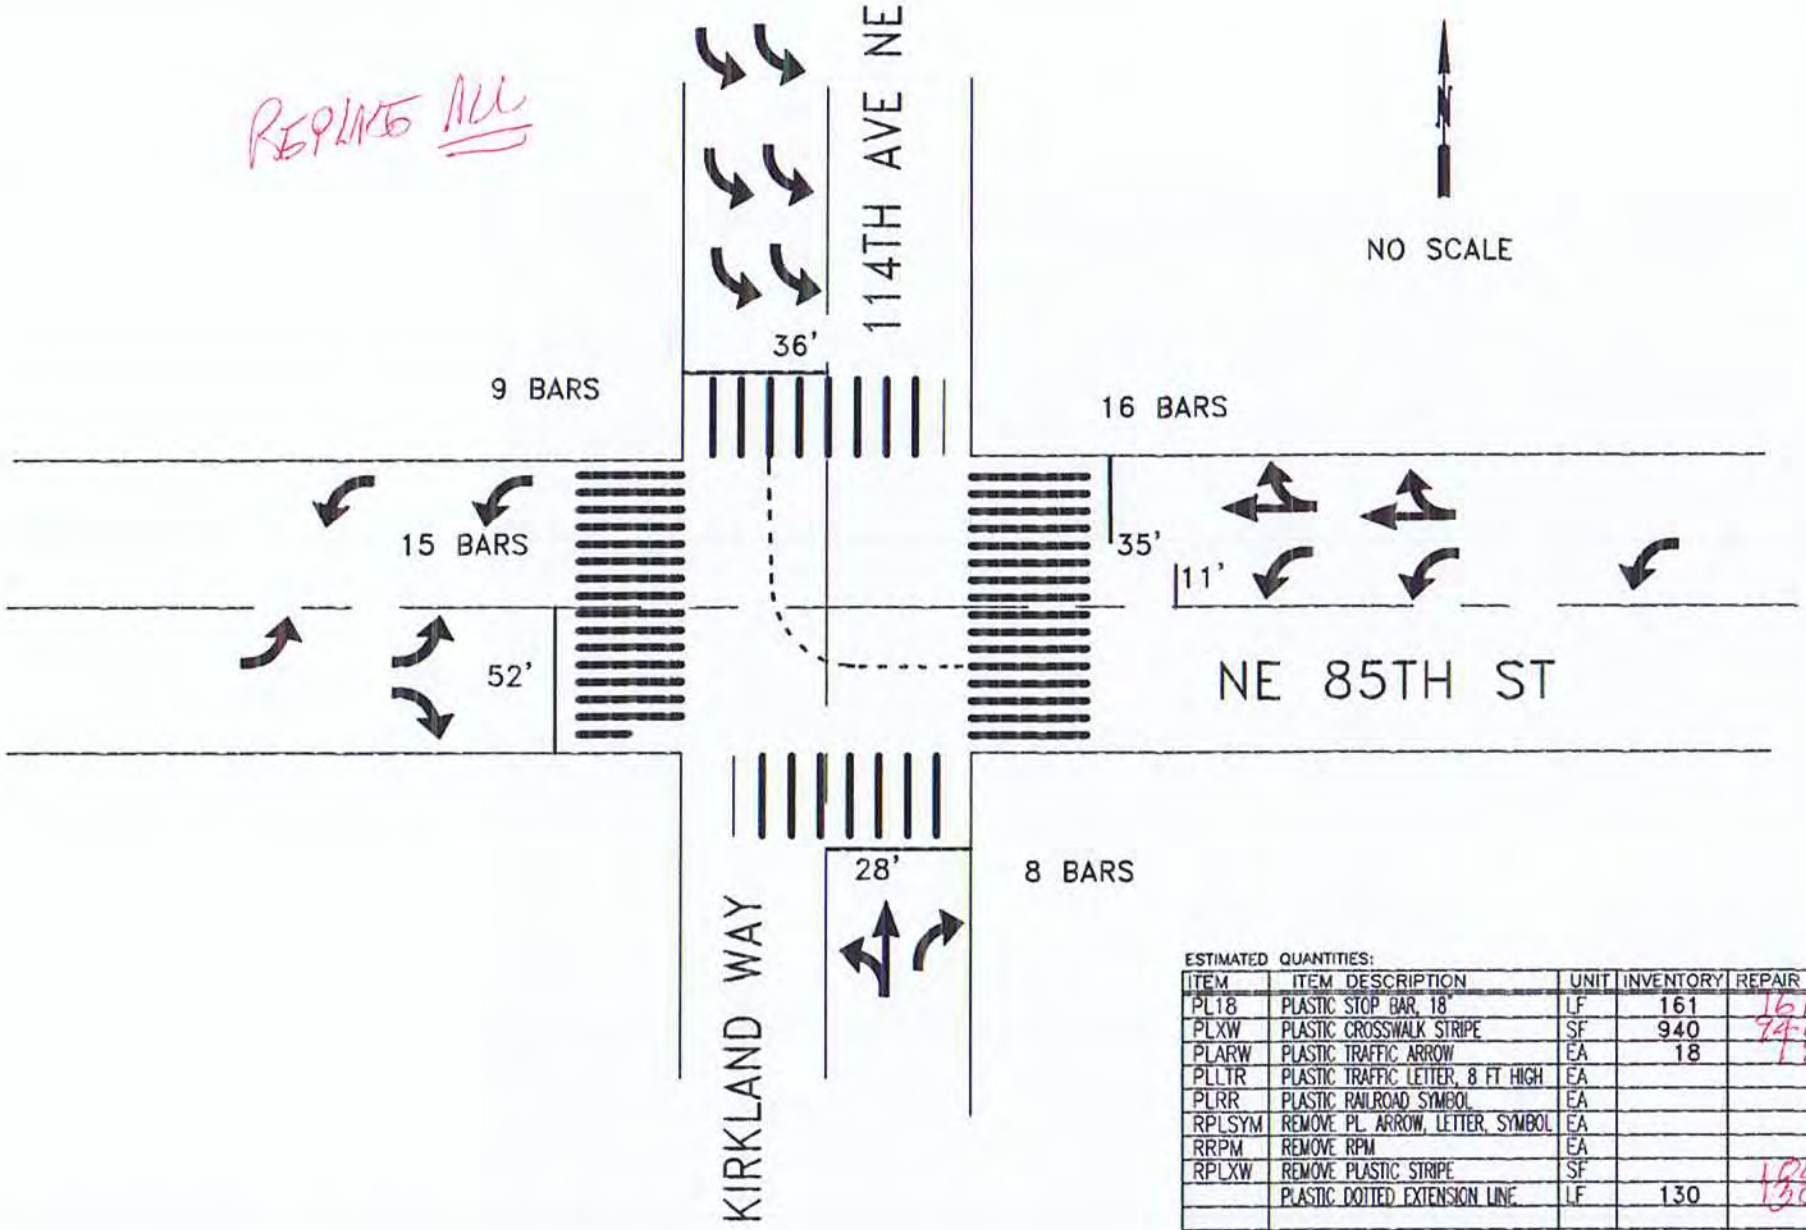

ESTIMATED QUANTITIES:

ITEM	ITEM DESCRIPTION	UNIT	INVENTORY	REPAIR QTY
PL18	PLASTIC STOP BAR, 18"	LF	161	161
PLXW	PLASTIC CROSSWALK STRIPE	SF	940	940
PLARW	PLASTIC TRAFFIC ARROW	EA	18	18
PLLTR	PLASTIC TRAFFIC LETTER, 8 FT HIGH	EA		
PLRR	PLASTIC RAILROAD SYMBOL	EA		
RPLSYM	REMOVE PL. ARROW, LETTER, SYMBOL	EA		
RRPM	REMOVE RPM	EA		
RPLXW	REMOVE PLASTIC STRIPE	SF		180
	PLASTIC DOTTED EXTENSION LINE	LF	130	130

CITY OF KIRKLAND WASHINGTON

CITY OF KIRKLAND
DEPARTMENT OF PUBLIC WORKS
123 FIFTH AVENUE KIRKLAND, WA 98033
(425) 828-1243 www.ci.kirkland.wa.us

G. HORTILLOSA 2/2012
DESIGNED BY: DATE

J.JENNINGS 2/2012
DRAWN BY: DATE

CHECKED BY: DATE

20__ PAVEMENT MARKING PROGRAM

STREET: NE 85TH ST

CROSS STREET: 114TH AVE NE

SEGMENT: 1620-#10

SCALE: N.T.S.

FILENAME: Page 7-2

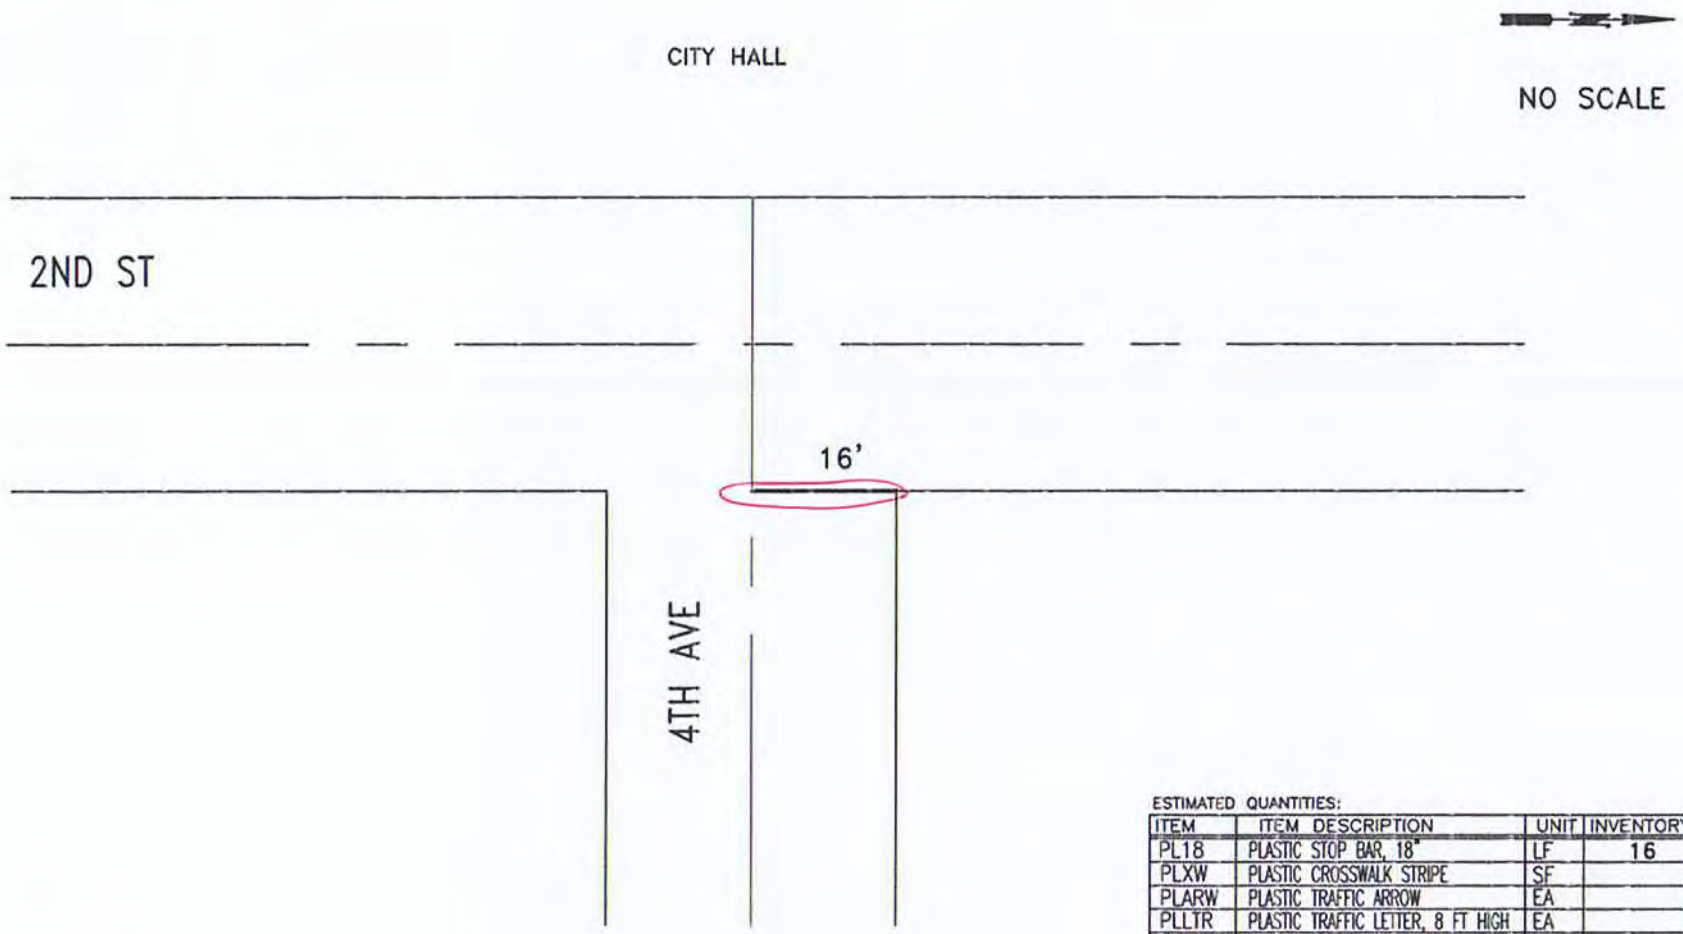

ESTIMATED QUANTITIES:

ITEM	ITEM DESCRIPTION	UNIT	INVENTORY	REPAIR QTY
PL18	PLASTIC STOP BAR, 18"	LF	16	16
PLXW	PLASTIC CROSSWALK STRIPE	SF		
PLARW	PLASTIC TRAFFIC ARROW	EA		
PLLTR	PLASTIC TRAFFIC LETTER, 8 FT HIGH	EA		
PLRR	PLASTIC RAILROAD SYMBOL	EA		
RPLSYM	REMOVE PL. ARROW, LETTER, SYMBOL	EA		
RRPM	REMOVE RPM	EA		
RPLXW	REMOVE PLASTIC STRIPE	SF		

CITY OF KIRKLAND
DEPARTMENT OF PUBLIC WORKS
123 FIFTH AVENUE KIRKLAND, WA 98033
(425) 587-3800 www.kirklandwa.gov

D.GRILLEY 1/2000
DESIGNED BY: DATE

J.JENNINGS 1/2000
DRAWN BY: DATE

CHECKED BY: DATE

2020 PAVEMENT MARKING PROGRAM

STREET: 4TH AVE

CROSS STREET: 2ND ST

SEGMENT:

SCALE: N.T.S.

FILENAME: Page 7-4

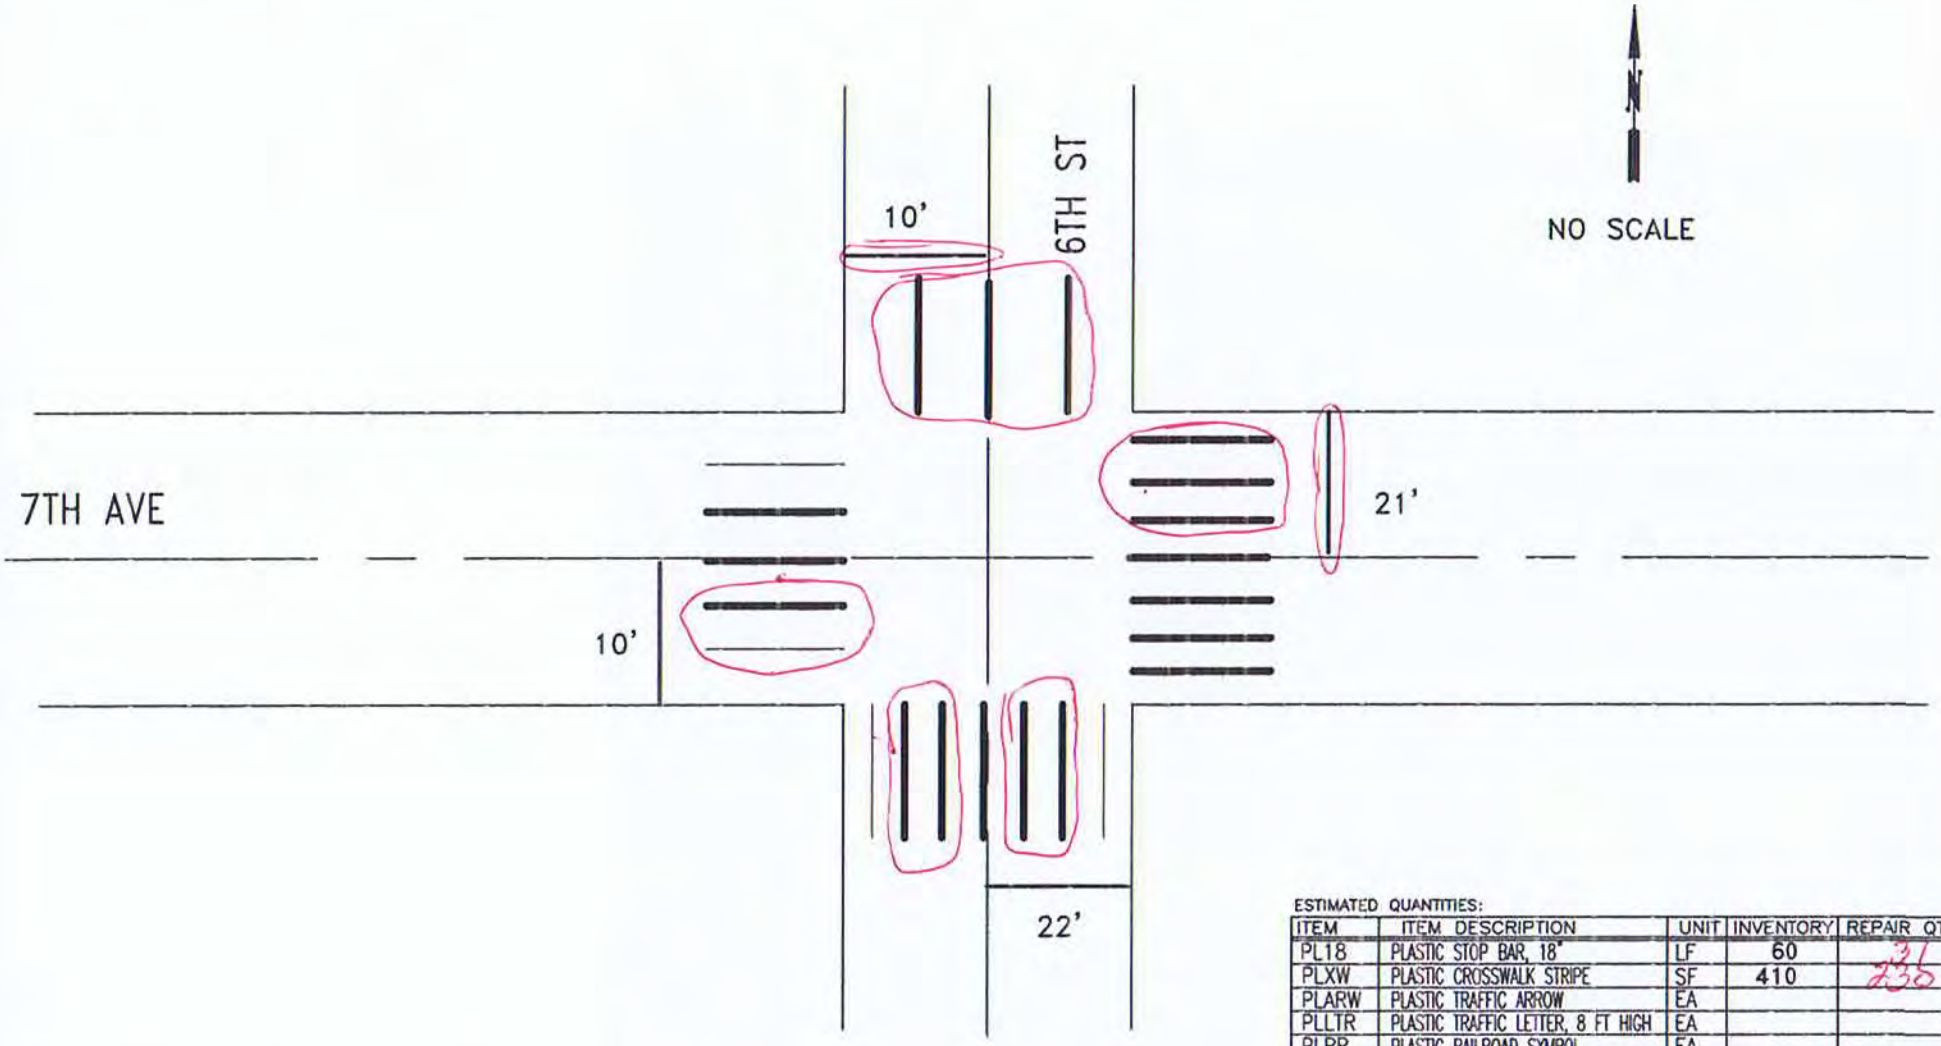

ESTIMATED QUANTITIES:

ITEM	ITEM DESCRIPTION	UNIT	INVENTORY	REPAIR QTY
PL18	PLASTIC STOP BAR, 18"	LF	60	35
PLXW	PLASTIC CROSSWALK STRIPE	SF	410	235
PLARW	PLASTIC TRAFFIC ARROW	EA		
PLLTR	PLASTIC TRAFFIC LETTER, 8 FT HIGH	EA		
PLRR	PLASTIC RAILROAD SYMBOL	EA		
RPLSYM	REMOVE PL. ARROW, LETTER, SYMBOL	EA		
RRPM	REMOVE RPM	EA		
RPLXW	REMOVE PLASTIC STRIPE	SF		80

CITY OF KIRKLAND
DEPARTMENT OF PUBLIC WORKS
123 FIFTH AVENUE KIRKLAND, WA 98033
(425) 587-3800 www.kirklandwa.gov

R STEITZER 10/2004
DESIGNED BY: DATE

J.JENNINGS 10/2004
DRAWN BY: DATE

CHECKED BY: DATE

2020 PAVEMENT MARKING PROGRAM

STREET: 7TH AVE

CROSS STREET: 6TH ST

SEGMENT:

SCALE: N.T.S.

FILENAME: Page 7-6

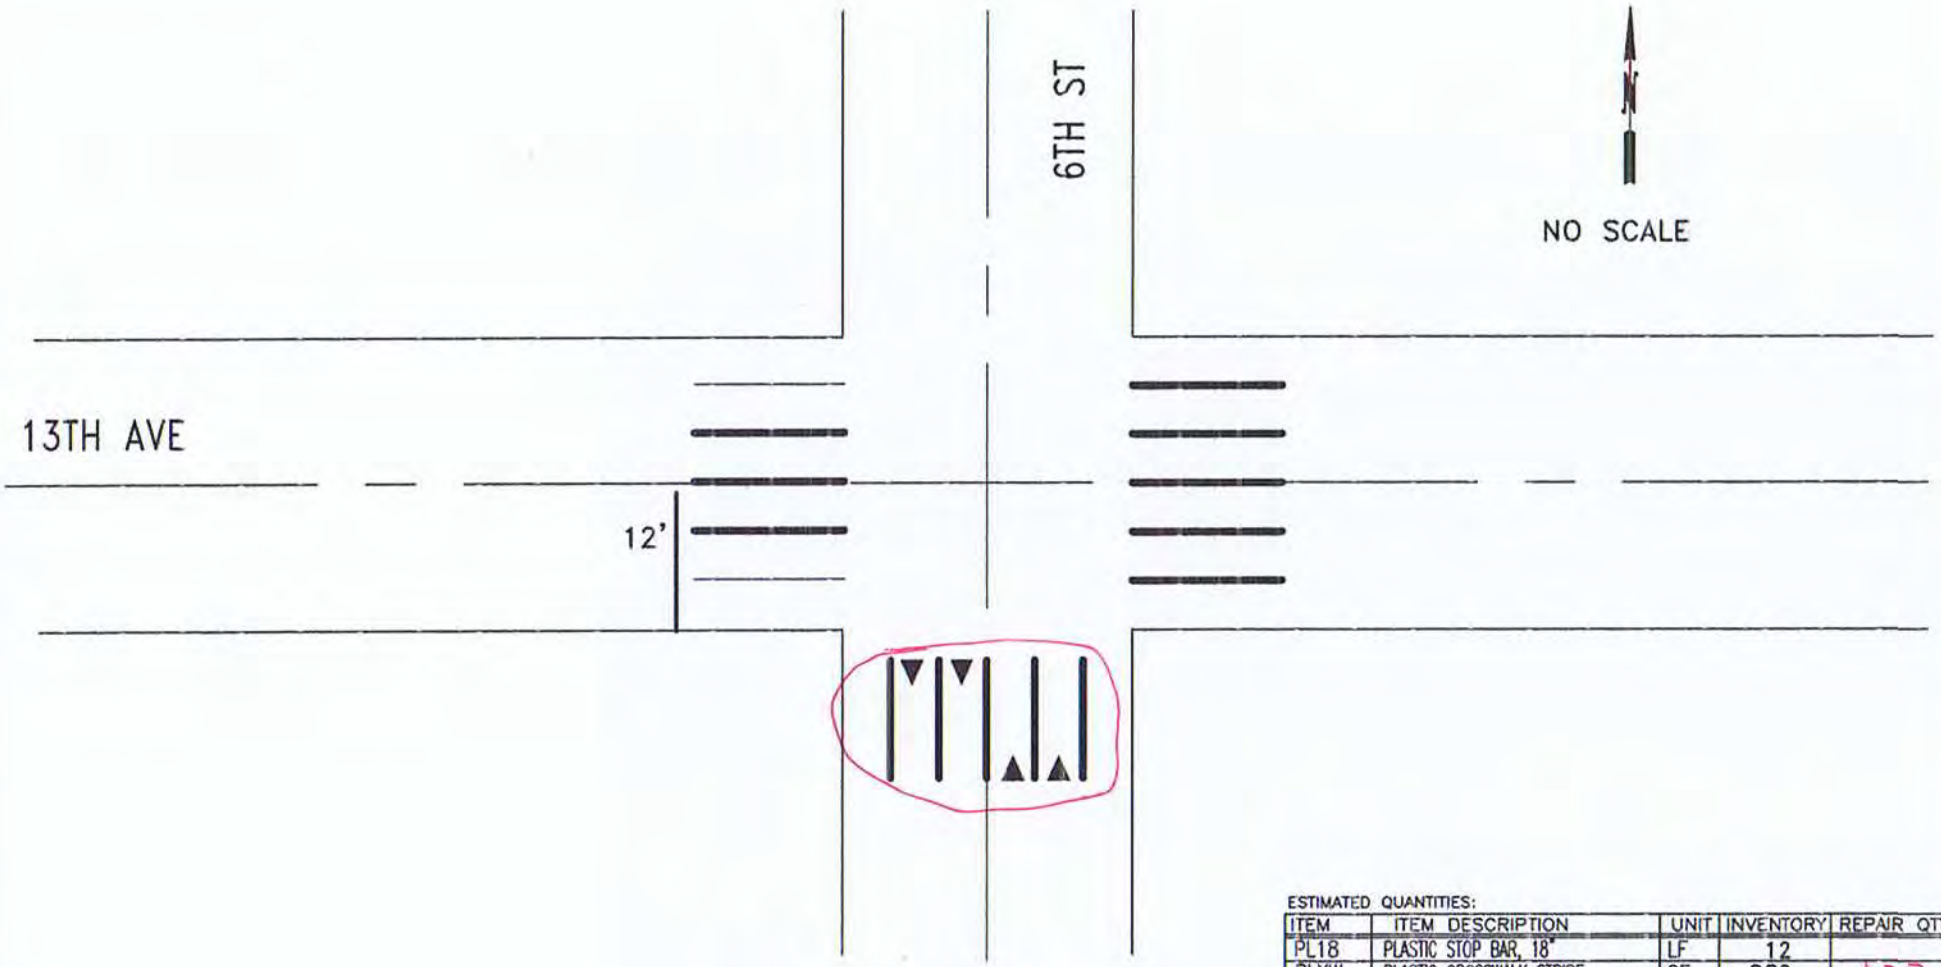

ESTIMATED QUANTITIES:

ITEM	ITEM DESCRIPTION	UNIT	INVENTORY	REPAIR QTY
PL18	PLASTIC STOP BAR, 18"	LF	12	
PLXW	PLASTIC CROSSWALK STRIPE	SF	280	100
PLARW	PLASTIC TRAFFIC ARROW	EA		
PLLTR	PLASTIC TRAFFIC LETTER, 8 FT HIGH	EA		
PLRR	PLASTIC RAILROAD SYMBOL	EA		
RPLSYM	REMOVE PL. ARROW, LETTER, SYMBOL	EA		
RRPM	REMOVE RPM	EA		
RPLXW	REMOVE PLASTIC STRIPE	SF		12P 18
	PLASTIC YIELD SYMBOL	SF	18	

CITY OF KIRKLAND
DEPARTMENT OF PUBLIC WORKS
123 FIFTH AVENUE KIRKLAND, WA 98033
(425) 587-3800 www.kirklandwa.gov

G. HORTILLOSA 4/2007
DESIGNED BY: DATE

J.JENNINGS 4/2007
DRAWN BY: DATE

CHECKED BY: DATE

2020 PAVEMENT MARKING PROGRAM

STREET: 6TH ST

CROSS STREET: 13TH AVE

SEGMENT:

SCALE: N.T.S.

FILENAME: Page 7-9

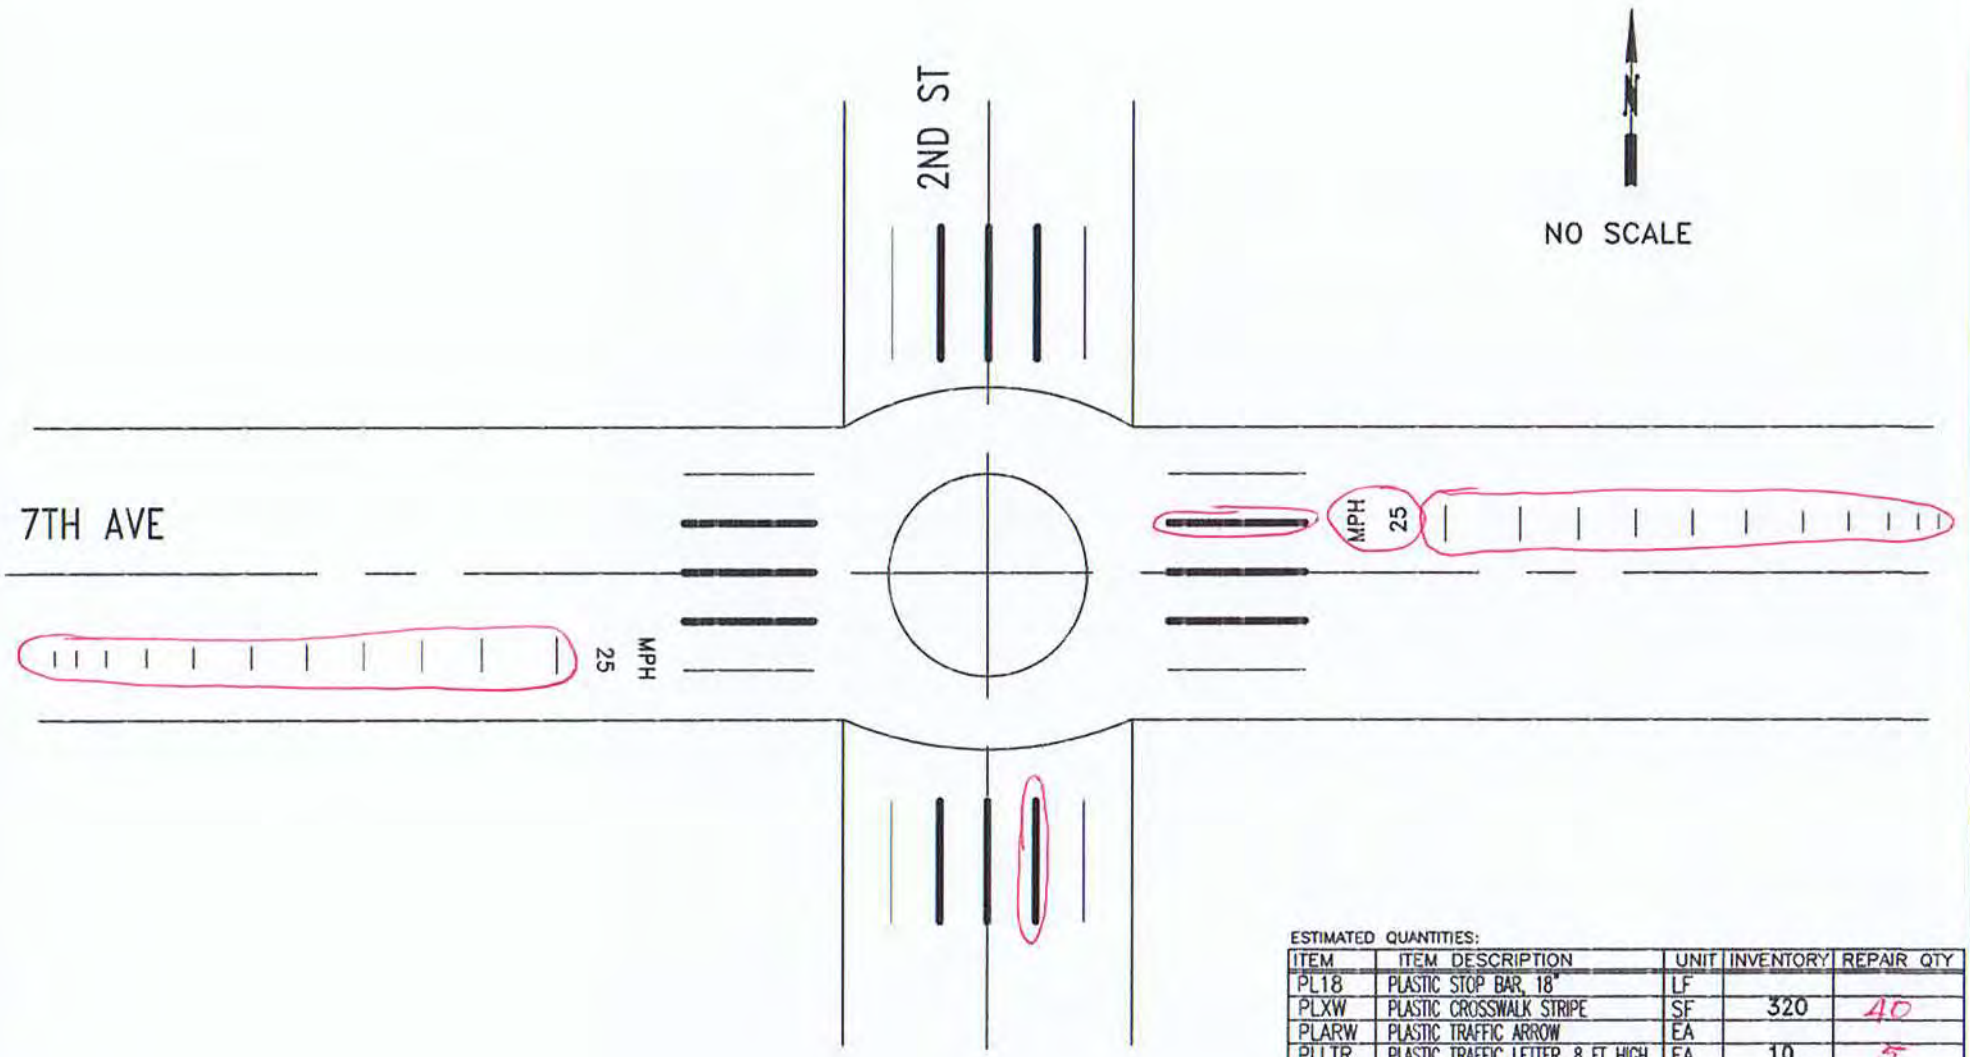

ESTIMATED QUANTITIES:

ITEM	ITEM DESCRIPTION	UNIT	INVENTORY	REPAIR QTY
PL18	PLASTIC STOP BAR, 18"	LF		
PLXW	PLASTIC CROSSWALK STRIPE	SF	320	40
PLARW	PLASTIC TRAFFIC ARROW	EA		
PLLTR	PLASTIC TRAFFIC LETTER, 8 FT HIGH	EA	10	5
PLRR	PLASTIC RAILROAD SYMBOL	EA		
RPLSYM	REMOVE PL. ARROW, LETTER, SYMBOL	EA		2
RRPM	REMOVE RPM	EA		
RPLXW	REMOVE PLASTIC STRIPE	SF		
PLLGD	PLASTIC SPEED LEGEND BARS	EA	124	37
	PAINT STRIPE 2' STRIPE/4'SKIP	LF	78	

CITY OF KIRKLAND
DEPARTMENT OF PUBLIC WORKS
123 FIFTH AVENUE KIRKLAND, WA 98033
(425) 587-3800 www.kirklandwa.gov

G. HORTILLOSA 4/2008
DESIGNED BY: DATE

J.JENNINGS 4/2008
DRAWN BY: DATE

CHECKED BY: DATE

2020 PAVEMENT MARKING PROGRAM

STREET: 7TH AVE

CROSS STREET: 2ND ST

SEGMENT:

SCALE: N.T.S.

FILENAME: Page 7-14

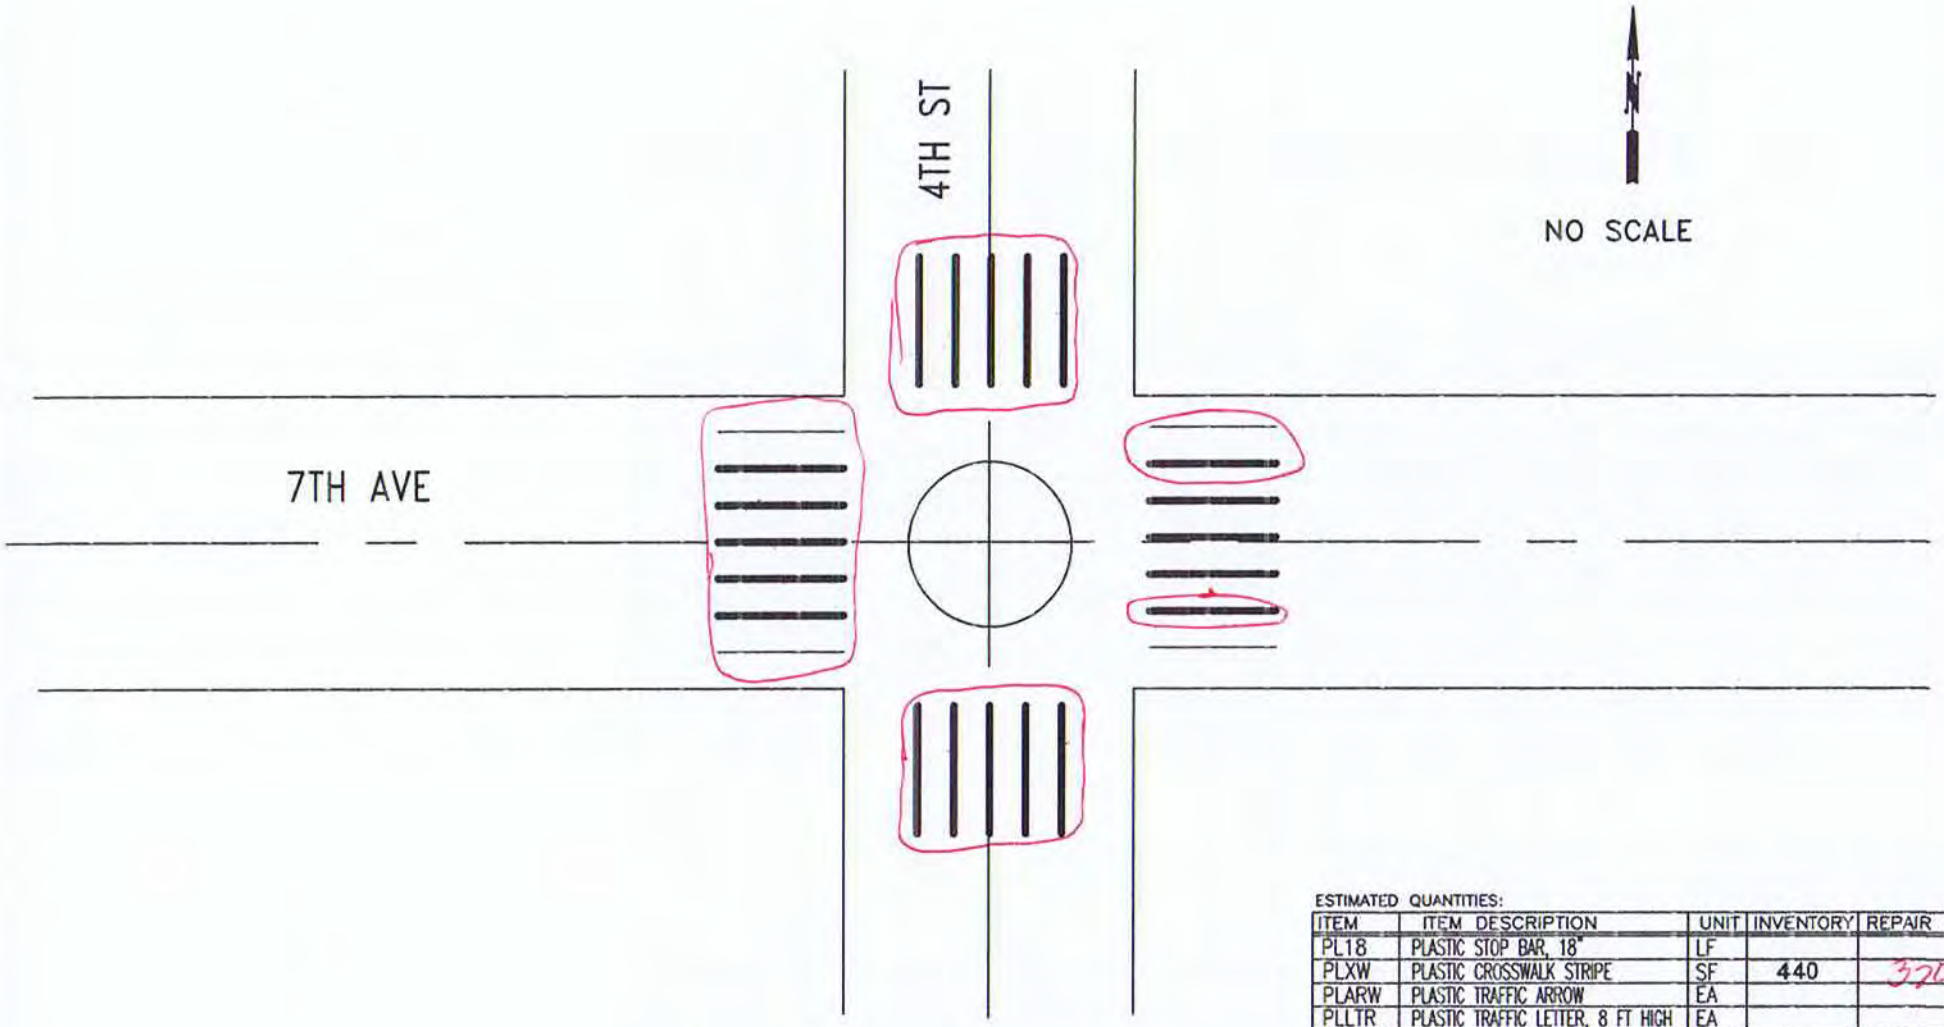

ESTIMATED QUANTITIES:

ITEM	ITEM DESCRIPTION	UNIT	INVENTORY	REPAIR QTY
PL18	PLASTIC STOP BAR, 18"	LF		
PLXW	PLASTIC CROSSWALK STRIPE	SF	440	320
PLARW	PLASTIC TRAFFIC ARROW	EA		
PLLTR	PLASTIC TRAFFIC LETTER, 8 FT HIGH	EA		
PLRR	PLASTIC RAILROAD SYMBOL	EA		
RPLSYM	REMOVE PL. ARROW, LETTER, SYMBOL	EA		
RRPM	REMOVE RPM	EA		
RPLXW	REMOVE PLASTIC STRIPE	SF		160

CITY OF KIRKLAND
DEPARTMENT OF PUBLIC WORKS
123 FIFTH AVENUE KIRKLAND, WA 98033
(425) 587-3800 www.kirklandwa.gov

A. KHANAL 10/2015
DESIGNED BY: DATE

J.JENNINGS 10/2015
DRAWN BY: DATE

CHECKED BY: DATE

2020 PAVEMENT MARKING PROGRAM

STREET: 7TH AVE

CROSS STREET: 4TH ST

SEGMENT:

SCALE: N.T.S.

FILENAME: Page 7-15

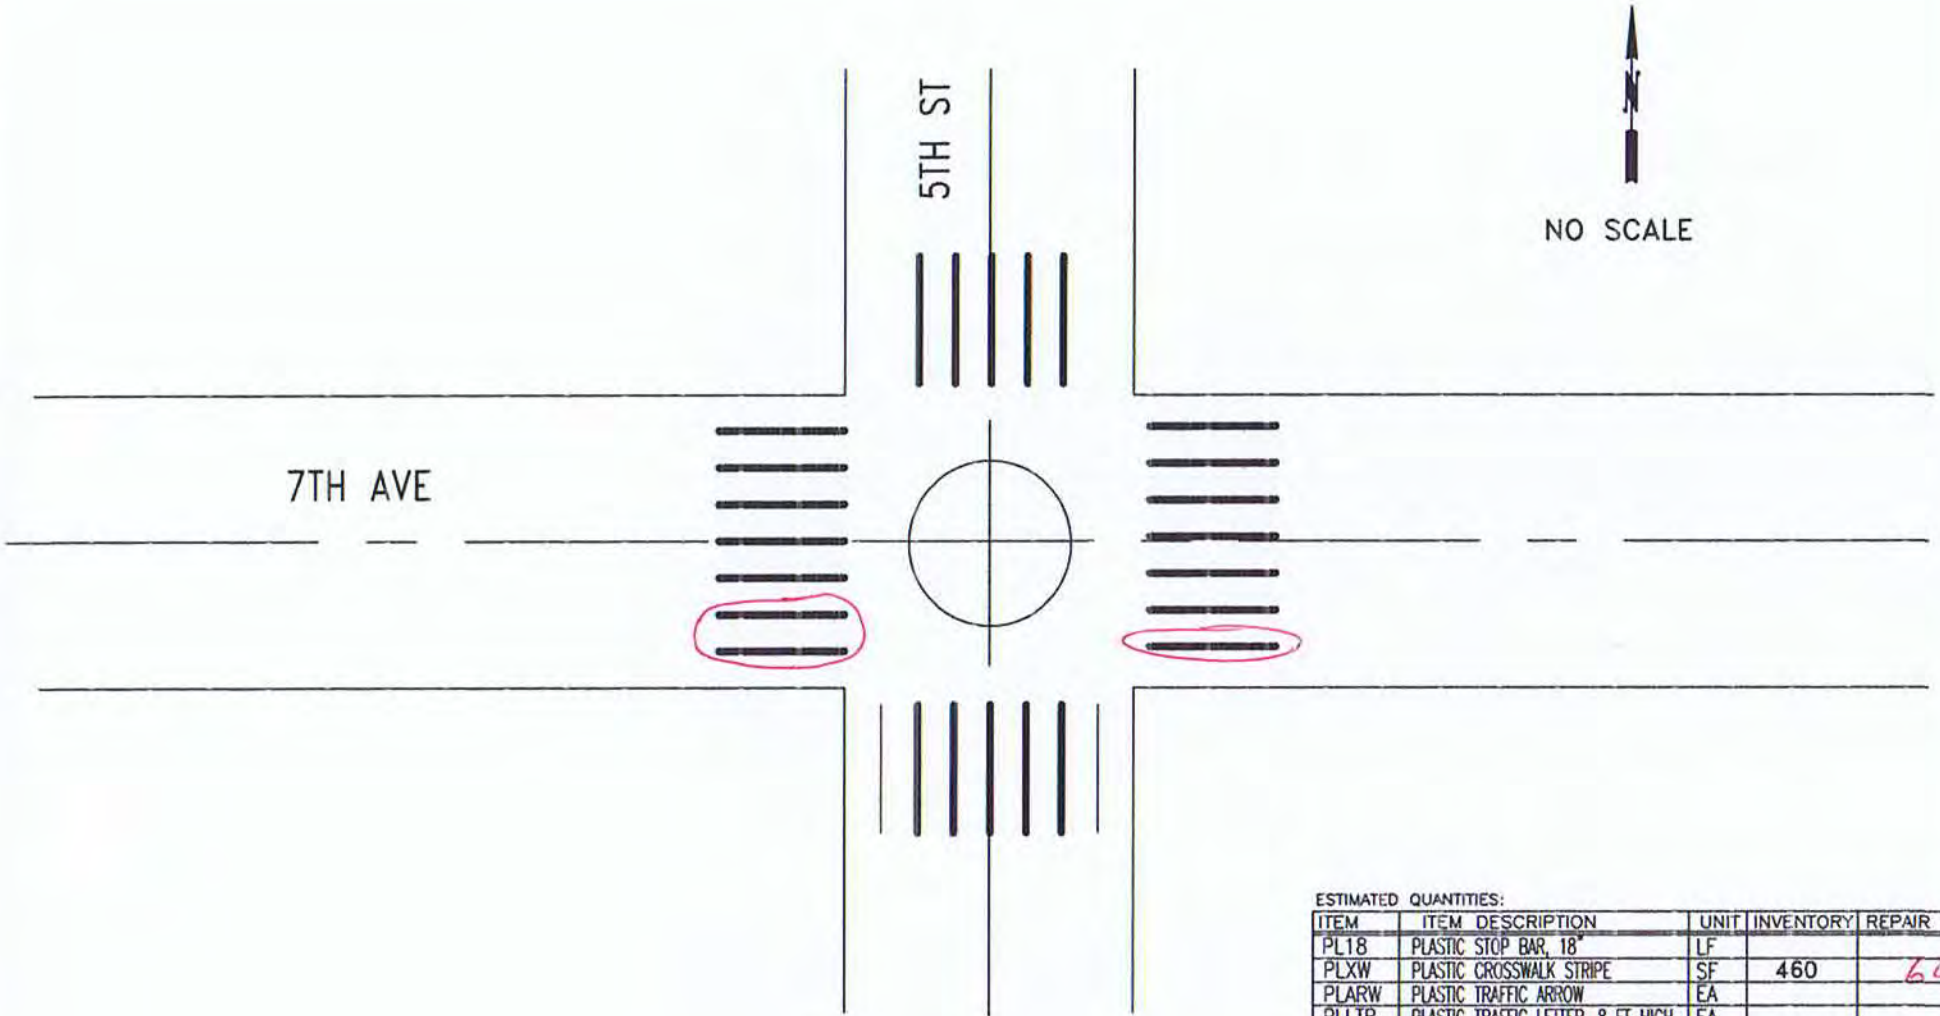

ESTIMATED QUANTITIES:

ITEM	ITEM DESCRIPTION	UNIT	INVENTORY	REPAIR QTY
PL18	PLASTIC STOP BAR, 18"	LF		
PLXW	PLASTIC CROSSWALK STRIPE	SF	460	60
PLARW	PLASTIC TRAFFIC ARROW	EA		
PLLTR	PLASTIC TRAFFIC LETTER, 8 FT HIGH	EA		
PLRR	PLASTIC RAILROAD SYMBOL	EA		
RPLSYM	REMOVE PL. ARROW, LETTER, SYMBOL	EA		
RRPM	REMOVE RPM	EA		
RPLXW	REMOVE PLASTIC STRIPE	SF		60

CITY OF KIRKLAND WASHINGTON

CITY OF KIRKLAND
DEPARTMENT OF PUBLIC WORKS
123 FIFTH AVENUE KIRKLAND, WA 98033
(425) 587-3800 www.kirklandwa.gov

A. KHANAL 10/2015
DESIGNED BY: DATE

J.JENNINGS 10/2015
DRAWN BY: DATE

CHECKED BY: DATE

2020 PAVEMENT MARKING PROGRAM

STREET: 7TH AVE

CROSS STREET: 5TH ST

SEGMENT:

SCALE: N.T.S.

FILENAME: Page 7-15A

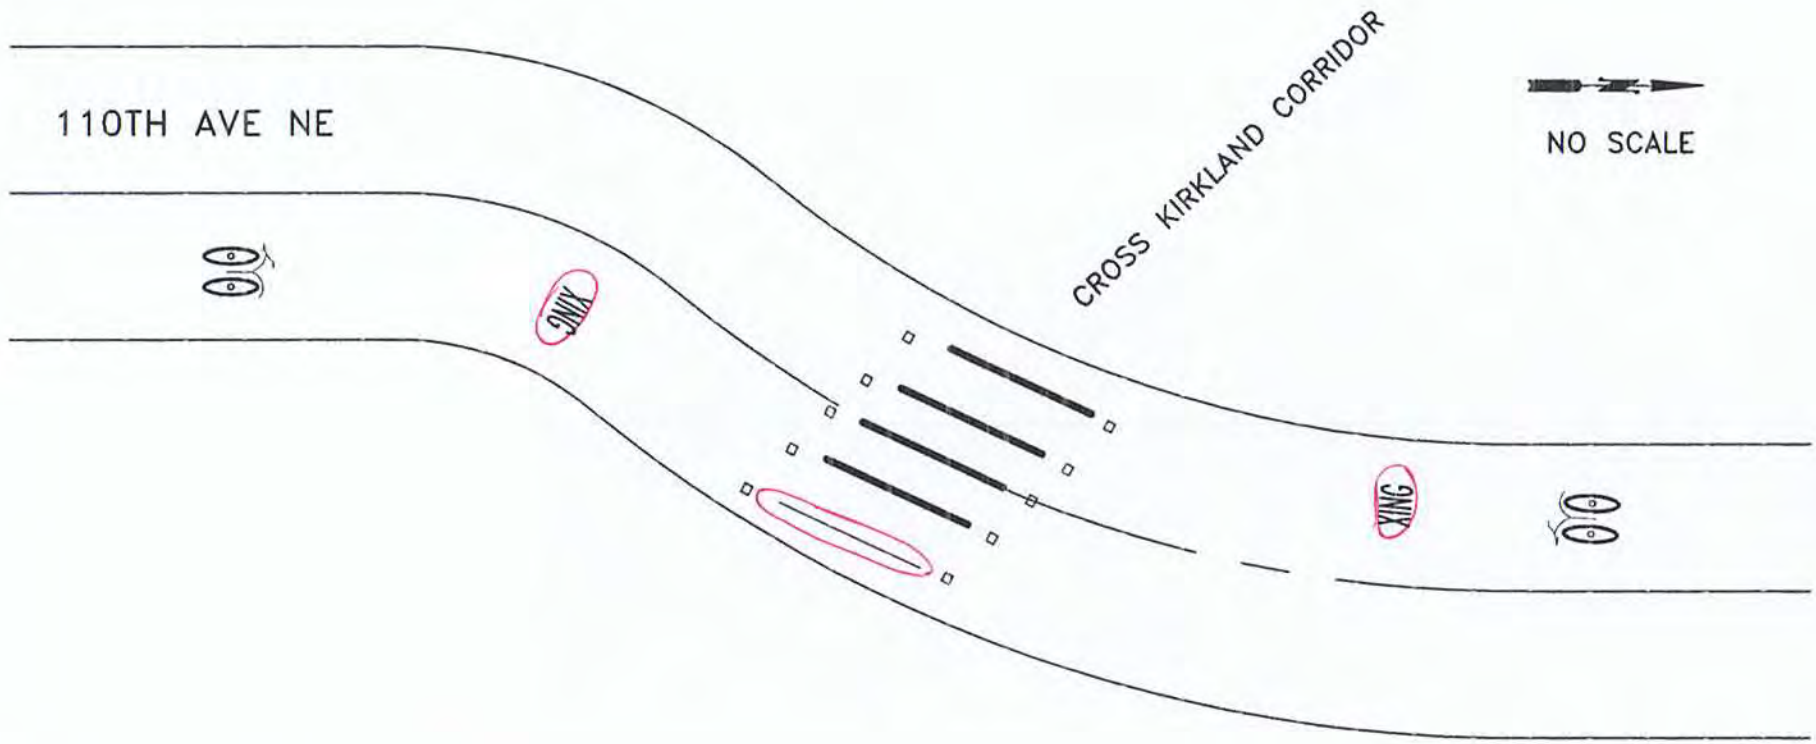

ESTIMATED QUANTITIES:

ITEM	ITEM DESCRIPTION	UNIT	INVENTORY	REPAIR QTY
PL18	PLASTIC STOP BAR, 18"	LF		
PLXW	PLASTIC CROSSWALK STRIPE	SF	90	10
PLARW	PLASTIC TRAFFIC ARROW	EA		
PLLTR	PLASTIC TRAFFIC LETTER, 8 FT HIGH	EA	8	8
	PLASTIC BICYCLE SYMBOL	EA	2	
PLRR24	PLASTIC RAILROAD STOP BAR 24"	SF		
RPLSYM	REMOVE PL. ARROW, LETTER, SYMBOL	EA		
RRPM	REMOVE RPM	EA		
RPLXW	REMOVE PLASTIC STRIPE	SF		
	RAISED PAVEMENT MARKER TYPE 2	EA	10	

CITY OF KIRKLAND
DEPARTMENT OF PUBLIC WORKS
123 FIFTH AVENUE KIRKLAND, WA 98033
(425) 587-3800 www.kirklandwa.gov

L. KAWAOKA 12/2016
DESIGNED BY: DATE

J.JENNINGS 12/2016
DRAWN BY: DATE

CHECKED BY: DATE

2020 PAVEMENT MARKING PROGRAM

STREET: 110TH AVE NE

CROSS STREET: CROSS KIRKLAND CORRIDOR

SEGMENT:

SCALE: N.T.S.

FILENAME: Page 7-17

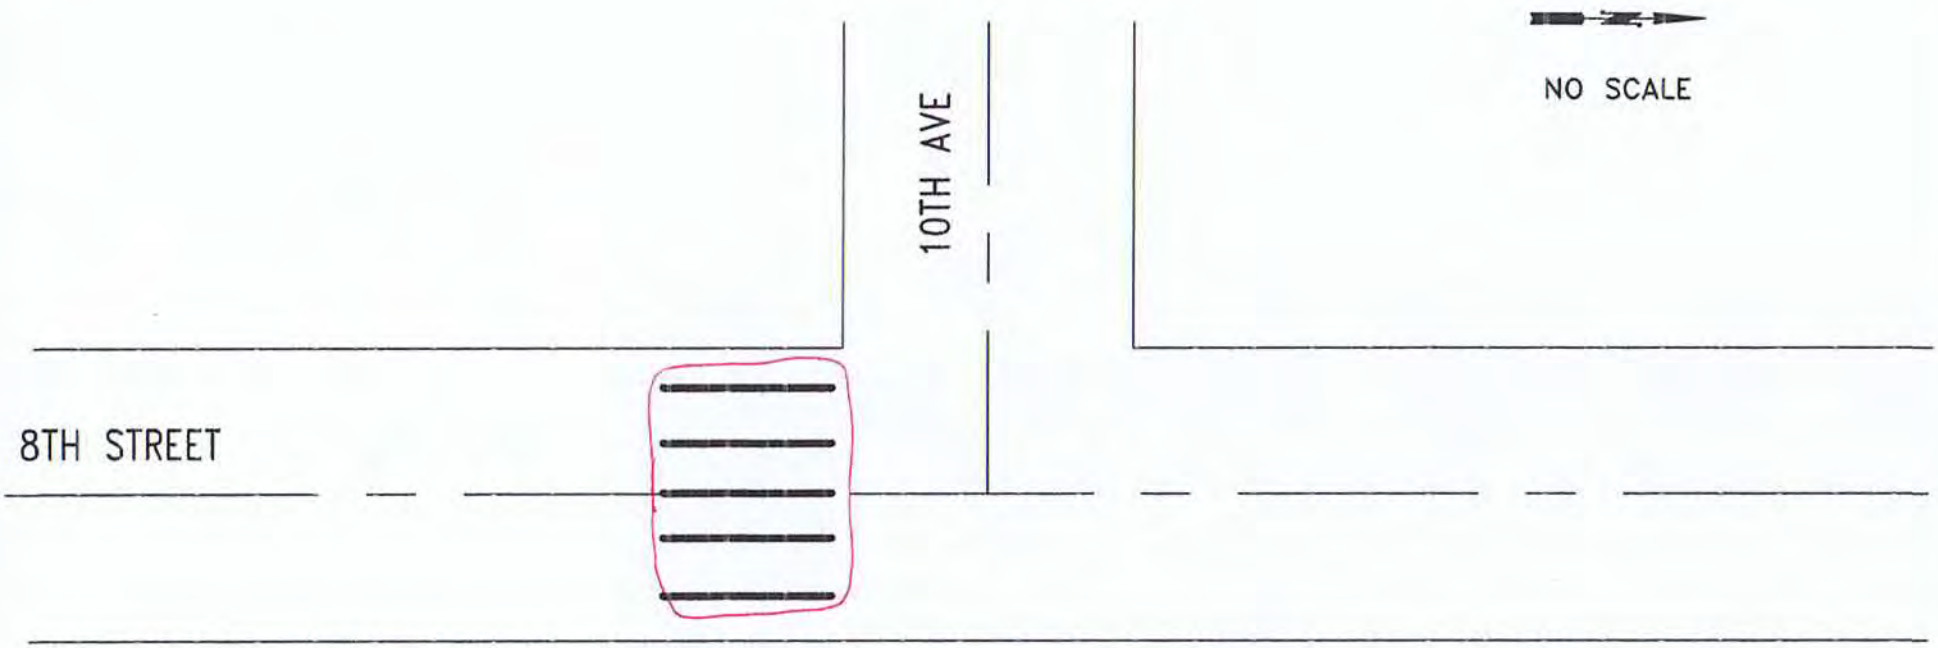

ESTIMATED QUANTITIES:

ITEM	ITEM DESCRIPTION	UNIT	INVENTORY	REPAIR QTY
PL18	PLASTIC STOP BAR, 18"	LF		
PLXW	PLASTIC CROSSWALK STRIPE	SF	100	100
PLARW	PLASTIC TRAFFIC ARROW	EA		
PLLTR	PLASTIC TRAFFIC LETTER, 8 FT HIGH	EA		
PLRR	PLASTIC RAILROAD SYMBOL	EA		
RPLSYM	REMOVE PL. ARROW, LETTER, SYMBOL	EA		
RRPM	REMOVE RPM	EA		
RPLXW	REMOVE PLASTIC STRIPE	SF		40

CITY OF KIRKLAND
DEPARTMENT OF PUBLIC WORKS
123 FIFTH AVENUE KIRKLAND, WA 98033
(425) 587-3800 www.kirklandwa.gov

P. HERBIG 4/2014
DESIGNED BY: DATE

J.JENNINGS 4/2014
DRAWN BY: DATE

CHECKED BY: DATE

2020 PAVEMENT MARKING PROGRAM

STREET: 8TH STREET

CROSS STREET: 10TH AVENUE

SEGMENT:

SCALE: N.T.S.

FILENAME:

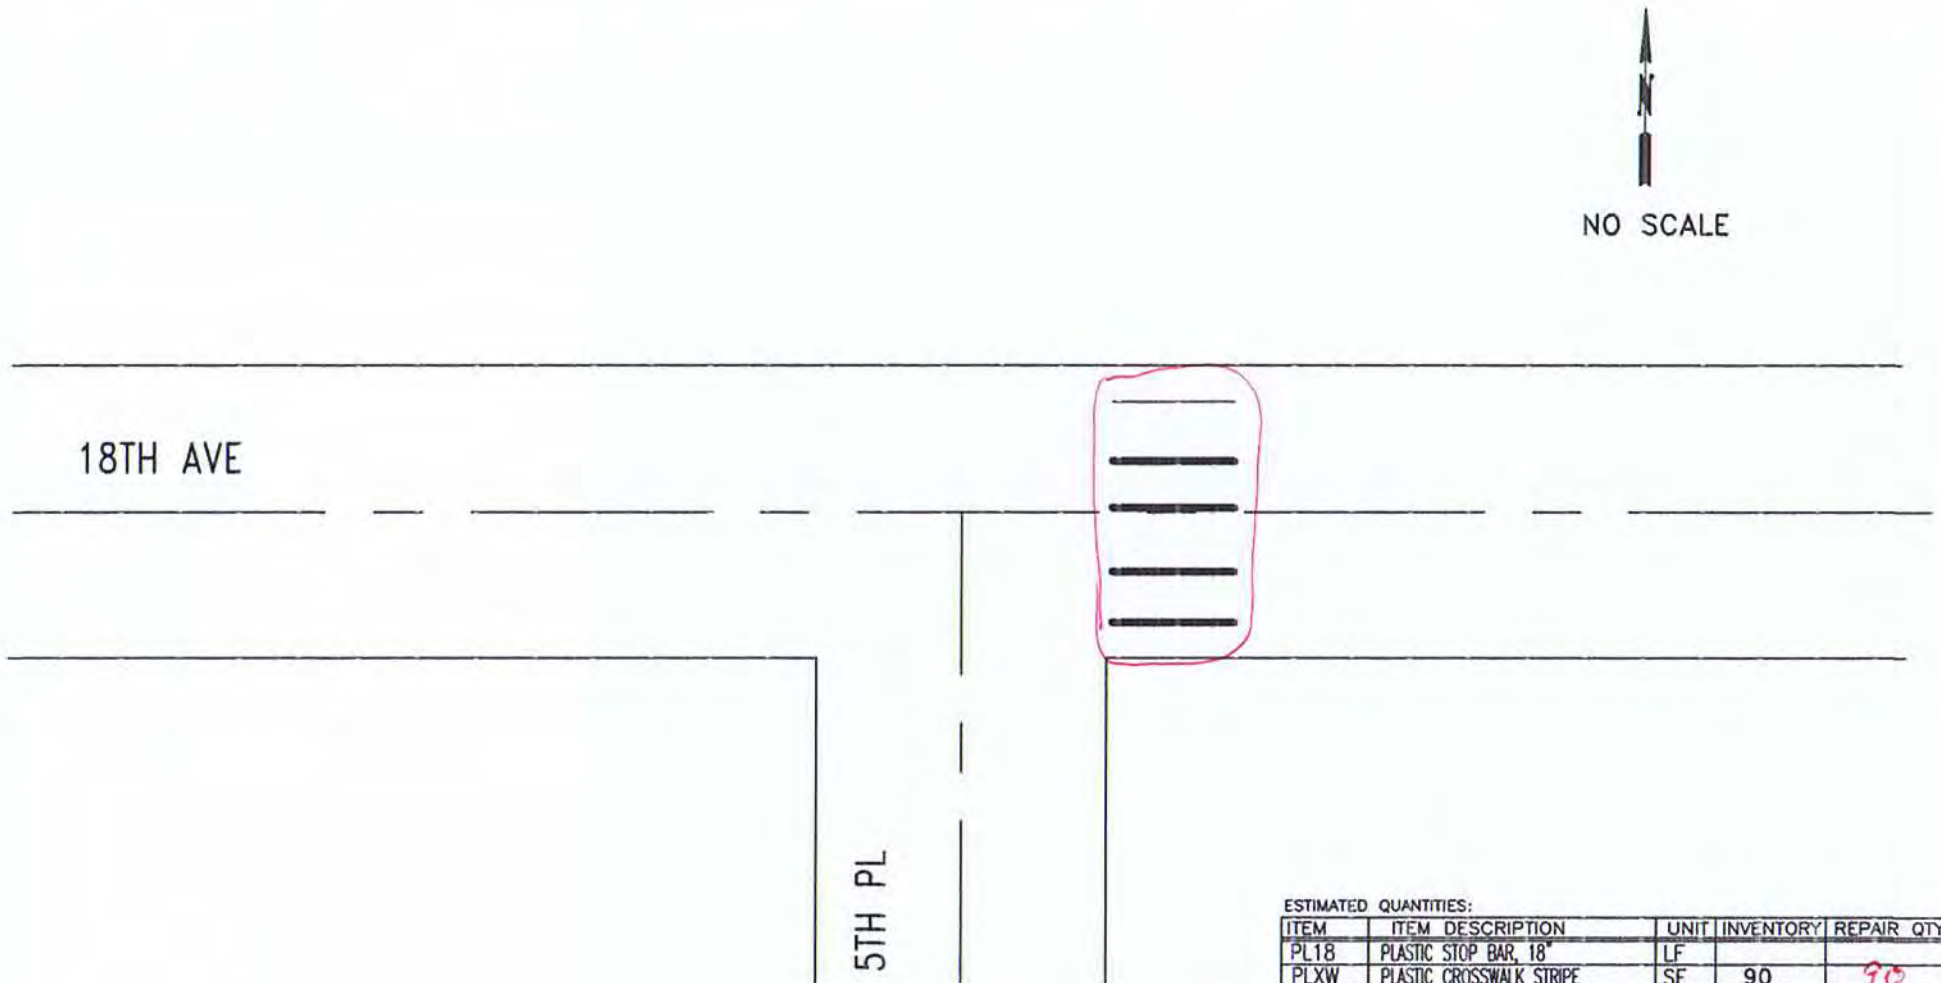

ESTIMATED QUANTITIES:

ITEM	ITEM DESCRIPTION	UNIT	INVENTORY	REPAIR QTY
PL18	PLASTIC STOP BAR, 18"	LF		
PLXW	PLASTIC CROSSWALK STRIPE	SF	90	90
PLARW	PLASTIC TRAFFIC ARROW	EA		
PLLTR	PLASTIC TRAFFIC LETTER, 8 FT HIGH	EA		
PLRR	PLASTIC RAILROAD SYMBOL	EA		
RPLSYM	REMOVE PL. ARROW, LETTER, SYMBOL	EA		
RRPM	REMOVE RPM	EA		
RPLXW	REMOVE PLASTIC STRIPE	SF		90

CITY OF KIRKLAND
DEPARTMENT OF PUBLIC WORKS
123 FIFTH AVENUE KIRKLAND, WA 98033
(425) 587-3800 www.kirklandwa.gov

D.GRILLEY 1/2000
DESIGNED BY: DATE

J.JENNINGS 2/2004
DRAWN BY: DATE

CHECKED BY: DATE

2020 PAVEMENT MARKING PROGRAM

STREET: 5TH PL

CROSS STREET: 18TH AVE

SEGMENT:

SCALE: N.T.S.

FILENAME: Page 7-24

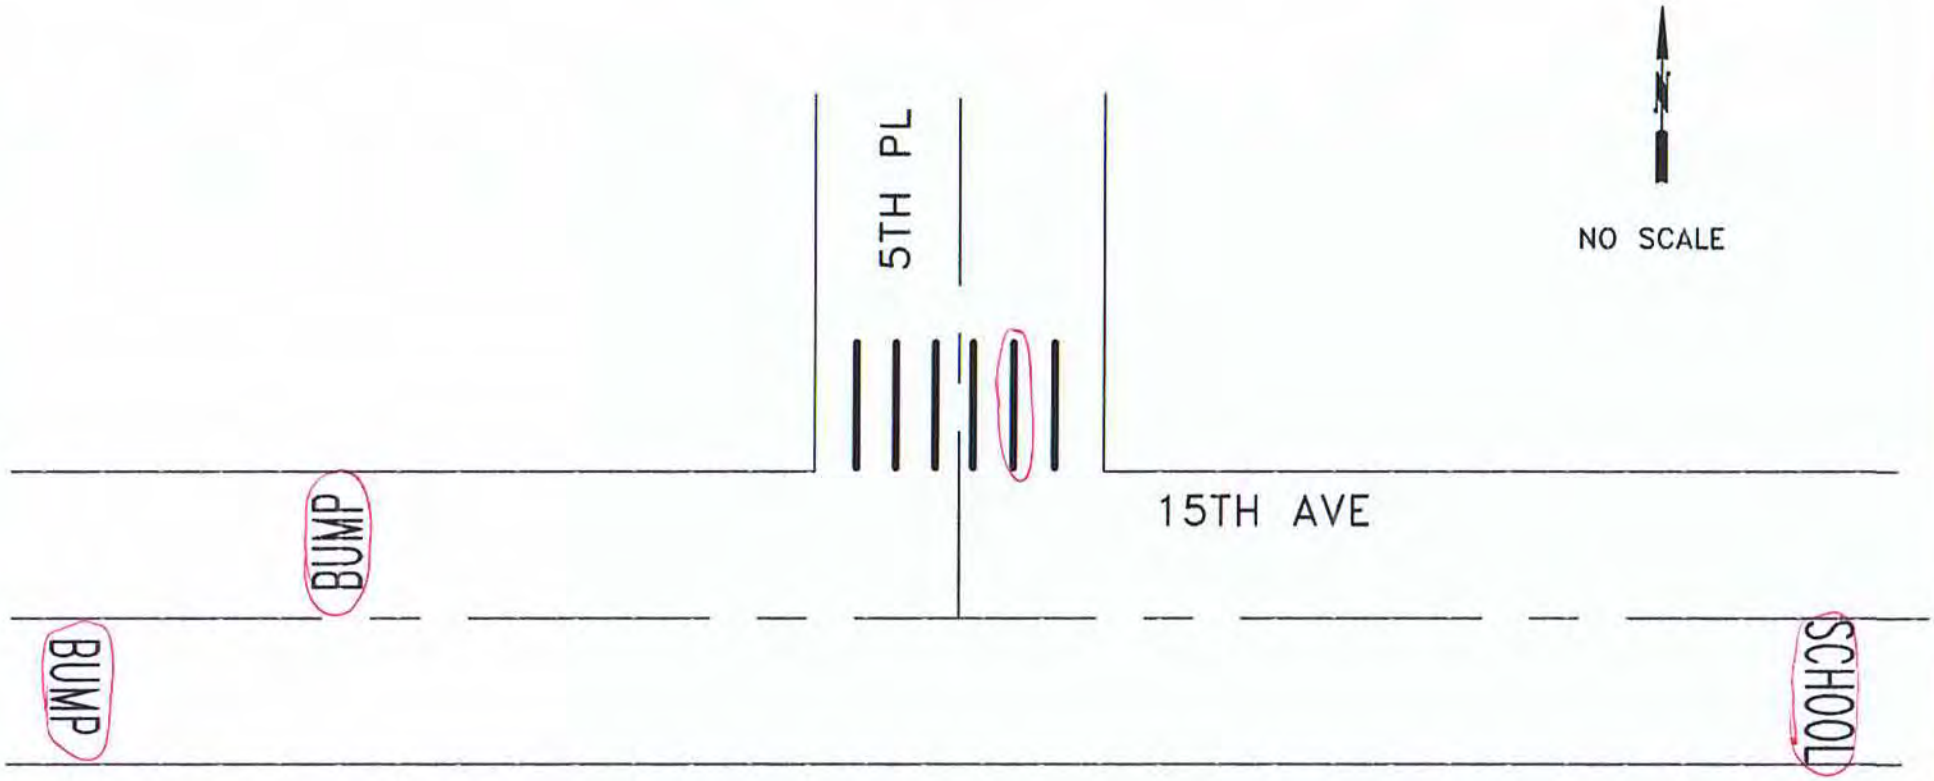

ESTIMATED QUANTITIES:

ITEM	ITEM DESCRIPTION	UNIT	INVENTORY	REPAIR QTY
PL18	PLASTIC STOP BAR, 18"	LF		
PLXW	PLASTIC CROSSWALK STRIPE	SF	120	70
PLARW	PLASTIC TRAFFIC ARROW	EA		
PLLTR	PLASTIC TRAFFIC LETTER, 8 FT HIGH	EA	14	14
PLRR	PLASTIC RAILROAD SYMBOL	EA		
RPLSYM	REMOVE PL. ARROW, LETTER, SYMBOL	EA		6
RRPM	REMOVE RPM	EA		
RPLXW	REMOVE PLASTIC STRIPE	SF		70

CITY OF KIRKLAND
DEPARTMENT OF PUBLIC WORKS
123 FIFTH AVENUE KIRKLAND, WA 98033
(425) 587-3800 www.kirklandwa.gov

G. HORTILLOSA 2/2011
DESIGNED BY: DATE

J.JENNINGS 10/2011
DRAWN BY: DATE

CHECKED BY: DATE

2020 PAVEMENT MARKING PROGRAM

STREET: 15TH AVE

CROSS STREET: 5TH PL

SEGMENT:

SCALE: N.T.S.

FILENAME: Page 7-25

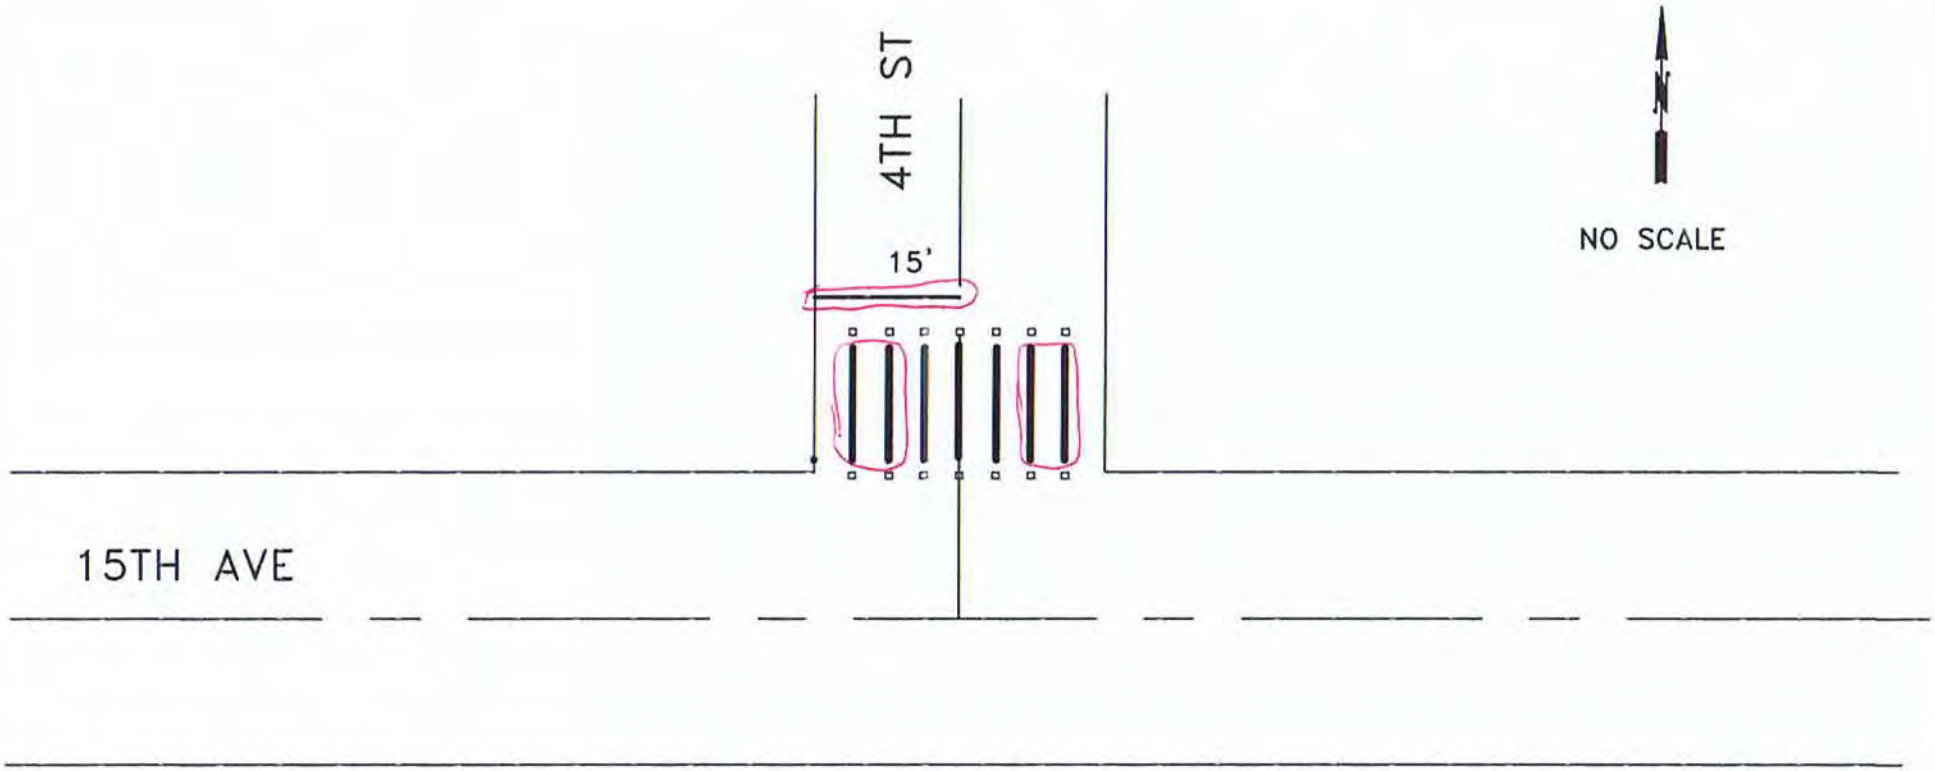

ESTIMATED QUANTITIES:

ITEM	ITEM DESCRIPTION	UNIT	INVENTORY	REPAIR QTY
PL18	PLASTIC STOP BAR, 18"	LF	15	15
PLXW	PLASTIC CROSSWALK STRIPE	SF	140	63
PLARW	PLASTIC TRAFFIC ARROW	EA		
PLLTR	PLASTIC TRAFFIC LETTER, 8 FT HIGH	EA		
PLRR	PLASTIC RAILROAD SYMBOL	EA		
RPLSYM	REMOVE PL. ARROW, LETTER, SYMBOL	EA		
RRPM	REMOVE RPM	EA		
RPLXW	REMOVE PLASTIC STRIPE	SF		
	RAISED PAVEMENT MARKER TYPE 2	EA	15	

CITY OF KIRKLAND
DEPARTMENT OF PUBLIC WORKS
123 FIFTH AVENUE KIRKLAND, WA 98033
(425) 587-3800 www.kirklandwa.gov

D.GRILLEY 1/2000
DESIGNED BY: DATE

J.JENNINGS 2/2004
DRAWN BY: DATE

CHECKED BY: DATE

20~~20~~ PAVEMENT MARKING PROGRAM

STREET: 15TH AVE

CROSS STREET: 4TH ST

SEGMENT:

SCALE: N.T.S.

FILENAME: Page 7-26

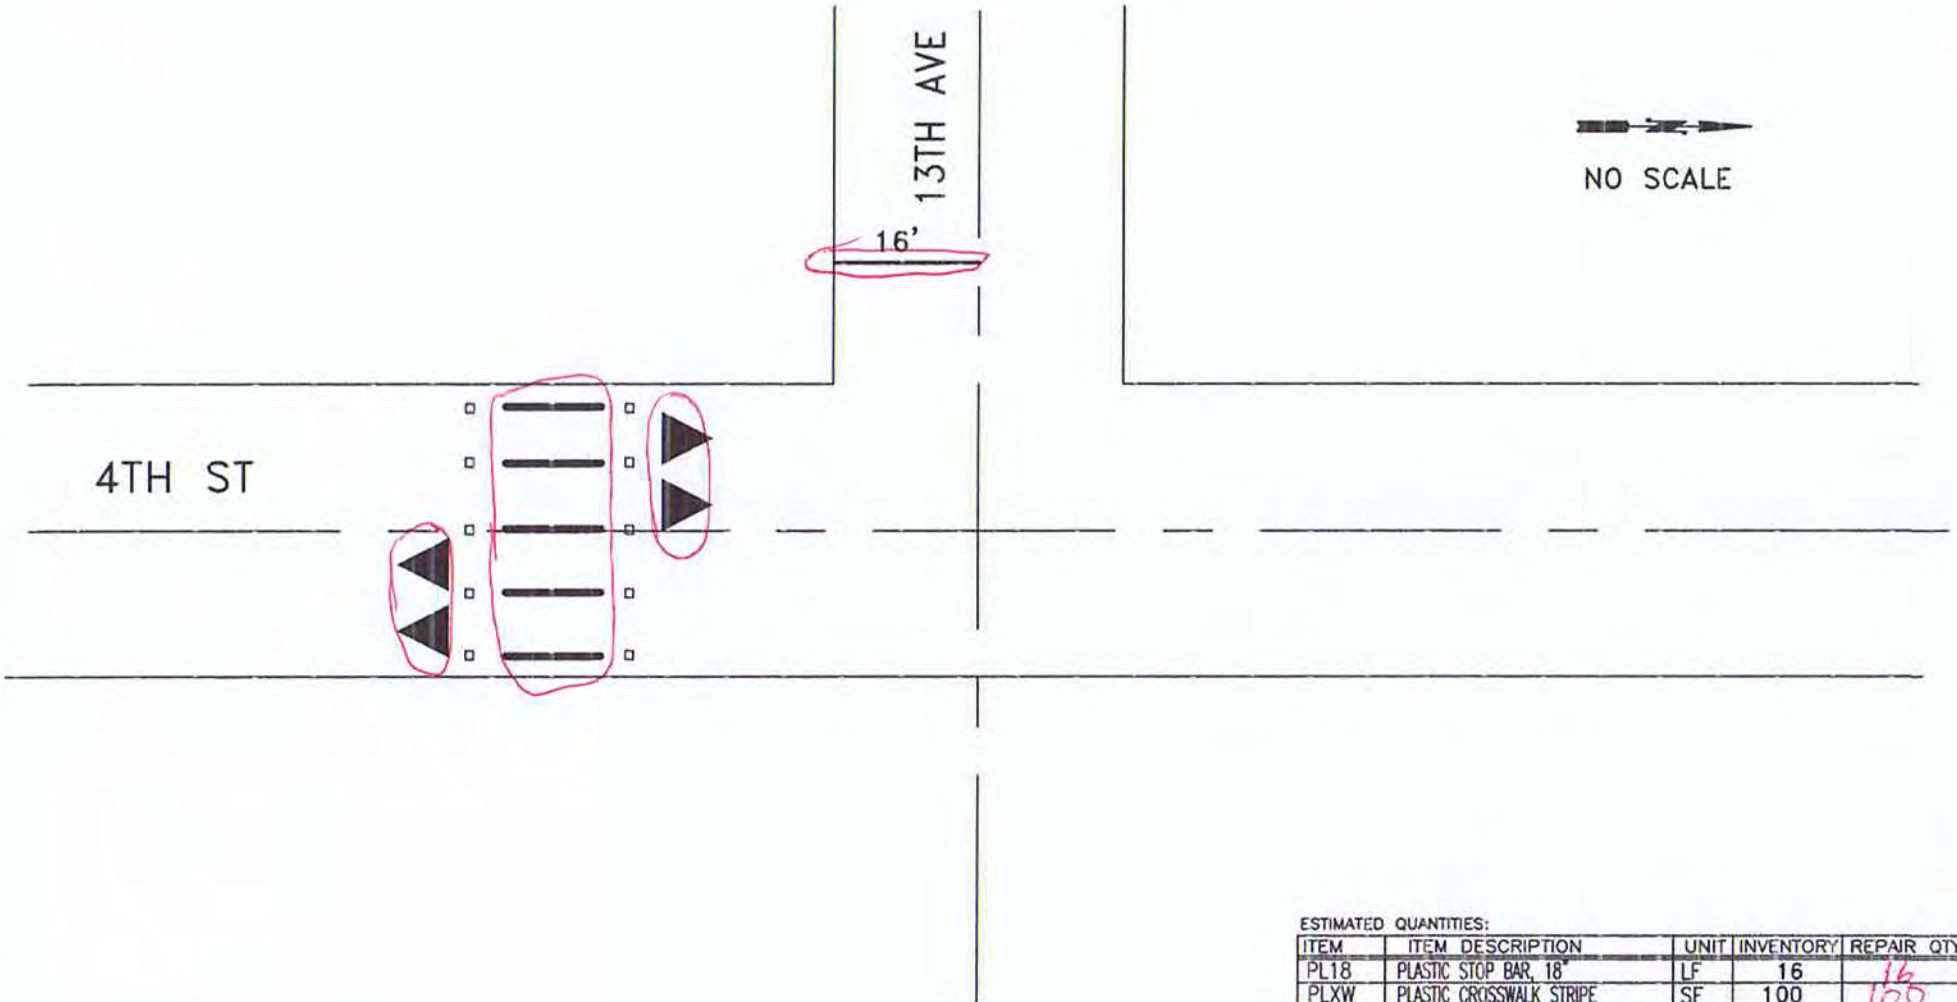

ESTIMATED QUANTITIES:

ITEM	ITEM DESCRIPTION	UNIT	INVENTORY	REPAIR QTY
PL18	PLASTIC STOP BAR, 18"	LF	16	16
PLXW	PLASTIC CROSSWALK STRIPE	SF	100	100
PLARW	PLASTIC TRAFFIC ARROW	EA		
PLLTR	PLASTIC TRAFFIC LETTER, 8 FT HIGH	EA		
PLRR	PLASTIC YIELD SYMBOL	SF	18	18
RPLSYM	REMOVE PL. ARROW, LETTER, SYMBOL	EA		
RRPM	REMOVE RPM	EA		10
RPLXW	REMOVE PLASTIC STRIPE	SF		140
	RAISED PAVEMENT MARKER TYPE 2	EA	10	10

CITY OF KIRKLAND
DEPARTMENT OF PUBLIC WORKS
123 FIFTH AVENUE KIRKLAND, WA 98033
(425) 587-3800 www.kirklandwa.gov

G. HORTILLOSA 10/2012
DESIGNED BY: DATE

J.JENNINGS 10/2012
DRAWN BY: DATE

CHECKED BY: DATE

2020 PAVEMENT MARKING PROGRAM

STREET: 13TH AVE

CROSS STREET: 4TH ST

SEGMENT:

SCALE: N.T.S.

FILENAME: Page 7-29

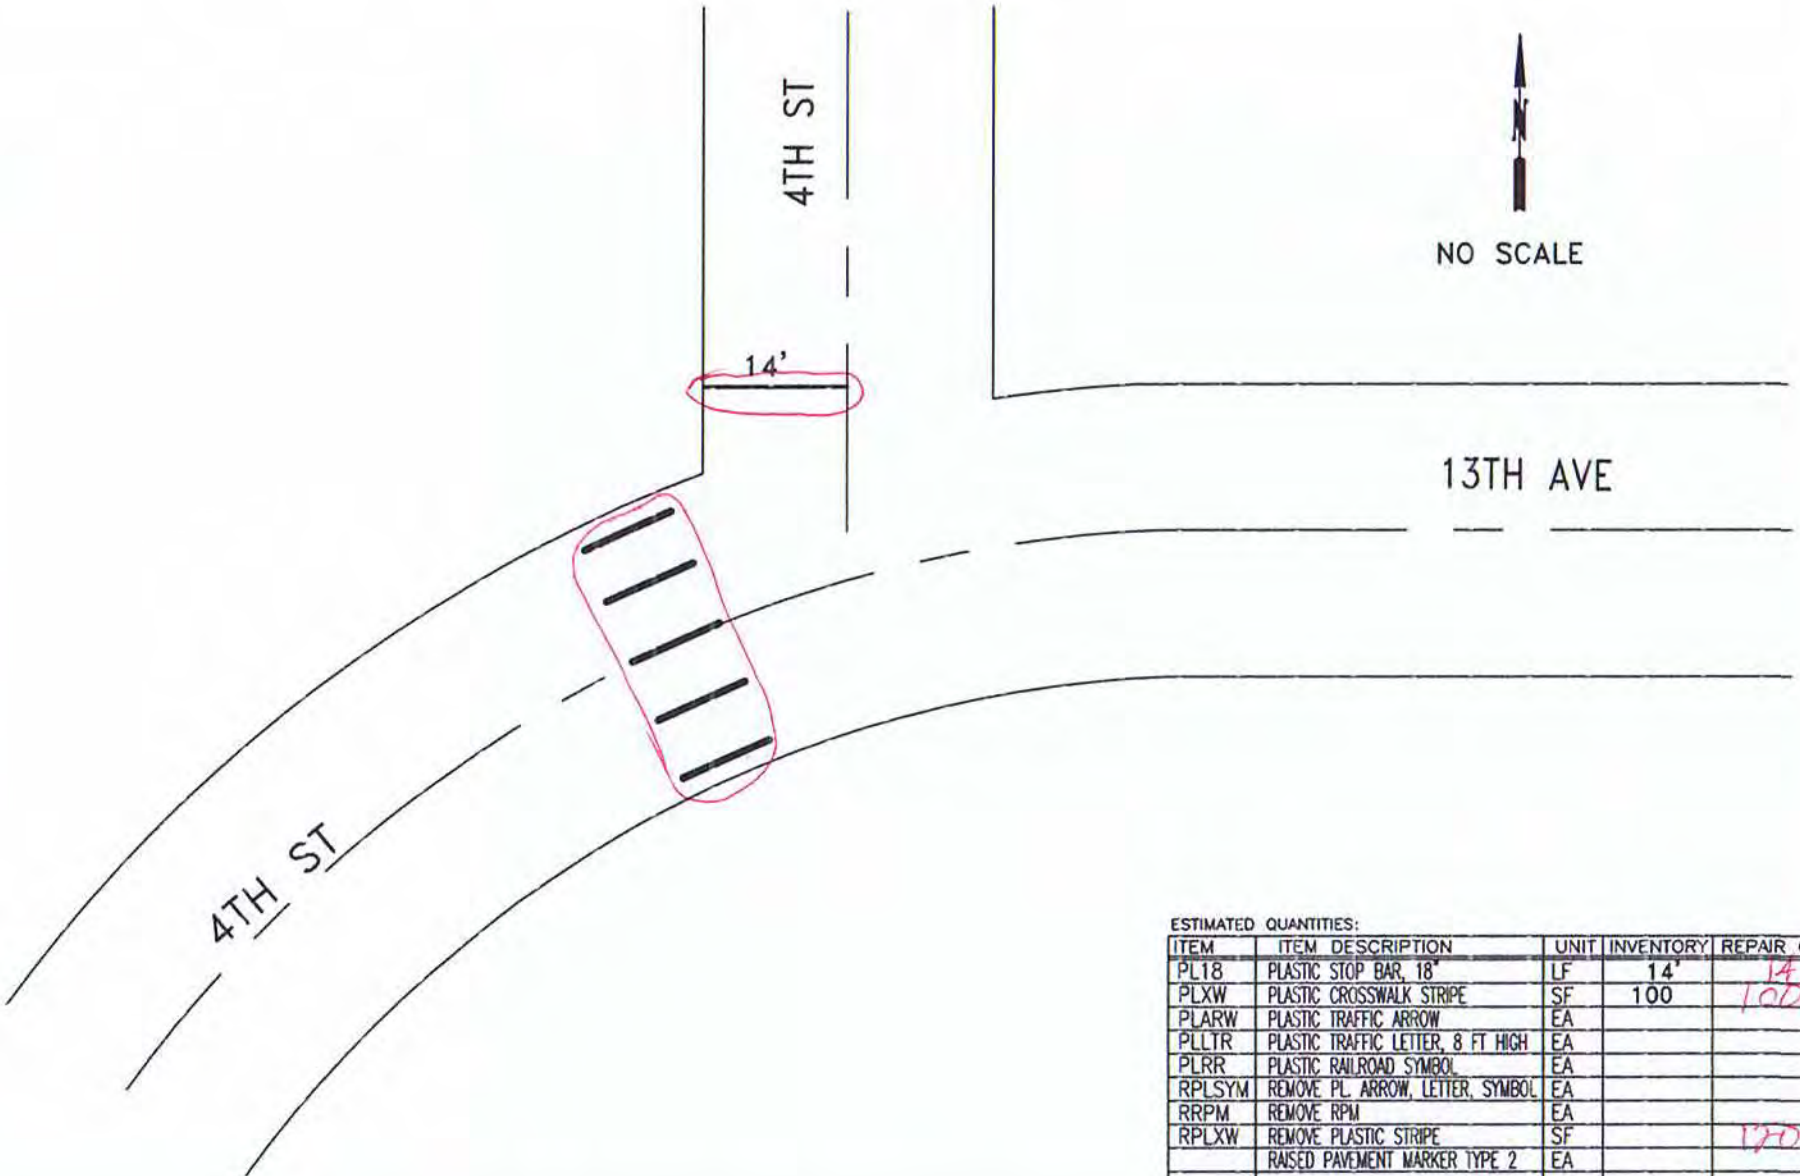

ESTIMATED QUANTITIES:

ITEM	ITEM DESCRIPTION	UNIT	INVENTORY	REPAIR QTY
PL18	PLASTIC STOP BAR, 18"	LF	14'	14
PLXW	PLASTIC CROSSWALK STRIPE	SF	100	100
PLARW	PLASTIC TRAFFIC ARROW	EA		
PLLTR	PLASTIC TRAFFIC LETTER, 8 FT HIGH	EA		
PLRR	PLASTIC RAILROAD SYMBOL	EA		
RPLSYM	REMOVE PL. ARROW, LETTER, SYMBOL	EA		
RRPM	REMOVE RPM	EA		
RPLXW	REMOVE PLASTIC STRIPE	SF		170
	RAISED PAVEMENT MARKER TYPE 2	EA		

CITY OF KIRKLAND
DEPARTMENT OF PUBLIC WORKS
123 FIFTH AVENUE KIRKLAND, WA 98033
(425) 587-3800 www.kirklandwa.gov

S. GONSAR 2/2018
DESIGNED BY: DATE

J.JENNINGS 2/2018
DRAWN BY: DATE

CHECKED BY: DATE

2022 PAVEMENT MARKING PROGRAM

STREET: 4TH STREET

CROSS STREET: 13TH AVE

SEGMENT:

SCALE: N.T.S.

FILENAME: Page 7-29A

HIGHLANDS
INTERSECTION PLANS

CITY OF KIRKLAND
DEPARTMENT OF PUBLIC WORKS
123 FIFTH AVENUE KIRKLAND, WA 98033
(425) 587-3800 www.kirklandwa.gov

S GONSAR	1/2019	DESIGNED BY: DATE
J.JENNINGS	1/2019	DRAWN BY: DATE
		CHECKED BY: DATE

2020 PAVEMENT MARKING PROGRAM

STREET:

CROSS STREET:

SEGMENT:

SCALE: N.T.S.

FILENAME: 8-0

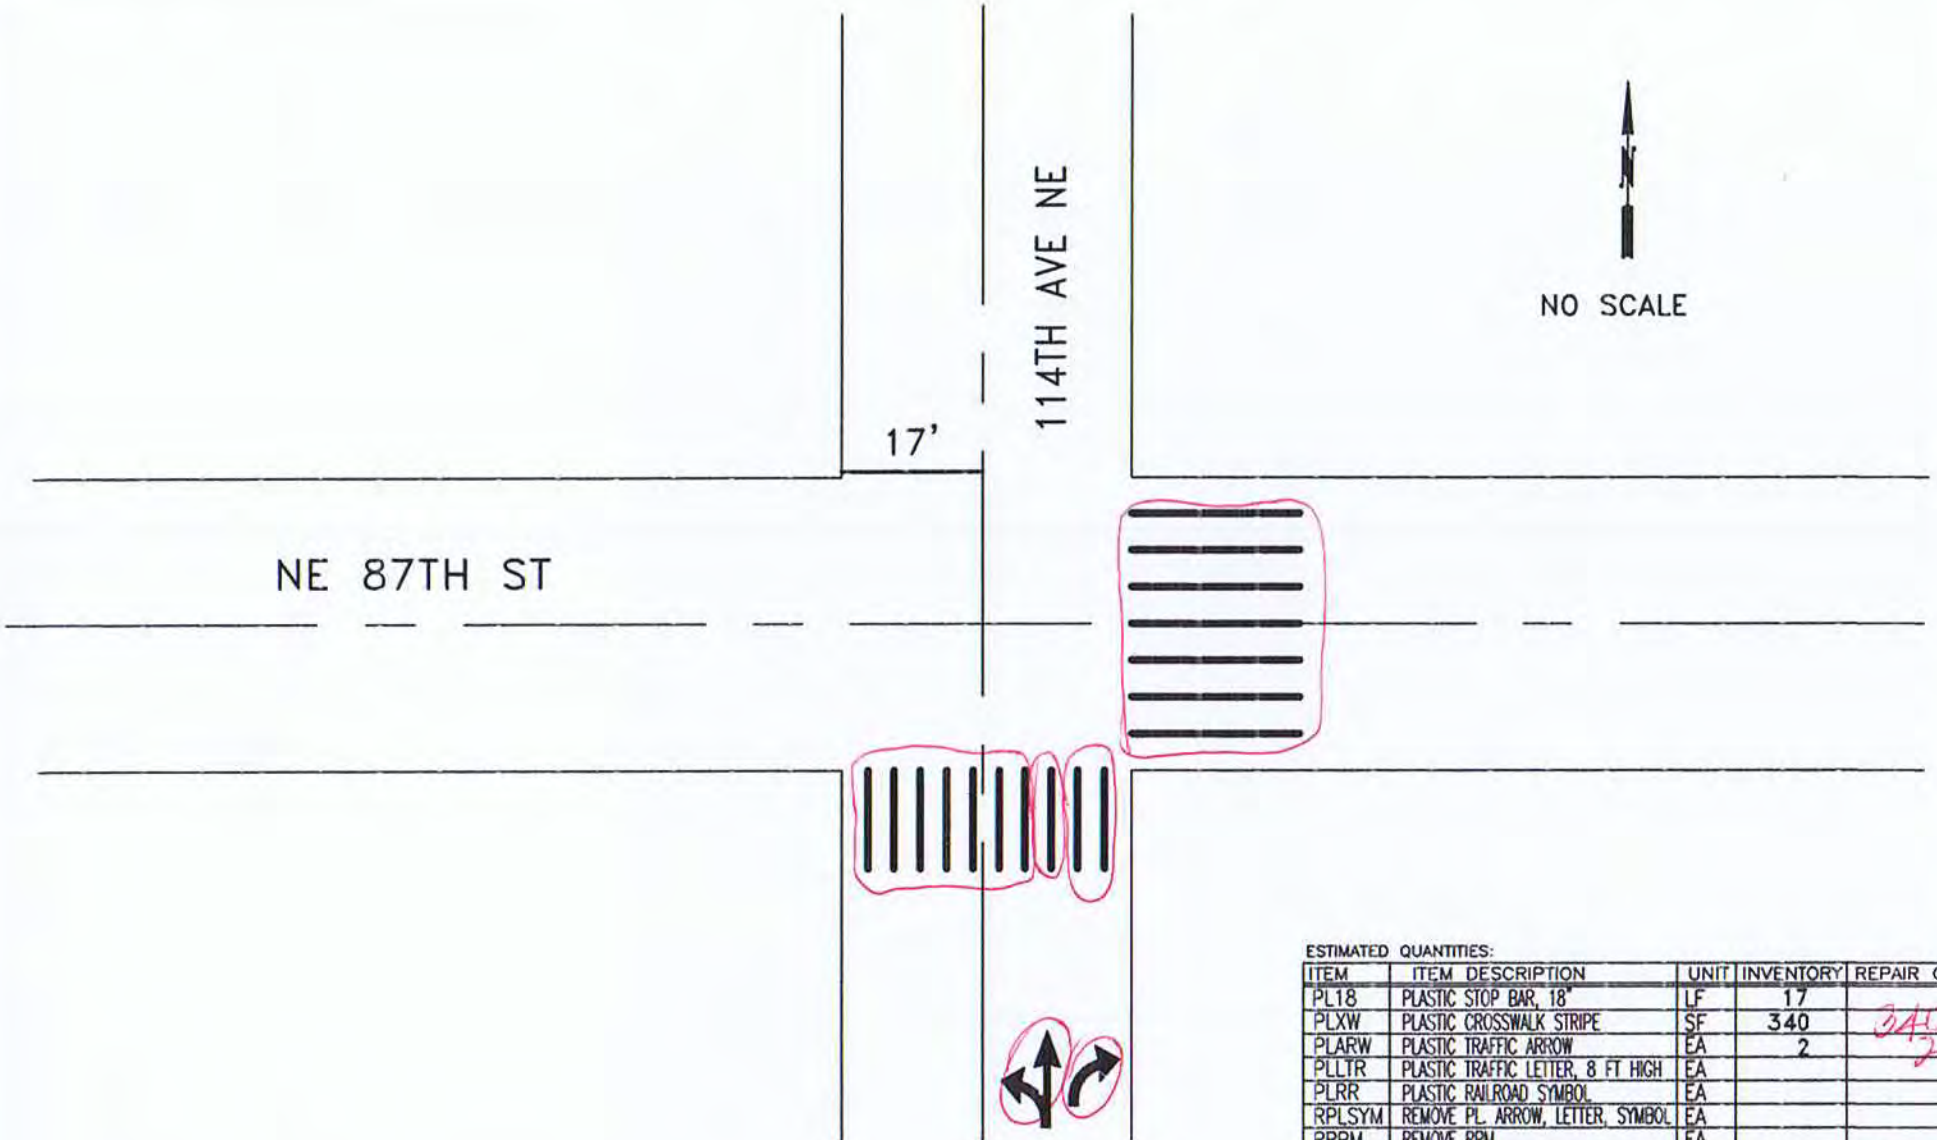

ESTIMATED QUANTITIES:

ITEM	ITEM DESCRIPTION	UNIT	INVENTORY	REPAIR QTY
PL18	PLASTIC STOP BAR, 18"	LF	17	
PLXW	PLASTIC CROSSWALK STRIPE	SF	340	340
PLARW	PLASTIC TRAFFIC ARROW	EA	2	2
PLLTR	PLASTIC TRAFFIC LETTER, 8 FT HIGH	EA		
PLRR	PLASTIC RAILROAD SYMBOL	EA		
RPLSYM	REMOVE PL. ARROW, LETTER, SYMBOL	EA		
RRPM	REMOVE RPM	EA		
RPLXW	REMOVE PLASTIC STRIPE	SF		200

CITY OF KIRKLAND WASHINGTON

CITY OF KIRKLAND
DEPARTMENT OF PUBLIC WORKS
123 FIFTH AVENUE KIRKLAND, WA 98033
(425) 587-3800 www.kirklandwa.gov

G. HORTILLOSA 10/2006
DESIGNED BY: DATE

J.JENNINGS 10/2006
DRAWN BY: DATE

CHECKED BY: DATE

2020 PAVEMENT MARKING PROGRAM

STREET: NE 87TH ST

CROSS STREET: 114TH AVE NE

SEGMENT:

SCALE: N.T.S.

FILENAME: Page 8-1

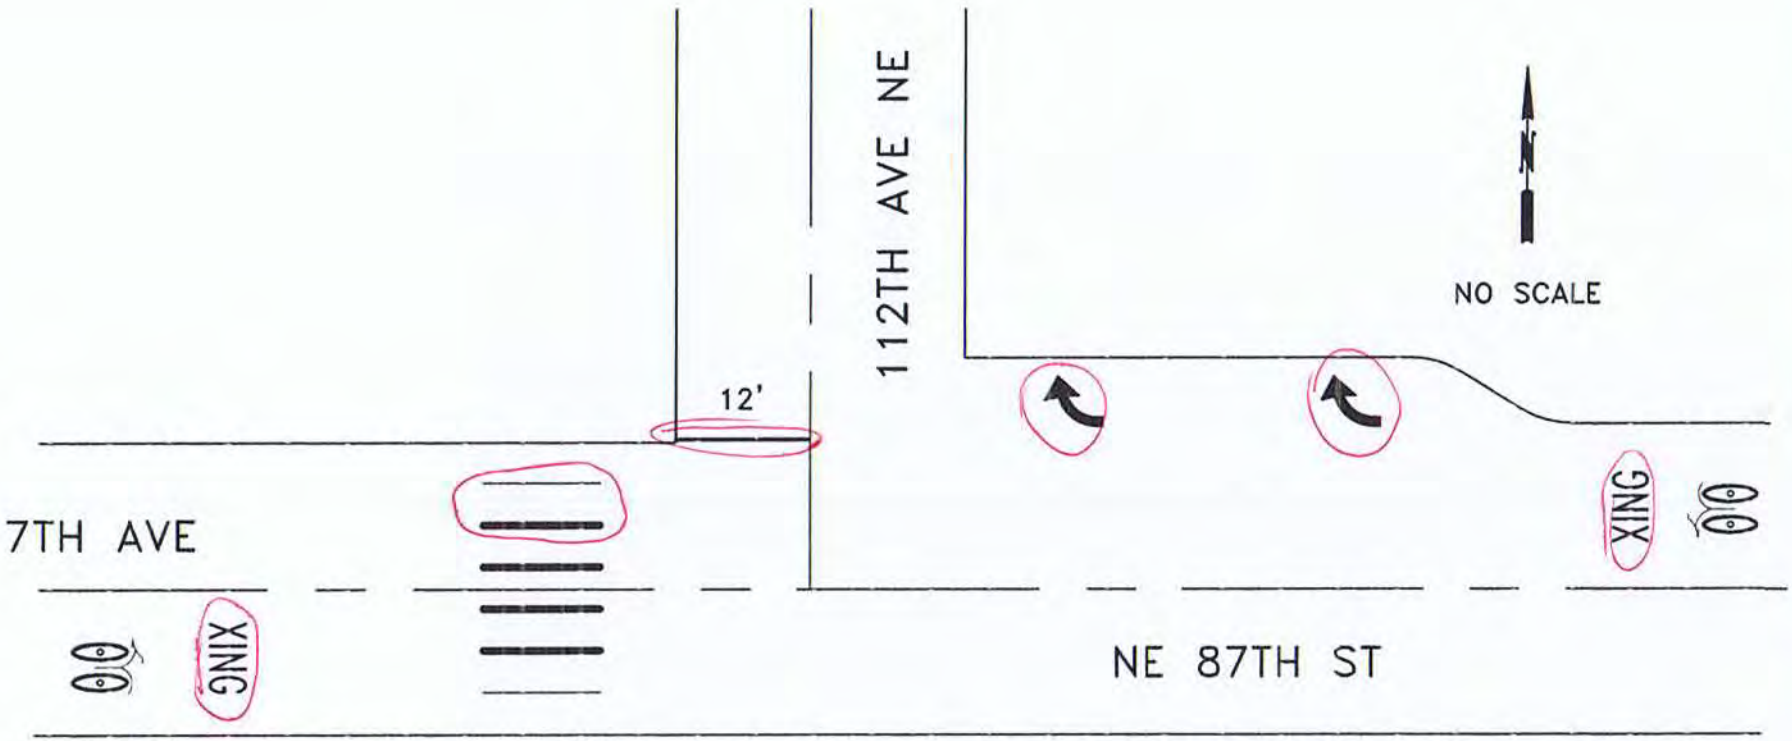

ESTIMATED QUANTITIES:

ITEM	ITEM DESCRIPTION	UNIT	INVENTORY	REPAIR QTY
PL18	PLASTIC STOP BAR, 18"	LF	39	13
PLXW	PLASTIC CROSSWALK STRIPE	SF	100	30
PLARW	PLASTIC TRAFFIC ARROW	EA	2	2
PLLTR	PLASTIC TRAFFIC LETTER, 8 FT HIGH	EA	8	8
RPLSYM	REMOVE PL. ARROW, LETTER, SYMBOL	EA		
RRPM	REMOVE RPM	EA		
RPLXW	REMOVE PLASTIC STRIPE	SF		

CITY OF KIRKLAND WASHINGTON

CITY OF KIRKLAND
DEPARTMENT OF PUBLIC WORKS
123 FIFTH AVENUE KIRKLAND, WA 98033
(425) 587-3800 www.kirklandwa.gov

G. HORTILLOSA 2/2012
DESIGNED BY: DATE

J.JENNINGS 2/2012
DRAWN BY: DATE

CHECKED BY: DATE

2012 PAVEMENT MARKING PROGRAM

STREET: 7TH AVE/NE 87TH ST

CROSS STREET: 112TH AVE NE

SEGMENT:

SCALE: N.T.S.

FILENAME: Page 8-2

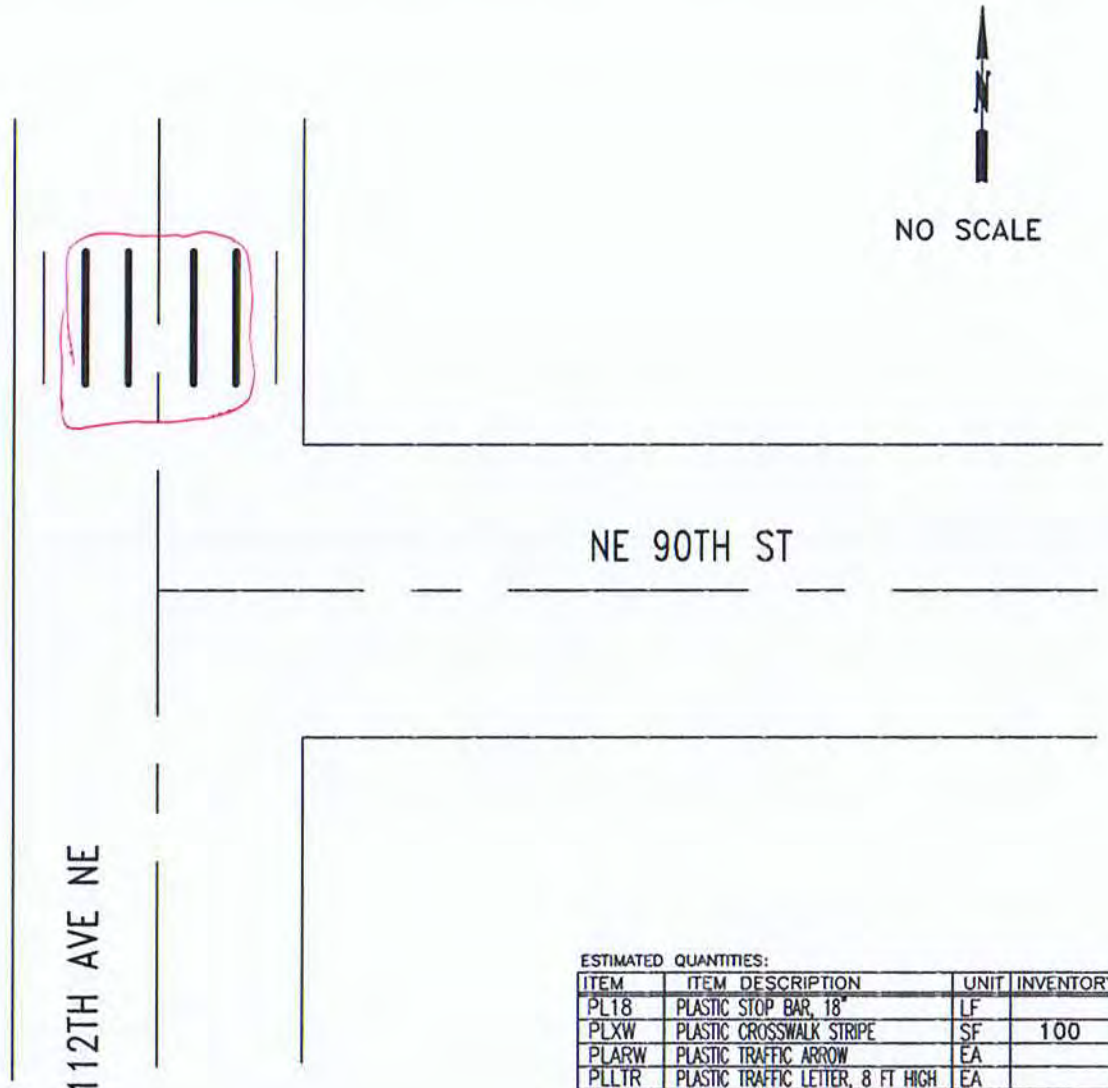

ESTIMATED QUANTITIES:

ITEM	ITEM DESCRIPTION	UNIT	INVENTORY	REPAIR QTY
PL18	PLASTIC STOP BAR, 18"	LF		
PLXW	PLASTIC CROSSWALK STRIPE	SF	100	80
PLARW	PLASTIC TRAFFIC ARROW	EA		
PLLTR	PLASTIC TRAFFIC LETTER, 8 FT HIGH	EA		
PLRR	PLASTIC RAILROAD SYMBOL	EA		
RPLSYM	REMOVE PL. ARROW, LETTER, SYMBOL	EA		
RRPM	REMOVE RPM	EA		
RPLXW	REMOVE PLASTIC STRIPE	SF		

CITY OF KIRKLAND
DEPARTMENT OF PUBLIC WORKS
123 FIFTH AVENUE KIRKLAND, WA 98033
(425) 587-3800 www.kirklandwa.gov

D.GRILLEY 1/2000
DESIGNED BY: DATE

J.JENNINGS 1/2000
DRAWN BY: DATE

CHECKED BY: DATE

2022 PAVEMENT MARKING PROGRAM

STREET: 112TH AVE NE

CROSS STREET: NE 90TH ST

SEGMENT:

SCALE: N.T.S.

FILENAME: Page 8-3

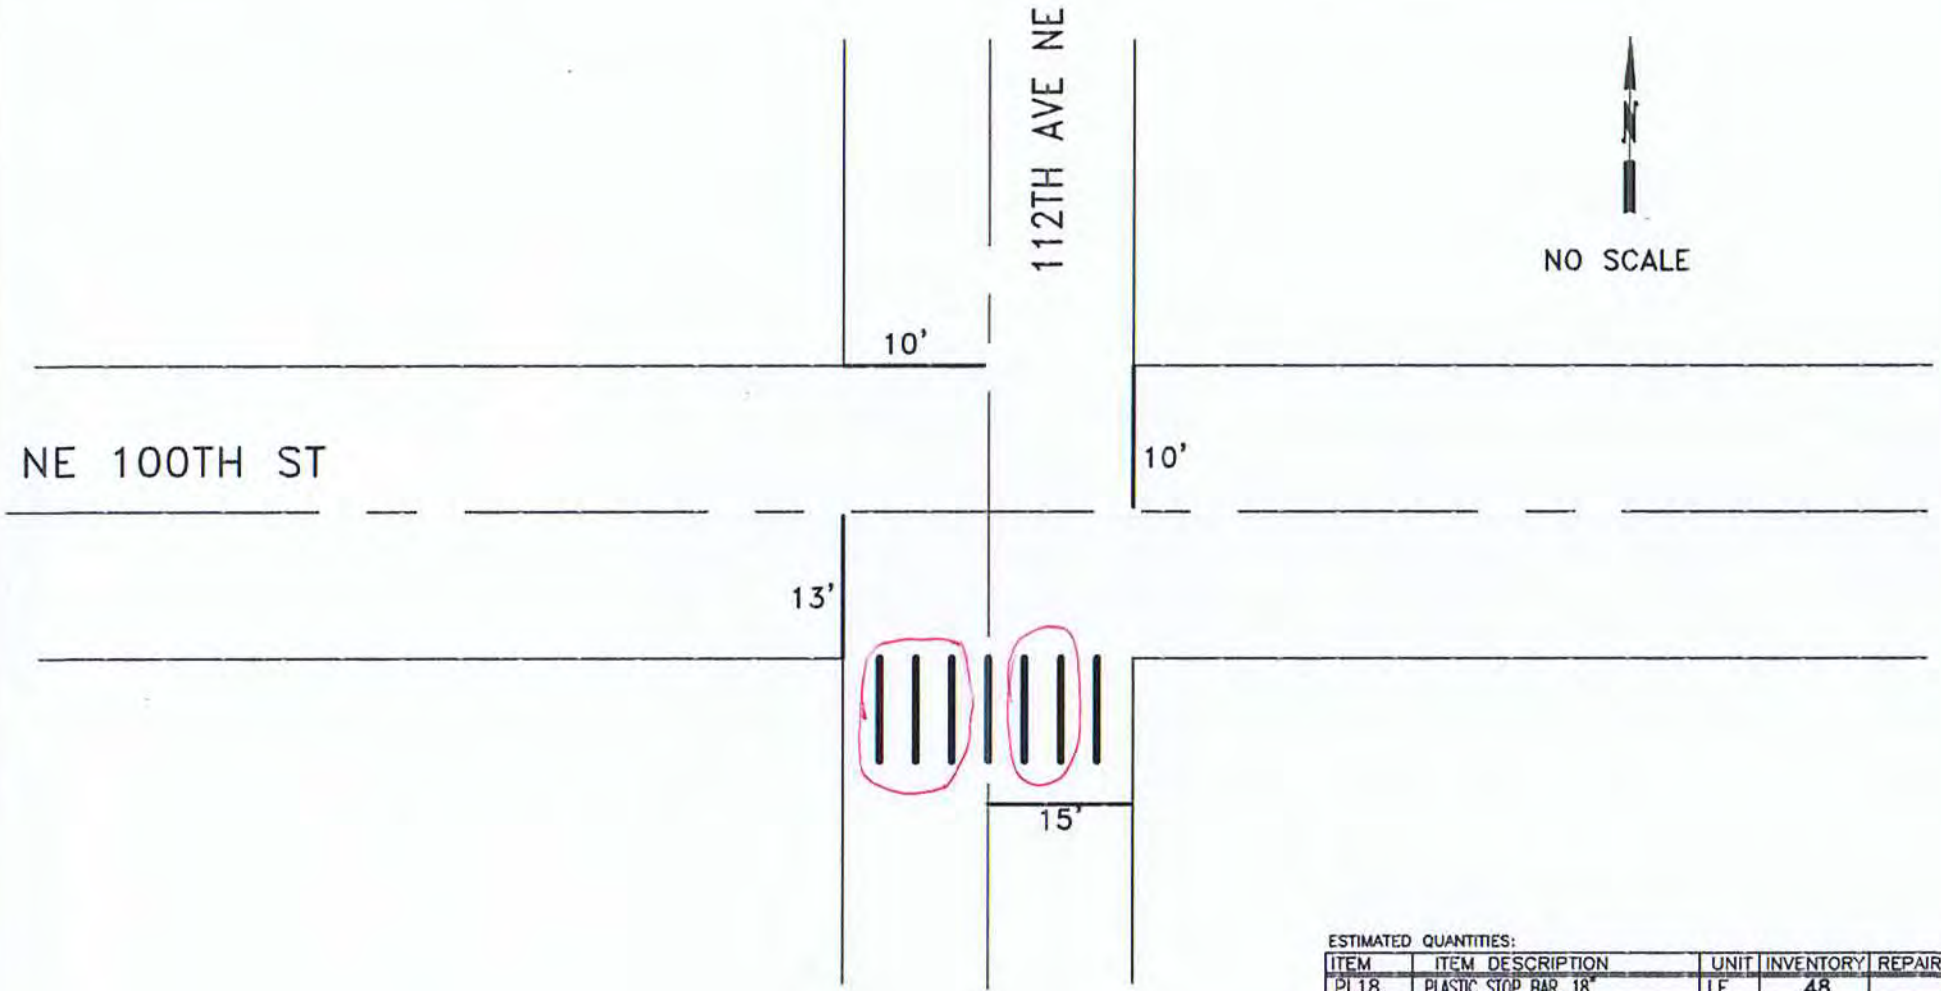

ESTIMATED QUANTITIES:

ITEM	ITEM DESCRIPTION	UNIT	INVENTORY	REPAIR QTY
PL18	PLASTIC STOP BAR, 18"	LF	48	
PLXW	PLASTIC CROSSWALK STRIPE	SF	140	100
PLARW	PLASTIC TRAFFIC ARROW	EA		
PLLTR	PLASTIC TRAFFIC LETTER, 8 FT HIGH	EA		
PLRR	PLASTIC RAILROAD SYMBOL	EA		
RPLSYM	REMOVE PL. ARROW, LETTER, SYMBOL	EA		
RRPM	REMOVE RPM	EA		
RPLXW	REMOVE PLASTIC STRIPE	SF		40

CITY OF KIRKLAND
DEPARTMENT OF PUBLIC WORKS
123 FIFTH AVENUE KIRKLAND, WA 98033
(425) 587-3800 www.kirklandwa.gov

D.GRILLEY 1/2000
DESIGNED BY: DATE

J.JENNINGS 1/2000
DRAWN BY: DATE

CHECKED BY: DATE

2020 PAVEMENT MARKING PROGRAM

STREET: 112TH AVE NE

CROSS STREET: NE 100TH ST

SEGMENT:

SCALE: N.T.S.

FILENAME: Page 8-4

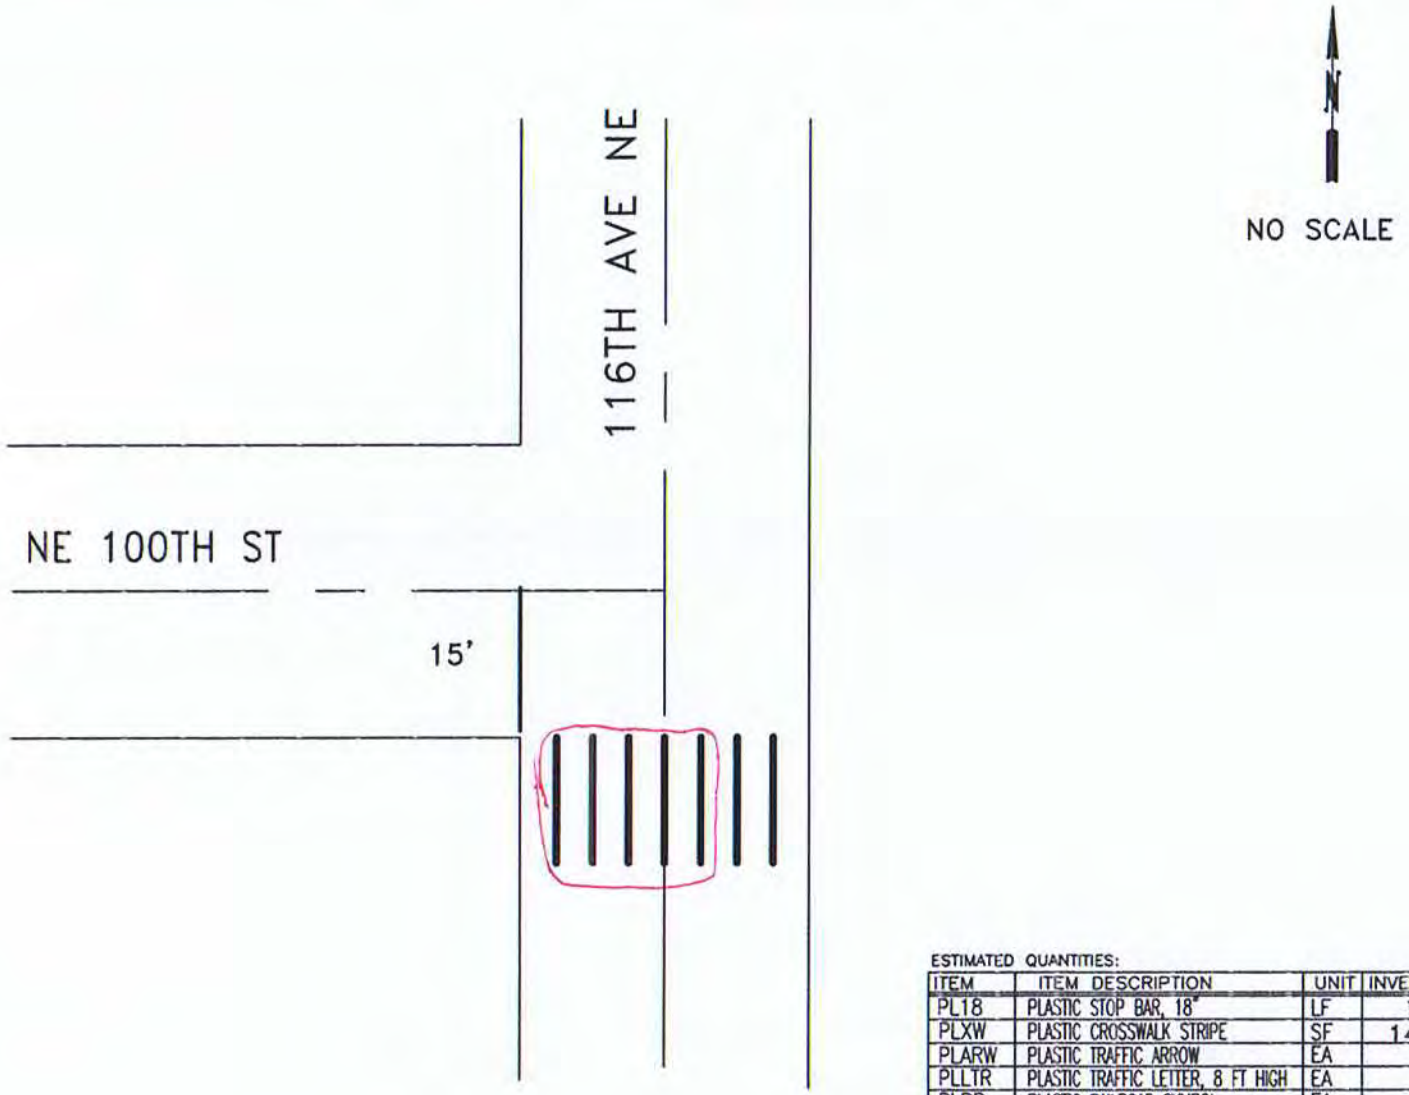

ESTIMATED QUANTITIES:

ITEM	ITEM DESCRIPTION	UNIT	INVENTORY	REPAIR QTY
PL18	PLASTIC STOP BAR, 18"	LF	15	
PLXW	PLASTIC CROSSWALK STRIPE	SF	140	100
PLARW	PLASTIC TRAFFIC ARROW	EA		
PLLTR	PLASTIC TRAFFIC LETTER, 8 FT HIGH	EA		
PLRR	PLASTIC RAILROAD SYMBOL	EA		
RPLSYM	REMOVE PL. ARROW, LETTER, SYMBOL	EA		
RRPM	REMOVE RPM	EA		
RPLXW	REMOVE PLASTIC STRIPE	SF		40

CITY OF KIRKLAND
DEPARTMENT OF PUBLIC WORKS
123 FIFTH AVENUE KIRKLAND, WA 98033
(425) 587-3800 www.kirklandwa.gov

D.GRILLEY 1/2000
DESIGNED BY: DATE

J.JENNINGS 1/2000
DRAWN BY: DATE

CHECKED BY: DATE

2020 PAVEMENT MARKING PROGRAM

STREET: 116TH AVE NE

CROSS STREET: NE 100TH ST

SEGMENT:

SCALE: N.T.S.

FILENAME: PAGE 8-5

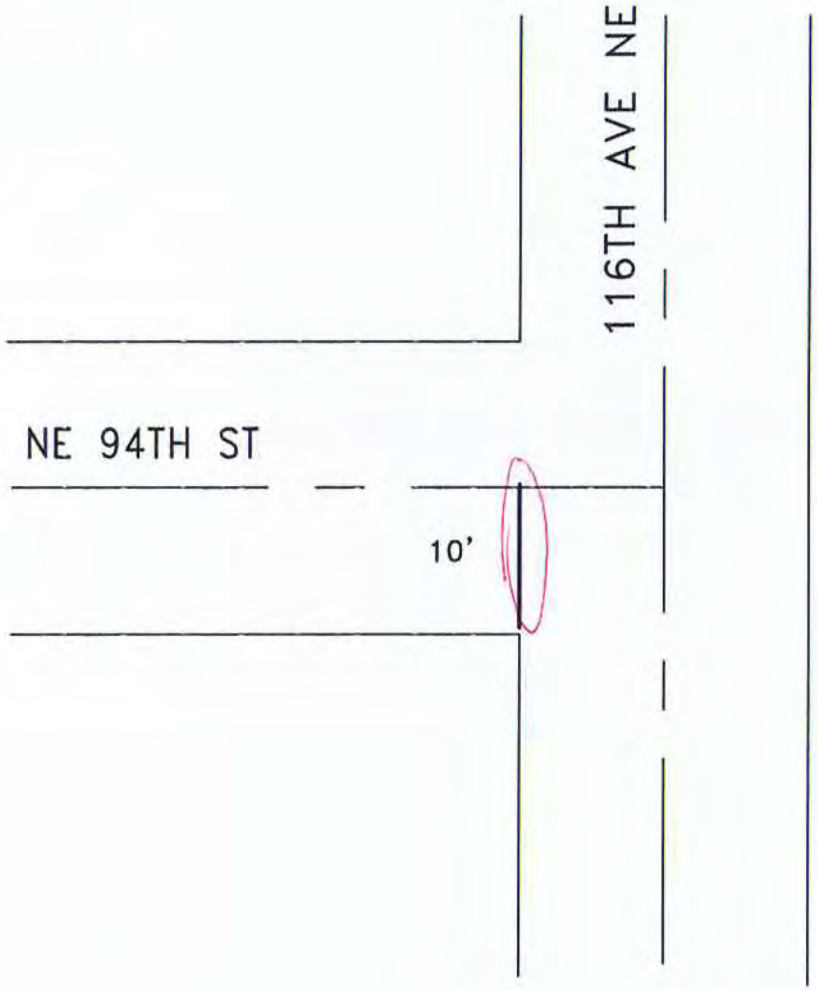

NO SCALE

ESTIMATED QUANTITIES:

ITEM	ITEM DESCRIPTION	UNIT	INVENTORY	REPAIR QTY
PL18	PLASTIC STOP BAR, 18"	LF	10	10
PLXW	PLASTIC CROSSWALK STRIPE	SF		
PLARW	PLASTIC TRAFFIC ARROW	EA		
PLLTR	PLASTIC TRAFFIC LETTER, 8 FT HIGH	EA		
PLRR	PLASTIC RAILROAD SYMBOL	EA		
RPLSYM	REMOVE PL. ARROW, LETTER, SYMBOL	EA		
RRPM	REMOVE RPM	EA		
RPLXW	REMOVE PLASTIC STRIPE	SF		

CITY OF KIRKLAND
DEPARTMENT OF PUBLIC WORKS
123 FIFTH AVENUE KIRKLAND, WA 98033
(425) 587-3800 www.kirklandwa.gov

S. GONSAR 2/2018
DESIGNED BY: DATE

J.JENNINGS 2/2018
DRAWN BY: DATE

CHECKED BY: DATE

2022 PAVEMENT MARKING PROGRAM

STREET: 116TH AVE NE

CROSS STREET: NE 94TH ST

SEGMENT:

SCALE: N.T.S.

FILENAME: PAGE 8-5A

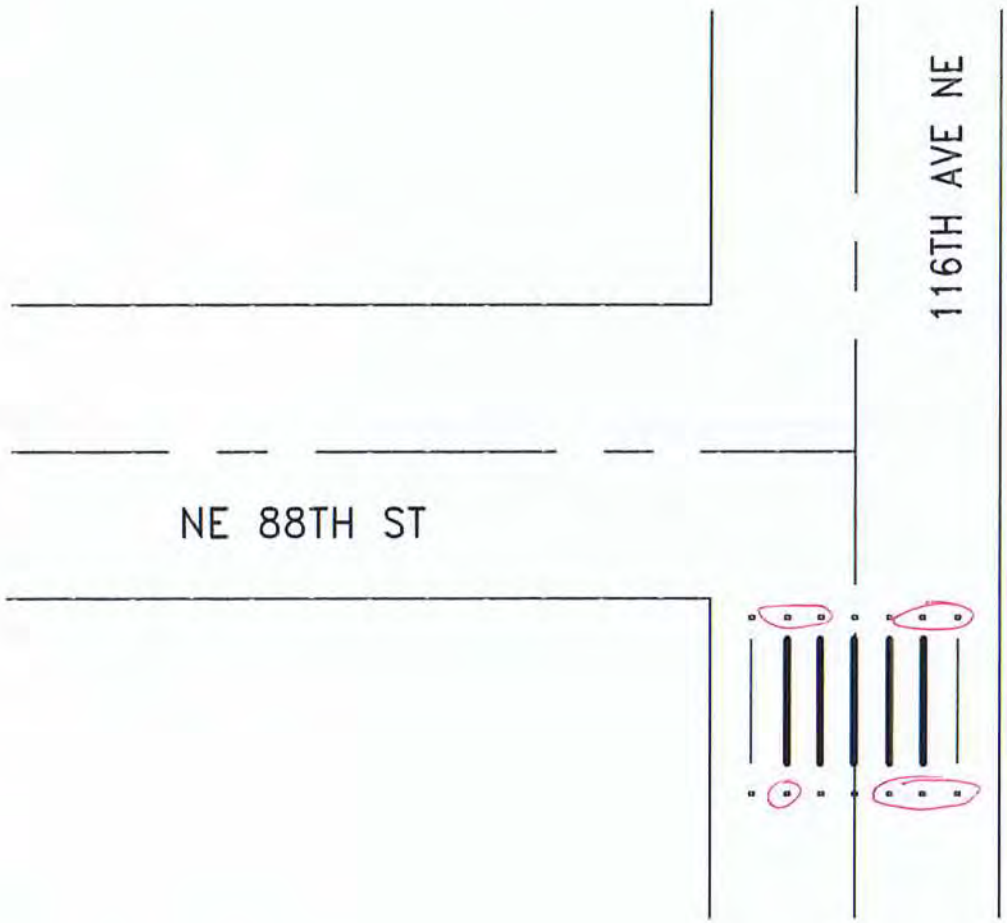

NO SCALE

ESTIMATED QUANTITIES:

ITEM	ITEM DESCRIPTION	UNIT	INVENTORY	REPAIR QTY
PL18	PLASTIC STOP BAR, 18"	LF		
PLXW	PLASTIC CROSSWALK STRIPE	SF	120	
PLARW	PLASTIC TRAFFIC ARROW	EA		
PLLTR	PLASTIC TRAFFIC LETTER, 8 FT HIGH	EA		
PLRR	PLASTIC RAILROAD SYMBOL	EA		
RPLSYM	REMOVE PL. ARROW, LETTER, SYMBOL	EA		
RRPM	REMOVE RPM	EA		
RPLXW	REMOVE PLASTIC STRIPE	SF		
	TYPE II RPM	EA	14	8

CITY OF KIRKLAND WASHINGTON

CITY OF KIRKLAND
DEPARTMENT OF PUBLIC WORKS
123 FIFTH AVENUE KIRKLAND, WA 98033
(425) 587-3800 www.kirklandwa.gov

L KAWAOKA 3/2016
DESIGNED BY: DATE

J.JENNINGS 3/2016
DRAWN BY: DATE

CHECKED BY: DATE

2022 PAVEMENT MARKING PROGRAM

STREET: 116TH AVE NE

CROSS STREET: NE 88TH ST

SEGMENT:

SCALE: N.T.S.

FILENAME: Page 8-9

MOSS BAY
INTERSECTION PLANS

CITY OF KIRKLAND
DEPARTMENT OF PUBLIC WORKS
123 FIFTH AVENUE KIRKLAND, WA 98033
(425) 587-3800 www.kirklandwa.gov

DESIGNED BY: S GONSAR	DATE: 1/2019
DRAWN BY: J.JENNINGS	DATE: 1/2019
CHECKED BY:	DATE

2020 PAVEMENT MARKING PROGRAM

STREET:

CROSS STREET:

SEGMENT:

SCALE: N.T.S.

FILENAME: 10-0

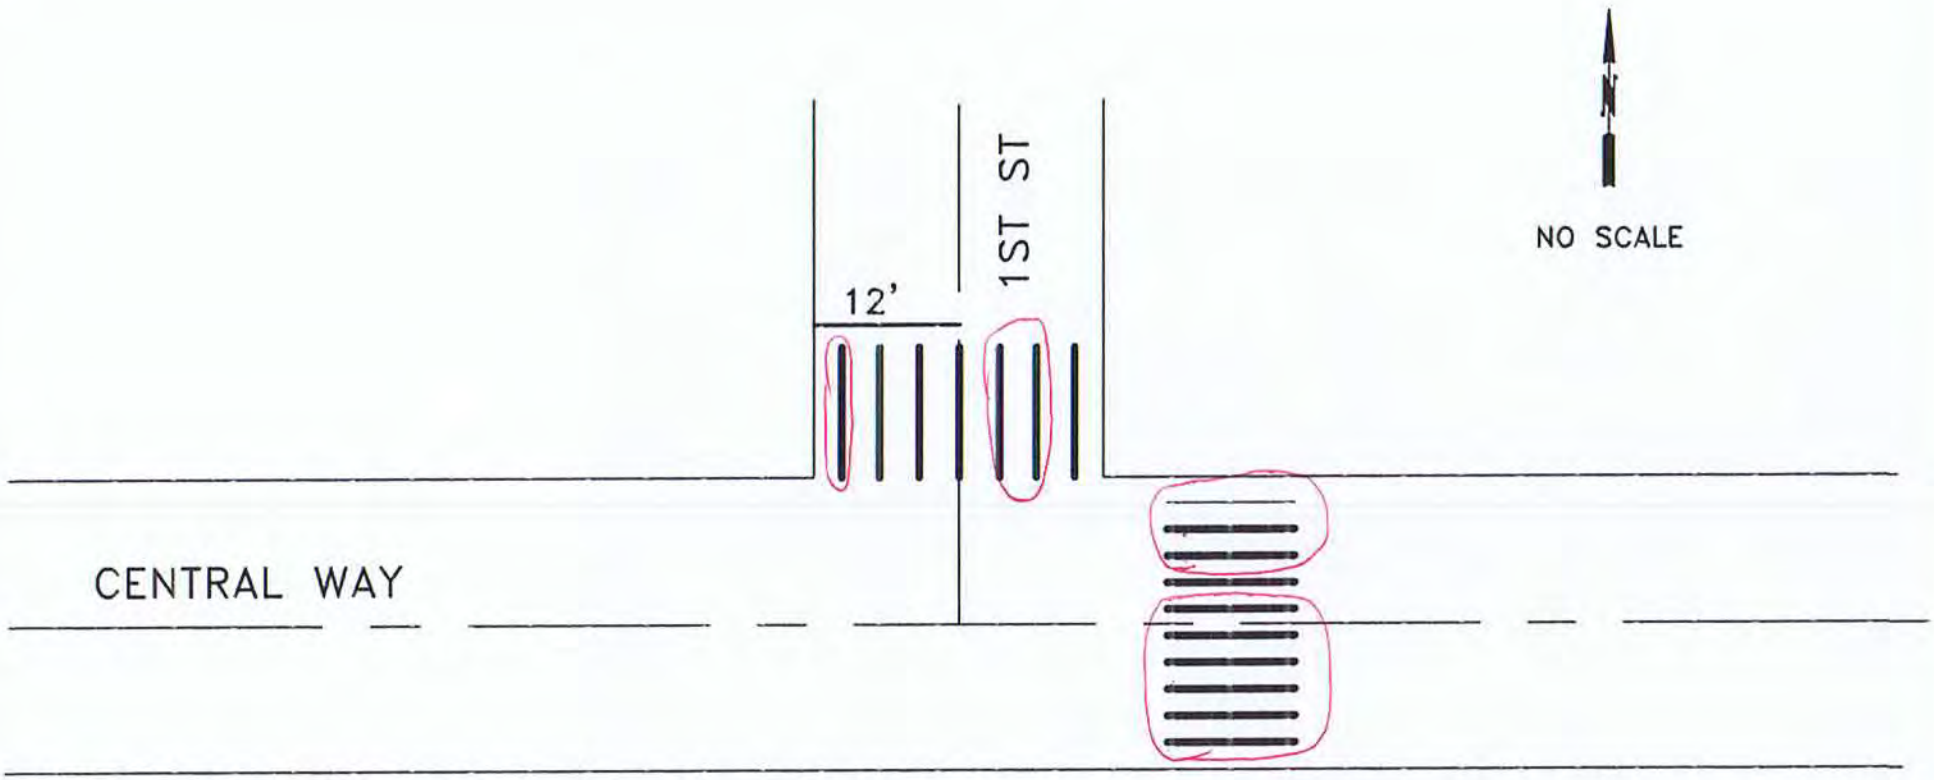

ESTIMATED QUANTITIES:

ITEM	ITEM DESCRIPTION	UNIT	INVENTORY	REPAIR QTY
PL18	PLASTIC STOP BAR, 18"	LF	12	
PLXW	PLASTIC CROSSWALK STRIPE	SF	330	230
PLARW	PLASTIC TRAFFIC ARROW	EA		
PLLTR	PLASTIC TRAFFIC LETTER, 8 FT HIGH	EA		
PLRR	PLASTIC RAILROAD SYMBOL	EA		
RPLSYM	REMOVE PL. ARROW, LETTER, SYMBOL	EA		
RRPM	REMOVE RPM	EA		
RPLXW	REMOVE PLASTIC STRIPE	SF		150

CITY OF KIRKLAND
DEPARTMENT OF PUBLIC WORKS
123 FIFTH AVENUE KIRKLAND, WA 98033
(425) 587-3800 www.kirklandwa.gov

D.GRILLEY 1/2000
DESIGNED BY: DATE

J.JENNINGS 2/2009
DRAWN BY: DATE

REVISED BY: DATE

2020 PAVEMENT MARKING PROGRAM

STREET: CENTRAL WAY

CROSS STREET: 1ST ST

SEGMENT:

SCALE: N.T.S.

FILENAME: Page 10-1

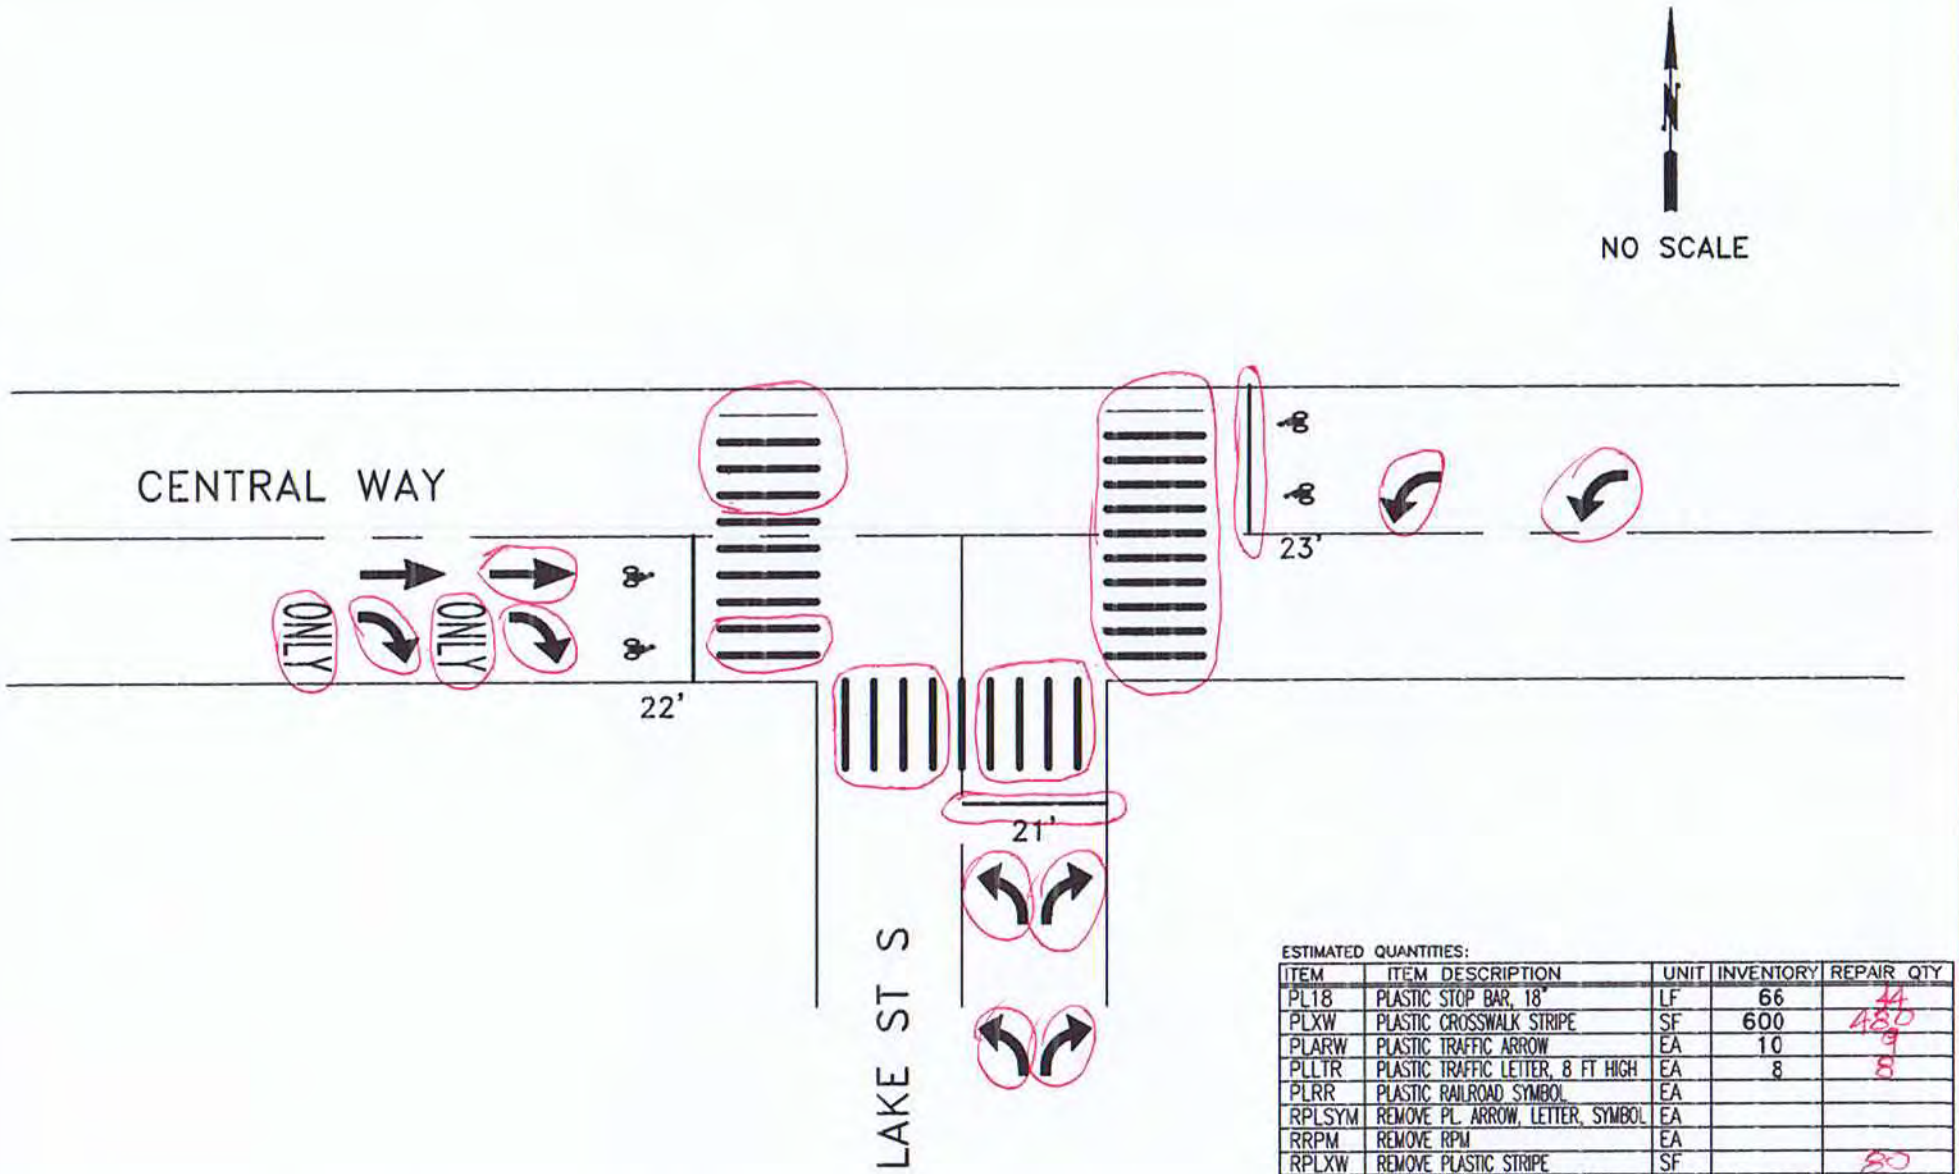

ESTIMATED QUANTITIES:

ITEM	ITEM DESCRIPTION	UNIT	INVENTORY	REPAIR QTY
PL18	PLASTIC STOP BAR, 18"	LF	66	44
PLXW	PLASTIC CROSSWALK STRIPE	SF	600	480
PLARW	PLASTIC TRAFFIC ARROW	EA	10	9
PLLTR	PLASTIC TRAFFIC LETTER, 8 FT HIGH	EA	8	8
PLRR	PLASTIC RAILROAD SYMBOL	EA		
RPLSYM	REMOVE PL. ARROW, LETTER, SYMBOL	EA		
RRPM	REMOVE RPM	EA		
RPLXW	REMOVE PLASTIC STRIPE	SF		80
	PLASTIC BIKE DETECTION SYMBOL	EA	4	

CITY OF KIRKLAND
DEPARTMENT OF PUBLIC WORKS
123 FIFTH AVENUE KIRKLAND, WA 98033
(425) 587-3800 www.kirklandwa.gov

G. HORTILLOSA 10/2006
DESIGNED BY: DATE

J.JENNINGS 10/2006
DRAWN BY: DATE

CHECKED BY: DATE

2020 PAVEMENT MARKING PROGRAM

STREET: CENTRAL WAY

CROSS STREET: LAKE ST S

SEGMENT:

SCALE: N.T.S.

FILENAME:

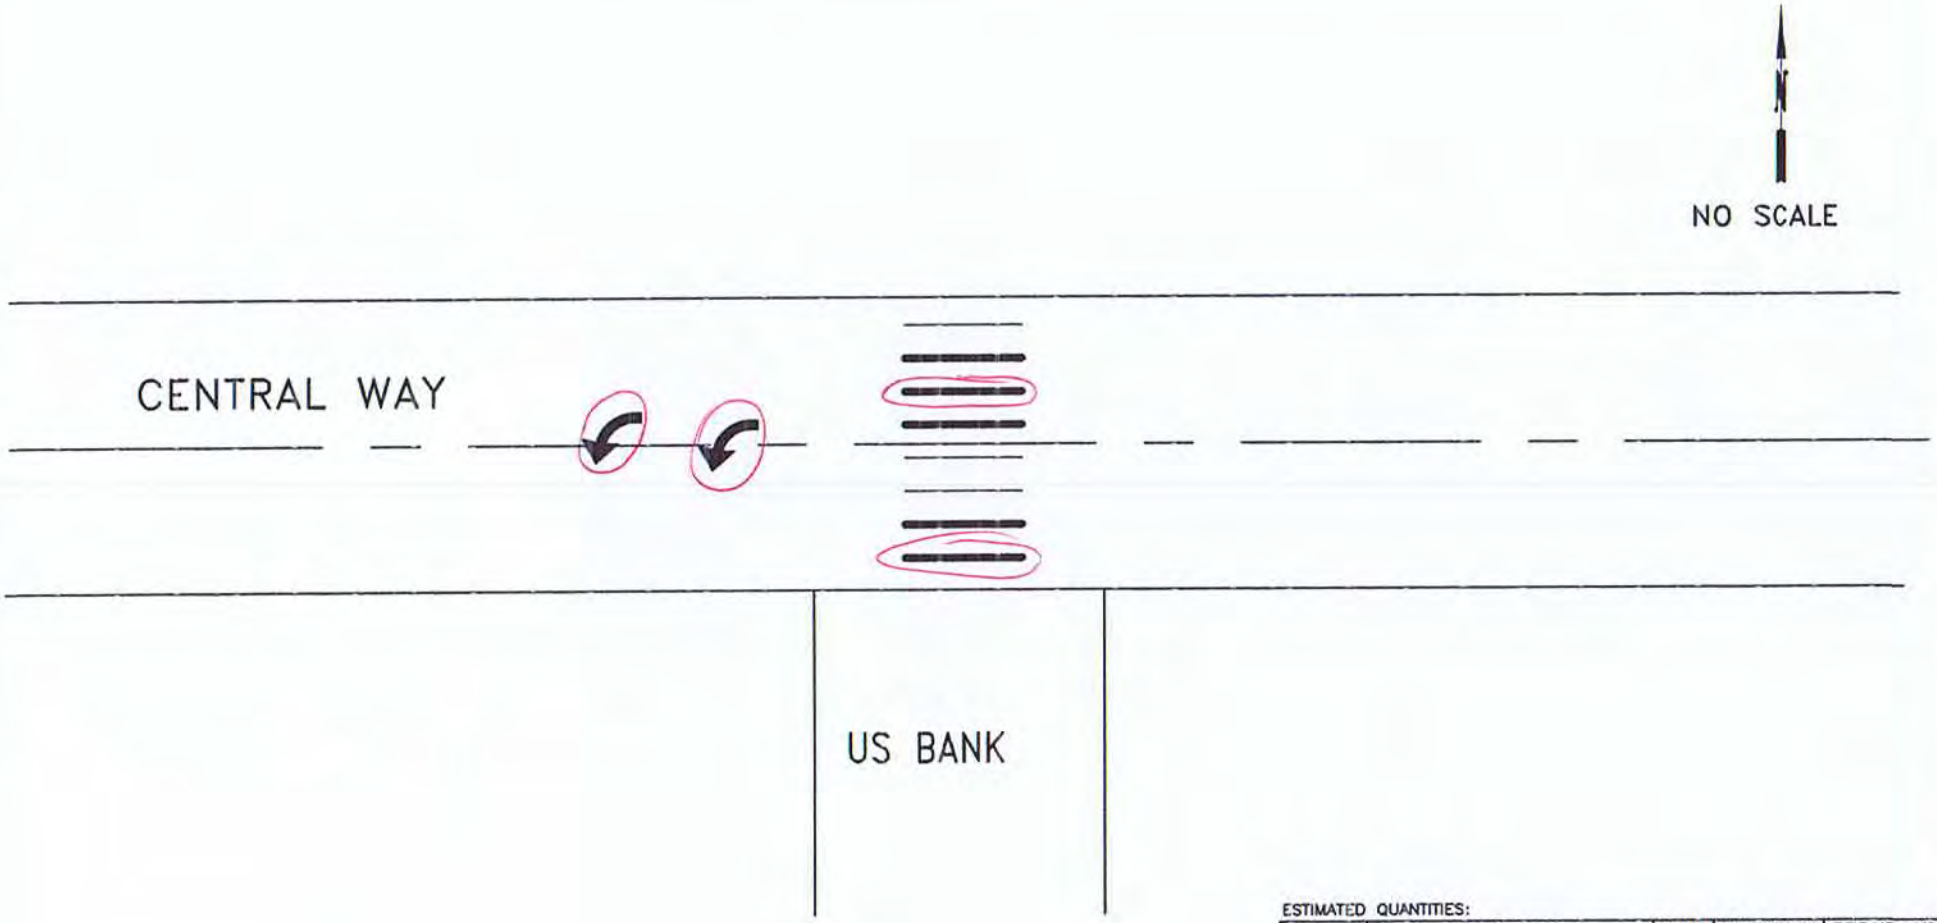

ESTIMATED QUANTITIES:

ITEM	ITEM DESCRIPTION	UNIT	INVENTORY	REPAIR QTY
PL18	PLASTIC STOP BAR, 18"	LF		
PLXW	PLASTIC CROSSWALK STRIPE	SF	130	40
PLARW	PLASTIC TRAFFIC ARROW	EA		2
PLLTR	PLASTIC TRAFFIC LETTER, 8 FT HIGH	EA		
PLRR	PLASTIC RAILROAD SYMBOL	EA		
RPLSYM	REMOVE PL. ARROW, LETTER, SYMBOL	EA		
RRPM	REMOVE RPM	EA		
RPLXW	REMOVE PLASTIC STRIPE	SF		

CITY OF KIRKLAND WASHINGTON

CITY OF KIRKLAND
DEPARTMENT OF PUBLIC WORKS
123 FIFTH AVENUE KIRKLAND, WA 98033
(425) 587-3800 www.kirklandwa.gov

G. HORTILLOSA 10/2012
DESIGNED BY: DATE

J.JENNINGS 10/2012
DRAWN BY: DATE

CHECKED BY: DATE

2020 PAVEMENT MARKING PROGRAM

STREET: CENTRAL WAY

CROSS STREET: US BANK

SEGMENT:

SCALE: N.T.S.

FILENAME: Page 10-3

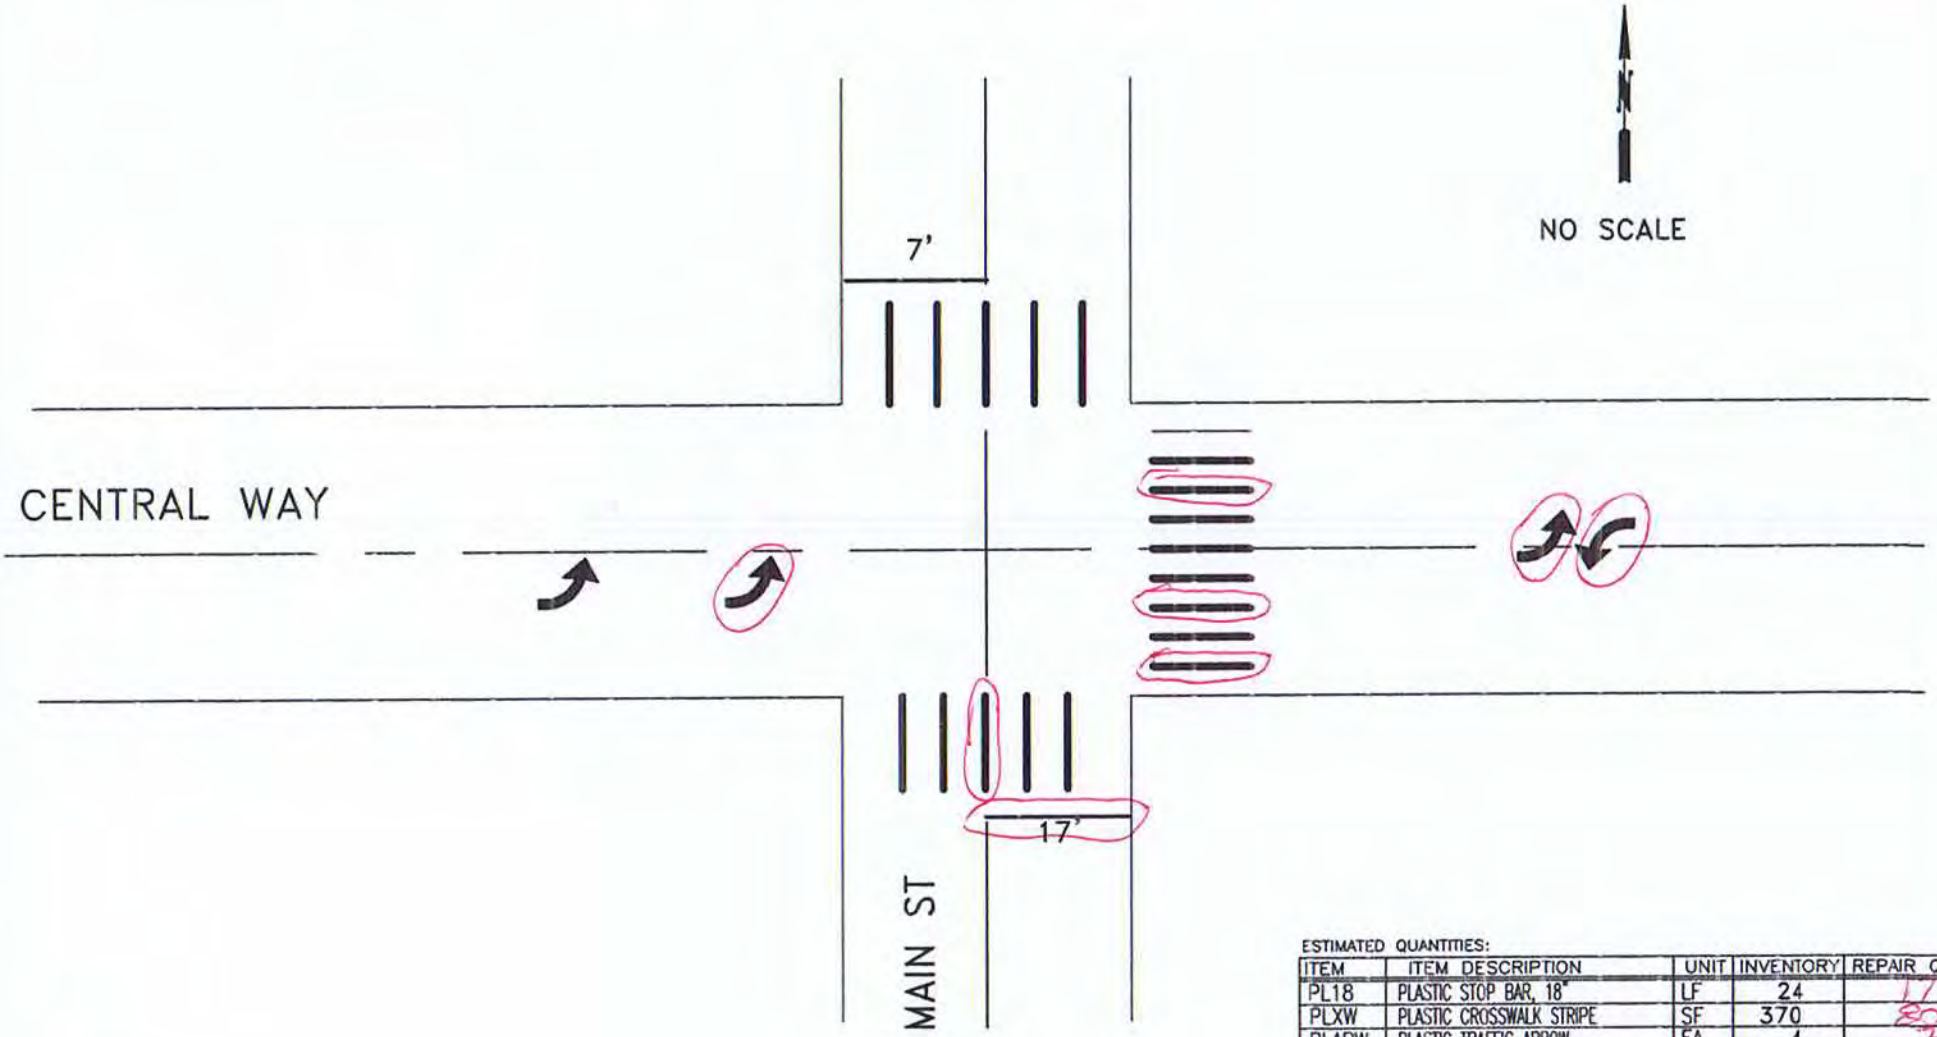

ESTIMATED QUANTITIES:

ITEM	ITEM DESCRIPTION	UNIT	INVENTORY	REPAIR QTY
PL18	PLASTIC STOP BAR, 18"	LF	24	17
PLXW	PLASTIC CROSSWALK STRIPE	SF	370	83
PLARW	PLASTIC TRAFFIC ARROW	EA	4	3
PLLTR	PLASTIC TRAFFIC LETTER, 8 FT HIGH	EA		
PLRR	PLASTIC RAILROAD SYMBOL	EA		
RPLSYM	REMOVE PL. ARROW, LETTER, SYMBOL	EA		1
RRPM	REMOVE RPM	EA		
RPLXW	REMOVE PLASTIC STRIPE	SF		

CITY OF KIRKLAND WASHINGTON

CITY OF KIRKLAND
DEPARTMENT OF PUBLIC WORKS
123 FIFTH AVENUE KIRKLAND, WA 98033
(425) 587-3800 www.kirklandwa.gov

G. HORTILLOSA 10/2006
DESIGNED BY: DATE

J.JENNINGS 10/2009
DRAWN BY: DATE

CHECKED BY: DATE

20__ PAVEMENT MARKING PROGRAM

STREET: CENTRAL WAY

CROSS STREET: MAIN STREET

SEGMENT:

SCALE: N.T.S.

FILENAME: Page 10-4

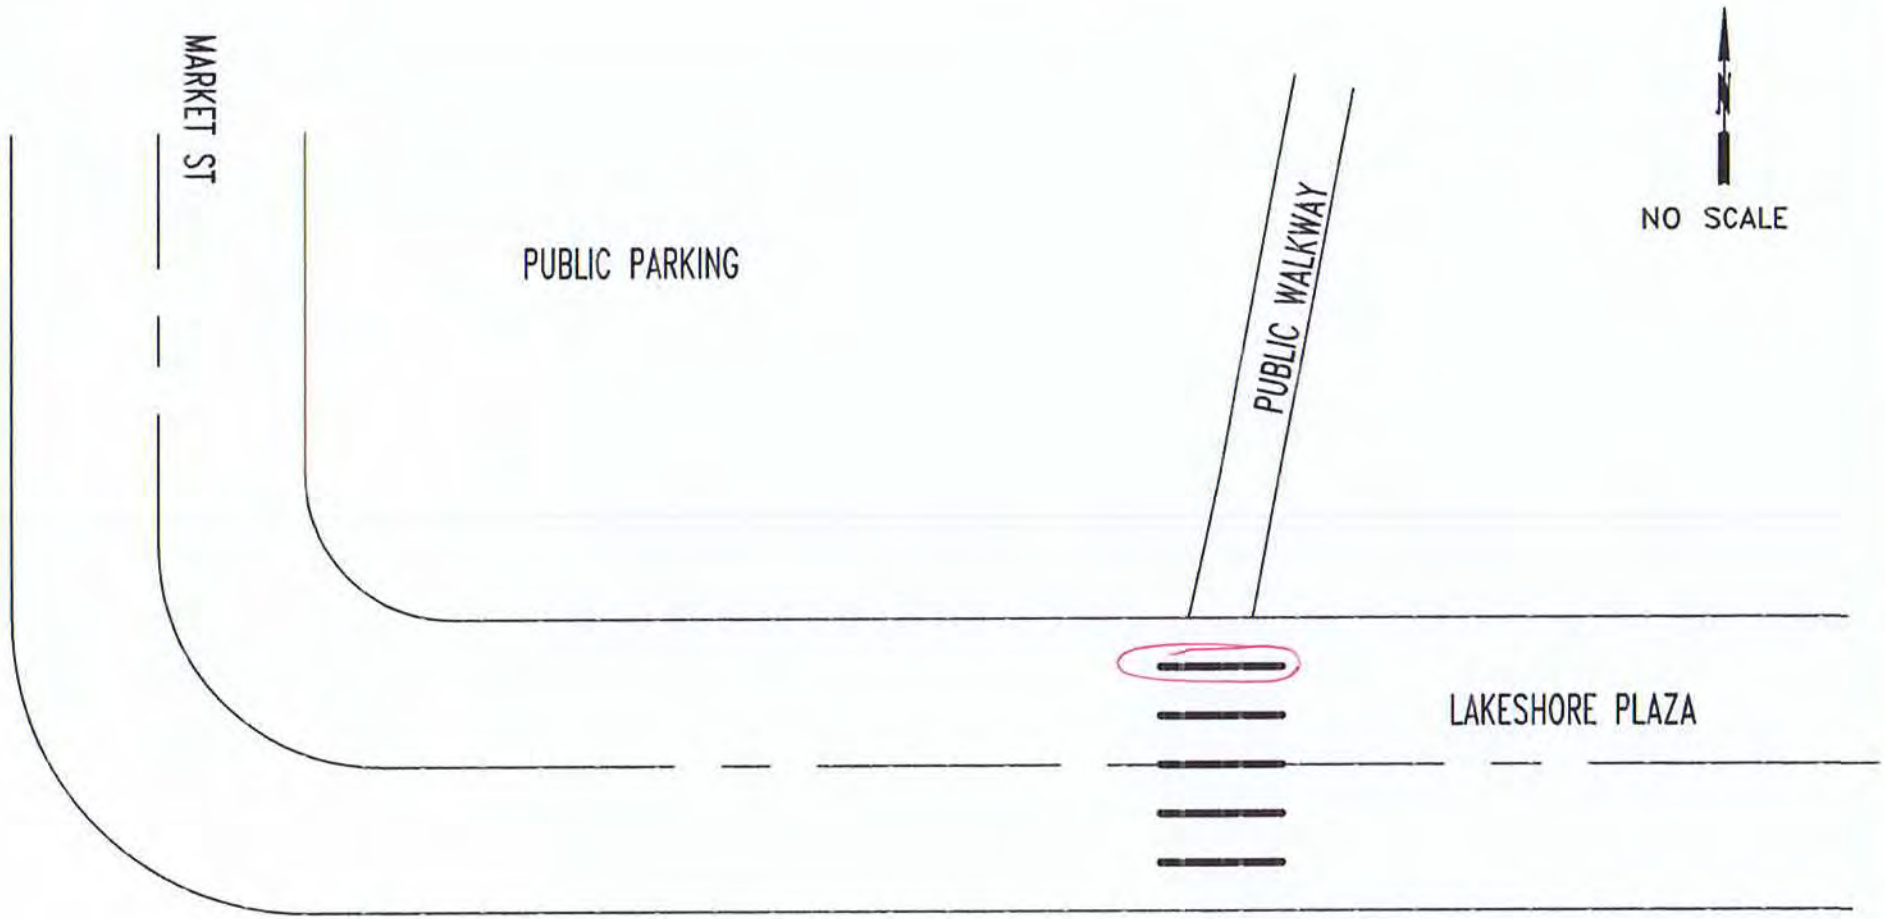

ESTIMATED QUANTITIES:

ITEM	ITEM DESCRIPTION	UNIT	INVENTORY	REPAIR QTY
PL18	PLASTIC STOP BAR, 18"	LF		
PLXW	PLASTIC CROSSWALK STRIPE	SF	100	70
PLARW	PLASTIC TRAFFIC ARROW	EA		
PLLTR	PLASTIC TRAFFIC LETTER, 8 FT HIGH	EA		
PLRR	PLASTIC RAILROAD SYMBOL	EA		
RPLSYM	REMOVE PL. ARROW, LETTER, SYMBOL	EA		
RRPM	RAISED PAVEMENT MARKER TYPE 2	EA		
RPLXW	REMOVE PLASTIC STRIPE	SF		
	REMOVE RPM	EA		

CITY OF KIRKLAND
DEPARTMENT OF PUBLIC WORKS
123 FIFTH AVENUE KIRKLAND, WA 98033
(425) 587-3800 www.kirklandwa.gov

S.GONSAR 3/2019
DESIGNED BY: DATE

J.JENNINGS 3/2019
DRAWN BY: DATE

CHECKED BY: DATE

2020 PAVEMENT MARKING PROGRAM

STREET: LAKESHORE PLAZA

CROSS STREET: MARKET ST

SEGMENT:

SCALE: N.T.S.

FILENAME: Page 10-4A

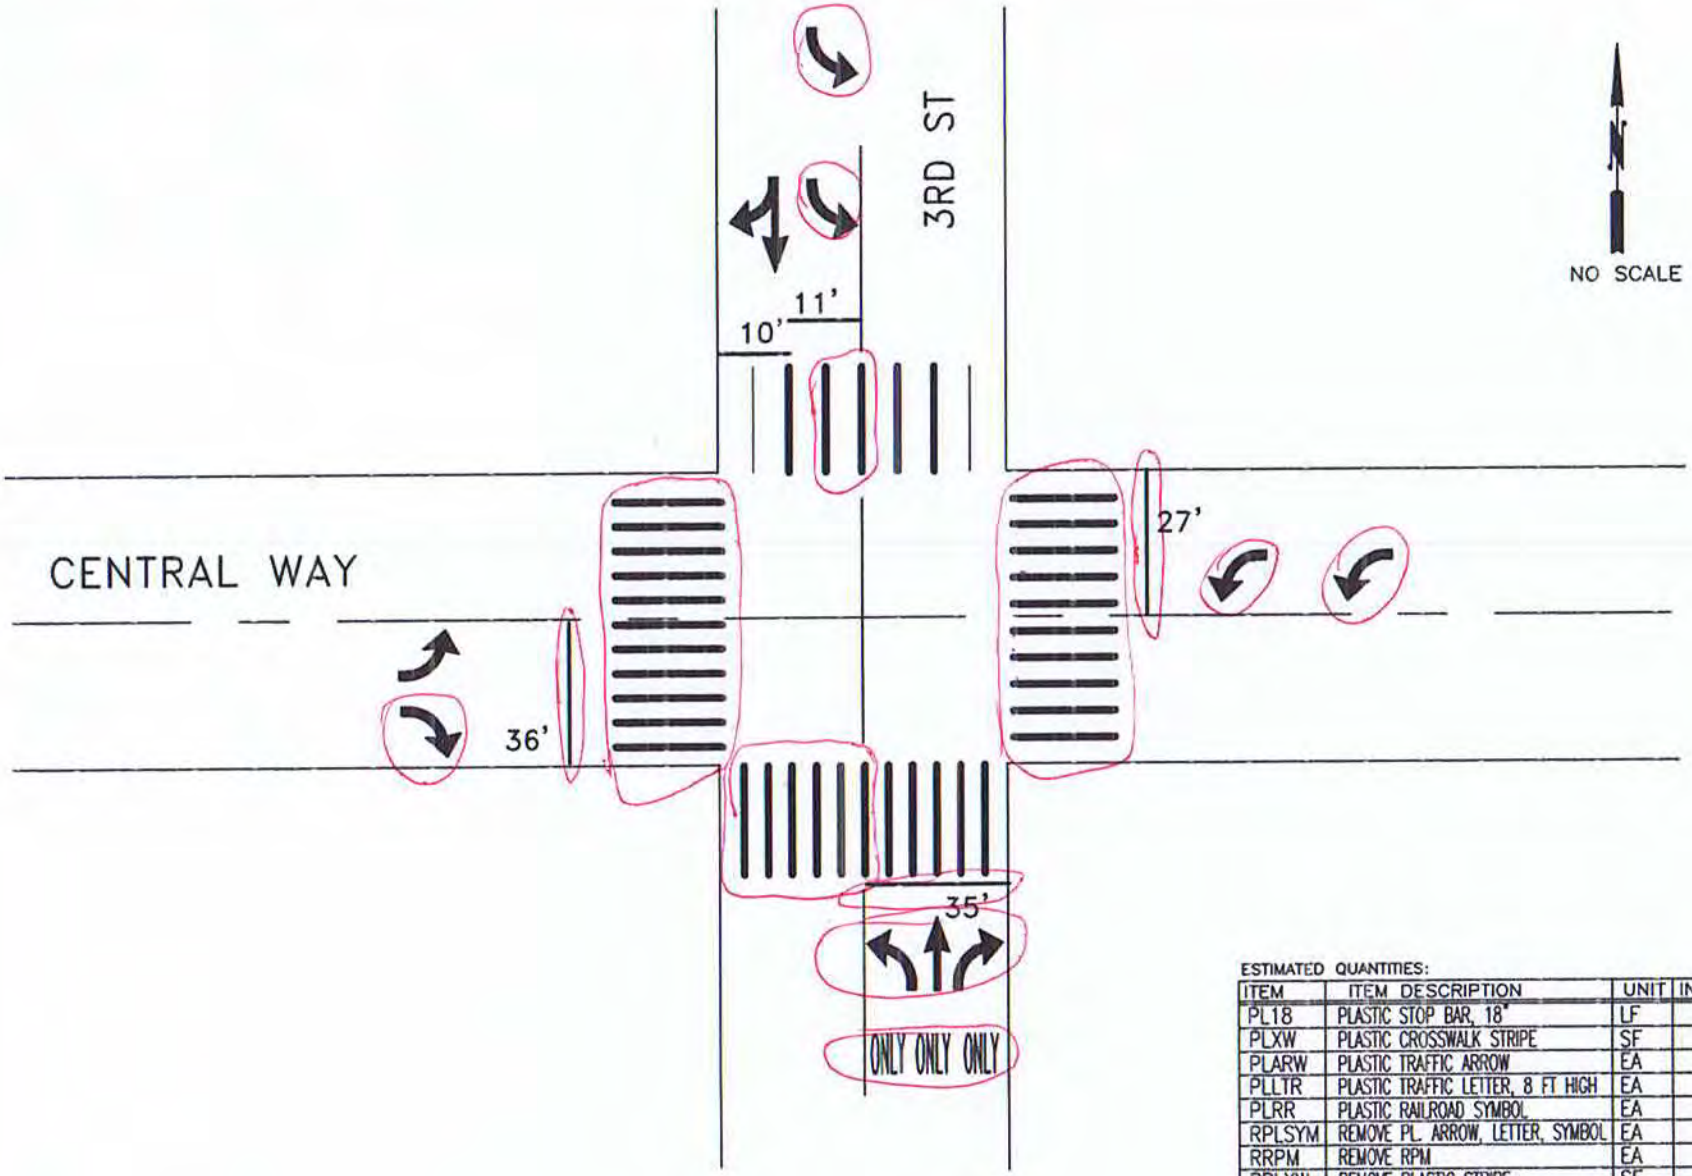

ESTIMATED QUANTITIES:

ITEM	ITEM DESCRIPTION	UNIT	INVENTORY	REPAIR QTY
PL18	PLASTIC STOP BAR, 18"	LF	119	96
PLXW	PLASTIC CROSSWALK STRIPE	SF	760	550
PLARW	PLASTIC TRAFFIC ARROW	EA	10	8
PLLTR	PLASTIC TRAFFIC LETTER, 8 FT HIGH	EA	12	12
PLRR	PLASTIC RAILROAD SYMBOL	EA		
RPLSYM	REMOVE PL. ARROW, LETTER, SYMBOL	EA		
RRPM	REMOVE RPM	EA		
RPLXW	REMOVE PLASTIC STRIPE	SF		100

CITY OF KIRKLAND
DEPARTMENT OF PUBLIC WORKS
123 FIFTH AVENUE KIRKLAND, WA 98033
(425) 587-3800 www.kirklandwa.gov

G. HORTILLOSA 10/2006
DESIGNED BY: DATE

J.JENNINGS 10/2011
DRAWN BY: DATE

CHECKED BY: DATE

2020 PAVEMENT MARKING PROGRAM

STREET: CENTRAL WAY

CROSS STREET: 3RD STREET

SEGMENT:

SCALE: N.T.S.

FILENAME:

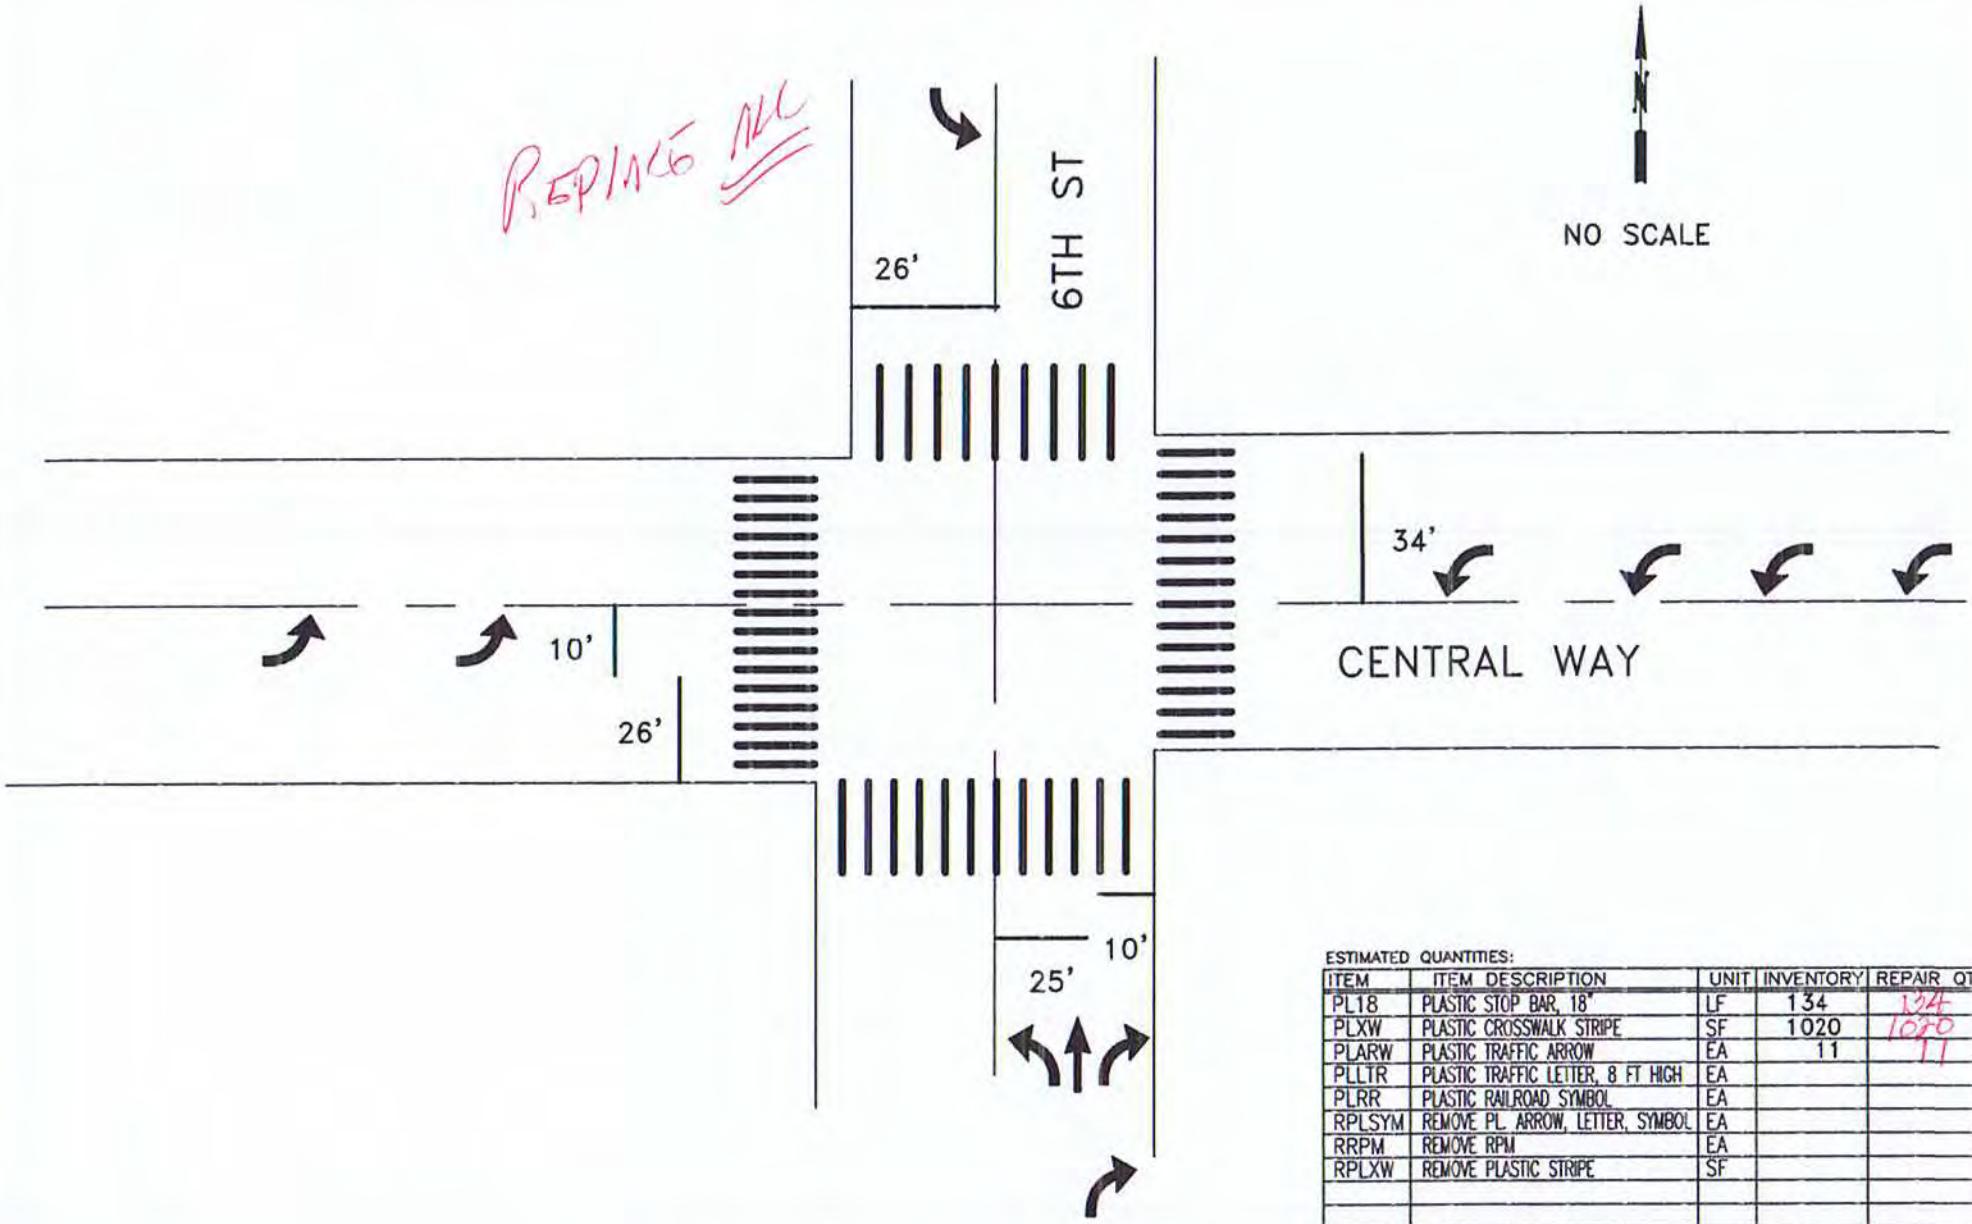

ESTIMATED QUANTITIES:

ITEM	ITEM DESCRIPTION	UNIT	INVENTORY	REPAIR QTY
PL18	PLASTIC STOP BAR, 18"	LF	134	134
PLXW	PLASTIC CROSSWALK STRIPE	SF	1020	1020
PLARW	PLASTIC TRAFFIC ARROW	EA	11	11
PLLTR	PLASTIC TRAFFIC LETTER, 8 FT HIGH	EA		
PLRR	PLASTIC RAILROAD SYMBOL	EA		
RPLSYM	REMOVE PL. ARROW, LETTER, SYMBOL	EA		
RRPM	REMOVE RPM	EA		
RPLXW	REMOVE PLASTIC STRIPE	SF		

CITY OF KIRKLAND WASHINGTON

CITY OF KIRKLAND
DEPARTMENT OF PUBLIC WORKS
123 FIFTH AVENUE KIRKLAND, WA 98033
(425) 587-3800 www.kirklandwa.gov

G. HORTILLOSA 2/2012
DESIGNED BY: DATE

J.JENNINGS 2/2012
DRAWN BY: DATE

CHECKED BY: DATE

2012 PAVEMENT MARKING PROGRAM

STREET: CENTRAL WAY

CROSS STREET: 6TH ST

SEGMENT:

SCALE: N.T.S.

FILENAME: Page 10-8

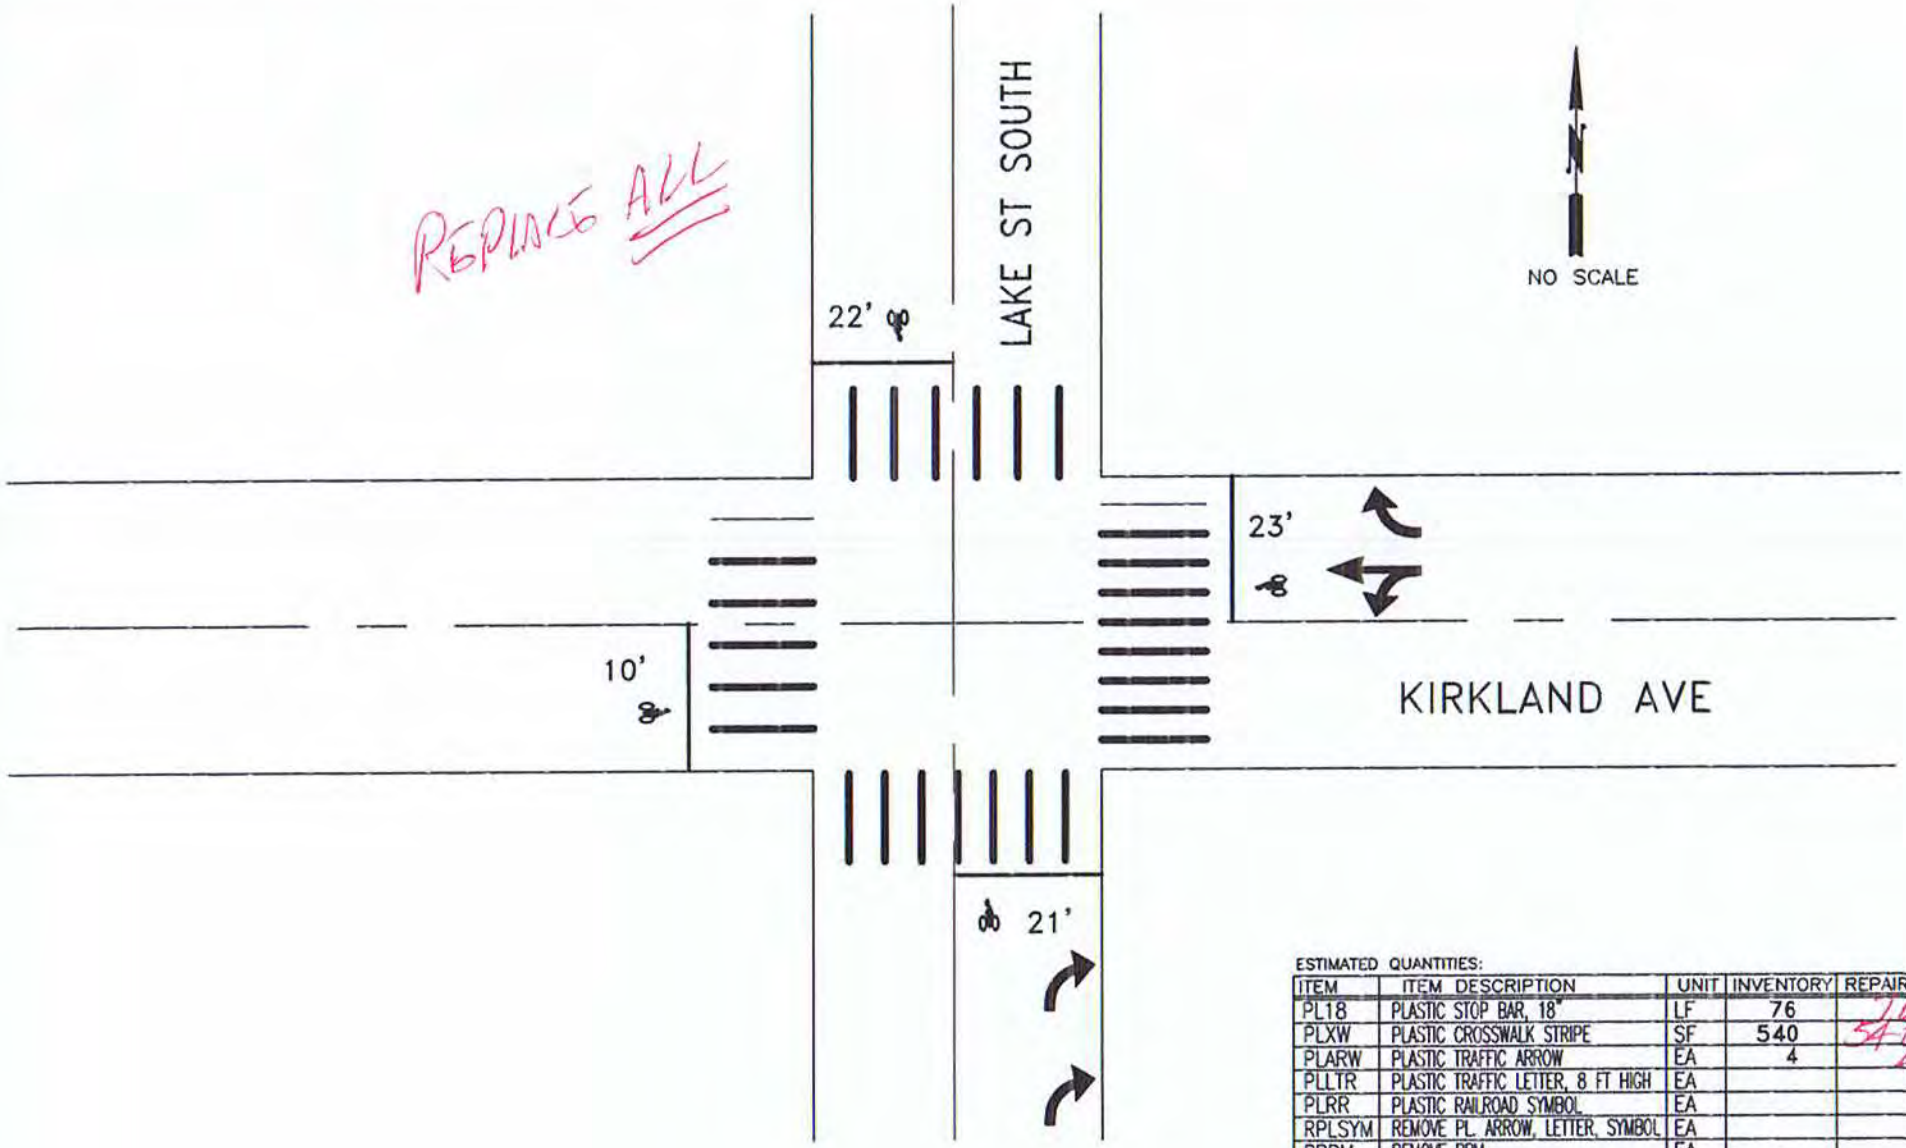

ESTIMATED QUANTITIES:

ITEM	ITEM DESCRIPTION	UNIT	INVENTORY	REPAIR QTY
PL18	PLASTIC STOP BAR, 18"	LF	76	76
PLXW	PLASTIC CROSSWALK STRIPE	SF	540	540
PLARW	PLASTIC TRAFFIC ARROW	EA	4	4
PLLTR	PLASTIC TRAFFIC LETTER, 8 FT HIGH	EA		
PLRR	PLASTIC RAILROAD SYMBOL	EA		
RPLSYM	REMOVE PL. ARROW, LETTER, SYMBOL	EA		
RRPM	REMOVE RPM	EA		
RPLXW	REMOVE PLASTIC STRIPE	SF		
	PLASTIC BIKE DETECTION SYMBOL	EA	4	

CITY OF KIRKLAND WASHINGTON

CITY OF KIRKLAND
DEPARTMENT OF PUBLIC WORKS
123 FIFTH AVENUE KIRKLAND, WA 98033
(425) 587-3800 www.kirklandwa.gov

G. HORTILLOSA 10/2006
DESIGNED BY: DATE

J.JENNINGS 10/2011
DRAWN BY: DATE

CHECKED BY: DATE

2022 PAVEMENT MARKING PROGRAM

STREET: KIRKLAND AVENUE

CROSS STREET: LAKE ST SOUTH

SEGMENT:

SCALE: N.T.S.

FILENAME: Page 10-9

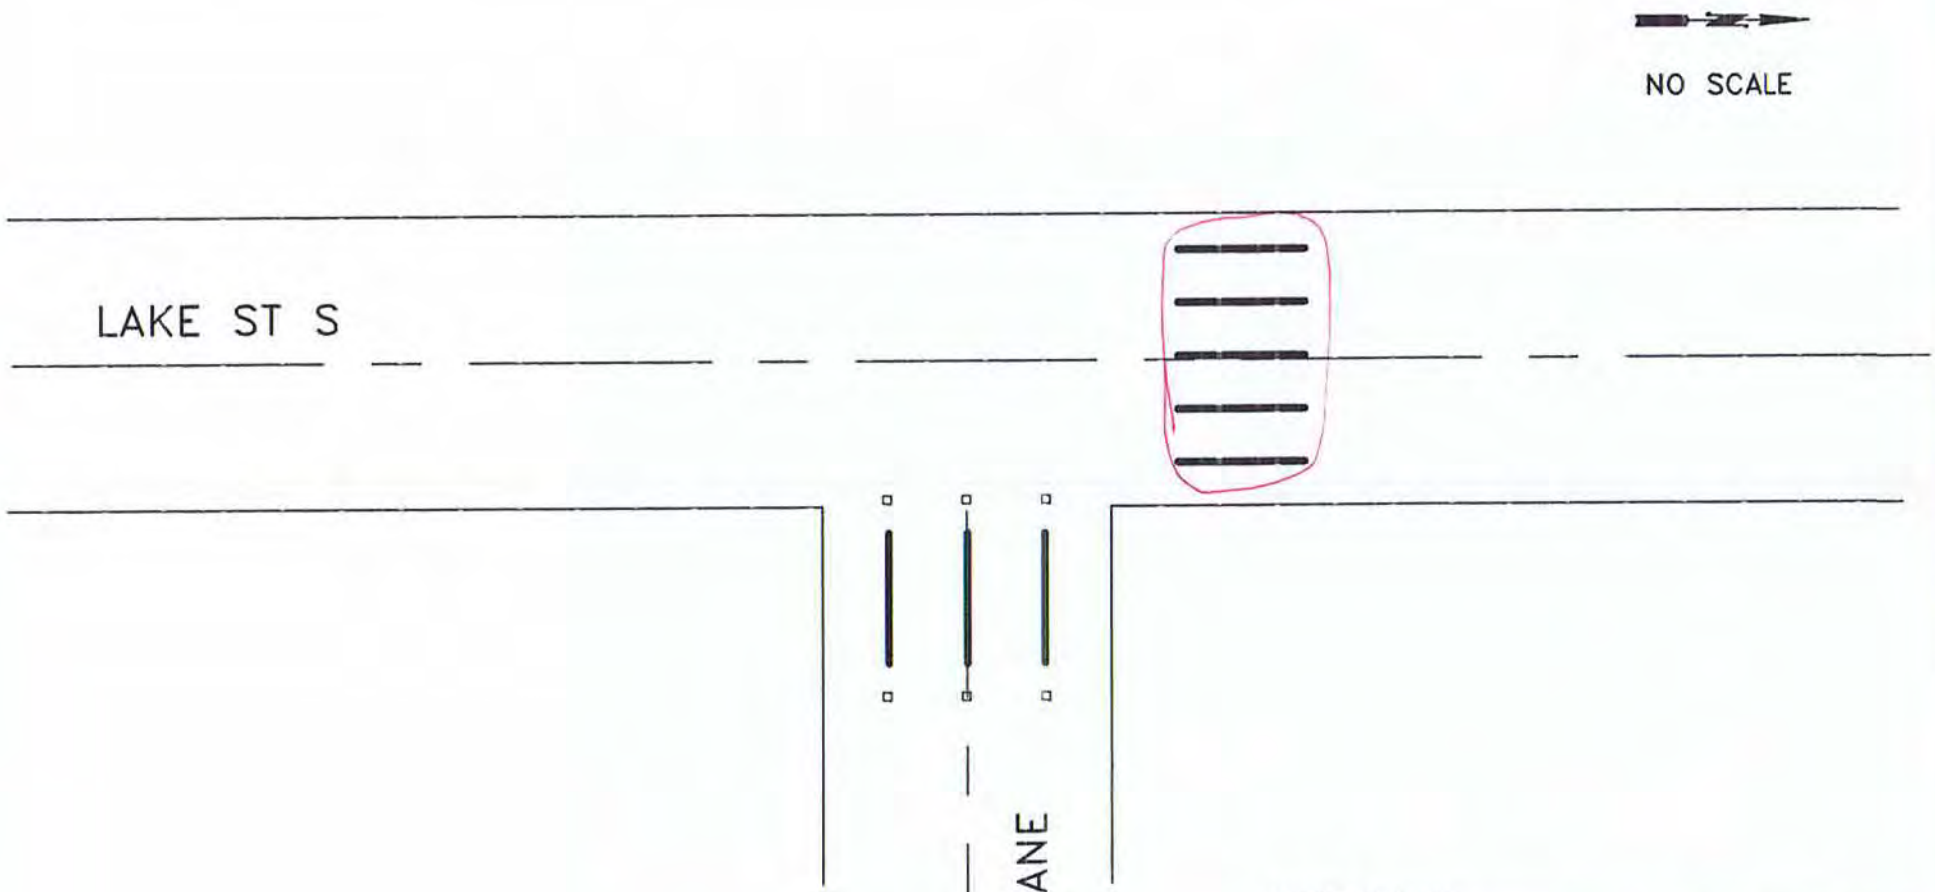

ESTIMATED QUANTITIES:

ITEM	ITEM DESCRIPTION	UNIT	INVENTORY	REPAIR QTY
PL18	PLASTIC STOP BAR, 18"	LF		
PLXW	PLASTIC CROSSWALK STRIPE	SF	160	100
PLARW	PLASTIC TRAFFIC ARROW	EA		
PLLTR	PLASTIC TRAFFIC LETTER, 8 FT HIGH	EA		
PLRR	PLASTIC RAILROAD SYMBOL	EA		
RPLSYM	REMOVE PL. ARROW, LETTER, SYMBOL	EA		
RRPM	REMOVE RPM	EA		
RPLXW	REMOVE PLASTIC STRIPE	SF		100
	RAISED PAVEMENT MARKER TYPE 2	EA	6	

CITY OF KIRKLAND WASHINGTON

CITY OF KIRKLAND
DEPARTMENT OF PUBLIC WORKS
123 FIFTH AVENUE KIRKLAND, WA 98033
(425) 587-3800 www.kirklandwa.gov

S. GONSAR 2/2018
DESIGNED BY: DATE

J.JENNINGS 2/2018
DRAWN BY: DATE

REVISED BY: DATE

2020 PAVEMENT MARKING PROGRAM

STREET: LAKE ST S

CROSS STREET: PARK LANE

SEGMENT:

SCALE: N.T.S.

FILENAME: Page 10-9A

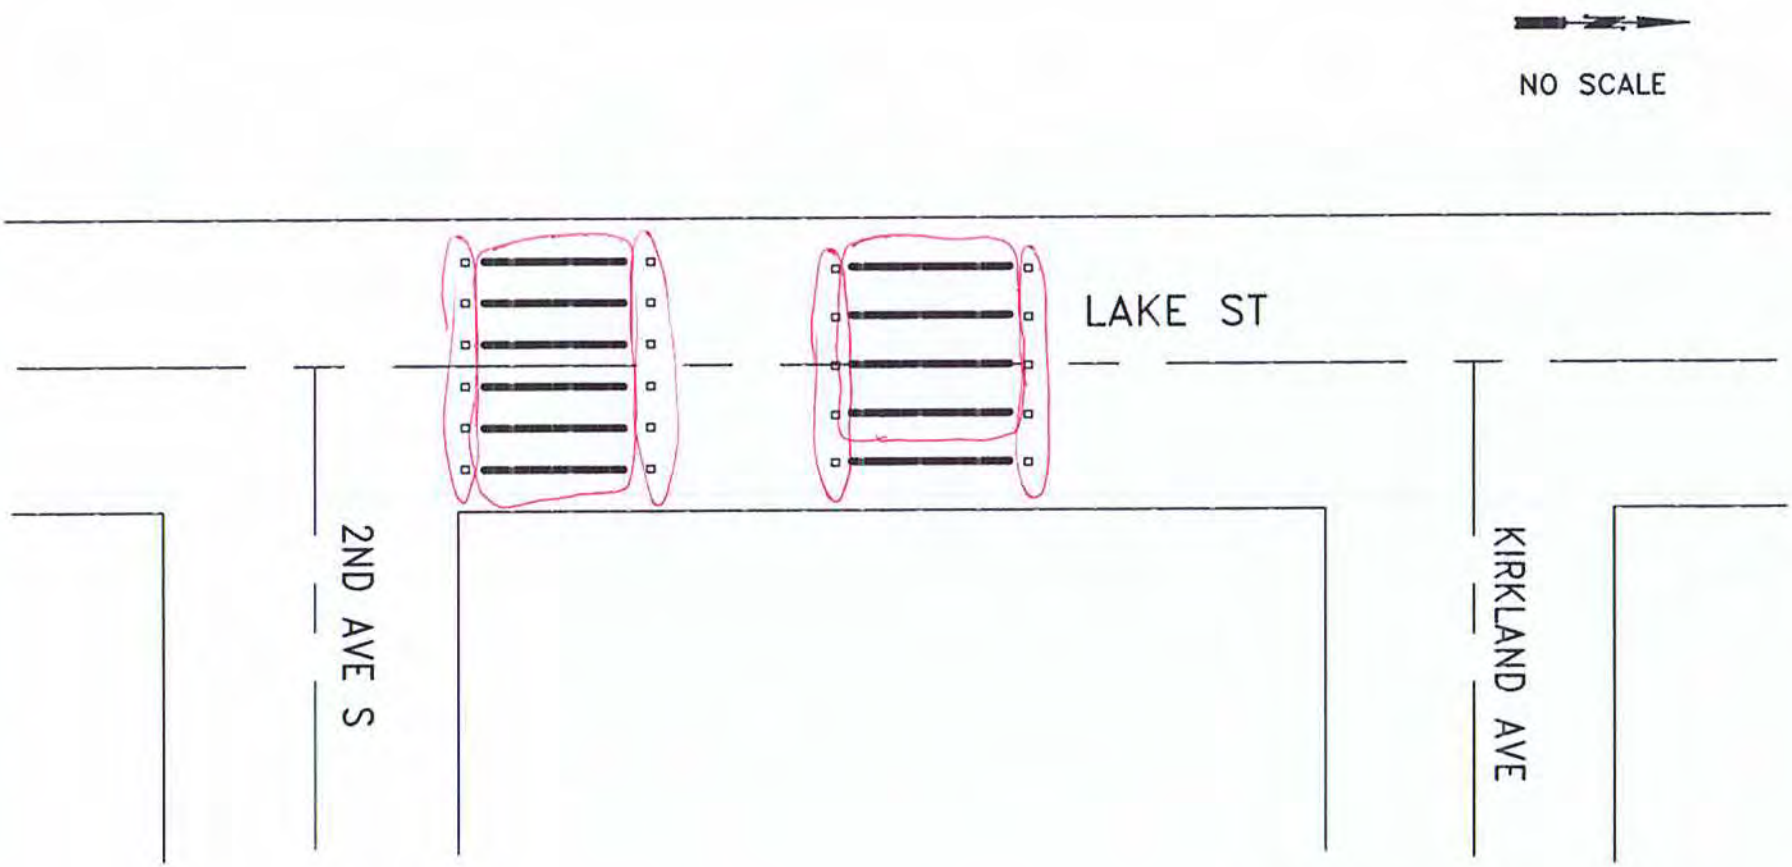

ESTIMATED QUANTITIES:

ITEM	ITEM DESCRIPTION	UNIT	INVENTORY	REPAIR QTY
PL18	PLASTIC STOP BAR, 18"	LF		
PLXW	PLASTIC CROSSWALK STRIPE	SF	220	200
PLARW	PLASTIC TRAFFIC ARROW	EA		
PLLTR	PLASTIC TRAFFIC LETTER, 8 FT HIGH	EA		
PLRR	PLASTIC RAILROAD SYMBOL	EA		
RPLSYM	REMOVE PL. ARROW, LETTER, SYMBOL	EA		
RRPM	REMOVE RPM	EA		5
RPLXW	REMOVE PLASTIC STRIPE	SF		
	RAISED PAVEMENT MARKER TYPE 2		22	22

CITY OF KIRKLAND
DEPARTMENT OF PUBLIC WORKS
123 FIFTH AVENUE KIRKLAND, WA 98033
(425) 587-3800 www.kirklandwa.gov

D.GRILLEY 1/2000
DESIGNED BY: DATE

J.JENNINGS 1/2000
DRAWN BY: DATE

CHECKED BY: DATE

2022 PAVEMENT MARKING PROGRAM

STREET: LAKE ST S

CROSS STREET: KIRKLAND AVE TO 2ND ST SO

SEGMENT:

SCALE: N.T.S.

FILENAME: Page 10-10

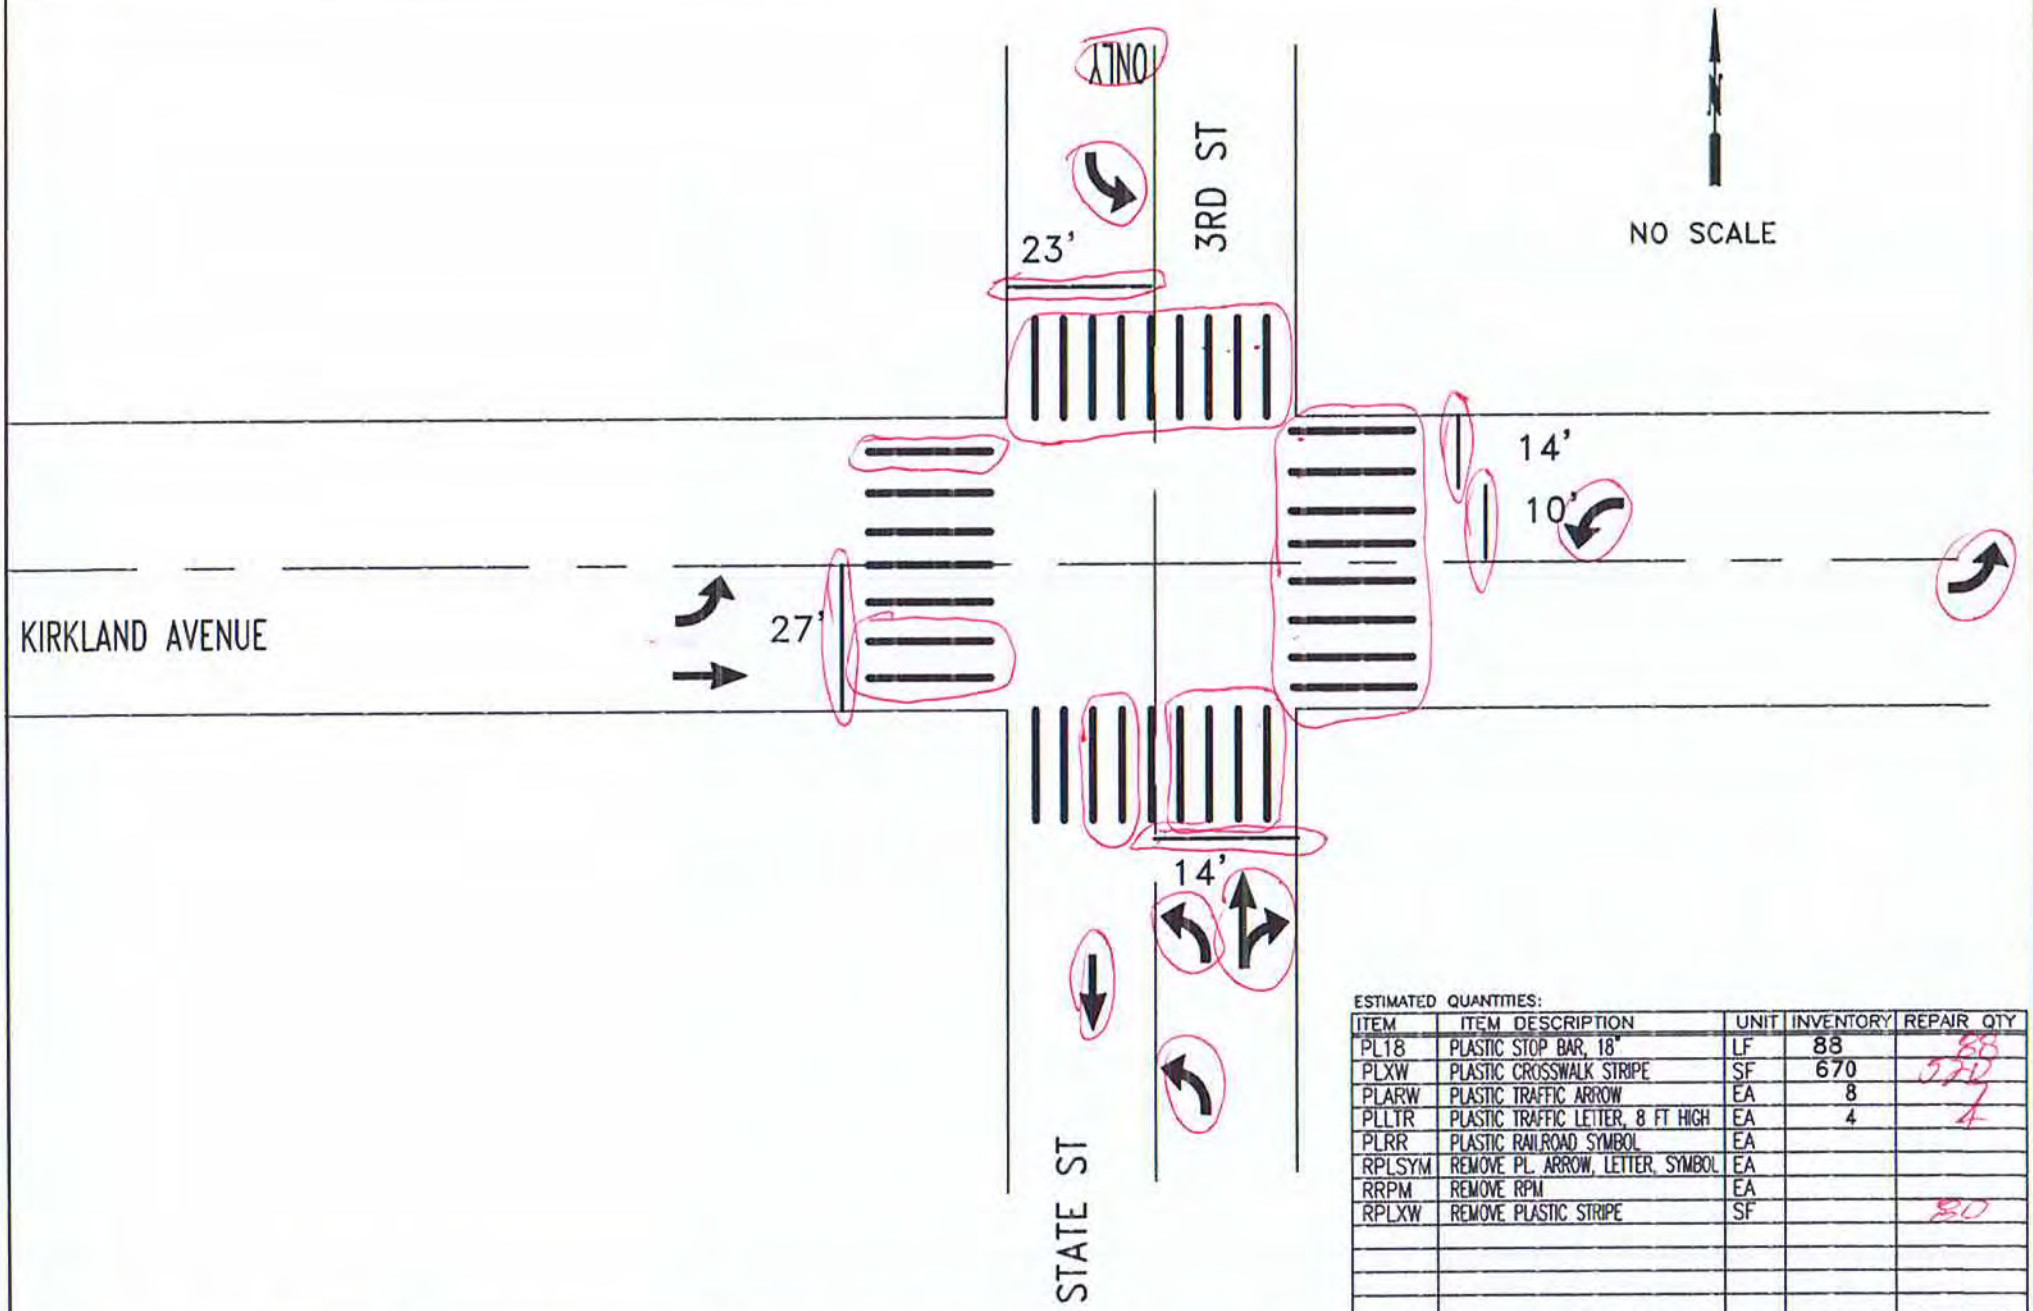

ESTIMATED QUANTITIES:

ITEM	ITEM DESCRIPTION	UNIT	INVENTORY	REPAIR QTY
PL18	PLASTIC STOP BAR, 18"	LF	88	88
PLXW	PLASTIC CROSSWALK STRIPE	SF	670	320
PLARW	PLASTIC TRAFFIC ARROW	EA	8	4
PLLTR	PLASTIC TRAFFIC LETTER, 8 FT HIGH	EA	4	4
PLRR	PLASTIC RAILROAD SYMBOL	EA		
RPLSYM	REMOVE PL. ARROW, LETTER, SYMBOL	EA		
RRPM	REMOVE RPM	EA		
RPLXW	REMOVE PLASTIC STRIPE	SF		20

CITY OF KIRKLAND
DEPARTMENT OF PUBLIC WORKS
123 FIFTH AVENUE KIRKLAND, WA 98033
(425) 587-3800 www.kirklandwa.gov

G. HORTILLOSA 2/2012
DESIGNED BY: DATE

J.JENNINGS 2/2012
DRAWN BY: DATE

CHECKED BY: DATE

2020 PAVEMENT MARKING PROGRAM

STREET: 3RD ST

CROSS STREET: KIRKLAND AVENUE

SEGMENT:

SCALE: N.T.S.

FILENAME: PAGE 10-11

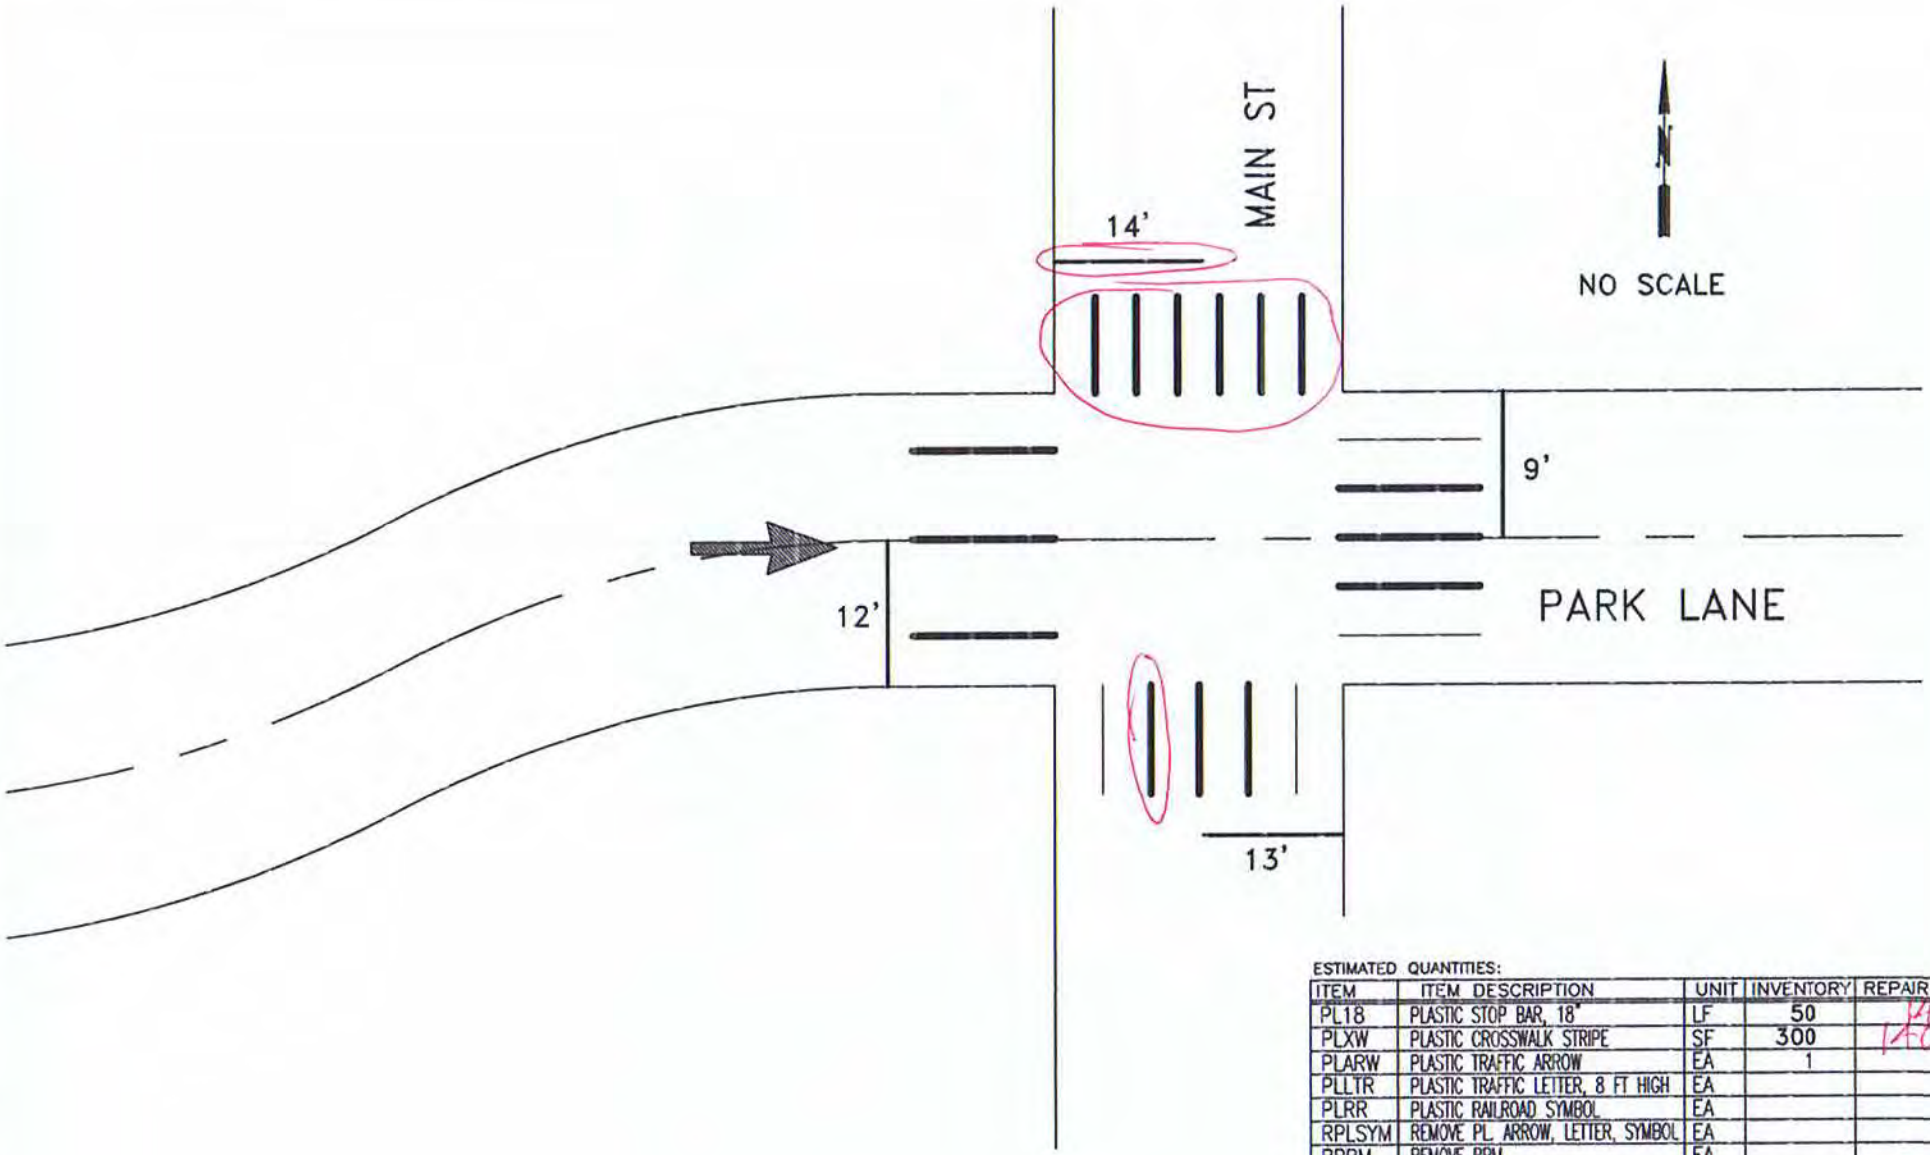

ESTIMATED QUANTITIES:

ITEM	ITEM DESCRIPTION	UNIT	INVENTORY	REPAIR QTY
PL18	PLASTIC STOP BAR, 18"	LF	50	14
PLXW	PLASTIC CROSSWALK STRIPE	SF	300	140
PLARW	PLASTIC TRAFFIC ARROW	EA	1	
PLLTR	PLASTIC TRAFFIC LETTER, 8 FT HIGH	EA		
PLRR	PLASTIC RAILROAD SYMBOL	EA		
RPLSYM	REMOVE PL. ARROW, LETTER, SYMBOL	EA		
RRPM	REMOVE RPM	EA		
RPLXW	REMOVE PLASTIC STRIPE	SF		60

CITY OF KIRKLAND WASHINGTON

CITY OF KIRKLAND
DEPARTMENT OF PUBLIC WORKS
123 FIFTH AVENUE KIRKLAND, WA 98033
(425) 587-3800 www.kirklandwa.gov

G. HORTILLOSA 4/2008
DESIGNED BY: DATE

J.JENNINGS 4/2008
DRAWN BY: DATE

CHECKED BY: DATE

2022 PAVEMENT MARKING PROGRAM

STREET: MAIN ST

CROSS STREET: PARK LANE

SEGMENT:

SCALE: N.T.S.

FILENAME:

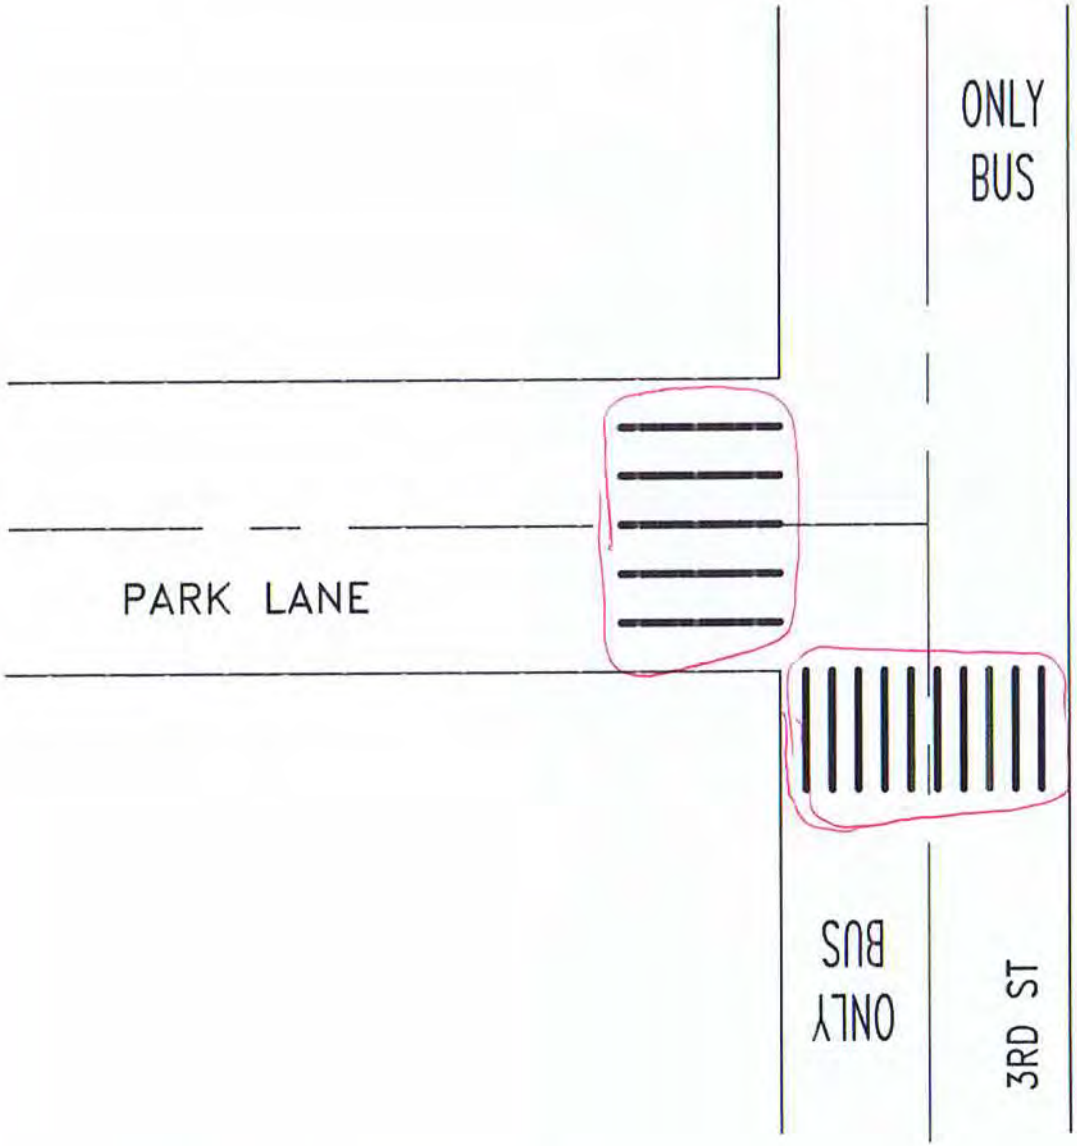

NO SCALE

ESTIMATED QUANTITIES:

ITEM	ITEM DESCRIPTION	UNIT	INVENTORY	REPAIR QTY
PL18	PLASTIC STOP BAR, 18"	LF		
PLXW	PLASTIC CROSSWALK STRIPE	SF	300	300
PLARW	PLASTIC TRAFFIC ARROW	EA		
PLLTR	PLASTIC TRAFFIC LETTER, 8 FT HIGH	EA	14	
PLRR	PLASTIC RAILROAD SYMBOL	EA		
RPLSYM	REMOVE PL. ARROW, LETTER, SYMBOL	EA		
RRPM	REMOVE RPM	EA		
RPLXW	REMOVE PLASTIC STRIPE	SF		100

CITY OF KIRKLAND
DEPARTMENT OF PUBLIC WORKS
123 FIFTH AVENUE KIRKLAND, WA 98033
(425) 587-3800 www.kirklandwa.gov

F. LEE 4/2015
DESIGNED BY: DATE

J.JENNINGS 4/2015
DRAWN BY: DATE

CHECKED BY: DATE

2020 PAVEMENT MARKING PROGRAM

STREET: 3RD ST

CROSS STREET: PARK LANE

SEGMENT:

SCALE: N.T.S.

FILENAME:

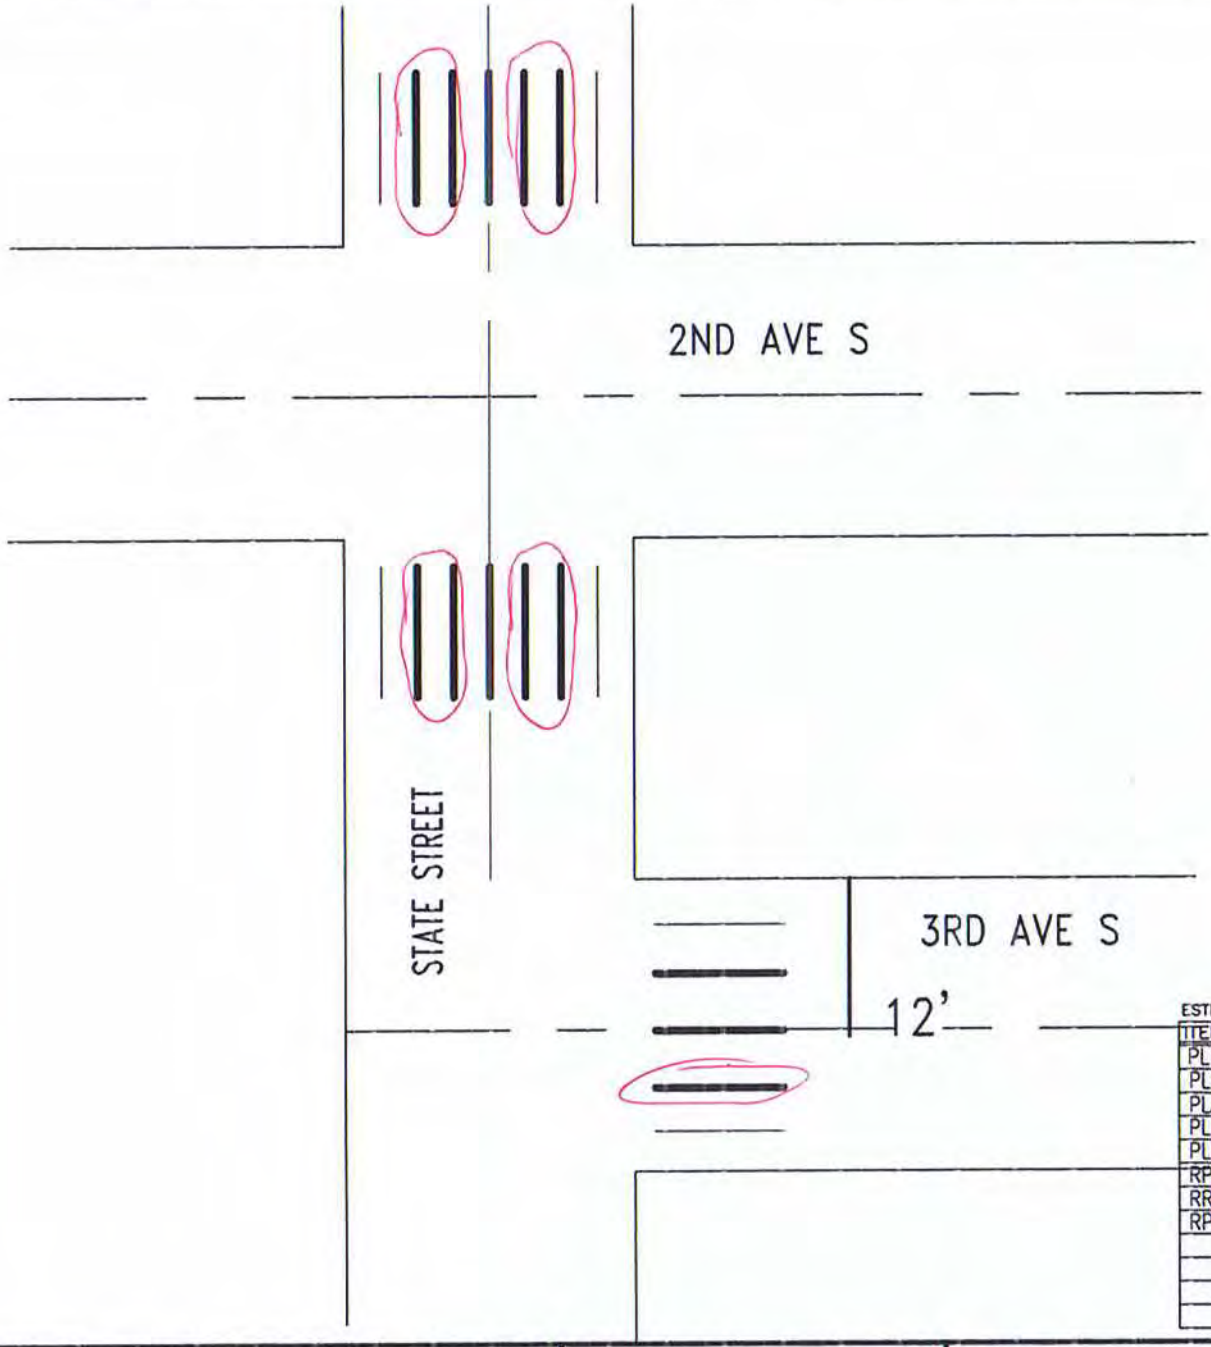

NO SCALE

ESTIMATED QUANTITIES:

ITEM	ITEM DESCRIPTION	UNIT	INVENTORY	REPAIR QTY
PL18	PLASTIC STOP BAR, 18"	LF	12	
PLXW	PLASTIC CROSSWALK STRIPE	SF	320	180
PLARW	PLASTIC TRAFFIC ARROW	EA		
PLLTR	PLASTIC TRAFFIC LETTER, 8 FT HIGH	EA		
PLRR	PLASTIC RAILROAD SYMBOL	EA		
RPLSYM	REMOVE PL. ARROW, LETTER, SYMBOL	EA		
RRPM	REMOVE RPM	EA		
RPLXW	REMOVE PLASTIC STRIPE	SF		

CITY OF KIRKLAND
DEPARTMENT OF PUBLIC WORKS
123 FIFTH AVENUE KIRKLAND, WA 98033
(425) 587-3800 www.kirklandwa.gov

L. KAWAOKA 7/2016
DESIGNED BY: DATE

J.JENNINGS 7/2016
DRAWN BY: DATE

CHECKED BY: DATE

2020 PAVEMENT MARKING PROGRAM

STREET: STATE ST

CROSS STREET: 2ND AVE S

SEGMENT:

SCALE: N.T.S.

FILENAME:

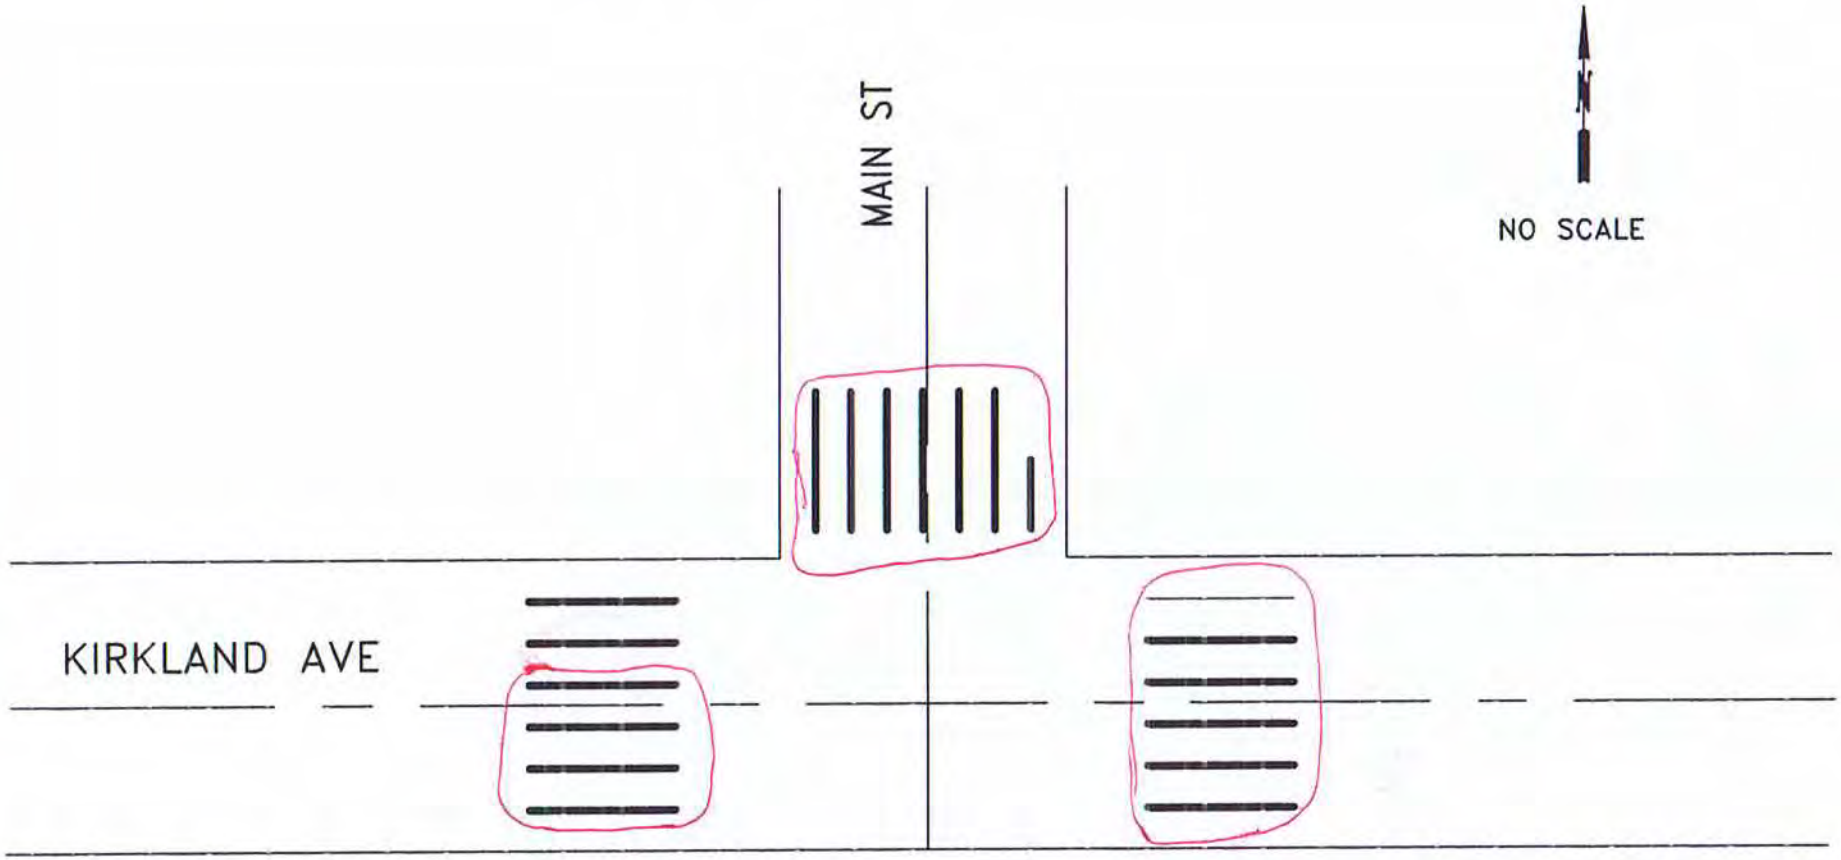

ESTIMATED QUANTITIES:

ITEM	ITEM DESCRIPTION	UNIT	INVENTORY	REPAIR QTY
PL18	PLASTIC STOP BAR, 18"	LF		
PLXW	PLASTIC CROSSWALK STRIPE	SF	360	320
PLARW	PLASTIC TRAFFIC ARROW	EA		
PLLTR	PLASTIC TRAFFIC LETTER, 8 FT HIGH	EA		
PLRR	PLASTIC RAILROAD SYMBOL	EA		
RPLSYM	REMOVE PL. ARROW, LETTER, SYMBOL	EA		
RRPM	REMOVE RPM	EA		
RPLXW	REMOVE PLASTIC STRIPE	SF		60

CITY OF KIRKLAND
DEPARTMENT OF PUBLIC WORKS
123 FIFTH AVENUE KIRKLAND, WA 98033
(425) 587-3800 www.kirklandwa.gov

G. HORTILLOSA 3/2009
DESIGNED BY: DATE

J.JENNINGS 10/2011
DRAWN BY: DATE

CHECKED BY: DATE

2020 PAVEMENT MARKING PROGRAM

STREET: KIRKLAND AVENUE

CROSS STREET: MAIN STREET

SEGMENT:

SCALE: N.T.S.

FILENAME: Page 10-15

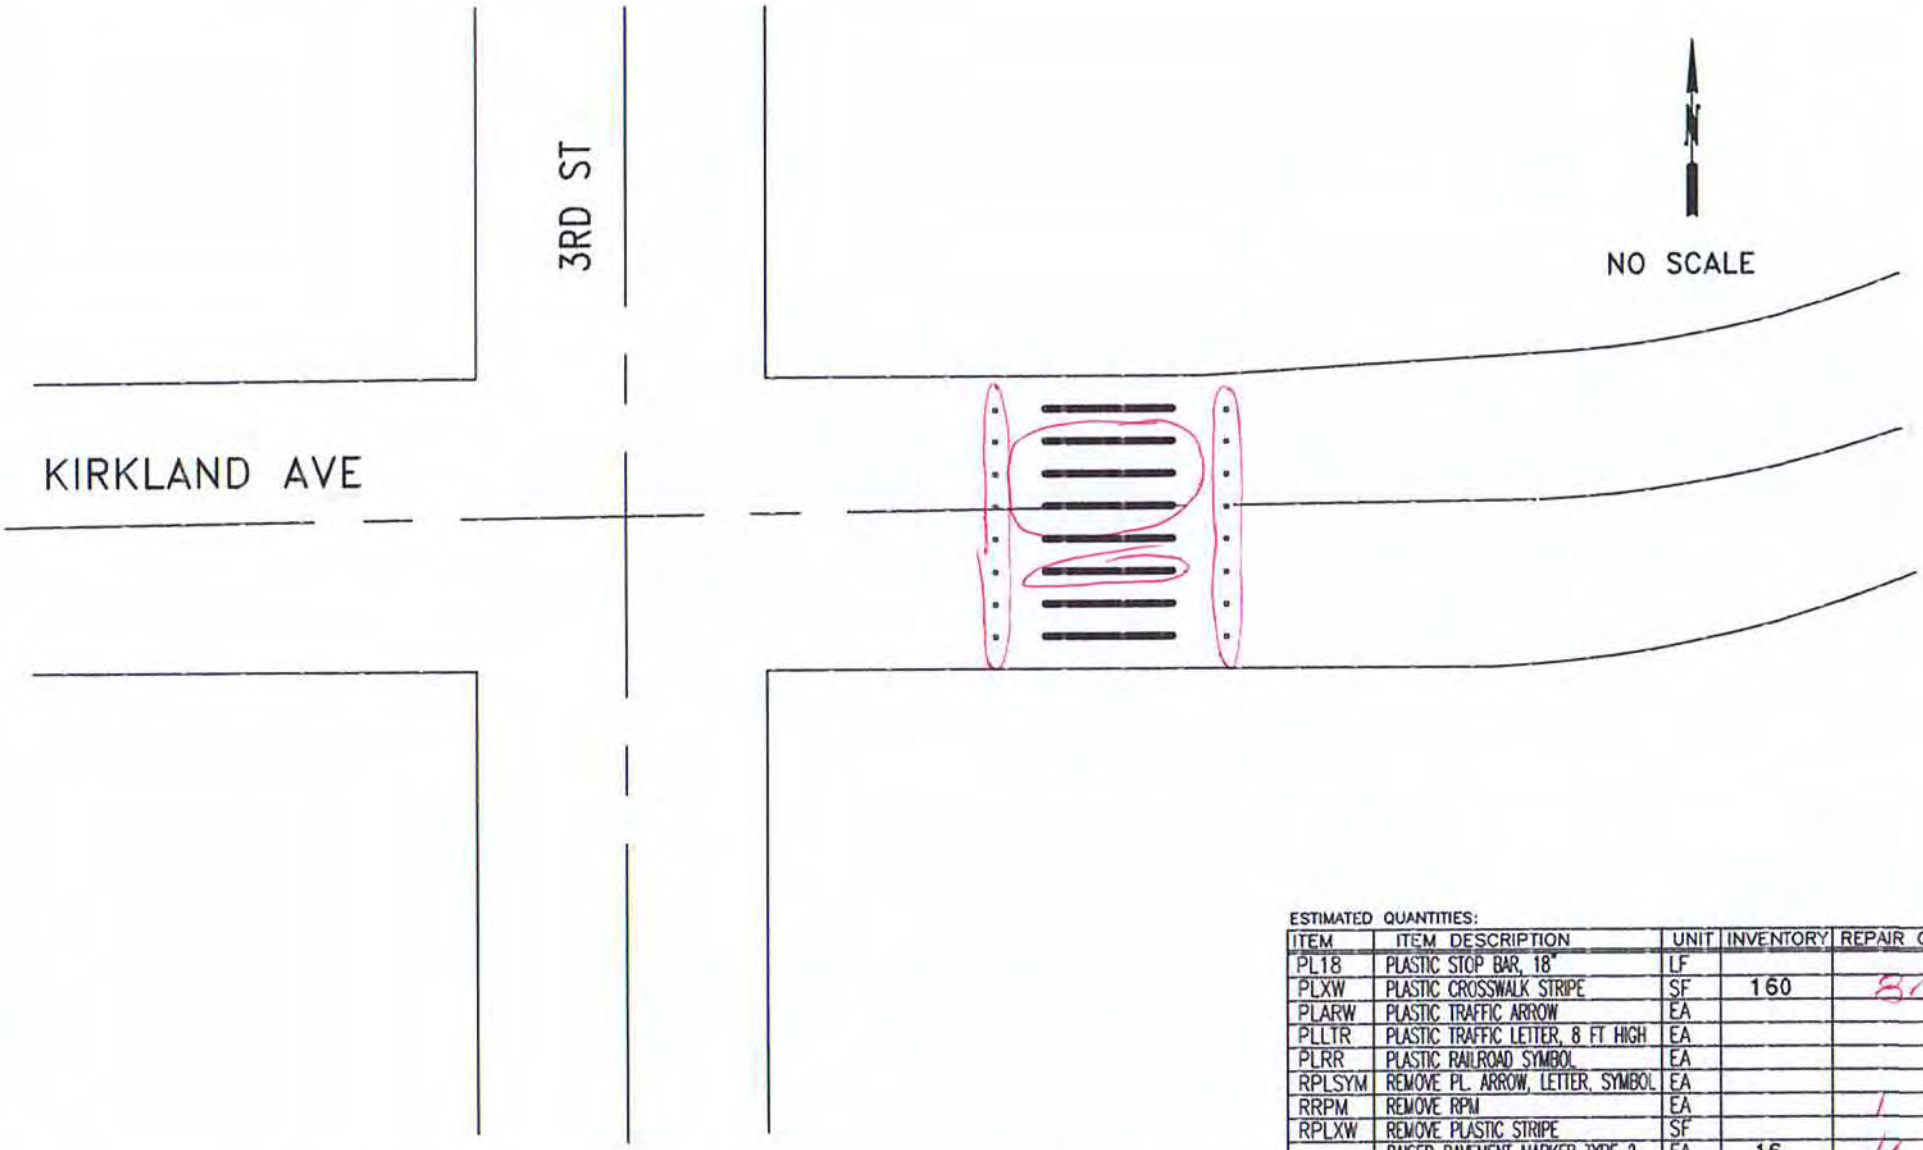

ESTIMATED QUANTITIES:

ITEM	ITEM DESCRIPTION	UNIT	INVENTORY	REPAIR QTY
PL18	PLASTIC STOP BAR, 18"	LF		
PLXW	PLASTIC CROSSWALK STRIPE	SF	160	80
PLARW	PLASTIC TRAFFIC ARROW	EA		
PLLTR	PLASTIC TRAFFIC LETTER, 8 FT HIGH	EA		
PLRR	PLASTIC RAILROAD SYMBOL	EA		
RPLSYM	REMOVE PL. ARROW, LETTER, SYMBOL	EA		
RRPM	REMOVE RPM	EA		1
RPLXW	REMOVE PLASTIC STRIPE	SF		
	RAISED PAVEMENT MARKER TYPE 2	EA	16	16

CITY OF KIRKLAND
DEPARTMENT OF PUBLIC WORKS
123 FIFTH AVENUE KIRKLAND, WA 98033
(425) 587-3800 www.kirklandwa.gov

D.GRILLEY 1/2000
DESIGNED BY: DATE

J.JENNINGS 10/2011
DRAWN BY: DATE

CHECKED BY: DATE

2020 PAVEMENT MARKING PROGRAM

STREET: KIRKLAND AVE

CROSS STREET: MID BLOCK

SEGMENT:

SCALE: N.T.S.

FILENAME: Page 10-16

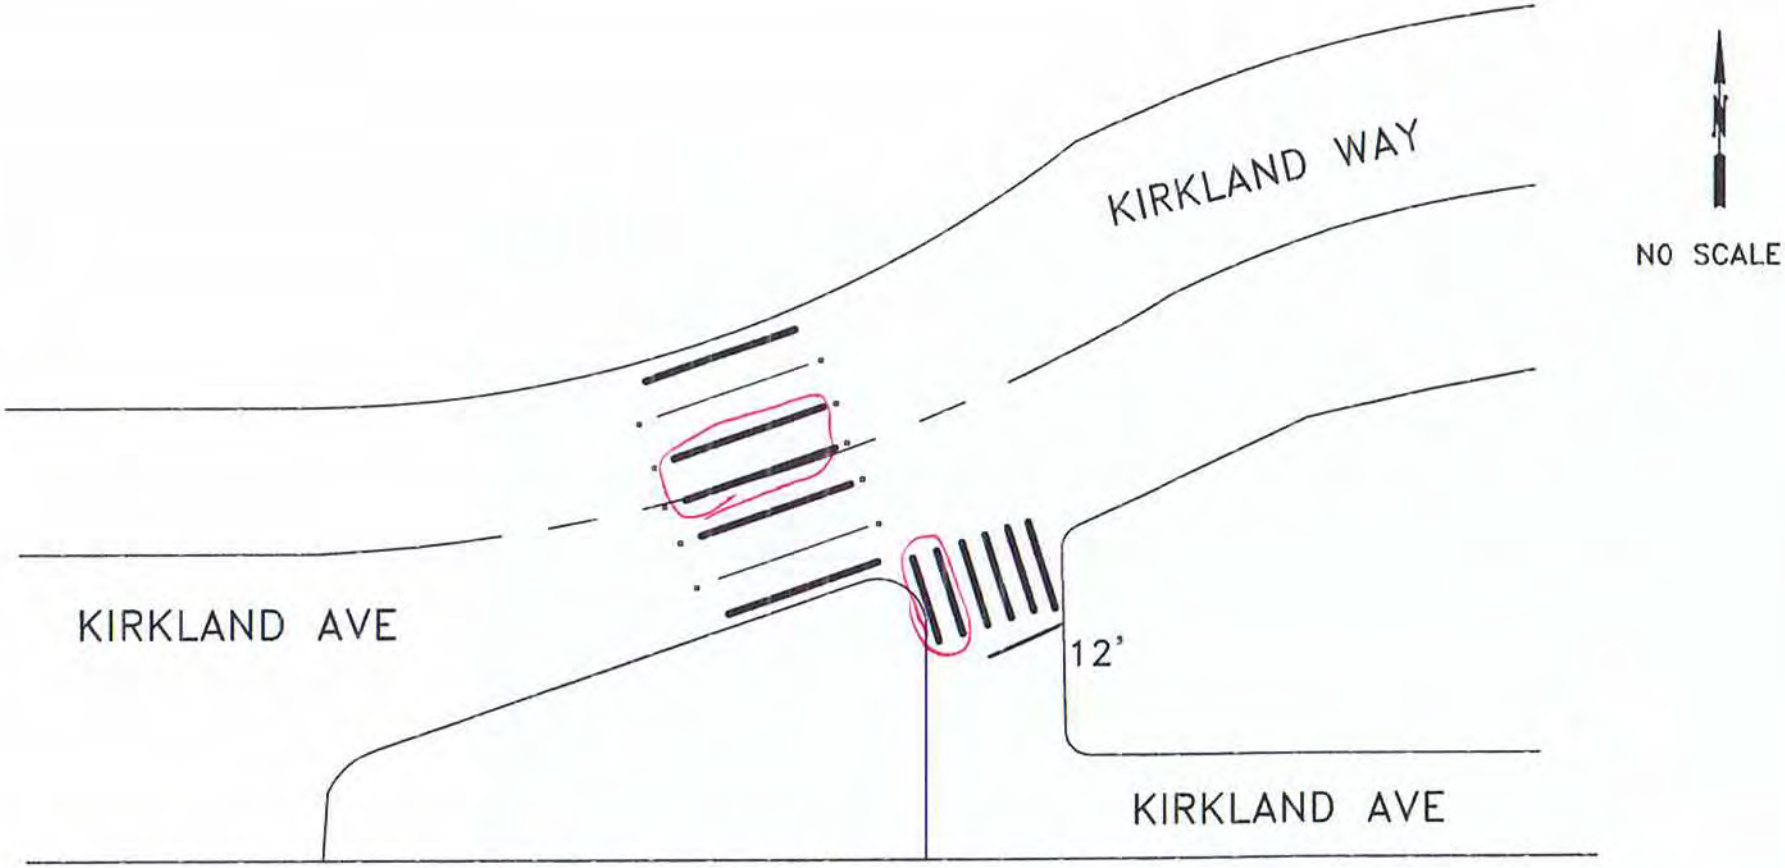

ESTIMATED QUANTITIES:

ITEM	ITEM DESCRIPTION	UNIT	INVENTORY	REPAIR QTY
PL18	PLASTIC STOP BAR, 18"	LF	12	
PLXW	PLASTIC CROSSWALK STRIPE	SF	240	80
PLARW	PLASTIC TRAFFIC ARROW	EA		
PLLTR	PLASTIC TRAFFIC LETTER, 8 FT HIGH	EA		
PLRR	PLASTIC RAILROAD SYMBOL	EA		
RPLSYM	REMOVE PL. ARROW, LETTER, SYMBOL	EA		
RRPM	REMOVE RPM	EA		
RPLXW	REMOVE PLASTIC STRIPE	SF		
	RAISED PAVEMENT MARKER TYPE 2	EA	10	

CITY OF KIRKLAND
DEPARTMENT OF PUBLIC WORKS
123 FIFTH AVENUE KIRKLAND, WA 98033
(425) 587-3800 www.kirklandwa.gov

S. GONSAR 2/2019
DESIGNED BY: DATE

J.JENNINGS 2/2019
DRAWN BY: DATE

CHECKED BY: DATE

2020 PAVEMENT MARKING PROGRAM

STREET: KIRKLAND AVENUE

CROSS STREET: KIRKLAND WAY

SEGMENT:

SCALE: N.T.S.

FILENAME: Page 10-17

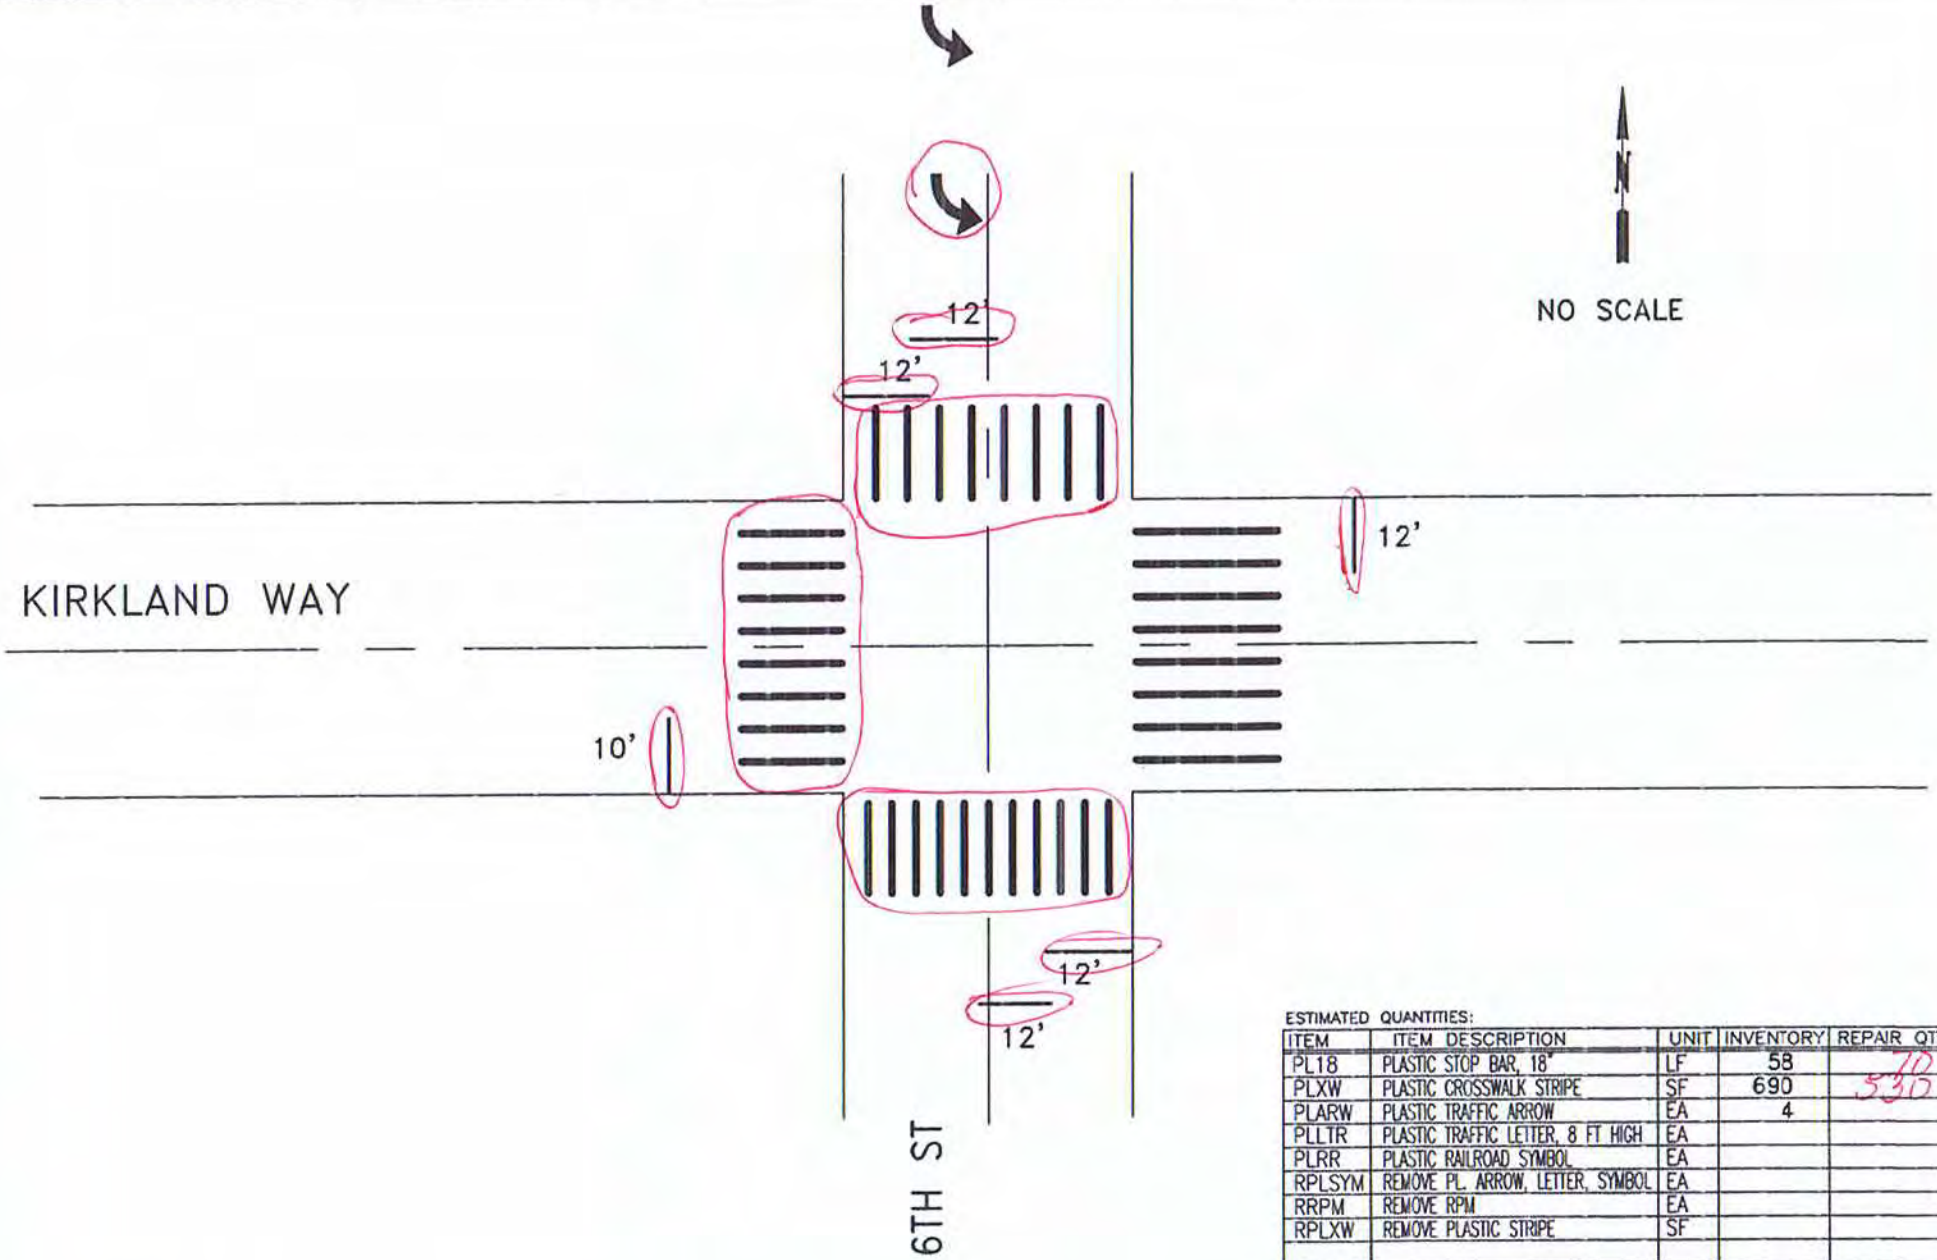

ESTIMATED QUANTITIES:

ITEM	ITEM DESCRIPTION	UNIT	INVENTORY	REPAIR QTY
PL18	PLASTIC STOP BAR, 18"	LF	58	
PLXW	PLASTIC CROSSWALK STRIPE	SF	690	538
PLARW	PLASTIC TRAFFIC ARROW	EA	4	
PLLTR	PLASTIC TRAFFIC LETTER, 8 FT HIGH	EA		
PLRR	PLASTIC RAILROAD SYMBOL	EA		
RPLSYM	REMOVE PL. ARROW, LETTER, SYMBOL	EA		
RRPM	REMOVE RPM	EA		
RPLXW	REMOVE PLASTIC STRIPE	SF		

CITY OF KIRKLAND
DEPARTMENT OF PUBLIC WORKS
123 FIFTH AVENUE KIRKLAND, WA 98033
(425) 587-3800 www.kirklandwa.gov

S. GONSAR 2/2019
DESIGNED BY: DATE

J.JENNINGS 2/2019
DRAWN BY: DATE

CHECKED BY: DATE

2020 PAVEMENT MARKING PROGRAM

STREET: KIRKLAND WAY

CROSS STREET: 6TH ST

SEGMENT:

SCALE: N.T.S.

FILENAME: Page 10-19

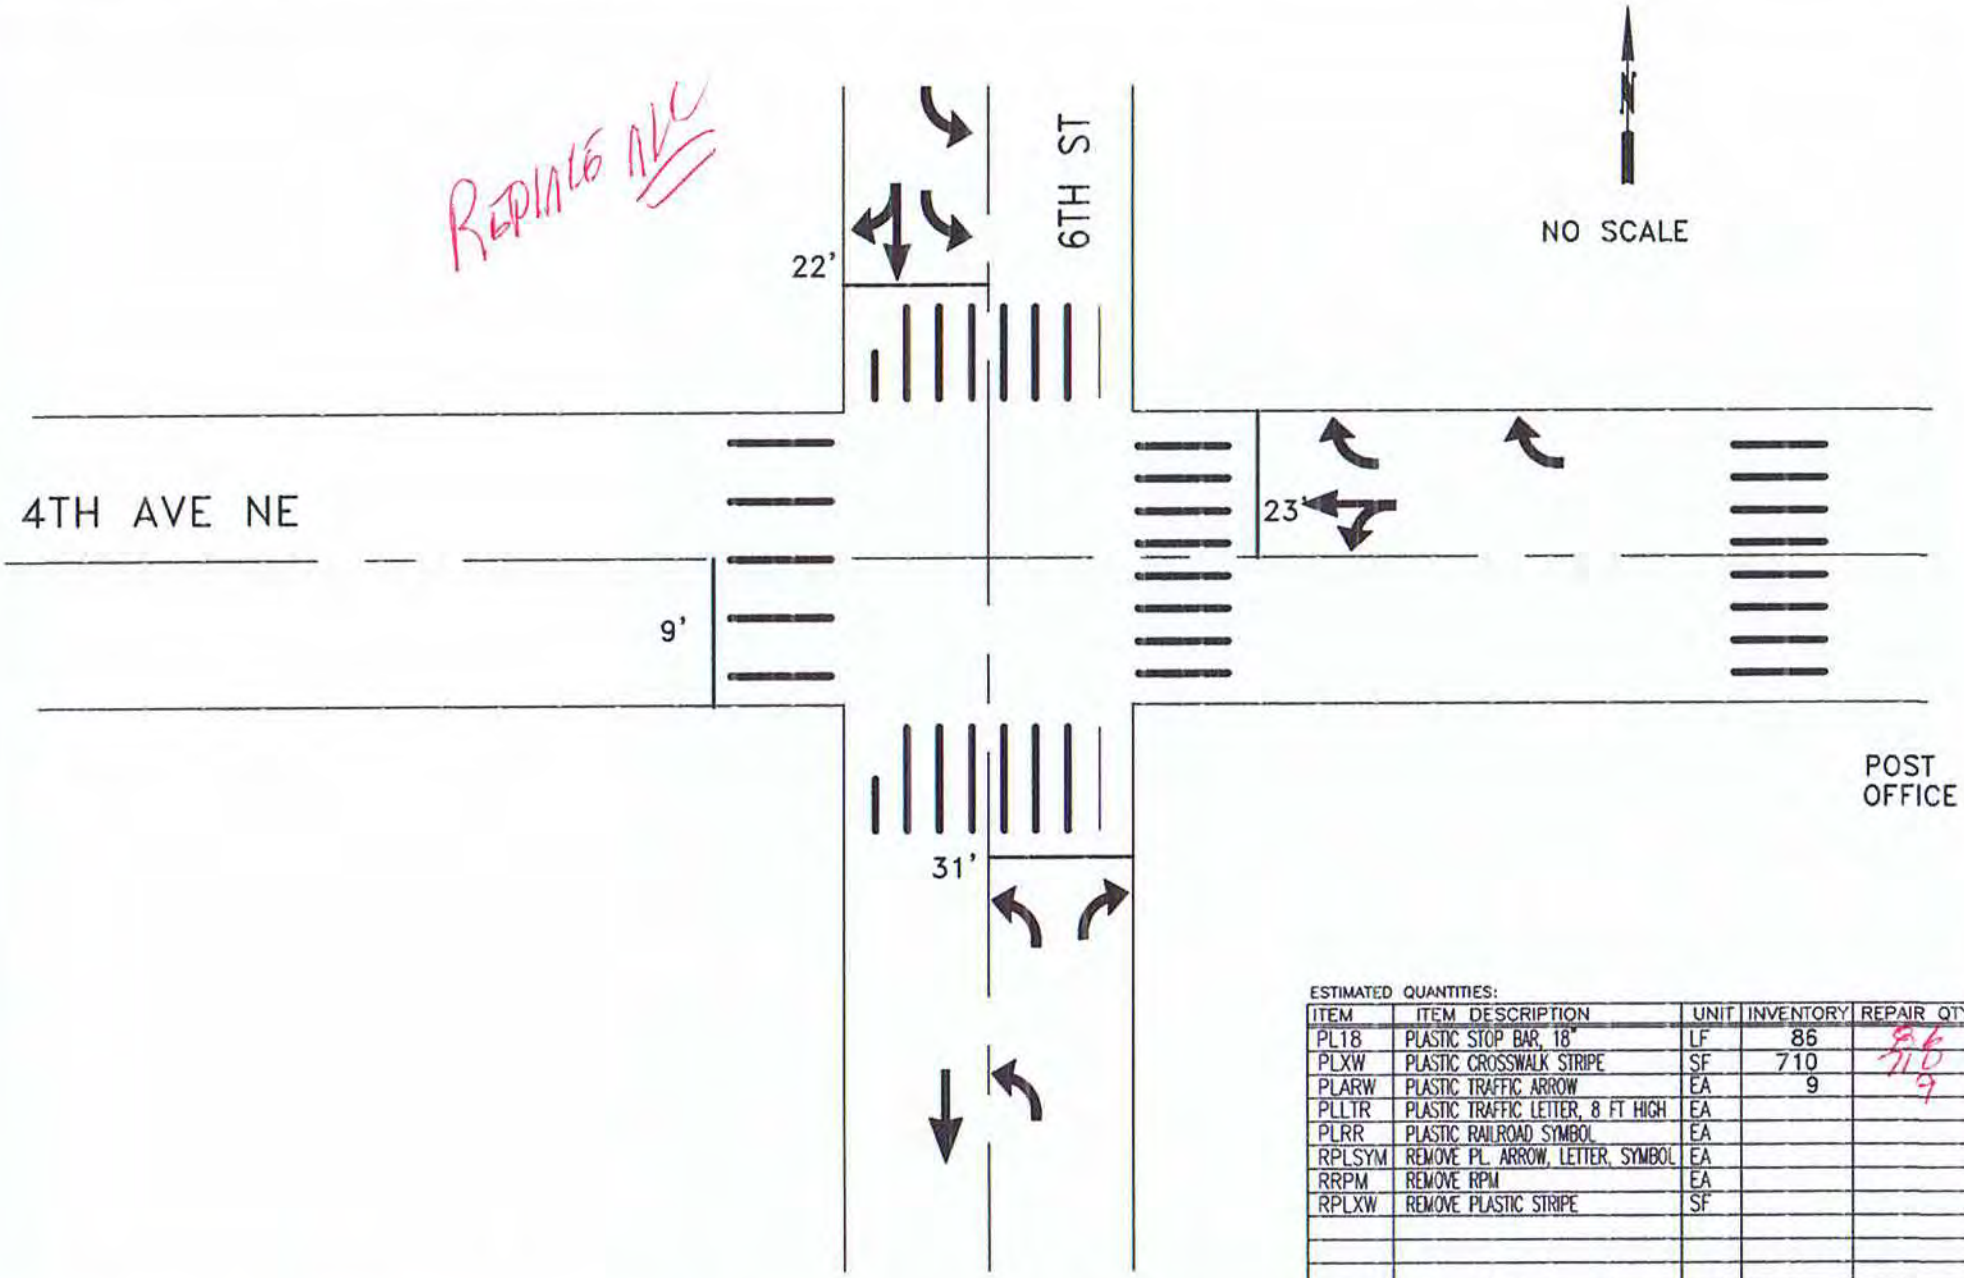

ESTIMATED QUANTITIES:

ITEM	ITEM DESCRIPTION	UNIT	INVENTORY	REPAIR QTY
PL18	PLASTIC STOP BAR, 18"	LF	86	86
PLXW	PLASTIC CROSSWALK STRIPE	SF	710	710
PLARW	PLASTIC TRAFFIC ARROW	EA	9	9
PLLTR	PLASTIC TRAFFIC LETTER, 8 FT HIGH	EA		
PLRR	PLASTIC RAILROAD SYMBOL	EA		
RPLSYM	REMOVE PL. ARROW, LETTER, SYMBOL	EA		
RRPM	REMOVE RPM	EA		
RPLXW	REMOVE PLASTIC STRIPE	SF		

CITY OF KIRKLAND
DEPARTMENT OF PUBLIC WORKS
123 FIFTH AVENUE KIRKLAND, WA 98033
(425) 587-3800 www.kirklandwa.gov

G. HORTILLOSA 10/2011
DESIGNED BY: DATE

J.JENNINGS 10/2011
DRAWN BY: DATE

CHECKED BY: DATE

2022 PAVEMENT MARKING PROGRAM

STREET: 4TH AVE NE

CROSS STREET: 6TH ST

SEGMENT:

SCALE: N.T.S.

FILENAME: Page 10-21

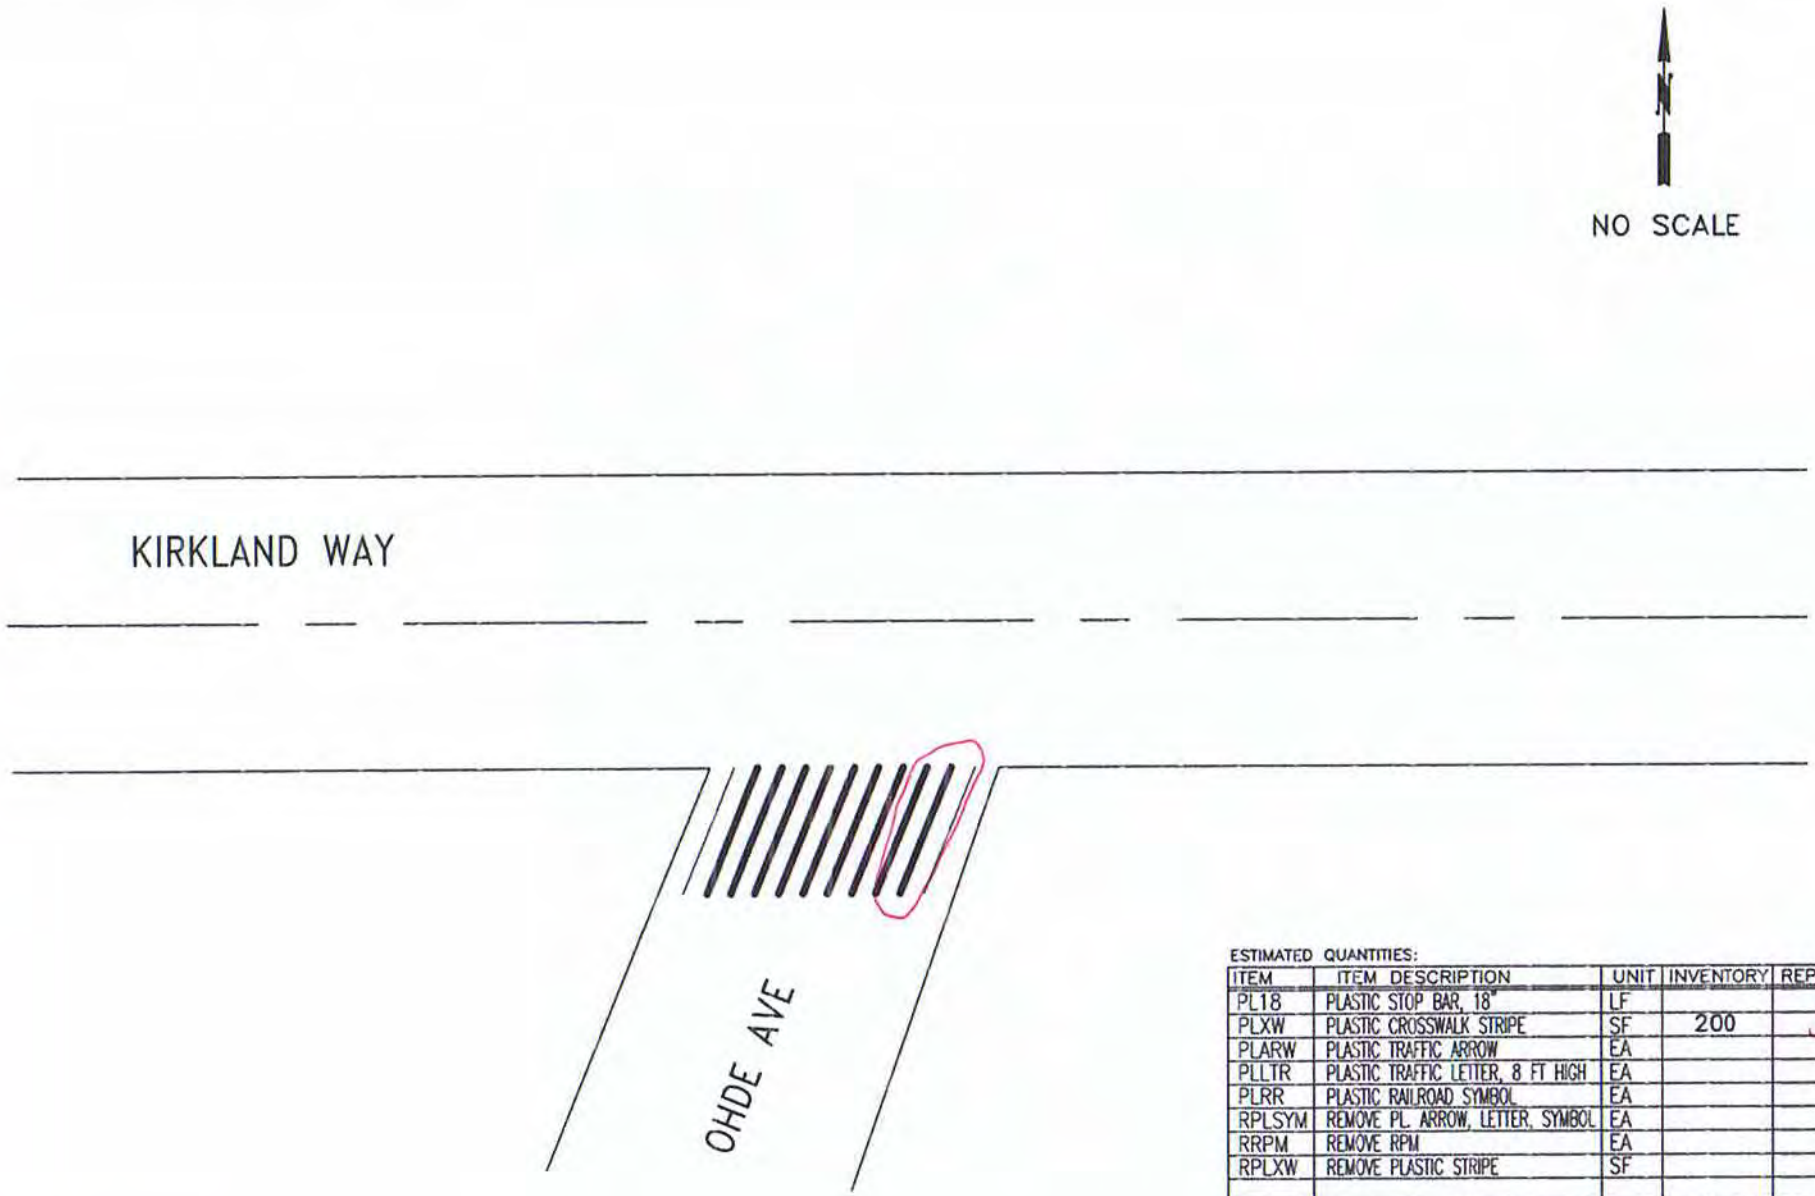

ESTIMATED QUANTITIES:

ITEM	ITEM DESCRIPTION	UNIT	INVENTORY	REPAIR QTY
PL18	PLASTIC STOP BAR, 18"	LF		
PLXW	PLASTIC CROSSWALK STRIPE	SF	200	50
PLARW	PLASTIC TRAFFIC ARROW	EA		
PLLTR	PLASTIC TRAFFIC LETTER, 8 FT HIGH	EA		
PLRR	PLASTIC RAILROAD SYMBOL	EA		
RPLSYM	REMOVE PL. ARROW, LETTER, SYMBOL	EA		
RRPM	REMOVE RPM	EA		
RPLXW	REMOVE PLASTIC STRIPE	SF		

CITY OF KIRKLAND
DEPARTMENT OF PUBLIC WORKS
123 FIFTH AVENUE KIRKLAND, WA 98033
(425) 587-3800 www.kirklandwa.gov

T PLATT 12/2001
DESIGNED BY: DATE

J.JENNINGS 12/2001
DRAWN BY: DATE

CHECKED BY: DATE

2020 PAVEMENT MARKING PROGRAM

STREET: KIRKLAND WAY

CROSS STREET: OHDE AVE

SEGMENT:

SCALE: N.T.S.

FILENAME: Page 10-26

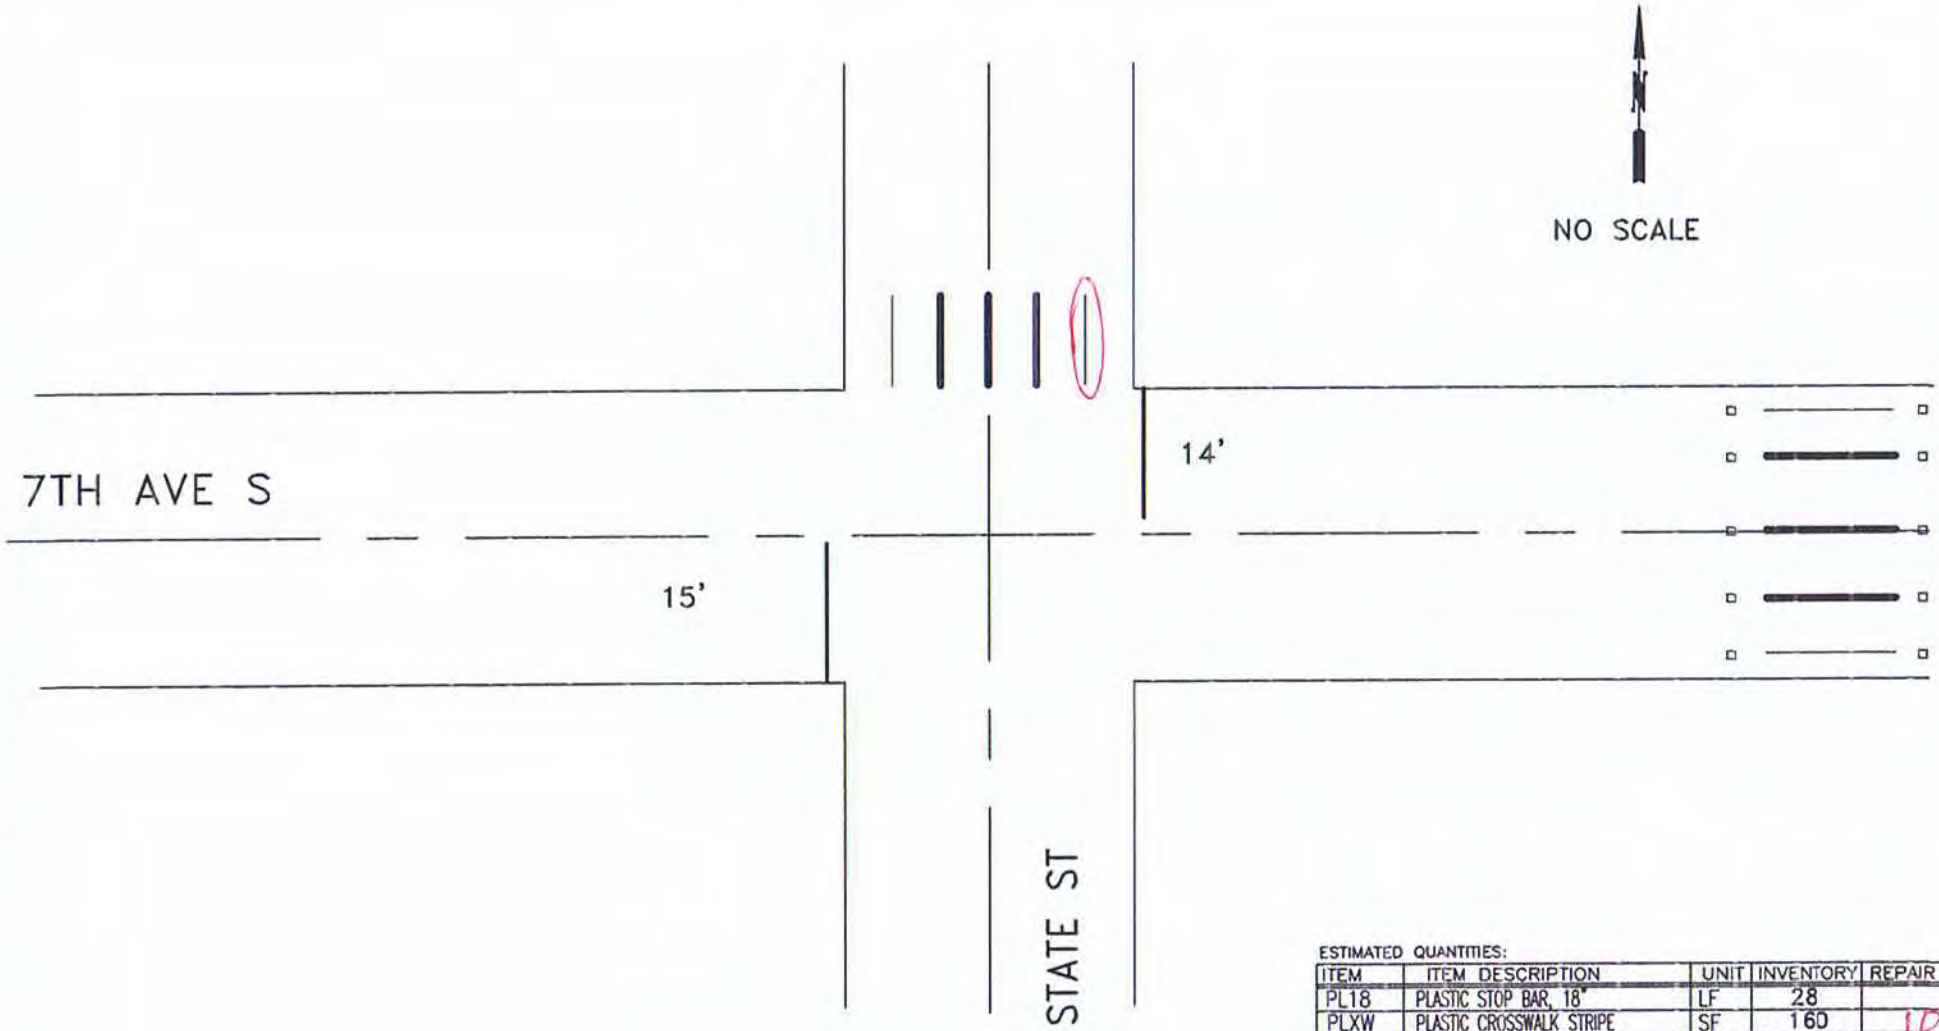

ESTIMATED QUANTITIES:

ITEM	ITEM DESCRIPTION	UNIT	INVENTORY	REPAIR QTY
PL18	PLASTIC STOP BAR, 18"	LF	28	
PLXW	PLASTIC CROSSWALK STRIPE	SF	160	10
PLARW	PLASTIC TRAFFIC ARROW	EA		
PLLTR	PLASTIC TRAFFIC LETTER, 8 FT HIGH	EA		
PLRR	PLASTIC RAILROAD SYMBOL	EA		
RPLSYM	REMOVE PL. ARROW, LETTER, SYMBOL	EA		
RRPM	REMOVE RPM	EA		
RPLXW	REMOVE PLASTIC STRIPE	SF		
	RAISED PAVEMENT MARKER TYPE 2	EA	10	

CITY OF KIRKLAND WASHINGTON

CITY OF KIRKLAND
DEPARTMENT OF PUBLIC WORKS
123 FIFTH AVENUE KIRKLAND, WA 98033
(425) 587-3800 www.kirklandwa.gov

G. HORTILLOSA 10/2006
DESIGNED BY: DATE

J.JENNINGS 10/2006
DRAWN BY: DATE

CHECKED BY: DATE

2020 PAVEMENT MARKING PROGRAM

STREET: STATE STREET

CROSS STREET: 7TH ST S

SEGMENT:

SCALE: N.T.S.

FILENAME:

NO SCALE

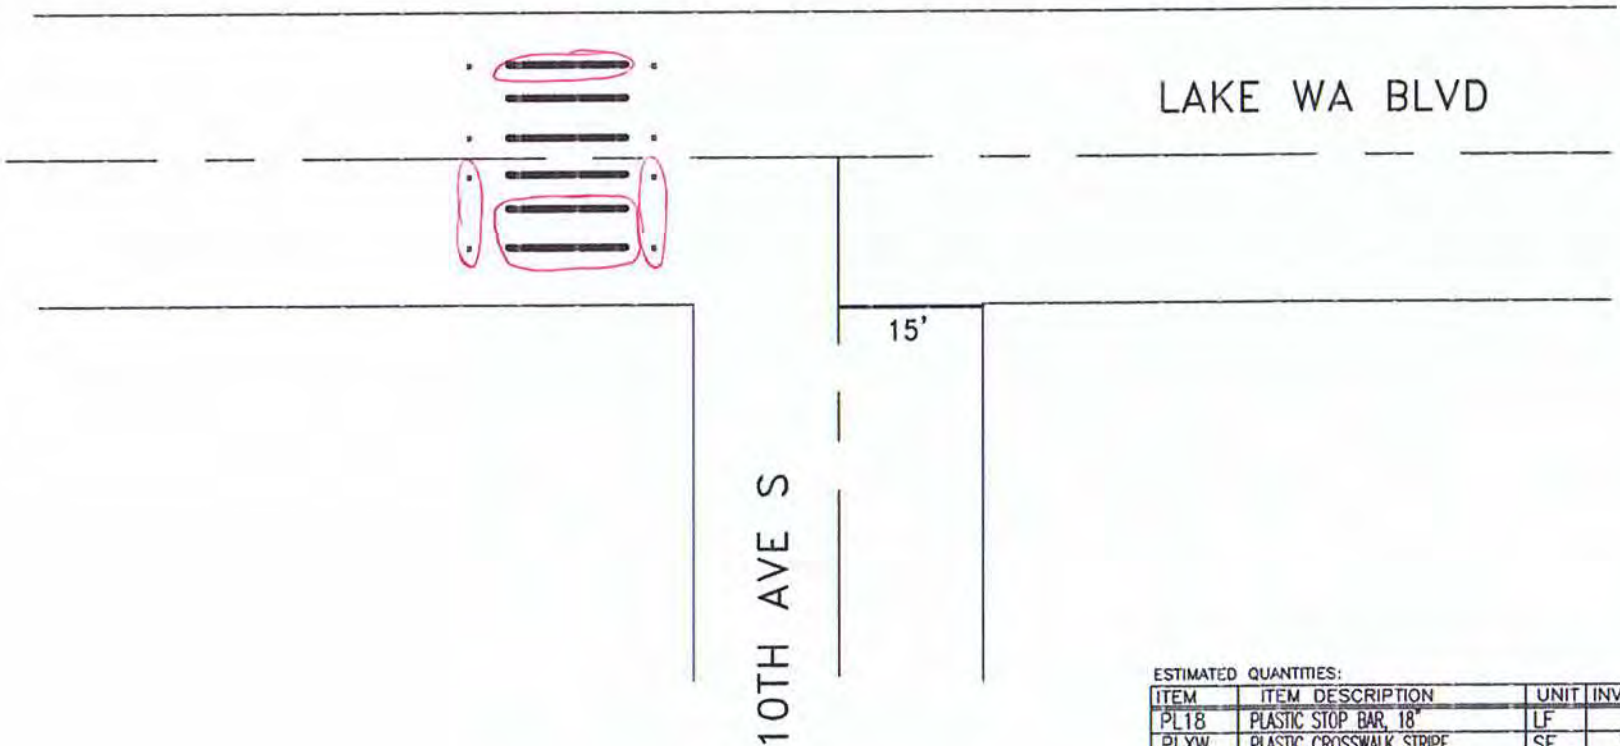

ESTIMATED QUANTITIES:

ITEM	ITEM DESCRIPTION	UNIT	INVENTORY	REPAIR QTY
PL18	PLASTIC STOP BAR, 18"	LF	15	
PLXW	PLASTIC CROSSWALK STRIPE	SF	116	60
PLARW	PLASTIC TRAFFIC ARROW	EA		
PLLTR	PLASTIC TRAFFIC LETTER, 8 FT HIGH	EA		
PLRR	PLASTIC RAILROAD SYMBOL	EA		
RPLSYM	REMOVE PL. ARROW, LETTER, SYMBOL	EA		
RRPM	REMOVE RPM	EA		
RPLXW	REMOVE PLASTIC STRIPE	SF		
	RAISED PAVEMENT MARKER TYPE 2	EA	8	6

CITY OF KIRKLAND WASHINGTON

CITY OF KIRKLAND
DEPARTMENT OF PUBLIC WORKS
123 FIFTH AVENUE KIRKLAND, WA 98033
(425) 587-3800 www.kirklandwa.gov

G. HORTILLOSA 10/2006
DESIGNED BY: DATE

J.JENNINGS 10/2006
DRAWN BY: DATE

CHECKED BY: DATE

2022 PAVEMENT MARKING PROGRAM

STREET: LAKE WA BLVD

CROSS STREET: 10TH AVE S

SEGMENT:

SCALE: N.T.S.

FILENAME: Page 10-29

NO SCALE

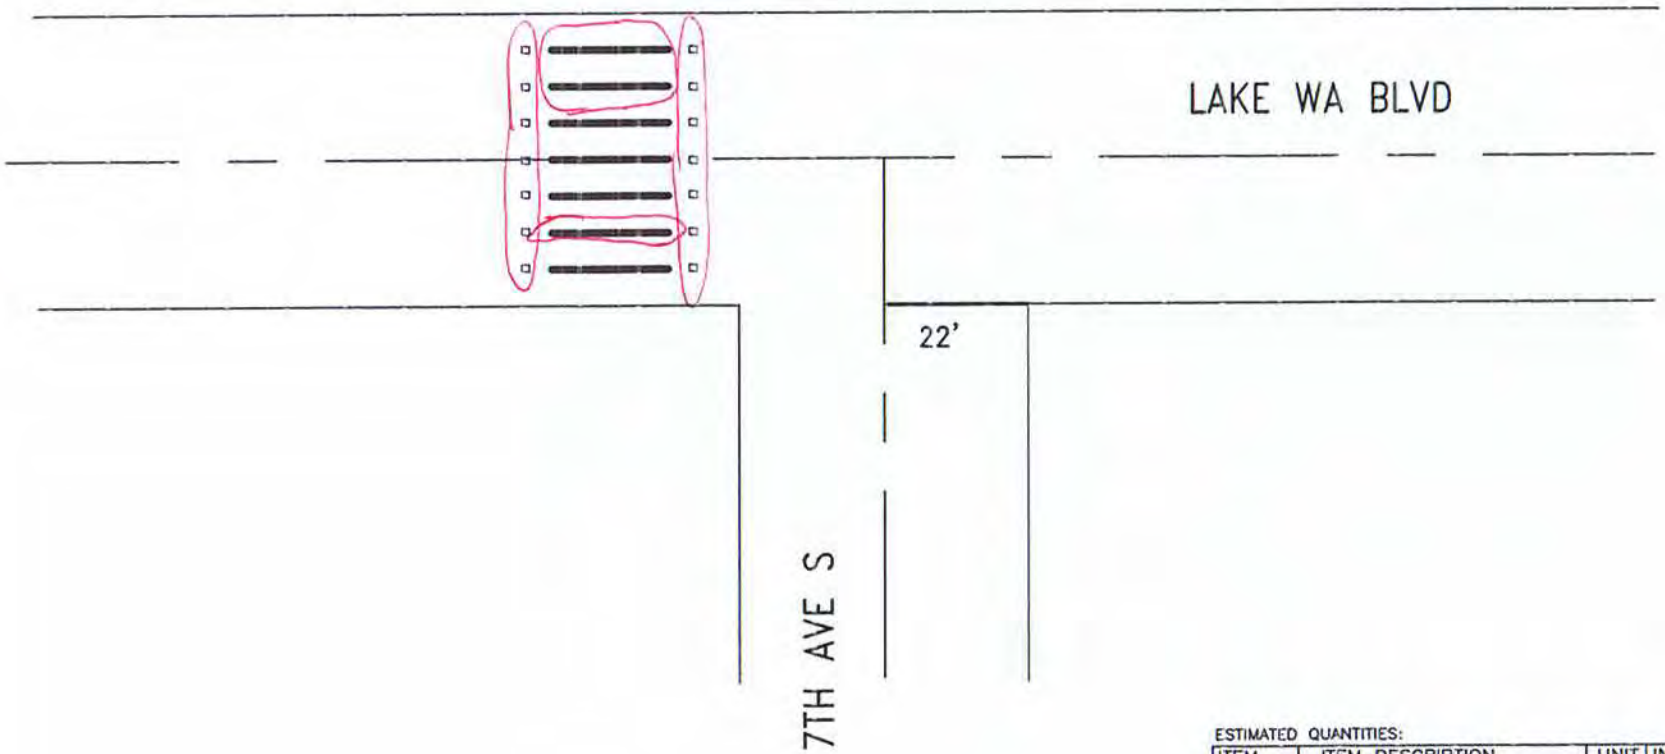

ESTIMATED QUANTITIES:

ITEM	ITEM DESCRIPTION	UNIT	INVENTORY	REPAIR QTY
PL18	PLASTIC STOP BAR, 18"	LF	22	
PLXW	PLASTIC CROSSWALK STRIPE	SF	140	60
PLARW	PLASTIC TRAFFIC ARROW	EA		
PLLTR	PLASTIC TRAFFIC LETTER, 8 FT HIGH	EA		
PLRR	PLASTIC RAILROAD SYMBOL	EA		
RPLSYM	REMOVE PL. ARROW, LETTER, SYMBOL	EA		
RRPM	REMOVE RPM	EA		
RPLXW	REMOVE PLASTIC STRIPE	SF		
	RAISED PAVEMENT MARKER TYPE 2	EA	14	14

CITY OF KIRKLAND WASHINGTON

CITY OF KIRKLAND
DEPARTMENT OF PUBLIC WORKS
123 FIFTH AVENUE KIRKLAND, WA 98033
(425) 587-3800 www.kirklandwa.gov

G. HORTILLOSA 10/2006
DESIGNED BY: DATE

J.JENNINGS 10/2006
DRAWN BY: DATE

CHECKED BY: DATE

2020 PAVEMENT MARKING PROGRAM

STREET: LAKE WA BLVD

CROSS STREET: 7TH AVE S

SEGMENT:

SCALE: N.T.S.

FILENAME:

NO SCALE

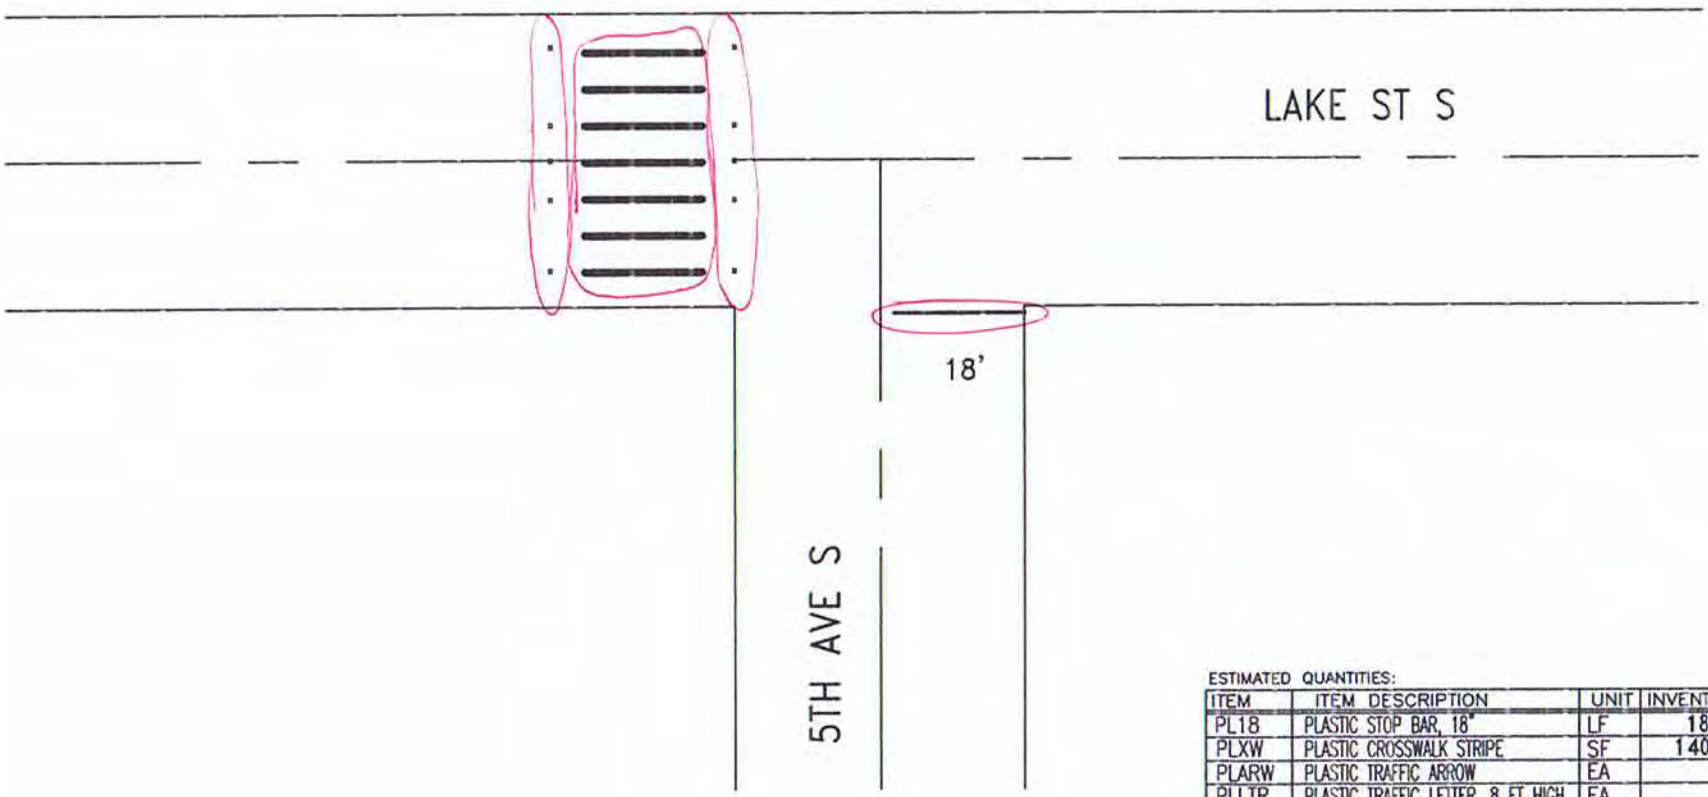

ESTIMATED QUANTITIES:

ITEM	ITEM DESCRIPTION	UNIT	INVENTORY	REPAIR QTY
PL18	PLASTIC STOP BAR, 18"	LF	18	18
PLXW	PLASTIC CROSSWALK STRIPE	SF	140	148
PLARW	PLASTIC TRAFFIC ARROW	EA		
PLLTR	PLASTIC TRAFFIC LETTER, 8 FT HIGH	EA		
PLRR	PLASTIC RAILROAD SYMBOL	EA		
RPLSYM	REMOVE PL. ARROW, LETTER, SYMBOL	EA		
RRPM	REMOVE RPM	EA		2
RPLXW	REMOVE PLASTIC STRIPE	SF		
	RAISED PAVEMENT MARKER TYPE 2	EA	14	14

CITY OF KIRKLAND WASHINGTON

CITY OF KIRKLAND
DEPARTMENT OF PUBLIC WORKS
123 FIFTH AVENUE KIRKLAND, WA 98033
(425) 587-3800 www.kirklandwa.gov

G. HORTILLOSA 10/2006
DESIGNED BY: DATE

J.JENNINGS 10/2006
DRAWN BY: DATE

CHECKED BY: DATE

2022 PAVEMENT MARKING PROGRAM

STREET: 5TH AVE S

CROSS STREET: LAKE ST S

SEGMENT:

SCALE: N.T.S.

FILENAME:

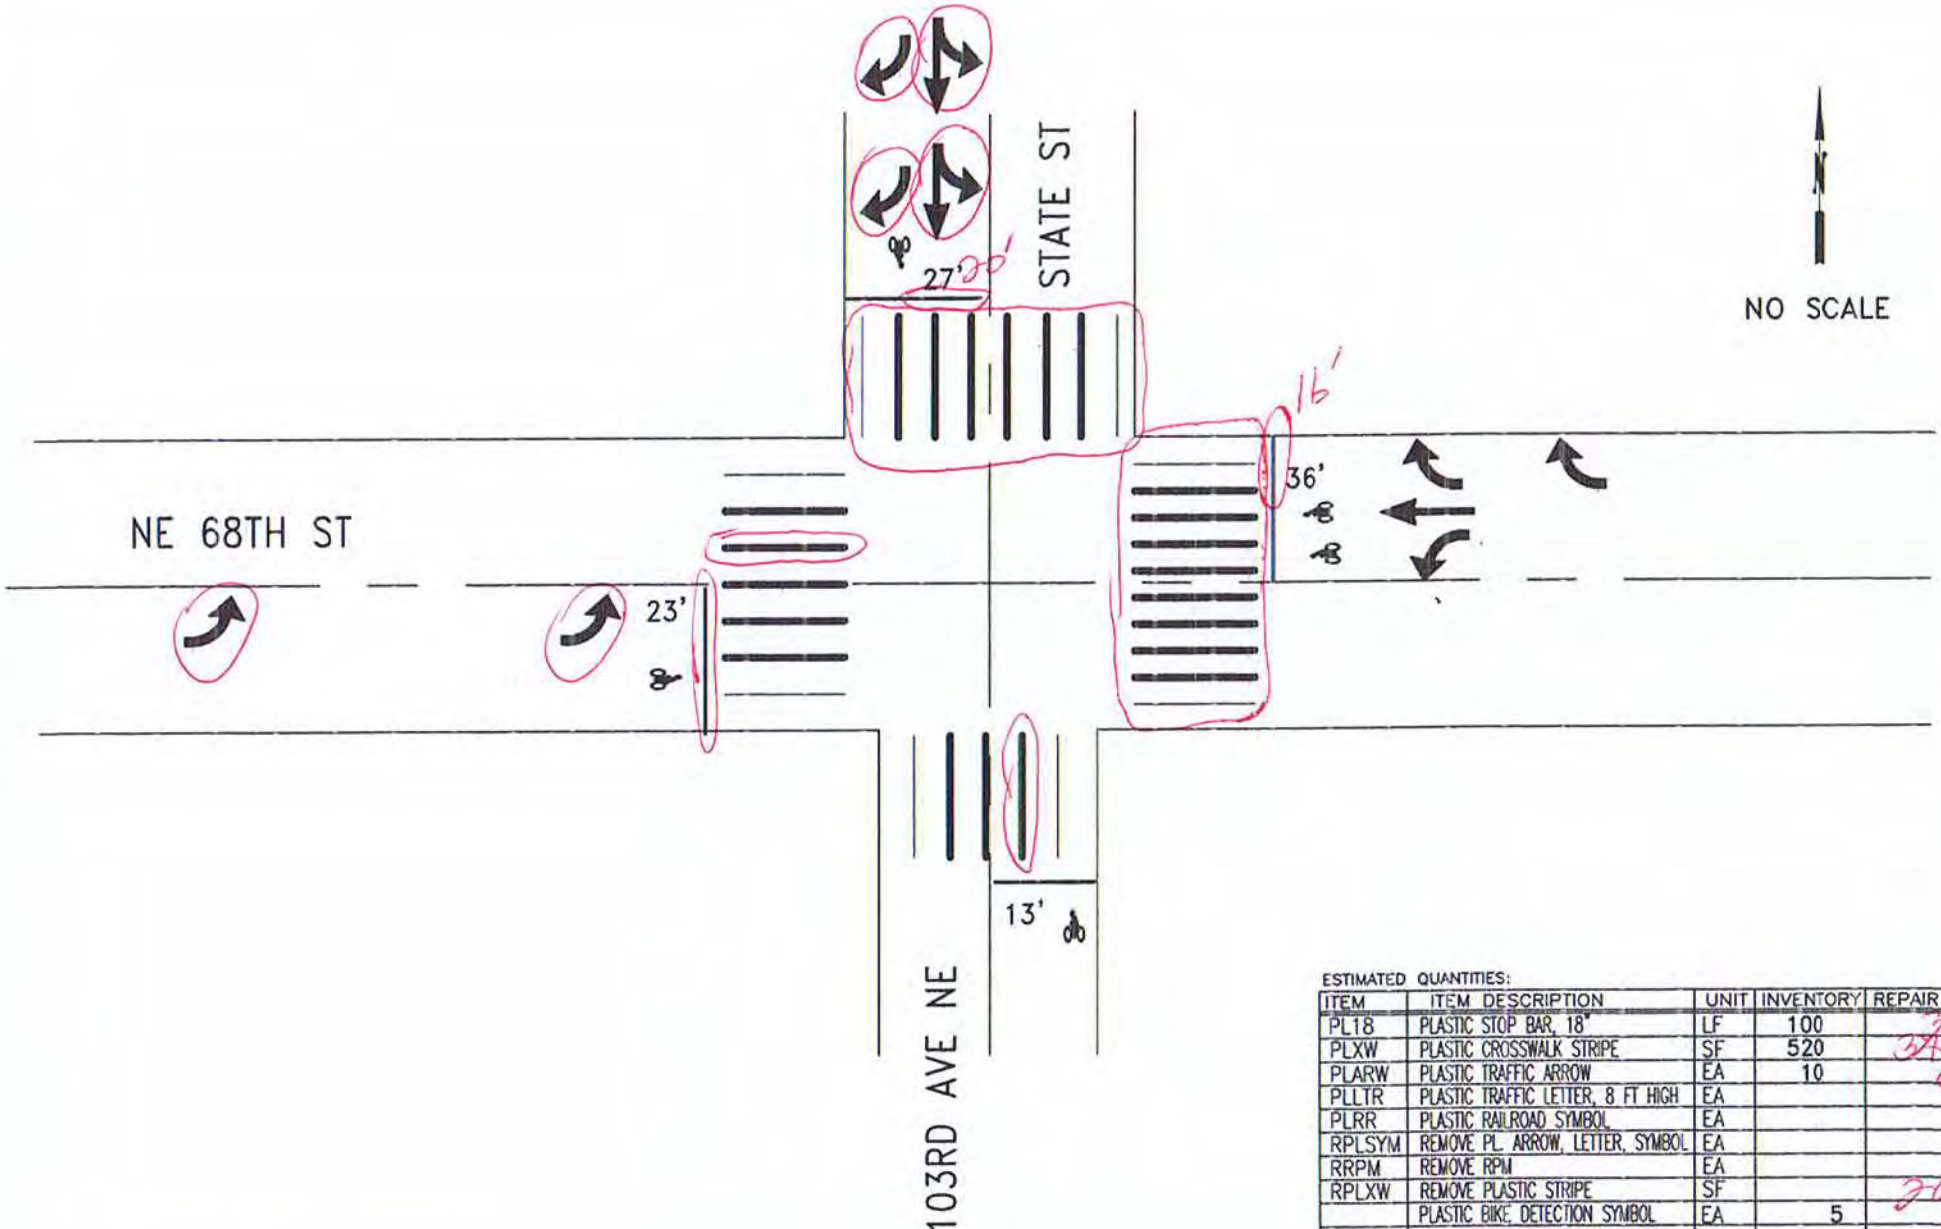

ESTIMATED QUANTITIES:

ITEM	ITEM DESCRIPTION	UNIT	INVENTORY	REPAIR QTY
PL18	PLASTIC STOP BAR, 18"	LF	100	36
PLXW	PLASTIC CROSSWALK STRIPE	SF	520	376
PLARW	PLASTIC TRAFFIC ARROW	EA	10	6
PLLTR	PLASTIC TRAFFIC LETTER, 8 FT HIGH	EA		
PLRR	PLASTIC RAILROAD SYMBOL	EA		
RPLSYM	REMOVE PL. ARROW, LETTER, SYMBOL	EA		
RRPM	REMOVE RPM	EA		
RPLXW	REMOVE PLASTIC STRIPE	SF		20
	PLASTIC BIKE DETECTION SYMBOL	EA	5	

CITY OF KIRKLAND WASHINGTON

CITY OF KIRKLAND
DEPARTMENT OF PUBLIC WORKS
123 FIFTH AVENUE KIRKLAND, WA 98033
(425) 587-3800 www.kirklandwa.gov

G. HORTILLOSA 10/2011
DESIGNED BY: DATE

J.JENNINGS 10/2011
DRAWN BY: DATE

CHECKED BY: DATE

2021 PAVEMENT MARKING PROGRAM

STREET: NE 68TH ST

CROSS STREET: STATE ST

SEGMENT:

SCALE: N.T.S.

FILENAME: Page 10-32

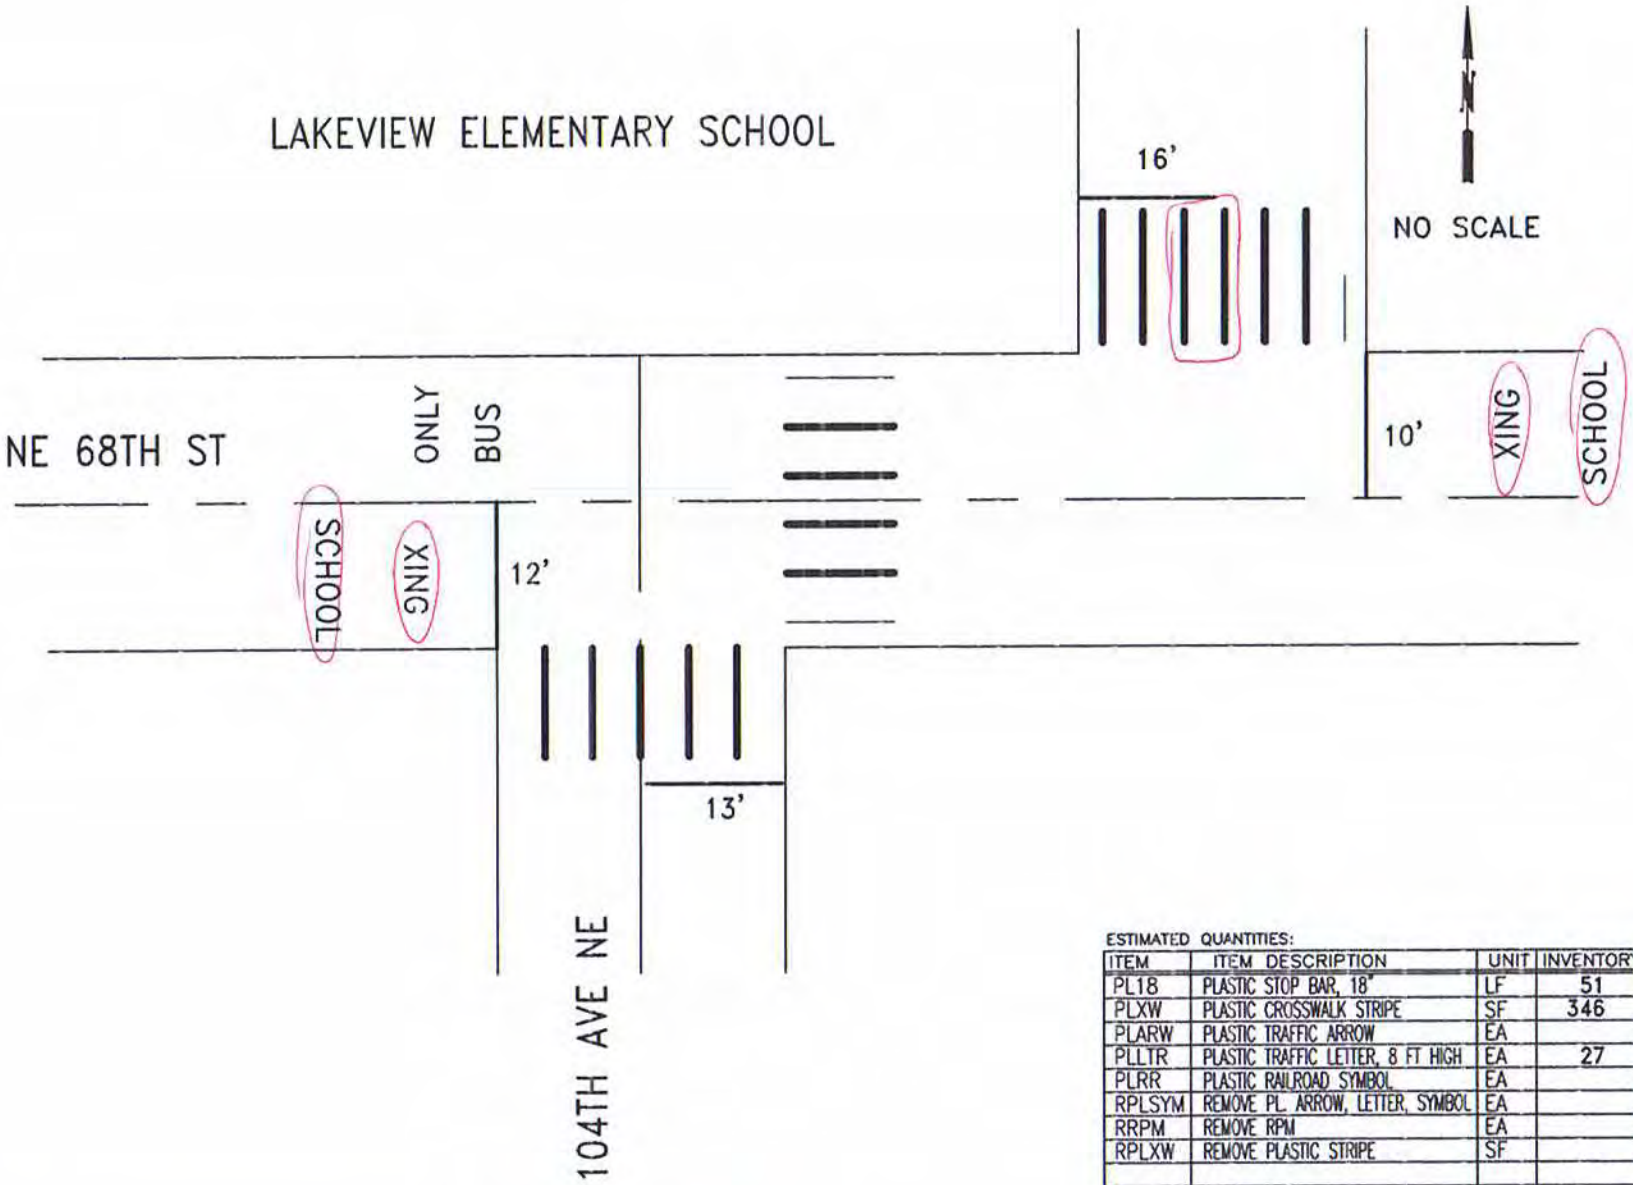

ESTIMATED QUANTITIES:

ITEM	ITEM DESCRIPTION	UNIT	INVENTORY	REPAIR QTY
PL18	PLASTIC STOP BAR, 18"	LF	51	
PLXW	PLASTIC CROSSWALK STRIPE	SF	346	40
PLARW	PLASTIC TRAFFIC ARROW	EA		
PLLTR	PLASTIC TRAFFIC LETTER, 8 FT HIGH	EA	27	18
PLRR	PLASTIC RAILROAD SYMBOL	EA		
RPLSYM	REMOVE PL. ARROW, LETTER, SYMBOL	EA		
RRPM	REMOVE RPM	EA		
RPLXW	REMOVE PLASTIC STRIPE	SF		

CITY OF KIRKLAND
DEPARTMENT OF PUBLIC WORKS
123 FIFTH AVENUE KIRKLAND, WA 98033
(425) 587-3800 www.kirklandwa.gov

G. HORTILLOSA 10/2011
DESIGNED BY: DATE

J.JENNINGS 10/2011
DRAWN BY: DATE

CHECKED BY: DATE

20~~22~~ PAVEMENT MARKING PROGRAM

STREET: NE 68TH ST

CROSS STREET: 104TH AVE NE

SEGMENT:

SCALE: N.T.S.

FILENAME:

APPENDIX G

ALTERNATE G– PLAN SHEETS

LAKEVIEW
INTERSECTION PLANS

CITY OF KIRKLAND
DEPARTMENT OF PUBLIC WORKS
123 FIFTH AVENUE KIRKLAND, WA 98033
(425) 587-3800 www.kirklandwa.gov

S GONSAR	1/2019	DESIGNED BY: DATE
J.JENNINGS	1/2019	DRAWN BY: DATE
		CHECKED BY: DATE

2020 PAVEMENT MARKING PROGRAM

STREET:

CROSS STREET:

SEGMENT:

SCALE: N.T.S.

FILENAME: 13-0

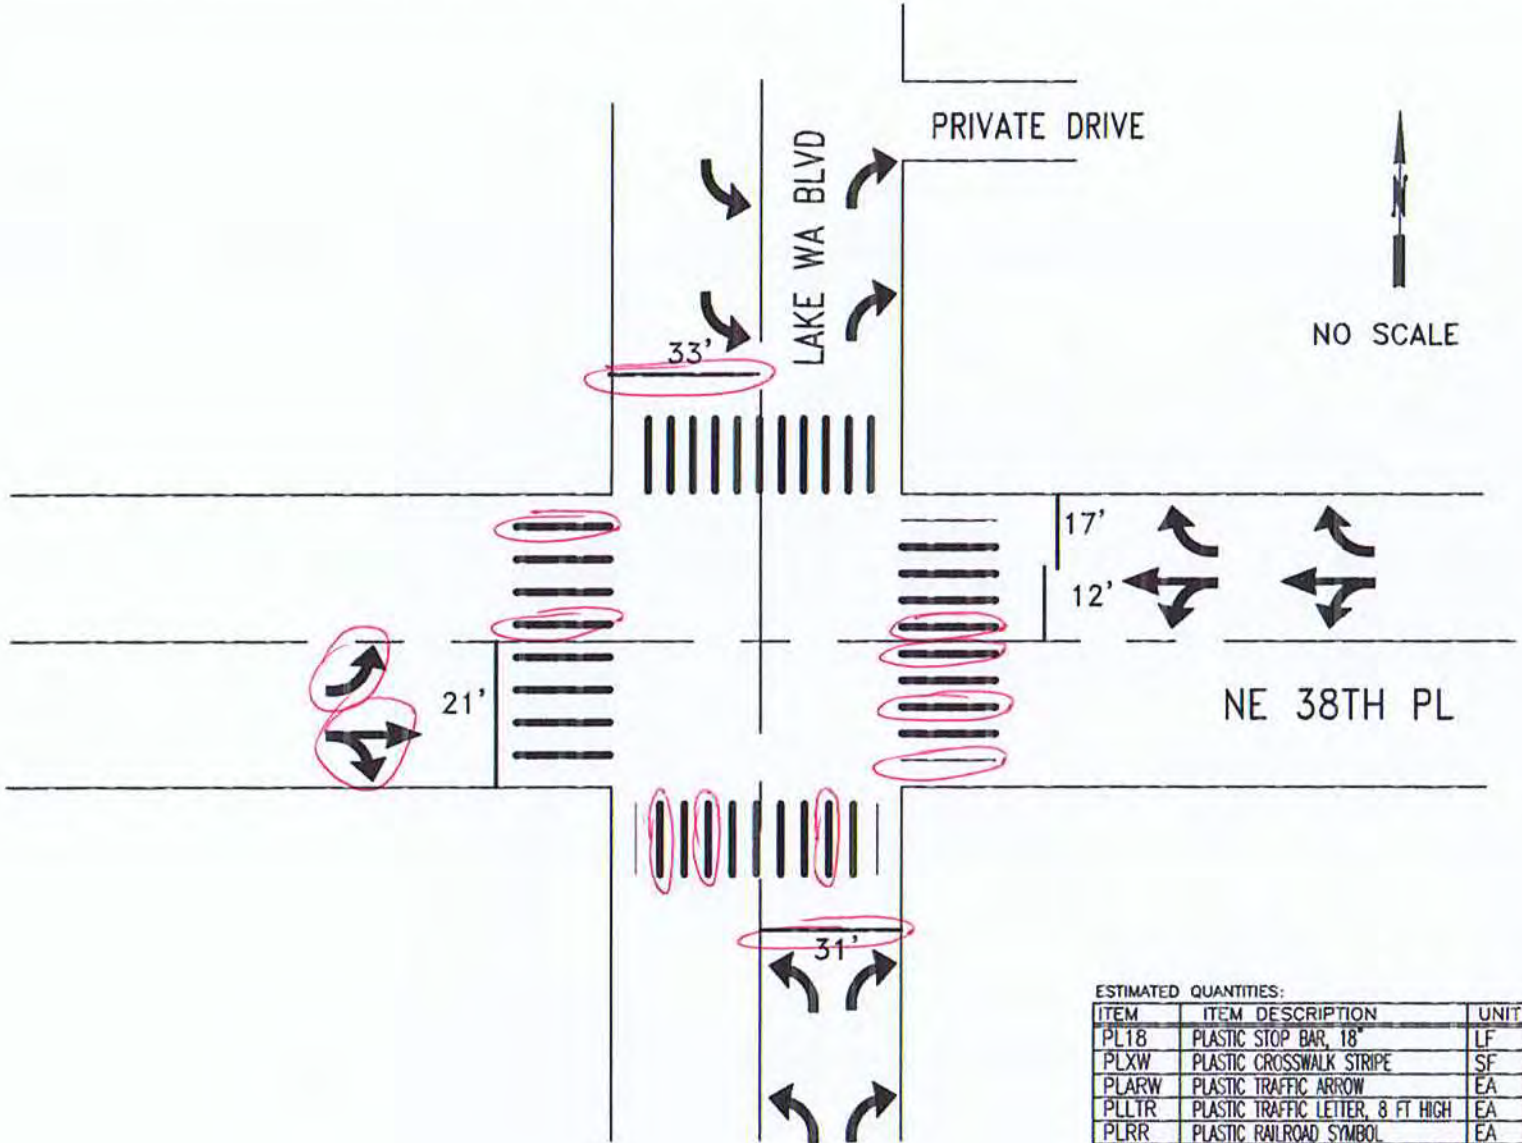

ESTIMATED QUANTITIES:

ITEM	ITEM DESCRIPTION	UNIT	INVENTORY	REPAIR QTY
PL18	PLASTIC STOP BAR, 18"	LF	114	44
PLXW	PLASTIC CROSSWALK STRIPE	SF	690	190
PLARW	PLASTIC TRAFFIC ARROW	EA	14	2
PLLTR	PLASTIC TRAFFIC LETTER, 8 FT HIGH	EA		
PLRR	PLASTIC RAILROAD SYMBOL	EA		
RPLSYM	REMOVE PL. ARROW, LETTER, SYMBOL	EA		2
RRPM	REMOVE RPM	EA		
RPLXW	REMOVE PLASTIC STRIPE	SF		

CITY OF KIRKLAND
DEPARTMENT OF PUBLIC WORKS
123 FIFTH AVENUE KIRKLAND, WA 98033
(425) 587-3800 www.kirklandwa.gov

D.GRILLEY 1/2000
DESIGNED BY: DATE

J.JENNINGS 1/2000
DRAWN BY: DATE

CHECKED BY: DATE

2020 PAVEMENT MARKING PROGRAM

STREET: LAKE WA BLVD

CROSS STREET: NE 38TH PL

SEGMENT:

SCALE: N.T.S.

FILENAME:

NO SCALE

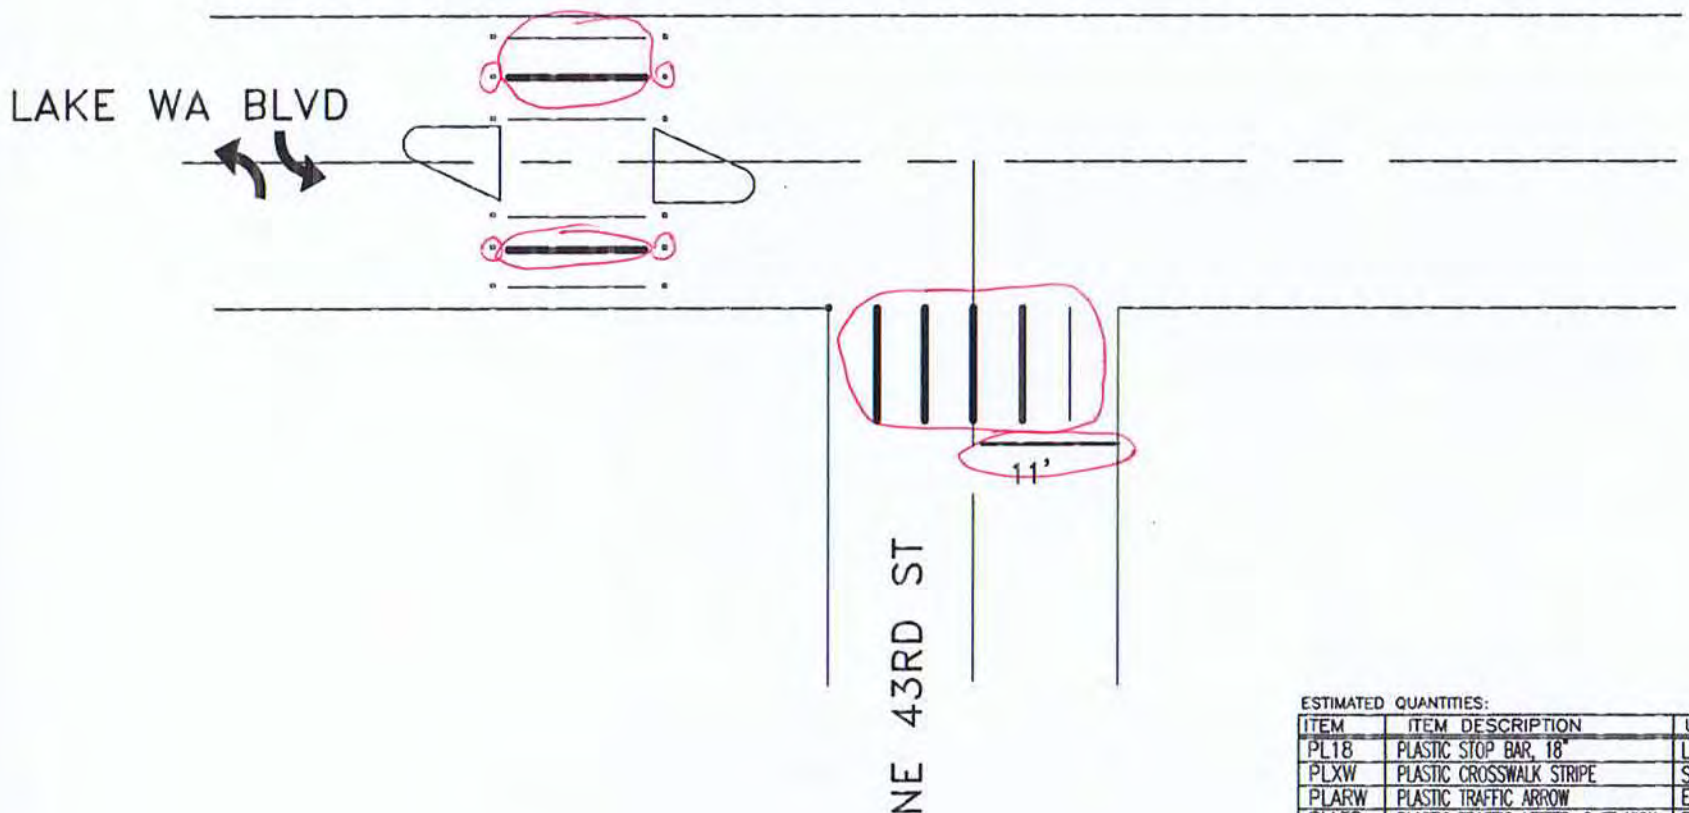

ESTIMATED QUANTITIES:

ITEM	ITEM DESCRIPTION	UNIT	INVENTORY	REPAIR QTY
PL18	PLASTIC STOP BAR, 18"	LF	11	11
PLXW	PLASTIC CROSSWALK STRIPE	SF	210	140
PLARW	PLASTIC TRAFFIC ARROW	EA		
PLLTR	PLASTIC TRAFFIC LETTER, 8 FT HIGH	EA		
PLRR	PLASTIC RAILROAD SYMBOL	EA		
RPLSYM	REMOVE PL. ARROW, LETTER, SYMBOL	EA		
RRPM	REMOVE RPM	EA		
RPLXW	REMOVE PLASTIC STRIPE	SF		
	RAISED PAVEMENT MARKER TYPE 2	EA	12	4

CITY OF KIRKLAND
DEPARTMENT OF PUBLIC WORKS
123 FIFTH AVENUE KIRKLAND, WA 98033
(425) 587-3800 www.kirklandwa.gov

G. HORTILLOSA 10/2011
DESIGNED BY: DATE

J.JENNINGS 10/2011
DRAWN BY: DATE

CHECKED BY: DATE

2020 PAVEMENT MARKING PROGRAM

STREET: LAKE WA BLVD

CROSS STREET: NE 43RD ST

SEGMENT:

SCALE: N.T.S.

FILENAME:

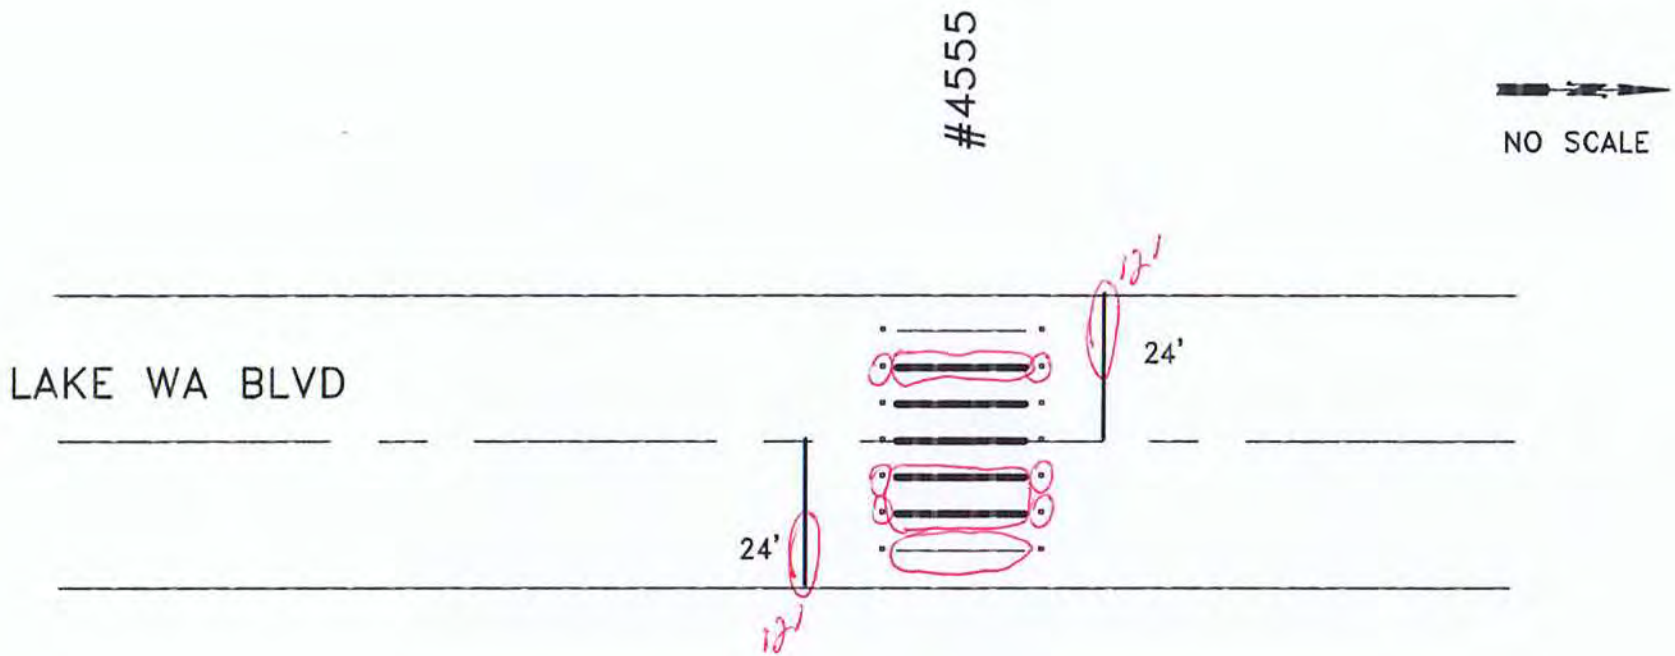

ESTIMATED QUANTITIES:

ITEM	ITEM DESCRIPTION	UNIT	INVENTORY	REPAIR QTY
PL18	PLASTIC STOP BAR, 18"	LF	48	24
PLXW	PLASTIC CROSSWALK STRIPE	SF	120	70
PLARW	PLASTIC TRAFFIC ARROW	EA		
PLLTR	PLASTIC TRAFFIC LETTER, 8 FT HIGH	EA		
PLRR	PLASTIC RAILROAD SYMBOL	EA		
RPLSYM	REMOVE PL. ARROW, LETTER, SYMBOL	EA		
RRPM	REMOVE RPM	EA		
RPLXW	REMOVE PLASTIC STRIPE	SF		
	RAISED PAVEMENT MARKER TYPE 2	EA	14	6

CITY OF KIRKLAND WASHINGTON

CITY OF KIRKLAND
DEPARTMENT OF PUBLIC WORKS
123 FIFTH AVENUE KIRKLAND, WA 98033
(425) 587-3800 www.kirklandwa.gov

G. HORTILLOSA 3/2009
DESIGNED BY: DATE

J.JENNINGS 3/2009
DRAWN BY: DATE

CHECKED BY: DATE

2020 PAVEMENT MARKING PROGRAM

STREET: LAKE WA BLVD

CROSS STREET: 46TH ST

SEGMENT:

SCALE: N.T.S.

FILENAME: Page 13-6

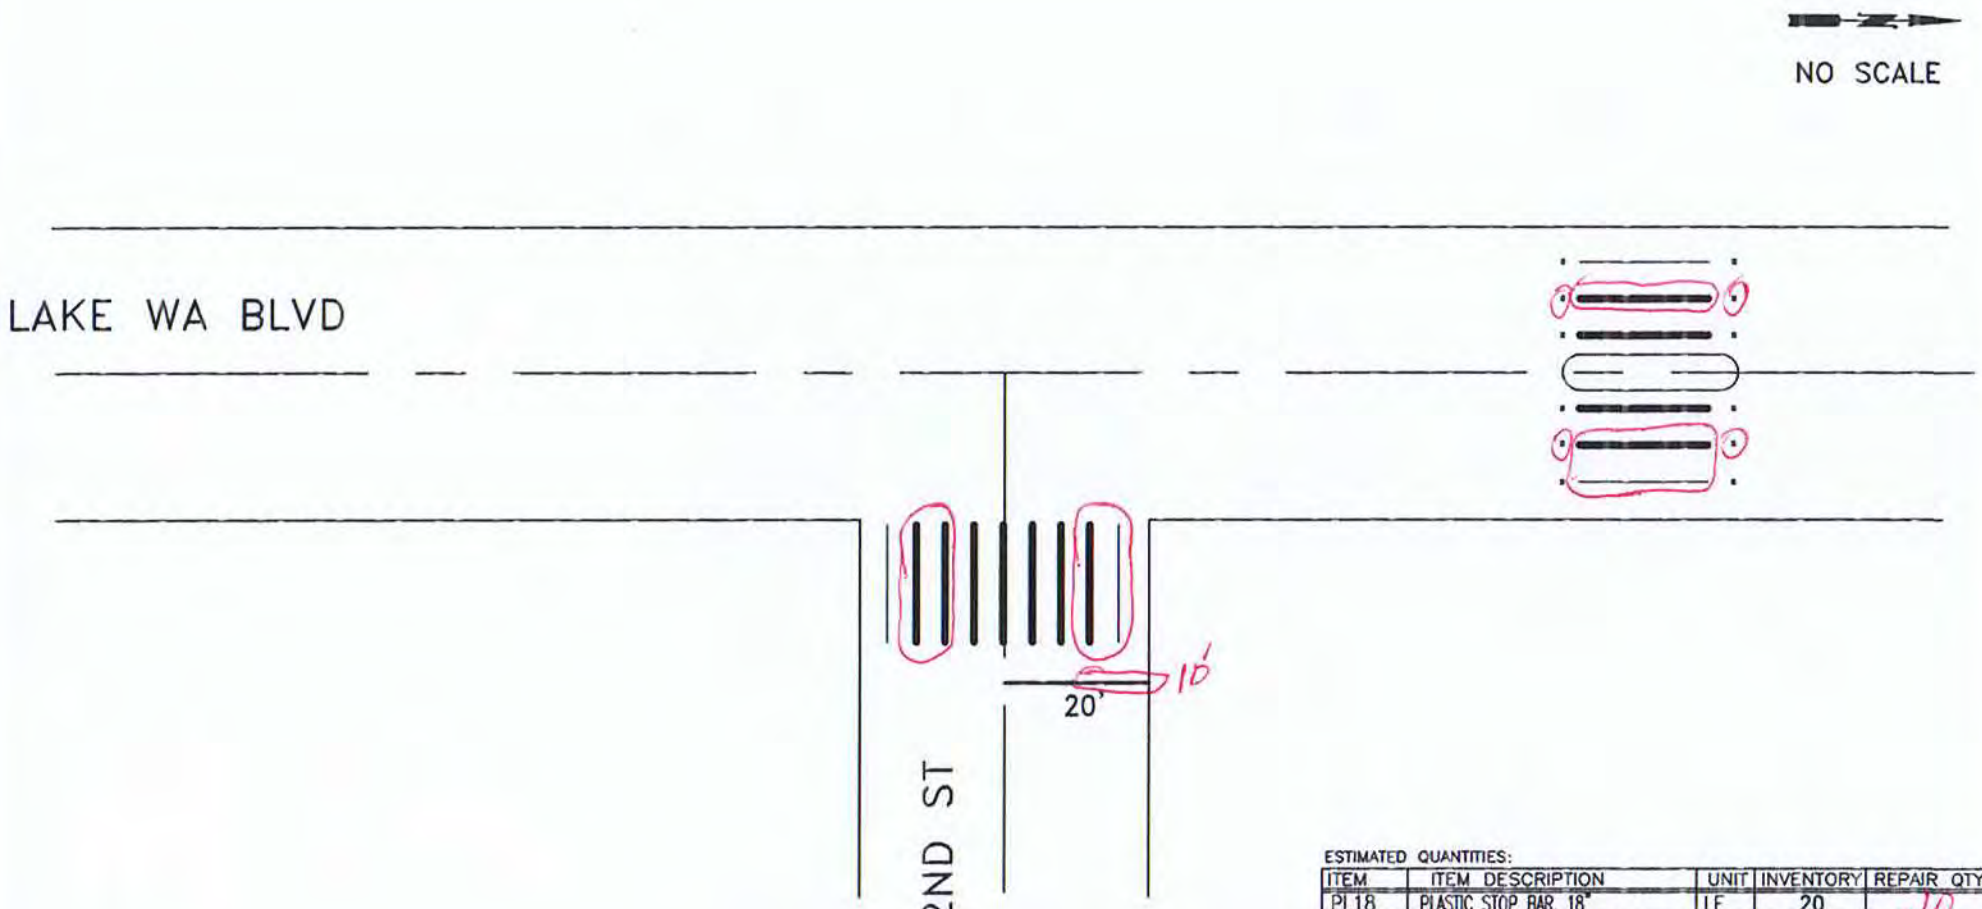

ESTIMATED QUANTITIES:

ITEM	ITEM DESCRIPTION	UNIT	INVENTORY	REPAIR QTY
PL18	PLASTIC STOP BAR, 18"	LF	20	10
PLXW	PLASTIC CROSSWALK STRIPE	SF	260	130
PLARW	PLASTIC TRAFFIC ARROW	EA		
PLLTR	PLASTIC TRAFFIC LETTER, 8 FT HIGH	EA		
PLRR	PLASTIC RAILROAD SYMBOL	EA		
RPLSYM	REMOVE PL. ARROW, LETTER, SYMBOL	EA		
RRPM	REMOVE RPM	EA		
RPLXW	REMOVE PLASTIC STRIPE	SF		70
	RAISED PAVEMENT MARKER TYPE 2	EA	12	4

CITY OF KIRKLAND
DEPARTMENT OF PUBLIC WORKS
123 FIFTH AVENUE KIRKLAND, WA 98033
(425) 587-3800 www.kirklandwa.gov

G. HORTILLOSA 10/2011
DESIGNED BY: DATE

J.JENNINGS 10/2011
DRAWN BY: DATE

CHECKED BY: DATE

2020 PAVEMENT MARKING PROGRAM

STREET: LAKE WA BLVD

CROSS STREET: NE 52ND ST

SEGMENT:

SCALE: N.T.S.

FILENAME: Page 13-7

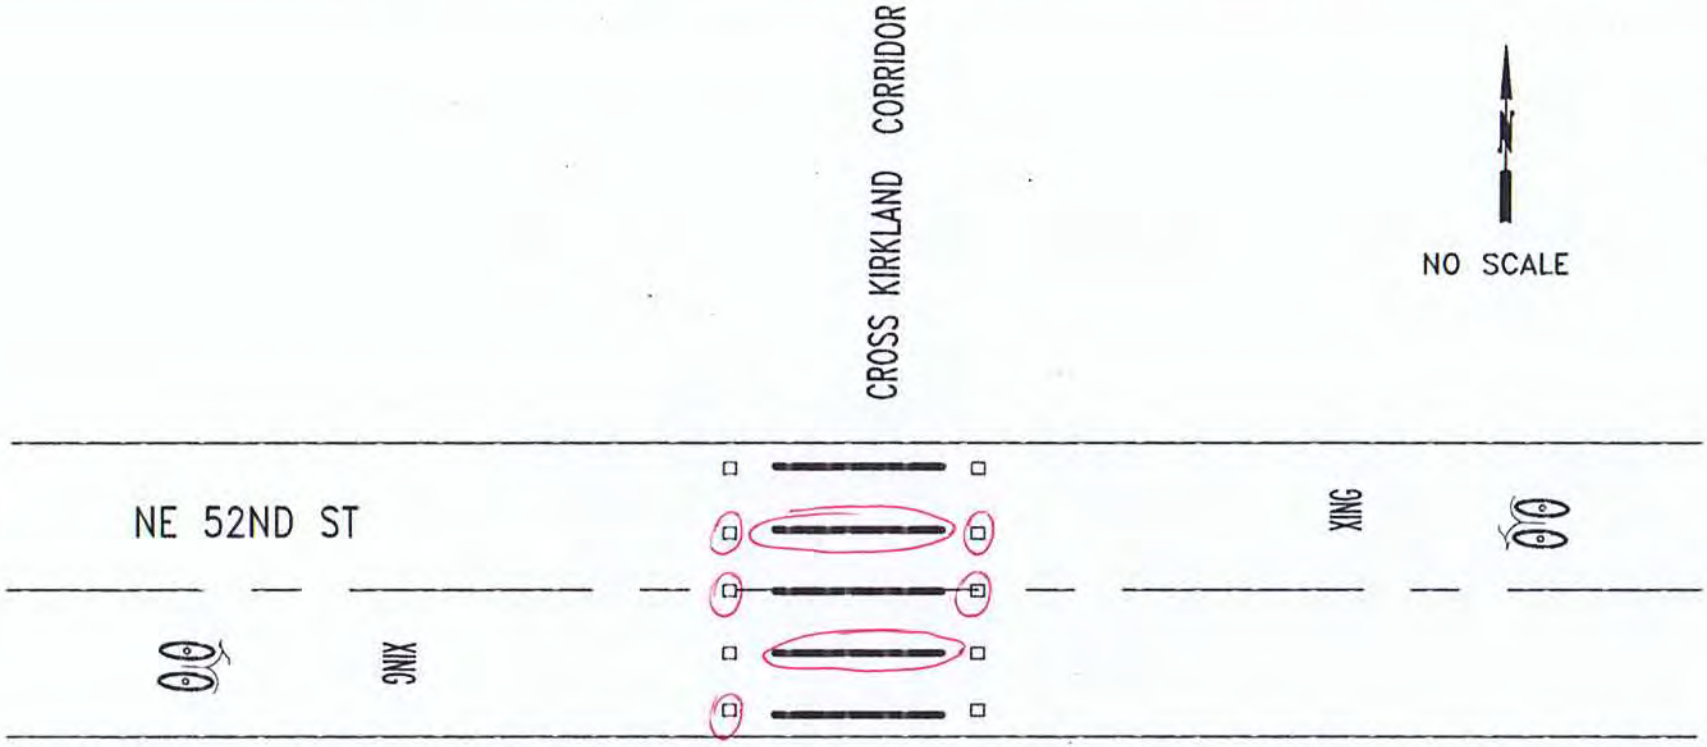

ESTIMATED QUANTITIES:

ITEM	ITEM DESCRIPTION	UNIT	INVENTORY	REPAIR QTY
PL18	PLASTIC STOP BAR, 18"	LF		
PLXW	PLASTIC CROSSWALK STRIPE	SF	100	40
PLARW	PLASTIC TRAFFIC ARROW	EA		
PLLTR	PLASTIC TRAFFIC LETTER, 8 FT HIGH	EA	8	
	PLASTIC BICYCLE SYMBOL	EA	2	
	RAISED PAVEMENT MARKER TYPE 2	EA	10	5
RPLSYM	REMOVE PL. ARROW, LETTER, SYMBOL	EA		
RRPM	REMOVE RPM	EA		
RPLXW	REMOVE PLASTIC STRIPE	SF		

CITY OF KIRKLAND
DEPARTMENT OF PUBLIC WORKS
123 FIFTH AVENUE KIRKLAND, WA 98033
(425) 587-3800 www.kirklandwa.gov

L. KAWAOKA 12/2016
DESIGNED BY: DATE

J.JENNINGS 12/2016
DRAWN BY: DATE

CHECKED BY: DATE

2020 PAVEMENT MARKING PROGRAM

STREET: NE 52ND ST

CROSS STREET: CROSS KIRKLAND CORRIDOR

SEGMENT:

SCALE: N.T.S.

FILENAME: Page 13-7A

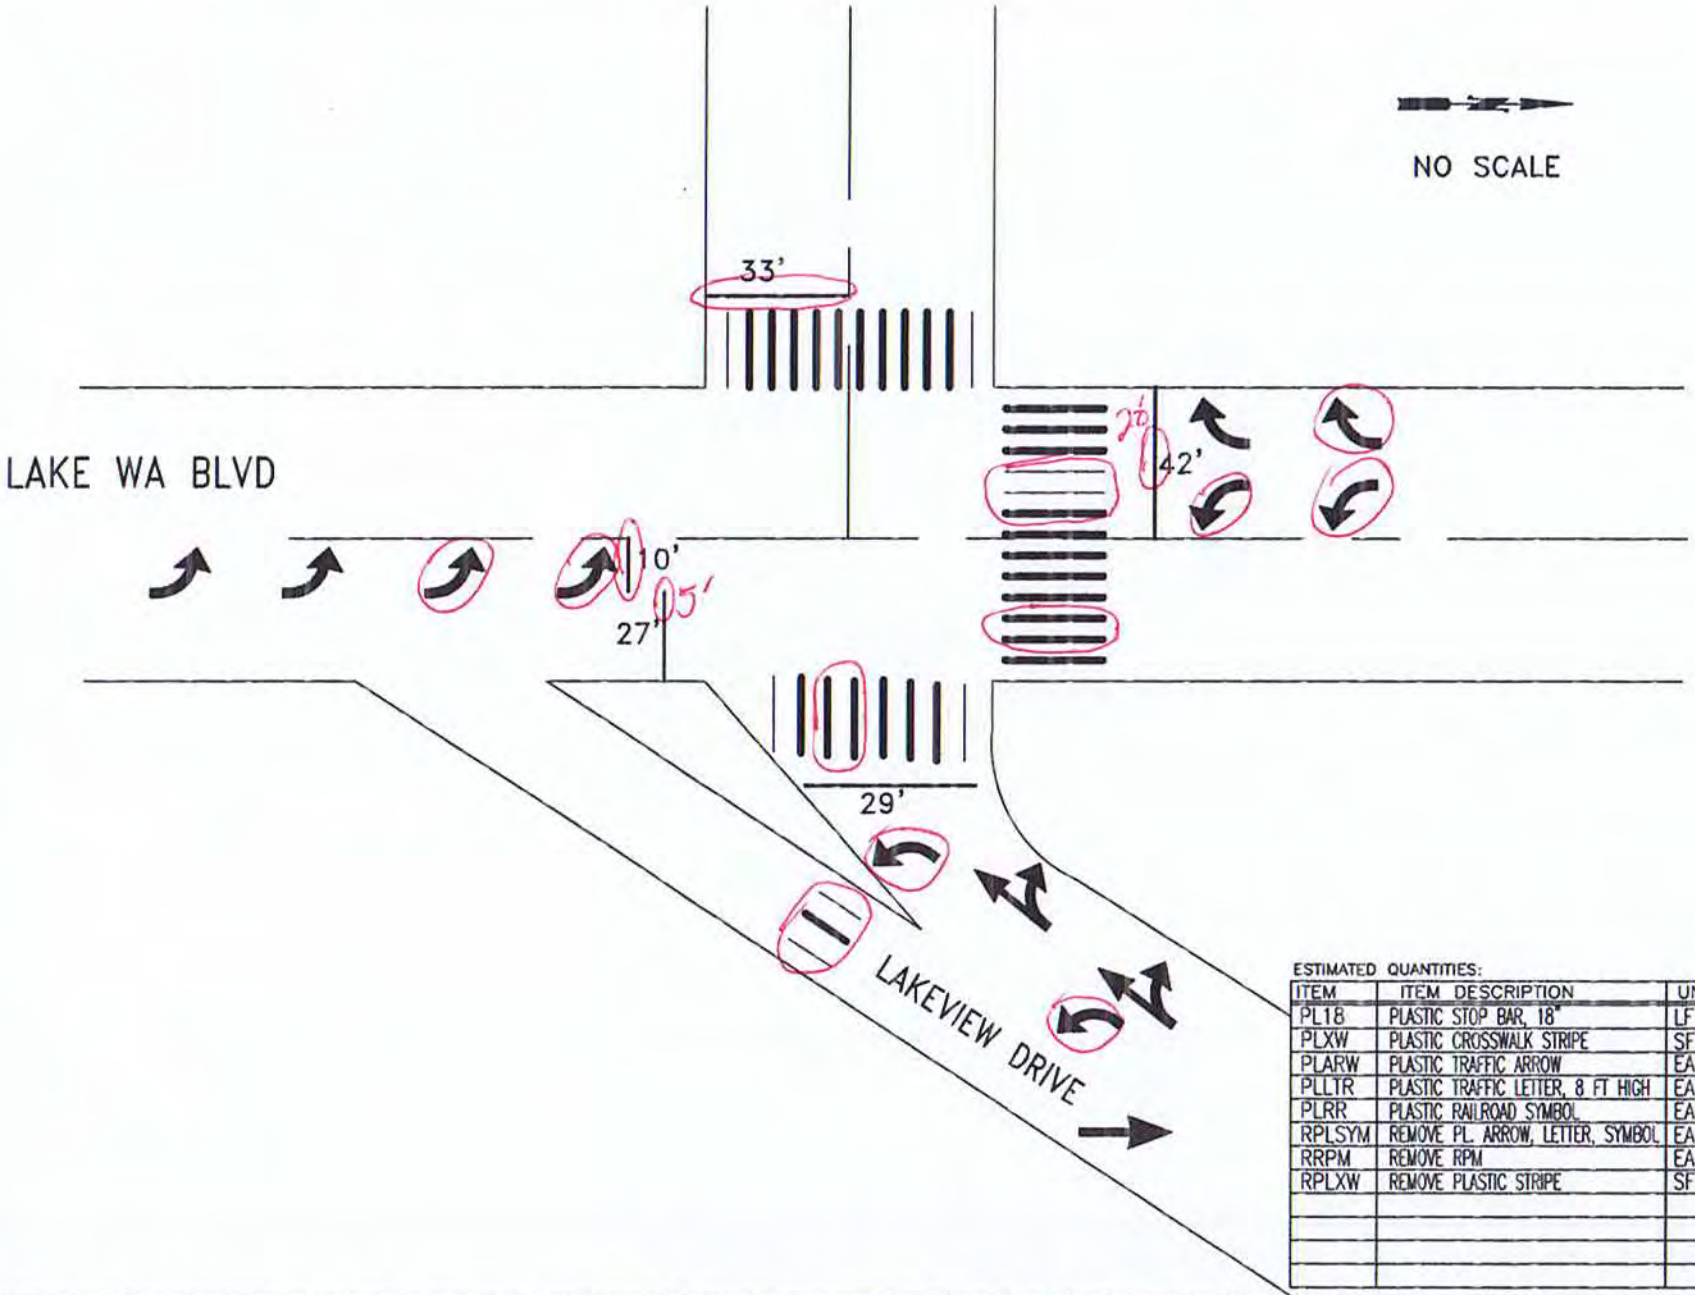

ESTIMATED QUANTITIES:

ITEM	ITEM DESCRIPTION	UNIT	INVENTORY	REPAIR QTY
PL18	PLASTIC STOP BAR, 18"	LF	141	68
PLXW	PLASTIC CROSSWALK STRIPE	SF	640	120
PLARW	PLASTIC TRAFFIC ARROW	EA	13	7
PLLTR	PLASTIC TRAFFIC LETTER, 8 FT HIGH	EA		
PLRR	PLASTIC RAILROAD SYMBOL	EA		
RPLSYM	REMOVE PL. ARROW, LETTER, SYMBOL	EA		5
RRPM	REMOVE RPM	EA		
RPLXW	REMOVE PLASTIC STRIPE	SF		80

CITY OF KIRKLAND
DEPARTMENT OF PUBLIC WORKS
123 FIFTH AVENUE KIRKLAND, WA 98033
(425) 587-3800 www.kirklandwa.gov

G. HORTILLOSA 2/2011
DESIGNED BY: DATE

J.JENNINGS 10/2011
DRAWN BY: DATE

CHECKED BY: DATE

2020 PAVEMENT MARKING PROGRAM

STREET: LAKE WA BLVD

CROSS STREET: LAKEVIEW DRIVE

SEGMENT:

SCALE: N.T.S.

FILENAME:

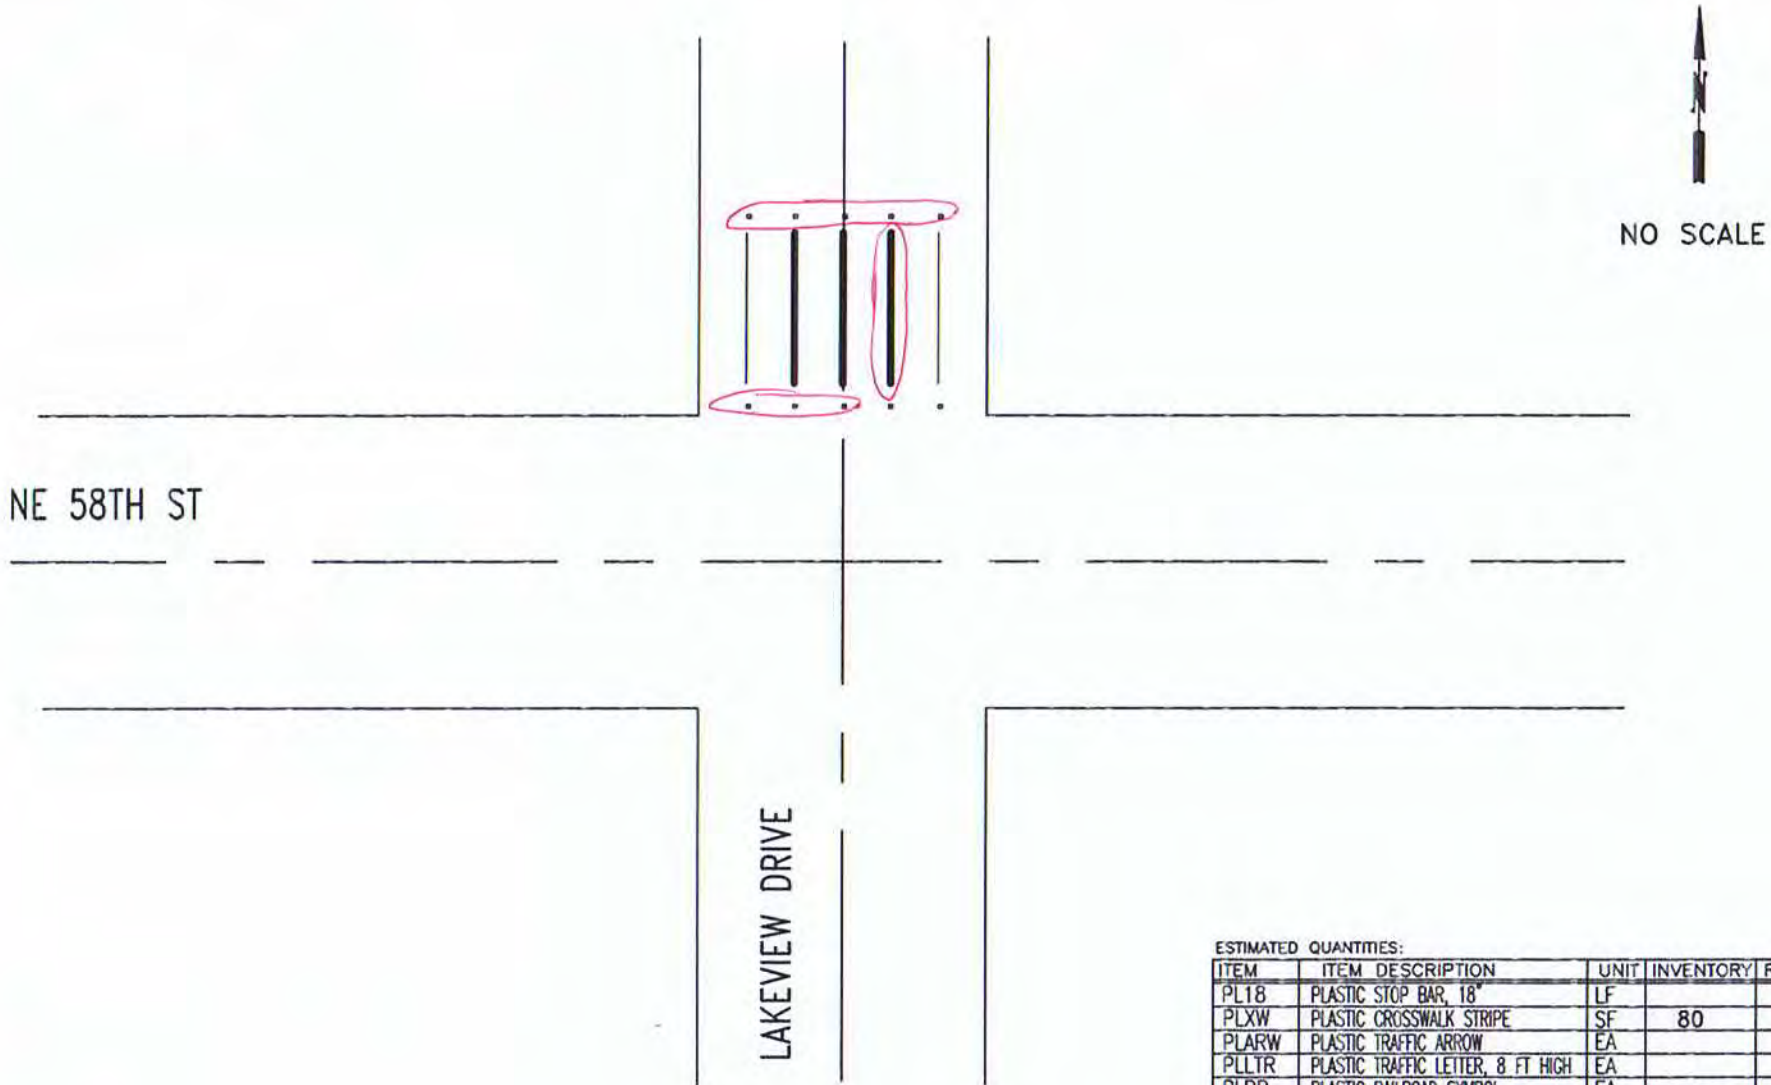

ESTIMATED QUANTITIES:

ITEM	ITEM DESCRIPTION	UNIT	INVENTORY	REPAIR QTY
PL18	PLASTIC STOP BAR, 18"	LF		
PLXW	PLASTIC CROSSWALK STRIPE	SF	80	20
PLARW	PLASTIC TRAFFIC ARROW	EA		
PLLTR	PLASTIC TRAFFIC LETTER, 8 FT HIGH	EA		
PLRR	PLASTIC RAILROAD SYMBOL	EA		
RPLSYM	REMOVE PL. ARROW, LETTER, SYMBOL	EA		
RRPM	REMOVE RPM	EA		
RPLXW	REMOVE PLASTIC STRIPE	SF		28
	RAISED PAVEMENT MARKER TYPE 2	EA	10	8

CITY OF KIRKLAND
DEPARTMENT OF PUBLIC WORKS
123 FIFTH AVENUE KIRKLAND, WA 98033
(425) 587-3800 www.kirklandwa.gov

D.GRILLEY 1/2000
DESIGNED BY: DATE

J.JENNINGS 1/2000
DRAWN BY: DATE

CHECKED BY: DATE

2022 PAVEMENT MARKING PROGRAM

STREET: NE 58TH ST

CROSS STREET: LAKEVIEW DRIVE

SEGMENT:

SCALE: N.T.S.

FILENAME:

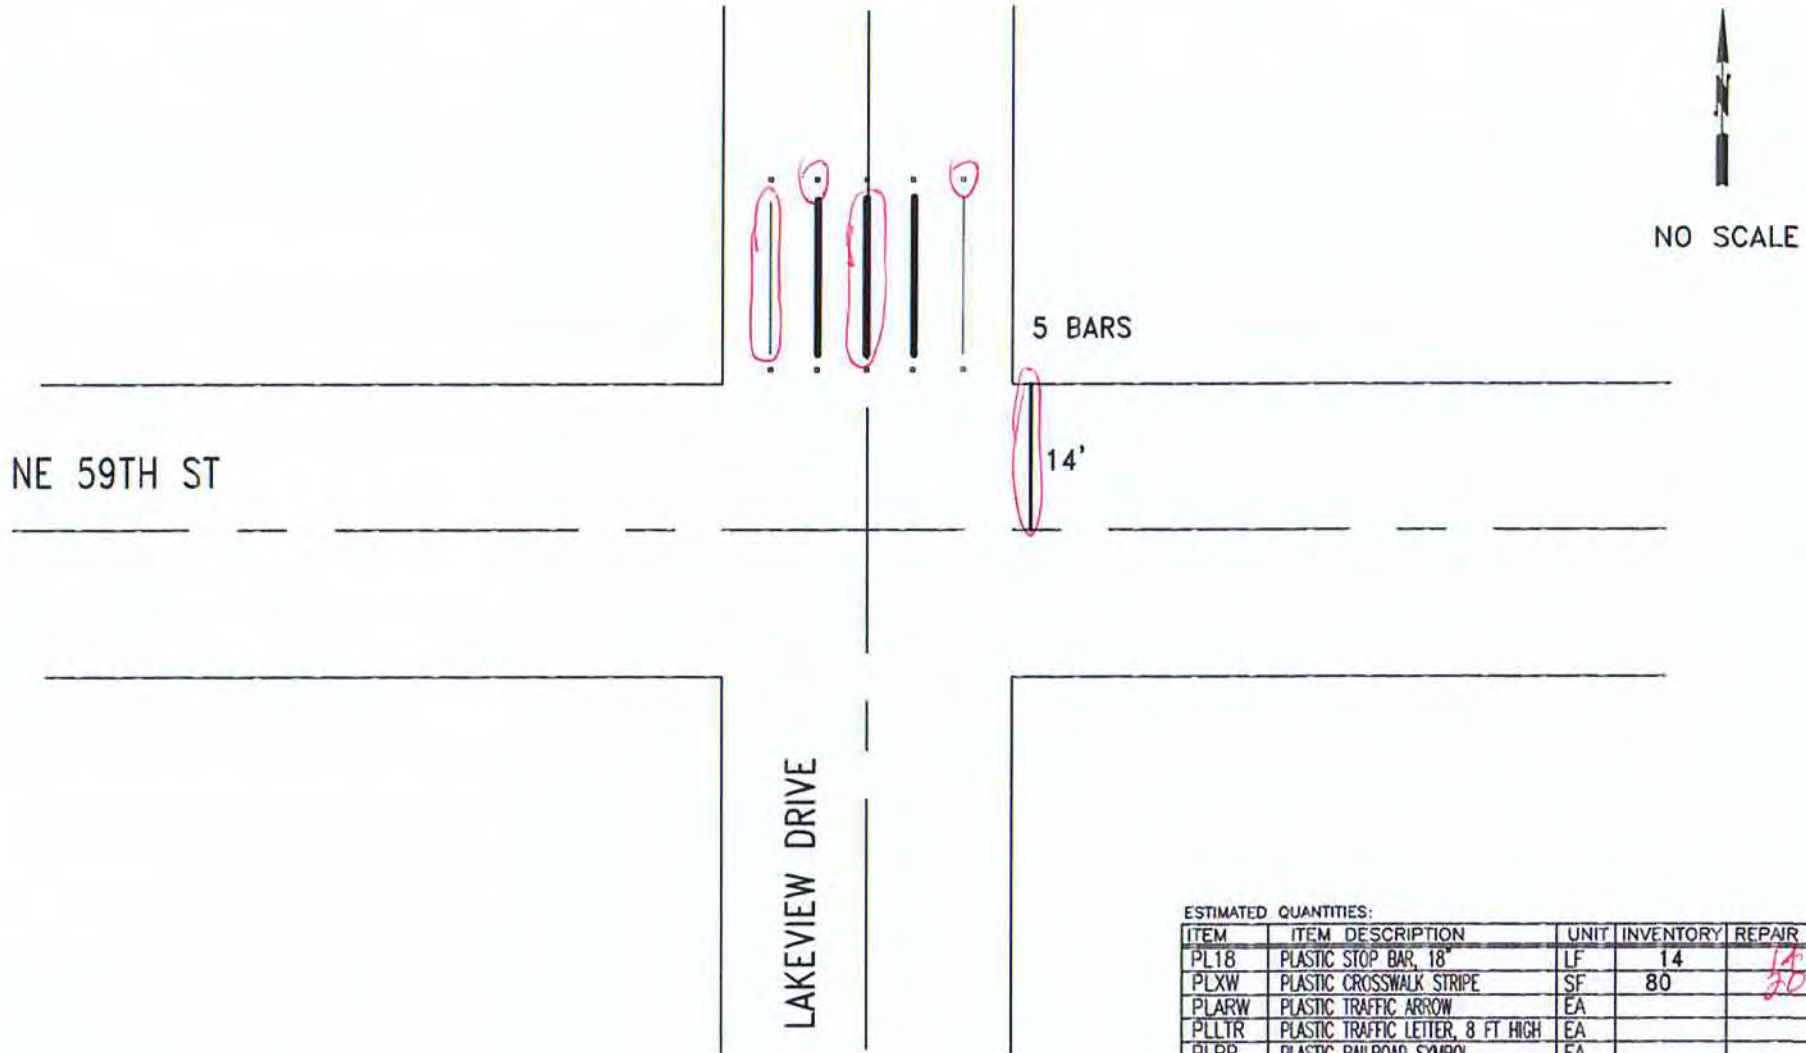

ESTIMATED QUANTITIES:

ITEM	ITEM DESCRIPTION	UNIT	INVENTORY	REPAIR QTY
PL18	PLASTIC STOP BAR, 18"	LF	14	16
PLXW	PLASTIC CROSSWALK STRIPE	SF	80	20
PLARW	PLASTIC TRAFFIC ARROW	EA		
PLLTR	PLASTIC TRAFFIC LETTER, 8 FT HIGH	EA		
PLRR	PLASTIC RAILROAD SYMBOL	EA		
RPLSYM	REMOVE PL. ARROW, LETTER, SYMBOL	EA		
RRPM	REMOVE RPM	EA		
RPLXW	REMOVE PLASTIC STRIPE	SF		
	RAISED PAVEMENT MARKER TYPE 2	EA	10	2

CITY OF KIRKLAND
DEPARTMENT OF PUBLIC WORKS
123 FIFTH AVENUE KIRKLAND, WA 98033
(425) 587-3800 www.kirklandwa.gov

D.GRILLEY 1/2000
DESIGNED BY: DATE

J.JENNINGS 1/2000
DRAWN BY: DATE

CHECKED BY: DATE

2020 PAVEMENT MARKING PROGRAM

STREET: NE 59TH ST

CROSS STREET: LAKEVIEW DRIVE

SEGMENT:

SCALE: N.T.S.

FILENAME: Page 13-10

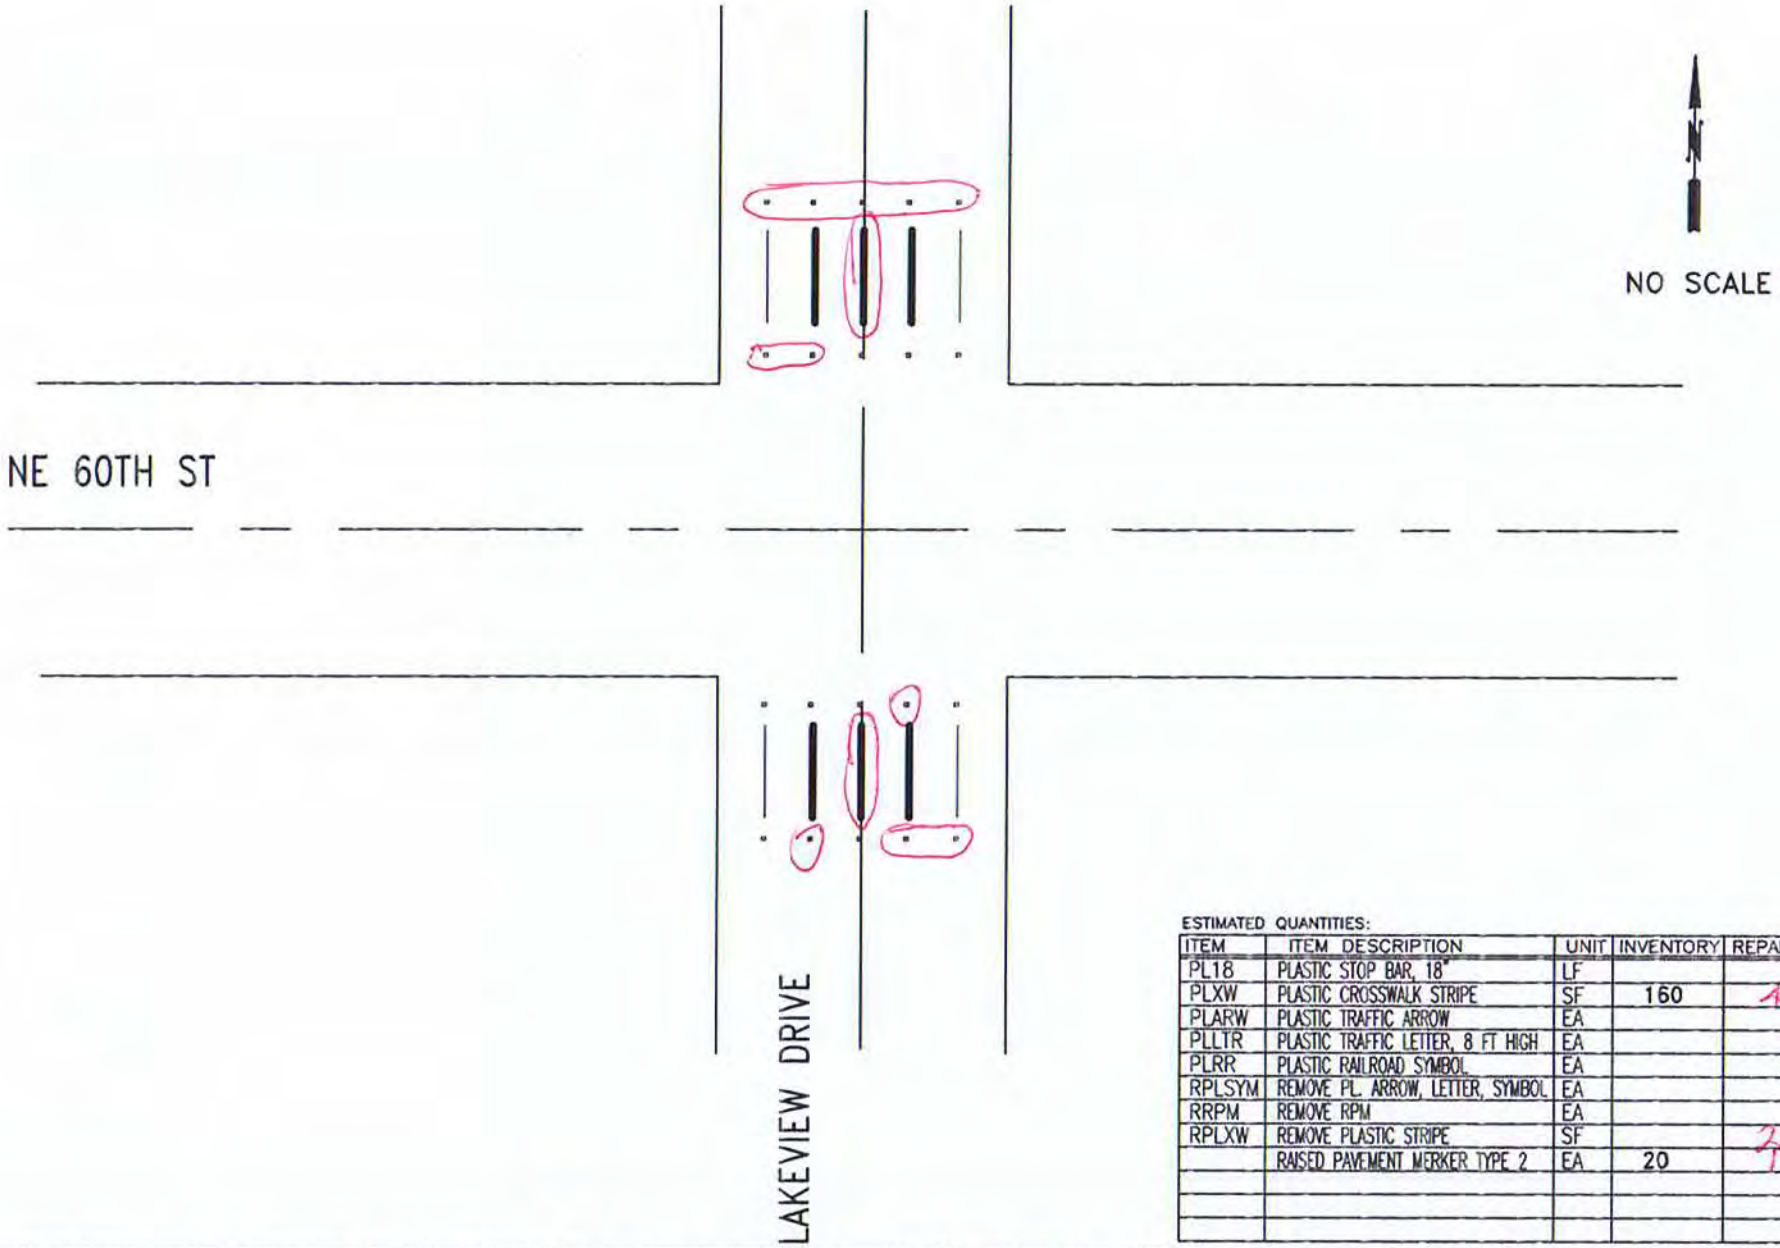

ESTIMATED QUANTITIES:

ITEM	ITEM DESCRIPTION	UNIT	INVENTORY	REPAIR QTY
PL18	PLASTIC STOP BAR, 18"	LF		
PLXW	PLASTIC CROSSWALK STRIPE	SF	160	10
PLARW	PLASTIC TRAFFIC ARROW	EA		
PLLTR	PLASTIC TRAFFIC LETTER, 8 FT HIGH	EA		
PLRR	PLASTIC RAILROAD SYMBOL	EA		
RPLSYM	REMOVE PL. ARROW, LETTER, SYMBOL	EA		
RRPM	REMOVE RPM	EA		
RPLXW	REMOVE PLASTIC STRIPE	SF		70
	RAISED PAVEMENT MERKER TYPE 2	EA	20	11

CITY OF KIRKLAND
DEPARTMENT OF PUBLIC WORKS
123 FIFTH AVENUE KIRKLAND, WA 98033
(425) 587-3800 www.kirklandwa.gov

G. HORTILLOSA 10/2006
DESIGNED BY: DATE

J.JENNINGS 10/2006
DRAWN BY: DATE

CHECKED BY: DATE

2020 PAVEMENT MARKING PROGRAM

STREET: NE 60TH ST

CROSS STREET: LAKEVIEW DRIVE

SEGMENT:

SCALE: N.T.S.

FILENAME: Page 13-11

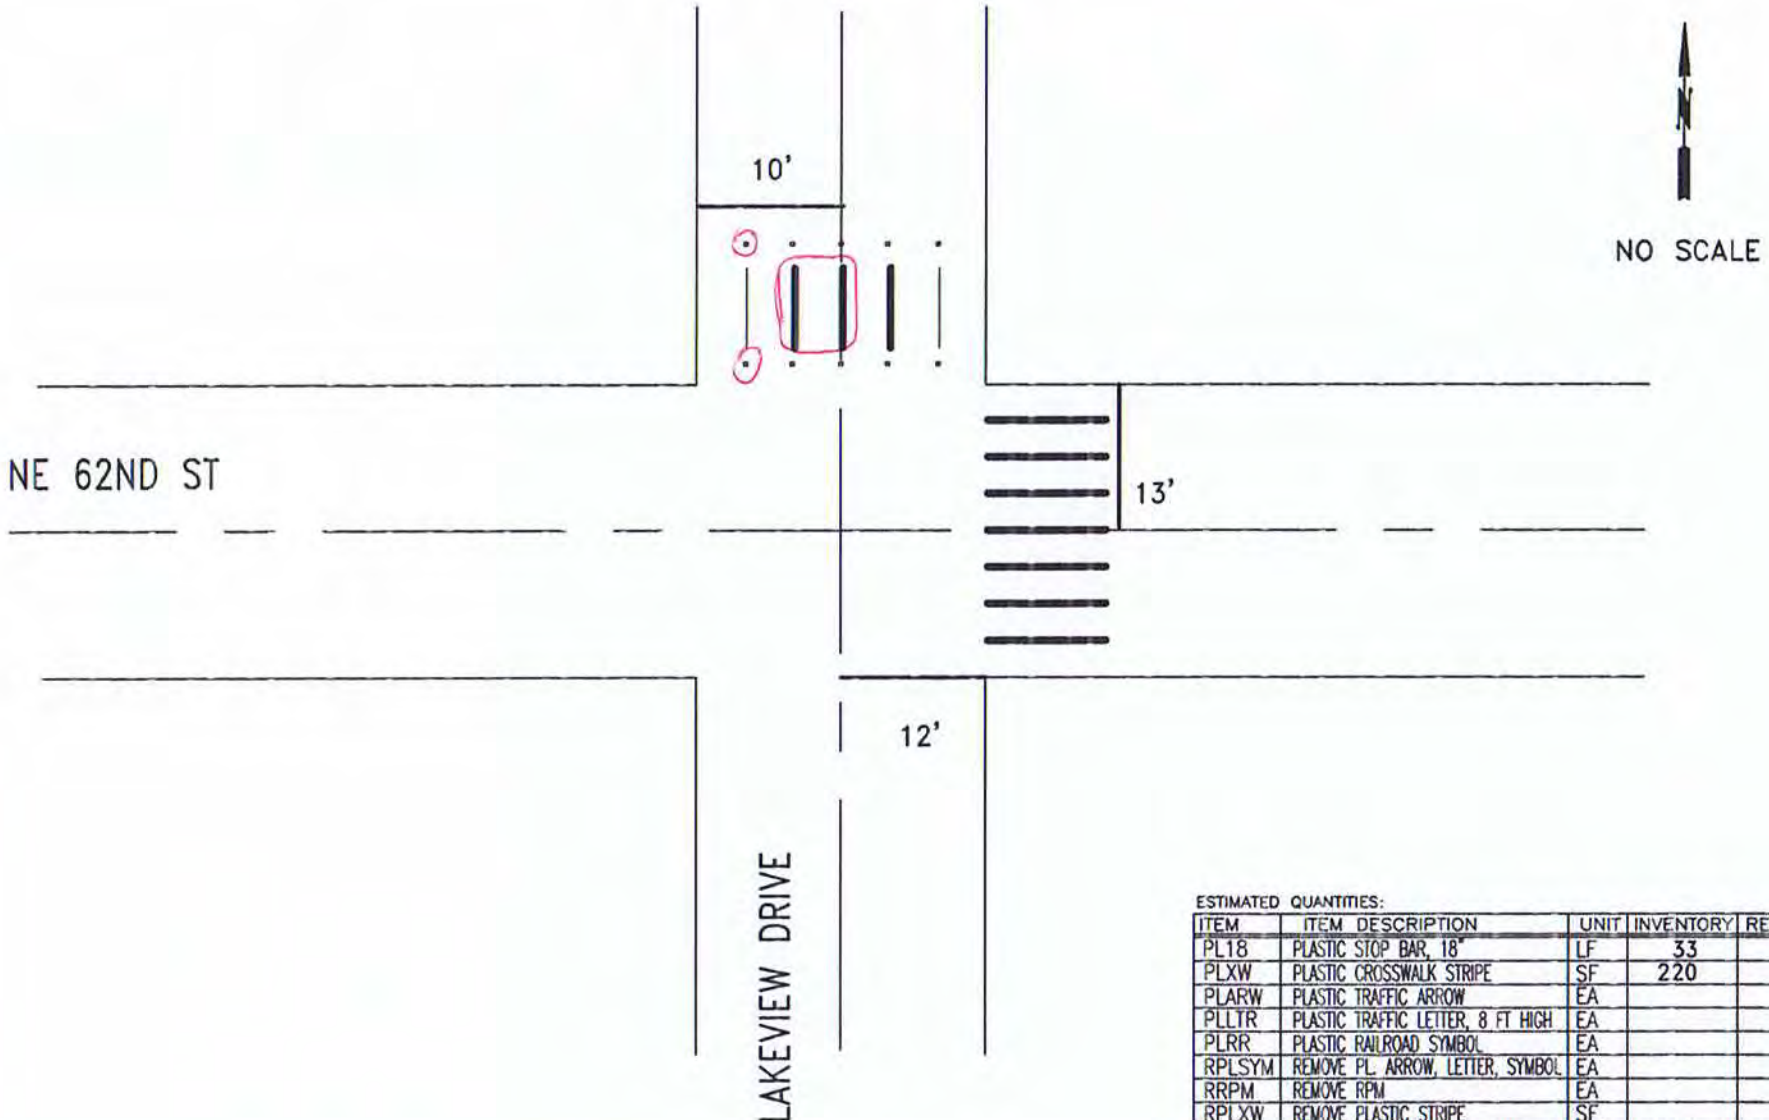

ESTIMATED QUANTITIES:

ITEM	ITEM DESCRIPTION	UNIT	INVENTORY	REPAIR QTY
PL18	PLASTIC STOP BAR, 18"	LF	33	
PLXW	PLASTIC CROSSWALK STRIPE	SF	220	40
PLARW	PLASTIC TRAFFIC ARROW	EA		
PLLTR	PLASTIC TRAFFIC LETTER, 8 FT HIGH	EA		
PLRR	PLASTIC RAILROAD SYMBOL	EA		
RPLSYM	REMOVE PL. ARROW, LETTER, SYMBOL	EA		
RRPM	REMOVE RPM	EA		
RPLXW	REMOVE PLASTIC STRIPE	SF		
	RAISED PAVEMENT MARKER TYPE 2	EA	10	2

CITY OF KIRKLAND
DEPARTMENT OF PUBLIC WORKS
123 FIFTH AVENUE KIRKLAND, WA 98033
(425) 587-3800 www.kirklandwa.gov

G. HORTILLOSA 10/2011
DESIGNED BY: DATE

J.JENNINGS 10/2011
DRAWN BY: DATE

CHECKED BY: DATE

2020 PAVEMENT MARKING PROGRAM

STREET: NE 62ND ST

CROSS STREET: LAKEVIEW DRIVE

SEGMENT:

SCALE: N.T.S.

FILENAME: Page 13-12

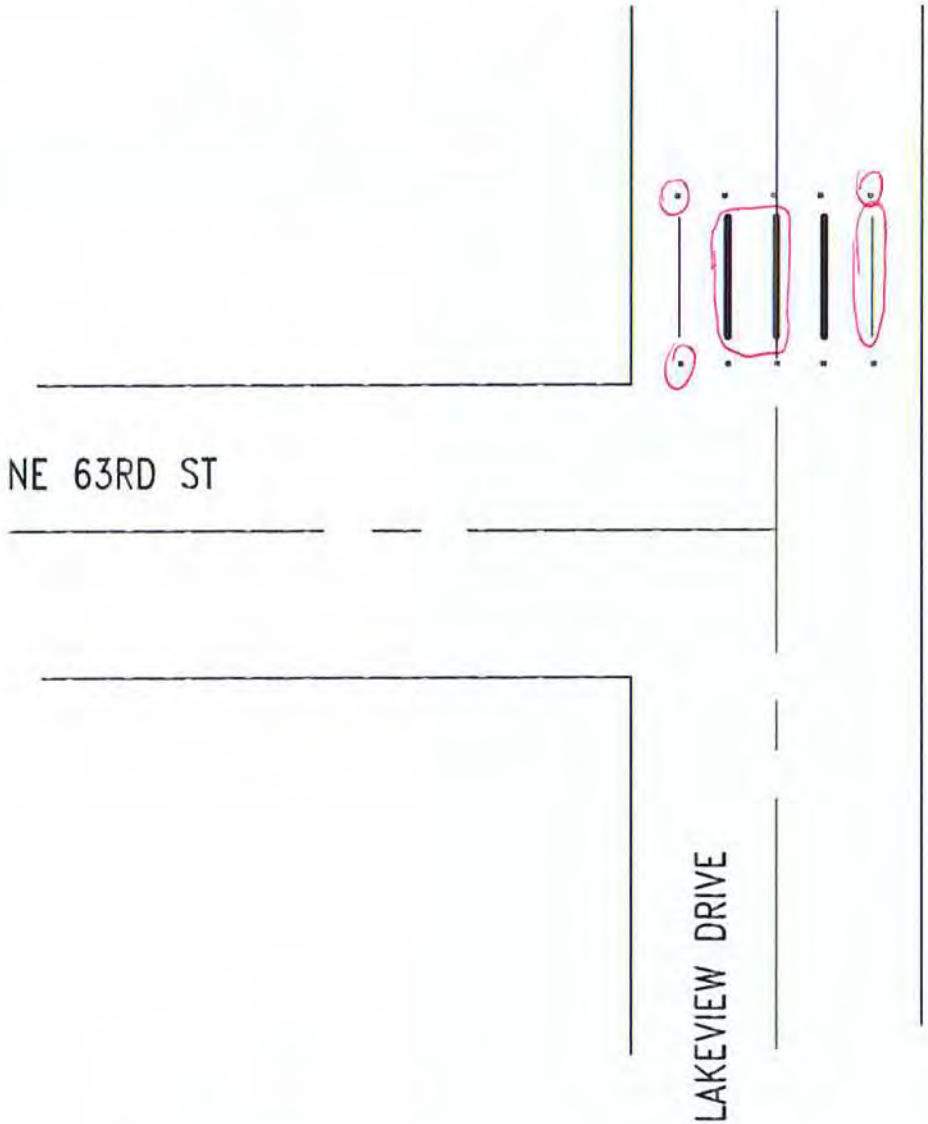

NO SCALE

ESTIMATED QUANTITIES:

ITEM	ITEM DESCRIPTION	UNIT	INVENTORY	REPAIR QTY
PL18	PLASTIC STOP BAR, 18"	LF		
PLXW	PLASTIC CROSSWALK STRIPE	SF	80	50
PLARW	PLASTIC TRAFFIC ARROW	EA		
PLLTR	PLASTIC TRAFFIC LETTER, 8 FT HIGH	EA		
PLRR	PLASTIC RAILROAD SYMBOL	EA		
RPLSYM	REMOVE PL. ARROW, LETTER, SYMBOL	EA		
RRPM	REMOVE RPM	EA		2
RPLXW	REMOVE PLASTIC STRIPE	SF		
	RAISED PAVEMENT MARKER TYPE 2	EA	10	3

CITY OF KIRKLAND
DEPARTMENT OF PUBLIC WORKS
123 FIFTH AVENUE KIRKLAND, WA 98033
(425) 587-3800 www.kirklandwa.gov

D.GRILLEY 1/2000
DESIGNED BY: DATE

J.JENNINGS 1/2000
DRAWN BY: DATE

CHECKED BY: DATE

2020 PAVEMENT MARKING PROGRAM

STREET: NE 63RD ST

CROSS STREET: LAKEVIEW DRIVE

SEGMENT:

SCALE: N.T.S.

FILENAME: Page 13-13

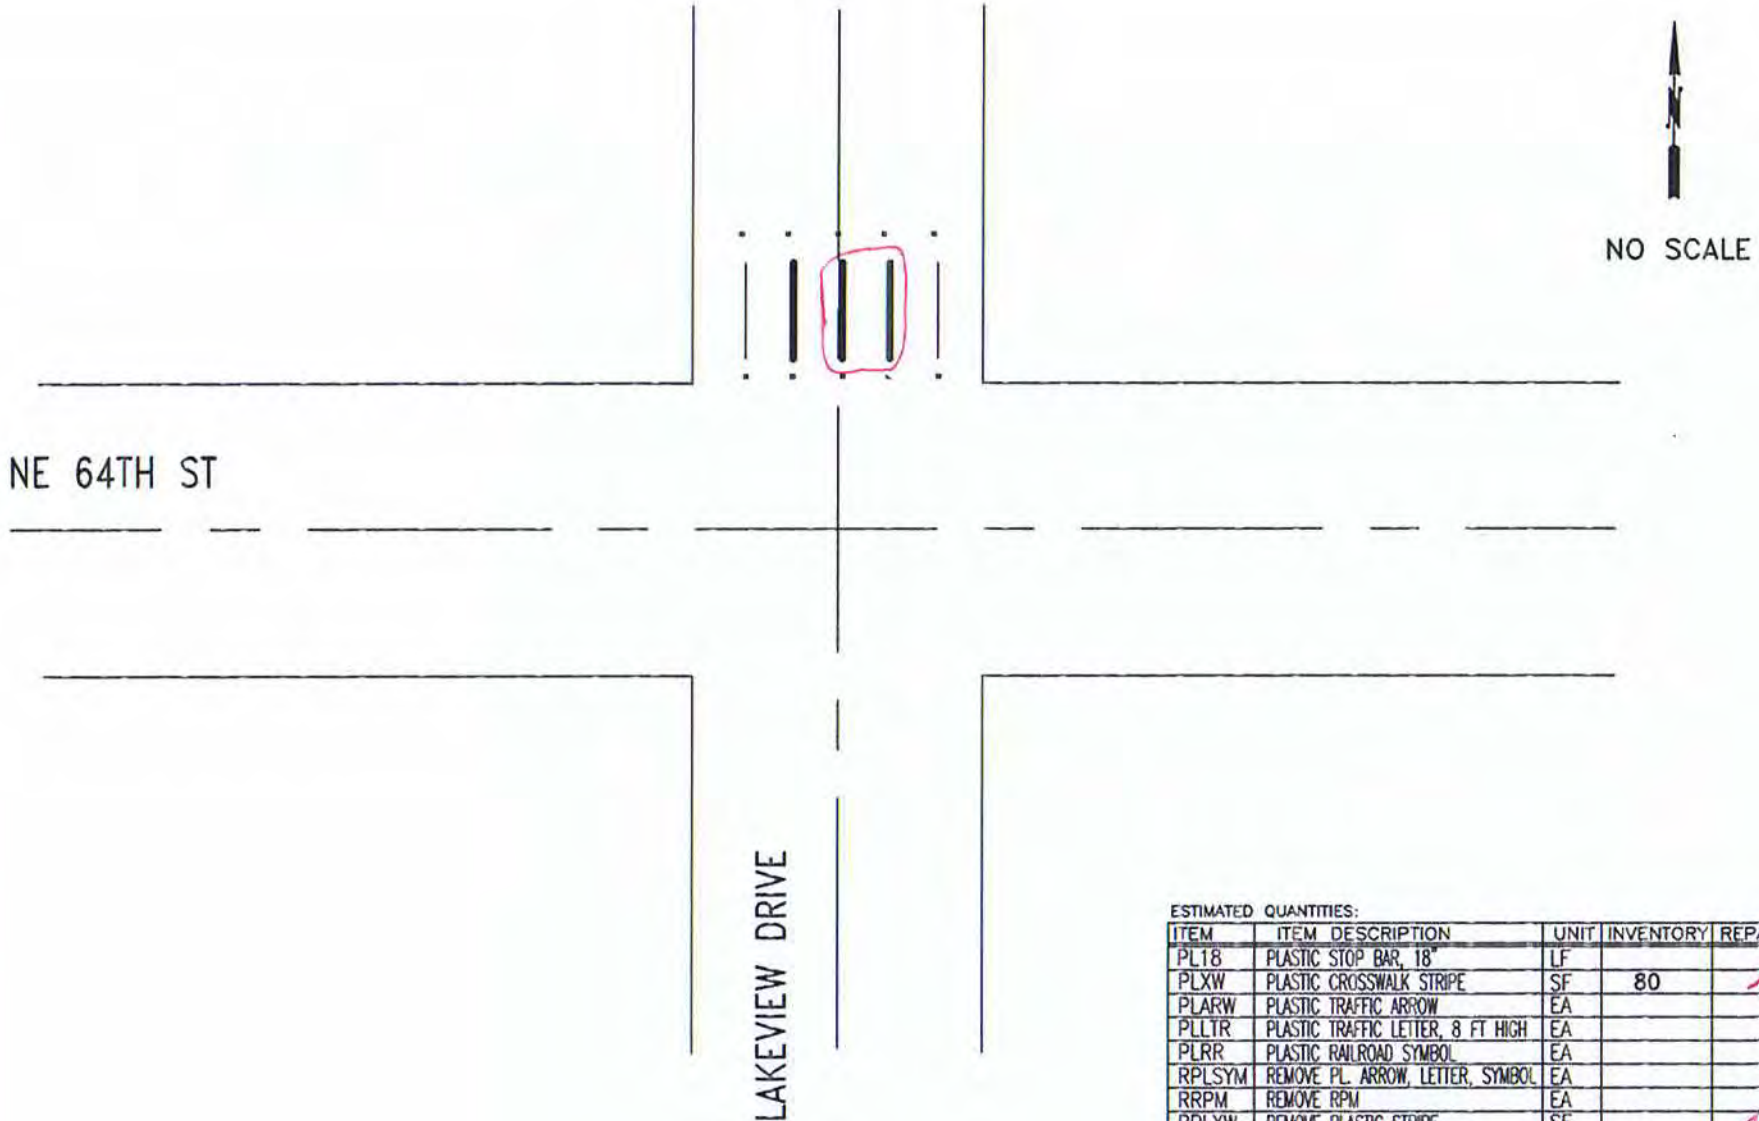

ESTIMATED QUANTITIES:

ITEM	ITEM DESCRIPTION	UNIT	INVENTORY	REPAIR QTY
PL18	PLASTIC STOP BAR, 18"	LF		
PLXW	PLASTIC CROSSWALK STRIPE	SF	80	10
PLARW	PLASTIC TRAFFIC ARROW	EA		
PLLTR	PLASTIC TRAFFIC LETTER, 8 FT HIGH	EA		
PLRR	PLASTIC RAILROAD SYMBOL	EA		
RPLSYM	REMOVE PL. ARROW, LETTER, SYMBOL	EA		
RRPM	REMOVE RPM	EA		
RPLXW	REMOVE PLASTIC STRIPE	SF		10
	RAISED PAVEMENT MARKER TYPE 2	EA	10	

CITY OF KIRKLAND
DEPARTMENT OF PUBLIC WORKS
123 FIFTH AVENUE KIRKLAND, WA 98033

G. HORTILLOSA 10/2006
DESIGNED BY: DATE

J.JENNINGS 10/2006
DRAWN BY: DATE

CHECKED BY: DATE

2020 PAVEMENT MARKING PROGRAM

STREET: NE 64TH ST

CROSS STREET: LAKEVIEW DRIVE

SEGMENT:

SCALE: N.T.S.

FILENAME: Page 13-14

NO SCALE

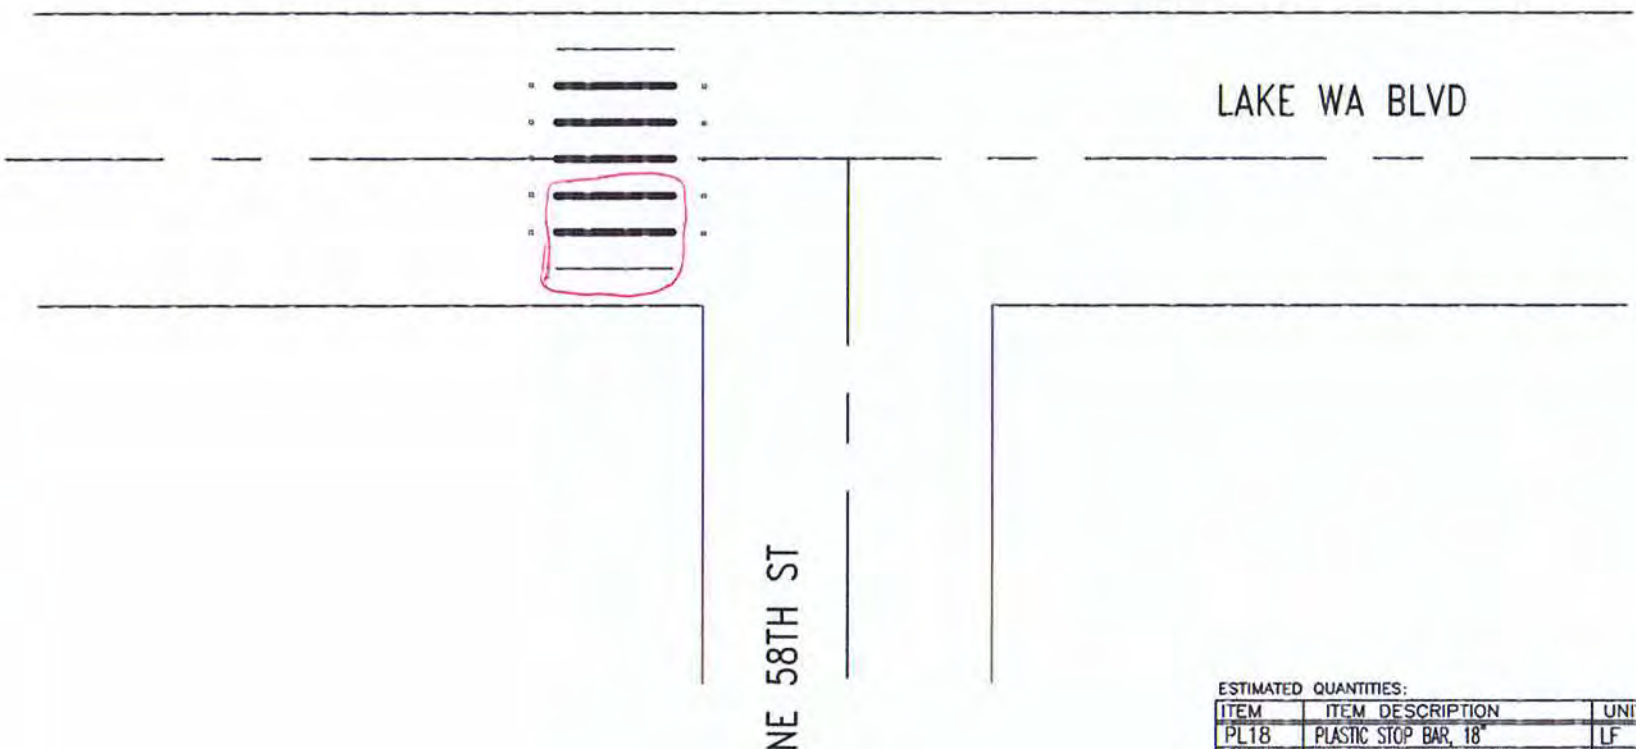

ESTIMATED QUANTITIES:

ITEM	ITEM DESCRIPTION	UNIT	INVENTORY	REPAIR QTY
PL18	PLASTIC STOP BAR, 18"	LF		
PLXW	PLASTIC CROSSWALK STRIPE	SF	120	50
PLARW	PLASTIC TRAFFIC ARROW	EA		
PLLTR	PLASTIC TRAFFIC LETTER, 8 FT HIGH	EA		
PLRR	PLASTIC RAILROAD SYMBOL	EA		
RPLSYM	REMOVE PL. ARROW, LETTER, SYMBOL	EA		
RRPM	REMOVE RPM	EA		
RPLXW	REMOVE PLASTIC STRIPE	SF		
	RAISED PAVEMENT MARKER TYPE 2	EA	10	

CITY OF KIRKLAND
DEPARTMENT OF PUBLIC WORKS
123 FIFTH AVENUE KIRKLAND, WA 98033
(425) 587-3800 www.kirklandwa.gov

G. HORTILLOSA 10/2011
DESIGNED BY: DATE

J.JENNINGS 10/2011
DRAWN BY: DATE

CHECKED BY: DATE

2020 PAVEMENT MARKING PROGRAM

STREET: LAKE WA BLVD

CROSS STREET: NE 58TH ST

SEGMENT:

SCALE: N.T.S.

FILENAME: Page 13-15

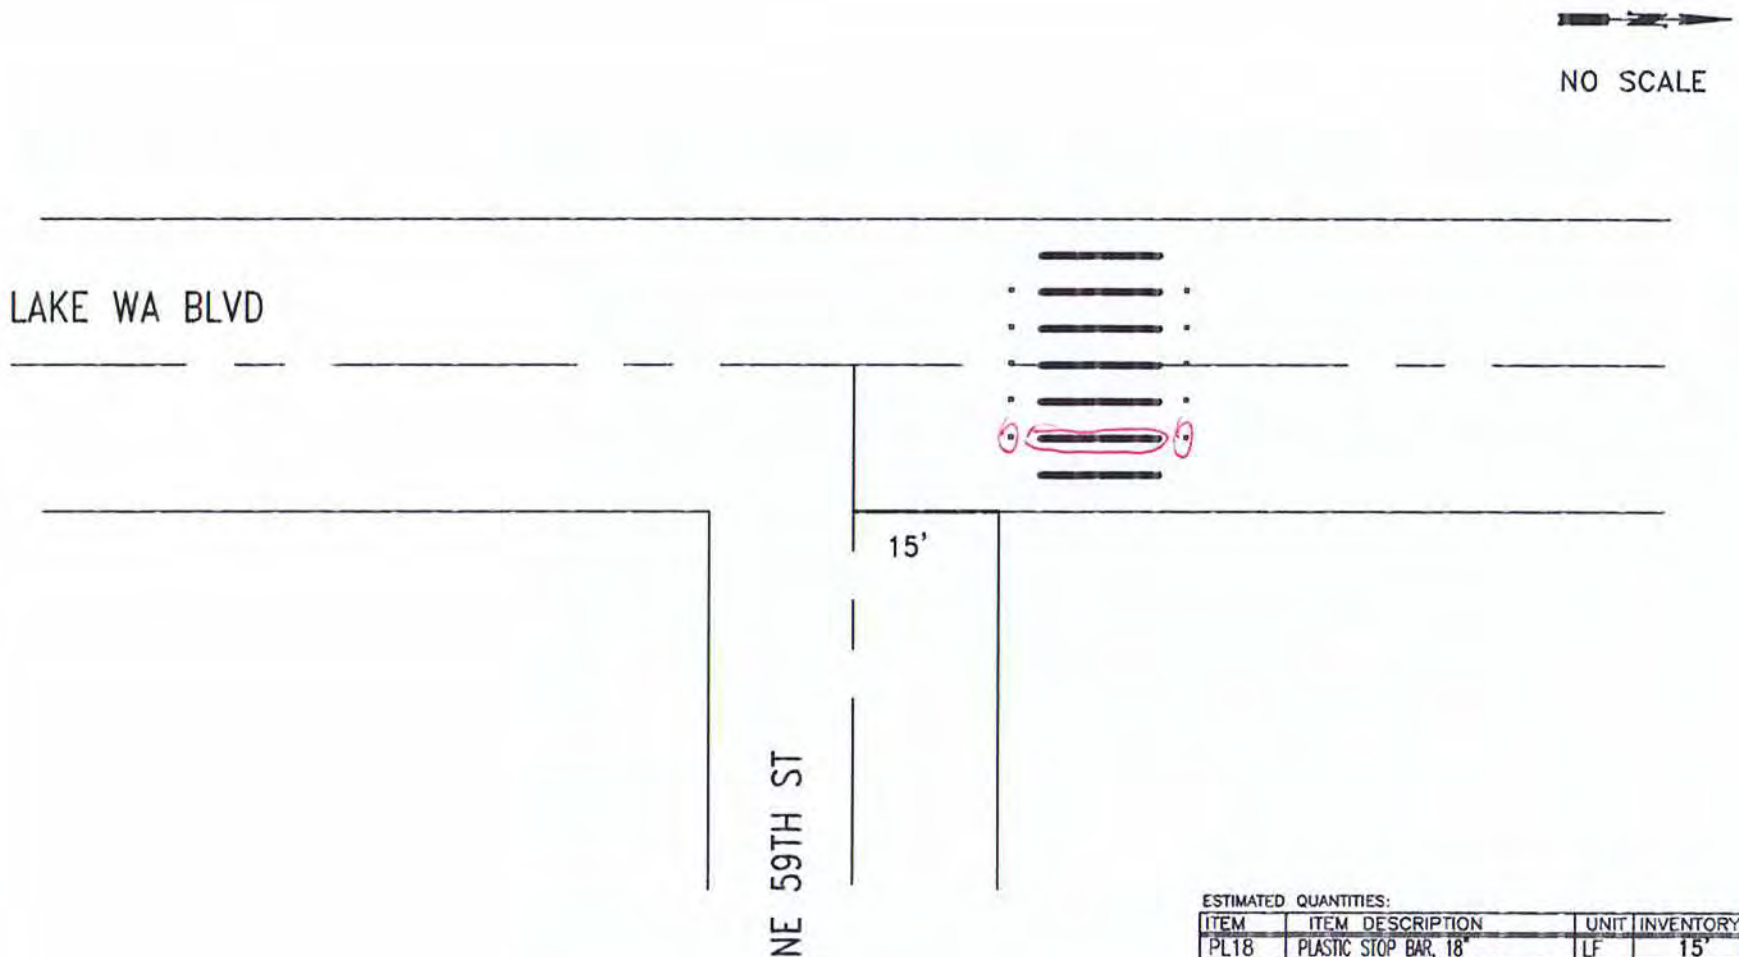

ESTIMATED QUANTITIES:

ITEM	ITEM DESCRIPTION	UNIT	INVENTORY	REPAIR QTY
PL18	PLASTIC STOP BAR, 18"	LF	15'	
PLXW	PLASTIC CROSSWALK STRIPE	SF	140	20
PLARW	PLASTIC TRAFFIC ARROW	EA		
PLLTR	PLASTIC TRAFFIC LETTER, 8 FT HIGH	EA		
PLRR	PLASTIC RAILROAD SYMBOL	EA		
RPLSYM	REMOVE PL. ARROW, LETTER, SYMBOL	EA		
RRPM	REMOVE RPM	EA		
RPLXW	REMOVE PLASTIC STRIPE	SF		
	RAISED PAVEMENT MARKER TYPE 2	EA	10	2

CITY OF KIRKLAND
DEPARTMENT OF PUBLIC WORKS
123 FIFTH AVENUE KIRKLAND, WA 98033
(425) 587-3800 www.kirklandwa.gov

G. HORTILLOSA 10/2011
DESIGNED BY: DATE

J.JENNINGS 10/2011
DRAWN BY: DATE

CHECKED BY: DATE

2020 PAVEMENT MARKING PROGRAM

STREET: LAKE WA BLVD

CROSS STREET: NE 59TH ST

SEGMENT:

SCALE: N.T.S.

FILENAME: Page 13-16

NO SCALE

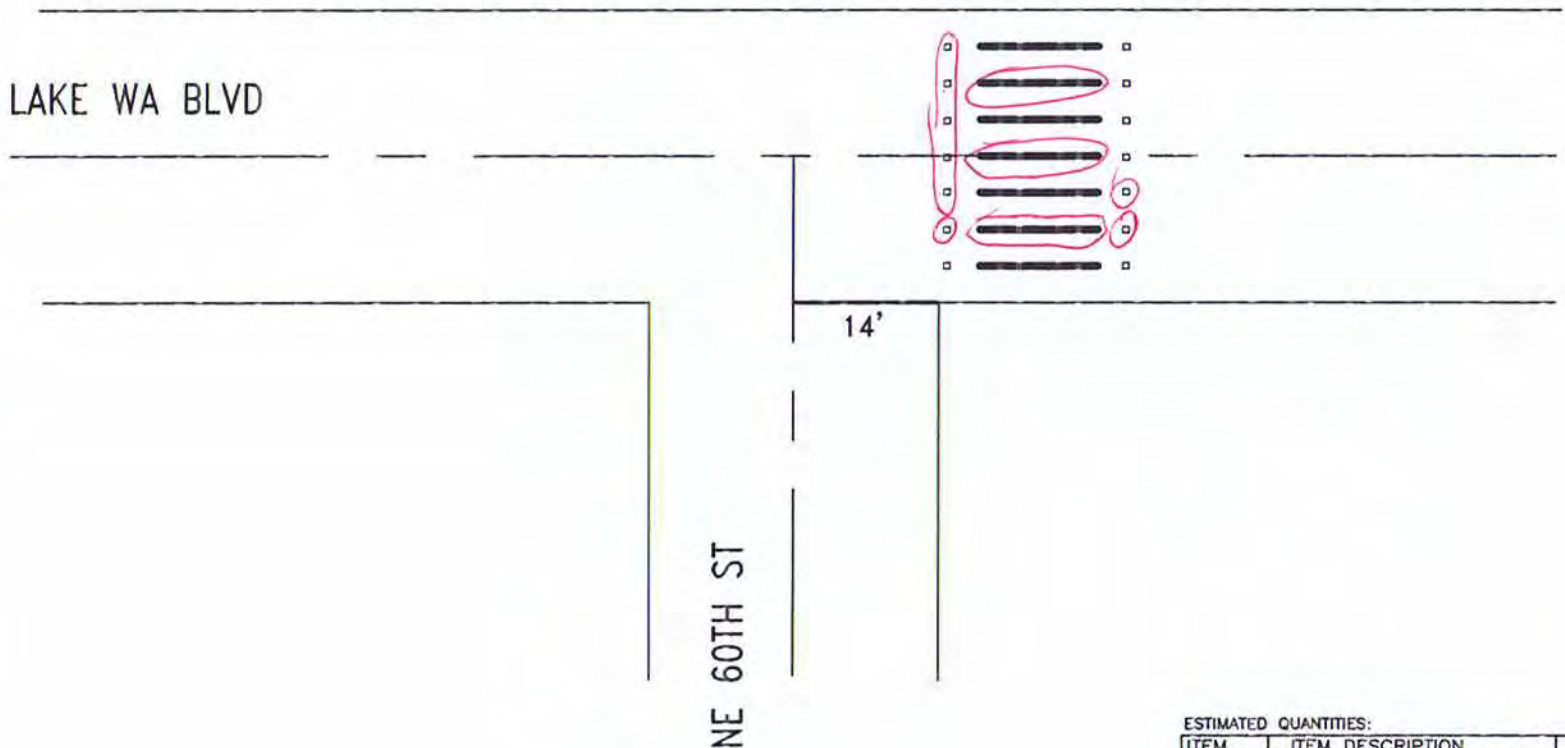

ESTIMATED QUANTITIES:

ITEM	ITEM DESCRIPTION	UNIT	INVENTORY	REPAIR QTY
PL18	PLASTIC STOP BAR, 18"	LF	14	
PLXW	PLASTIC CROSSWALK STRIPE	SF	140	60
PLARW	PLASTIC TRAFFIC ARROW	EA		
PLLTR	PLASTIC TRAFFIC LETTER, 8 FT HIGH	EA		
PLRR	PLASTIC RAILROAD SYMBOL	EA		
RPLSYM	REMOVE PL. ARROW, LETTER, SYMBOL	EA		
RRPM	REMOVE RPM	EA		3
RPLXW	REMOVE PLASTIC STRIPE	SF		10
	RAISED PAVEMENT MARKER TYPE 2	EA	14	8

CITY OF KIRKLAND
DEPARTMENT OF PUBLIC WORKS
123 FIFTH AVENUE KIRKLAND, WA 98033
(425) 587-3800 www.kirklandwa.gov

D.GRILLEY 1/2000
DESIGNED BY: DATE

J.JENNINGS 1/2000
DRAWN BY: DATE

CHECKED BY: DATE

2020 PAVEMENT MARKING PROGRAM

STREET: LAKE WA BLVD

CROSS STREET: NE 60TH ST

SEGMENT:

SCALE: N.T.S.

FILENAME: Page 13-17

NO SCALE

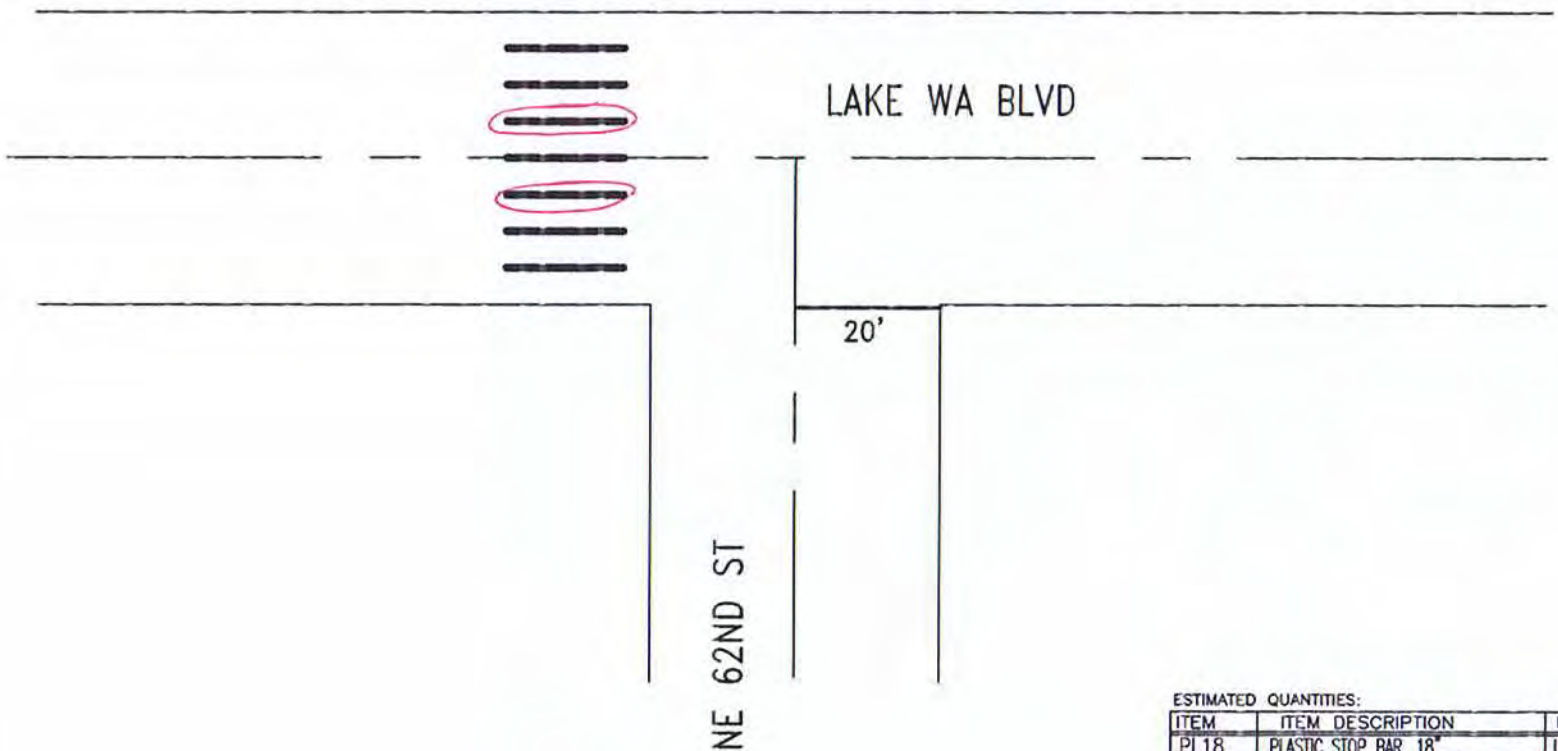

ESTIMATED QUANTITIES:

ITEM	ITEM DESCRIPTION	UNIT	INVENTORY	REPAIR QTY
PL18	PLASTIC STOP BAR, 18"	LF	20	
PLXW	PLASTIC CROSSWALK STRIPE	SF	140	40
PLARW	PLASTIC TRAFFIC ARROW	EA		
PLLTR	PLASTIC TRAFFIC LETTER, 8 FT HIGH	EA		
PLRR	PLASTIC RAILROAD SYMBOL	EA		
RPLSYM	REMOVE PL. ARROW, LETTER, SYMBOL	EA		
RRPM	REMOVE RPM	EA		
RPLXW	REMOVE PLASTIC STRIPE	SF		

CITY OF KIRKLAND
DEPARTMENT OF PUBLIC WORKS
123 FIFTH AVENUE KIRKLAND, WA 98033

D.GRILLEY 1/2000
DESIGNED BY: DATE

J.JENNINGS 1/2000
DRAWN BY: DATE

CHECKED BY: DATE

20__ PAVEMENT MARKING PROGRAM

STREET: LAKE WA BLVD

CROSS STREET: NE 62ND ST

SEGMENT:

SCALE: N.T.S.

FILENAME:

NO SCALE

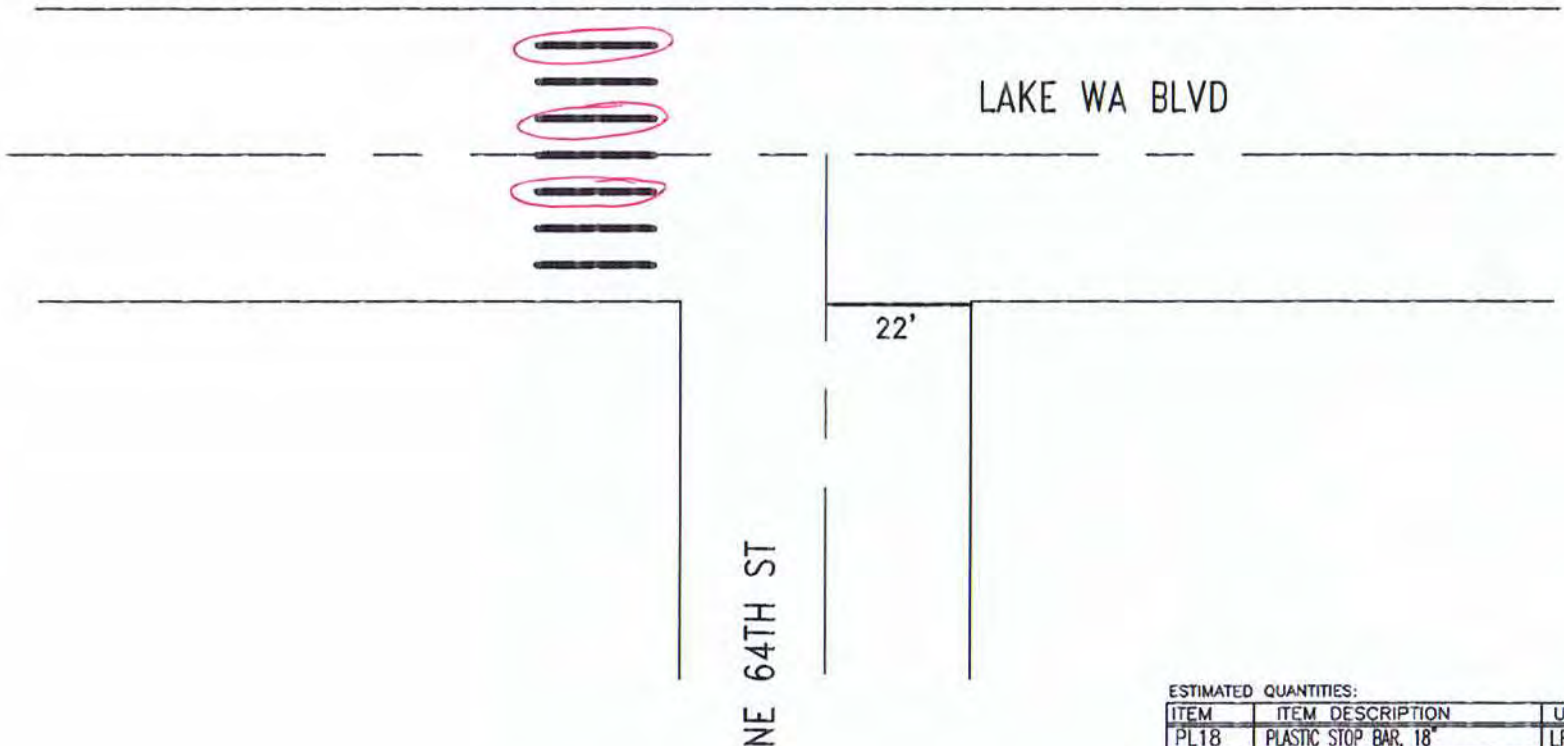

ESTIMATED QUANTITIES:

ITEM	ITEM DESCRIPTION	UNIT	INVENTORY	REPAIR QTY
PL18	PLASTIC STOP BAR, 18"	LF	22	
PLXW	PLASTIC CROSSWALK STRIPE	SF	140	60
PLARW	PLASTIC TRAFFIC ARROW	EA		
PLLTR	PLASTIC TRAFFIC LETTER, 8 FT HIGH	EA		
PLRR	PLASTIC RAILROAD SYMBOL	EA		
RPLSYM	REMOVE PL. ARROW, LETTER, SYMBOL	EA		
RRPM	REMOVE RPM	EA		
RPLXW	REMOVE PLASTIC STRIPE	SF		30

CITY OF KIRKLAND
DEPARTMENT OF PUBLIC WORKS
123 FIFTH AVENUE KIRKLAND, WA 98033
(425) 587-3800 www.kirklandwa.gov

D.GRILLEY 1/2000
DESIGNED BY: DATE

J.JENNINGS 1/2000
DRAWN BY: DATE

CHECKED BY: DATE

2022 PAVEMENT MARKING PROGRAM

STREET: LAKE WA BLVD

CROSS STREET: NE 64TH ST

SEGMENT:

SCALE: N.T.S.

FILENAME:

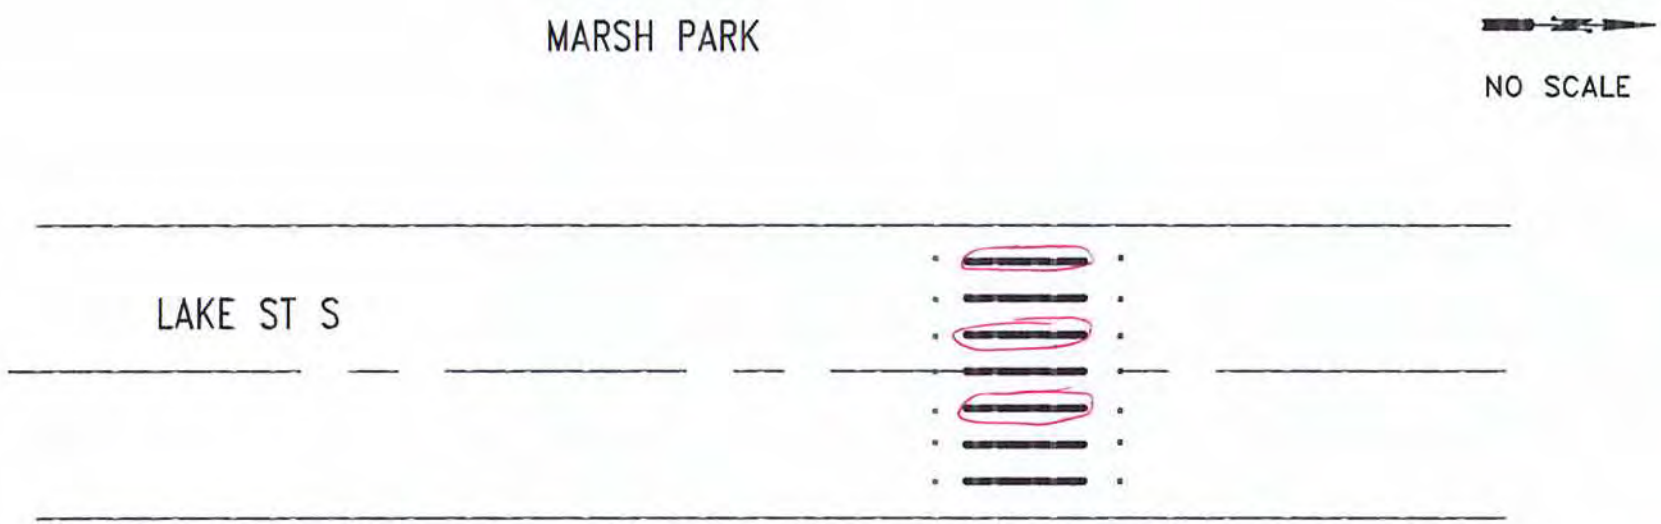

ESTIMATED QUANTITIES:

ITEM	ITEM DESCRIPTION	UNIT	INVENTORY	REPAIR QTY
PL18	PLASTIC STOP BAR, 18"	LF		
PLXW	PLASTIC CROSSWALK STRIPE	SF	140	40
PLARW	PLASTIC TRAFFIC ARROW	EA		
PLLTR	PLASTIC TRAFFIC LETTER, 8 FT HIGH	EA		
PLRR	PLASTIC RAILROAD SYMBOL	EA		
RPLSYM	REMOVE PL. ARROW, LETTER, SYMBOL	EA		
RRPM	REMOVE RPM	EA		
RPLXW	REMOVE PLASTIC STRIPE	SF		
	RAISED PAVEMENT MARKER TYPE 2	EA	14	

CITY OF KIRKLAND
DEPARTMENT OF PUBLIC WORKS
123 FIFTH AVENUE KIRKLAND, WA 98033
(425) 587-3800 www.kirklandwa.gov

G. HORTILLOSA 10/2006
DESIGNED BY: DATE

J.JENNINGS 10/2006
DRAWN BY: DATE

CHECKED BY: DATE

2020 PAVEMENT MARKING PROGRAM

STREET: LAKE ST S

CROSS STREET: 67TH BLOCK

SEGMENT:

SCALE: N.T.S.

FILENAME:

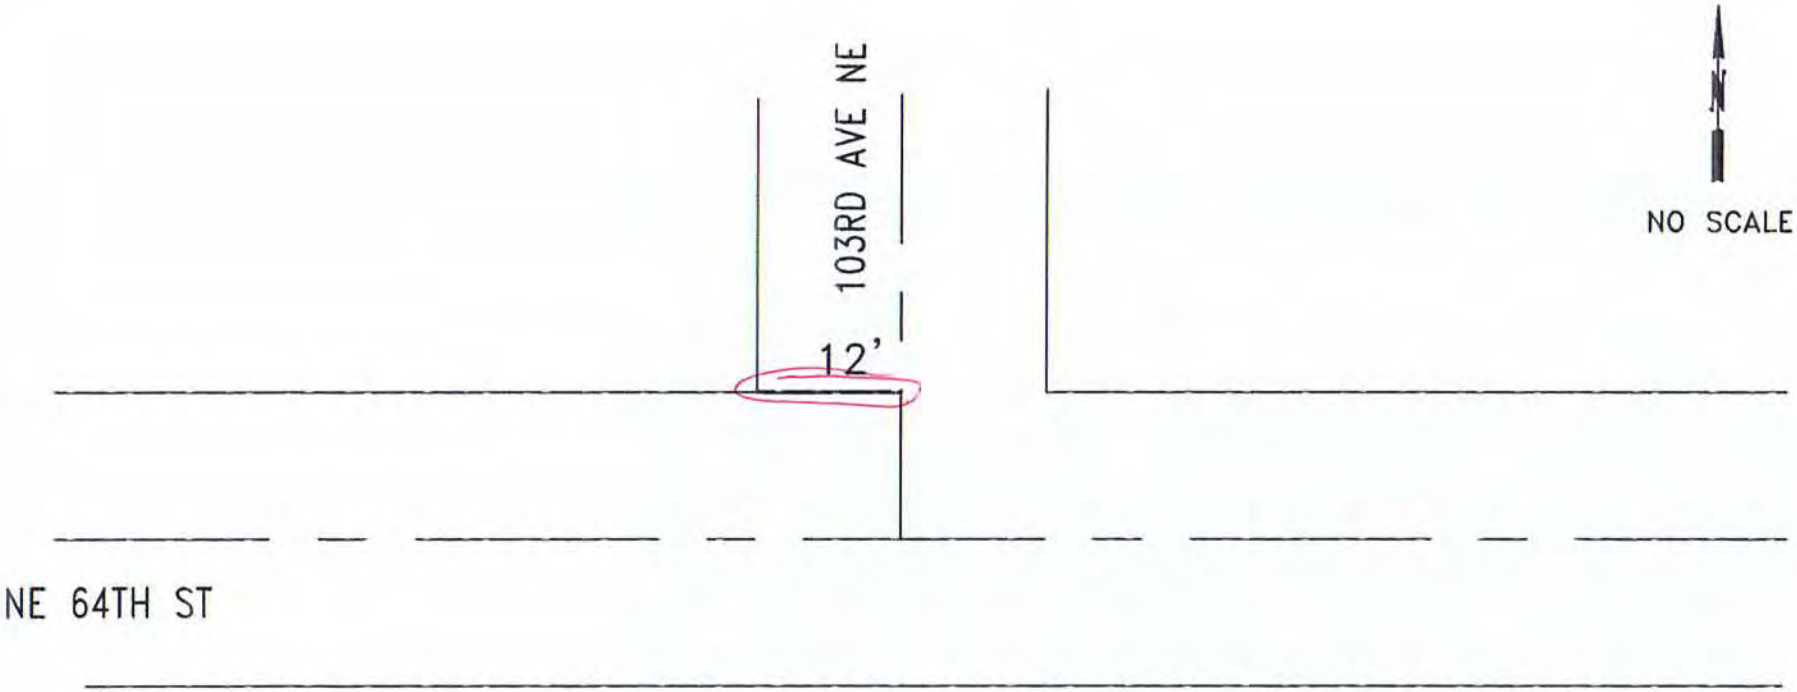

ESTIMATED QUANTITIES:

ITEM	ITEM DESCRIPTION	UNIT	INVENTORY	REPAIR QTY
PL18	PLASTIC STOP BAR, 18"	LF	12	12
PLXW	PLASTIC CROSSWALK STRIPE	SF		
PLARW	PLASTIC TRAFFIC ARROW	EA		
PLLTR	PLASTIC TRAFFIC LETTER, 8 FT HIGH	EA		
PLRR	PLASTIC RAILROAD SYMBOL	EA		
RPLSYM	REMOVE PL. ARROW, LETTER, SYMBOL	EA		
RRPM	REMOVE RPM	EA		
RPLXW	REMOVE PLASTIC STRIPE	SF		

CITY OF KIRKLAND
DEPARTMENT OF PUBLIC WORKS
123 FIFTH AVENUE KIRKLAND, WA 98033
(425) 587-3800 www.kirklandwa.gov

D.GRILLEY 1/2000
DESIGNED BY: DATE

J.JENNINGS 1/2000
DRAWN BY: DATE

CHECKED BY: DATE

2022 PAVEMENT MARKING PROGRAM

STREET: 103RD AVE NE

CROSS STREET: NE 64TH ST

SEGMENT:

SCALE: N.T.S.

FILENAME: Page 13-21

CENTRAL HOUGHTON INTERSECTION PLANS

CITY OF KIRKLAND
DEPARTMENT OF PUBLIC WORKS
123 FIFTH AVENUE KIRKLAND, WA 98033
(425) 587-3800 www.kirklandwa.gov

S GONSAR	1/2020	DESIGNED BY: DATE
J.JENNINGS	1/2020	DRAWN BY: DATE
		CHECKED BY: DATE

2020 PAVEMENT MARKING PROGRAM

STREET:

CROSS STREET:

SEGMENT:

SCALE: N.T.S.

FILENAME: 14-0

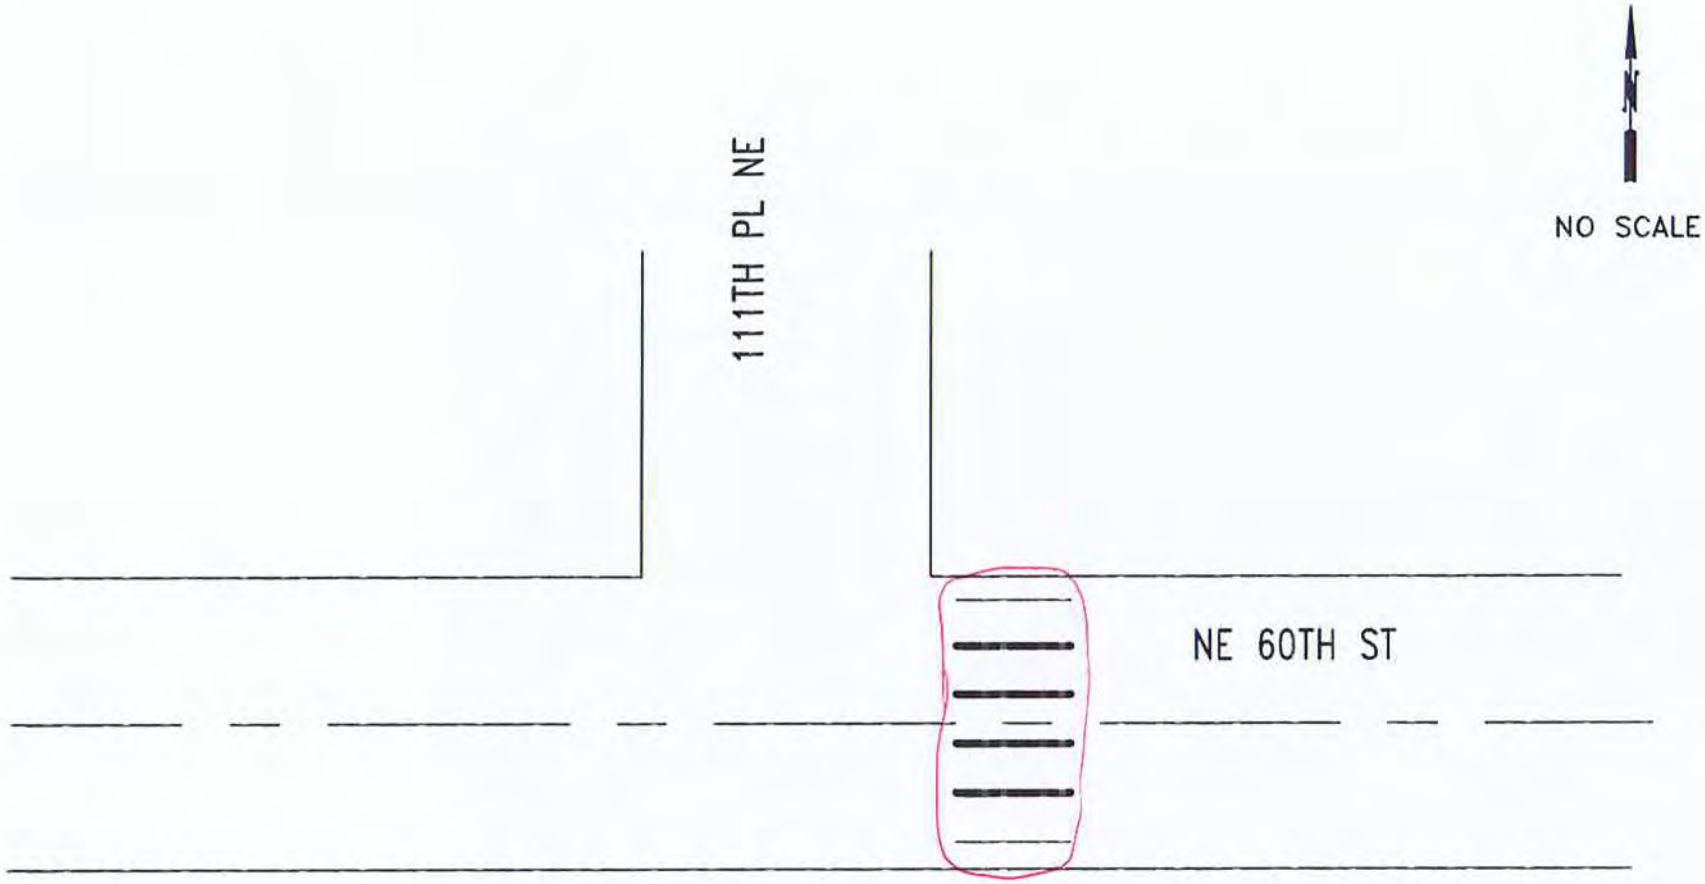

ESTIMATED QUANTITIES:

ITEM	ITEM DESCRIPTION	UNIT	INVENTORY	REPAIR QTY
PL18	PLASTIC STOP BAR, 18"	LF		
PLXW	PLASTIC CROSSWALK STRIPE	SF	100	100
PLARW	PLASTIC TRAFFIC ARROW	EA		
PLLTR	PLASTIC TRAFFIC LETTER, 8 FT HIGH	EA		
PLRR	PLASTIC RAILROAD SYMBOL	EA		
RPLSYM	REMOVE PL. ARROW, LETTER, SYMBOL	EA		
RRPM	REMOVE RPM	EA		
RPLXW	REMOVE PLASTIC STRIPE	SF		

CITY OF KIRKLAND
DEPARTMENT OF PUBLIC WORKS
123 FIFTH AVENUE KIRKLAND, WA 98033
(425) 587-3800 www.kirklandwa.gov

D.GRILLEY 1/2000
DESIGNED BY: DATE

J.JENNINGS 11/2000
DRAWN BY: DATE

CHECKED BY: DATE

2020 PAVEMENT MARKING PROGRAM

STREET: NE 60TH ST

CROSS STREET: 111TH PL NE

SEGMENT:

SCALE: N.T.S.

FILENAME: Page 14-1

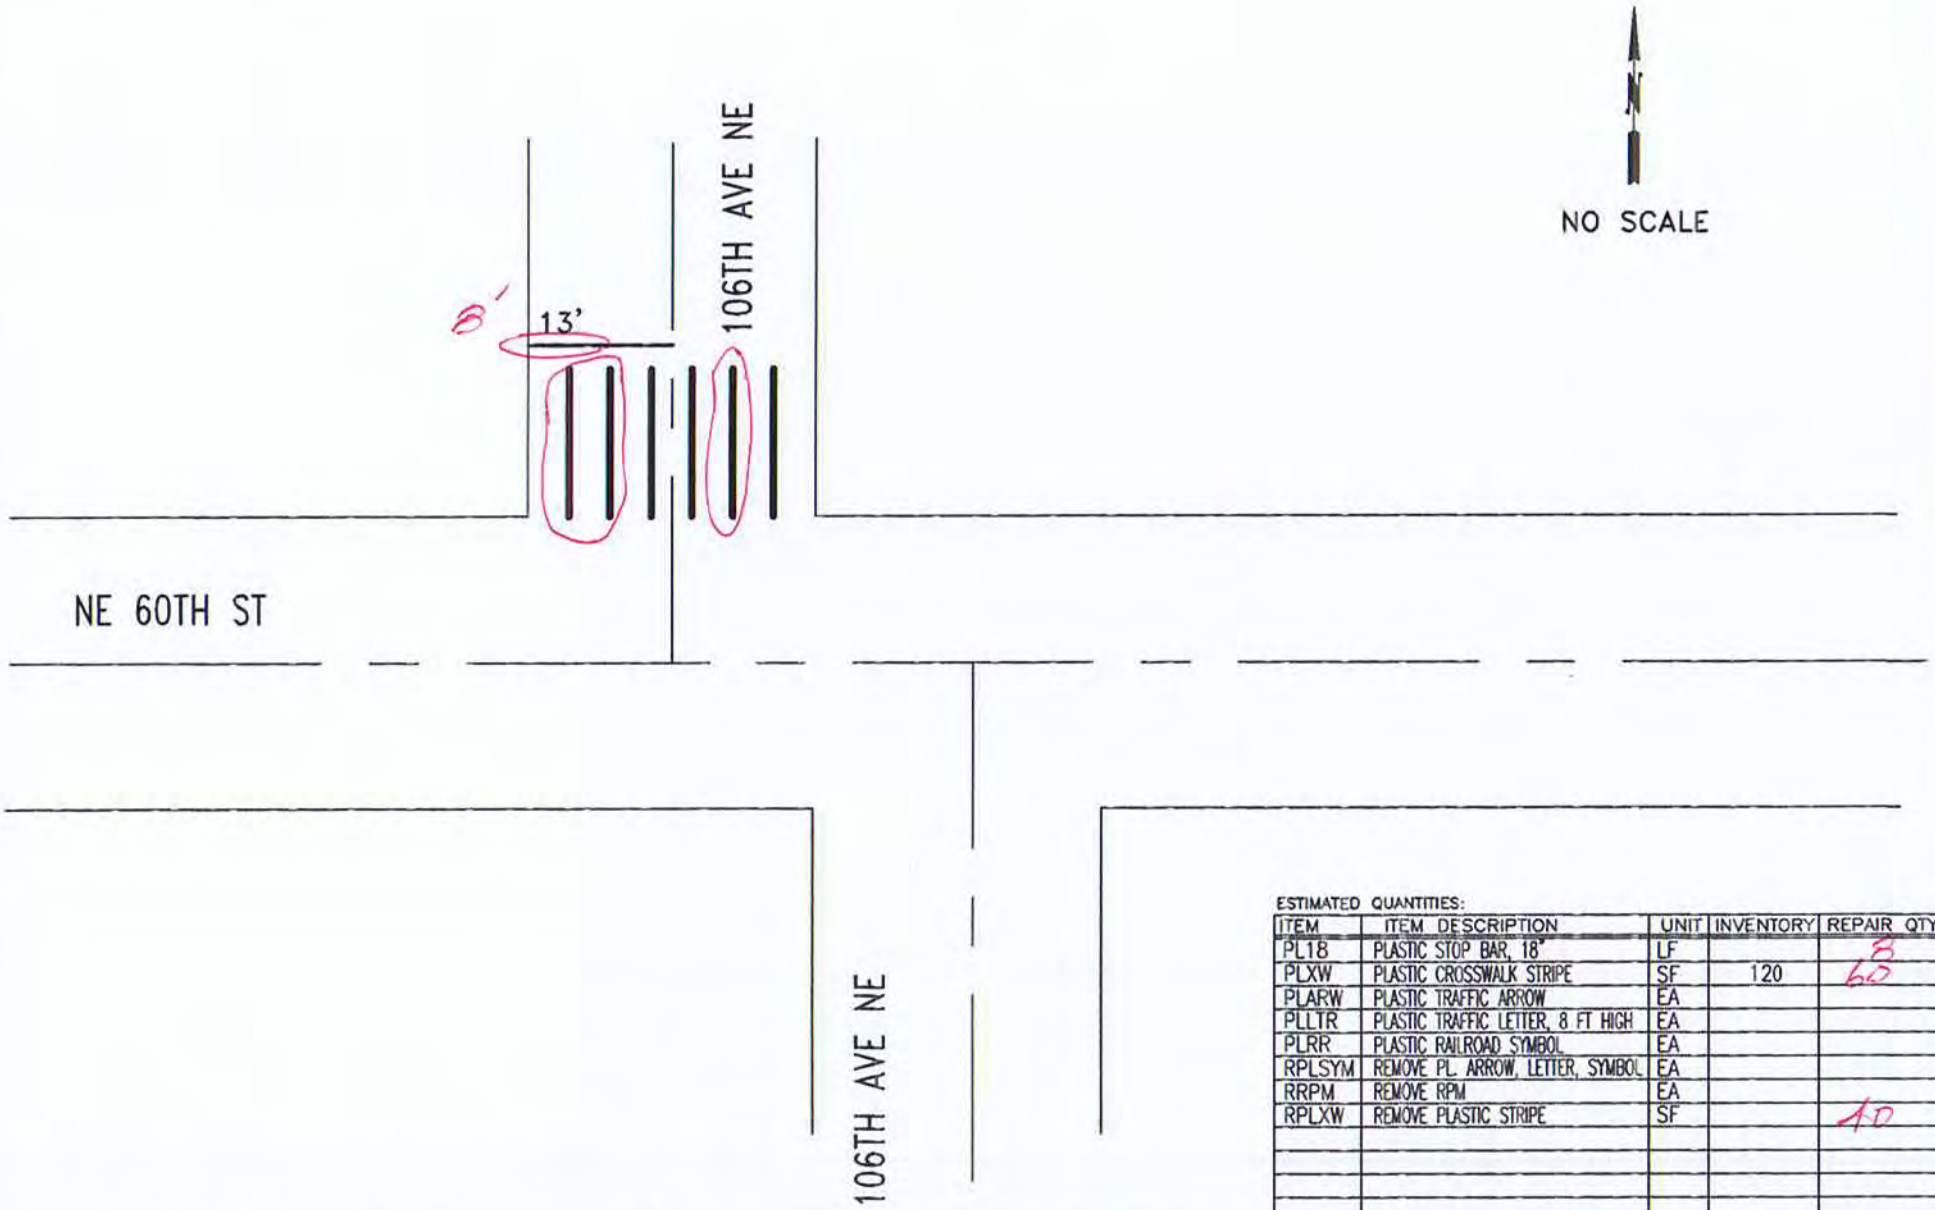

ESTIMATED QUANTITIES:

ITEM	ITEM DESCRIPTION	UNIT	INVENTORY	REPAIR QTY
PL18	PLASTIC STOP BAR, 18"	LF		8
PLXW	PLASTIC CROSSWALK STRIPE	SF	120	60
PLARW	PLASTIC TRAFFIC ARROW	EA		
PLLTR	PLASTIC TRAFFIC LETTER, 8 FT HIGH	EA		
PLRR	PLASTIC RAILROAD SYMBOL	EA		
RPLSYM	REMOVE PL. ARROW, LETTER, SYMBOL	EA		
RRPM	REMOVE RPM	EA		
RPLXW	REMOVE PLASTIC STRIPE	SF		10

CITY OF KIRKLAND WASHINGTON

CITY OF KIRKLAND
DEPARTMENT OF PUBLIC WORKS
123 FIFTH AVENUE KIRKLAND, WA 98033
(425) 587-3800 www.kirklandwa.gov

D.GRILLEY 1/2000
DESIGNED BY: DATE

J.JENNINGS 5/2001
DRAWN BY: DATE

CHECKED BY: DATE

2022 PAVEMENT MARKING PROGRAM

STREET: NE 60TH ST

CROSS STREET: 106TH AVE NE

SEGMENT:

SCALE: N.T.S.

FILENAME: Page 14-3

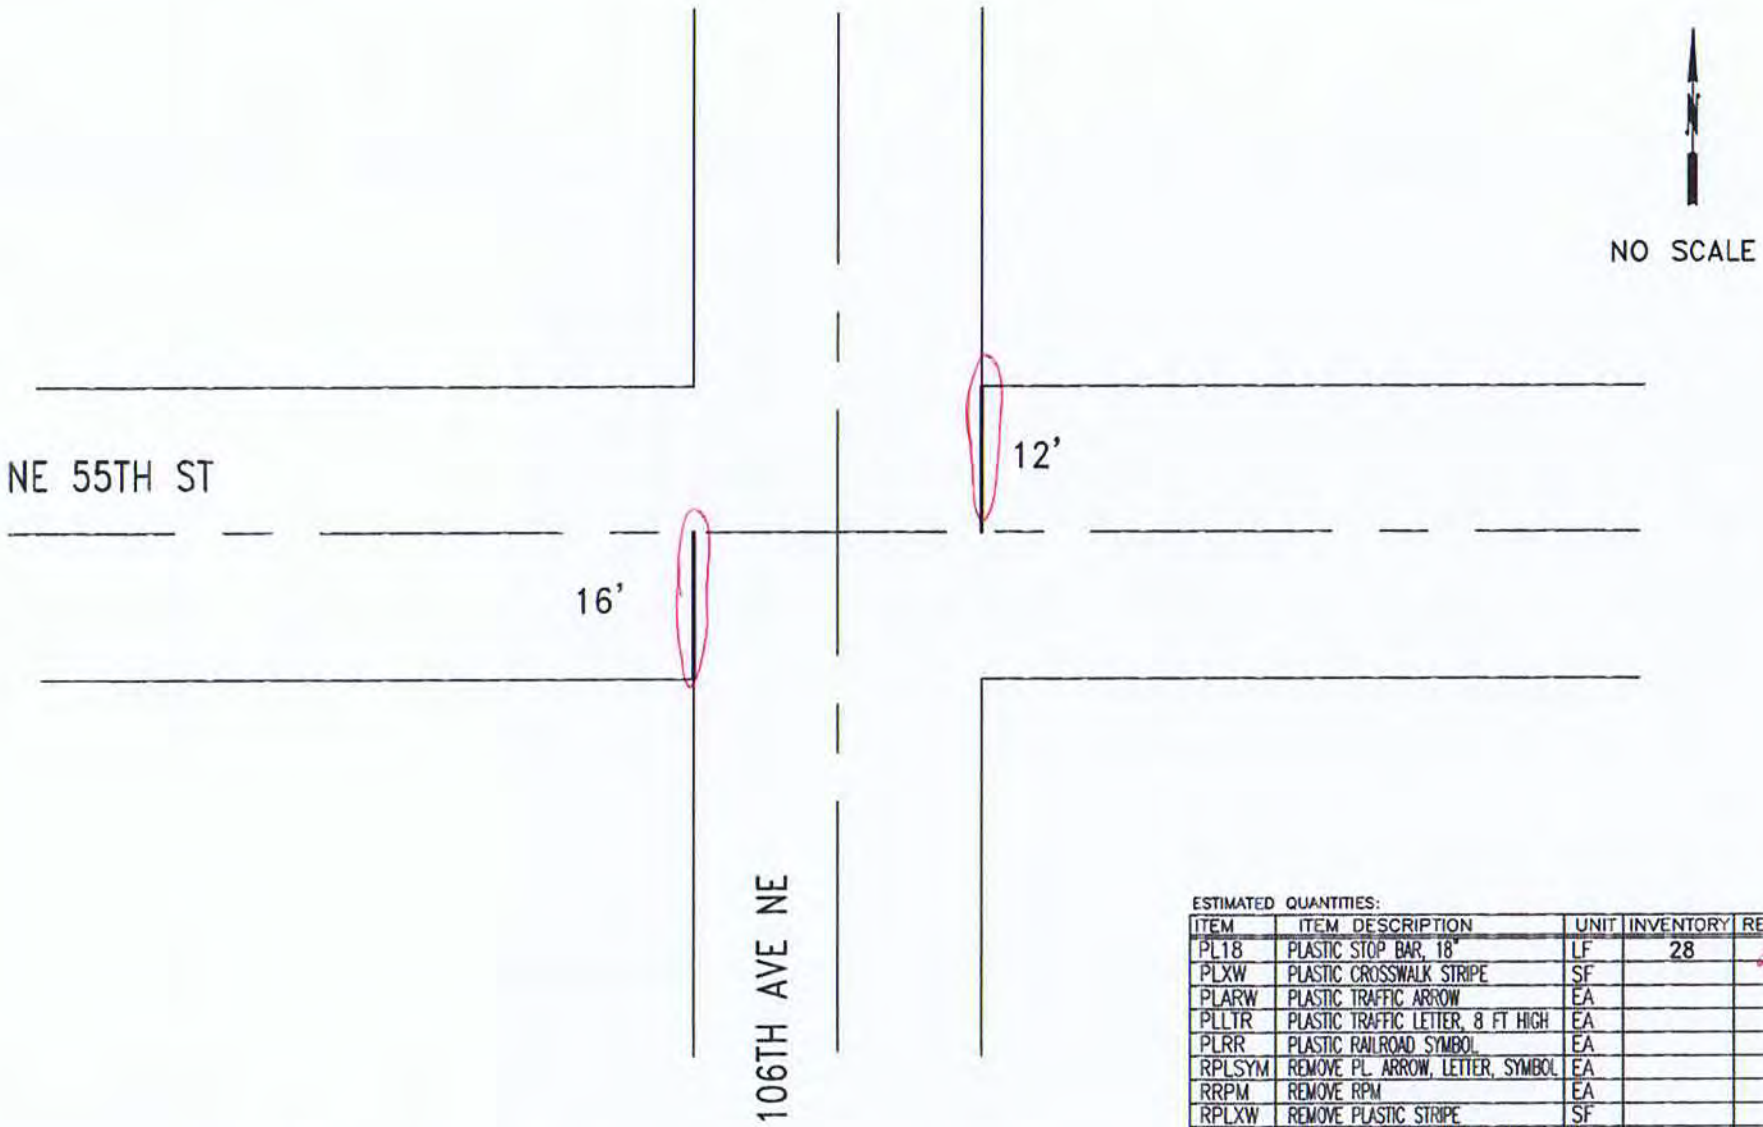

ESTIMATED QUANTITIES:

ITEM	ITEM DESCRIPTION	UNIT	INVENTORY	REPAIR QTY
PL18	PLASTIC STOP BAR, 18"	LF	28	28
PLXW	PLASTIC CROSSWALK STRIPE	SF		
PLARW	PLASTIC TRAFFIC ARROW	EA		
PLLTR	PLASTIC TRAFFIC LETTER, 8 FT HIGH	EA		
PLRR	PLASTIC RAILROAD SYMBOL	EA		
RPLSYM	REMOVE PL. ARROW, LETTER, SYMBOL	EA		
RRPM	REMOVE RPM	EA		
RPLXW	REMOVE PLASTIC STRIPE	SF		
	PAINT STRIPE, 12" TRANSVERSE	LF		
	PAINTED TRAFFIC LETTER, 8'	EA		

CITY OF KIRKLAND
DEPARTMENT OF PUBLIC WORKS
123 FIFTH AVENUE KIRKLAND, WA 98033
(425) 587-3800 www.kirklandwa.gov

R. STEITZER 10/2003
DESIGNED BY: DATE

J.JENNINGS 2/2004
DRAWN BY: DATE

CHECKED BY: DATE

2020 PAVEMENT MARKING PROGRAM

STREET: NE 55TH ST

CROSS STREET: 106TH AVE NE

SEGMENT:

SCALE: N.T.S.

FILENAME: Page 14-4

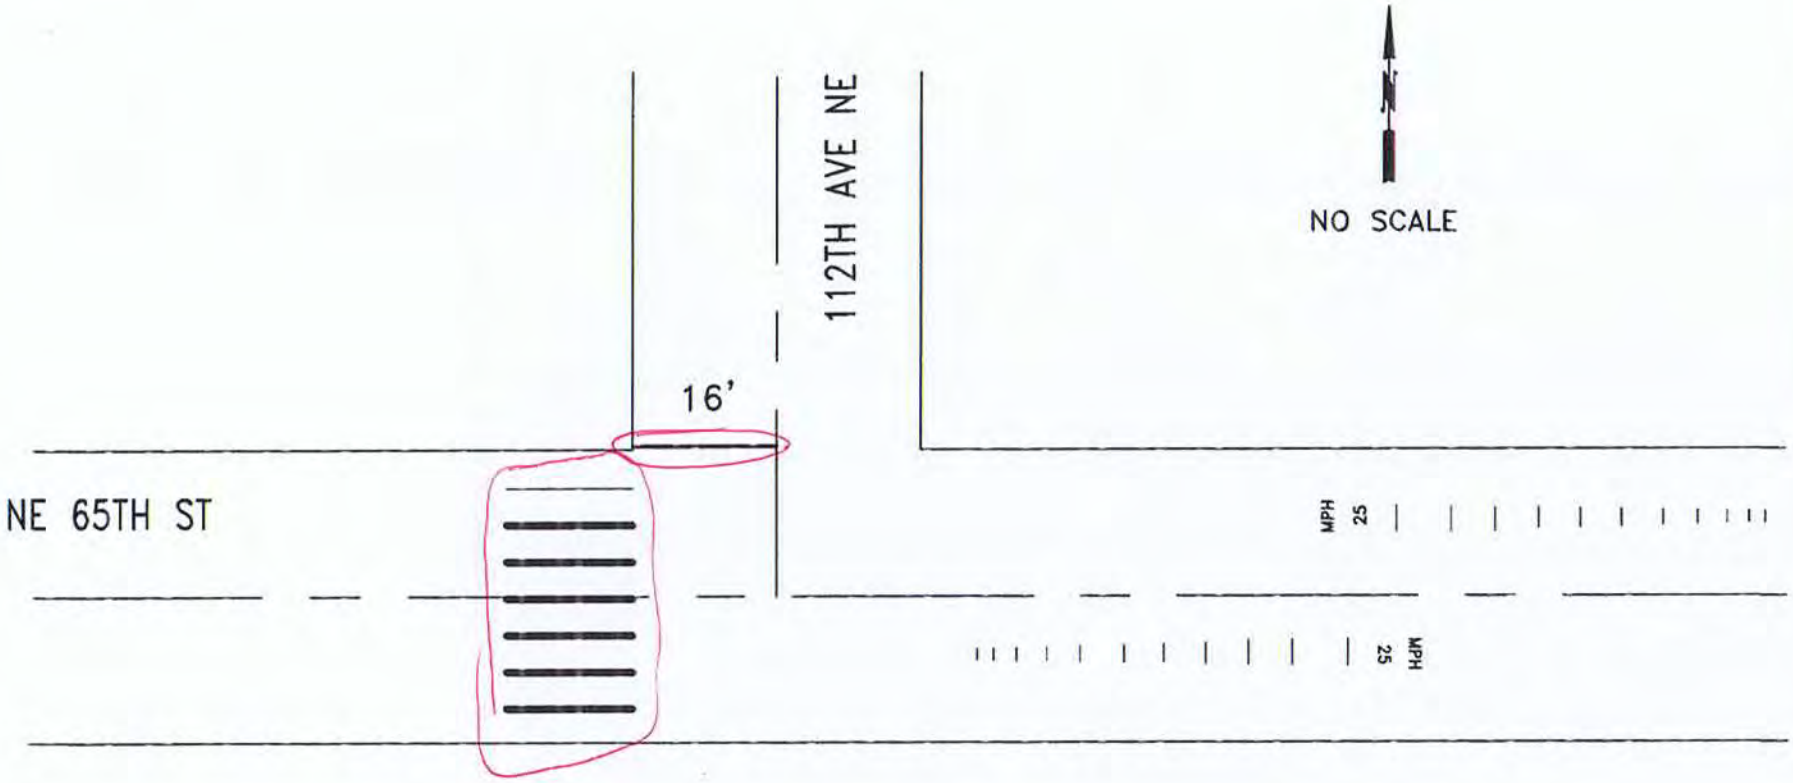

ESTIMATED QUANTITIES:

ITEM	ITEM DESCRIPTION	UNIT	INVENTORY	REPAIR QTY
PL18	PLASTIC STOP BAR, 18"	LF	24	
PLXW	PLASTIC CROSSWALK STRIPE	SF	130	130
PLARW	PLASTIC TRAFFIC ARROW	EA		
PLLTR	PLASTIC TRAFFIC LETTER, 8 FT HIGH	EA		
PLRR	PLASTIC RAILROAD SYMBOL	EA		
RPLSYM	REMOVE PL. ARROW, LETTER, SYMBOL	EA	10	
RRPM	REMOVE RPM	EA		
RPLXW	REMOVE PLASTIC STRIPE	SF		130
	PLASTIC SPEED LEGEND BARS		24	

CITY OF KIRKLAND
DEPARTMENT OF PUBLIC WORKS
123 FIFTH AVENUE KIRKLAND, WA 98033
(425) 587-3800 www.kirklandwa.gov

G. HORTILLOSA 10/2011
DESIGNED BY: DATE

J.JENNINGS 10/2011
DRAWN BY: DATE

CHECKED BY: DATE

2020 PAVEMENT MARKING PROGRAM

STREET: NE 65TH ST

CROSS STREET: 112TH AVE NE

SEGMENT:

SCALE: N.T.S.

FILENAME: Page 14-5

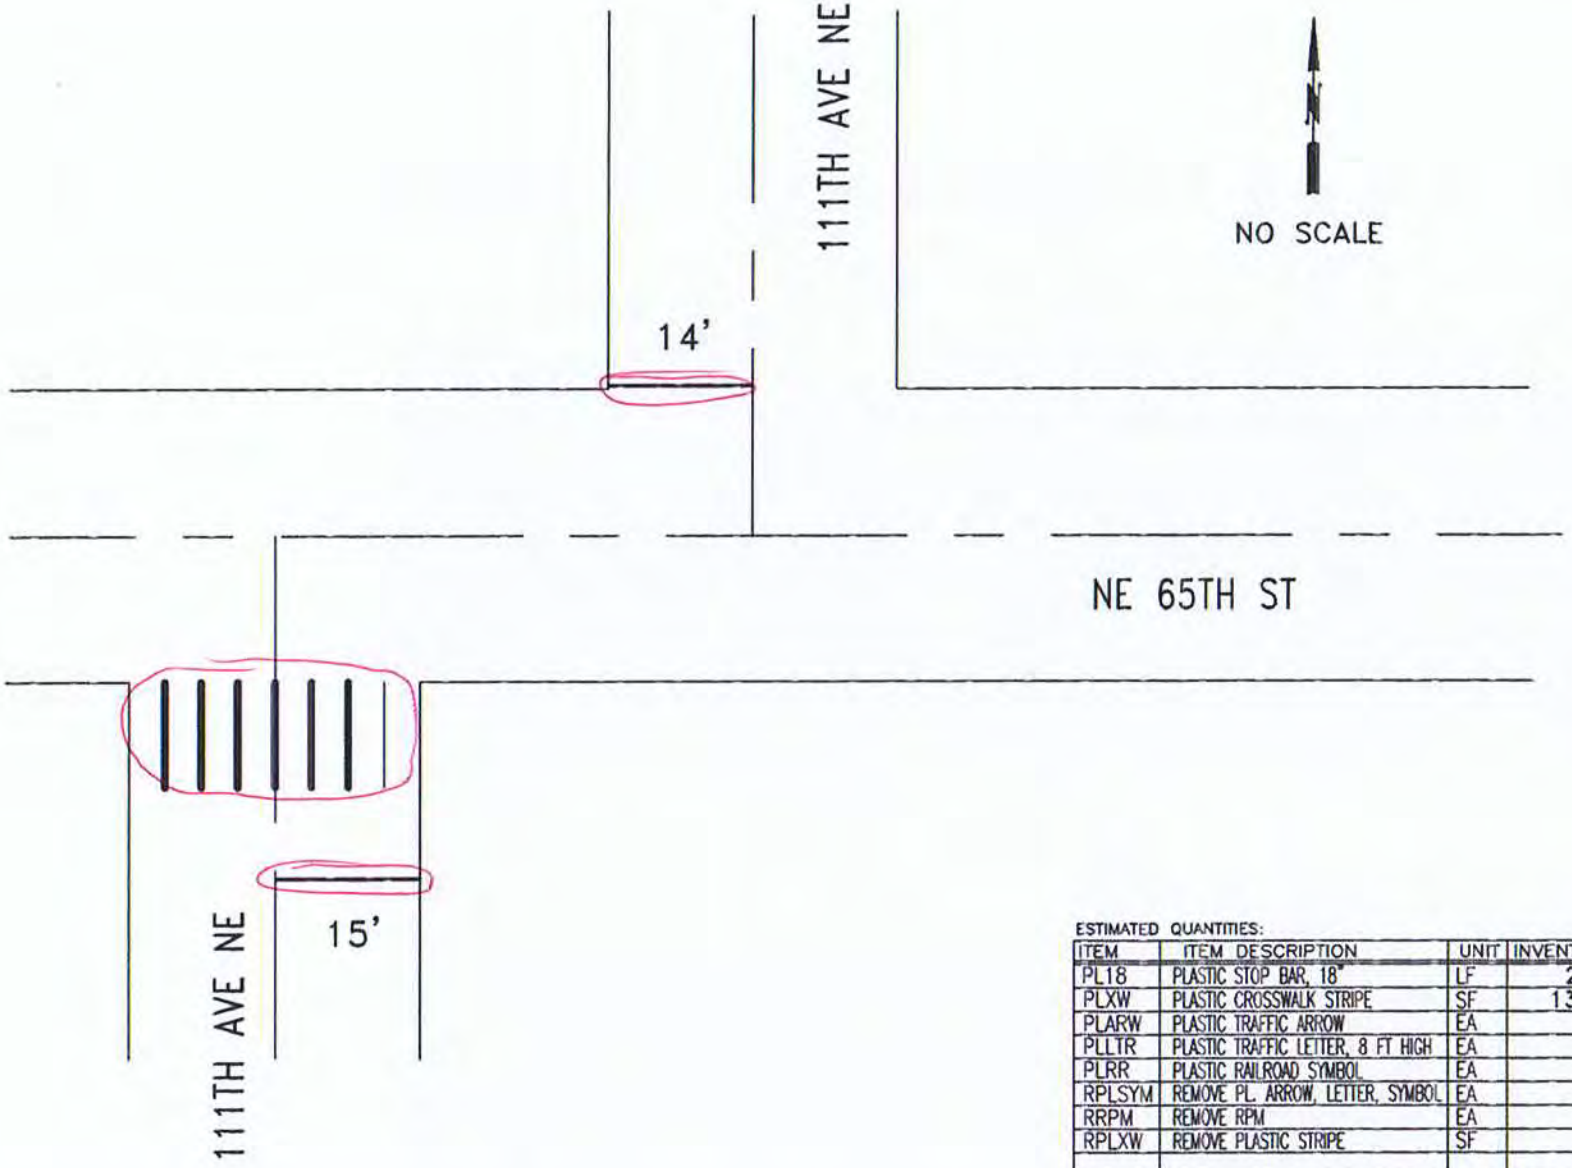

ESTIMATED QUANTITIES:

ITEM	ITEM DESCRIPTION	UNIT	INVENTORY	REPAIR QTY
PL18	PLASTIC STOP BAR, 18"	LF	29	
PLXW	PLASTIC CROSSWALK STRIPE	SF	130	135
PLARW	PLASTIC TRAFFIC ARROW	EA		
PLLTR	PLASTIC TRAFFIC LETTER, 8 FT HIGH	EA		
PLRR	PLASTIC RAILROAD SYMBOL	EA		
RPLSYM	REMOVE PL. ARROW, LETTER, SYMBOL	EA		
RRPM	REMOVE RPM	EA		
RPLXW	REMOVE PLASTIC STRIPE	SF		

CITY OF KIRKLAND
DEPARTMENT OF PUBLIC WORKS
123 FIFTH AVENUE KIRKLAND, WA 98033
(425) 587-3800 www.kirklandwa.gov

G. HORTILLOSA 10/2011
DESIGNED BY: DATE

J.JENNINGS 10/2011
DRAWN BY: DATE

CHECKED BY: DATE

2022 PAVEMENT MARKING PROGRAM

STREET: NE 65TH ST

CROSS STREET: 111TH AVE NE

SEGMENT:

SCALE: N.T.S.

FILENAME:

NO SCALE

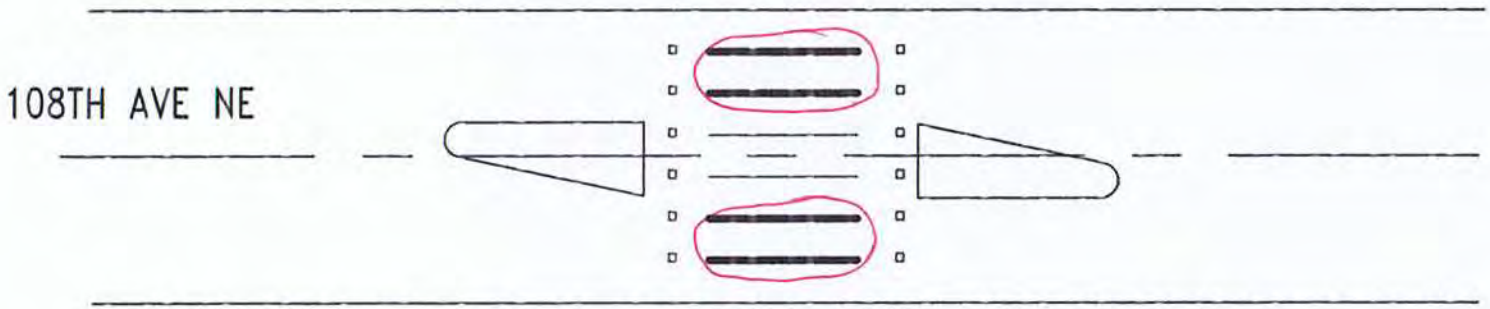

ESTIMATED QUANTITIES:

ITEM	ITEM DESCRIPTION	UNIT	INVENTORY	REPAIR QTY
PL18	PLASTIC STOP BAR, 18"	LF		
PLXW	PLASTIC CROSSWALK STRIPE	SF	80	80
PLARW	PLASTIC TRAFFIC ARROW	EA		
PLLTR	PLASTIC TRAFFIC LETTER, 8 FT HIGH	EA		
PLRR	PLASTIC RAILROAD SYMBOL	EA		
RPLSYM	REMOVE PL. ARROW, LETTER, SYMBOL	EA		
RRPM	REMOVE RPM	EA		
RPLXW	REMOVE PLASTIC STRIPE	SF		
RPM11	TYPE II RPM	EA	12	

CITY OF KIRKLAND WASHINGTON

CITY OF KIRKLAND
DEPARTMENT OF PUBLIC WORKS
123 FIFTH AVENUE KIRKLAND, WA 98033
(425) 587-3800 www.kirklandwa.gov

G. HORTILLOSA 10/2011
DESIGNED BY: DATE

J.JENNINGS 10/2011
DRAWN BY: DATE

CHECKED BY: DATE

20__ PAVEMENT MARKING PROGRAM

STREET: 108TH AVE NE

CROSS STREET: X-WALK N OF 62ND AVE NE

SEGMENT:

SCALE: N.T.S.

FILENAME: Page 14-7

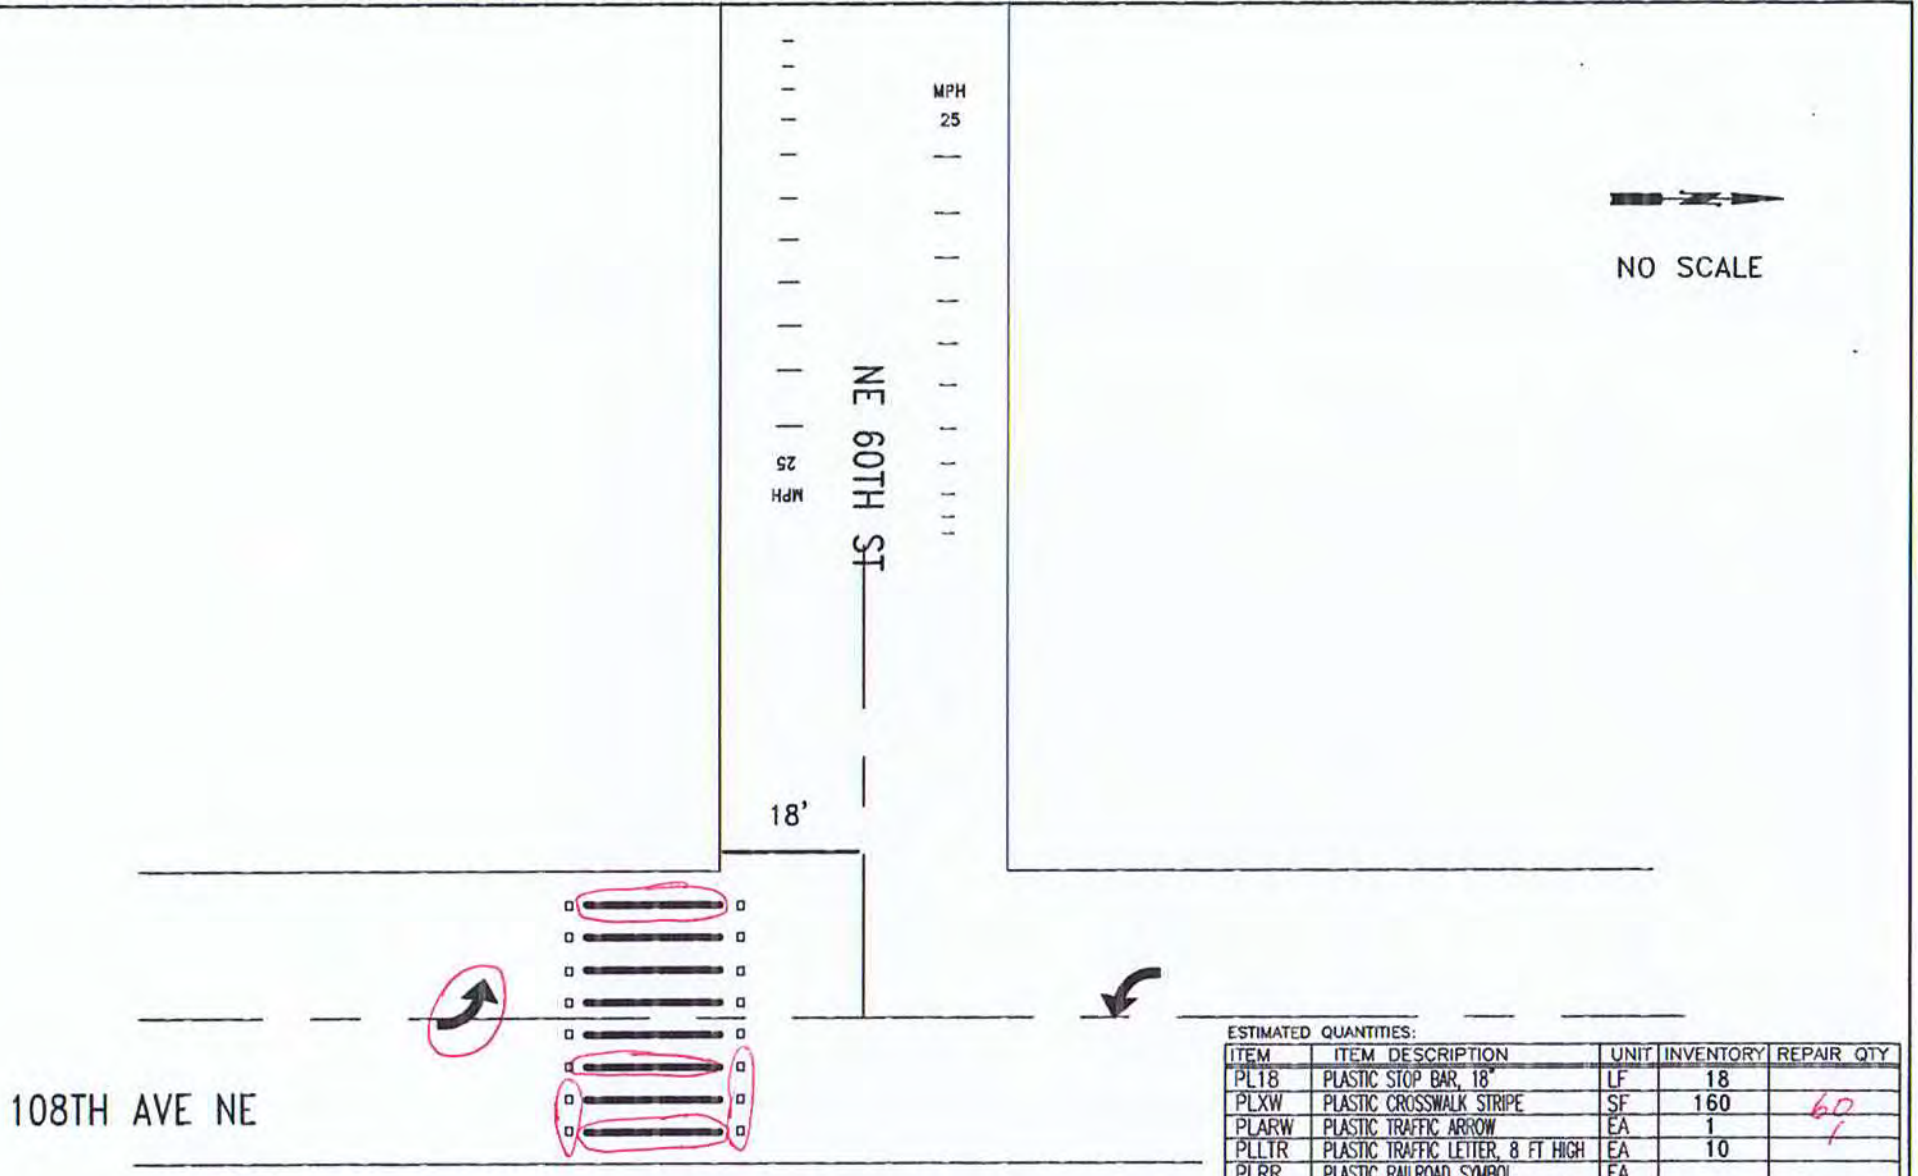

ESTIMATED QUANTITIES:

ITEM	ITEM DESCRIPTION	UNIT	INVENTORY	REPAIR QTY
PL18	PLASTIC STOP BAR, 18"	LF	18	
PLXW	PLASTIC CROSSWALK STRIPE	SF	160	60
PLARW	PLASTIC TRAFFIC ARROW	EA	1	1
PLLTR	PLASTIC TRAFFIC LETTER, 8 FT HIGH	EA	10	
PLRR	PLASTIC RAILROAD SYMBOL	EA		
RPLSYM	REMOVE PL. ARROW, LETTER, SYMBOL	EA		
RRPM	REMOVE RPM	EA		
RPLXW	REMOVE PLASTIC STRIPE	SF		40
	RAISED PAVEMENT MARKER TYPE 2	EA	16	8
	PLASTIC SPEED LEGEND BARS		124	

CITY OF KIRKLAND
DEPARTMENT OF PUBLIC WORKS
123 FIFTH AVENUE KIRKLAND, WA 98033
(425) 587-3800 www.kirklandwa.gov

D.GRILLEY 1/2000
DESIGNED BY: DATE

J.JENNINGS 2/2004
DRAWN BY: DATE

CHECKED BY: DATE

20~~20~~ PAVEMENT MARKING PROGRAM

STREET: 108TH AVE NE

CROSS STREET: NE 60TH ST

SEGMENT:

SCALE: N.T.S.

FILENAME: Page 14-8

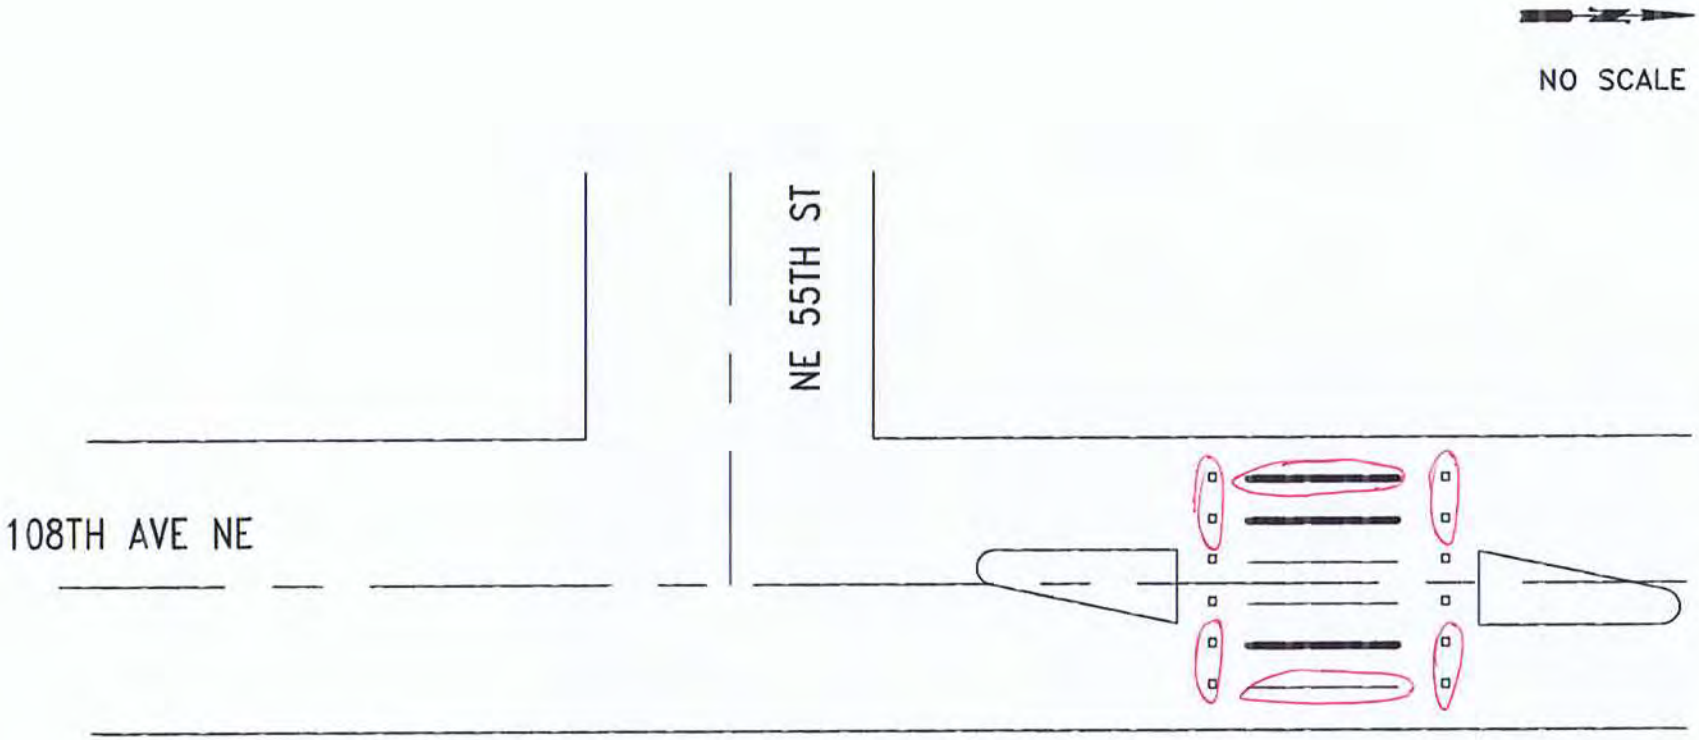

ESTIMATED QUANTITIES:

ITEM	ITEM DESCRIPTION	UNIT	INVENTORY	REPAIR QTY
PL18	PLASTIC STOP BAR, 18"	LF		
PLXW	PLASTIC CROSSWALK STRIPE	SF	100	30
PLARW	PLASTIC TRAFFIC ARROW	EA		
PLLTR	PLASTIC TRAFFIC LETTER, 8 FT HIGH	EA		
PLRR	PLASTIC RAILROAD SYMBOL	EA		
RPLSYM	REMOVE PL. ARROW, LETTER, SYMBOL	EA		
RRPM	REMOVE RPM	EA		3
RPLXW	REMOVE PLASTIC STRIPE	SF		30
RPM11	TYPE II RPM	EA	12	3

CITY OF KIRKLAND
DEPARTMENT OF PUBLIC WORKS
123 FIFTH AVENUE KIRKLAND, WA 98033
(425) 587-3800 www.kirklandwa.gov

D.GRILLEY 1/2000
DESIGNED BY: DATE

J.JENNINGS 1/2000
DRAWN BY: DATE

CHECKED BY: DATE

2020 PAVEMENT MARKING PROGRAM

STREET: 108TH AVE NE

CROSS STREET: X-WALK N OF NE 55TH ST

SEGMENT:

SCALE: N.T.S.

FILENAME: Page 14-9

NO SCALE

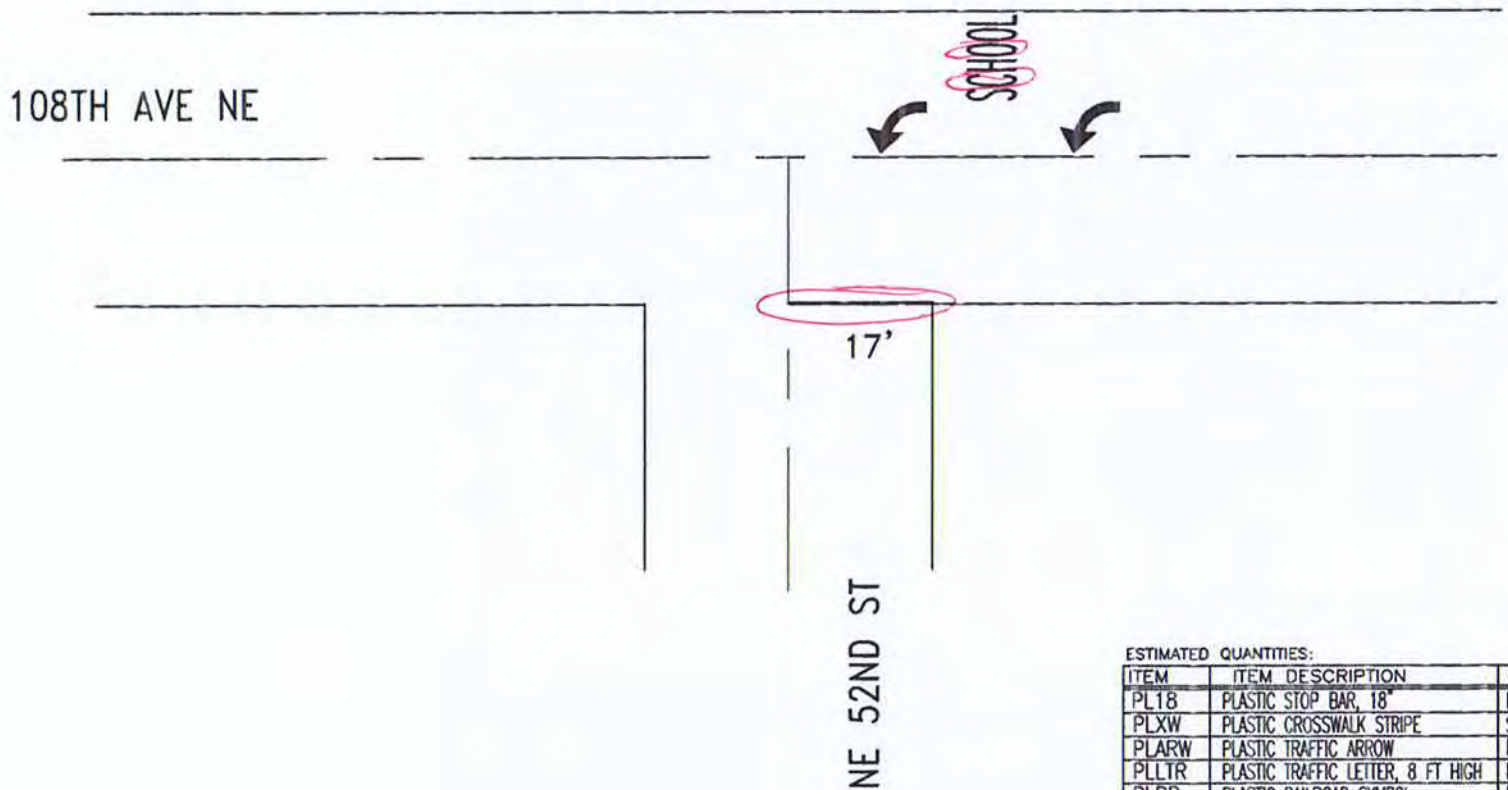

ESTIMATED QUANTITIES:

ITEM	ITEM DESCRIPTION	UNIT	INVENTORY	REPAIR QTY
PL18	PLASTIC STOP BAR, 18"	LF	17	17
PLXW	PLASTIC CROSSWALK STRIPE	SF		
PLARW	PLASTIC TRAFFIC ARROW	EA	2	
PLLTR	PLASTIC TRAFFIC LETTER, 8 FT HIGH	EA	6	2
PLRR	PLASTIC RAILROAD SYMBOL	EA		
RPLSYM	REMOVE PL. ARROW, LETTER, SYMBOL	EA		
RRPM	REMOVE RPM	EA		
RPLXW	REMOVE PLASTIC STRIPE	SF		

CITY OF KIRKLAND
DEPARTMENT OF PUBLIC WORKS
123 FIFTH AVENUE KIRKLAND, WA 98033
(425) 587-3800 www.kirklandwa.gov

S. GONSAR 11/2017
DESIGNED BY: DATE

J.JENNINGS 11/2017
DRAWN BY: DATE

CHECKED BY: DATE

20__ PAVEMENT MARKING PROGRAM

STREET: 108TH AVE NE

CROSS STREET: NE 52ND ST

SEGMENT:

SCALE: N.T.S.

FILENAME: Page 14-10

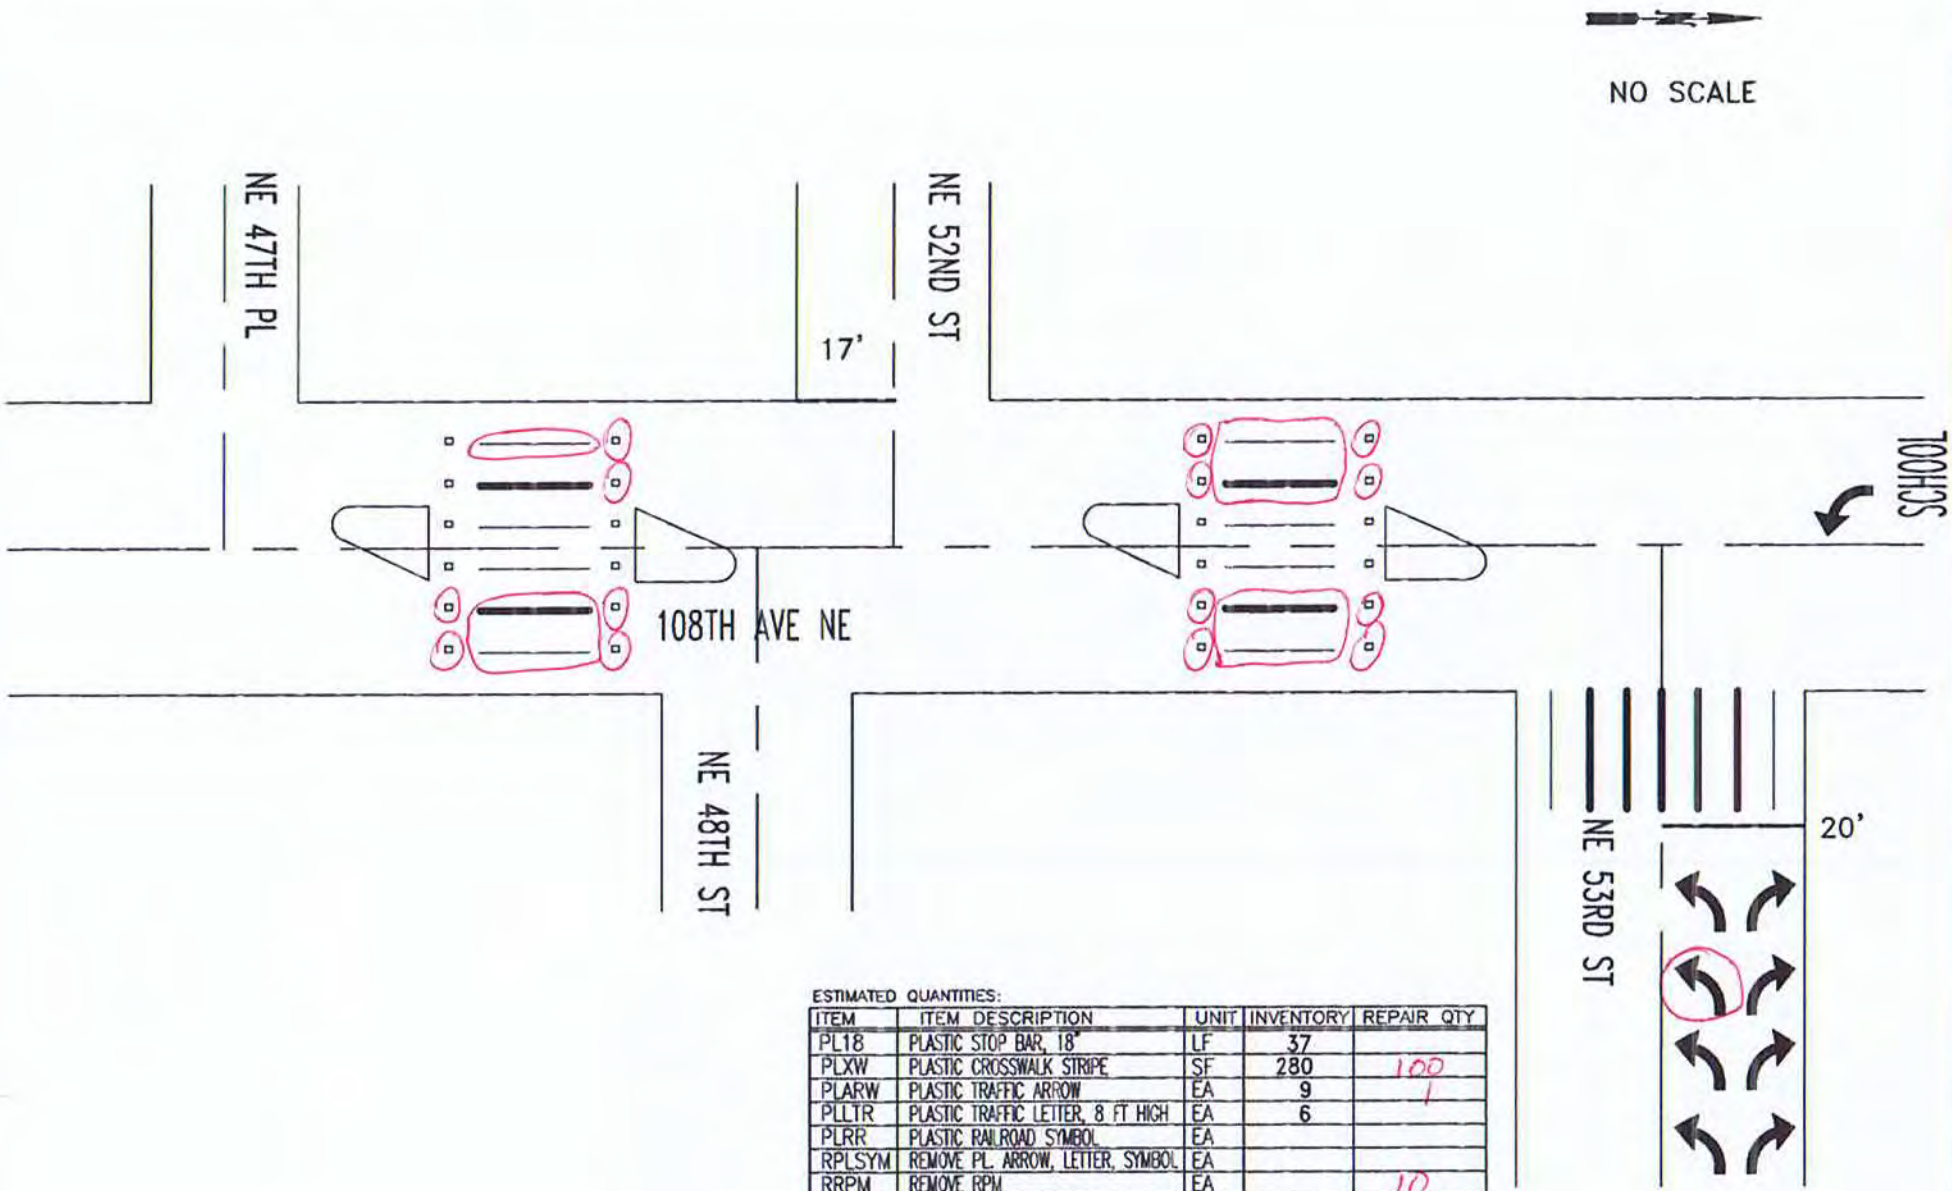

ESTIMATED QUANTITIES:

ITEM	ITEM DESCRIPTION	UNIT	INVENTORY	REPAIR QTY
PL18	PLASTIC STOP BAR, 18"	LF	37	
PLXW	PLASTIC CROSSWALK STRIPE	SF	280	100
PLARW	PLASTIC TRAFFIC ARROW	EA	9	1
PLLTR	PLASTIC TRAFFIC LETTER, 8 FT HIGH	EA	6	
PLRR	PLASTIC RAILROAD SYMBOL	EA		
RPLSYM	REMOVE PL. ARROW, LETTER, SYMBOL	EA		
RRPM	REMOVE RPM	EA		10
RPLXW	REMOVE PLASTIC STRIPE	SF		
RPM11	TYPE II RPM	EA	24	14

CITY OF KIRKLAND
DEPARTMENT OF PUBLIC WORKS
123 FIFTH AVENUE KIRKLAND, WA 98033
(425) 587-3800 www.kirklandwa.gov

D.GRILLEY 4/2007
DESIGNED BY: DATE

J.JENNINGS 4/2007
DRAWN BY: DATE

CHECKED BY: DATE

2022 PAVEMENT MARKING PROGRAM

STREET: 108TH AVE NE

CROSS STREET: NE 53RD ST TO NE 46TH ST

SEGMENT:

SCALE: N.T.S.

FILENAME:

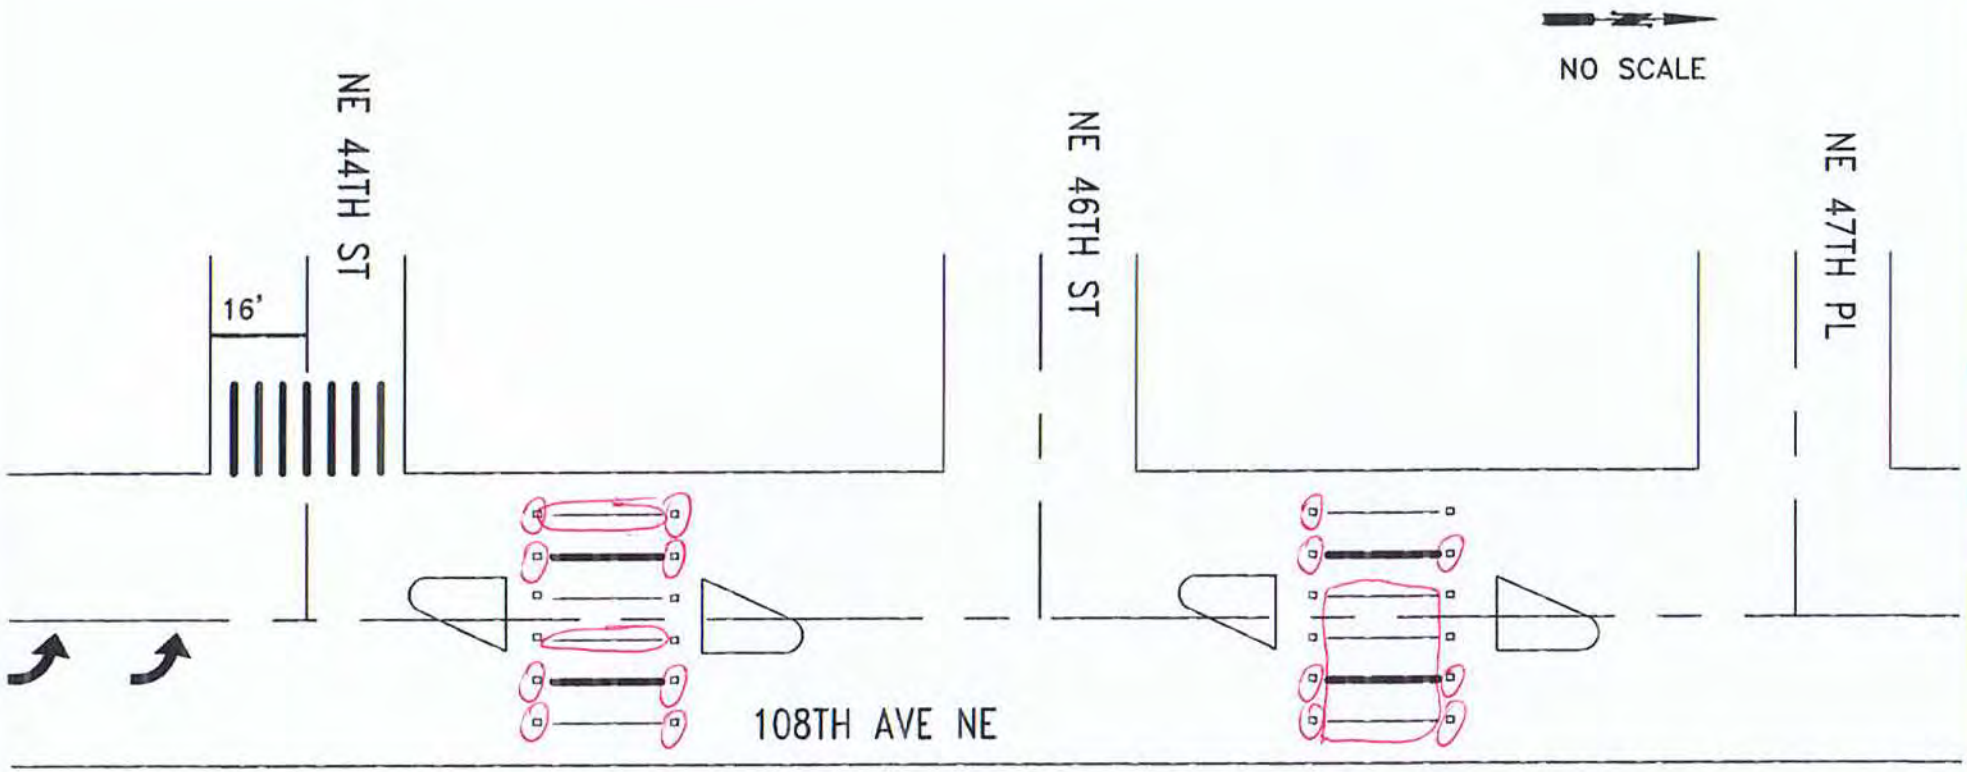

ESTIMATED QUANTITIES:

ITEM	ITEM DESCRIPTION	UNIT	INVENTORY	REPAIR QTY
PL18	PLASTIC STOP BAR, 18"	LF	16	
PLXW	PLASTIC CROSSWALK STRIPE	SF	300	70
PLARW	PLASTIC TRAFFIC ARROW	EA	2	
PLLTR	PLASTIC TRAFFIC LETTER, 8 FT HIGH	EA		
PLRR	PLASTIC RAILROAD SYMBOL	EA		
RPLSYM	REMOVE PL. ARROW, LETTER, SYMBOL	EA		
RRPM	REMOVE RPM	EA		7
RPLXW	REMOVE PLASTIC STRIPE	SF		
RPM11	TYPE II RPM	EA	24	15

CITY OF KIRKLAND
DEPARTMENT OF PUBLIC WORKS
123 FIFTH AVENUE KIRKLAND, WA 98033
(425) 587-3800 www.kirklandwa.gov

G. HORTILLOSA 2/2011
DESIGNED BY: DATE

J.JENNINGS 10/2011
DRAWN BY: DATE

CHECKED BY: DATE

2020 PAVEMENT MARKING PROGRAM

STREET: 108TH AVE NE

CROSS STREET: NE 47TH TO NE 44TH ST

SEGMENT:

SCALE: N.T.S.

FILENAME: Page 14-12

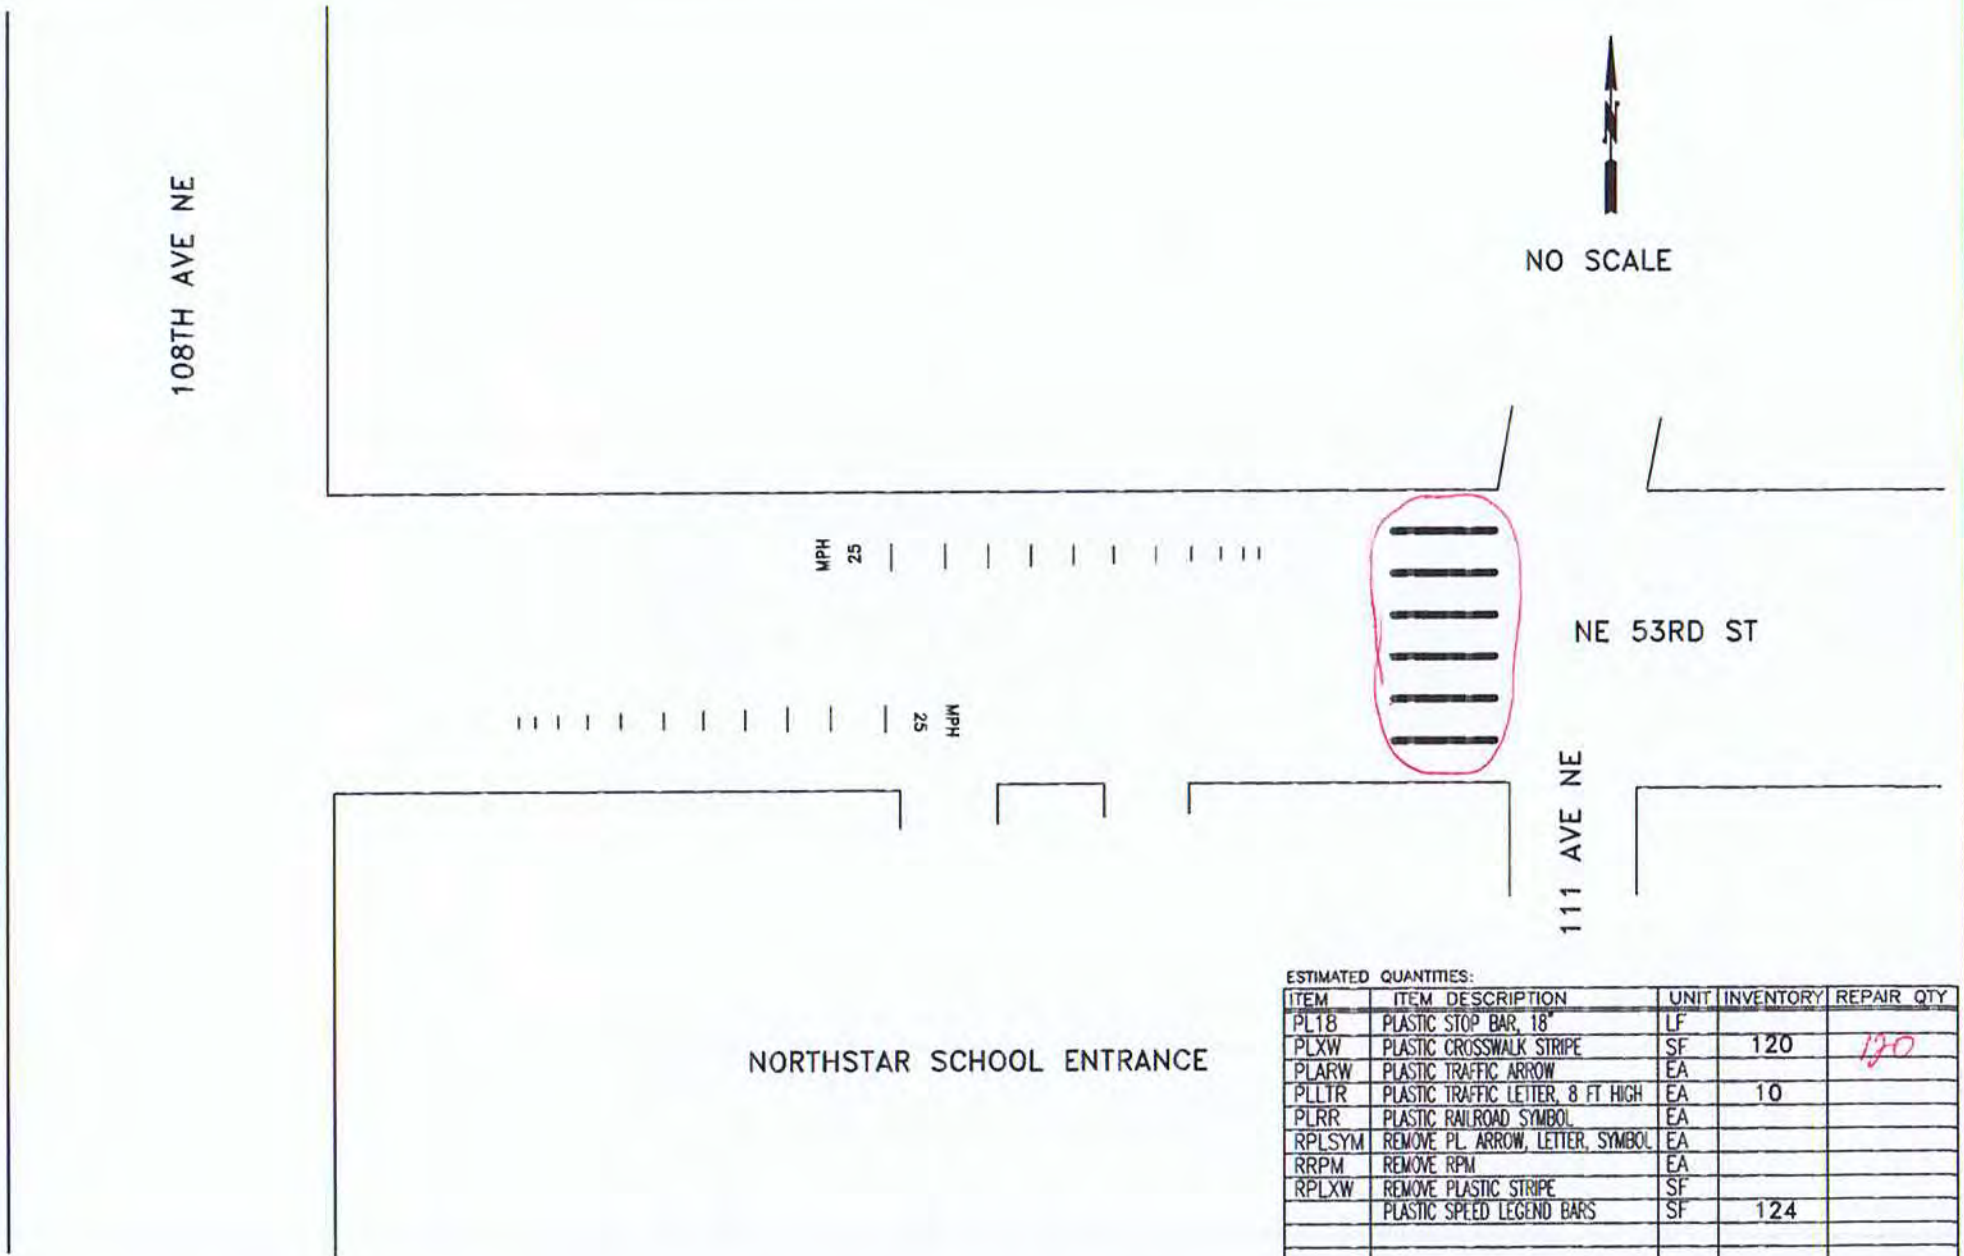

ESTIMATED QUANTITIES:

ITEM	ITEM DESCRIPTION	UNIT	INVENTORY	REPAIR QTY
PL18	PLASTIC STOP BAR, 18"	LF		
PLXW	PLASTIC CROSSWALK STRIPE	SF	120	120
PLARW	PLASTIC TRAFFIC ARROW	EA		
PLLTR	PLASTIC TRAFFIC LETTER, 8 FT HIGH	EA	10	
PLRR	PLASTIC RAILROAD SYMBOL	EA		
RPLSYM	REMOVE PL. ARROW, LETTER, SYMBOL	EA		
RRPM	REMOVE RPM	EA		
RPLXW	REMOVE PLASTIC STRIPE	SF		
	PLASTIC SPEED LEGEND BARS	SF	124	

CITY OF KIRKLAND
DEPARTMENT OF PUBLIC WORKS
123 FIFTH AVENUE KIRKLAND, WA 98033
(425) 587-3800 www.kirklandwa.gov

G. HORTILLOSA 5/2007
DESIGNED BY: DATE

J.JENNINGS 5/2007
DRAWN BY: DATE

CHECKED BY: DATE

2020 PAVEMENT MARKING PROGRAM

STREET: NE 53RD ST

CROSS STREET: 108–111 AVE NE

SEGMENT:

SCALE: N.T.S.

FILENAME: page 14–13

NO SCALE

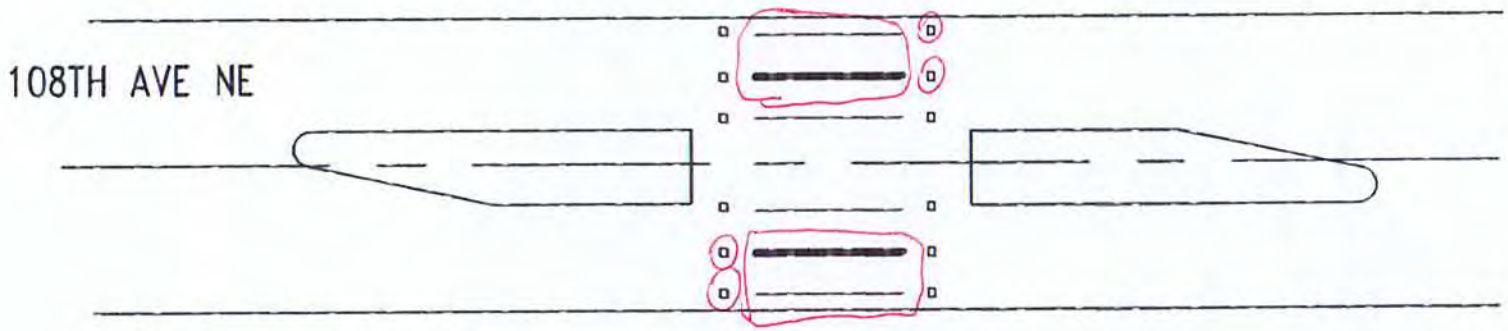

ESTIMATED QUANTITIES:

ITEM	ITEM DESCRIPTION	UNIT	INVENTORY	REPAIR QTY
PL18	PLASTIC STOP BAR, 18"	LF		
PLXW	PLASTIC CROSSWALK STRIPE	SF	100	60
PLARW	PLASTIC TRAFFIC ARROW	EA		
PLLTR	PLASTIC TRAFFIC LETTER, 8 FT HIGH	EA		
PLRR	PLASTIC RAILROAD SYMBOL	EA		
RPLSYM	REMOVE PL. ARROW, LETTER, SYMBOL	EA		
RRPM	REMOVE RPM	EA		4
RPLXW	REMOVE PLASTIC STRIPE	SF		
RPM11	TYPE II RPM	EA	12	4

CITY OF KIRKLAND
DEPARTMENT OF PUBLIC WORKS
123 FIFTH AVENUE KIRKLAND, WA 98033
(425) 587-3800 www.kirklandwa.gov

D.GRILLEY 1/2000
DESIGNED BY: DATE

J.JENNINGS 1/2000
DRAWN BY: DATE

CHECKED BY: DATE

2020 PAVEMENT MARKING PROGRAM

STREET: 108TH AVE NE

CROSS STREET: 44TH - 41ST CROSSWALK

SEGMENT:

SCALE: N.T.S.

FILENAME: Page 14-15

APPENDIX H

ALTERNA H – PLAN SHEET

Additional Item #14 – Bicycle Symbol Refresh

NE 145TH ST
103TH CT NE
106TH PL NE
107TH AVE NE
108TH PL NE
112TH AVE NE
NE 144TH ST
NE 144TH PL
107TH PL NE
108TH AVE NE
105TH AVE NE
NE 144TH ST
NE 143RD ST
104TH AVE NE
NE 143RD PL
NE 143RD ST
103TH AVE NE
106TH AVE NE
108TH AVE NE
NE 143RD ST
112TH AVE NE
NE 142ND PL
NE 142ND ST
111TH AVE NE
NE 142ND ST
NE 142ND ST
NE 141ST PL
NE 141ST CT
NE 141ST PL
NE 141ST PL
106TH AVE NE
NE 141ST PL
104TH PL NE
107TH AVE NE
110TH AVE NE
NE 141ST ST
111TH PL NE

Additional Item #15 – Bicycle Symbol Refresh

Additional Item #16 – Bicycle Symbol Refresh

Additional Item #17 – Bicycle Symbol Refresh

NE 64TH ST
NE 63RD ST
NE 62ND ST
101ST CT NE
LAKE WASHINGTON BLVD NE
LAKEVIEW DR
NE 60TH ST

STATE ST S
NE 68TH PL
NE 67TH ST
NE 66TH LN
103RD AVE NE
102ND PL NE
102ND AVE NE
LAKEVIEW DR
NE 65TH ST
NE 64TH ST

Additional Item #18 – Bicycle Symbol Refresh

KIRKLAND AVE
1ST AVE S
2ND ST S
2ND AVE S
3RD ST S
3RD LN S
4TH ST S
3RD AVE S
4TH CT S
STATE ST S
3RD LN S
5TH AVE S
5TH AVE S
4TH ST S
6TH AVE S

APPENDIX I

CITY OF KIRKLAND STANDARD PLANS
WSDOT STANDARD PLANS

LAST REVISED:01/2020

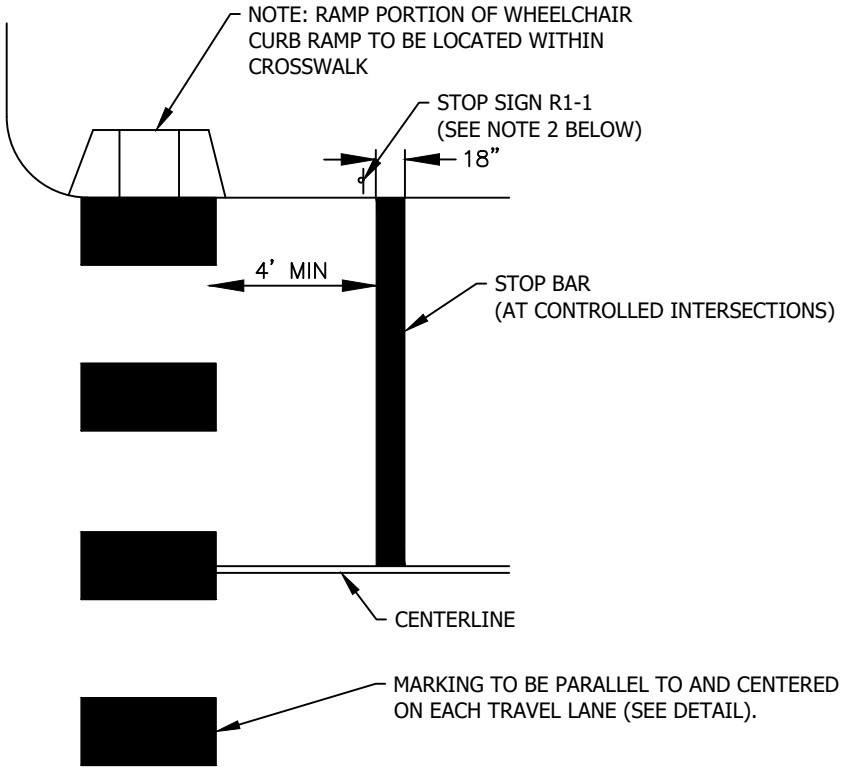

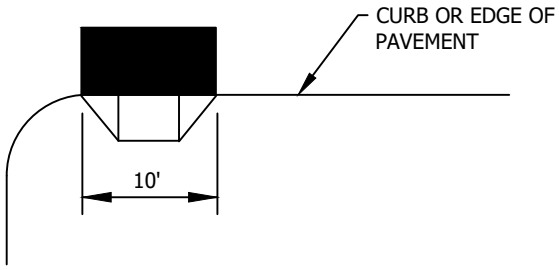

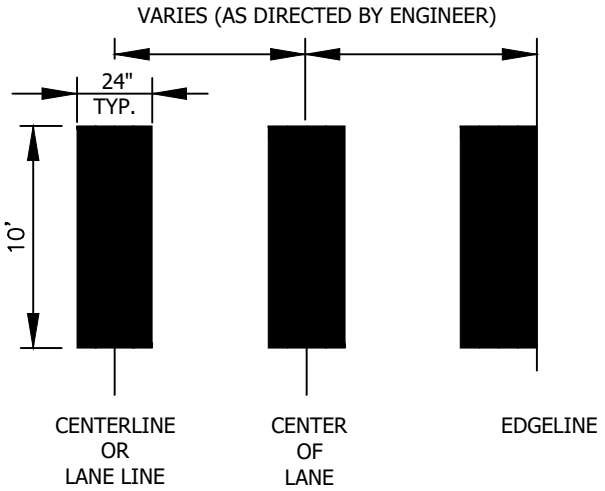

DETAIL

NOTES:

1. MARKINGS SHALL BE THERMOPLASTIC.
2. STOP SIGN LOCATION ADJACENT TO STOP BAR, OR AS DIRECTED BY ENGINEER

CITY OF KIRKLAND	
PLAN NO. CK–R.28	
CITY OF KIRKLAND WASHINGTON	CROSSWALK AND STOP BAR DETAIL

LAST REVISED:01/2020

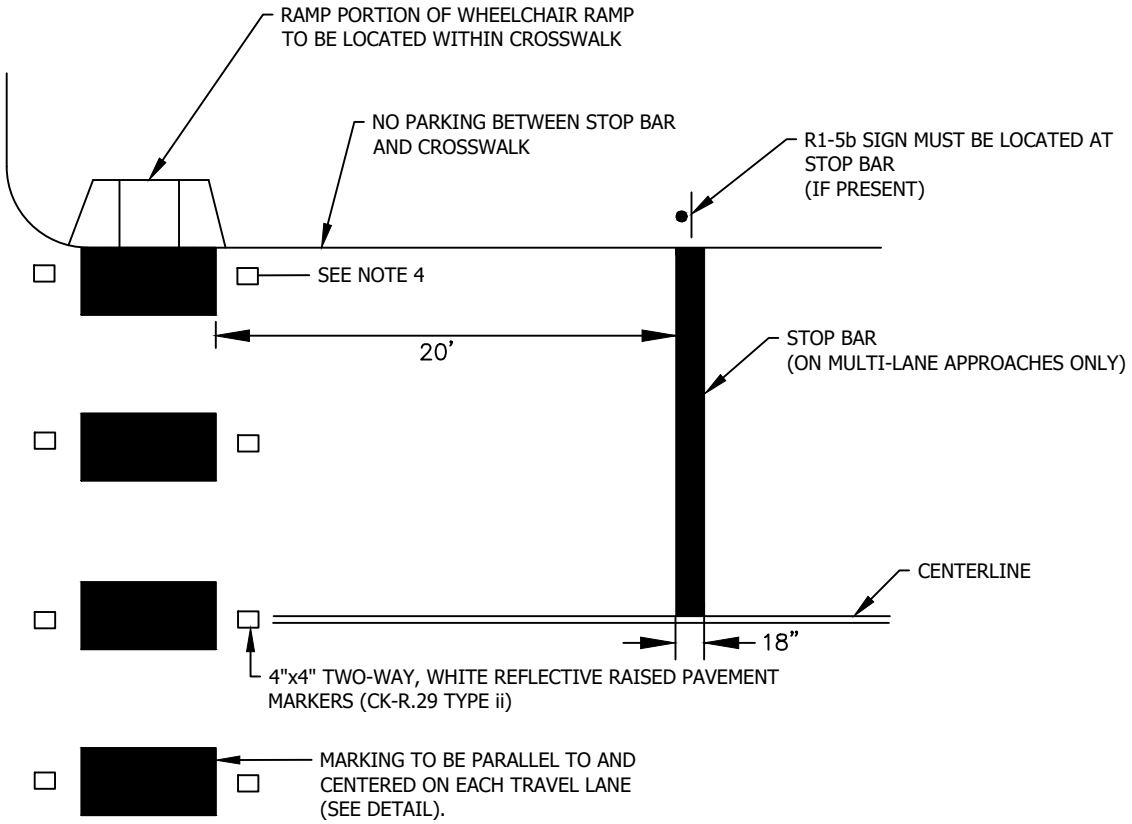

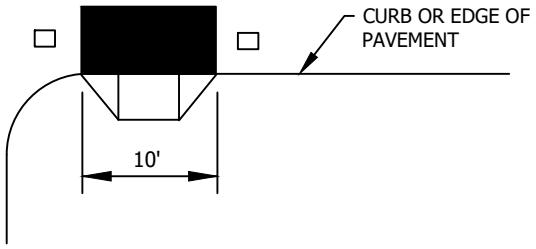

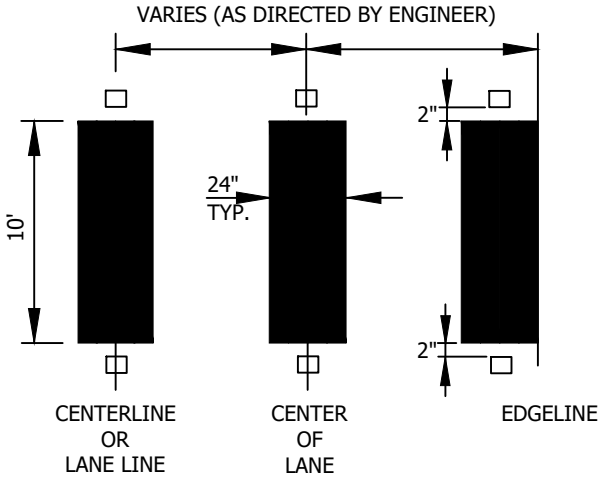

DETAIL

NOTES:

1. MARKINGS SHALL BE THERMOPLASTIC.
2. FOR TWO-WAY REFLECTIVE RAISED PAVEMENT MARKERS, SEE PLAN NO. CK-R.29 TYPE 2.
3. DO NOT PLACE RPM IN BIKE LANE OR ON EDGE LINES.

CITY OF KIRKLAND

PLAN NO. CK-R.28A

CITY OF KIRKLAND WASHINGTON

CROSSWALK AND STOP BAR DETAIL FOR UNCONTROLLED APPROACHES

LAST REVISED: 11/30/99

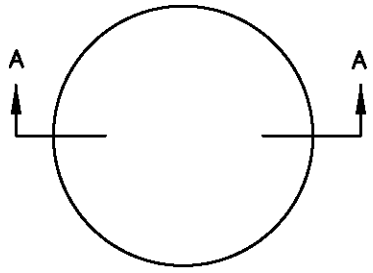

PLAN

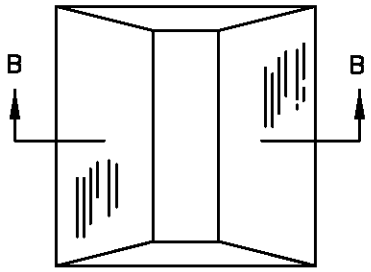

PLAN
DIRECTION OF TRAFFIC

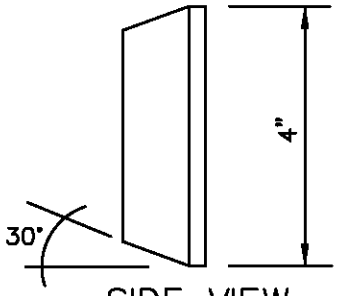

SIDE VIEW

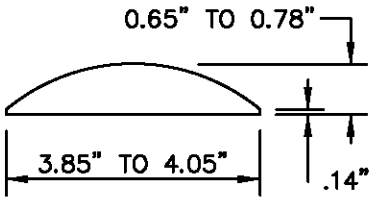

TYPE 1
SECTION A–A

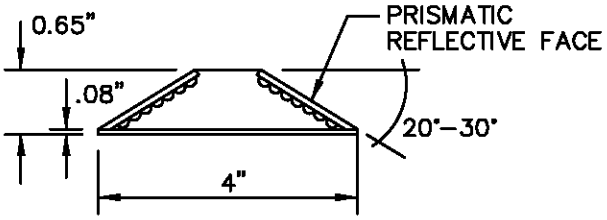

TYPE 2
SECTION B–B

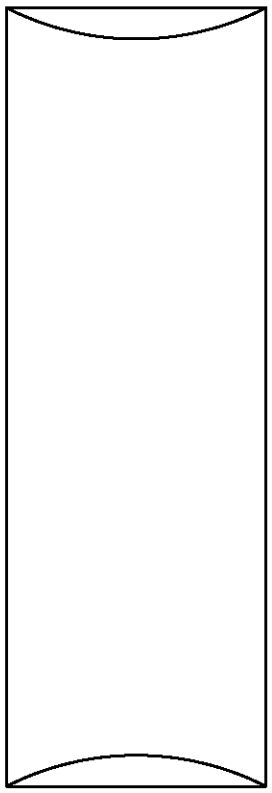

PLAN

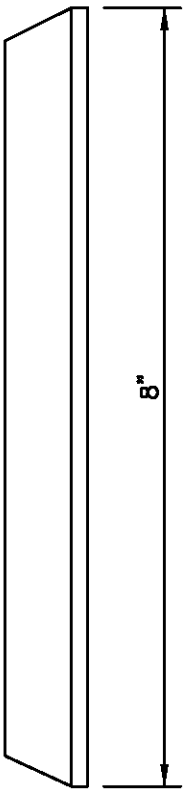

SIDE VIEW

NOTES

1. TYPE C PAVEMENT MARKERS TO BE USED ONLY UPON APPROVAL BY TRAFFIC ENGINEER.
2. NOT TO BE USED ON EDGELINES.

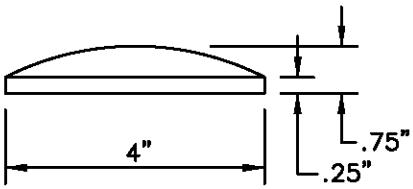

TYPE C

CITY OF KIRKLAND	
PLAN NO. CK–R.29	
CITY OF KIRKLAND WASHINGTON	LANE MARKERS (DIMENSIONS)

LAST REVISED: 1/1/18

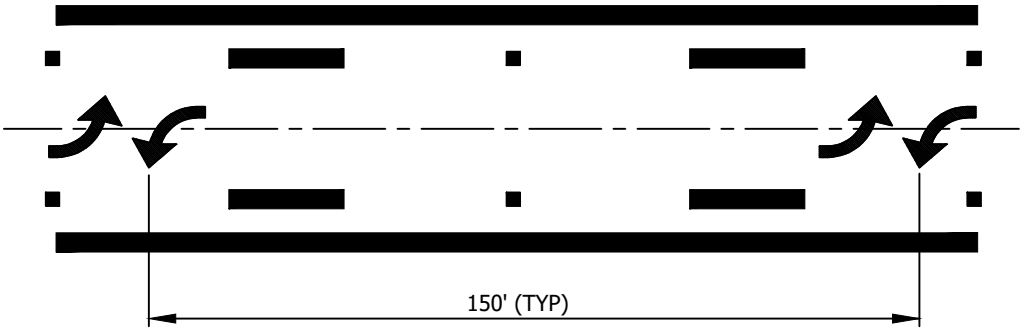

TWO-WAY LEFT TURN MARKERS

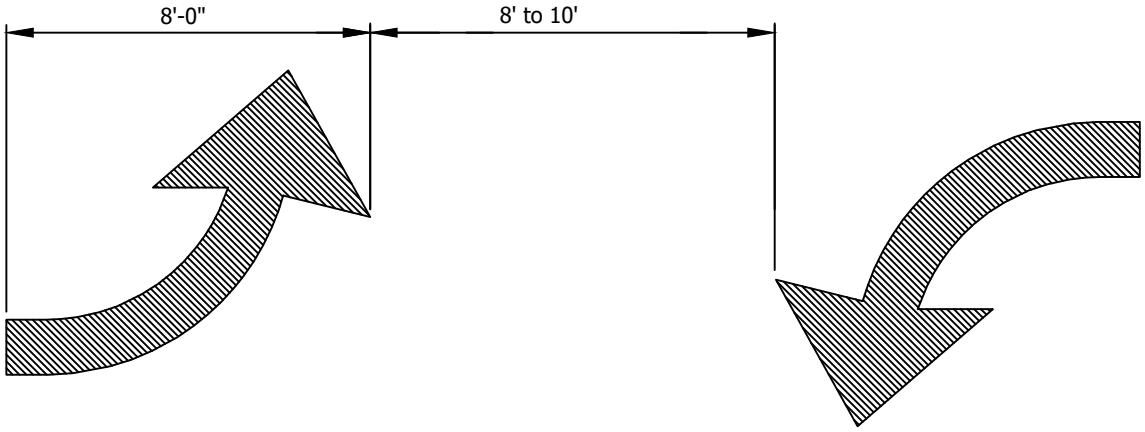

TYPICAL ARROW

NOTES

1. THERMOPLASTIC REQUIRED

CITY OF KIRKLAND	
PLAN NO. CK- R.30	
CITY OF KIRKLAND WASHINGTON	TWO-WAY LEFT TURN LANE AND TYPICAL ARROW

LAST REVISED:01/2020

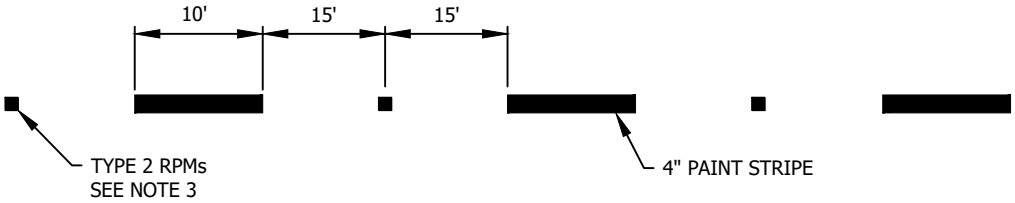

SKIP CENTER & LANE STRIPE DETAIL

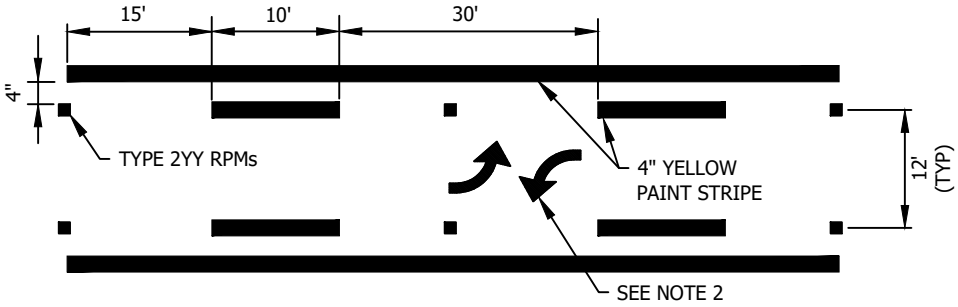

TWO-WAY LEFT TURN DETAIL

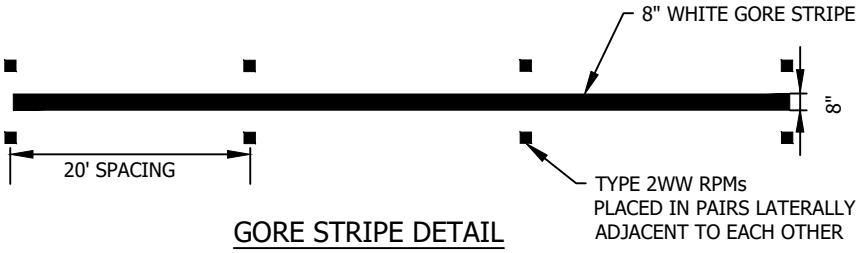

GORE STRIPE DETAIL

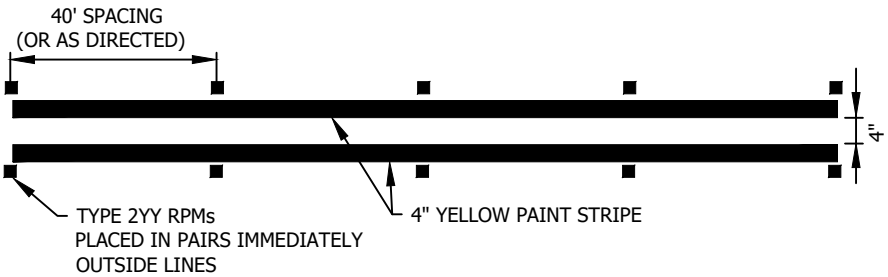

DOUBLE YELLOW CENTER DETAIL

NOTES:

1. MATCH EXISTING PAVEMENT MARKING DIMENSIONS.
2. SEE CK-R.30 FOR TWO-WAY LEFT TURN ARROW PLACEMENT.
3. RAISED PAVEMENT MARKER COLOR SHALL CONFORM TO THE COLOR OF THE MARKING FOR WHICH THEY SUPPLEMENT, SUBSTITUTE FOR, OR SERVE AS A POSITIONING GUIDE FOR.

CITY OF KIRKLAND

PLAN NO. CK–R.31

CITY OF KIRKLAND WASHINGTON

PAVEMENT MARKING DETAIL

LAST REVISED: 2/3/2017

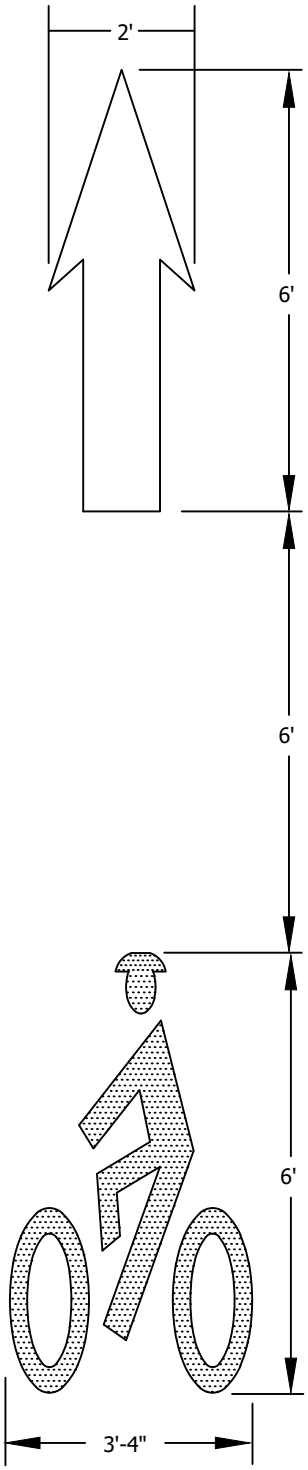

NOTES:

1. BIKE LANE SYMBOLS AND ARROW MATERIAL SHALL BE 90 MILL, PREFORMED, SKID RESISTANT THERMOPLASTIC.
2. BICYCLE SYMBOL FACES ROADWAY CENTERLINE.

CITY OF KIRKLAND	
PLAN NO. CK–R.34	
CITY OF KIRKLAND WASHINGTON	BICYCLE LANE MARKINGS

LAST REVISED: 1/1/2019

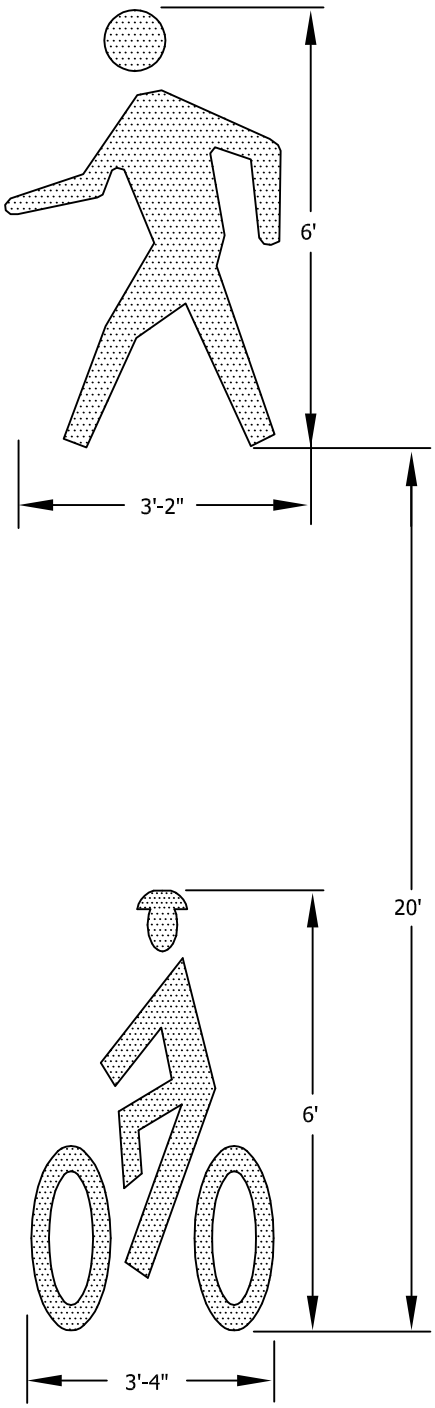

NOTES:

1. BIKE AND PEDESTRIAN LANE SYMBOLS MATERIAL SHALL BE 90 MILL, PERFORMED, SKID RESISTANT THERMOPLASTIC.
2. BICYCLE AND PEDESTRIAN SYMBOLS FACES ROADWAY CENTERLINE.

CITY OF KIRKLAND	
PLAN NO. CK–R.34B	
CITY OF KIRKLAND WASHINGTON	BICYCLE AND PEDESTRIAN LANE MARKINGS

LAST REVISED:2/12/2010

NOTES:

1. INSTALL MARKING AT SIGNALIZED INTERSECTIONS TO INDICATE WHERE BICYCLES SHOULD STOP IN ORDER TO ACHIEVE REGULAR AND RELIABLE DETECTION BY SIGNAL EQUIPMENT.
2. USE MARKING ON ANY APPROACH TO A SIGNALIZED INTERSECTION WHERE LOOP DETECTORS SPECIFICALLY FOR BICYCLES ARE NOT PRESENT AND ANY APPROACH WHICH IS SHOWN A GREEN INDICATION ONLY WHEN VEHICLE LOOPS ARE ACTUATED, I.E. THE APPROACH IS NOT ON "RECALL" OPERATION.
3. PLACE MARKING SUCH THAT BICYCLES WHICH STOP OVER THE MARKINGS WILL ACTIVATE THE SIGNAL.
4. PLACE THE MARKING TO ALLOW BICYCLES GOING THROUGH, TURNING RIGHT, OR TURNING LEFT TO ACTIVATE THE SIGNAL.
5. MARKINGS ARE NOT NECESSARY IN EXCLUSIVE LEFT TURN LANES OF APPROACHES THAT ARE OPERATED BOTH (1) ON RECALL AND (2) IN PERMISSIVE ONLY MODE.
6. IF AN APPROACH HAS MULTIPLE LANES SERVING THROUGH MOVEMENTS AND/OR MULTIPLE LANES SERVING THE SAME TURNING MOVEMENT, ONLY THE RIGHTMOST OF SUCH MULTIPLE LANE GROUPS SHALL BE MARKED.
7. WHERE MULTIPLE LOOPS ARE PRESENT IN A SINGLE LANE, MARKINGS SHALL BE PLACED AS CLOSE TO THE STOP BAR AS POSSIBLE.
8. IN GENERAL, MARKINGS SHALL BE PLACED OVER THE RIGHT EDGES OF SQUARE LOOPS OR CONGRUENT WITH A LINE TANGENT TO THE RIGHTMOST POINT ON THE EDGE OF A CIRCULAR LOOP.
9. IN GENERAL, BICYCLE MARKINGS ARE NOT NEEDED ON APPROACHES WHERE VIDEO DETECTION IS IN PLACE, AS LONG AS BICYCLES CAN BE DETECTED REGULARLY AND RELIABLY BY STOPPING AT THE STOP BAR IN THE MIDDLE OF THE LANE.
10. MATERIAL SHALL BE PAINT OR OTHER APPROVED MATERIAL.
11. SEE ALSO 2009 MANUAL ON UNIFORM TRAFFIC CONTROL DEVICES SECTION 9C.05; RCW 46.61.710; 2004 STANDARD HIGHWAY SIGNS PAGE 10–17.

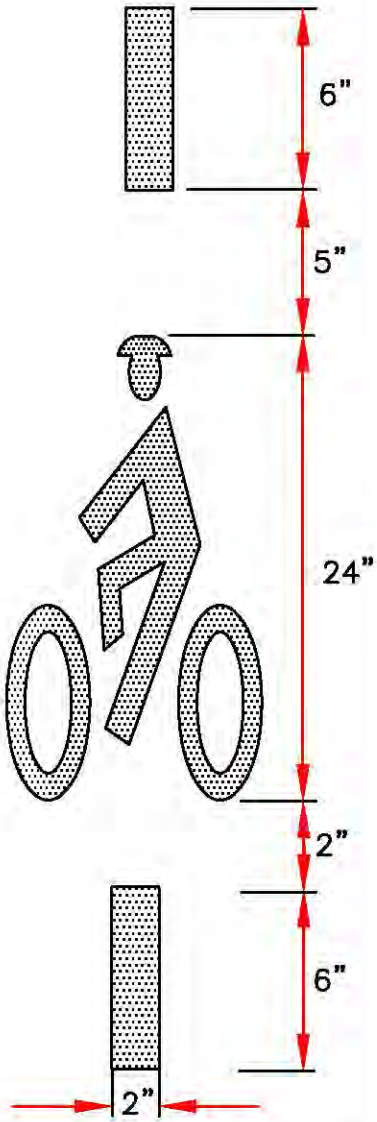

BICYCLE DETECTION MARKING DETAIL

NOT TO SCALE

CITY OF KIRKLAND

PLAN NO. CK–R.34A

BICYCLE DETECTION MARKING

LAST REVISED: 1/1/2018

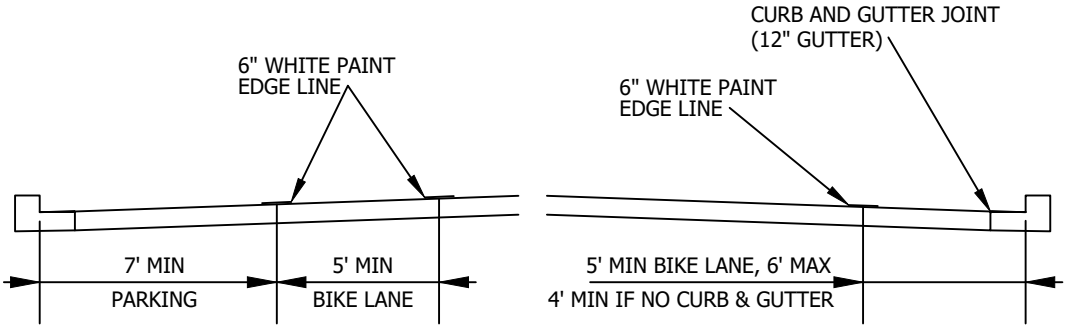

(MEASURED TO FACE OF CURB OR CENTER OF PAINT STRIPE)

BICYCLE LANE WITH PARKING

BICYCLE LANE WITHOUT PARKING

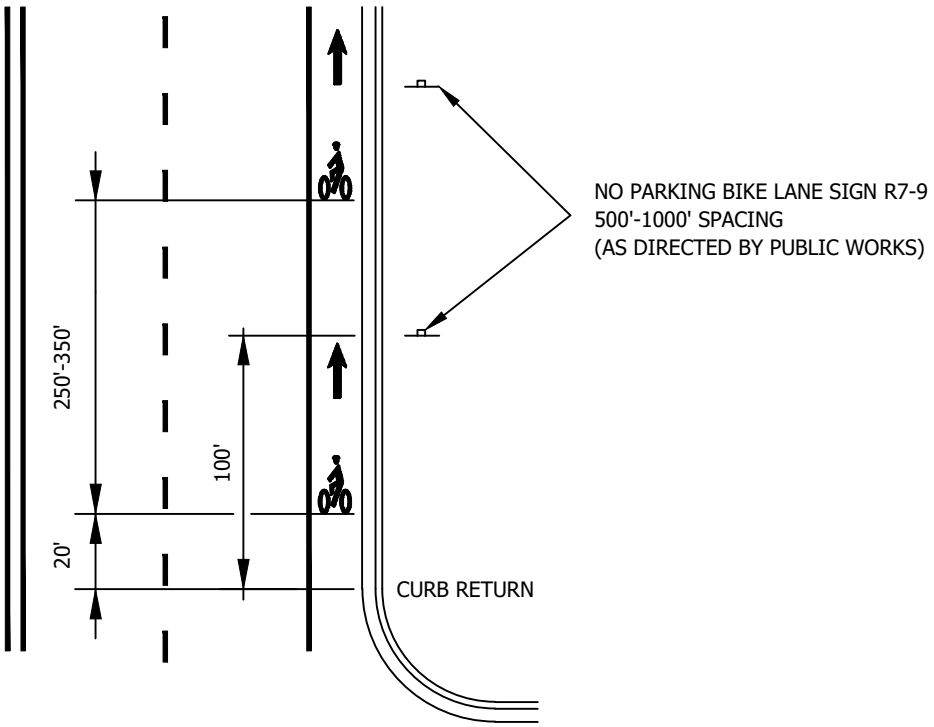

NOTES:

1. SEE MUTCD FOR MORE INFORMATION AND SPECIFICATIONS.
2. PER SEC. 9B.04 2009 MUTCD, DO NOT USE R3-17 SIGNS.
2. BICYCLIST SYMBOLS PER CK-R.34

CITY OF KIRKLAND	
PLAN NO. CK- R.35	
CITY OF KIRKLAND WASHINGTON	TYPICAL BICYCLE LANE - WIDTH, SIGNING & MARKING

LAST REVISED: 01/2020

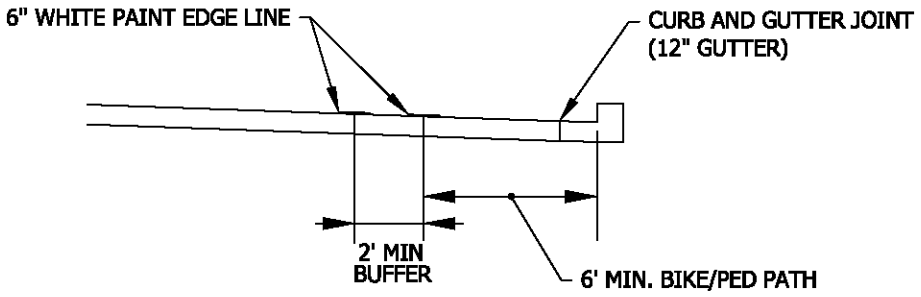

BUFFERED BICYCLE / PEDESTRIAN PATH WITHOUT PARKING
(MEASURED TO FACE OF CURB OR CENTER OF PAINT STRIPE)

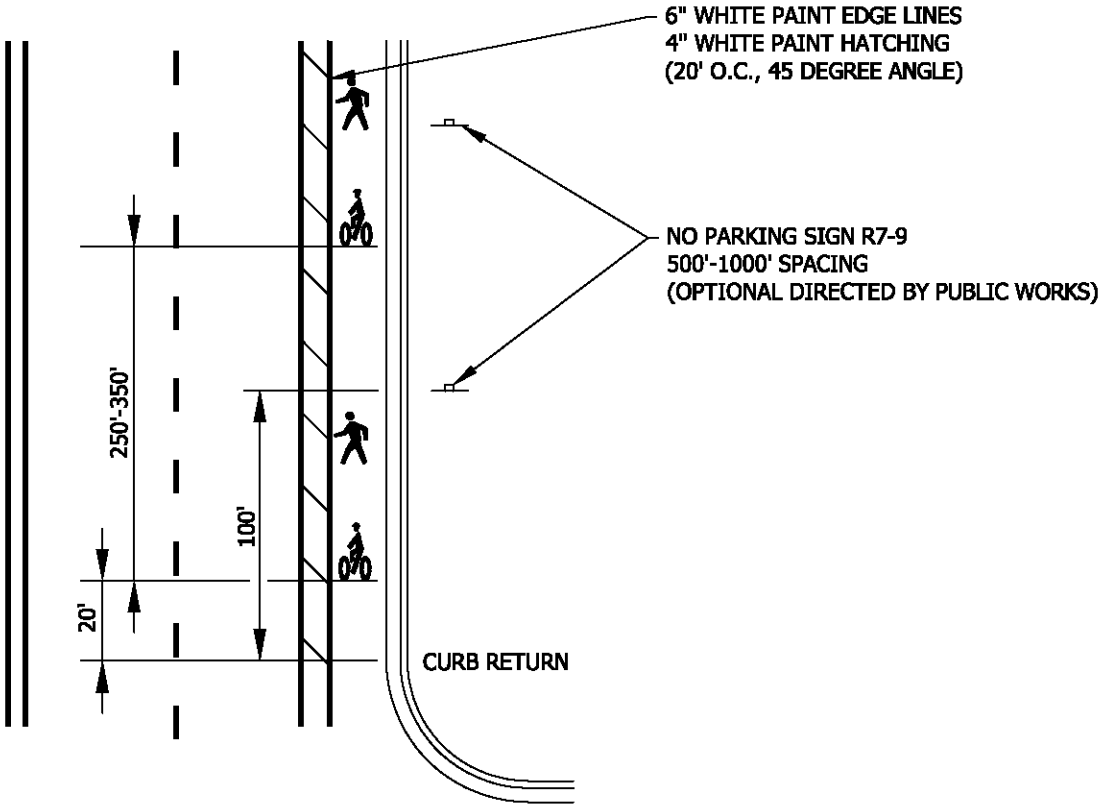

NOTES:

1. SEE MUTCD FOR MORE INFORMATION AND SPECIFICATIONS.
2. PER SEC. 9B.04 2009 MUTCD, DO NOT USE R3-17 SIGNS.
3. BICYCLIST AND PEDESTRIAN SYMBOLS PER CK-R.34B

CITY OF KIRKLAND	
PLAN NO. CK-R.35B	
CITY OF KIRKLAND WASHINGTON	TYPICAL BUFFERED BICYCLE/ PEDESTRIAN SHARED PATH

LAST REVISED: 1/1/18

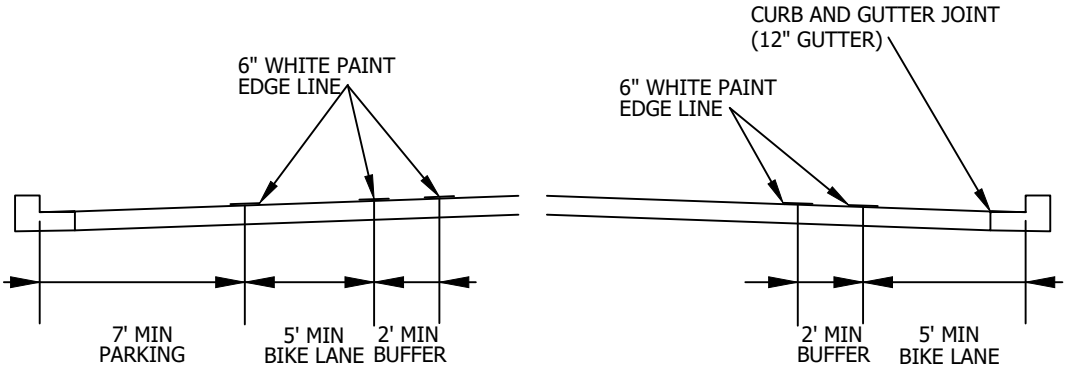

(MEASURED TO FACE OF CURB OR CENTER OF PAINT STRIPE)

BUFFERED BICYCLE LANE WITH PARKING

BUFFERED BICYCLE LANE WITHOUT PARKING

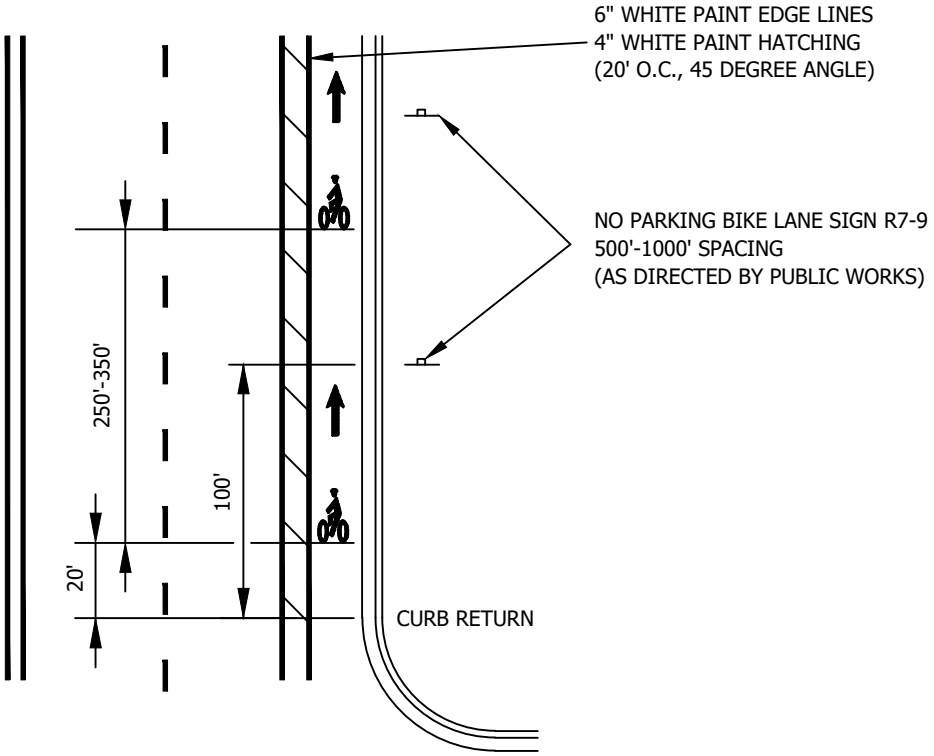

NOTES:

1. SEE MUTCD FOR MORE INFORMATION AND SPECIFICATIONS.

2. PER SEC. 9B.04 2009 MUTCD, DO NOT USE R3-17 SIGNS.

3. BICYCLIST SYMBOLS PER CK-R.34

CITY OF KIRKLAND

PLAN NO. CK-R.35A

CITY OF KIRKLAND WASHINGTON

TYPICAL BUFFERED BICYCLE LANE - WIDTH, SIGNING & MARKING

LAST REVISED: 1/1/19

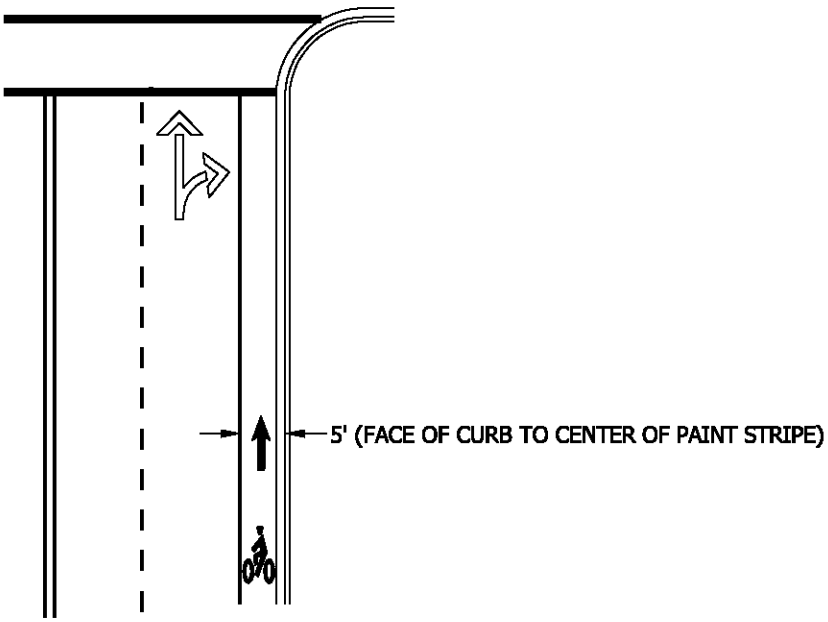

TYPICAL RIGHT-THROUGH LANE

(BICYCLE LANE CONTINUES THROUGH INTERSECTION)

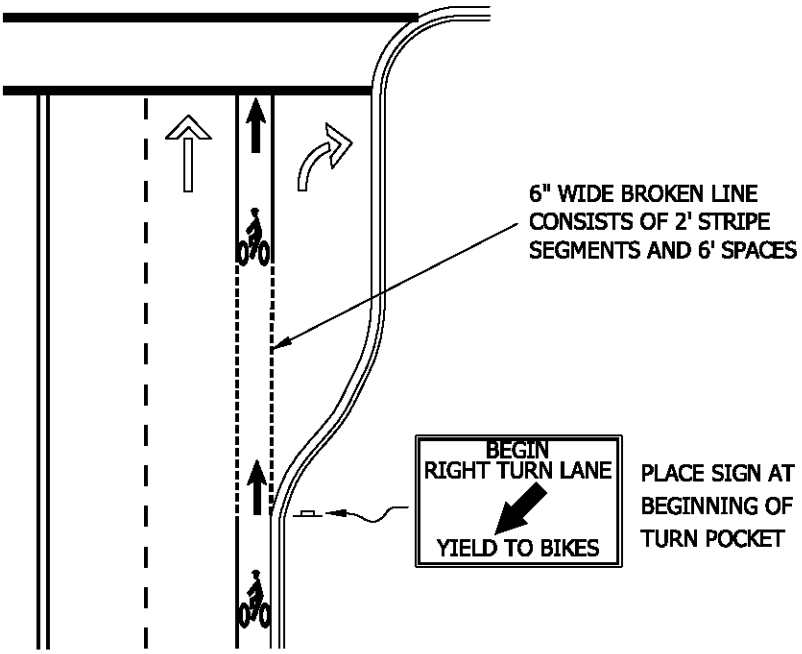

TYPICAL RIGHT TURN POCKET

(BICYCLE LANE CONTINUES THROUGH INTERSECTION)

NOTE:

SEE MUTCD FOR MORE INFORMATION
AND SPECIFICATIONS.
RIGHT TURN POCKETS WITH HIGH RIGHT TURN VEHICLE
VOLUMES OR LOCATED ON PRIORITY BICYCLE CORRIDORS
SHALL BE 90 MIL, PREFORMED, SKID-RESISTANT GREEN
THERMOPLASTIC or MMA BETWEEN BROKEN LINES, REFER
TO
CK-R.36A FOR DETAILS.

CITY OF KIRKLAND	
PLAN NO. CK–R.36	
CITY OF KIRKLAND WASHINGTON	TYPICAL BICYCLE LANE TREATMENTS AT INTERSECTION

LAST REVISED: 01/2020

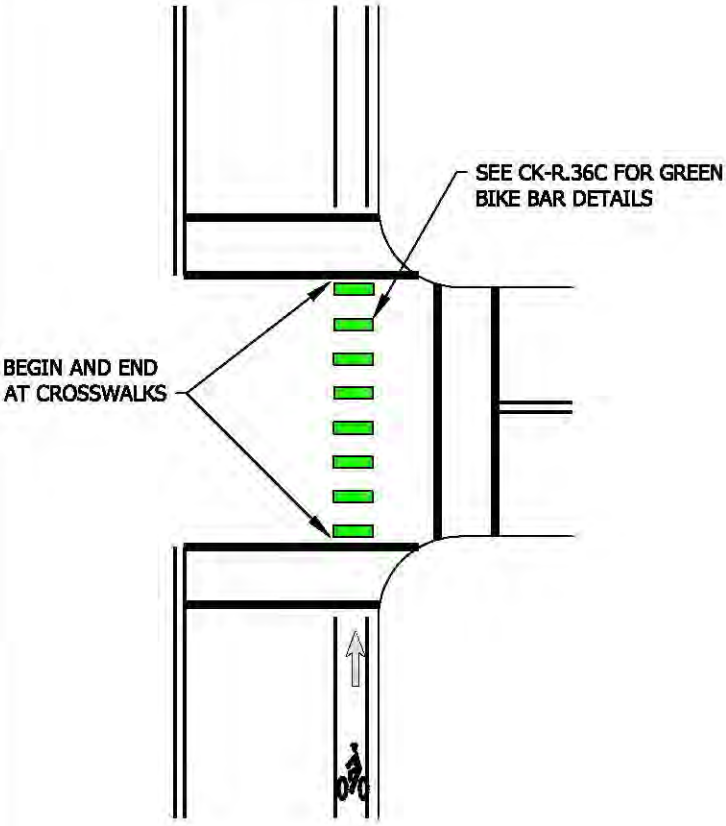

TYPICAL TREATMENT THROUGH INTERSECTION WITH CROSSWALKS

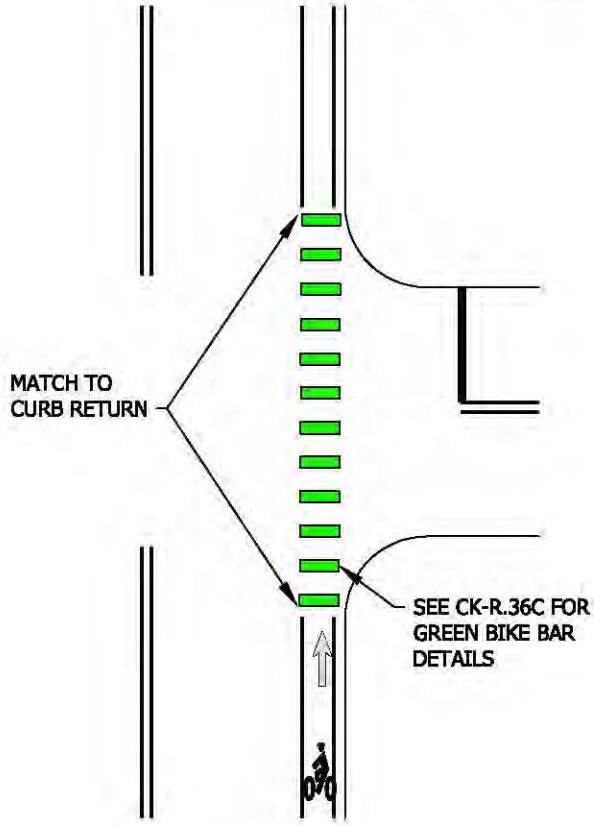

TYPICAL TREATMENT THROUGH INTERSECTION WITHOUT CROSSWALKS

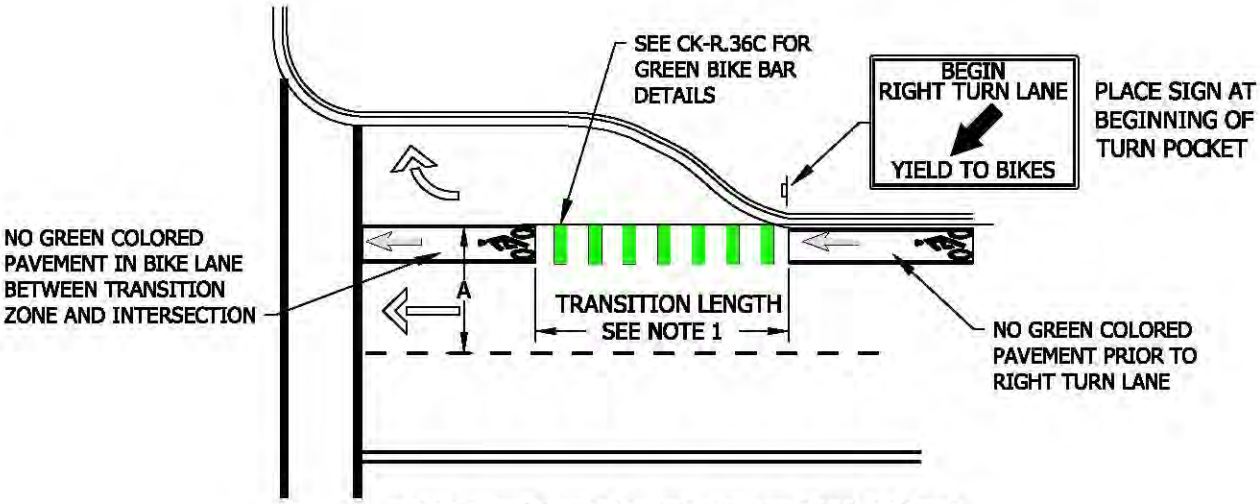

TYPICAL TREATMENT AT A RIGHT TURN POCKET (BICYCLE LANE CONTINUES THROUGH INTERSECTION)

NOTES:

1. TRANSITION LENGTH = 5 x A (TYPICALLY 80' AS SHOWN).
2. GREEN COLORED PAVEMENT, BIKE LANE SYMBOL, AND ARROW SHALL BE EITHER 90 MIL PREFORMED THERMOPLASTIC OR METHYL METHACRYLATE (MMA).
3. SEE PLAN NO. CK-R.34 FOR MORE DETAILS ABOUT BIKE LANE SYMBOLS AND ARROWS.
4. MARKING UNSIGNALIZED INTERSECTIONS WITH GREEN PAVEMENT IS EVALUATED ON A CASE-BY-CASE BASIS

CITY OF KIRKLAND

PLAN NO. CK-R.36A

CITY OF KIRKLAND WASHINGTON

GREEN BIKE LANE AT INTERSECTION

LAST REVISED: 01/2020

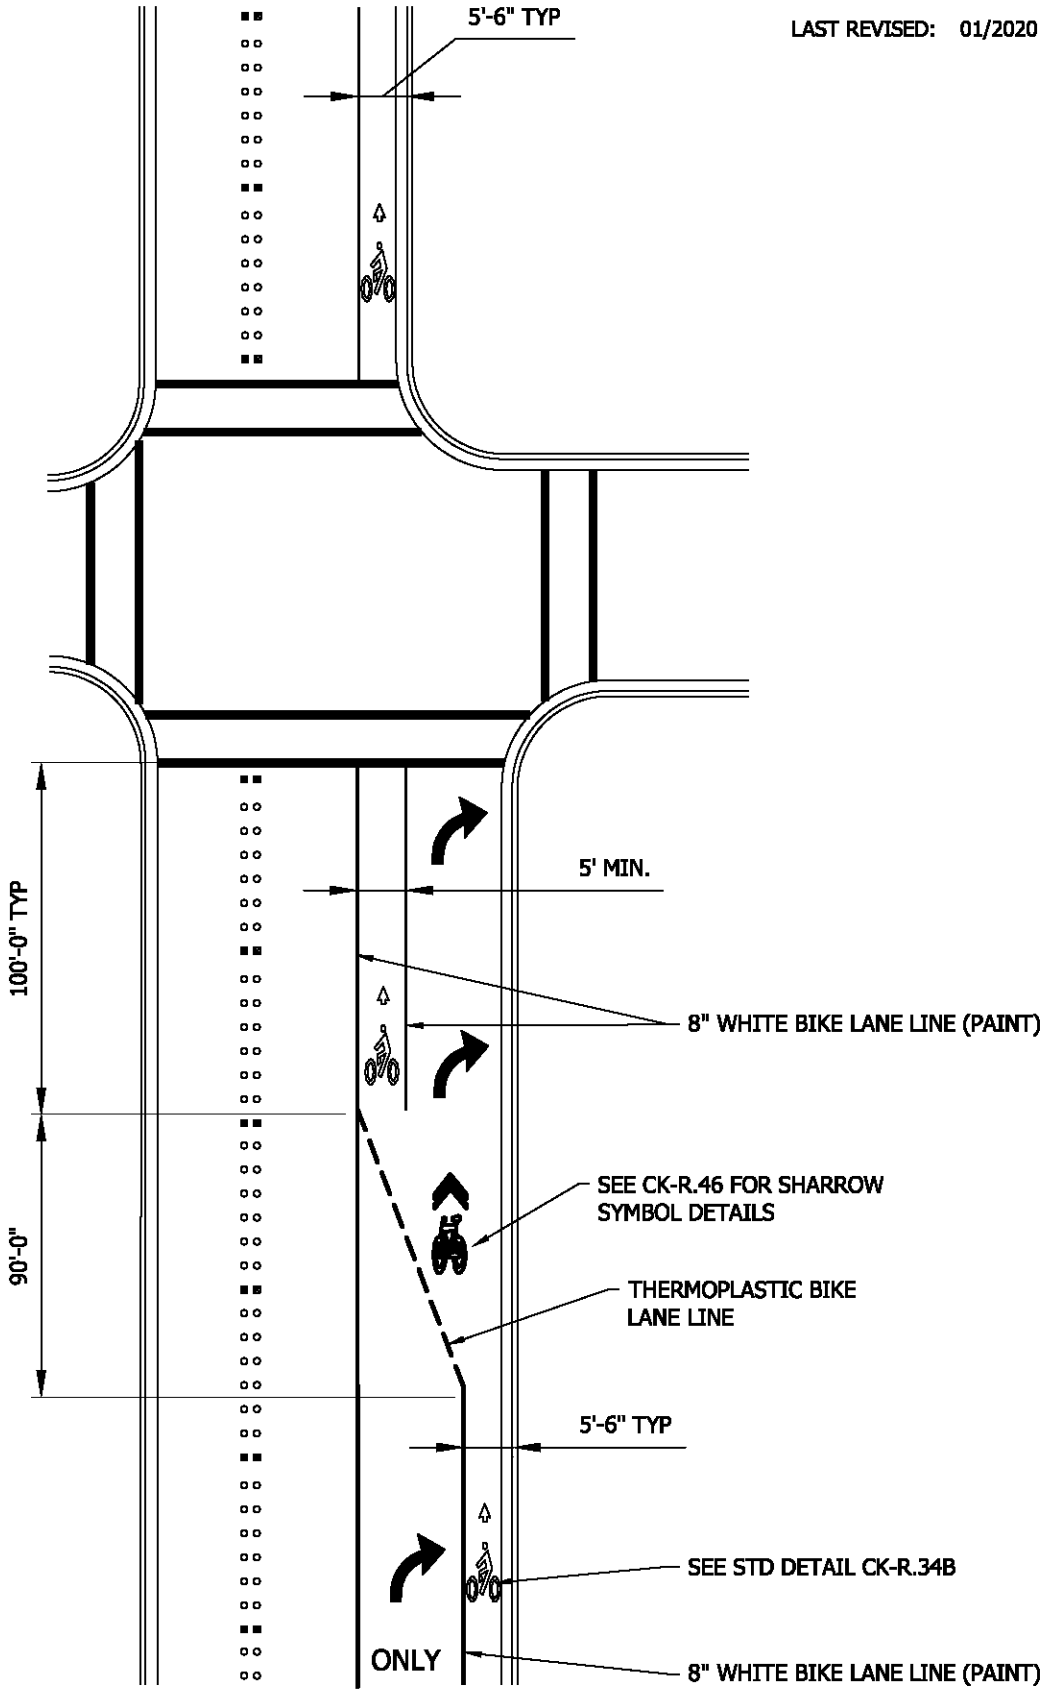

CITY OF KIRKLAND

PLAN NO. CK- R.36B

CITY OF KIRKLAND WASHINGTON

BIKE LANE TREATMENT AT DROP LANE RIGHT TURN

LAST REVISED:01/2020

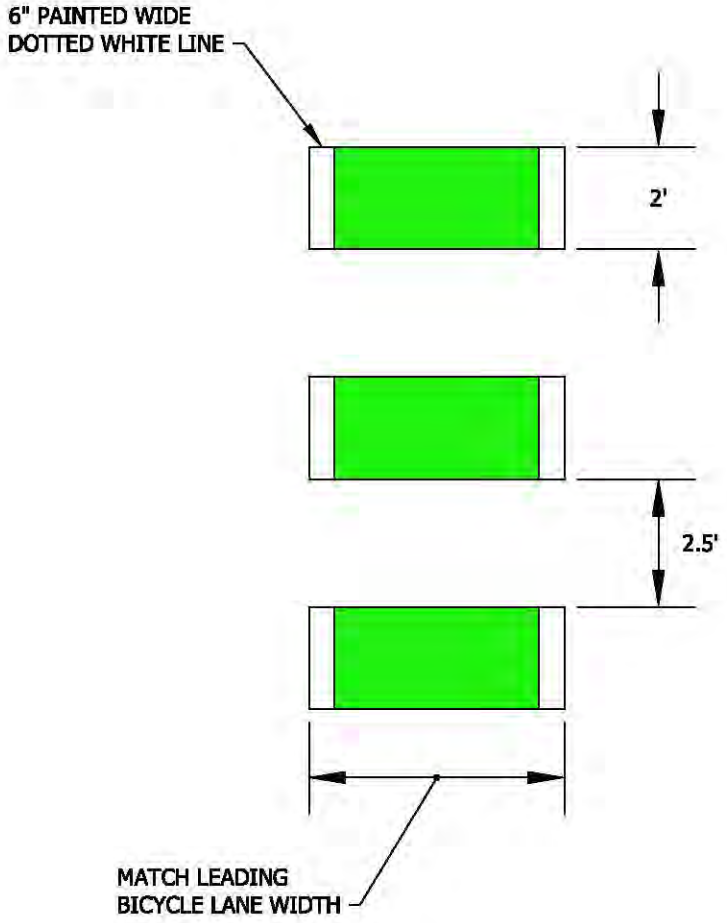

NOTE:

GREEN COLORED PAVEMENT SHALL BE EITHER 90 MIL PREFORMED THERMOPLASTIC OR METHYL METHACRYLATE (MMA)

CITY OF KIRKLAND

PLAN NO. CK-R.36C

CITY OF KIRKLAND WASHINGTON

TYPICAL INTERSECTION/ CONFLICT ZONE BIKE LANE PAVEMENT MARKING

LAST REVISED:01/2020

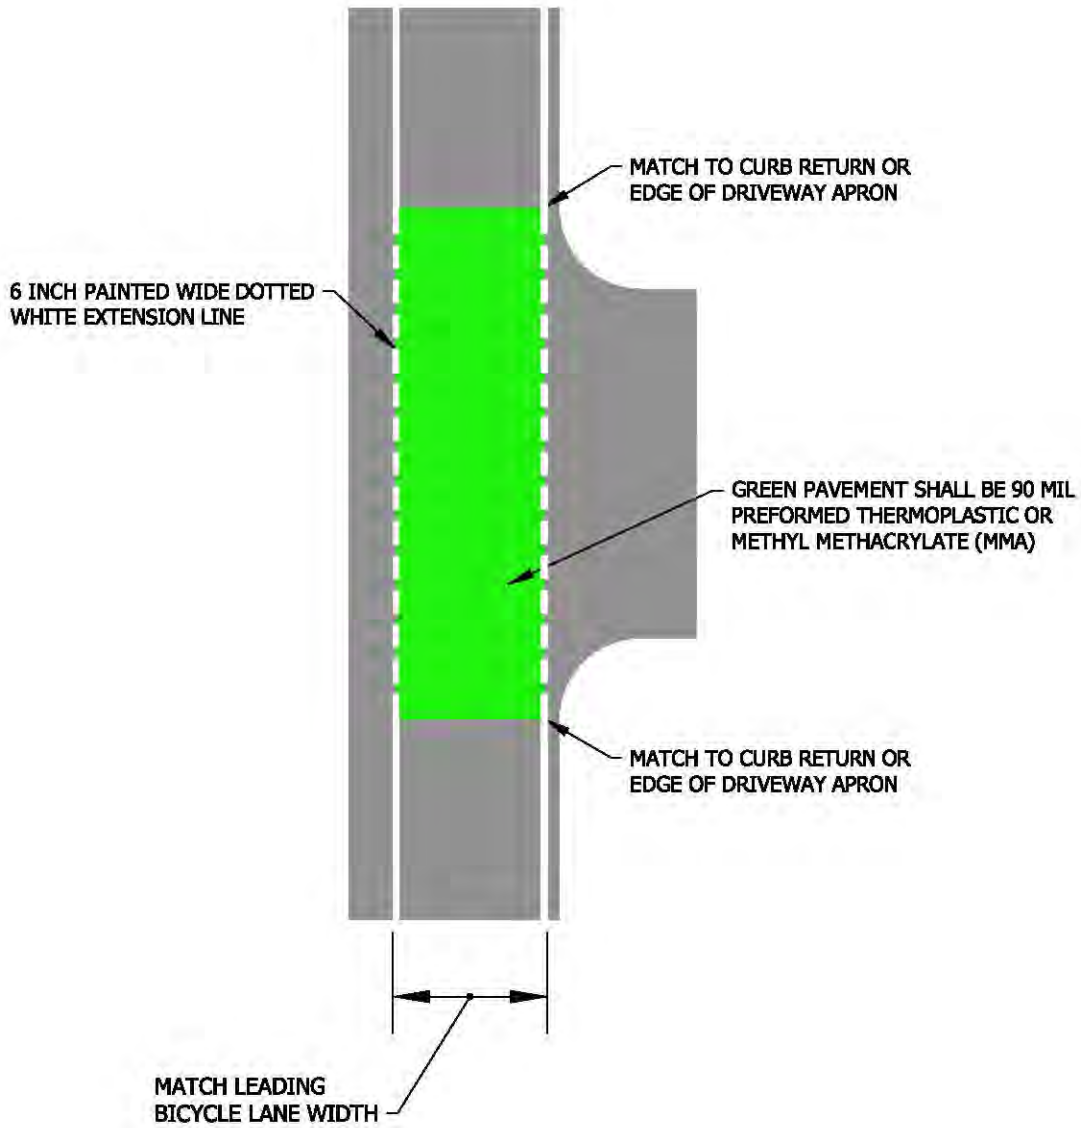

NOTE:

DRIVEWAYS ARE NOT TYPICALLY MARKED WITH GREEN PAVEMENT, BUT DRIVEWAYS WITH HIGH VEHICLE VOLUMES OR OTHER COMPLEX VEHICULAR MOVEMENTS SHOULD BE EVALUATED TO INCLUDE GREEN PAVEMENT MARKINGS.

CITY OF KIRKLAND

PLAN NO. CK-R.36D

CITY OF KIRKLAND WASHINGTON

TYPICAL DRIVEWAY CROSSING BIKE LANE PAVEMENT MARKING

LAST REVISED:01/2020

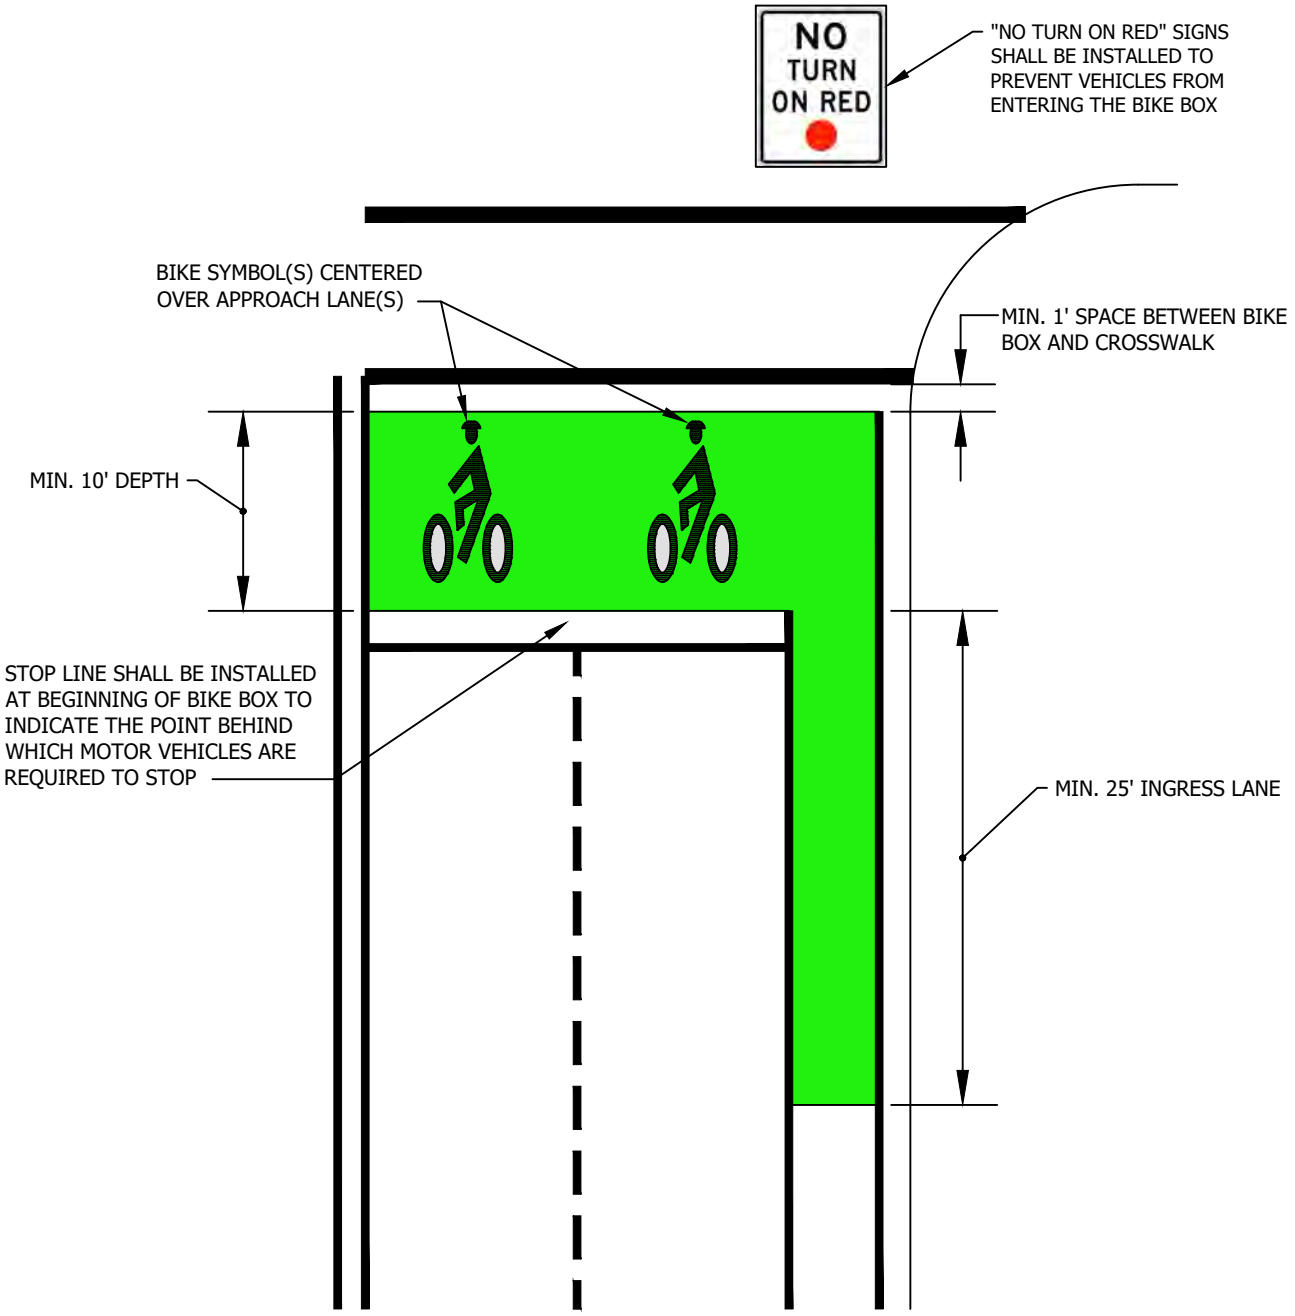

NOTES:

1. GREEN COLORED PAVEMENT AND BIKE LANE SYMBOL SHALL BE EITHER 90 MIL PREFORMED THERMOPLASTIC OR METHYL METHACYLATE (MMA). THE SAME MATERIAL SHALL BE USED FOR BOTH THE BIKE SYMBOLS AND THE GREEN PAVEMENT TREATMENT.
2. SEE PLAN NO. CK-R.34 FOR BIKE LANE SYMBOL DETAILS.
3. SEE CK-R.28 FOR STOP LINE DIMENSIONS.

CITY OF KIRKLAND

PLAN NO. CK–R.36E

CITY OF KIRKLAND WASHINGTON

TYPICAL BIKE BOX AT A SIGNALIZED INTERSECTION

LAST REVISED:01/2020

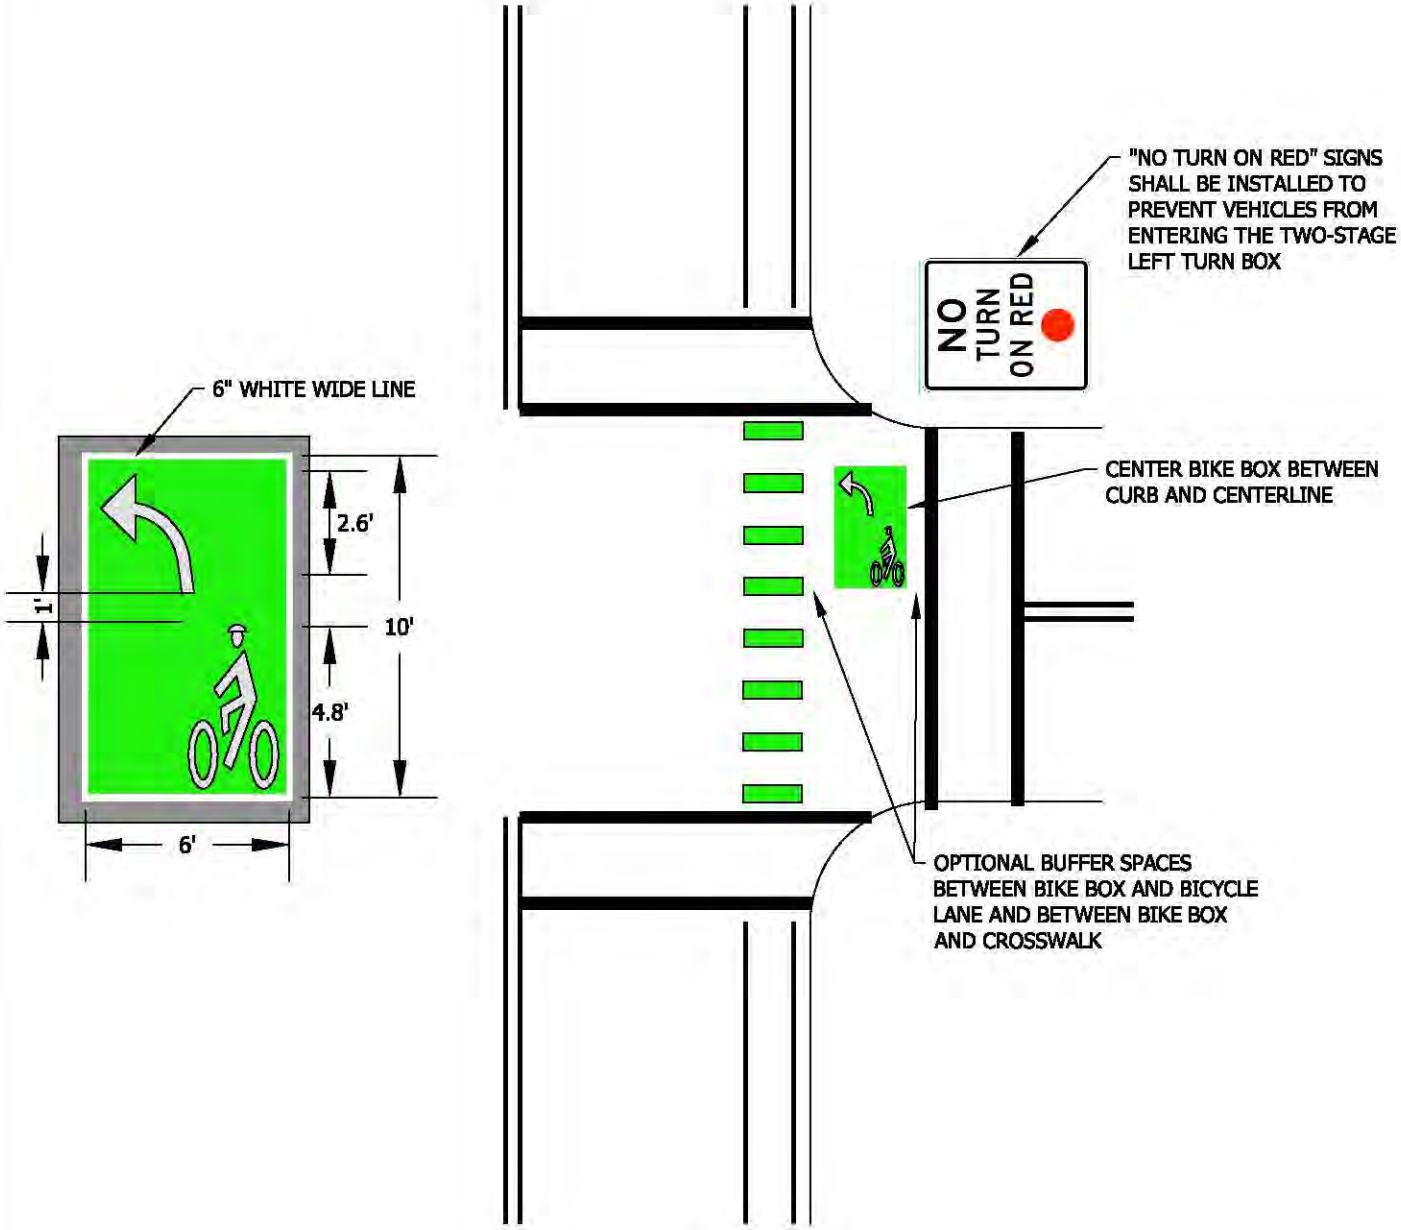

NOTES:

1. ARROW, BIKE SYMBOL, WHITE WIDE LINE, AND GREEN COLORED PAVEMENT SHALL BE EITHER 90 MIL PREFORMED THERMOPLASTIC OR METHYL METHACRYLATE (MMA). THE SAME MATERIAL SHALL BE USED FOR ALL ELEMENTS OF THE TWO-STAGE LEFT TURN BOX.
2. THE QUEUE BOX SHALL BE PLACED IN A PROTECTED AREA. THIS WILL TYPICALLY BE BETWEEN THE BICYCLE LANE AND THE PEDESTRIAN CROSSING BUT CAN ALSO BE PLACED ON THE LEFT SIDE OF THE BICYCLE INTERSECTION CROSSING DEPENDING ON INTERSECTION GEOMETRY.

CITY OF KIRKLAND

PLAN NO. CK-R.36F

CITY OF KIRKLAND WASHINGTON

TYPICAL TWO STAGE LEFT TURN BIKE BOX

LAST REVISED: 01/01/2018

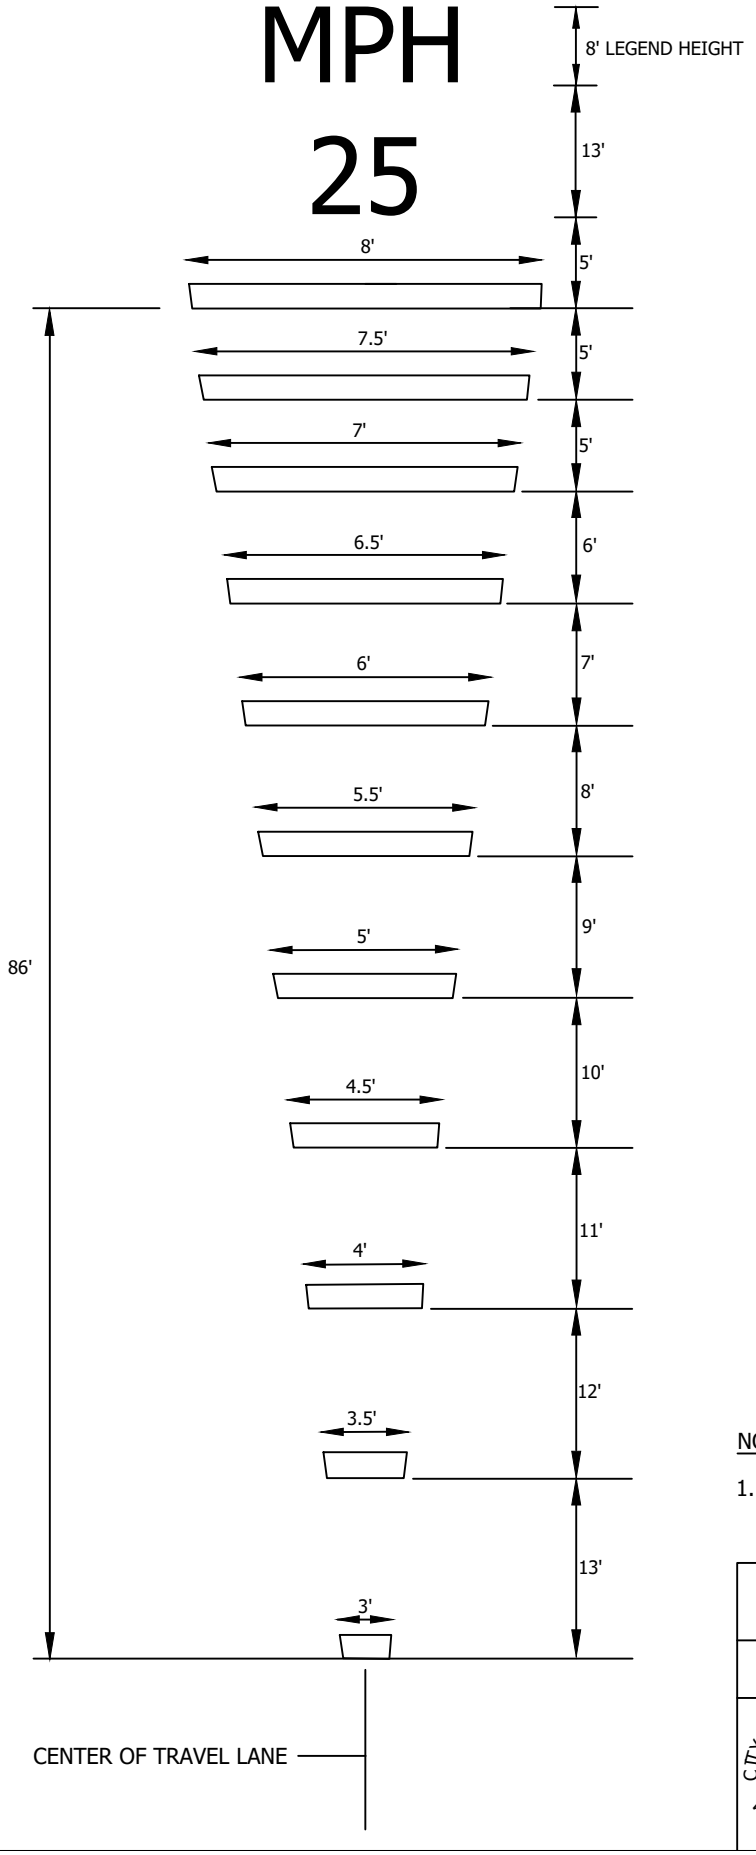

PAVEMENT MARKING DETAIL

NOT TO SCALE

NOTES:

1. TRANSVERSE BAR WIDTH IS 1'.

CITY OF KIRKLAND	
PLAN NO. CK- R.38	
CITY OF KIRKLAND WASHINGTON	TRANSVERSE BAR PAVEMENT MARKING PATTERN

LAST REVISED: 01/18/2018

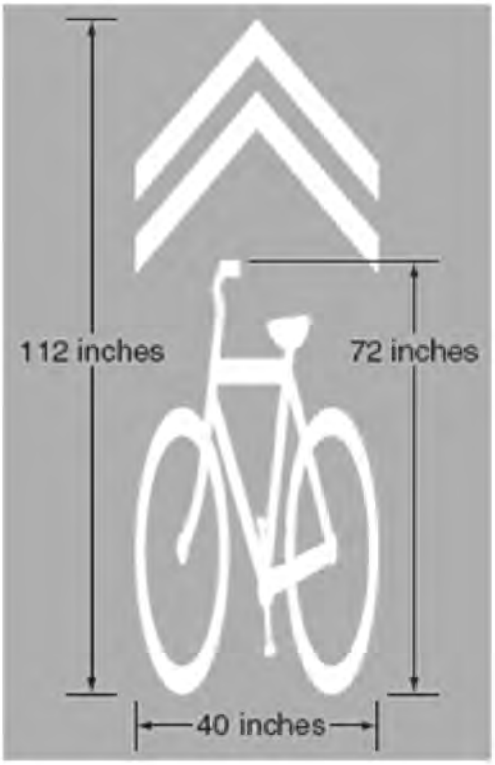

SHARED LANE MARKING DETAIL

NOT TO SCALE

NOTES:

1. PLACE MARKING IN CENTER OF TRAVELED WAY, EVERY 250'-350'.

2. SEE SECTION 9C.07, 2009 MUTCD FOR MORE GUIDANCE.

3. SHARED LANE MARKING MATERIAL SHALL BE 90 MILL, PREFORMED, SKID RESISTANT THERMOPLASTIC.

CITY OF KIRKLAND	
PLAN NO. CK- R.46	
CITY OF KIRKLAND WASHINGTON	SHARED LANE MARKING

LAST REVISED:01/2020

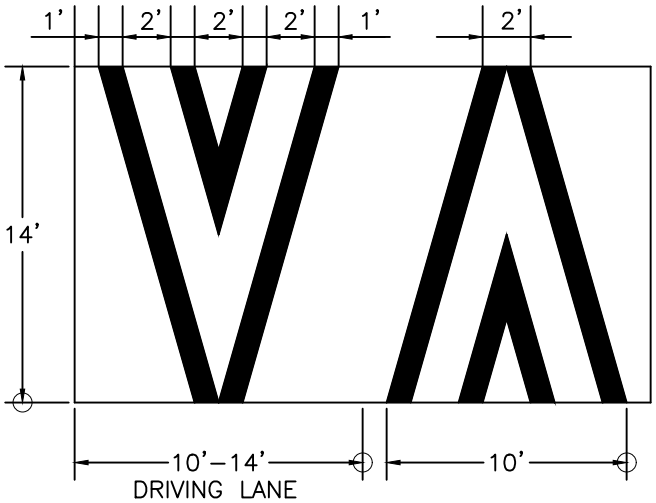

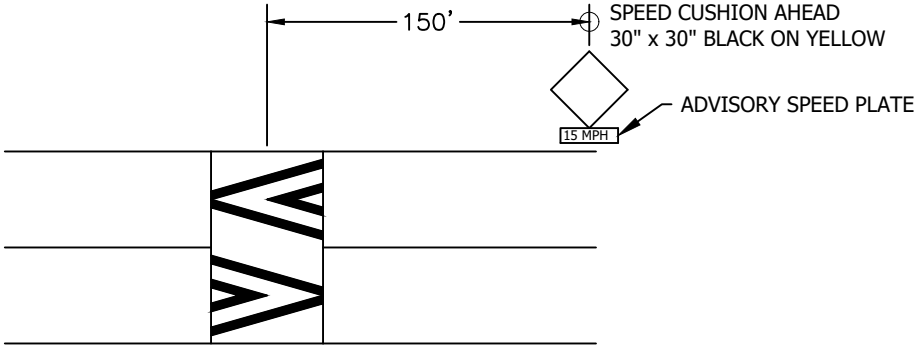

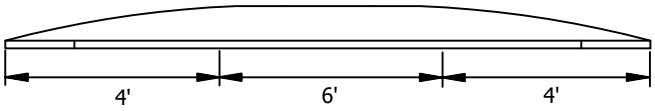

SLOTTED SPEED CUSHION SECTION
NO SCALE

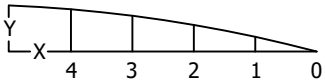

X (ft)	Y (in)
0	0.00
1	1.50
2	2.25
3	2.75
4	3.00

VERTICAL DIMENSION CHART
NO SCALE

NOTES:

1. CHEVRON MARKINGS TO BE WHITE 3M PREFORMED COLD PLASTIC.
2. SIGN LOCATION SHALL BE VERIFIED BY THE PROJECT ENGINEER PRIOR TO INSTALLATION.

CITY OF KIRKLAND

PLAN NO. CK–R.67

CITY OF KIRKLAND WASHINGTON

SPEED CUSHION MARKING AND SIGNAGE

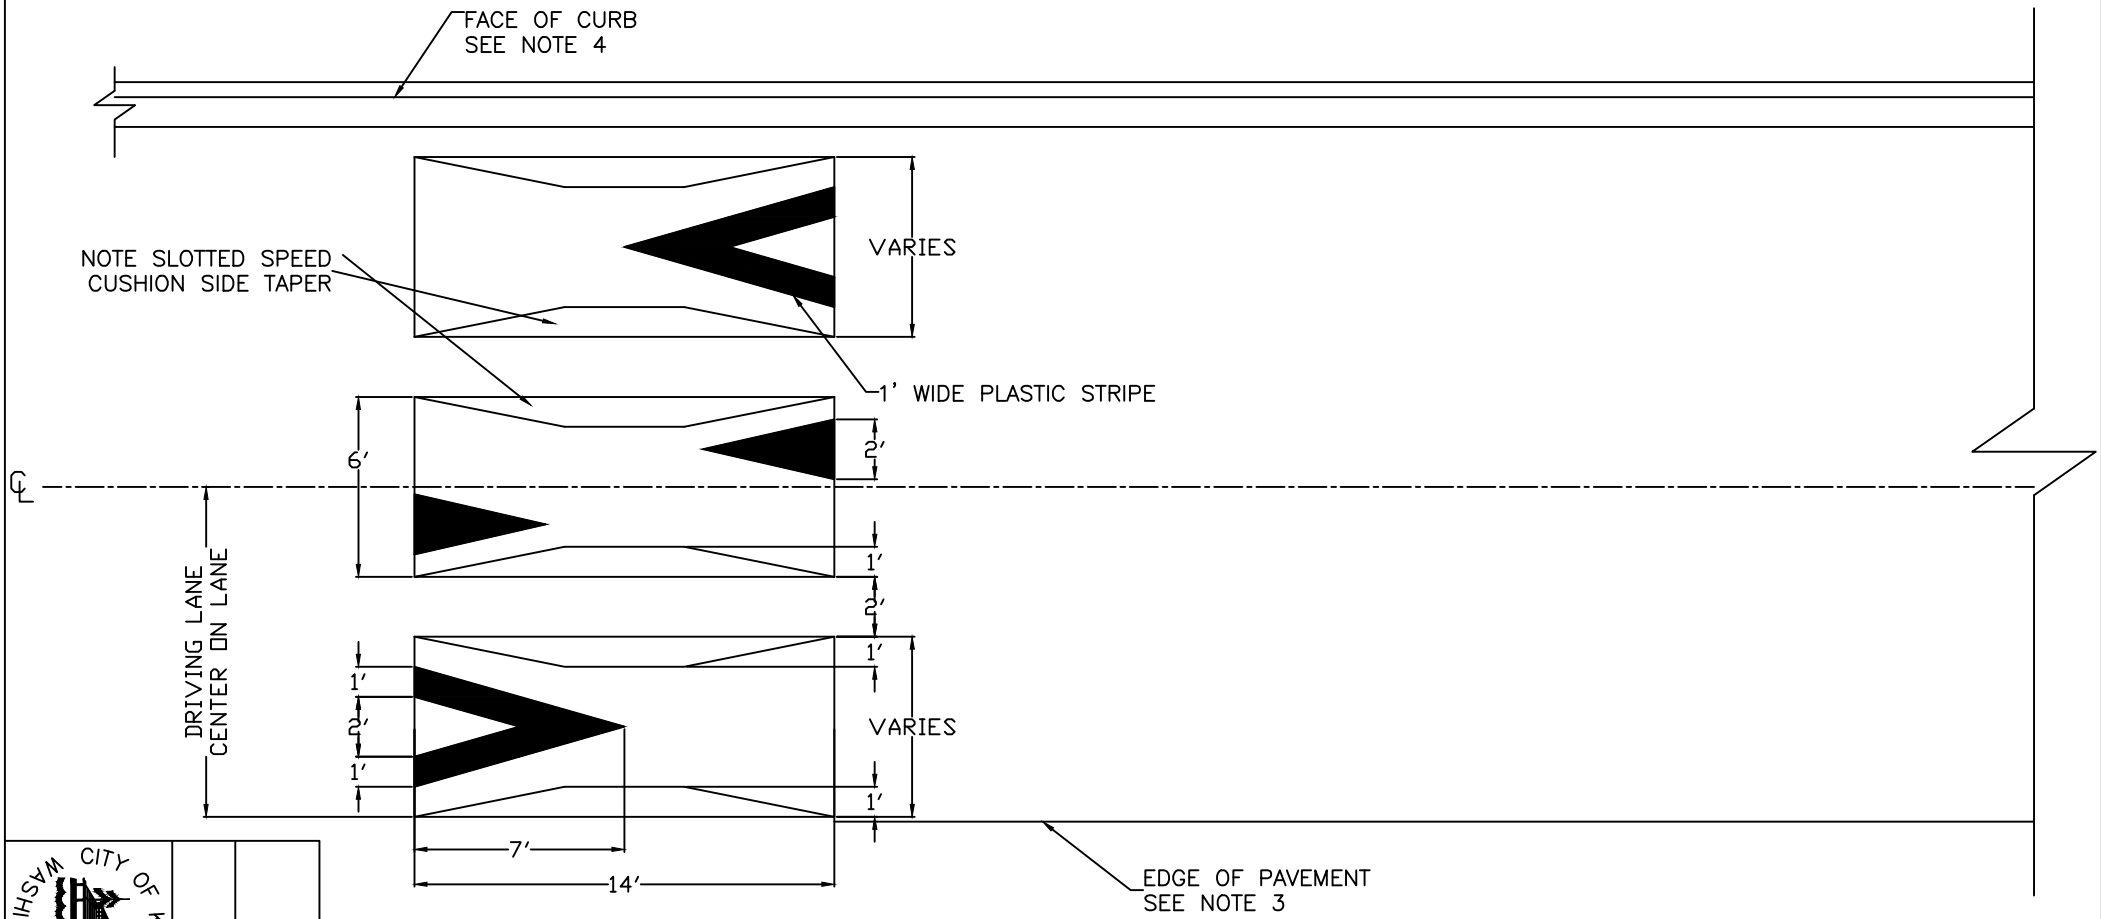

SLOTTED SPEED CUSHION

NO SCALE
MARKING, LAYOUT, AND EDGE DETAIL

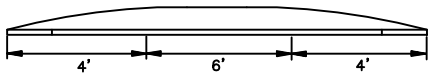

SLOTTED SPEED CUSHION SECTION
NO SCALE

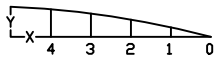

X (ft)	Y (in)
0	0.00
1	1.50
2	2.25
3	2.75
4	3.00

VERTICAL DIMENSION CHART
NO SCALE

NOTES:

1. PAVEMENT MARKINGS TYPICAL IN BOTH DIRECTIONS OF TRAVEL
2. ALL SLOTTED SPEED CUSHION MARKINGS SHALL BE PLASTIC
3. WHEN PLACED ON ROADWAY WITH NO CURB AND GUTTER, EDGE OF SPEED CUSHION EXTENDS TO EDGE OF PAVEMENT
4. WHEN PLACED ON ROADWAY WITH CURB AND GUTTER, EDGE OF SPEED CUSHION TO BE PLACED 2' FROM FACE OF CURB.
5. NOTE SIDE TAPER ON SPEED CUSHION.

CITY OF KIRKLAND
WASHINGTON

CITY OF KIRKLAND

PLAN NO. CK-R.67B

SLOTTED SPEED CUSHION MARKING AND SIGNAGE

LAST REVISED: 1/1/18

DRAWN BY: LISA CYFORD

CENTERLINE & LANE LINE

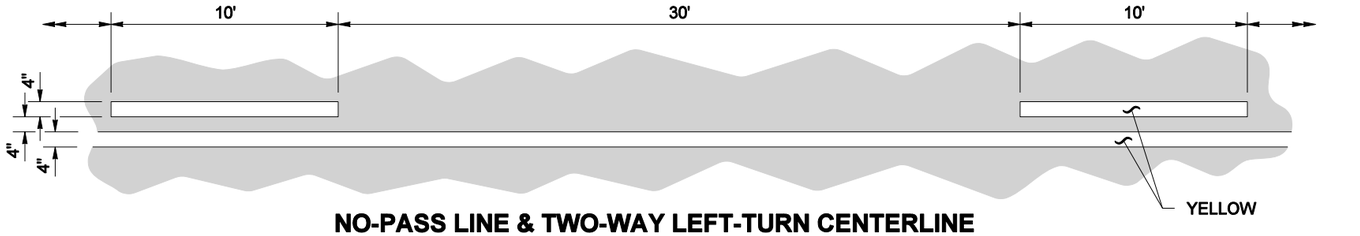

NO-PASS LINE & TWO-WAY LEFT-TURN CENTERLINE

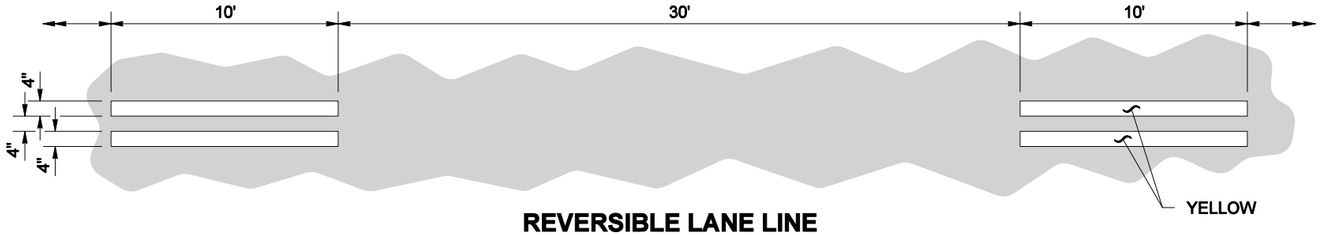

REVERSIBLE LANE LINE

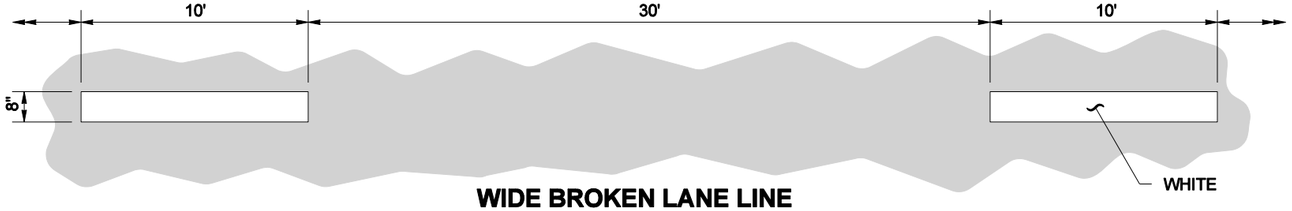

WIDE BROKEN LANE LINE

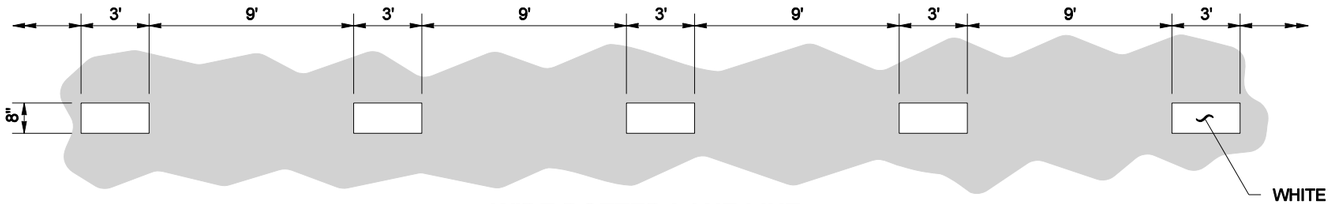

WIDE DOTTED LANE LINE

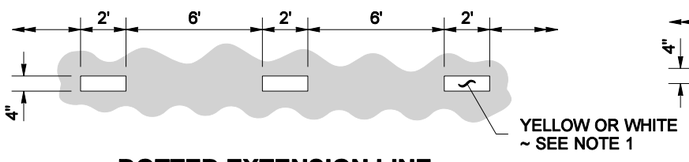

DOTTED EXTENSION LINE

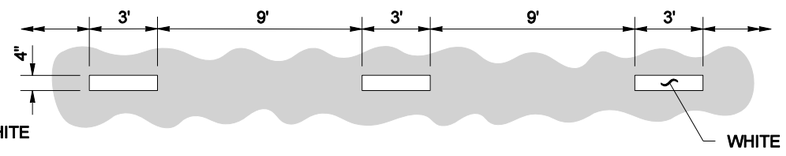

DOTTED LANE LINE

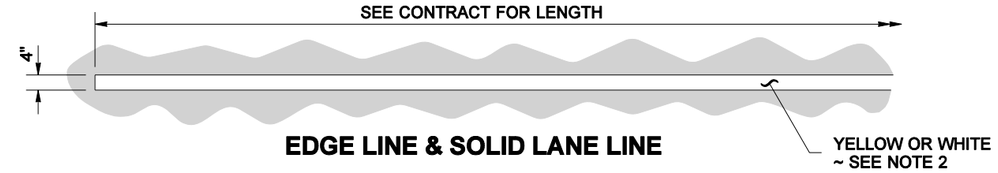

EDGE LINE & SOLID LANE LINE

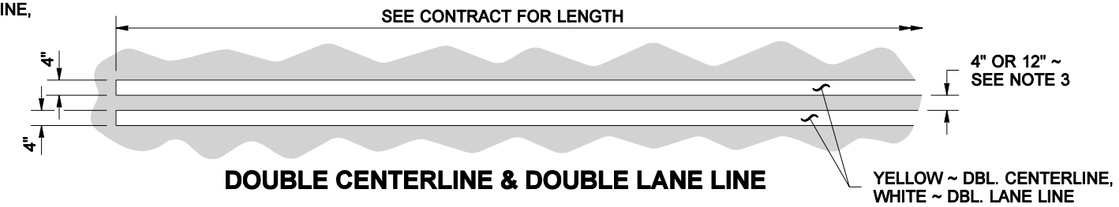

DOUBLE CENTERLINE & DOUBLE LANE LINE

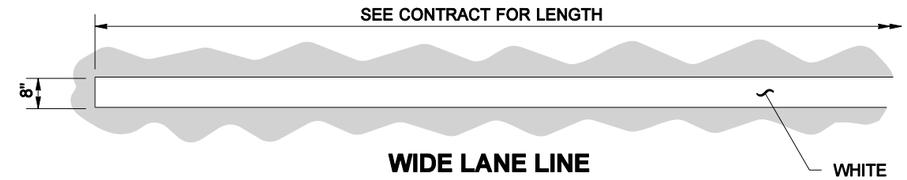

WIDE LANE LINE

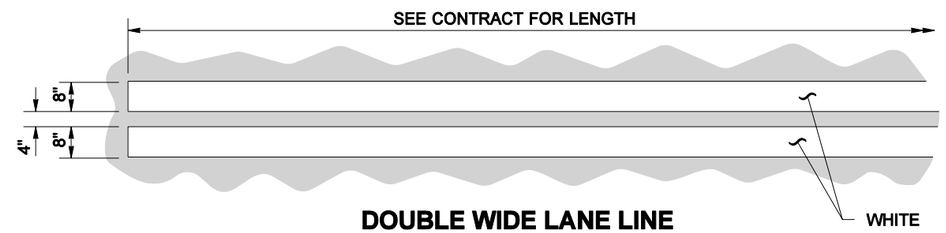

DOUBLE WIDE LANE LINE

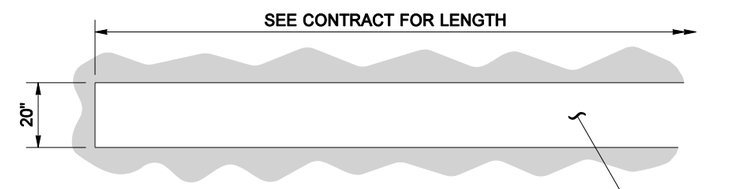

BARRIER CENTERLINE

NOTES

1. Dotted Extension Line shall be the same color as the line it is extending.
2. Edge Line shall be white on the right edge of traveled way, and yellow on the left edge of traveled way (on one-way roadways). Solid Lane Line shall be white.
3. The distance between the lines of the Double Centerline shall be 12" everywhere, except 4" for left-turn channelization and narrow roadways with lane widths of 10 feet or less. Local Agencies (on non-state routes) may specify a 4" distance for all locations.

   The distance between the lines of the Double Lane Line shall be 4".

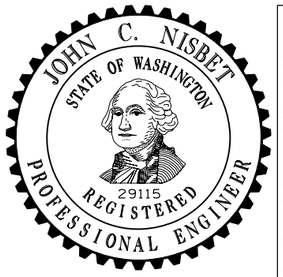

NOTE: THIS PLAN IS NOT A LEGAL ENGINEERING DOCUMENT BUT AN ELECTRONIC DUPLICATE. THE ORIGINAL, SIGNED BY THE ENGINEER AND APPROVED FOR PUBLICATION, IS KEPT ON FILE AT THE WASHINGTON STATE DEPARTMENT OF TRANSPORTATION. A COPY MAY BE OBTAINED UPON REQUEST.

LONGITUDINAL MARKING PATTERNS

STANDARD PLAN M-20.10-02

SHEET 1 OF 1 SHEET

APPROVED FOR PUBLICATION

Pasco Bakotich III — STATE DESIGN ENGINEER

06-03-11 — DATE

Washington State Department of Transportation


NOTE

1. If Rumble Strips are present, install marking outside of the Rumble Strip.

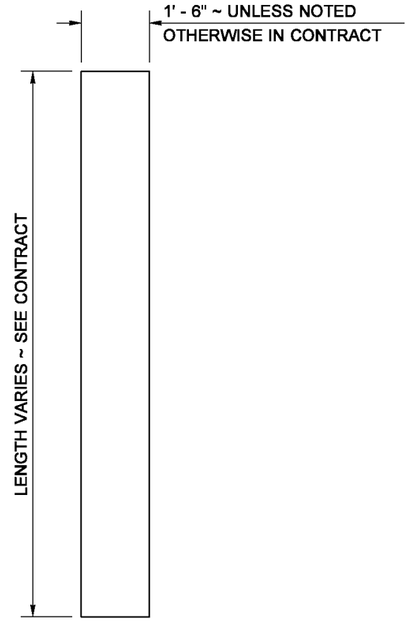

STOP LINE

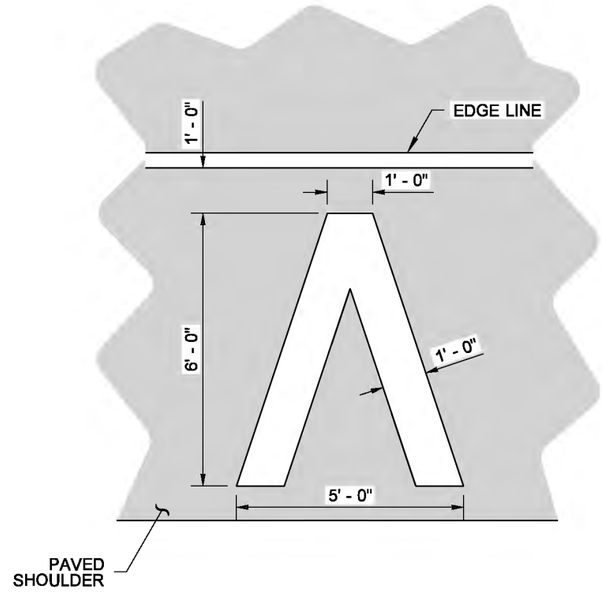

MARKING AREA = 11.73 SQ.FT.

HALF-MILE MARKER

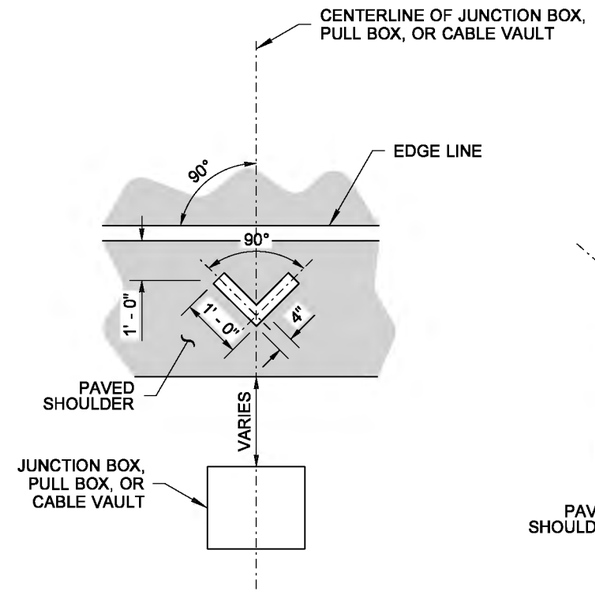

MARKING AREA = 0.56 SQ. FT.

JUNCTION BOX, PULL BOX, OR CABLE VAULT MARKINGS

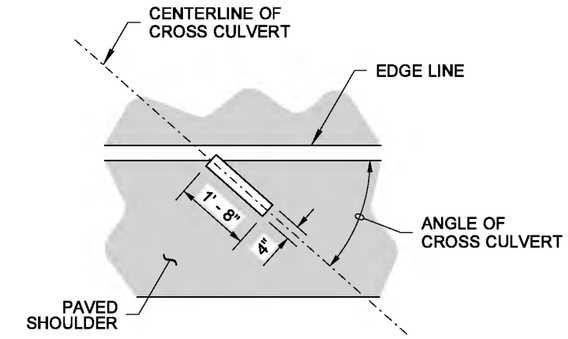

MARKING AREA = 0.56 SQ.FT.

CROSS CULVERT

DRAINAGE MARKING

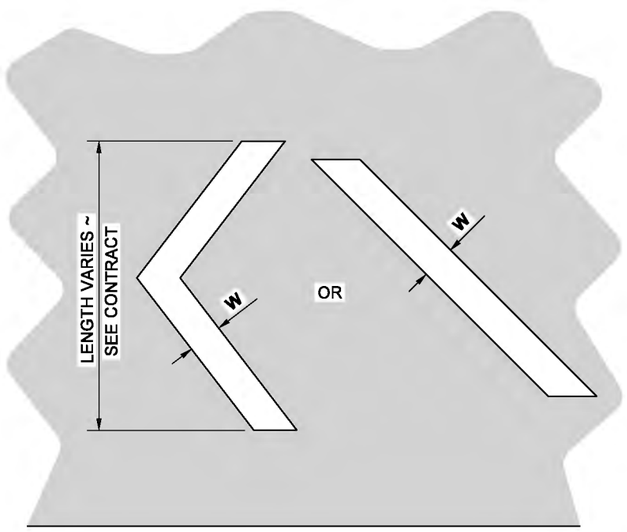

WHITE OR YELLOW ~ SEE CONTRACT

CHEVRON OR DIAGONAL

CROSSHATCH MARKING

W = 8" (IN) FOR POSTED SPEED LIMIT OF 40 MPH OR LOWER
W = 12" (IN) FOR POSTED SPEED LIMIT OF 45 MPH OR HIGHER

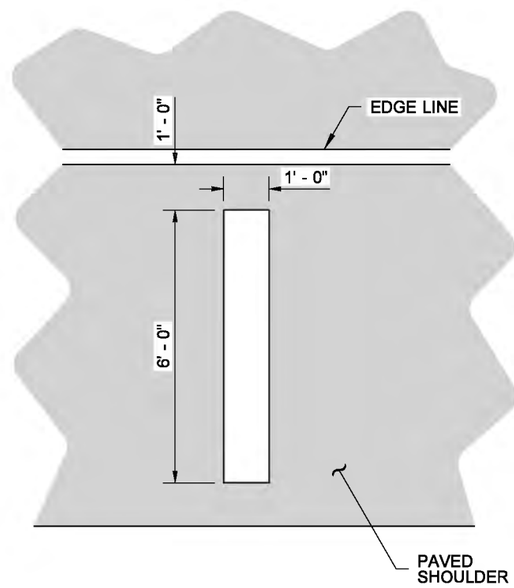

MARKING AREA = 6.00 SQ.FT.

FULL MILE MARKER

AERIAL SURVEILLANCE MARKERS

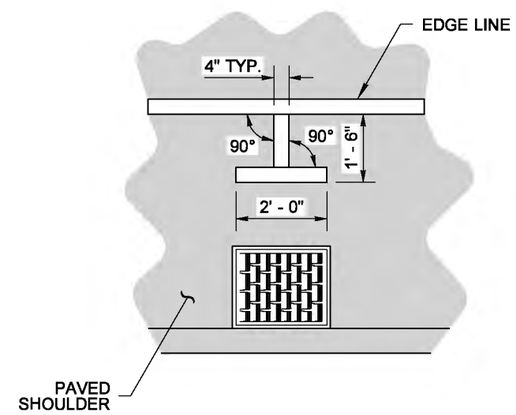

MARKING AREA = 1.06 SQ.FT.

DRAINAGE STRUCTURE INLET

DRAINAGE MARKING

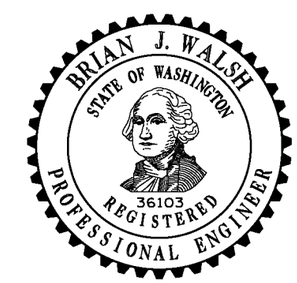

SYMBOL MARKINGS MISCELLANEOUS

STANDARD PLAN M-24.60-04

SHEET 1 OF 2 SHEETS

APPROVED FOR PUBLICATION

STATE DESIGN ENGINEER

Washington State Department of Transportation

DRAWN BY: LISA CYFORD

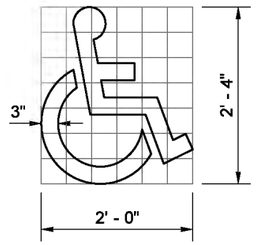

GRID IS 4" (IN) SQUARE MARKING AREA = 1.41 SQ.FT.

ACCESS PARKING SPACE SYMBOL (MINIMUM)

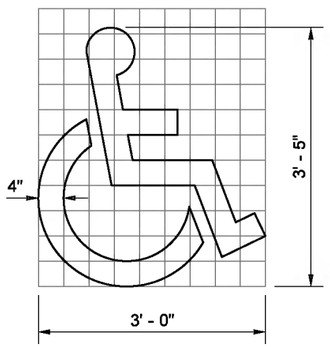

GRID IS 4" (IN) SQUARE MARKING AREA = 3.09 SQ.FT.

ACCESS PARKING SPACE SYMBOL (STANDARD)

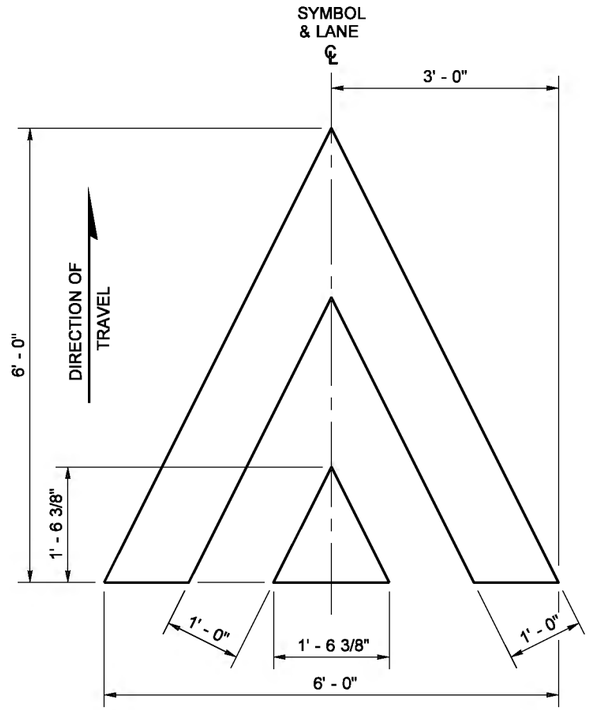

MARKING AREA = 12.08 SQ.FT.

SPEED BUMP SYMBOL

SYMBOL MARKING		A	B	C	D	USE	MARKING AREA
YIELD AHEAD SYMBOL	TYPE 1	6' - 0"	2' - 6"	13' - 0"	N/A	LESS THAN 45 MPH	25.90 SQ.FT.
	TYPE 2	6' - 0"	3' - 0"	20' - 0"	N/A	45 MPH OR GREATER	36.54 SQ.FT.
YIELD LINE SYMBOL	TYPE 1	1' - 0"	6"	1' - 6"	6"	LESS THAN 45 MPH	0.75 SQ.FT.
	TYPE 2	2' - 0"	1' - 0"	3' - 0"	1' - 0"	45 MPH OR GREATER	3.00 SQ.FT.
	TYPE 2	2' - 0"	1' - 0"	3' - 0"	1' - 0"	ROUNDABOUT ENTRY *	3.00 SQ.FT.

* MINIMUM OF 4 IN LANE

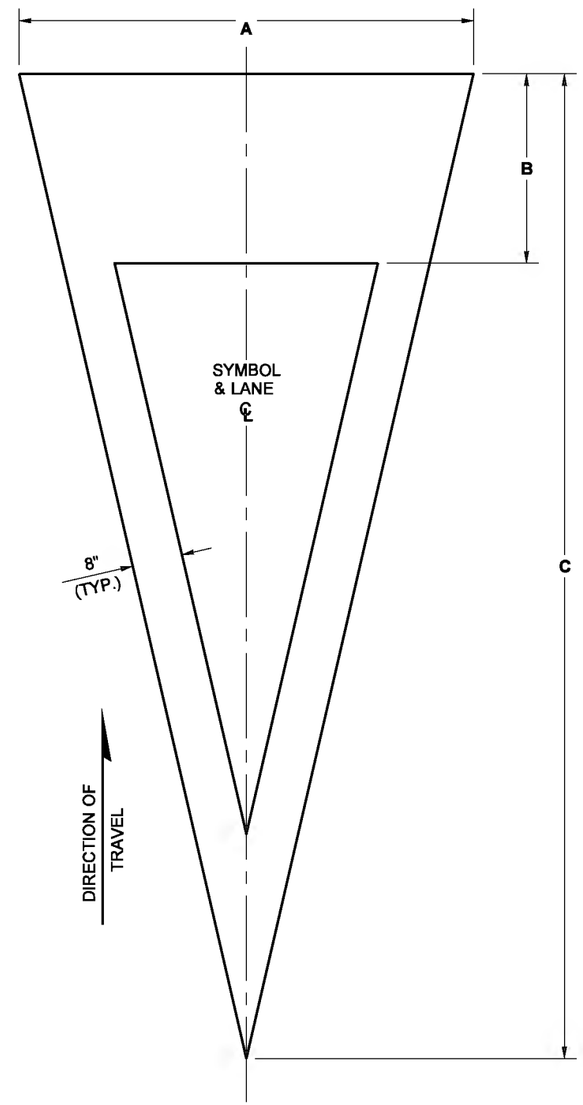

YIELD AHEAD SYMBOL

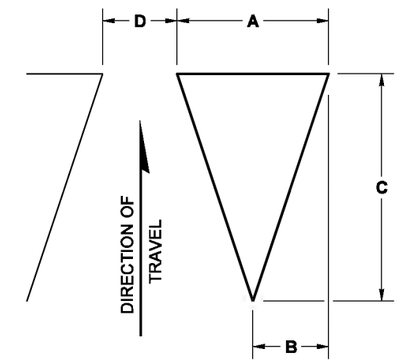

YIELD LINE SYMBOL
(MULTIPLE SYMBOLS REQUIRED FOR TRANSVERSE YIELD LINE ~ SEE CONTRACT)

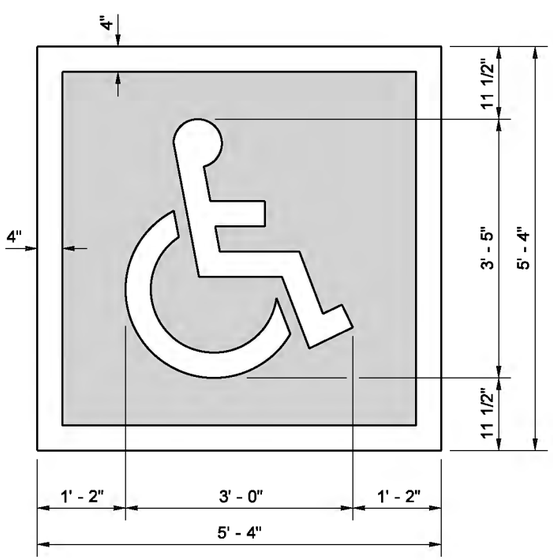

TOTAL MARKING AREA = 28.44 SQ.FT.
WHITE = 9.76 SQ.FT. BLUE = 18.69 SQ.FT.

ACCESS PARKING SPACE SYMBOL (STANDARD)
WITH BLUE BACKGROUND AND WHITE BORDER
(REQUIRED FOR CEMENT CONCRETE SURFACES)

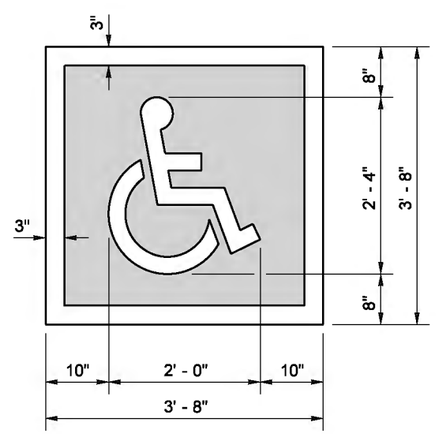

TOTAL MARKING AREA = 13.44 SQ.FT.
WHITE = 4.82 SQ.FT. BLUE = 8.62 SQ.FT.

ACCESS PARKING SPACE SYMBOL (MINIMUM)
WITH BLUE BACKGROUND AND WHITE BORDER
(REQUIRED FOR CEMENT CONCRETE SURFACES)

SYMBOL MARKINGS MISCELLANEOUS

STANDARD PLAN M-24.60-04

SHEET 2 OF 2 SHEETS

APPROVED FOR PUBLICATION

STATE DESIGN ENGINEER

Washington State Department of Transportation